

O.D.O.T. DISTRICT 2 SURVEY OFFICE (USE ONLY)

PERSONNEL

REFERENCE NO. 3

SHEET 3 OF 25

NOTES MILLER
H.C. MILLER
R.C. BARRIERE
BLUBAUGH

DATE 8/6/24
WEATHER CLOUDY
TEMP. 75°

ROUTE SR 582
COUNTY WOOD
TOWNSHIP MIDDLETON
SECTION 20

DWG BY BARRIERE PID 114849

T 6 N R 10 E

TYPE MONUMENT MAG WASHER

ON SURFACE - BELOW 0.5" BELOW

OFFSET $\angle$ PAVEMENT 6' LT : RT

TO EDGE PAVEMENT

STATION: 16+42

HORIZ.DATUM: NAD83 (2011)


GEOID: 18

GRID: NORTHING: 655578.232


EASTING: 1626511.217

LDP: NORTHING: 477078.322

EASTING: 137252.118

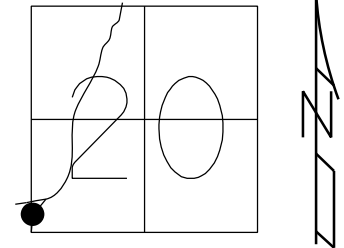

FD SM RR SPK
4/20/04, M.B.
RESET MAG/WASHER
7/30/04, MC
FND, 3/14/14
GPS, REF3
4/8/14, TMR
SET MAG/W
7/25/14, EBW
GPS, NEWREF3
7/29/14, JMR
FD MAG/WASH
REF3
12/7/23, JAM
FD TONE, DID NOT UNCOVER
8/6/24, JAM

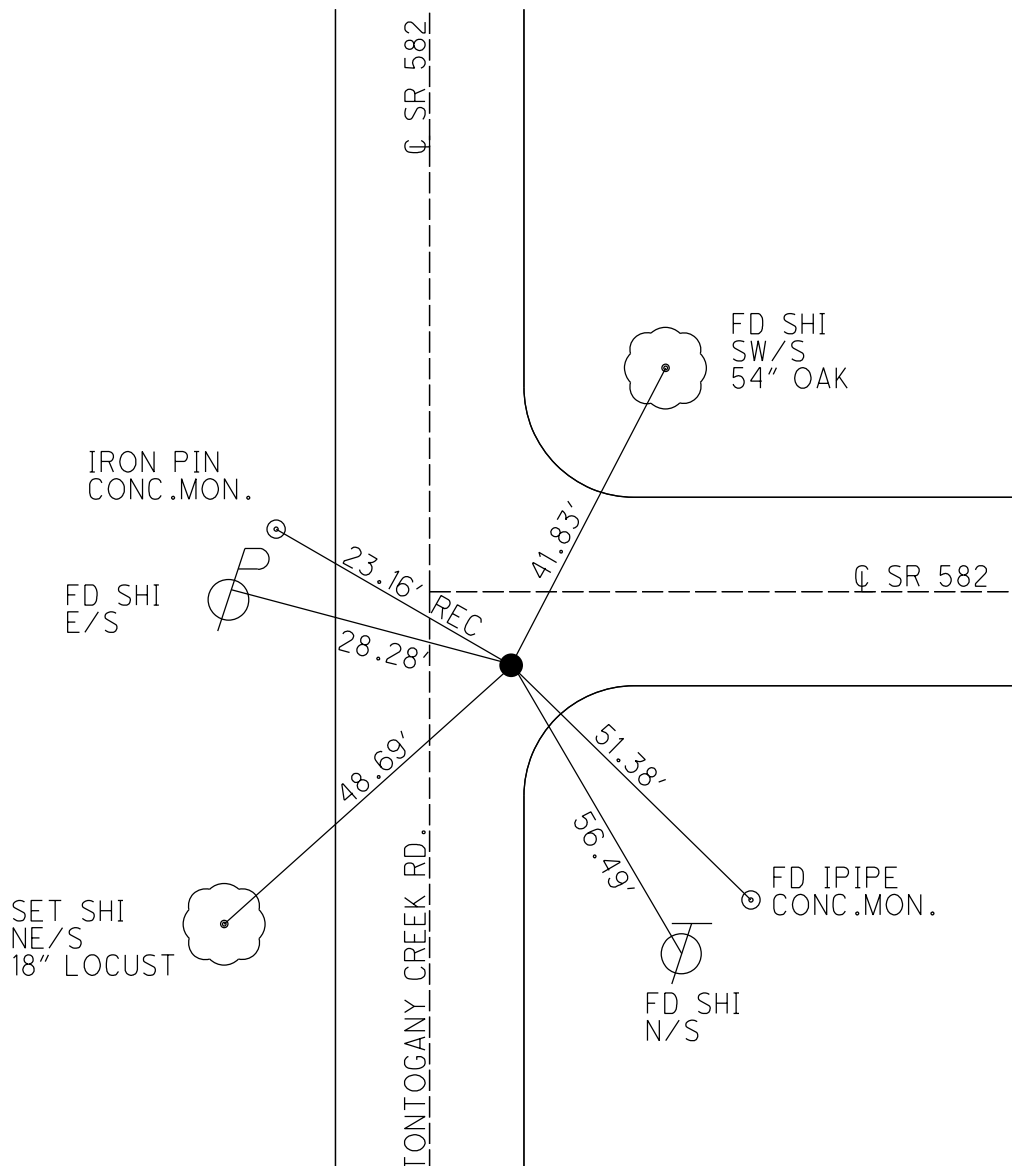


O.D.O.T. DISTRICT 2 SURVEY OFFICE (USE ONLY)

PERSONNEL _____ REFERENCE NO. 3 SHEET 3 OF 25
NOTES RHOADES DATE 4/8/14 ROUTE SR 582
H.C. ROUSOS WEATHER FAIR COUNTY WOOD
R.C. RHOADES TEMP. 44° TOWNSHIP MIDDLETON
SECTION 20
T 6 N R 10 E

TYPE MONUMENT PK/W
ON SURFACE - ~~BELOW~~ ON _____
~~LEFT~~ - Q PAV'T - RIGHT 6.0'
- TO - EDGE PAVEMENT
S.L.M. 16+42, 4.3' RT of Q NORTH

Grid: Northing: 655578.232 Easting: 1626511.217

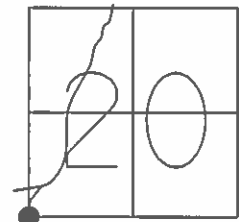

FD SM RR SPK
4/20/04, M.B.


RESET MAG/WASHER
7/30/04, MC

FND, 3/14/14

GPS, REF3
4/8/14, TMR

SET MAG/W
7/25/14, EBW

GPS, NEWREF3
7/29/14, JMR

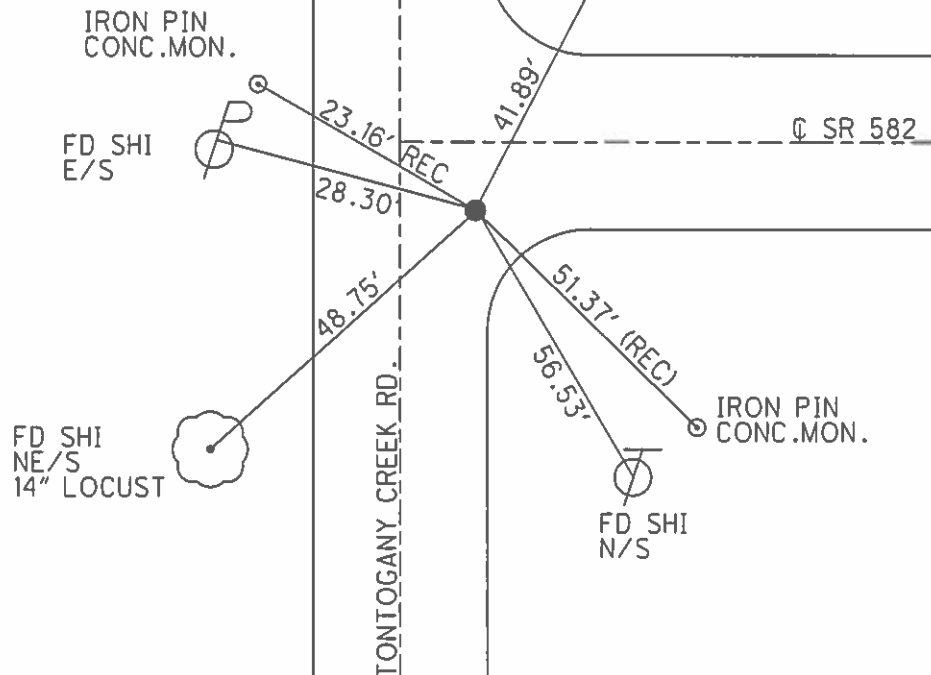

O.D.O.T. DISTRICT 2 SURVEY OFFICE

PERSONNEL _____

REFERENCE NO. 3

SHEET 1 OF 23

NOTES CANTERBURY RC

H.C. BARNHISEL (DRAWN)

R.C. _____

DATE 04/20/04

WEATHER cloudy

TEMP. +48°

ROUTE S.R. 582

COUNTY WOOD

TOWNSHIP MIDDLETON

SECTION 20

T.G. N R 10 E

TYPE MONUMENT Sm. RR Spk


ON SURFACE - BELOW 1.5"

LEFT - & PAV'T. - RIGHT 7.3'

12.4' TO RT EDGE PAVEMENT

S.L.M. 16+42

4.5' RT OF & NORTH

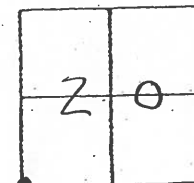

Reset Mag/Washer
07/30/04
MC

I. Pin
Conc. Mon.

23.16' - Rec

SET Shi
E/S

28.31'

& PAVT.
S.R.
582

41.97'

Fd Shi
SW/S
42" OAK

& PAVT. S.R. 582

48.79'

SET Shi
NE/S
14" LOCUST

TANTOGANY CREEK RD.

51.37'
56.55'

I. Pin, Conc. Mon.

Fd Shi
N/S

Resurveyed 2004

O.D.O.T. DISTRICT 2 SURVEY OFFICE

PERSONNEL

REFERENCE NO. 3

SHEET OF

NOTES BARNHISEL

H.C. Hoffman

DATE 3-26-86

ROUTE 582

R.C. Loehrke

WEATHER cloudy

COUNTY WOOD

GRAMZA

TEMP. +65°

TOWNSHIP MIDDLETON

SECTION 20

T. 6 N. R. 10 E.

TYPE MONUMENT Sm RR Spk



Set P.K. / washer
5-6-85 SWH

ON SURFACE - BELOW yes

LEFT - 0 PAV'T. - RIGHT 5.8 East 4.5 R & N


1.5 TO 5 EDGE PAVEMENT

S.L.M. 16 + 42

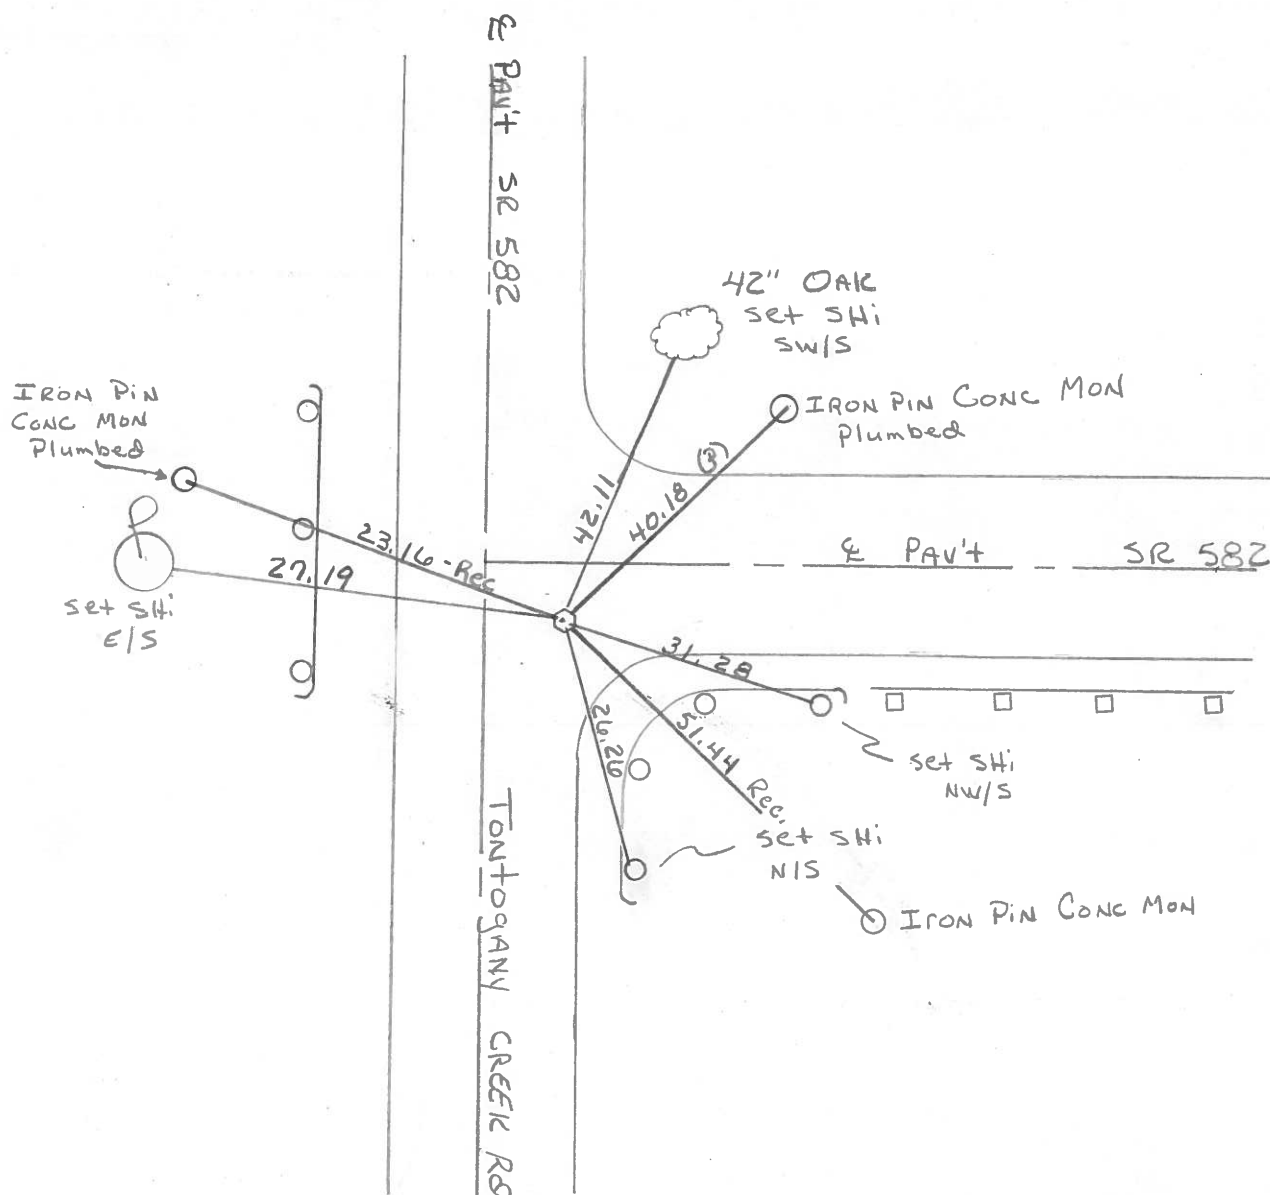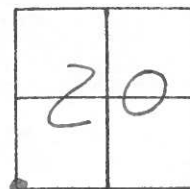


County Wood S.R. 582Date 5-10-1979Township MiddletonWeather ClearSection SW Corner Sec. 20Temp. 83°

T6N, R10E

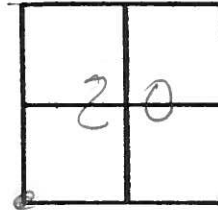Personnel SmithKnapeBowersmead

(3)

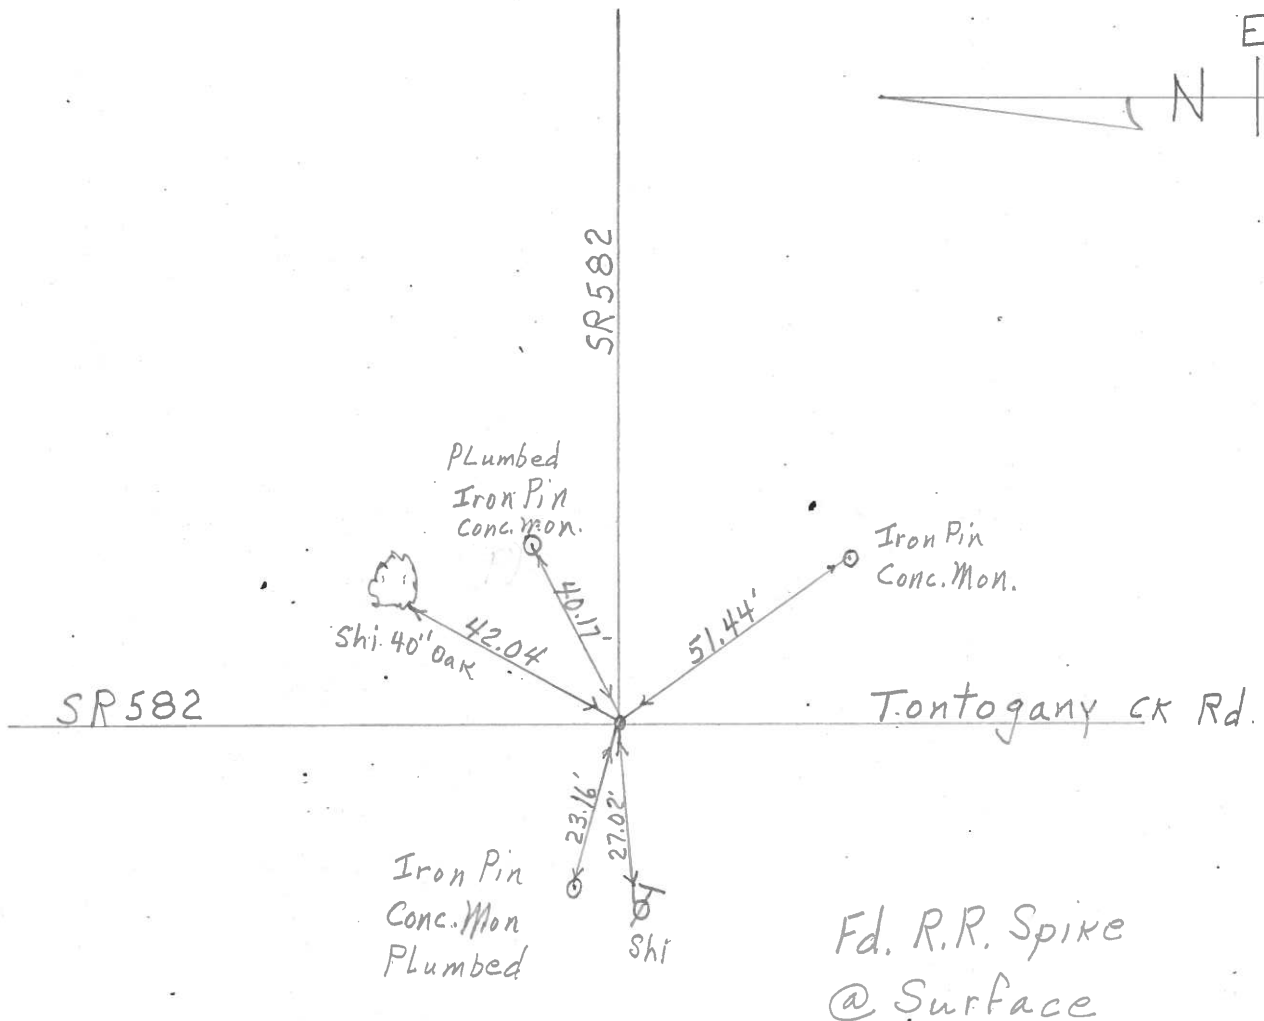


PERSONNEL	TITLE	PERSONNEL	TITLE
BURNSIDE			
SMITH			
BOWERS			
HOLCOMBE			

COUNTY WOOD DATE 5-25-71

S. R. 582 WEATHER CLOUDY

SEC. _____ TEMP. +60°

DESCRIPTION _____ LEFT _____ CENTER LINE _____ RIGHT _____ JOB NO. _____

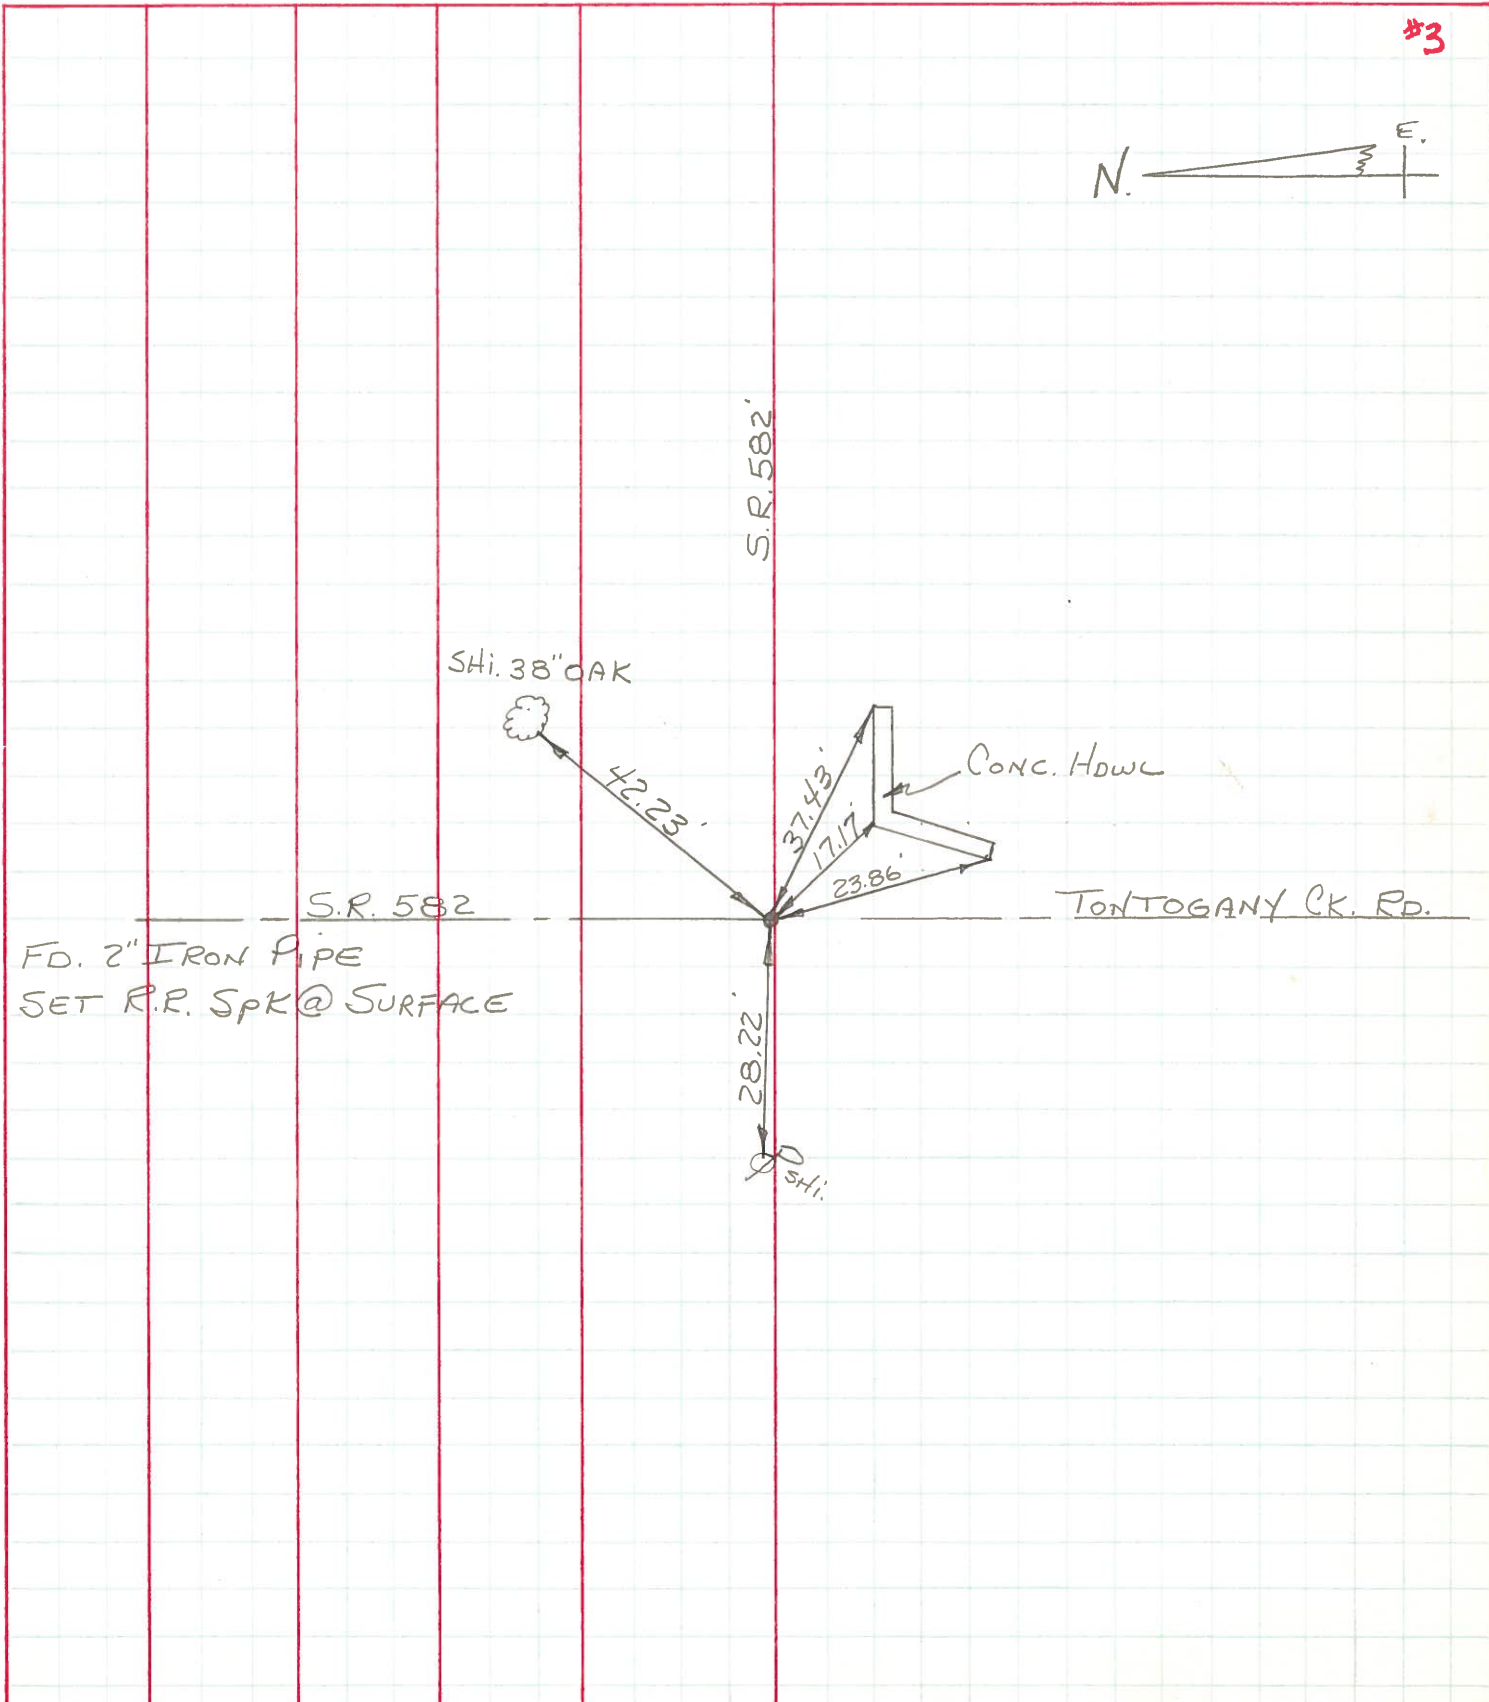

PERSONNEL

TITLE

PERSONNEL

TITLE

COUNTY

Wood

DATE

12-27-57

Sworden

4-4-60

S. R.

#582

WEATHER

SEC.

A, B, C, D

TEMP.

DESCRIPTION

LEFT

CENTER LINE

RIGHT

JOB NO.

433' S. of intersection of
S.H. 984 & S.H. 53.
Stone, mon. 25.7' E. of
center of road.

2

#431

O.K.

Shiner in 30" Elm
steel cor. post
Shiner in cor. post
(New) Shiner in P.P.

S. 6.9
W. 44.97
E. 21.2'
E. 76.59

Stone, 3' of 2" pipe on top.
S.R. 582 & Tontogany Ck. Rd.

#432

3

O.K.

Conc. marker N. E. 1.0'
S.W. Cor. S.W. Wing
S. Cor. E. end N. Hdwl.
Cor. of N. conc. wall E. of N.
Shiner P. Pole

W. 23.30
S.E. 23.58'
N.E. 31.25'
32.60
W. 28.25'

Steel rod set at S. edge of
E. & W. pav't.
Frost Rd.

#434

O.K.

Telephone Pole
Shiner in P.P.
Brace pole
P.P.

Sof E. 10.87
N.W. 34.45
W. of South 27.8'
N.E. 79.80

S.R. #582 & Green Rd.
Fd. Iron Pin
Co. 1963 - Set R.R. spk.

#435

S.E. To N.W. Cor. E. Wing 13.08'
S.W. To N.E. Cor. N. Wing 14.00'
Shiner 24" Elm N.S.W. 80.64'
Shiner in Tele Pole E.S.E. 80.55'
N.W. Cor. E. Conc. Hdwl. S.E. 18.04
N.E. Cor. W. " " S.W. 11.36
1.5' N. of S. edge Pav't.

#436

on back of Page