

O.D.O.T. DISTRICT 2 SURVEY OFFICE (USE ONLY)

PERSONNEL

REFERENCE NO. 4

SHEET 4 OF 25

NOTES MILLER
H.C. MILLER
R.C. BARRIERE
BLUBAUGH

DATE 8/6/24
WEATHER CLOUDY
TEMP. 75°

ROUTE SR 582
COUNTY WOOD
TOWNSHIP MIDDLETON
SECTION 20
T 6 N R 10 E

DWG BY BARRIERE PID 114849

TYPE MONUMENT MAG WASHER

ON SURFACE - BELOW 0.5" BELOW

OFFSET $\odot$ PAVEMENT 4' ~~LT~~ : RT

TO EDGE PAVEMENT

STATION: 42+86

HORIZ.DATUM: NAD83 (2011)


GEOID: 18

GRID: NORTHING: 655523.362


EASTING: 1629157.607

LDP: NORTHING: 477058.334

EASTING: 139899.094

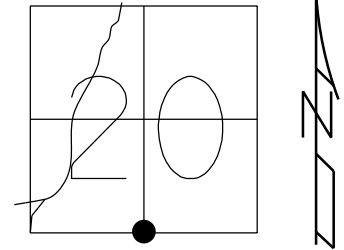


RESET MAG/WASHER
7/31/04, MC
GPS, REF4
4/8/14, TMR
SET MAG/W
7/25/14, EBW
GPS, NEWREF4
7/29/14, JMR
FD MAG/WASH,
REF4
12/7/23, JAM
FD TONE, DID NOT UNCOVER
8/6/24, JAM

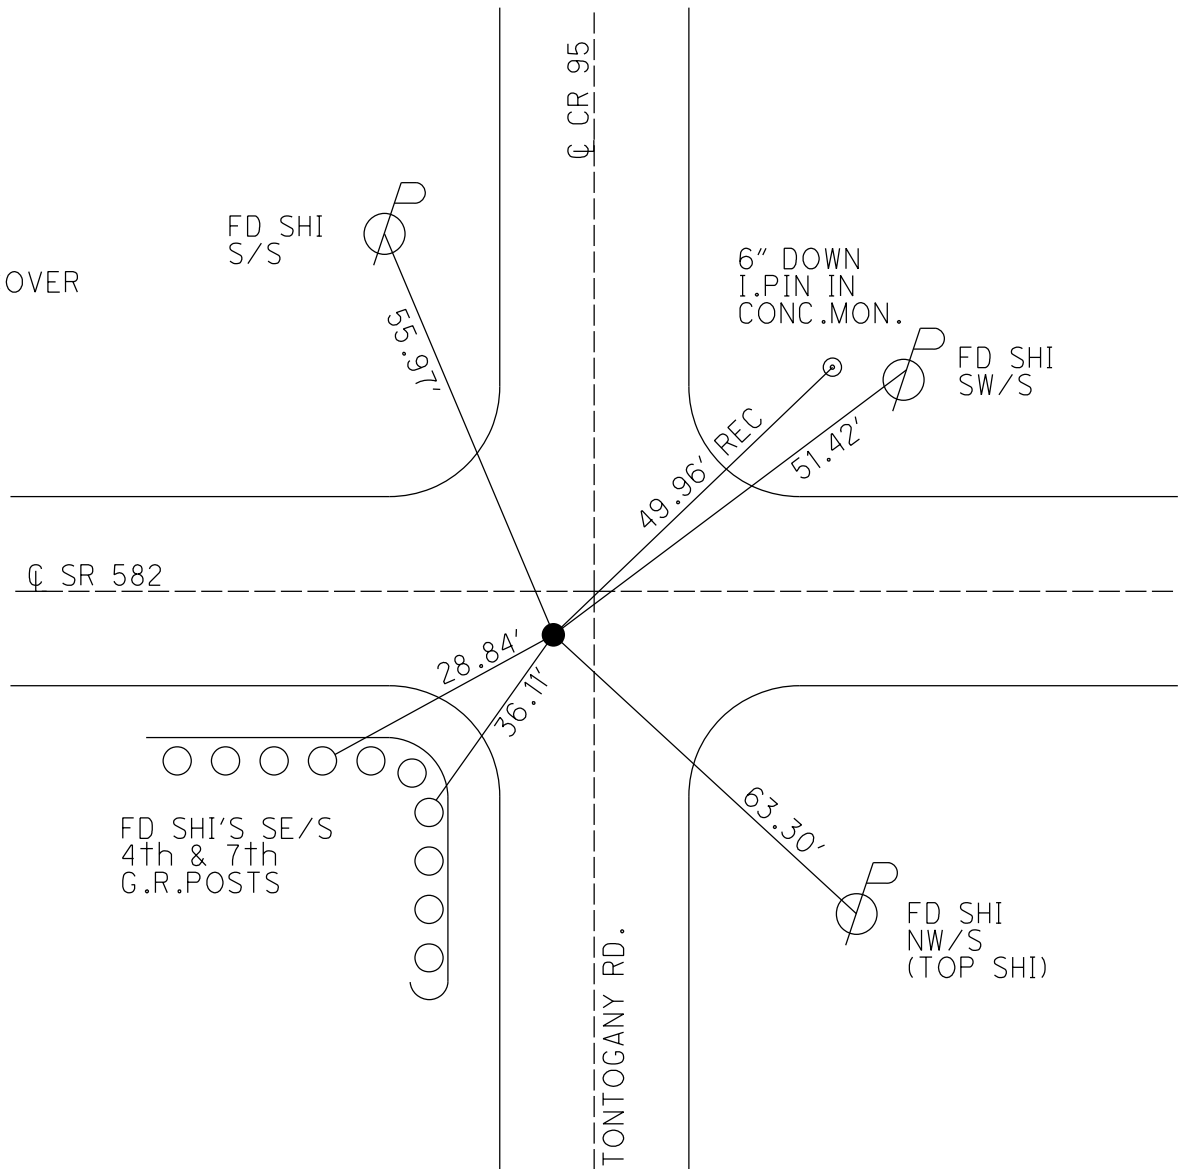

O.D.O.T. DISTRICT 2 SURVEY OFFICE (USE ONLY)

PERSONNEL	REFERENCE NO. <u>4</u>	SHEET <u>4</u> OF <u>25</u>
NOTES	DATE <u>4/8/14</u>	ROUTE <u>SR 582</u>
H.C. <u>RHOADES</u>	WEATHER <u>FAIR</u>	COUNTY <u>WOOD</u>
R.C. <u>ROUSOS</u>	TEMP. <u>44°</u>	TOWNSHIP <u>MIDDLETON</u>
<u>HOMAN</u>		SECTION <u>20</u>
<u>GABLE</u>		T <u>6</u> N R <u>10</u> E

TYPE MONUMENT MAG/WASHER
 ON SURFACE - ~~BELOW~~ ON
~~LEFT~~ - Q PAV'T - RIGHT 4.0'
TO EDGE PAVEMENT
 S.L.M. 42+86, 3' WEST OF Q SOUTH

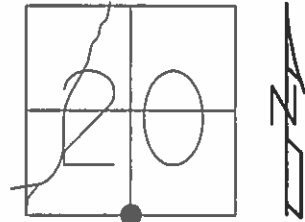


Grid: Northing: 655523.362 Easting: 1629157.607

RESET MAG/WASHER
7/31/04, MC

GPS, REF4
4/8/14, TMR

SET MAG/W
7/25/14, EBW

GPS, NEWREF4
7/29/14, JMR

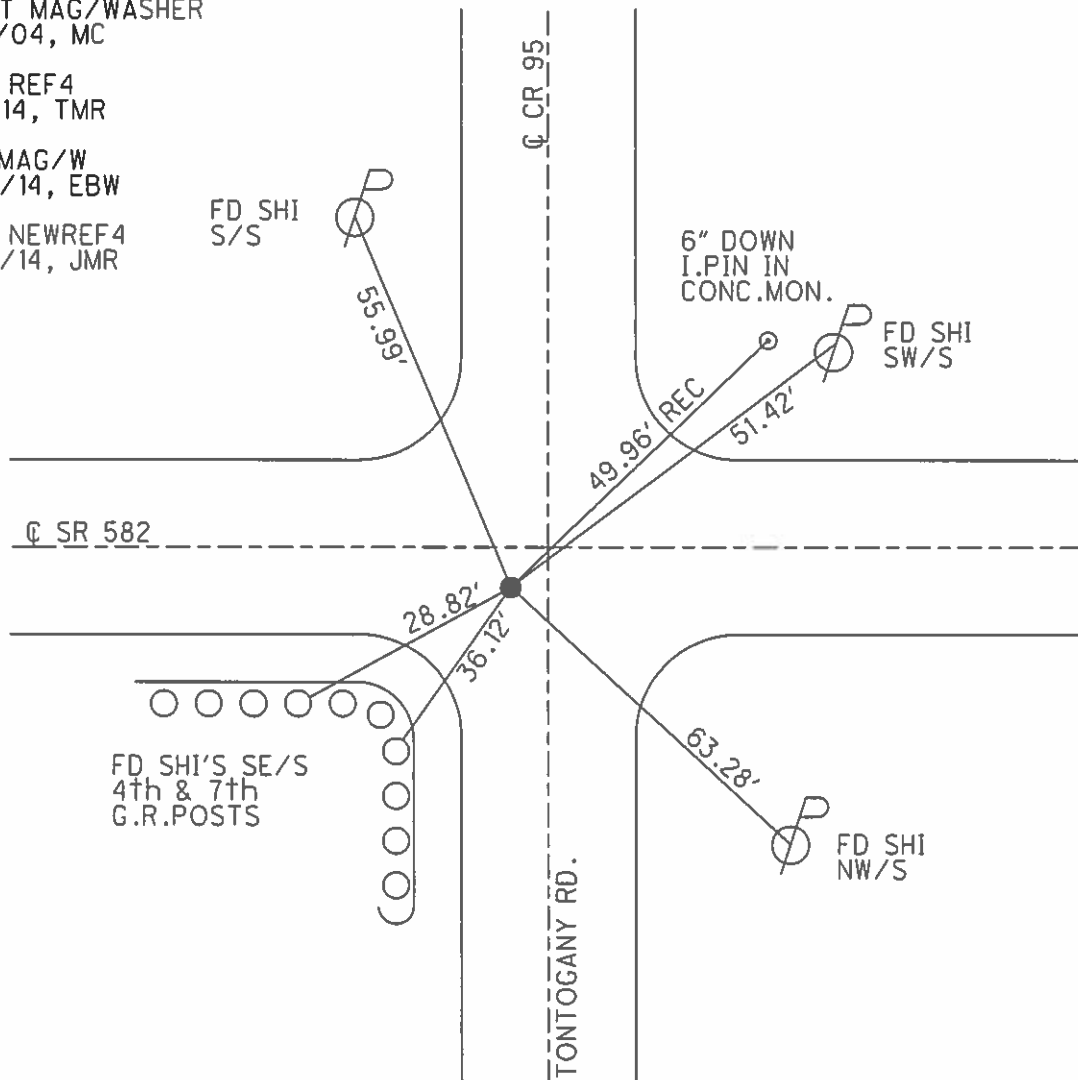

O.D.O.T. DISTRICT 2 SURVEY OFFICE

PERSONNEL _____

REFERENCE NO. 4

SHEET 2 OF 23

NOTES CANTERBURY RC

H.C. BARNHISEL (DRAWN)

R.C. _____

DATE 04/20/04

WEATHER Cloudy

TEMP. +48°

ROUTE S.R. 582

COUNTY WOOD

TOWNSHIP MIDDLETON

SECTION 20

T 6 N R 10 E

TYPE MONUMENT PK/Washer



ON SURFACE - BELOW yes

~~LEFT~~ - ¢ PAV'T. - RIGHT 4.0'

- TO - EDGE PAVEMENT

S.L.M. 42+86

3' WEST OF E South

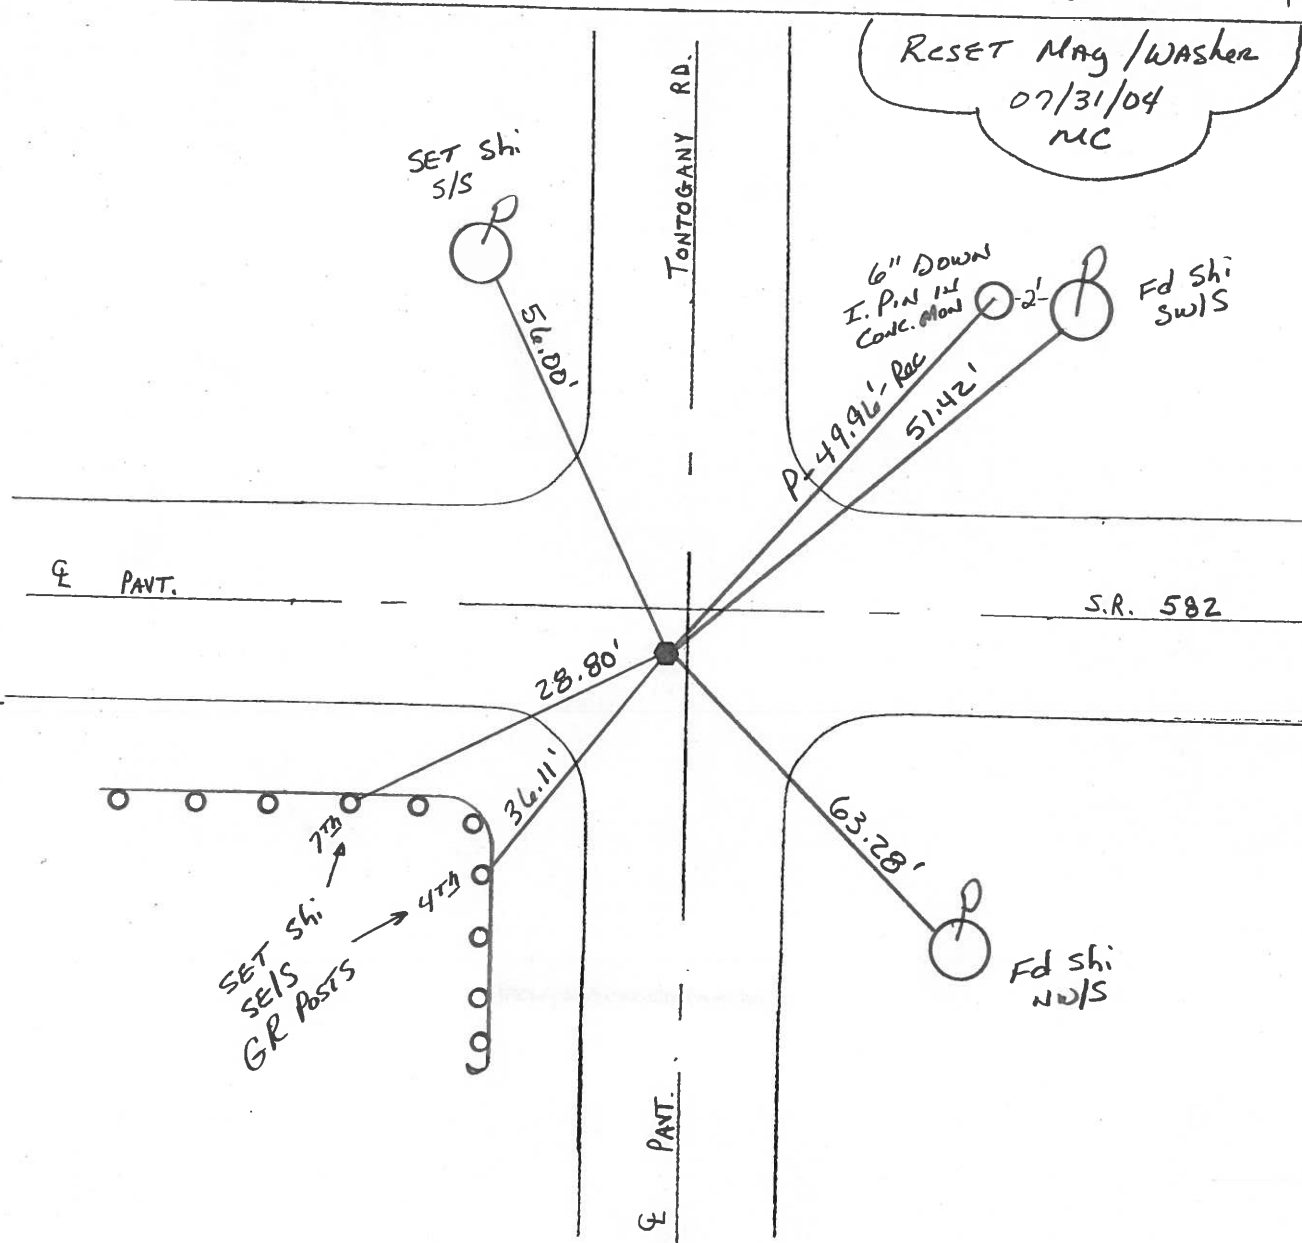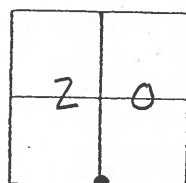

O.D.O.T. DISTRICT 2 SURVEY OFFICE

PERSONNEL

REFERENCE NO. 4

SHEET OF

NOTES BARNHISEL

H.C. Hoffman

R.C. Loehrke

GRAMZA

DATE 3-26-86

WEATHER Cloudy

TEMP. +65°

ROUTE 582

COUNTY WOOD

TOWNSHIP MIDDLETON

SECTION 20

T6 N R 10 E



TYPE MONUMENT Sm RR Spk Set P.K. / weather S-C-86 SWM


ON SURFACE - BELOW yes

LEFT - CL PAV'T. - RIGHT 4.6 - 2.5 W of N E


TO EDGE PAVEMENT

S.L.M. 42+86

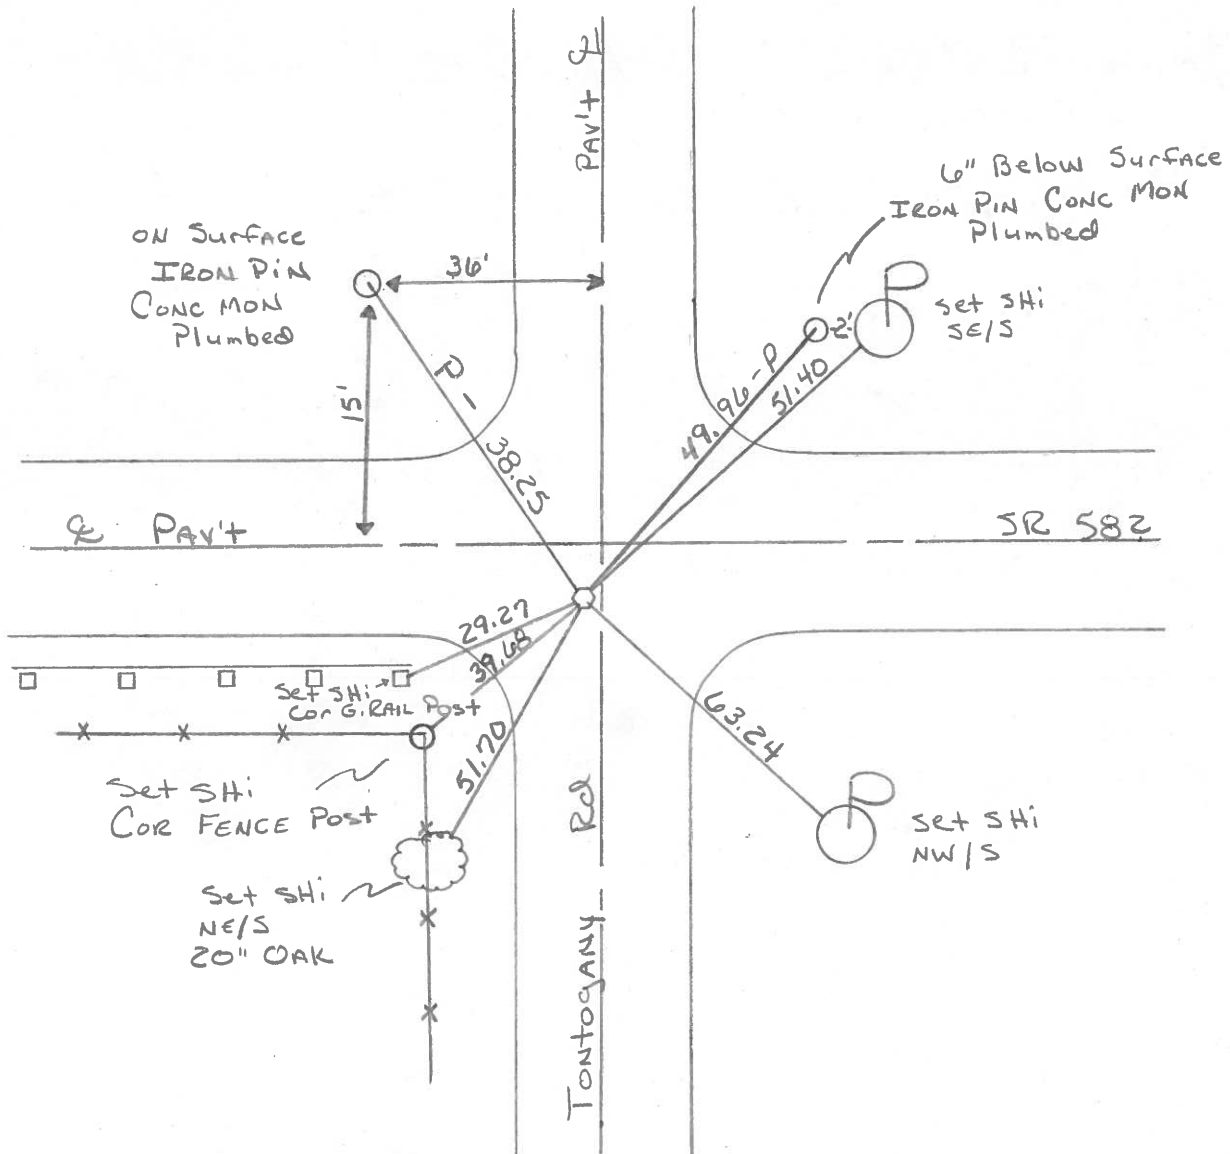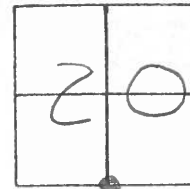

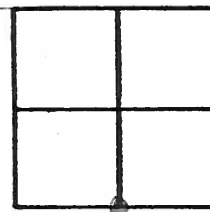County Wood S.R. 582Date 5-11-1979Township MiddletonWeather ClearSection 3¹/₄ Post Sec. 20Temp. 80°T6N, R10EPersonnel SmithKnappemead

④

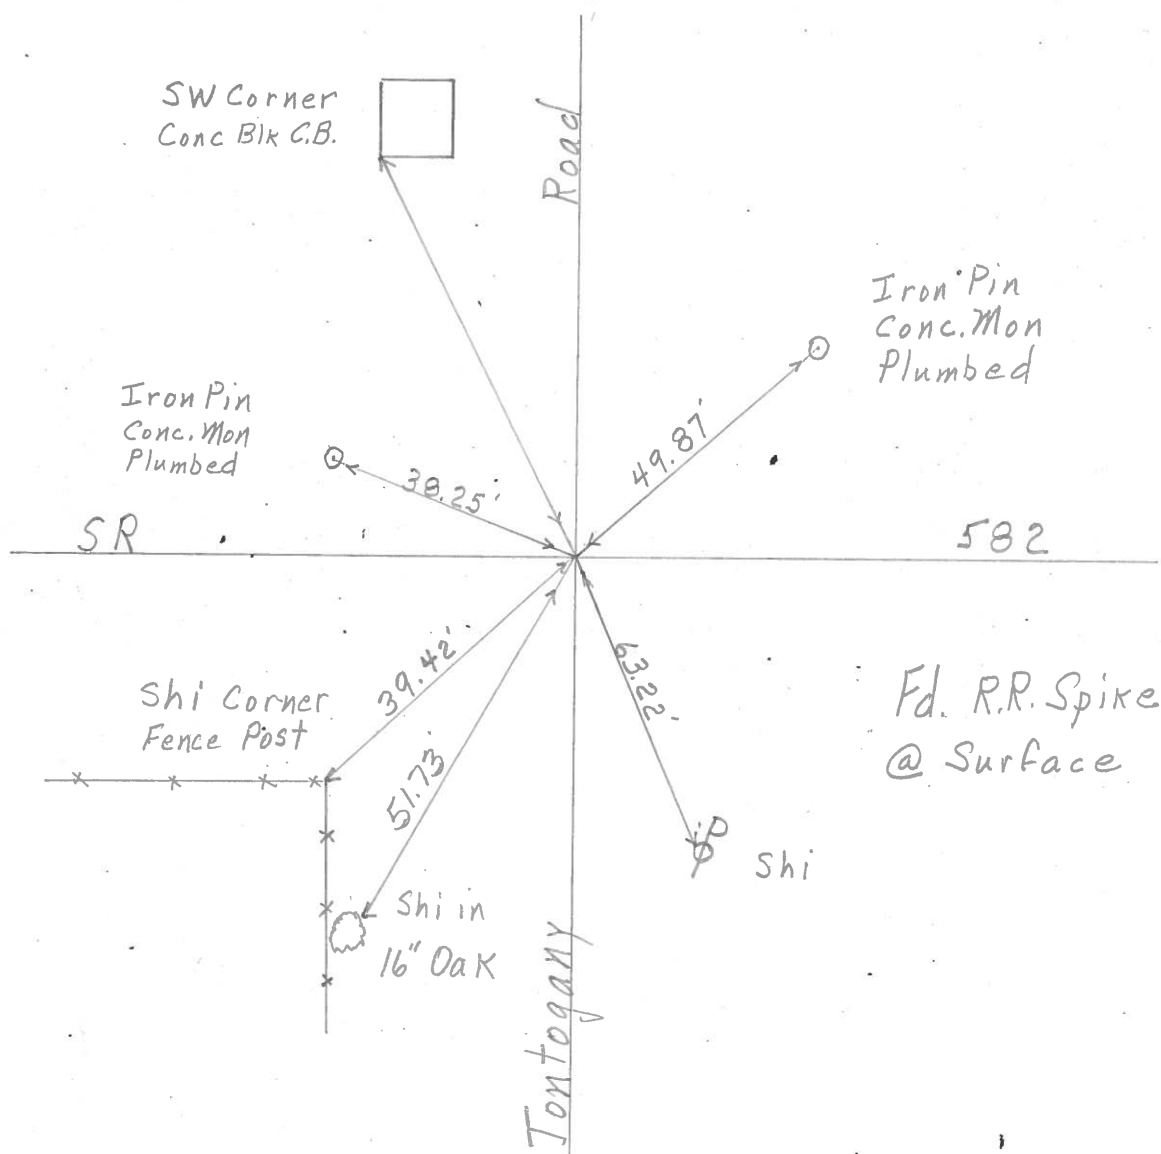

PERSONNEL	TITLE	PERSONNEL	TITLE
BURNSIDE			
SMITH			
BOWERS			
HOLCOMBE			

COUNTY WOODDATE 5-25-71S. R. 582WEATHER CLOUDY

SEC. _____

TEMP. +60°

DESCRIPTION _____

LEFT

CENTER LINE

RIGHT

JOB NO. _____

N. 1/4 COR. SEC. 29
R-10-E T-6-N
WASHINGTON Twp. TONTOGANY

STONE ON & PAVE,
S. & 3.4' N. of S.
EDGE PAVE. W.
FD. 1 1/4" I. PIPE
3' DEEP.

SET R.R. SPK. @ SURFACE

S.W. COR. CONC.
BLK. C. B.

N. COR. W.
HOWL. MASONRY
CULV.

S.E. COR. E. HOWL.
MASONRY CULV.

ROAD

SHI. 14" OAK

SHI. COR. FENCE
POST



#4