

O.D.O.T. DISTRICT 2 SURVEY OFFICE (USE ONLY)

PERSONNEL

REFERENCE NO. 9A

SHEET 10 OF 25

NOTES MILLER

DATE 8/6/24

ROUTE SR 582

H.C. MILLER

WEATHER CLOUDY

COUNTY WOOD

R.C. BARRIERE

TEMP. 75°

TOWNSHIP MIDDLETON

BLUBAUGH

SECTION 22

DWG BY BARRIERE

PID 114849

T 6 N R 10 E

TYPE MONUMENT MAG WASHER

~~ON SURFACE~~ - BELOW 0.5"

OFFSET Q PAVEMENT 7.0' LT : ~~RT~~

1.7' TO LT EDGE PAVEMENT

STATION: 135+00

HORIZ.DATUM: NAD83 (2011)


GEOID: 18

GRID: NORTHING: 655378.107


EASTING: 1638364.582

LDP: NORTHING: 477034.448

EASTING: 149107.805

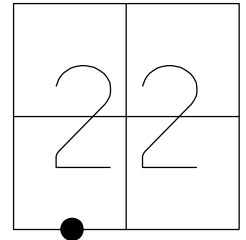

RECORD:
BRIDGE CONTROL
STA. 135+00
SET MAG/WASHER
8/2/04, MC
FND, 3/14/14
FD MAG NAIL
GPS, REFA9
4/8/14, DCH
SET MAG/W FROM TIES
7/29/14, EBW
GPS, NEWREFA9
7/29/14, JMR
FD MAG/WASH
REF9A
12/7/23, JAM
FD TONE, DID NOT UNCOVER
8/6/24, JAM

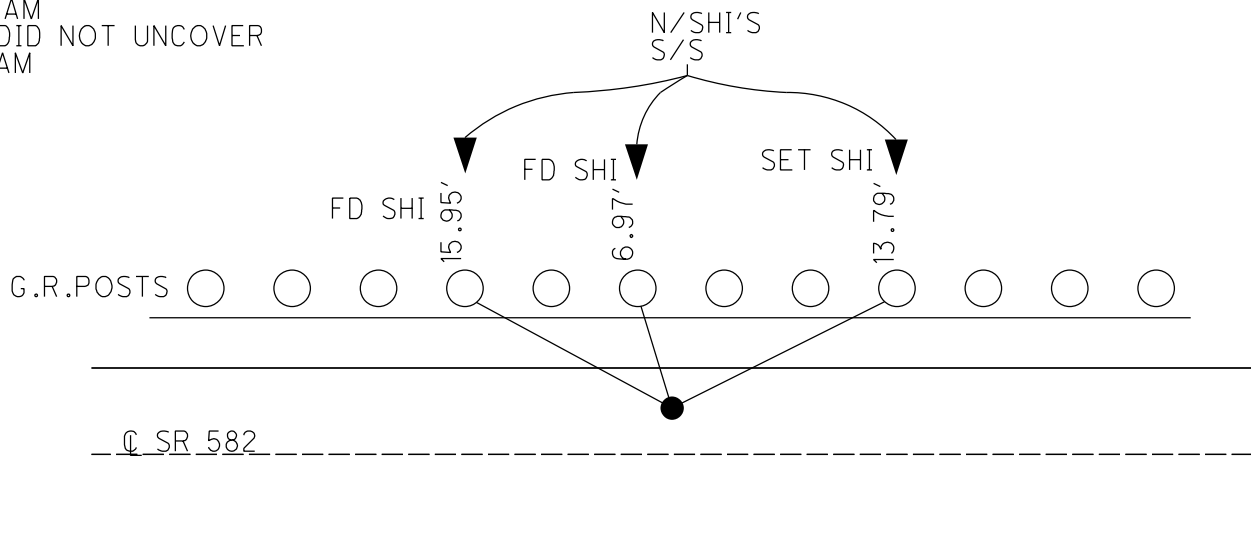

O.D.O.T. DISTRICT 2 SURVEY OFFICE (USE ONLY)

PERSONNEL

REFERENCE NO.

9A

SHEET 10 OF 25


NOTES RHOADES
H.C. HOMAN
R.C. ROUSOS
GABLE

DATE 4/8/14
WEATHER FAIR
TEMP. 53°

ROUTE SR 582
COUNTY WOOD
TOWNSHIP MIDDLETON
SECTION 22
T 6 N R 10 E

TYPE MONUMENT MAG NAIL
ON SURFACE - ~~BELOW~~ ON
LEFT - ~~Q~~ PAV'T - ~~RIGHT~~ 7.0'
1.7' TO LT EDGE PAVEMENT
S.L.M. 135+00

Grid: Northing: 655378.107 Easting: 1638364.582

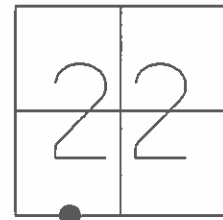

RECORD:
BRIDGE CONTROL
STA. 135+00


SET MAG/WASHER
8/2/04, MC

FND, 3/14/14

FD MAG NAIL
GPS, REFA9
4/8/14, DCH

SET MAG/W FROM TIES
7/29/14, EBW

GPS, NEWREFA9
7/29/14, JMR

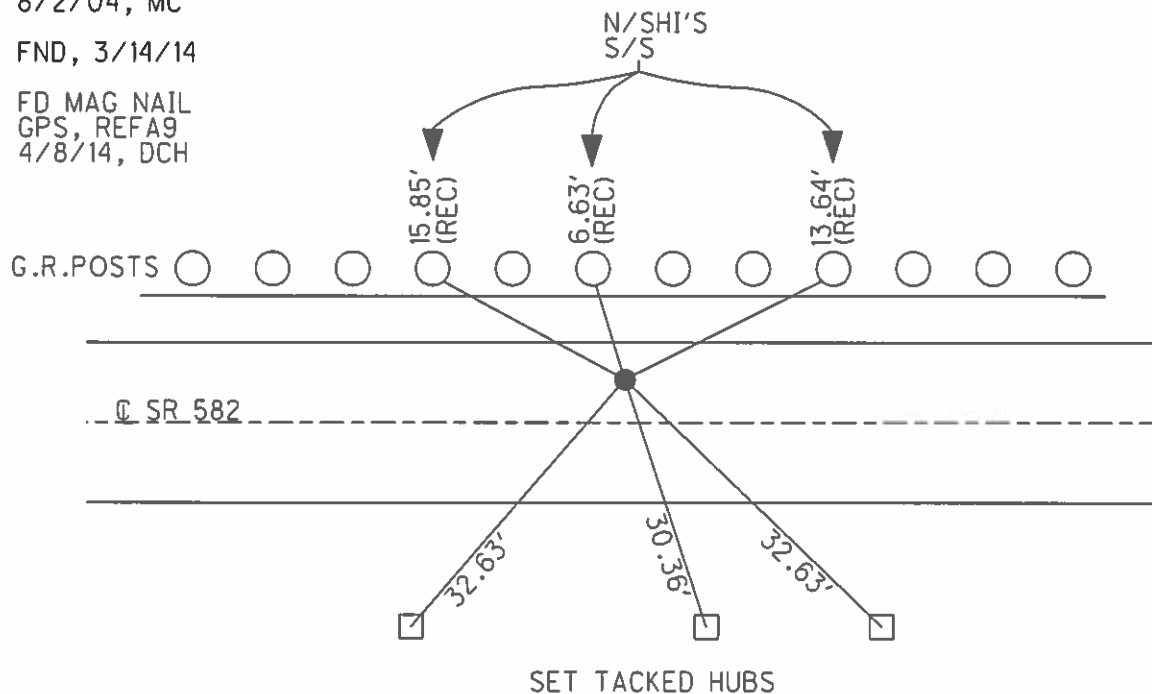

O.D.O.T. DISTRICT 2 SURVEY OFFICE

PERSONNEL

REFERENCE NO. 9A

SHEET 8 OF 23

NOTES M. Canterbury

H.C. R. Nuhfer

R.C. M. Canterbury

☒ S. Huss

DATE 4-22-04

WEATHER Clody / Windy

TEMP. +50°F

ROUTE S.R. 582

COUNTY Wood

TOWNSHIP MIDDLETON

SECTION 22

T 6 N R 10 E


TYPE MONUMENT N/shi

~~ON SURFACE~~ - BELOW 2" Down

LEFT - ~~PAINT MARK~~ RIGHT 7.0' Lt


1.7' TO Lt. EDGE PAVEMENT

S.L.M. 135+00

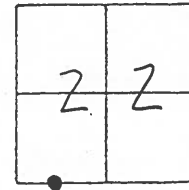

RECORD: BRIDGE CONTROL
STA 135+00

Set Mag/W
8-2-04
M.C.

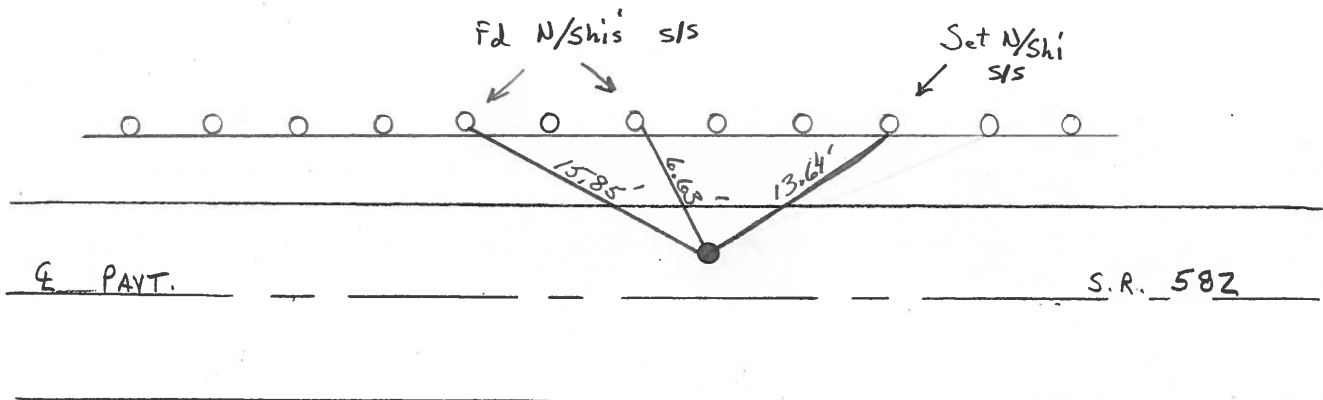

O.D.O.T. DISTRICT 2 SURVEY OFFICE

PERSONNEL

REFERENCE NO. 9A

SHEET ____ OF ____

NOTES BARNHISEL

H.C. HEFFMAN

R.C. LOEHLKE

GRAMZA

DATE 3-27-86

WEATHER CLOUDY

TEMP. +35°

ROUTE 582

COUNTY WOOD

TOWNSHIP MIDDLETON

SECTION 22

T 6 N R 10 E


TYPE MONUMENT (SHINER + NAIL)

ON SURFACE - ~~BELOW~~ yes

LEFT- & PAV'T. - ~~RIGHT~~

TO EDGE PAVEMENT

S.L.M. _____

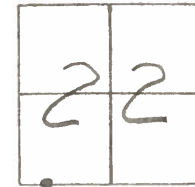

Bridge Control
Sta 135

Reset NAIL + SHI
5-1-86
MAR

