

O.D.O.T. DISTRICT 2 SURVEY OFFICE (USE ONLY)

PERSONNEL

REFERENCE NO. 16

SHEET 18 OF 25

NOTES MILLER
H.C. MILLER
R.C. BARRIERE
BLUBAUGH

DATE 8/6/24
WEATHER CLOUDY
TEMP. 75°

ROUTE SR 582
COUNTY WOOD
TOWNSHIP MIDDLETON
SECTION 24

DWG BY BARRIERE PID 114849

T 6 N R 10 E

TYPE MONUMENT MAG/WASHER

~~ON SURFACE~~ - BELOW 0.5" BELOW

OFFSET 6.0' ~~LT~~ : RT

3.8' TO RT EDGE PAVEMENT

STATION: 255+26.70, 15.5' W PF $\oslash$ PARGILLIS RD

HORZ.DATUM: NAD83 (2011)


GEOID: 18

GRID: NORTHING: 655026.899


EASTING: 1650422.306

LDP: NORTHING: 476842.179

EASTING: 161169.922

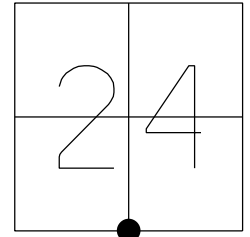

FD SM.R.R.SPIKE
4/26/04, MC
SET MAG/WASHER
7/30/04, MC
FND MAG/WASHER
GPS, REF16
3/14/14, DCH
SET MAG/WASHER
GPS, NEWREF16
7/29/14, EBW
FD MAG/WASH
REF16
12/8/23, JAM
8/6/24, JAM

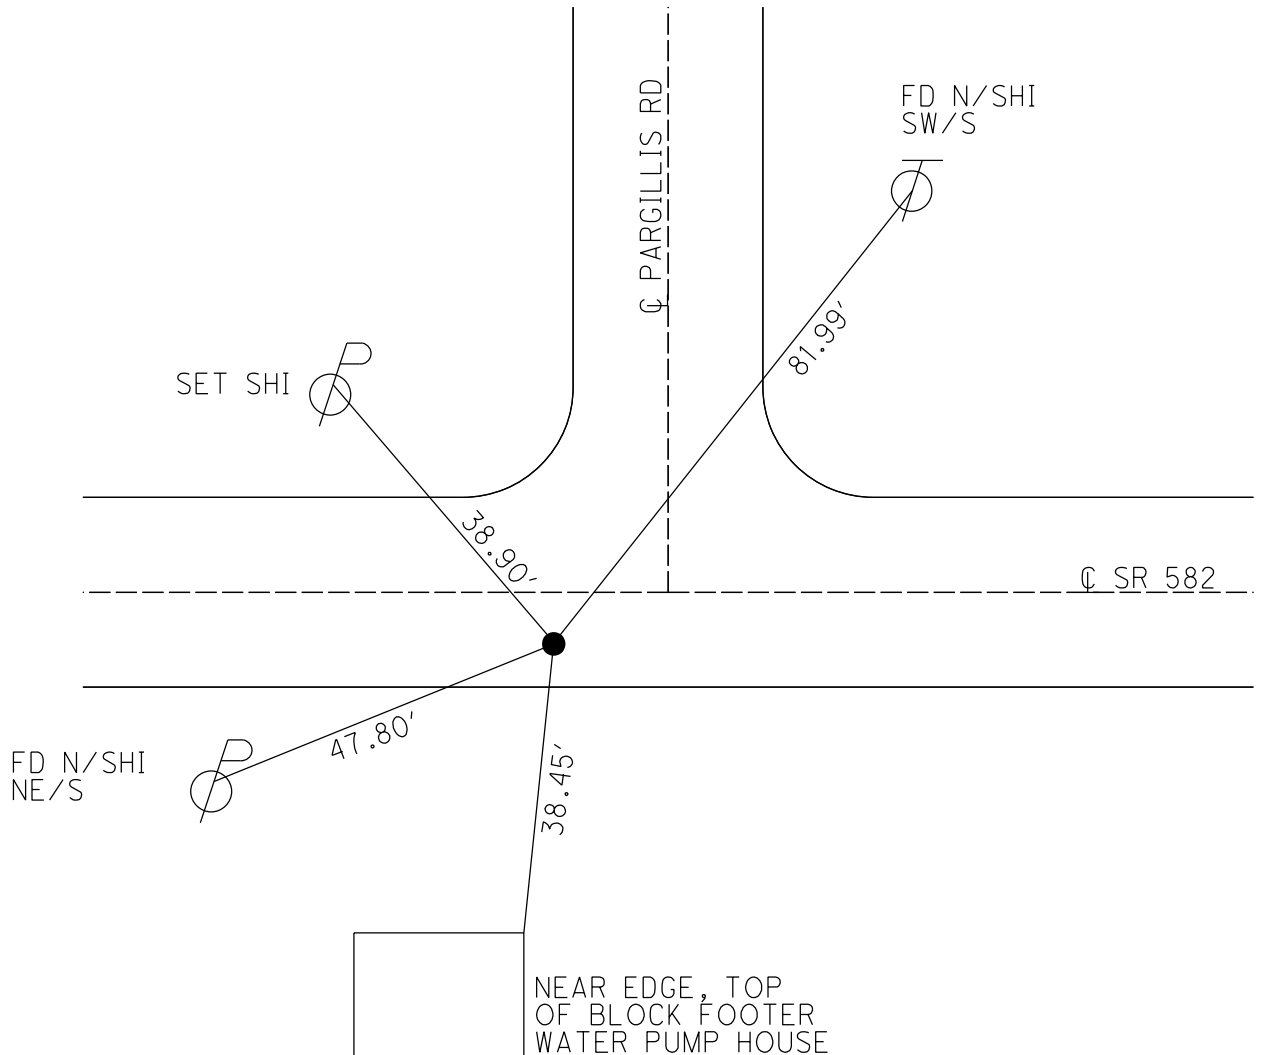

O.D.O.T. DISTRICT 2 SURVEY OFFICE (USE ONLY)

PERSONNEL

REFERENCE NO.

16

SHEET

18

OF 25

NOTES

RHOADES

DATE

4/9/14

ROUTE

SR 582

H.C.

ROUSOS

WEATHER

CLEAR

COUNTY

WOOD

R.C.

HOMAN

TEMP.

45°

TOWNSHIP

MIDDLETON

GABLE

SECTION

24

T_6 N R_10 E

TYPE MONUMENT MAG/WASHER


~~ON SURFACE~~ - BELOW 3"

~~LEFT~~ - C PAV'T - RIGHT 6.0'

3.8' TO RT EDGE PAVEMENT

S.L.M. 255+26.70, 15.5' W. OF & PARGILLIS RD

Grid: Northing: 655026.899 Easting: 1650422.306

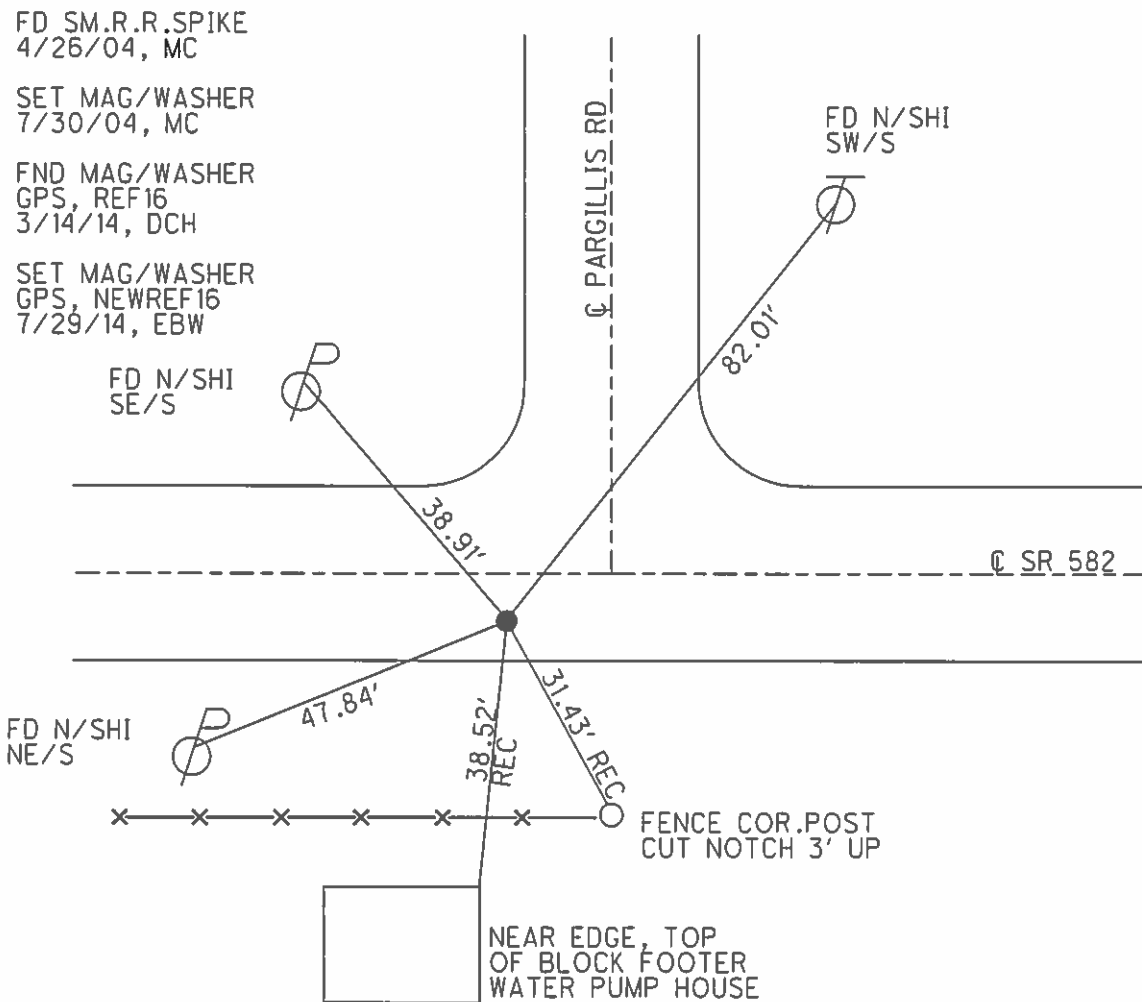Easting: 1650422.306

O.D.O.T. DISTRICT 2 SURVEY OFFICE

PERSONNEL

REFERENCE NO. 16

SHEET 15 OF 23

NOTES M.C.

H.C. M.B.

R.C. M.C.

DATE 4-26-04

WEATHER Pt. Cloudy

TEMP. +55°

ROUTE S.R. 582

COUNTY Wood

TOWNSHIP MIDDLETON

SECTION 24

T 6 N R 10 E

drawn (Joe Kotehmainen)


TYPE MONUMENT Sm. RR Spk

~~ON SURFACE~~ BELOW 3" down


~~LEFT~~ PAV'T. RIGHT 6.0 Rt

3.8' TO Rt. EDGE PAVEMENT

S.L.M. 255 + 26.70 15.5' W. of E Pargillis Rd.

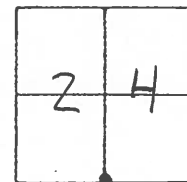

Reset Mag/Washer
7/29/04 M.R.C.

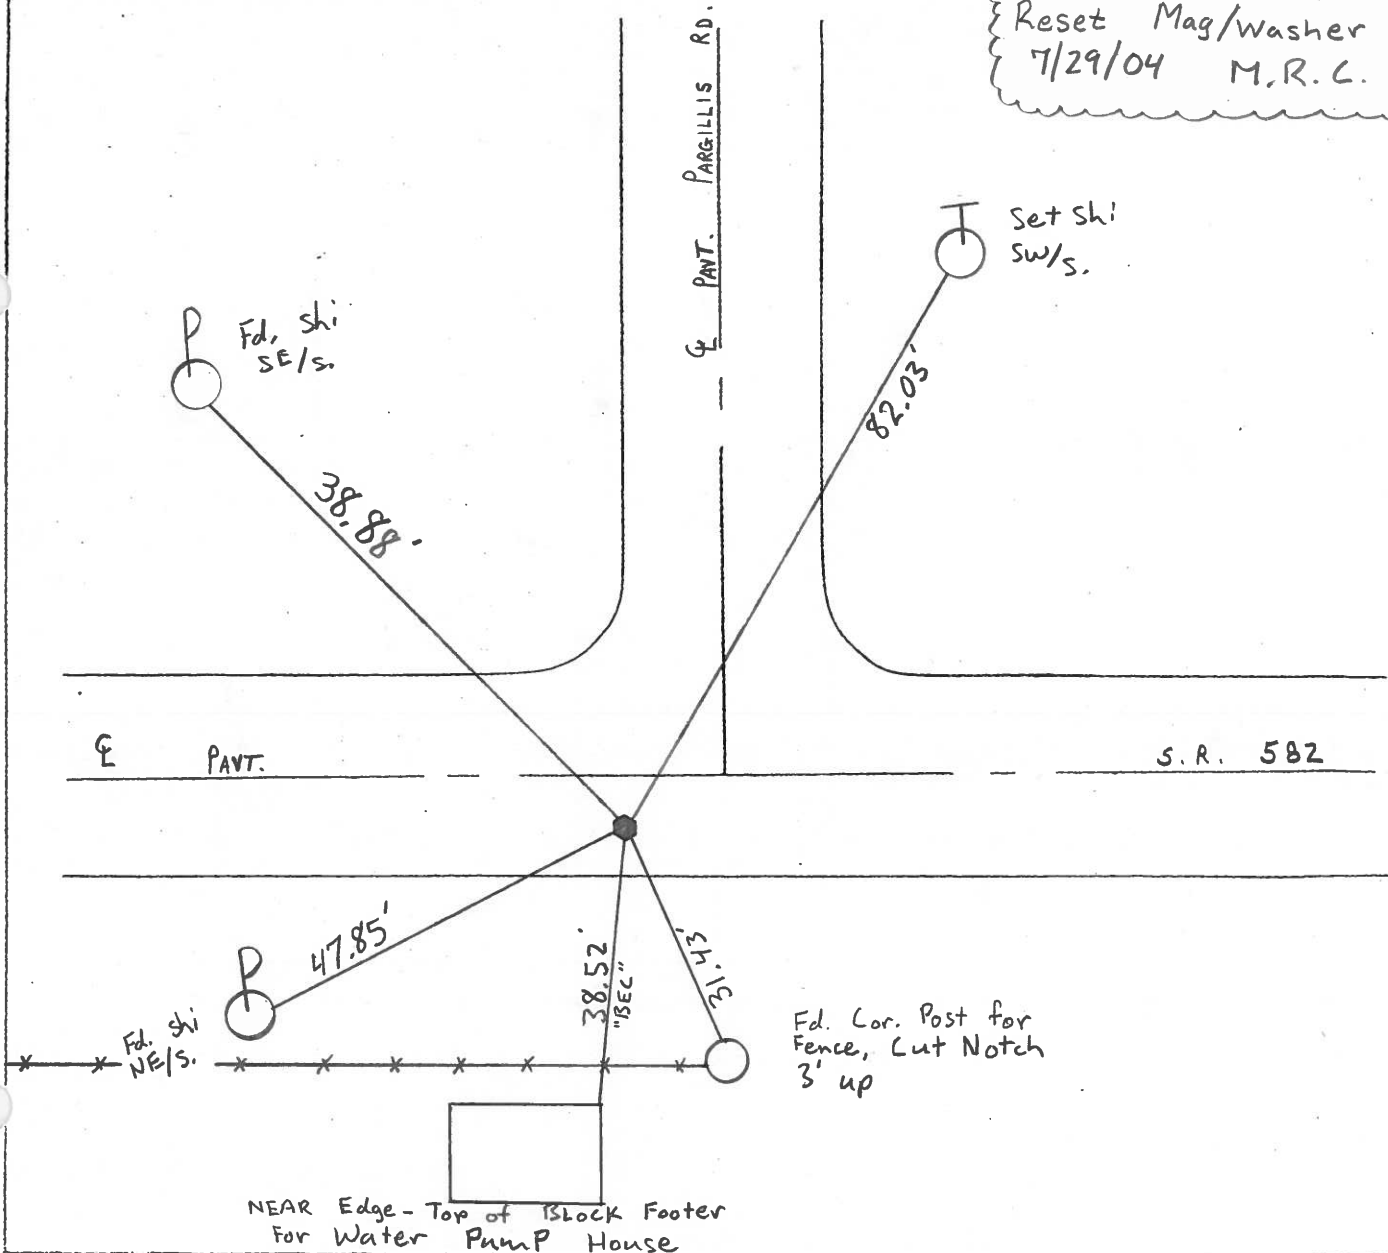

O.D.O.T. DISTRICT 2 SURVEY OFFICE

PERSONNEL

REFERENCE NO. 16

SHEET OF

NOTES BAENHISEL

H.C. HOFFMAN

R.C. Loehke

DATE 9-6-89

WEATHER Pt. Cloudy

TEMP. +72°

ROUTE S.R. 582

COUNTY Wood

TOWNSHIP Middleton

SECTION 24

T. 6 N. R. 10 E.

TYPE MONUMENT Sm RR Spk


ON SURFACE - BELOW yes

LEFT - ℄ PAV'T. - RIGHT 4.7


4.7 TO RT EDGE PAVEMENT

S.L.M. 255 + 26.70

14' W. OF ℄ PARGILLIS Rd

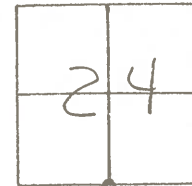

Set P.K. & Washer
11-8-89
MB

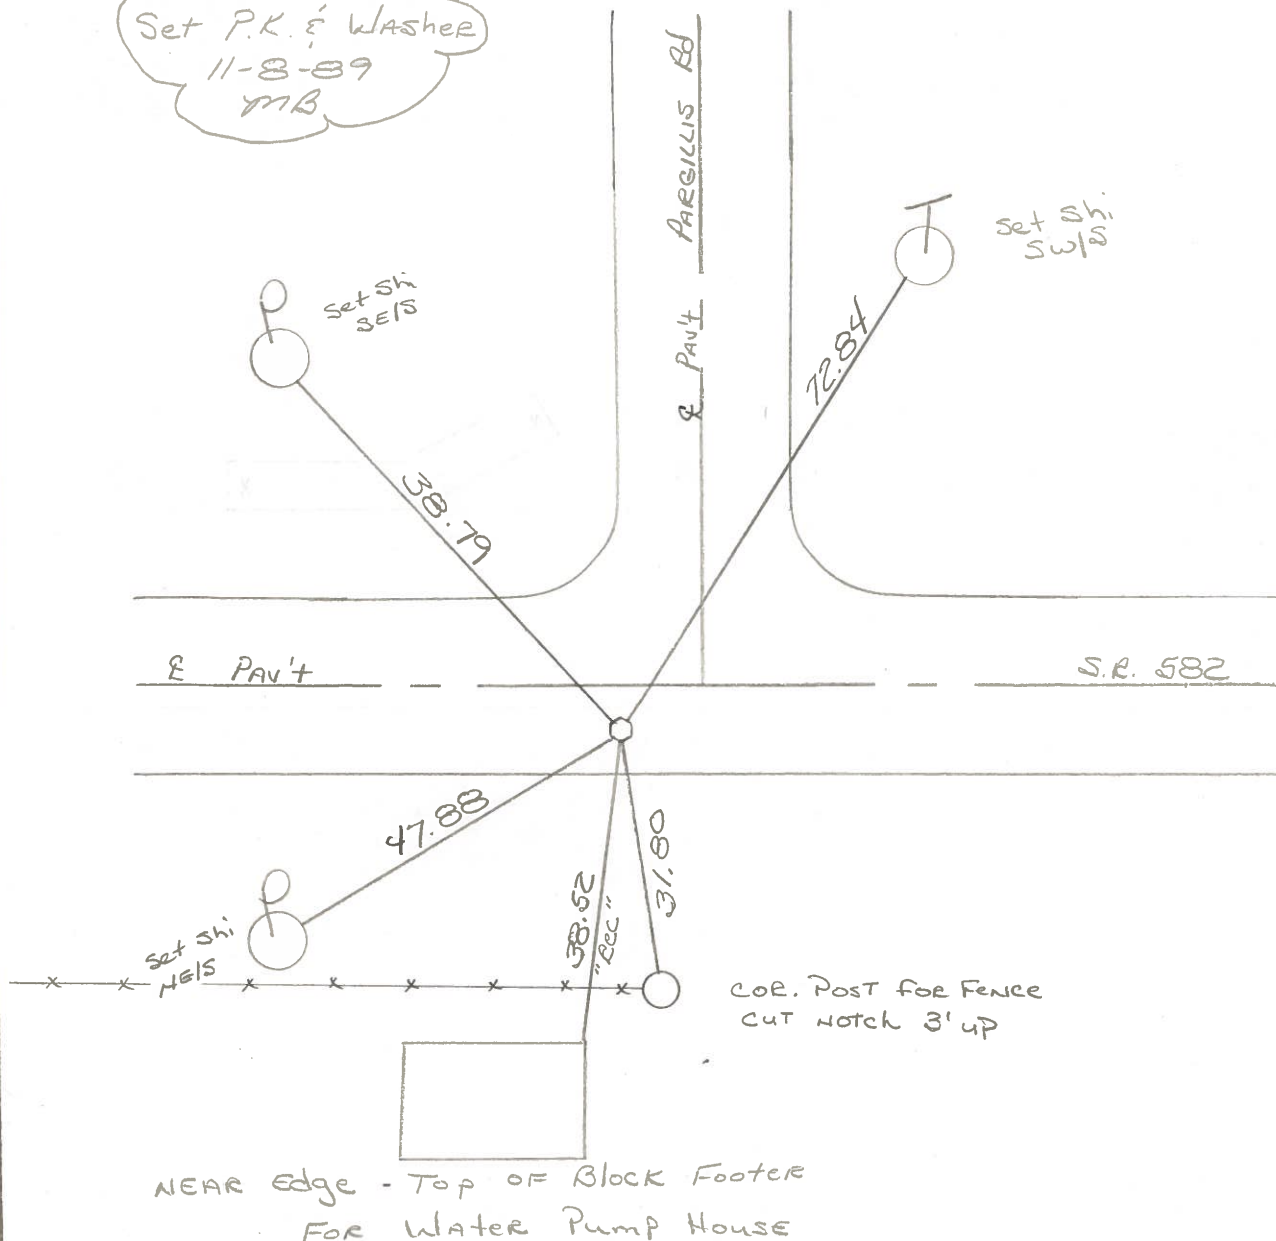

O.D.O.T. DISTRICT 2 SURVEY OFFICE

SHEET

OF

County Wood S.R. 582

Township Middleton

Section 24

T6N, R10E

Personnel S. Hoffman


C. Loshke

J. Householder

Date 5-20-81

Weather Clear

Temp. 70°

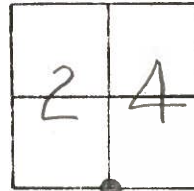

#16


Fd. Small R.R. Spk 1" Below Surface

SET SMALL R.R. SPK. 8-24-81

4.8 So. of C

5.7 TO S. E.P.

15.6 TO N. E.P.

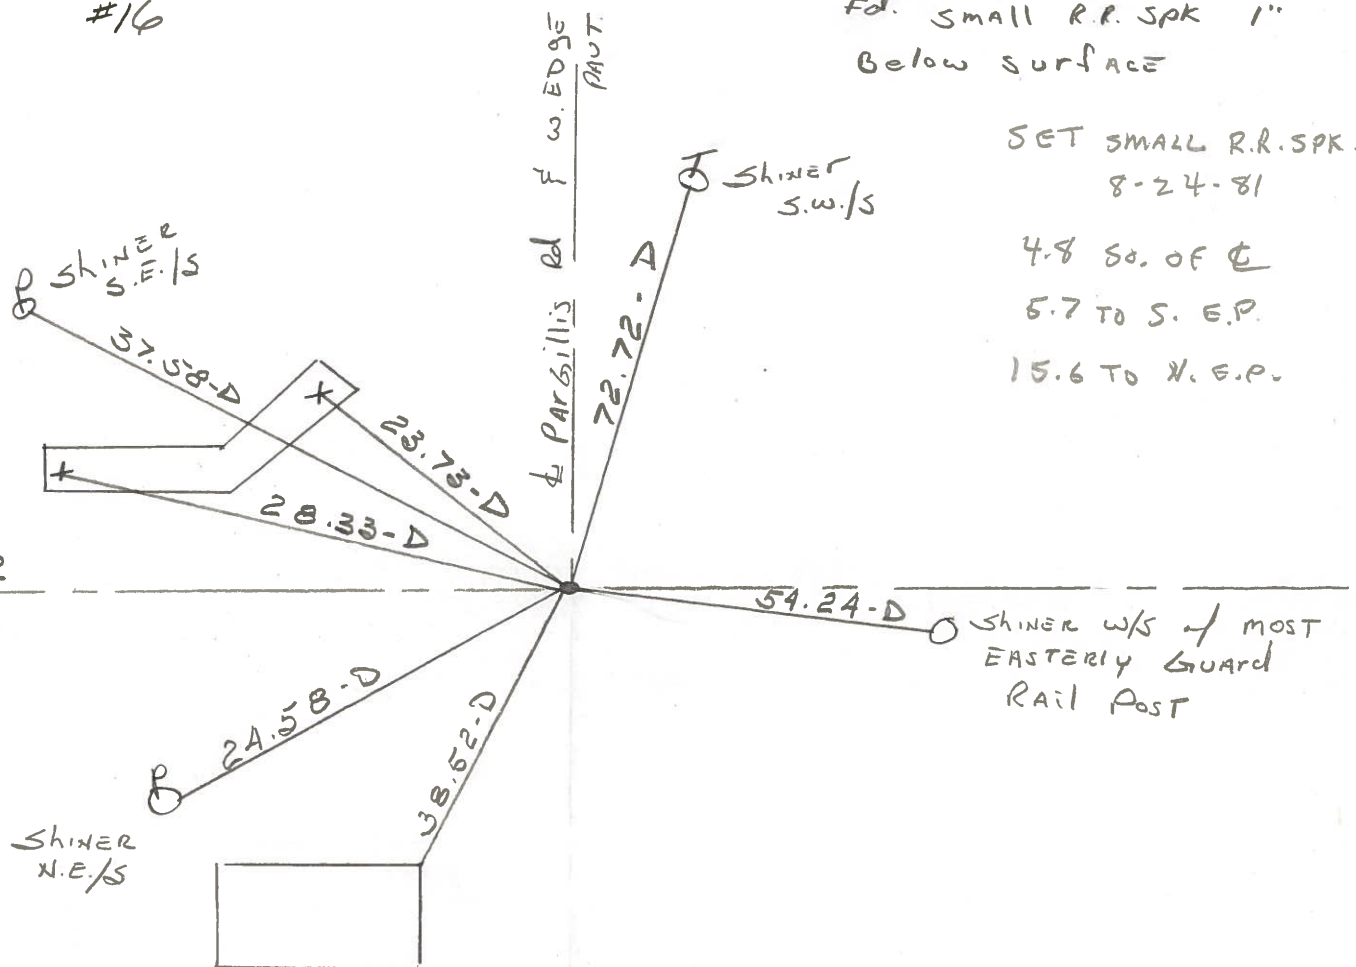

NEAR Edge-TOP of CONC BLOCK FOOTER FOR WATER PUMP HOUSE

ODOT. DISTRICT 2 SURVEY OFFICE

SHEET

OF

County Wood S.R. 582

Township Middleton

Section 24

T6N, R10E

Personnel J. Hoffmann


C. Loehrke

Householder

Date 5-20-81 8-24-81

Weather Clear

Temp. 70° 60°

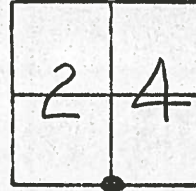

#16


Fd. Small R.P. Spk 1" Below surface

Set Small R.P. Spk

4.85. of E

5.7 TO S.E.P

15.6 TO N.E.P

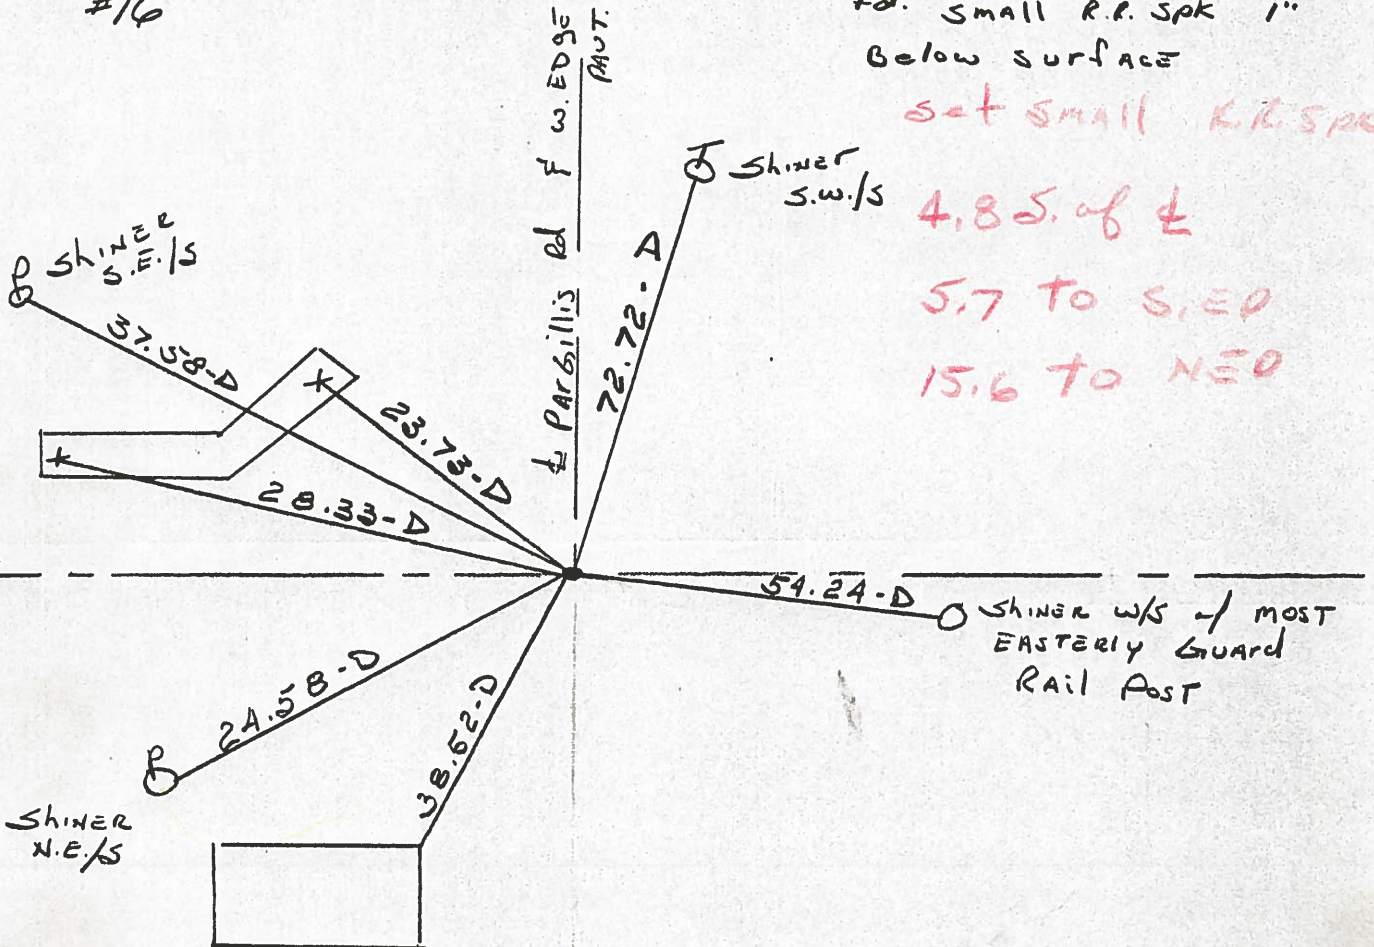

NEAR Edge-TOP of CONC BLOCK FOOTER FOR WATER PUMP HOWE


PERSONNEL	TITLE	PERSONNEL	TITLE
BURNSIDE			
SMITH			
BOWERS			
HOLCOMBE			

COUNTY WOOD DATE 5-28-71

S. R. 582 WEATHER CLEAR


SEC. _____ TEMP. +65°

DESCRIPTION _____ LEFT _____ CENTER LINE _____ RIGHT _____ JOB NO. _____

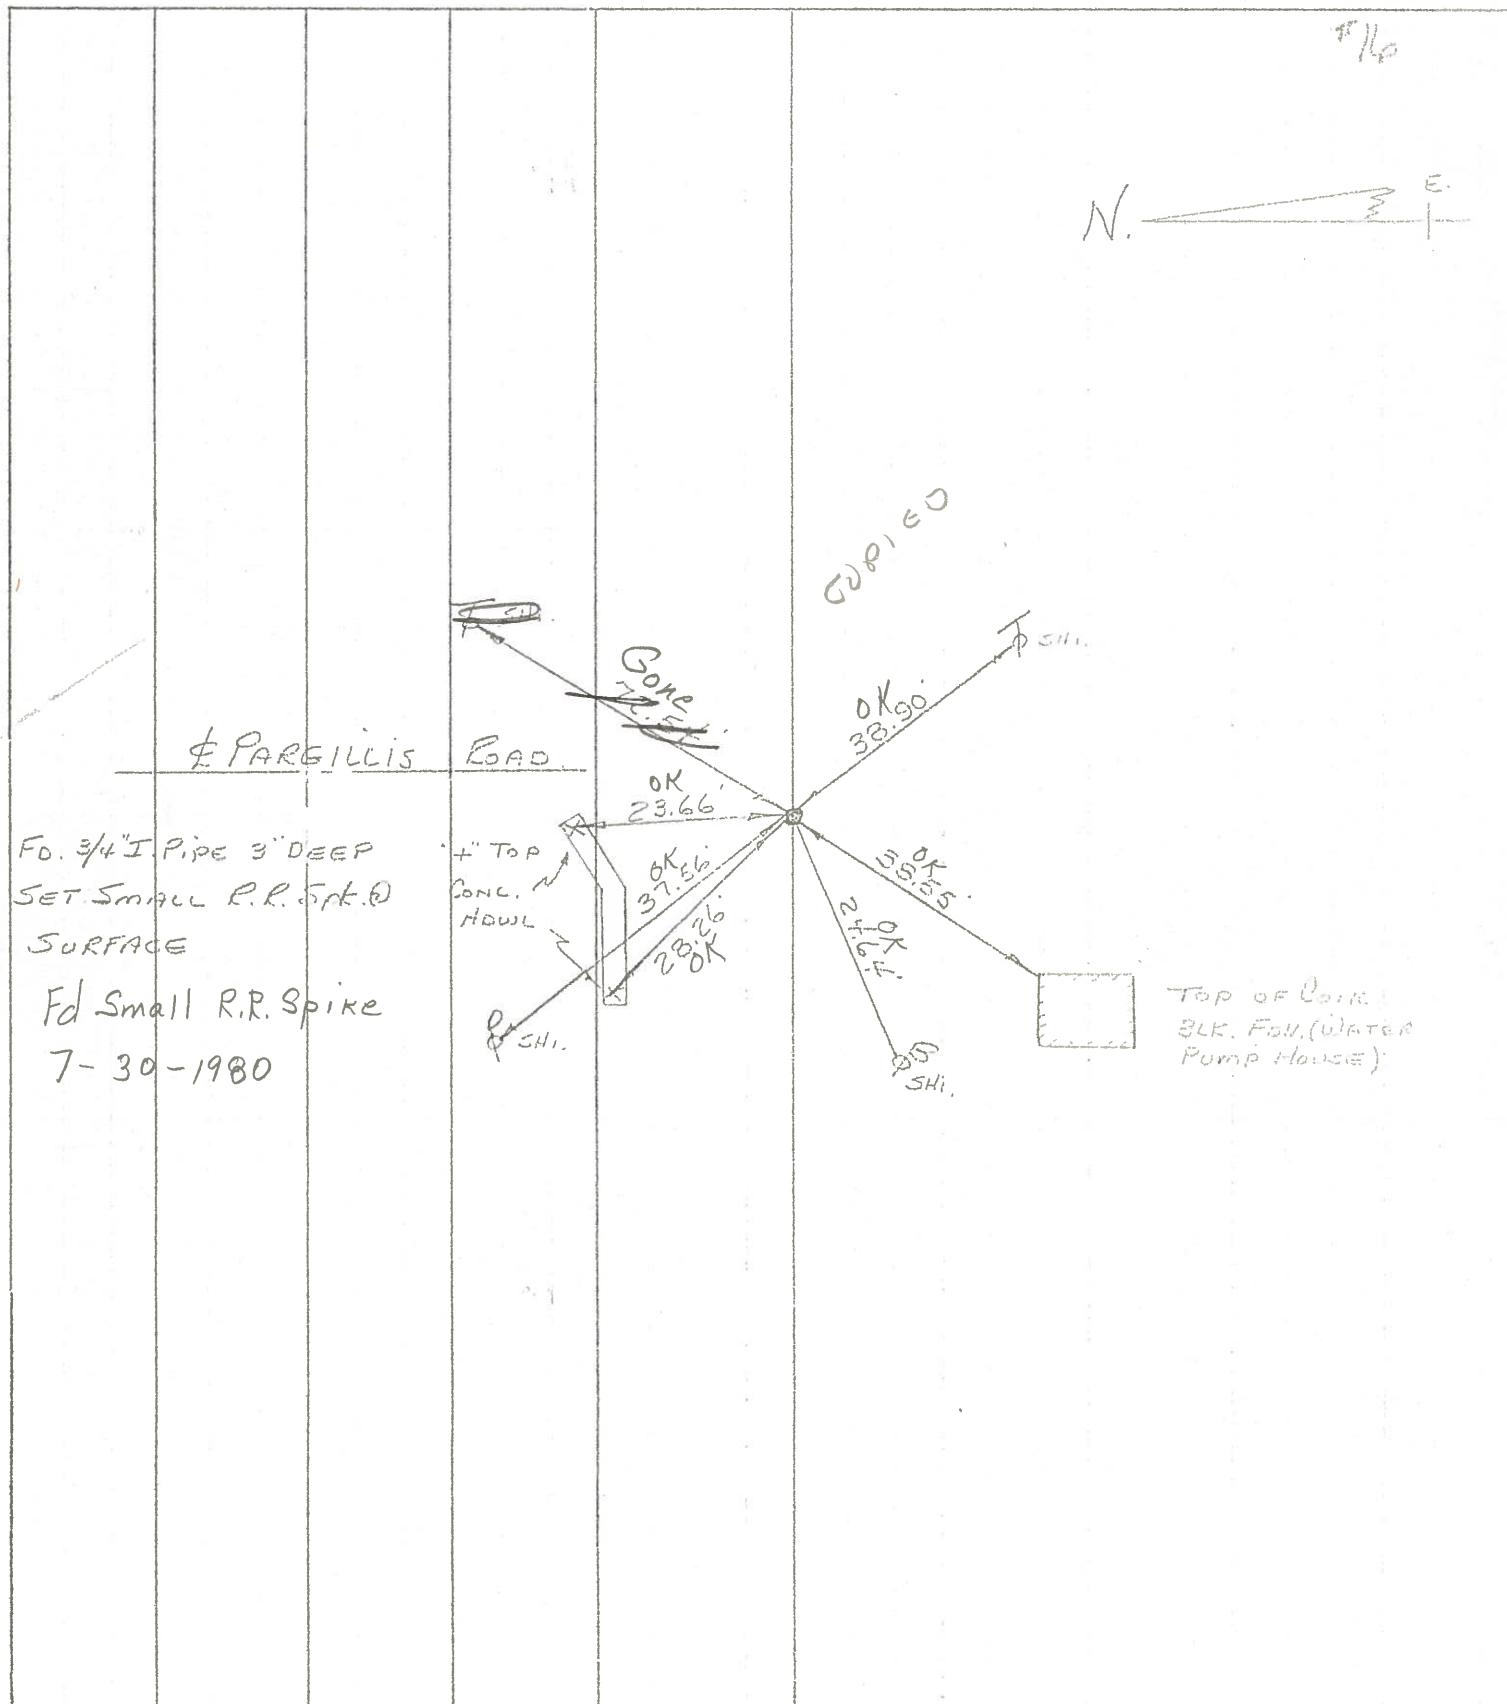

PERSONNEL	TITLE	PERSONNEL	TITLE	COUNTY	DATE	WEATHER	TEMP.
BURNSIDE				Wood	5-28-71	CLEAR	+65°
SMITH				S. R. 582			
BOWERS				SEC.			
HOLCOMBE							

DESCRIPTION	LEFT	CENTER LINE	RIGHT	JOB NO.
-------------	------	-------------	-------	---------

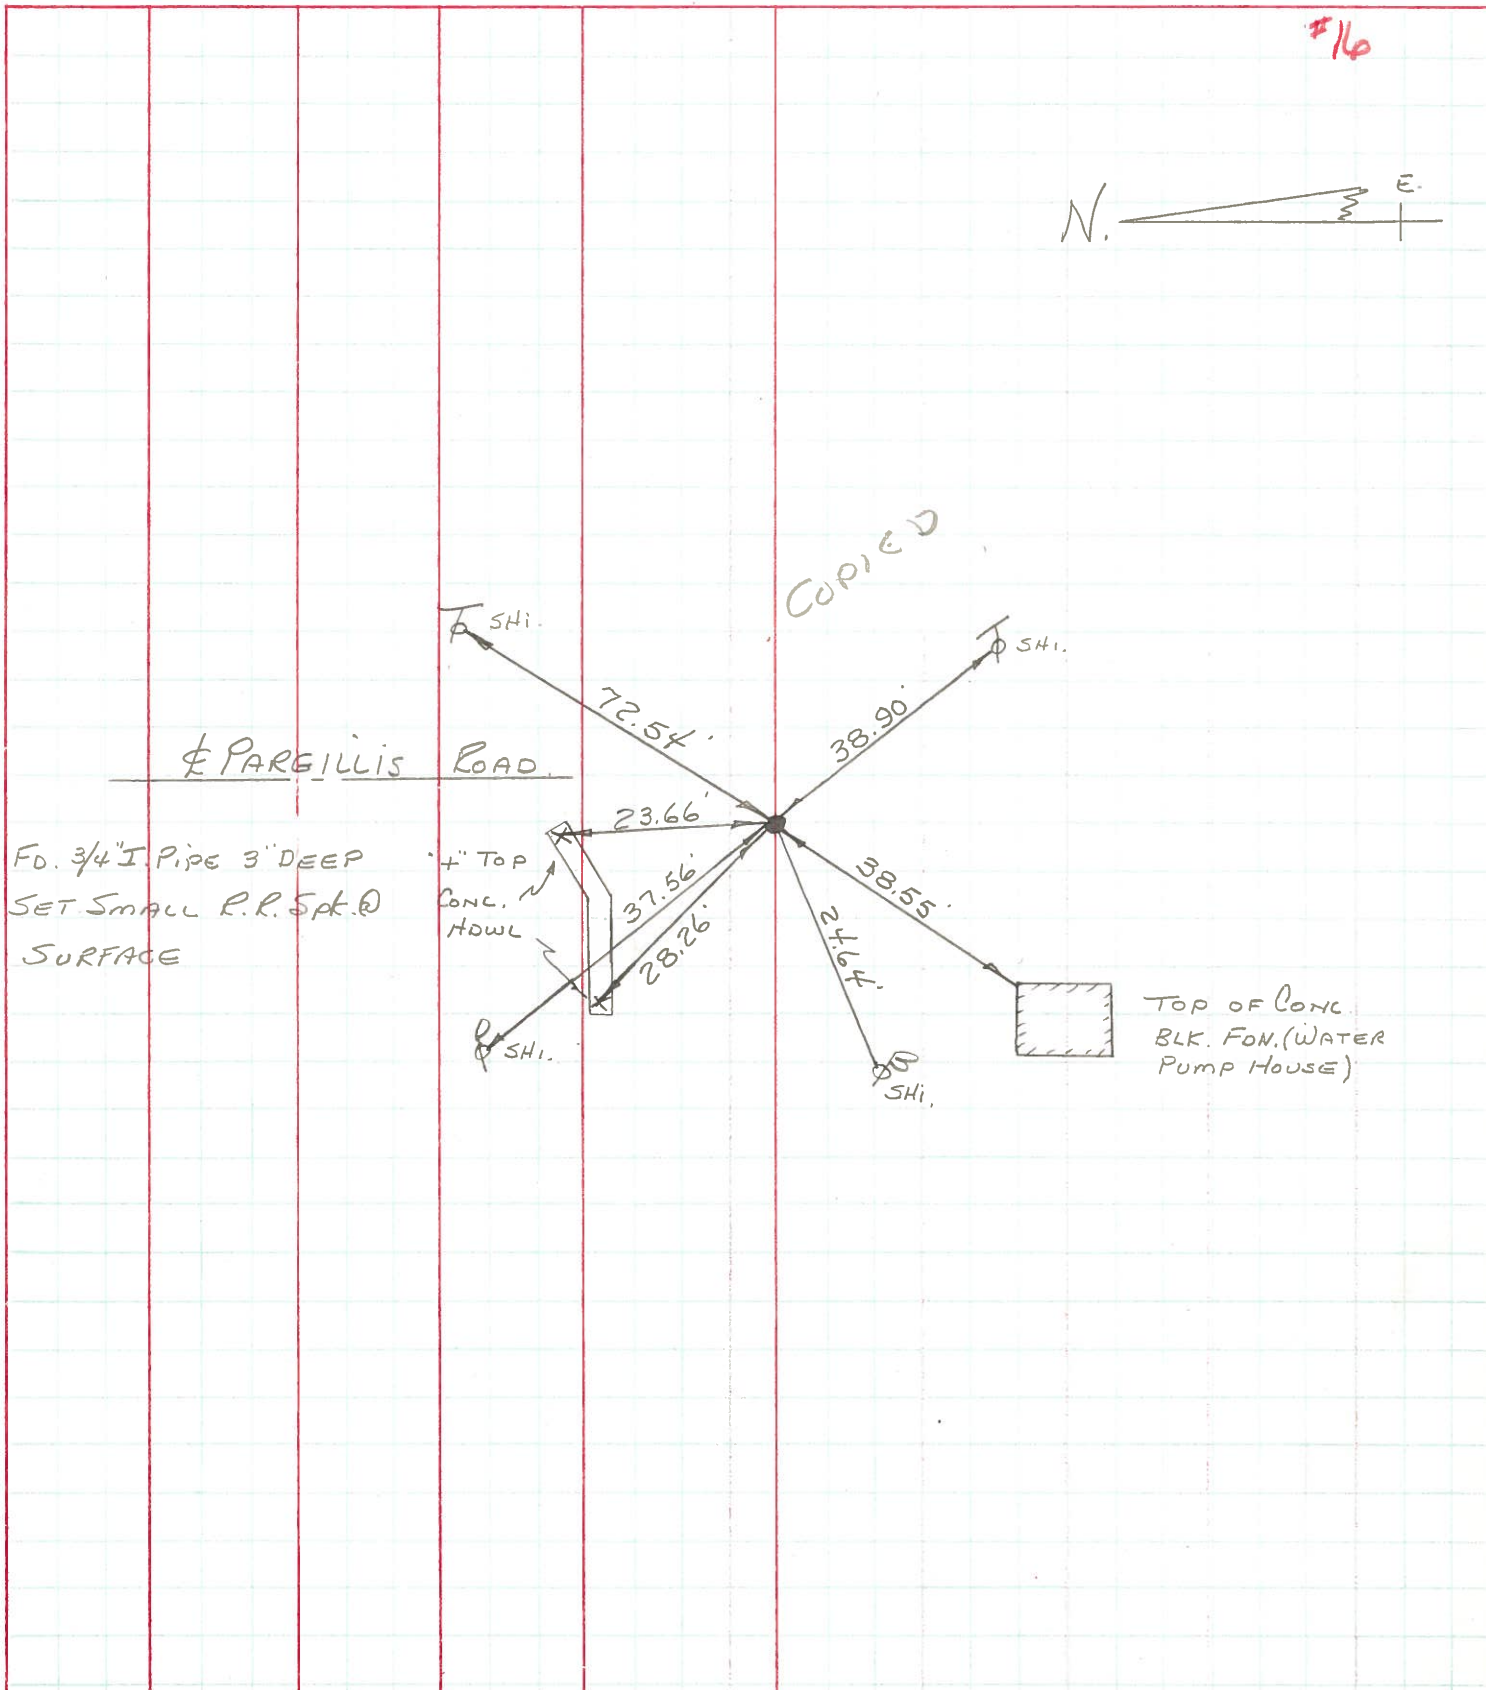

PERSONNEL TITLE PERSONNEL TITLE

SchneiderCOUNTY Wood

DATE

BarbourS. R. 582


WEATHER

ReddingSEC. 0.00-

TEMP.

PottsDESCRIPTION Ties for Control Point

JOB NO.

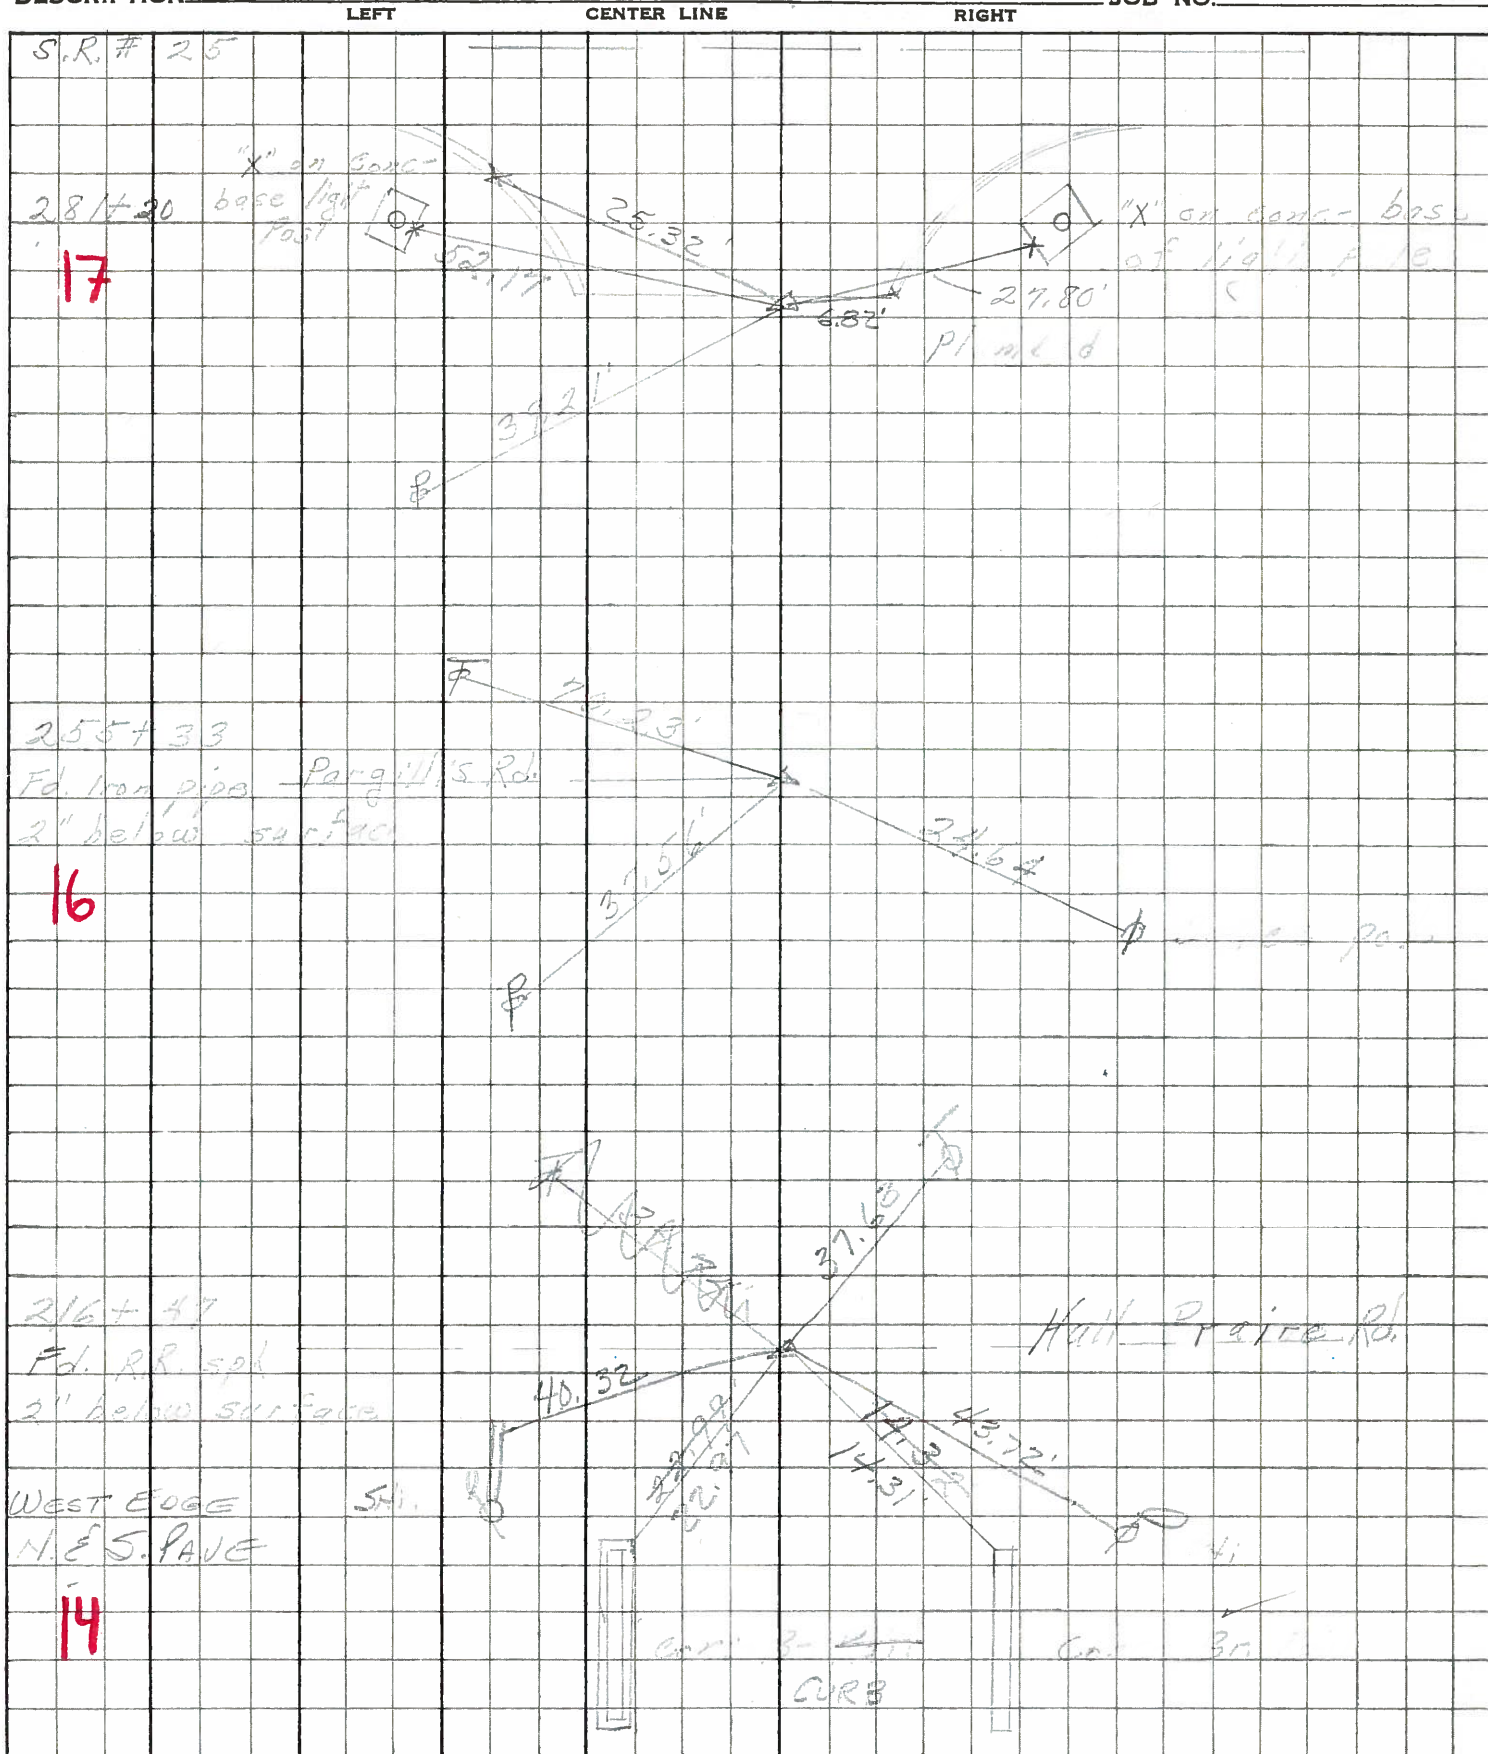

PERSONNEL TITLE PERSONNEL TITLE

COUNTY

Wood

DATE 12-27-57

Swanton 4-4-60

S. R.

#582

WEATHER

SEC.

TEMP.

DESCRIPTION

LEFT

CENTER LINE

RIGHT


JOB NO.

N. 1/4 of sec. 26
Middleton twp.
Iron pipe


15" twin
Ash

13

#442

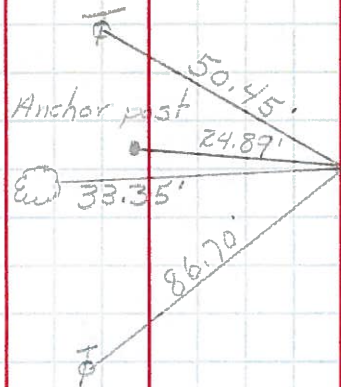

O.K.

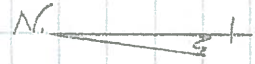

Hull Prairie Rd.
Stone - Iron pin - on line
with W. edge of pavt.
to S. & with S. edge of
pavt. to E.

14

#442-A

stonewit.	Angle abut.	N.W.	16.50
	Angle abut.	S.W.	15.20'
	Inside cor. conc. railing	S.W.	14.30
Pin wit.	S.E. cor. brick curb	N.W.	23.0'
	Shiner in T.P.	N.E.	34.70'

O.K.

Pargill's Rd.
Ed. iron pipe

16

#444

O.K.

Shiner in power brace pole S.W. 24.45
Shiner in T.P. 28.35' S.E. 28.46'
S.W. cor. N. culvert N.W. 28.26
E. cor. of wing wall N.E. 23.50
Shiner in Brace Pole S.W. 24.75
Shiner in Tele. Pole N.E. 70.20'