

O.D.O.T. DISTRICT 2 SURVEY OFFICE (USE ONLY)

PERSONNEL

REFERENCE NO. 17

SHEET 19 OF 25

NOTES MILLER
H.C. MILLER
R.C. BARRIERE
BLUBAUGH

DATE 8/6/24
WEATHER CLOUDY
TEMP. 75°

ROUTE SR 582
COUNTY WOOD
TOWNSHIP MIDDLETON
SECTION 24

DWG BY BARRIERE PID 114849

T 6 N R 10 E

TYPE MONUMENT MONBOX

ON SURFACE - ~~BELOW~~ ON

OFFSET Q PAVEMENT 3.1' ~~LT~~ : RT

7.5' TO RT EDGE PAVEMENT

STATION: 281+15.59

HORIZ.DATUM: NAD83 (2011)



GEOID: 18

GRID: NORTHING: 655237.678

EASTING: 1642379.623

LDP: NORTHING: 476786.593

EASTING: 163758.186

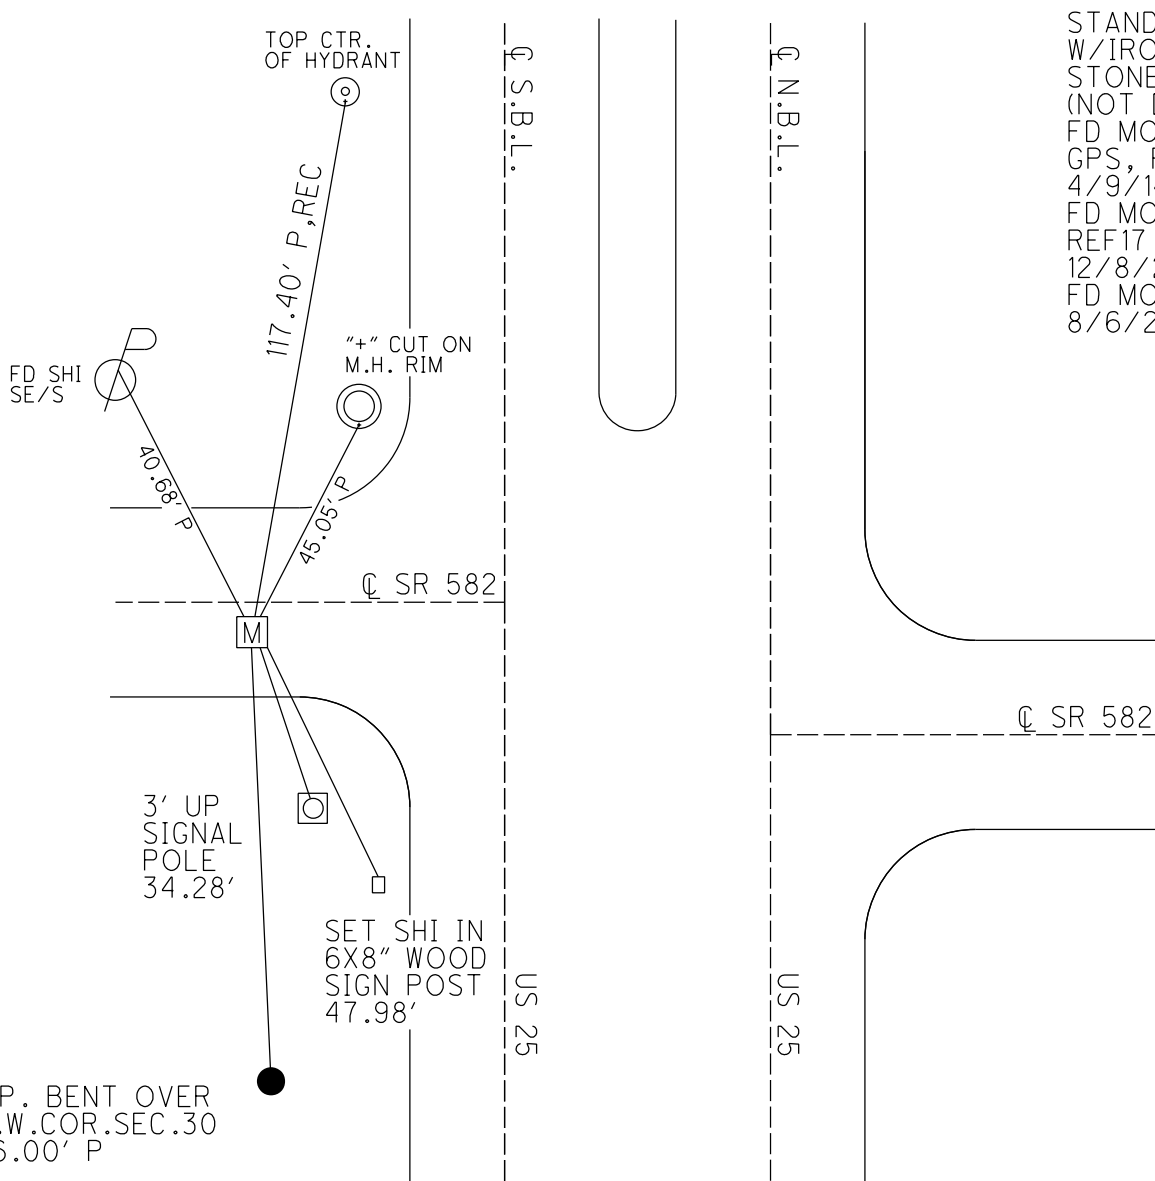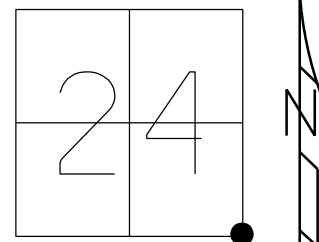



STANDARD MON.BOX
W/IRON PIN SET,
STONE AT 13" BELOW
(NOT DISTURBED)
FD MON.BOX
GPS, REF17
4/9/14, EBW
FD MONBOX
REF17
12/8/23, JAM
FD MONBOX UNDISTURBED
8/6/24, JAM

O.D.O.T. DISTRICT 2 SURVEY OFFICE (USE ONLY)

PERSONNEL	REFERENCE NO. <u>17</u>	SHEET <u>19</u> OF <u>25</u>
NOTES	DATE <u>4/9/14</u>	ROUTE <u>SR 582</u>
H.C. <u>RHOADES</u>	WEATHER <u>CLEAR</u>	COUNTY <u>WOOD</u>
R.C. <u>ROUSOS</u>	TEMP. <u>45°</u>	TOWNSHIP <u>MIDDLETON</u>
<u>HOMAN</u>		SECTION <u>24</u>
<u>GABLE</u>		T <u>6</u> N R <u>10</u> E

TYPE MONUMENT MON.BOX
 ON SURFACE - ~~BELOW~~ ON
~~LEFT~~ - Q PAV'T - RIGHT 3.1'
7.5' TO RT EDGE PAVEMENT
 S.L.M. 281+15.59

Grid: Northing: 655237.678 Easting: 1642379.623

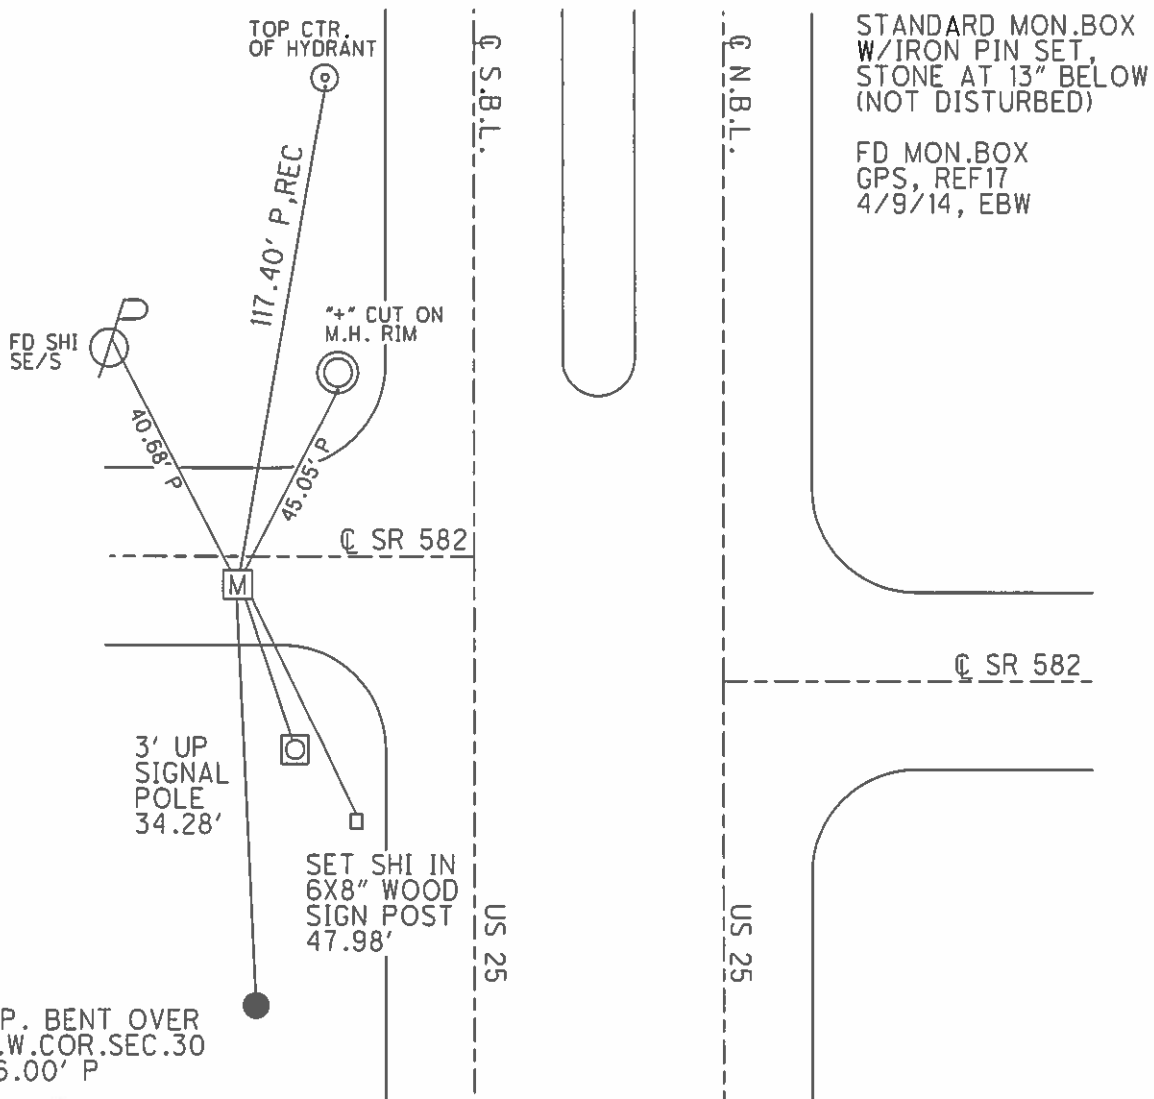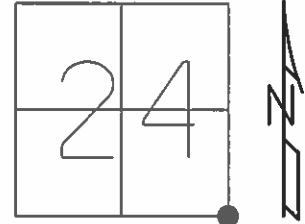

DATE 8-2-04


WEATHER clear

TEMP +80°

JOB NO.

RIGHT

17

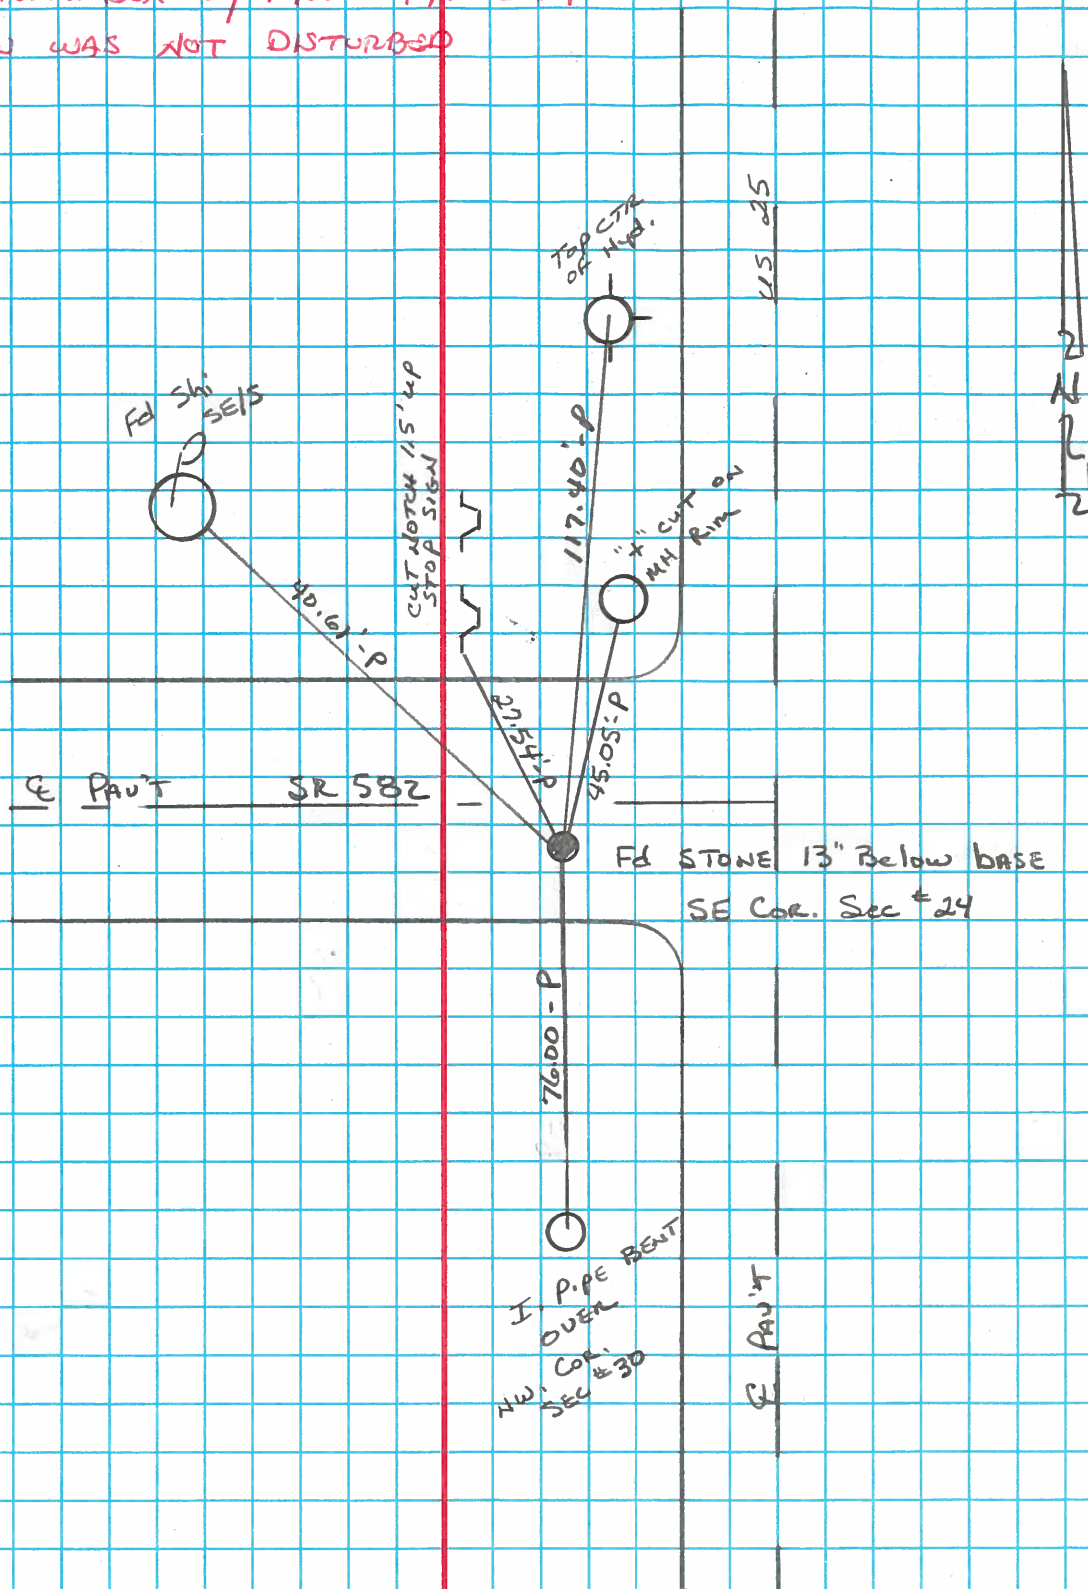

O.D.O.T. DISTRICT 2 SURVEY OFFICE

PERSONNEL

REFERENCE NO. 17

SHEET 16 OF 23

NOTES Barnhiser

H.C. Hoffman

R.C. Loehrke

DATE 7/29/04

WEATHER cloudy

TEMP. +72°

ROUTE S.R. 582

COUNTY Wood

TOWNSHIP MIDDLETON

SECTION 24

T 6 N R 10 E

Drawn (See Kolchmanen)


TYPE MONUMENT Fd Stone

~~ON SURFACE~~ BELOW 13" Below Base


~~LEFT~~ PAV'T. - RIGHT 3.1'

7.5 TO Rt EDGE PAVEMENT

S.L.M. 281 + 15.59

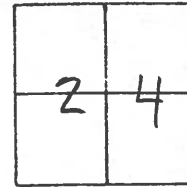

*Mon. Box was set
After const.*

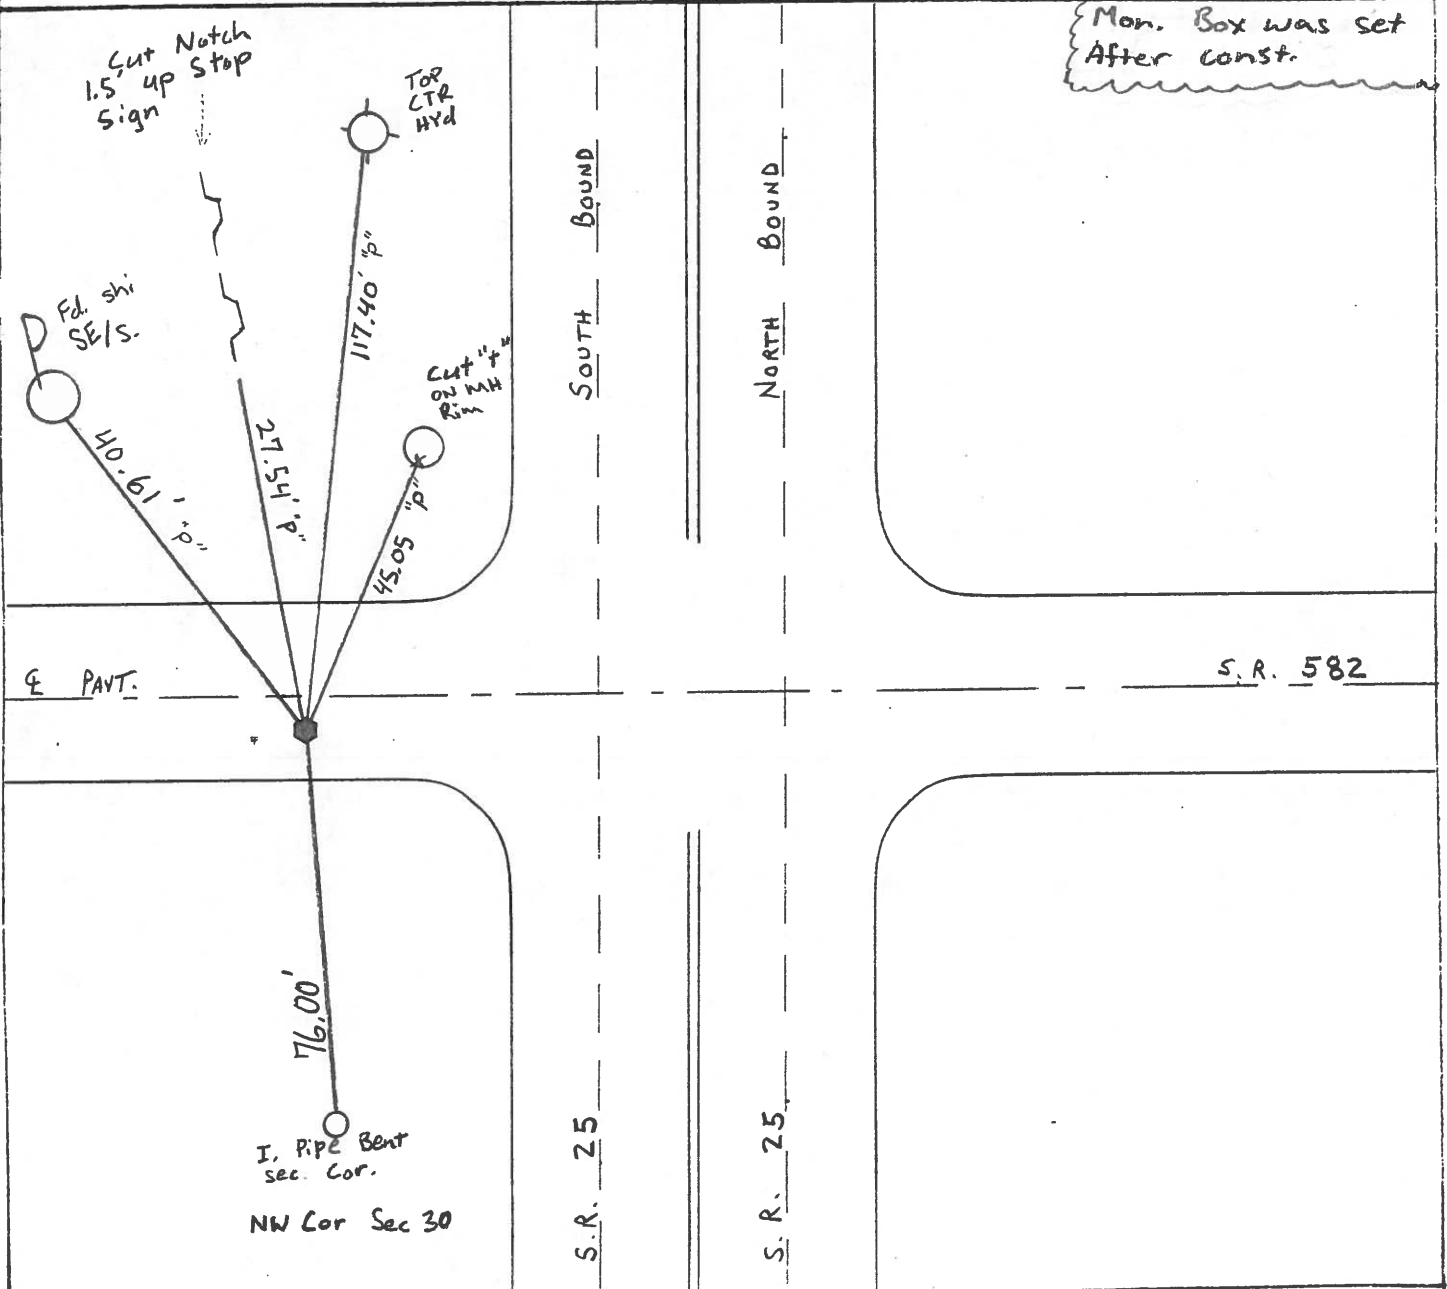

Middleton twp.

O.D.O.T. DISTRICT 2 SURVEY OFFICE

PERSONNEL

REFERENCE NO. 17

SHEET OF

NOTES BARNHISEL

H.C. HOFFMAN

R.C. Loehrke

DATE 9-6-89

WEATHER cloudy

TEMP. +72°

ROUTE S.R. 582

COUNTY Wood

TOWNSHIP Middleton

SECTION 24

T 6 N R 10 E


TYPE MONUMENT Sm RR Spk

ON SURFACE - BELOW yes


LEFT - & PAV'T. - RIGHT 3.1

7.5 TO RT EDGE PAVEMENT

S.L.M. 281 + 15x59

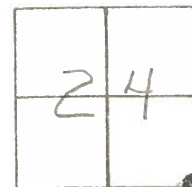

Set P.K. & k-laskee
11-8-89
MB

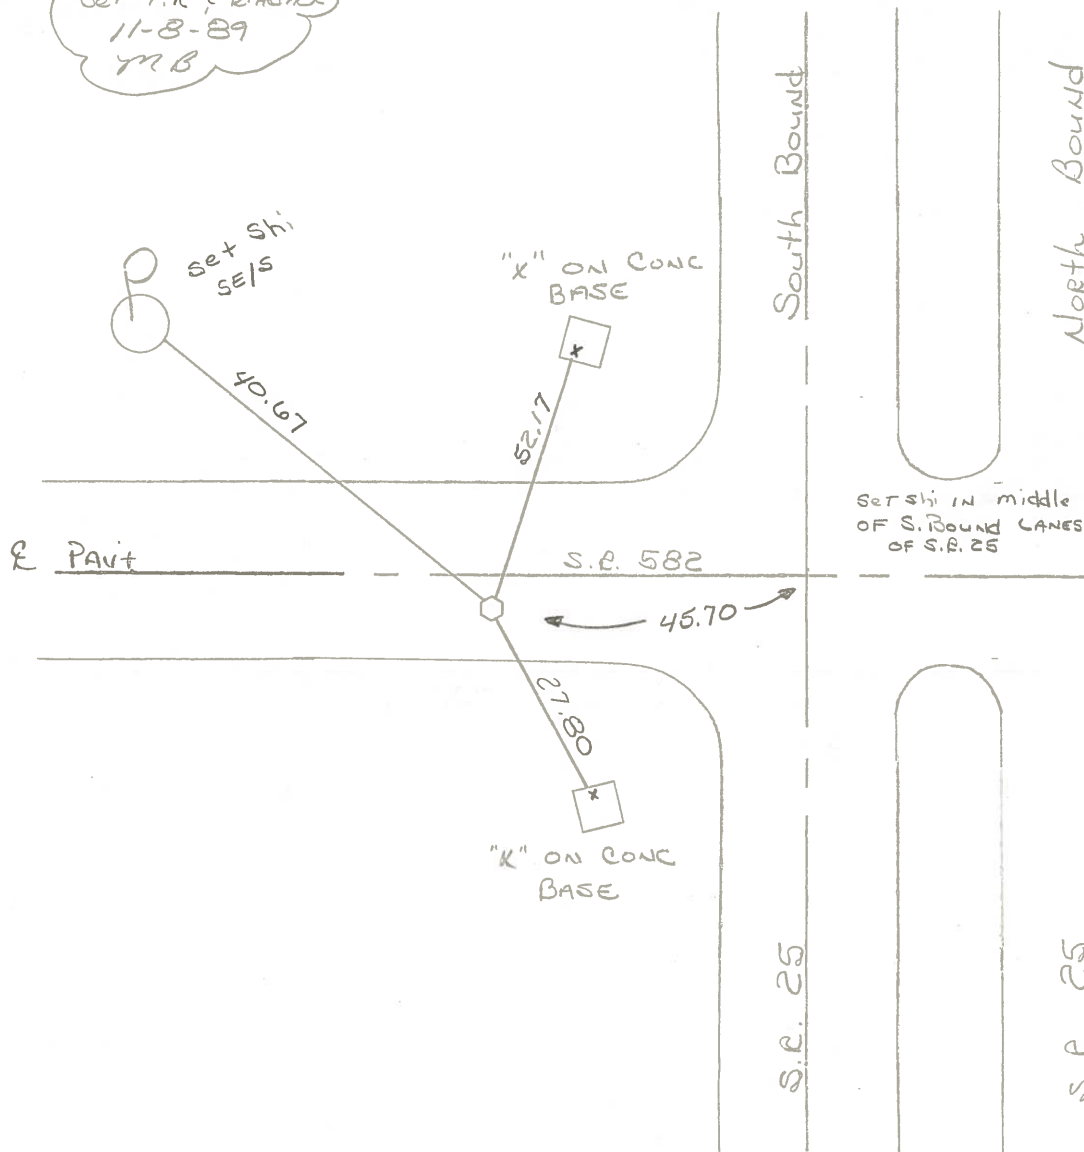

Q.D.O.T. DISTRICT 2 SURVEY OFFICE

Sht. ____ of ____

County WOOD S.R. 582

Township MIDDLETON

Section 24

T&N, RIDE

Personnel BURNSIDE

#17

SMITH


BOWERS

HOLCOMBE

Date OK-5-20-81
5-28-71


Weather CLEAR

Temp. 65°

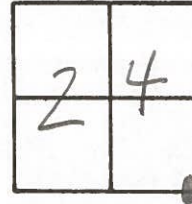

#17

OK-5-20-81
S-HOFFMAN

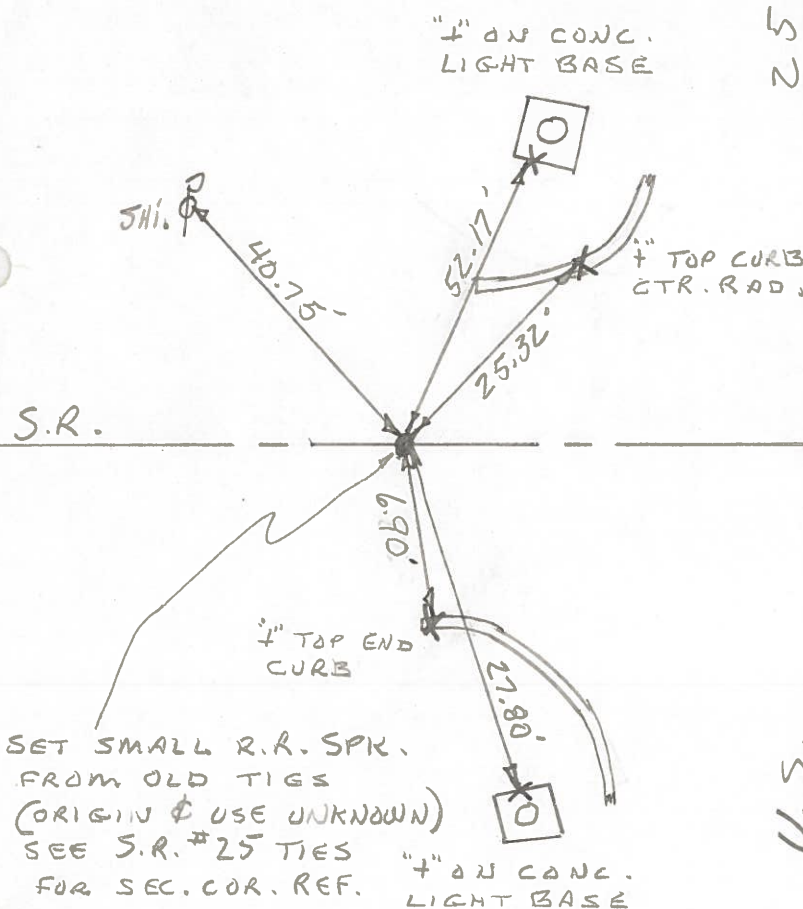

8-24-81
SET SMALL R.R. SPR.
6.2 - To S.E.P.
3.5 - S. of C.
17.5 - To N.E.P.

Q.D.O.T. DISTRICT 2 SURVEY OFFICE

Sht. ___ of ___

County WOOD S.R. 582

Township MIDDLETON

Section 24

T6N, R10E

Personnel BURNSIDE

SMITH


BOWERS

HOLCOMBE

Date OK-5-20-81
5-26-71 8-24-81

Weather CLEAR

Temp. 65°

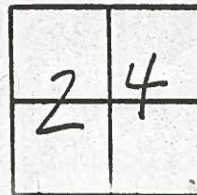

#17

OK-5-20-81
S-HOFFMAN

25

"4" AN CONC.
LIGHT BASE

SHI. P
40.75-

52.17'

"4" TOP CURB
CTR. RAD.

25.32'

S.R.

582

60.9'

"4" TOP END
CURB

27.80'

SET SMALL R.R. SPIKE
FROM OLD TIES
(ORIGIN & USE UNKNOWN)
SEE S.R. #25 TIES
FOR SEC. COR. REF.

"4" AN CONC.
LIGHT BASE

U.S.

6.2 TO S.E.D

3.5 S of E


17.5 to HED

Set small railroad
SPIKE

PERSONNEL	TITLE	PERSONNEL	TITLE
BURNSIDE			
SMITH			
BOWERS			
HOLCOMBE			


COUNTY WOOD DATE 5-28-71
 S. R. 582 WEATHER CLEAR
 SEC. _____ TEMP. +65

DESCRIPTION _____ LEFT _____ CENTER LINE _____ RIGHT _____ JOB NO. _____

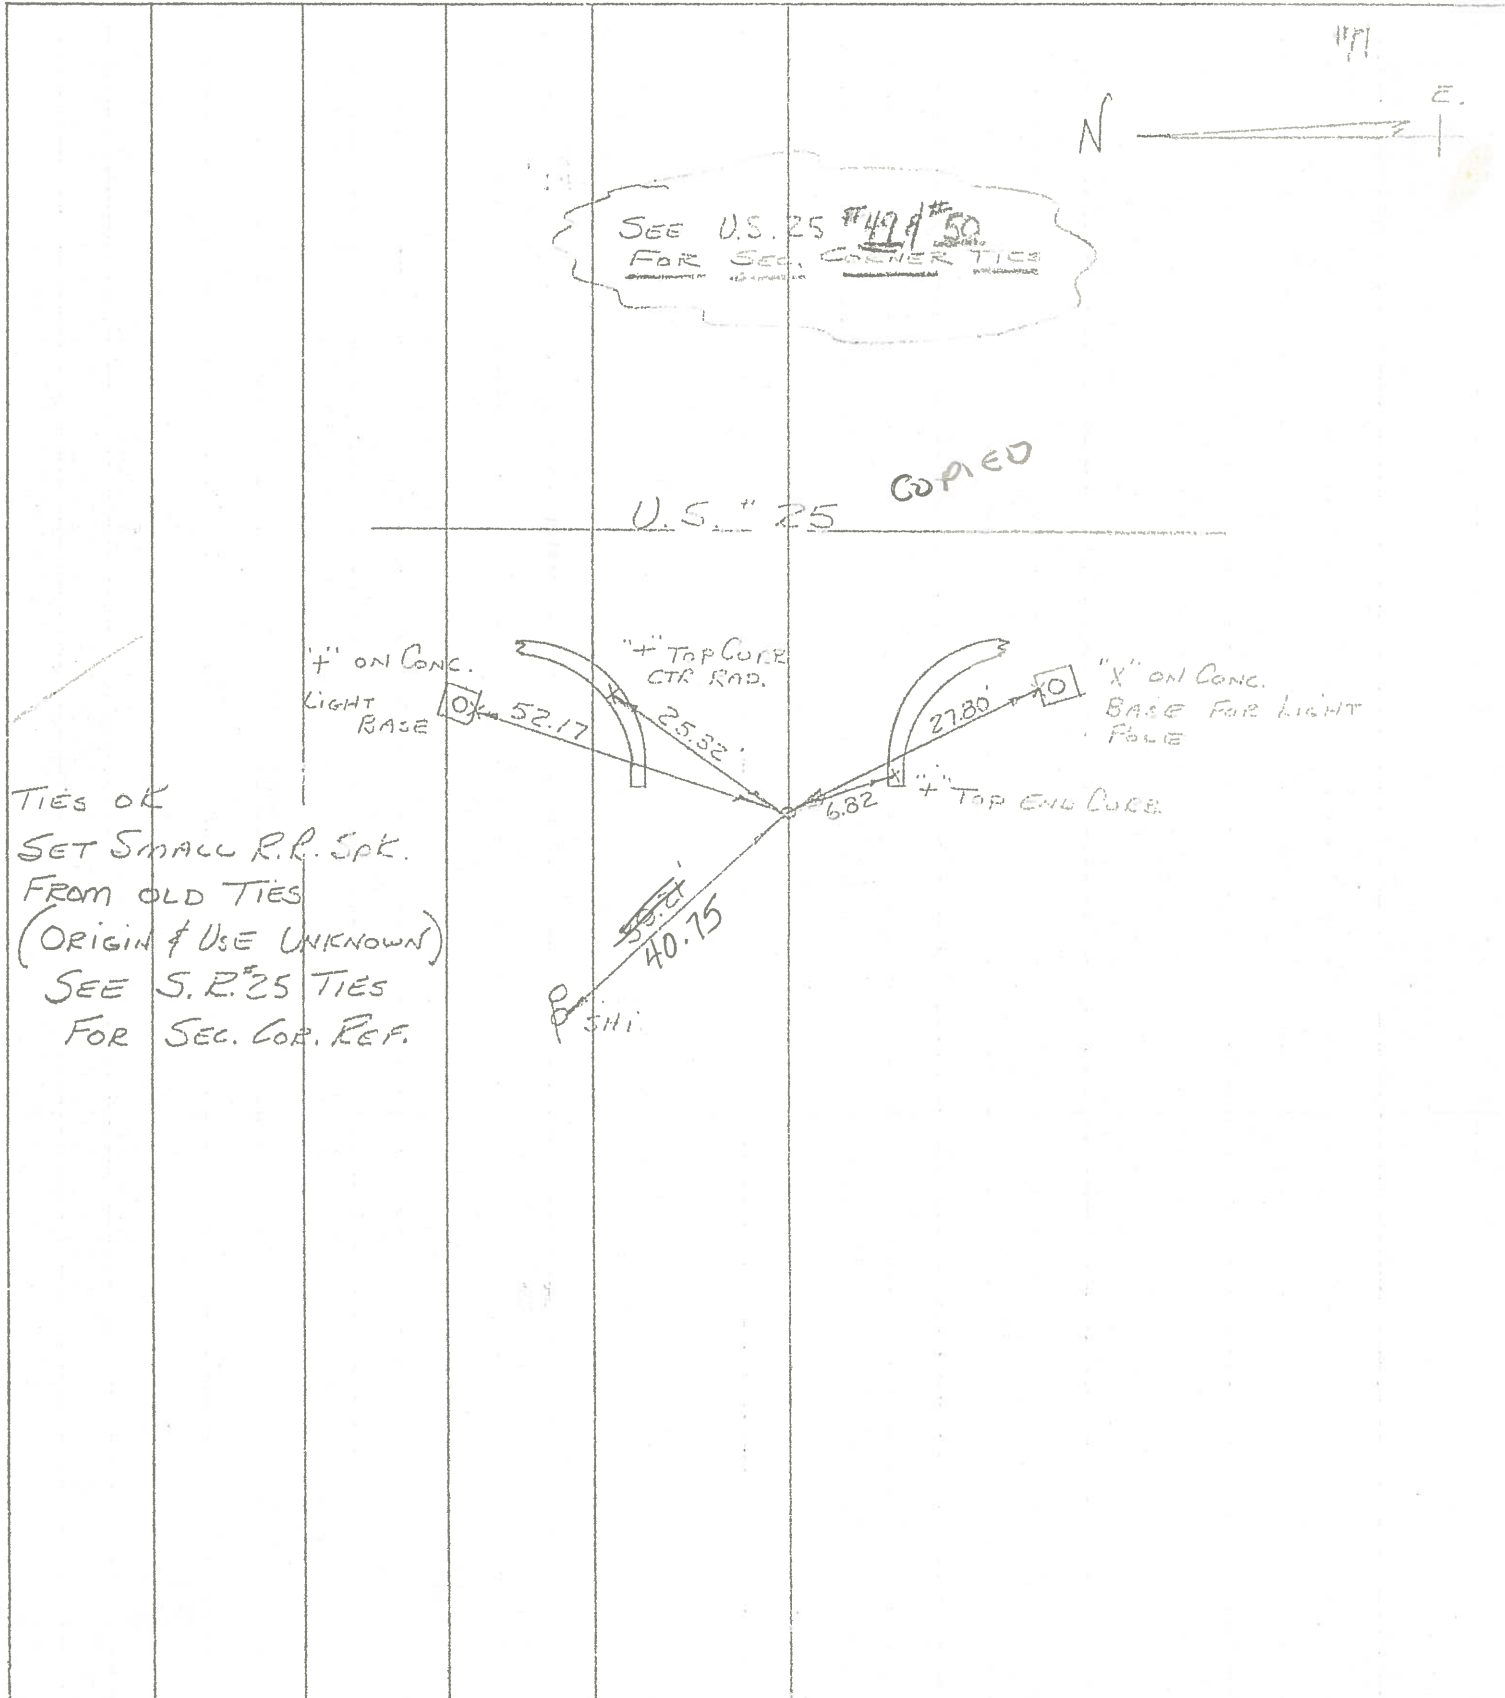

PERSONNEL	TITLE	PERSONNEL	TITLE	COUNTY	DATE	WEATHER	TEMP.
BURNSIDE				WOOD	5-28-71	CLEAR	+65
SMITH				S. R. 582			
BOWERS				SEC.			
HOLCOMBE							

DESCRIPTION	LEFT	CENTER LINE	RIGHT	JOB NO.
-------------	------	-------------	-------	---------

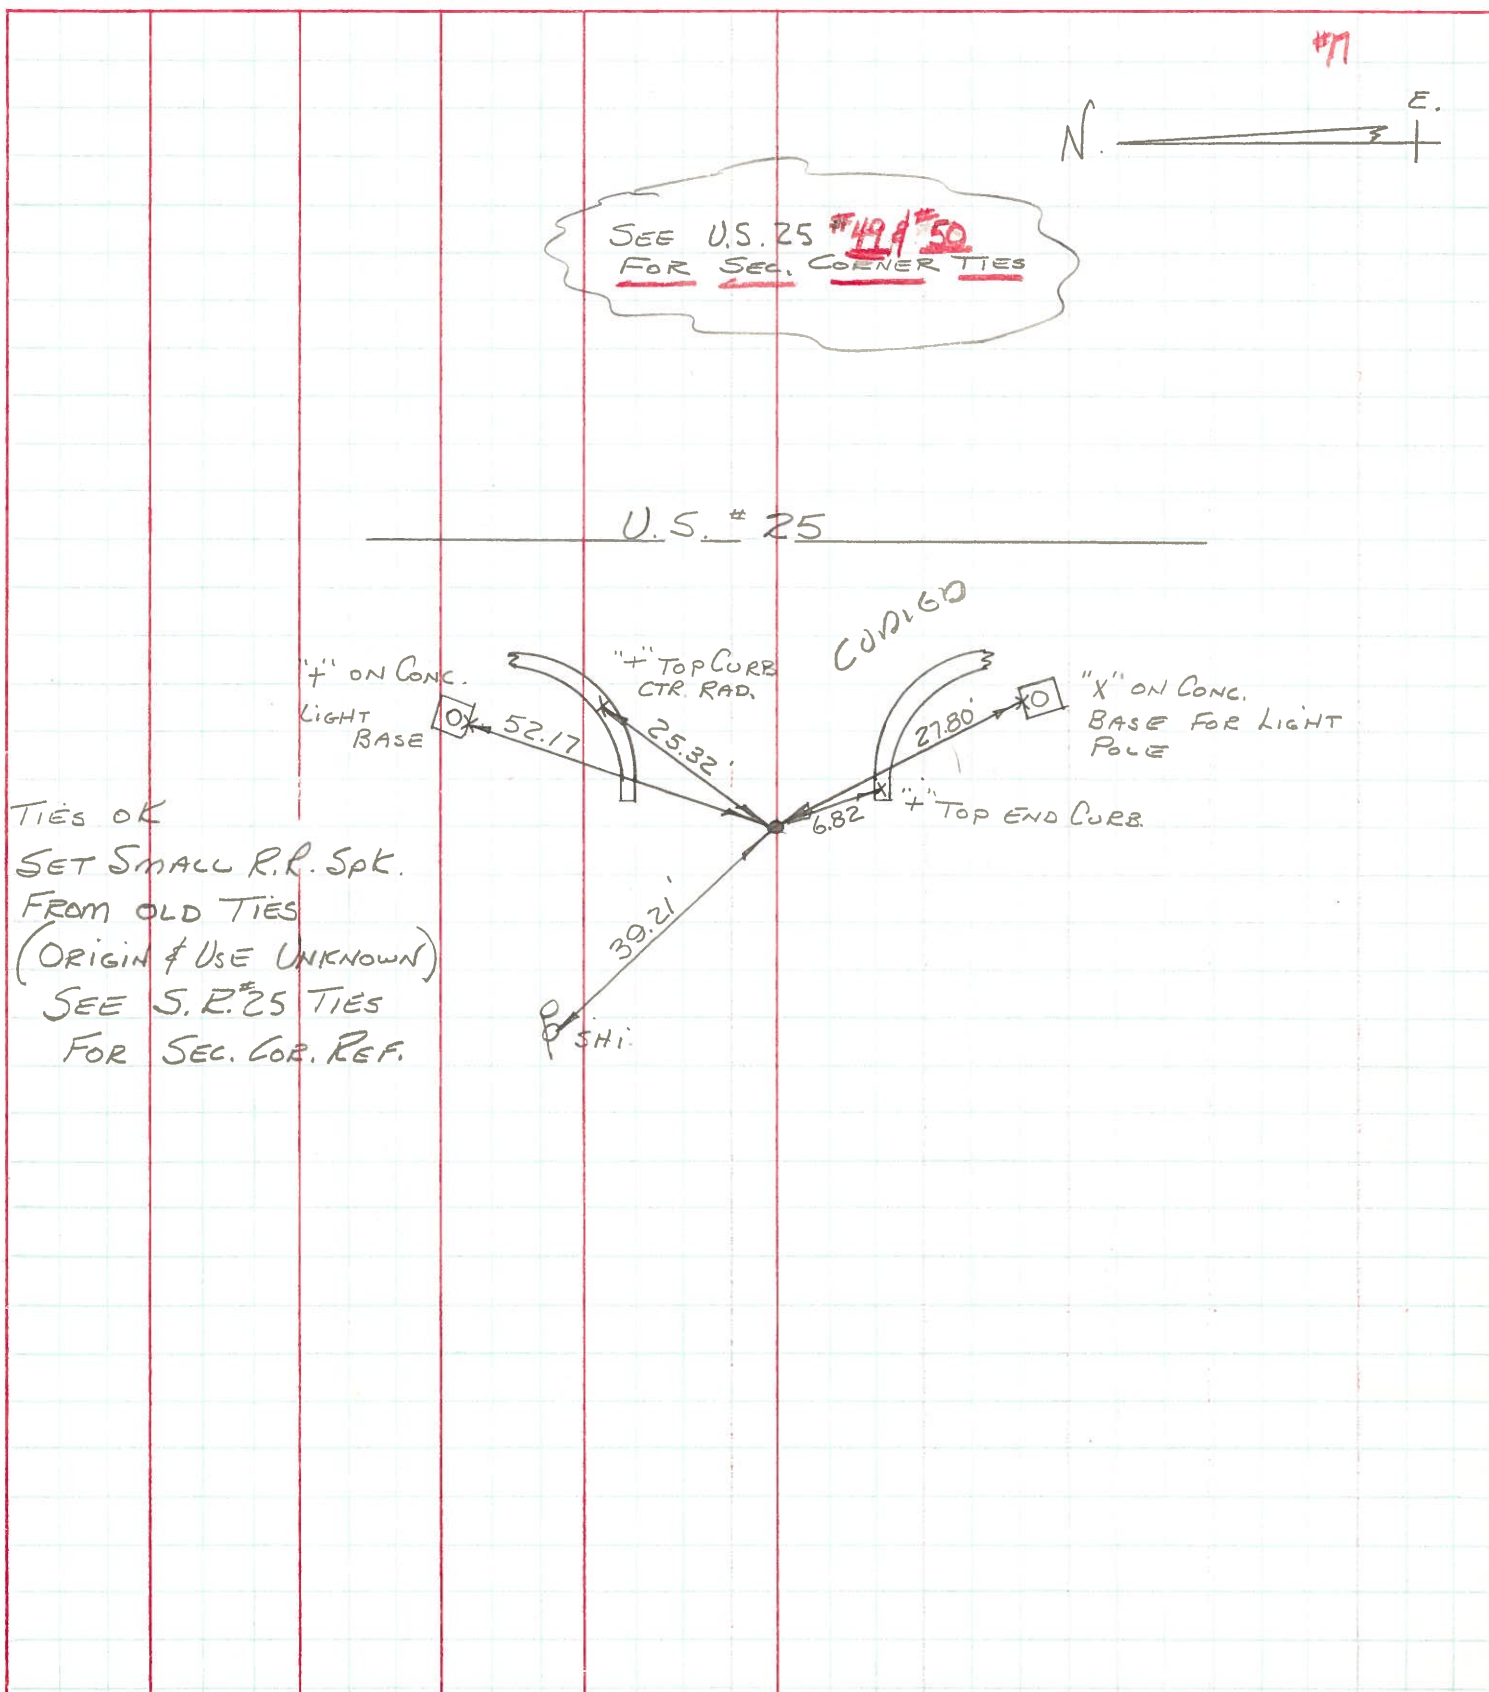

PERSONNEL TITLE PERSONNEL TITLE

SchneiderBarbourReddingPottsCOUNTY Wood

DATE

S. R. 582

WEATHER

SEC. 0.00-

TEMP.

DESCRIPTION Ties for Control Points

JOB NO.

LEFT

CENTER LINE

RIGHT

S.R. # 25281+20**17**"X" on CONC-
base light
Post25.32'27.80'PI - 10039.21'255+33Fd. Iron pipe - Paving S. Rd.
2" below surface**16**25.32'37.56'24.64'Brace pole216+47Fd. R.R. spk
2" below surface37.63'40.52'Hall Prairie Rd.43.72'14.31'WEST EDGESHIN.E.S. PAVESHI**14**CONC. BR. R. H.
CURBCONC. BR. R. H.