

O.D.O.T. DISTRICT 2 SURVEY OFFICE (USE ONLY)

PERSONNEL

REFERENCE NO. 26

SHEET 5 OF 21

NOTES NIESE

DATE 12/4/19

ROUTE SR 582

H.C. LEU

WEATHER CLOUDY

COUNTY WOOD

R.C. NASON

TEMP. 38°

TOWNSHIP MIDDLETON

SECTION 28

DWG BY BALBAUGH PID 81000

T 6 N R 11 E

TYPE MONUMENT MONBOX W/ 1" IPIN

ON SURFACE - ~~BELOW~~ ON

OFFSET CL PAVEMENT 10.8 ~~LT~~ : RT

— TO — EDGE PAVEMENT


STATION: 421+38.81

HORIZ.DATUM: NAD83 (2011)


GEOID: 2012A

GRID: NORTHING: 654406.503

EASTING: 1666965.330

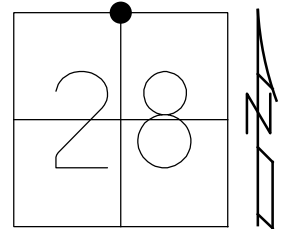

RECORD:
FD STONE
4/15/05, MC
FD STONE
4/14/15, JLL
FD STONE
5/8/19, JLL
FD MONBOX
W/ 1" IPIN
NEWREF26
11/14/19, JLL

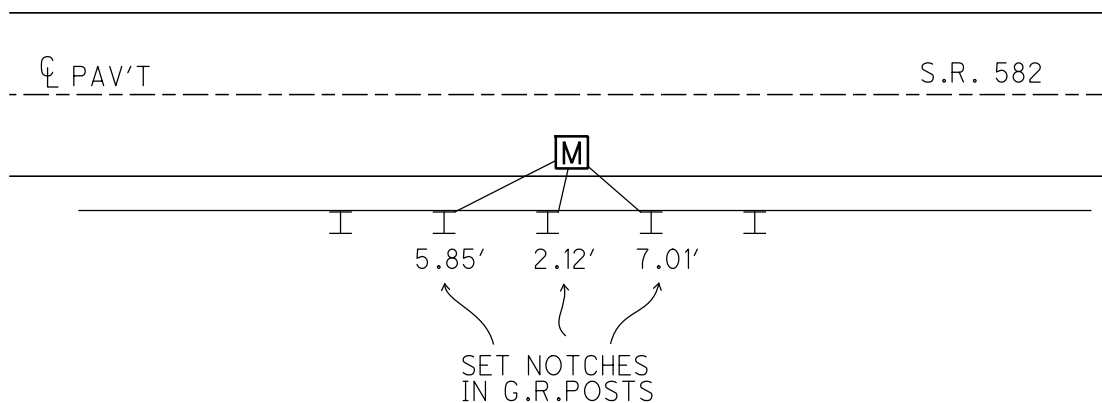

O.D.O.T. DISTRICT 2 SURVEY OFFICE

PERSONNEL

REFERENCE NO. 26

SHEET 4 OF 20

NOTES BARNHISEL

DATE 04/15/05

ROUTE 582

H.C. CANTERBURY

WEATHER CLEAR

COUNTY WOOD

R.C. BARNHISEL

TEMP. +50°

TOWNSHIP MIDDLETON

SECTION 28

T 6 N R 11 E

TYPE MONUMENT STONE



~~ON SURFACE~~ - BELOW 1.6'

~~LEFT~~ - Q PAV'T - RIGHT 10.8'

1.4' TO RT EDGE PAVEMENT

S.L.M. 421+64

GRID: NORTHING: EASTING:

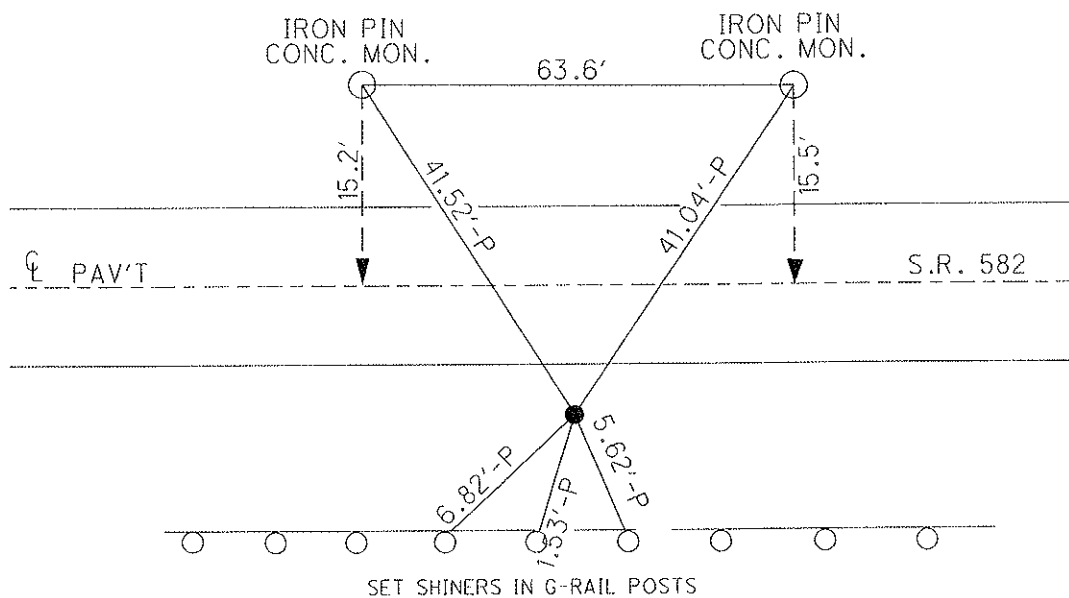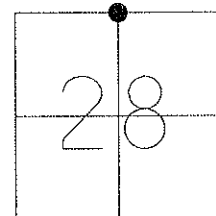

O.D.O.T. DISTRICT 2 SURVEY OFFICE

PERSONNEL

REFERENCE NO. 26

SHEET 5 OF 21

NOTES BARNHISEL

DATE 04/15/05

ROUTE 582

H.C. CANTERBURY

WEATHER CLEAR

COUNTY WOOD

R.C. BARNHISEL

TEMP. +50°

TOWNSHIP MIDDLETON

SECTION 28

T 6 N R 11 E



TYPE MONUMENT STONE

~~ON SURFACE~~ - BELOW 1.6'

~~LEFT~~ - C PAV'T - RIGHT 10.8'

1.4' RT of RT EDGE PAVEMENT

S.L.M. 421+64

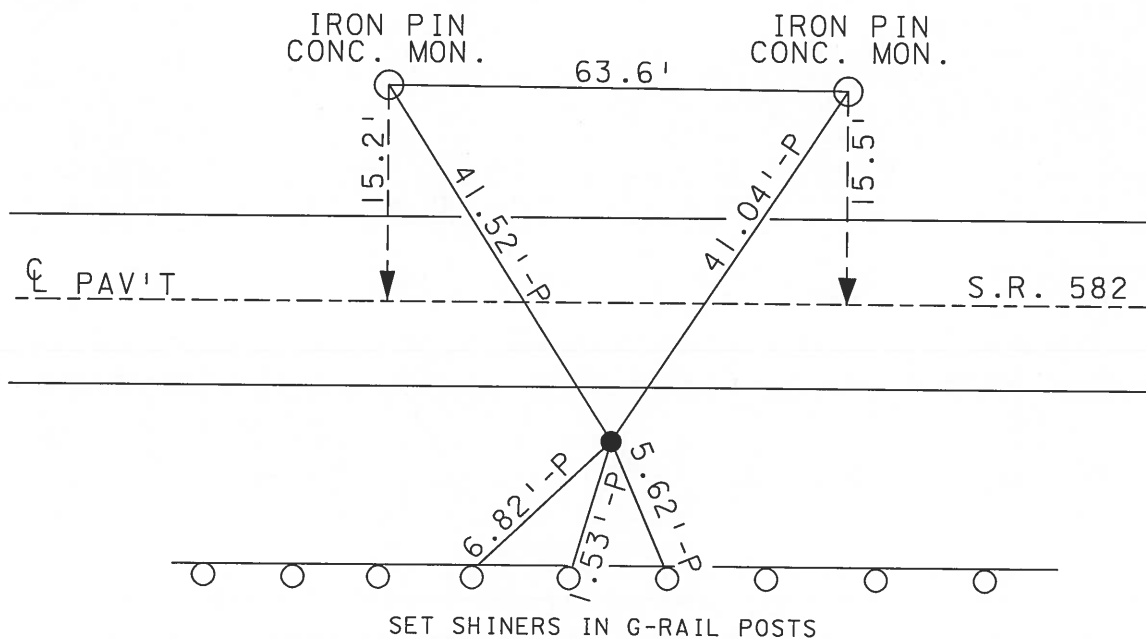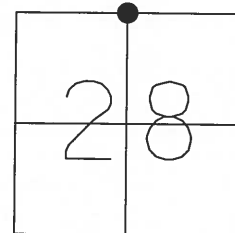

O.D.O.T. DISTRICT 2 SURVEY OFFICE

PERSONNEL

REFERENCE NO. 26

SHEET OF

NOTES BARNHISEL

H.C. " "

R.C. HOFFMAN

DATE 7-12-90

WEATHER cloudy

TEMP. +65°

ROUTE 582

COUNTY WOOD

TOWNSHIP Middleton

SECTION 28

T 6 N R 11 E


TYPE MONUMENT Fd. STONE

ON SURFACE - BELOW 1.55 BEFORE PAVING


LEFT - CL PAV'T. - RIGHT 10.8

1.4 RT TO RT EDGE PAVEMENT

S.L.M. 421+49

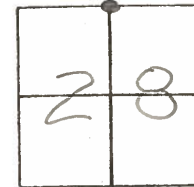

Set 1/2" IRON Re-bar
AT SURFACE
10-25-90
MB

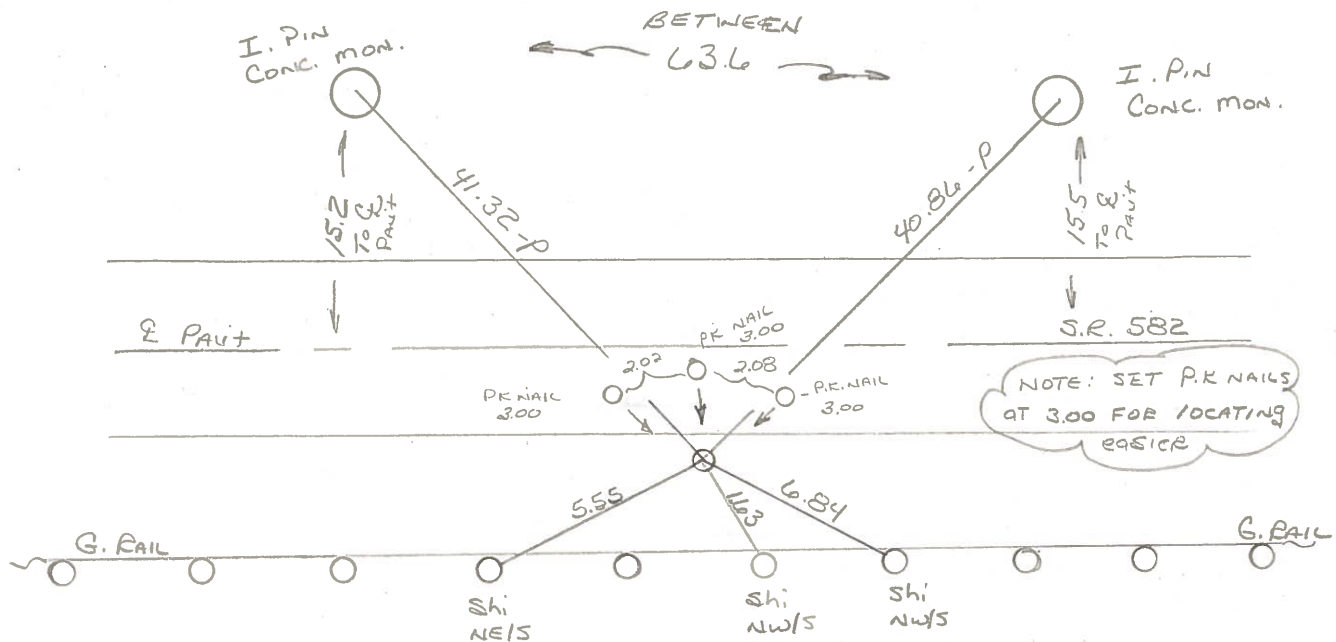

County Wood S.R. 582

Township Middleton

Section 28

T.N, R.E

Personnel I. Stone

P. Neusser


R. Michalek

D. Curtis


Date 13 July 83

Weather Warm

Temp. 83°

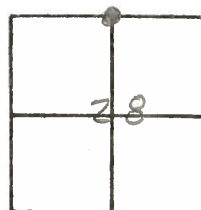

26

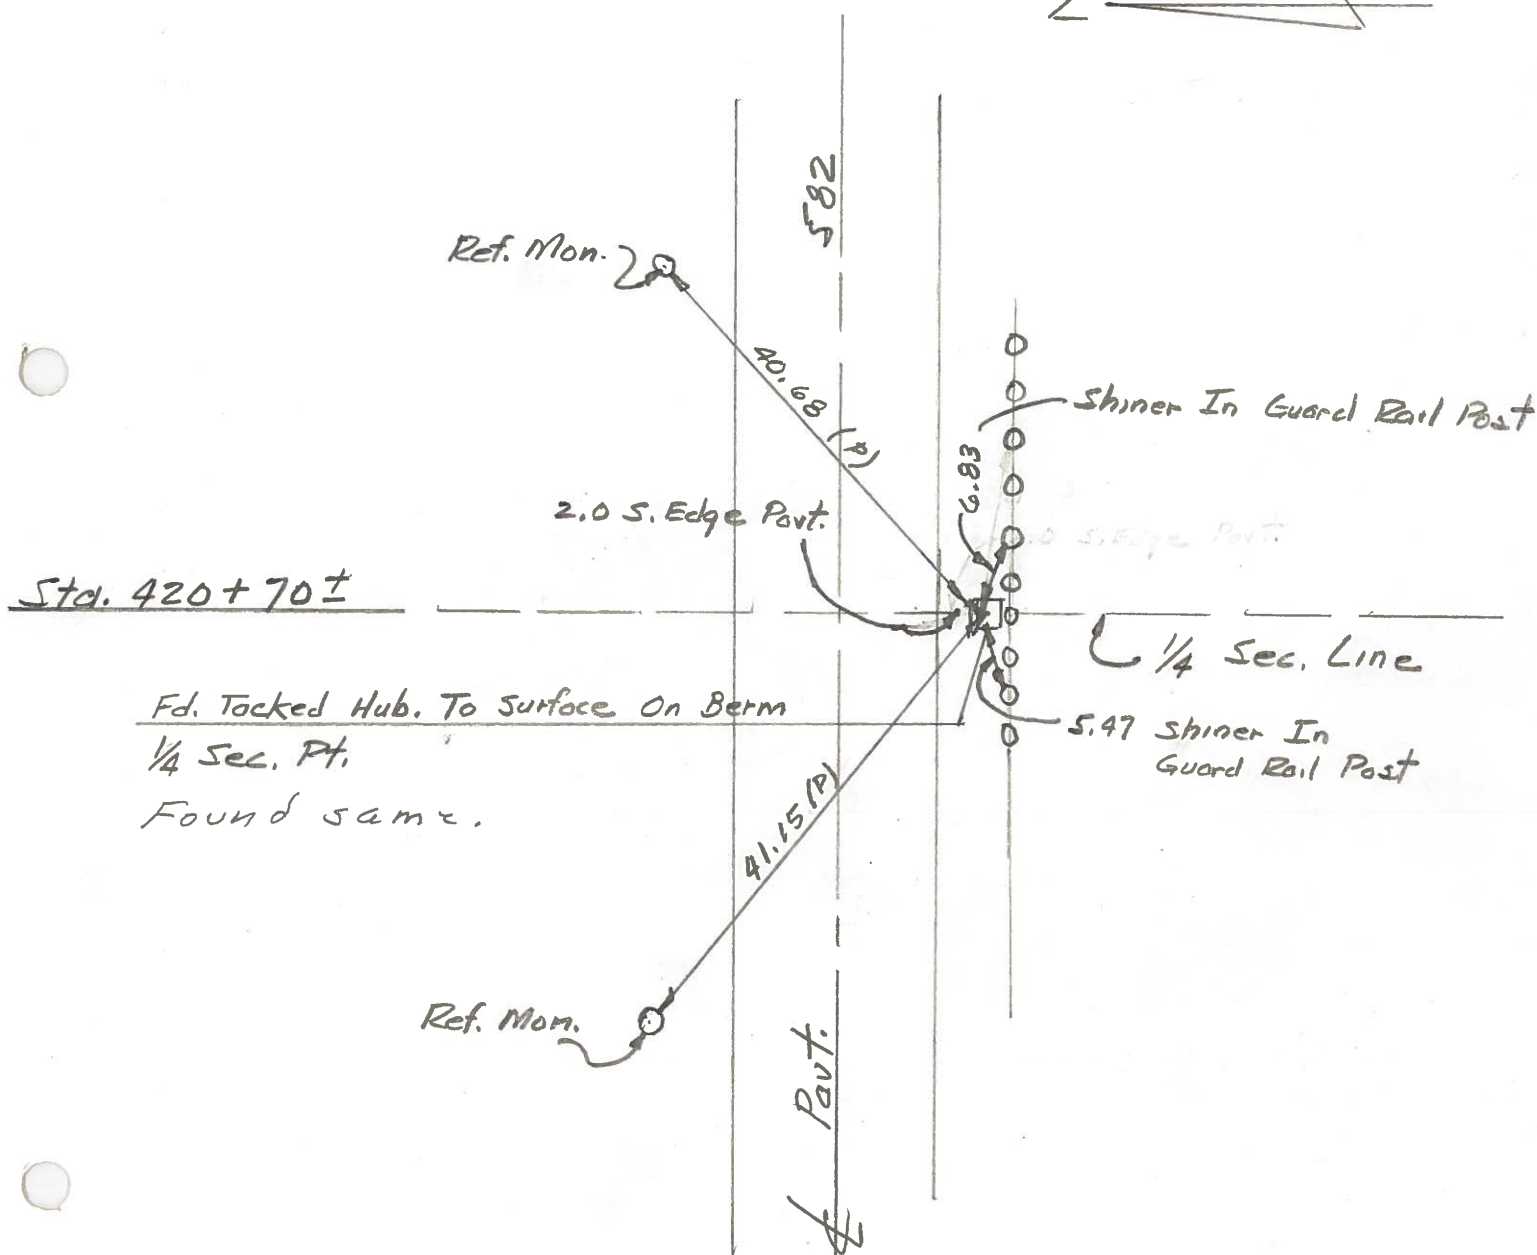

Q.D.O.T. DISTRICT 2 SURVEY OFFICE

SHEET 3 OF

County Wood S.R. 582

Township Middleton

Section 28

T.N, R.E

Personnel 1. Stone

P. Newser


R. Michalak

D. Curtis

Date 13 July 83

Weather Warm

Temp. 83°

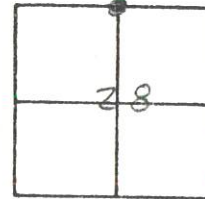

26

421+49

1.4 Rt of Rt E.P.
10.8 Rt of E. Post

Ref. Mon.

I. Pin
conc.
mon.

2.0 S. Edge Post.

Sta. 420+70±

Fd. Tacked Hub. To Surface On Berm

1/4 Sec. Pt.

Found same.

Ref. Mon.

I. Pin
conc.
mon.

Shiner In Guard Rail Post

FROM G. RAIL
P 1.43

1/4 Sec. Line

5.47 Shiner In
Guard Rail Post
5.55 P

Layed 3 to
Large R.R. SPIKES
ACROSS HIGH Point
of slope.

PERSONNEL	TITLE	PERSONNEL	TITLE
1	2	3	4
5	6	7	8
9	10	11	12
13	14	15	16
17	18	19	20
21	22	23	24
25	26	27	28
29	30	31	32
33	34	35	36
37	38	39	40
41	42	43	44
45	46	47	48
49	50	51	52
53	54	55	56
57	58	59	60
61	62	63	64
65	66	67	68
69	70	71	72
73	74	75	76
77	78	79	80
81	82	83	84
85	86	87	88
89	90	91	92
93	94	95	96
97	98	99	100

COUNTY Wood

DATE April 17, 1969

Mar 1507

Holcombe

5m 17h.

500.514

S. R. #582

WEATHER Pt. Clouds & Windy

SEC. From I-75 to SR#159

TEMP. $+75^{\circ}$


DESCRIPTION Ties to Control points.

JOB NO. 027300

LEFT

CENTER LINE

RIGHT

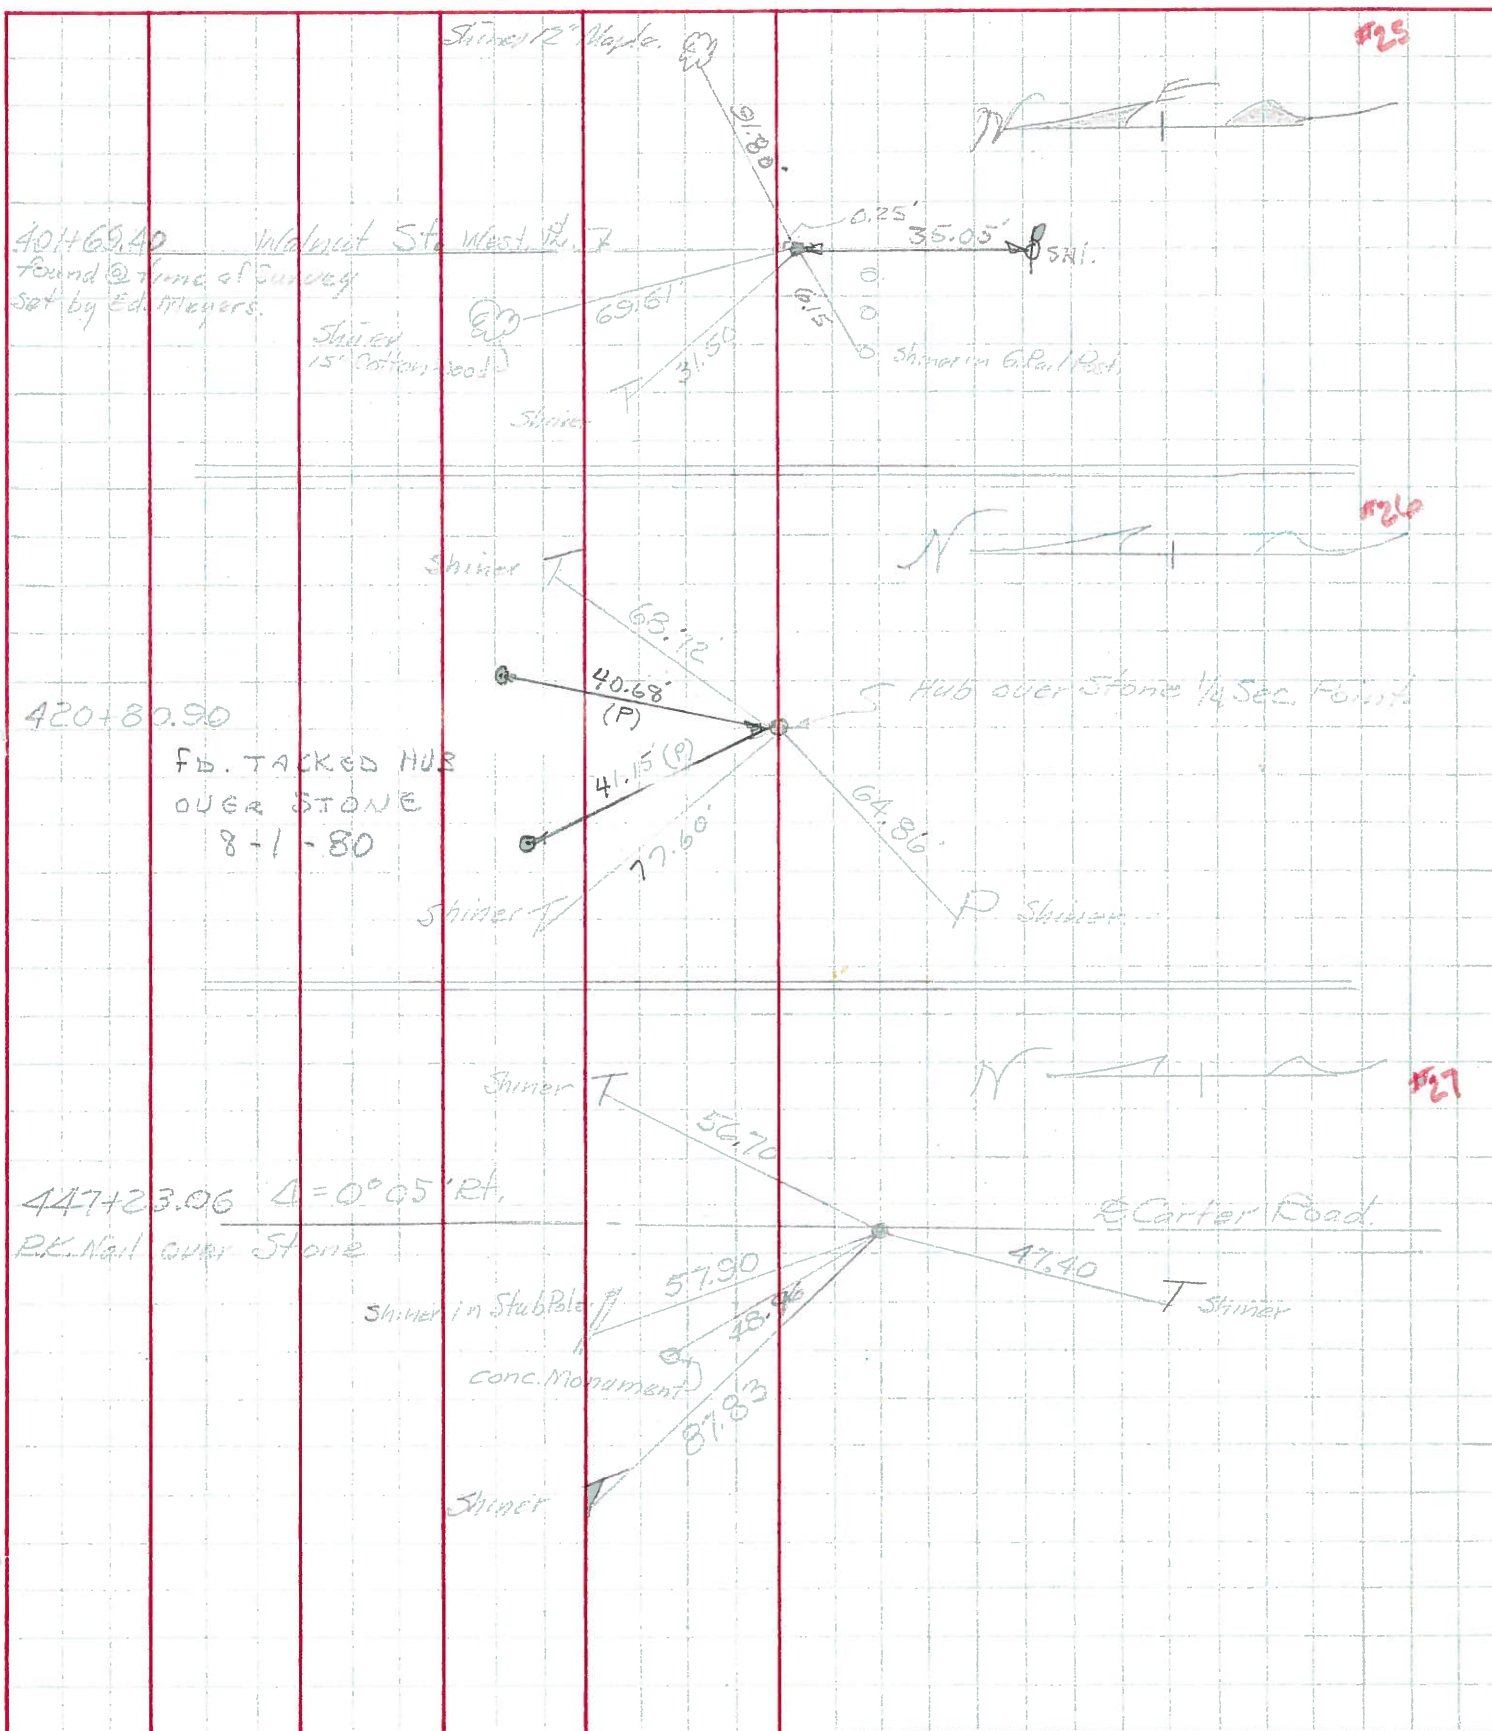

PERSONNEL TITLE PERSONNEL TITLE


COUNTY Wood DATE 2. 19. 1980

S. R. #1583 WEATHER Pl. Windy

SEC. From F-75 to SP#68 TEMP 27.8°

DESCRIPTION Trans to Central station JOB NO. 0-2-1980

LEFT CENTER LINE RIGHT

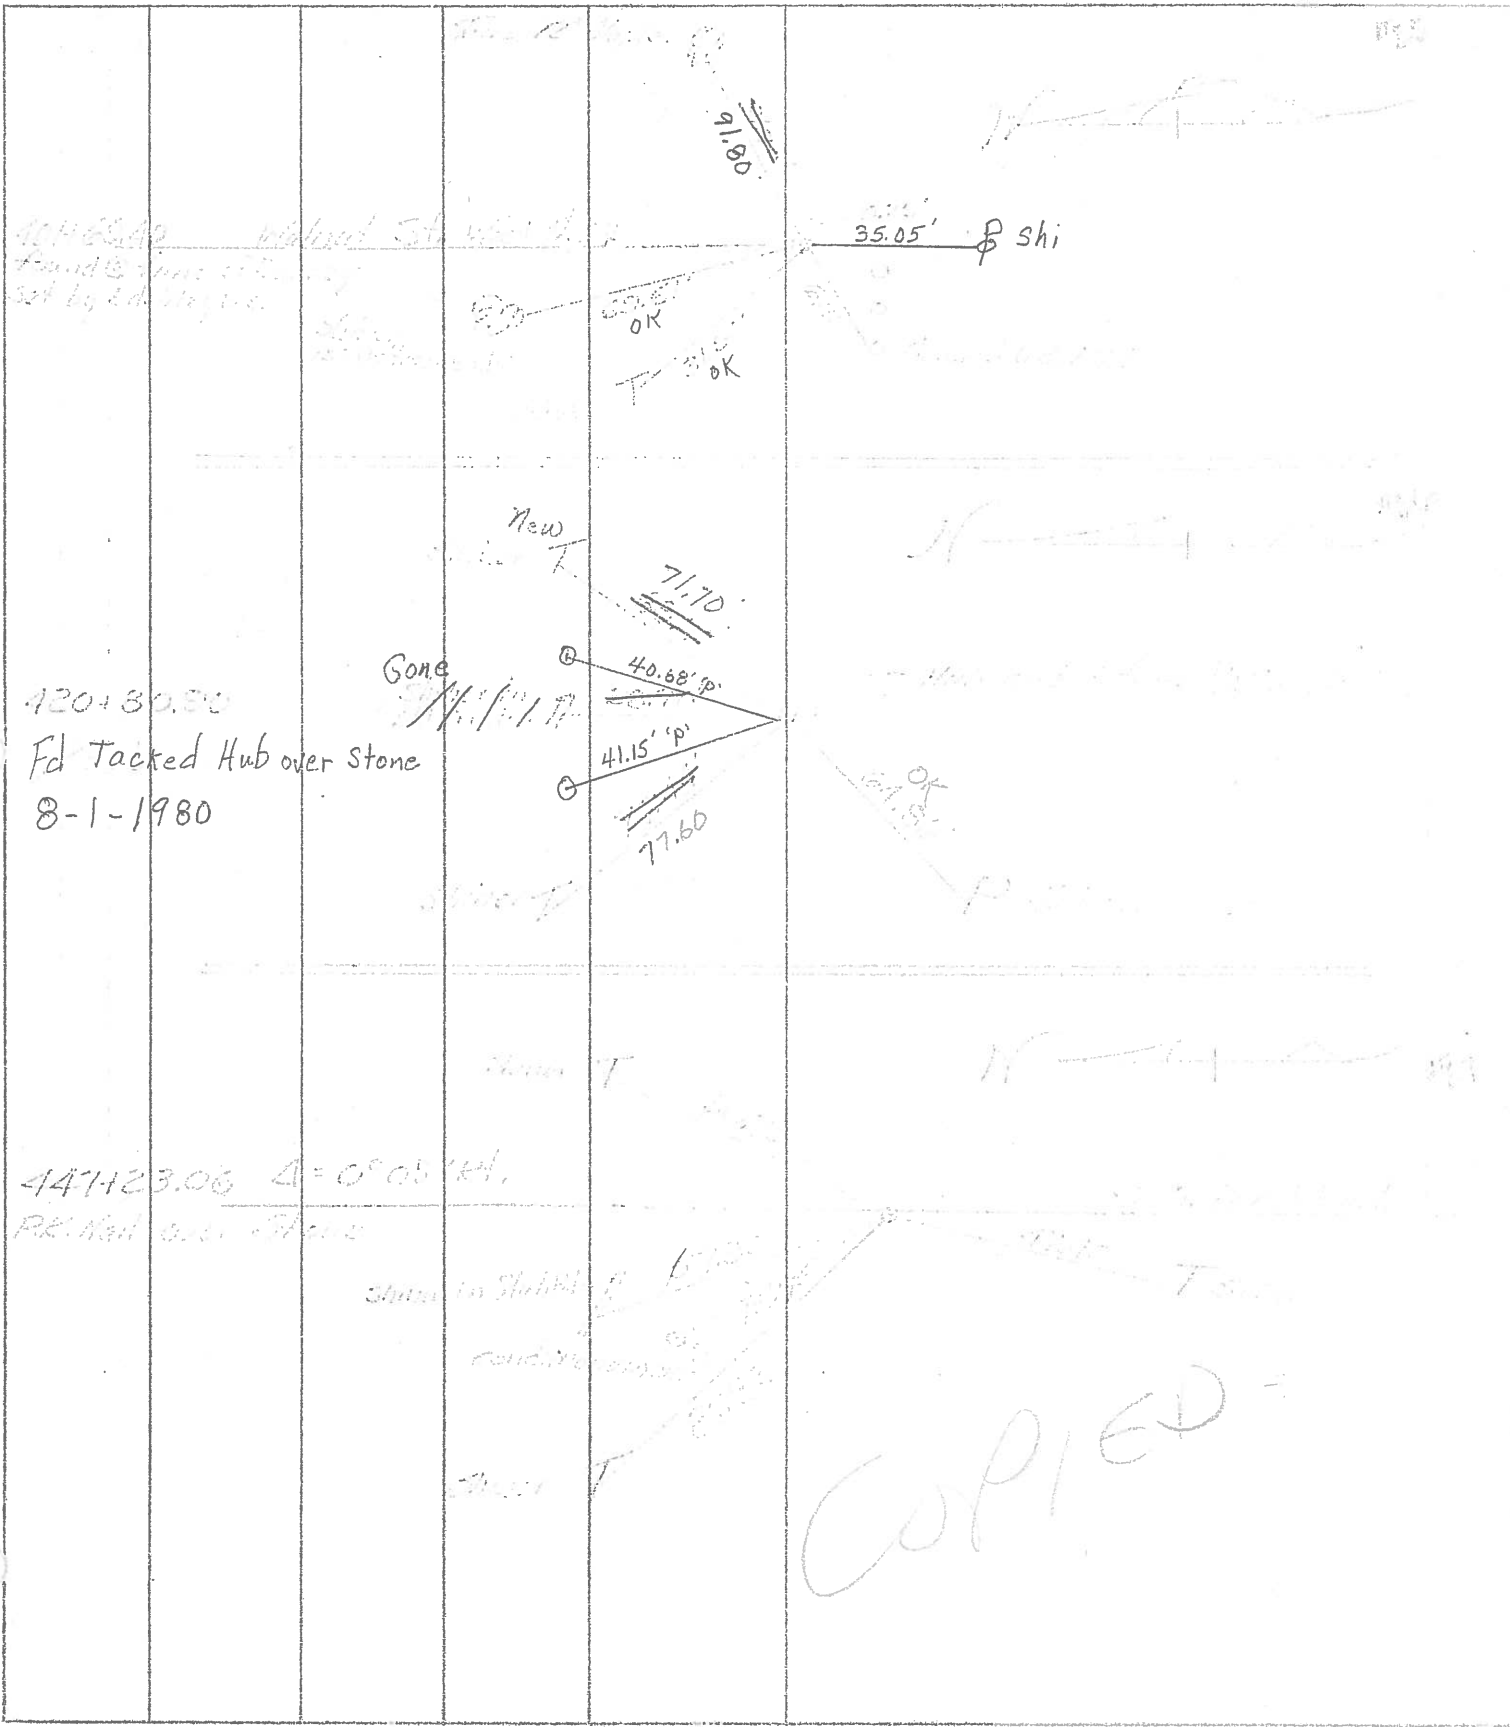

COPIED

40.68
41.15