



O.D.O.T. DISTRICT 2 SURVEY OFFICE (USE ONLY)

PERSONNEL	REFERENCE NO. <u>28</u>	SHEET <u>7</u> OF <u>21</u>
NOTES <u>LEU</u>	DATE <u>4/24/19</u>	ROUTE <u>SR 582</u>
H.C. <u>LEU</u>	WEATHER <u>SUNNY</u>	COUNTY <u>WOOD</u>
R.C. <u>JAMES</u>	TEMP. <u>46°</u>	TOWNSHIP <u>WEBSTER</u>
		SECTION <u>27</u>
DWG BY <u>BALBAUGH</u>	PID <u>81000</u>	T <u>6</u> N R <u>11</u> E
TYPE MONUMENT <u>3/4" IPIN BENT</u>		
ON SURFACE - BELOW <u>4"</u>		
OFFSET <u>CL</u> PAVEMENT <u>9.7'</u> LT : RT		
<u>1.6'</u> TO RT EDGE PAVEMENT		
STATION: <u>474+29.82</u>		
HORZ.DATUM: <u>NAD83 (2011)</u>		GEOID: <u>2012A</u>
GRID: NORTHING: <u>654275.487</u>		EASTING: <u>1672254.510</u>

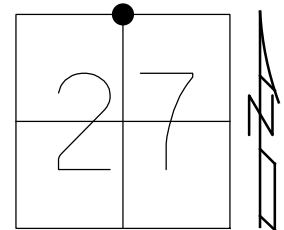

RECORD:
 FD LG.R.R.SPIKE
 4/15/05, MC
 SET 5/8" IPIN
 8/23/05
 FD 3/4" IPIN BENT
 REF28
 SET 3/4" IPIN
 4/14/15, JLL
 FD MONBOX
 W/ 1" IPIN
 NEWREF28
 11/14/19, JLL

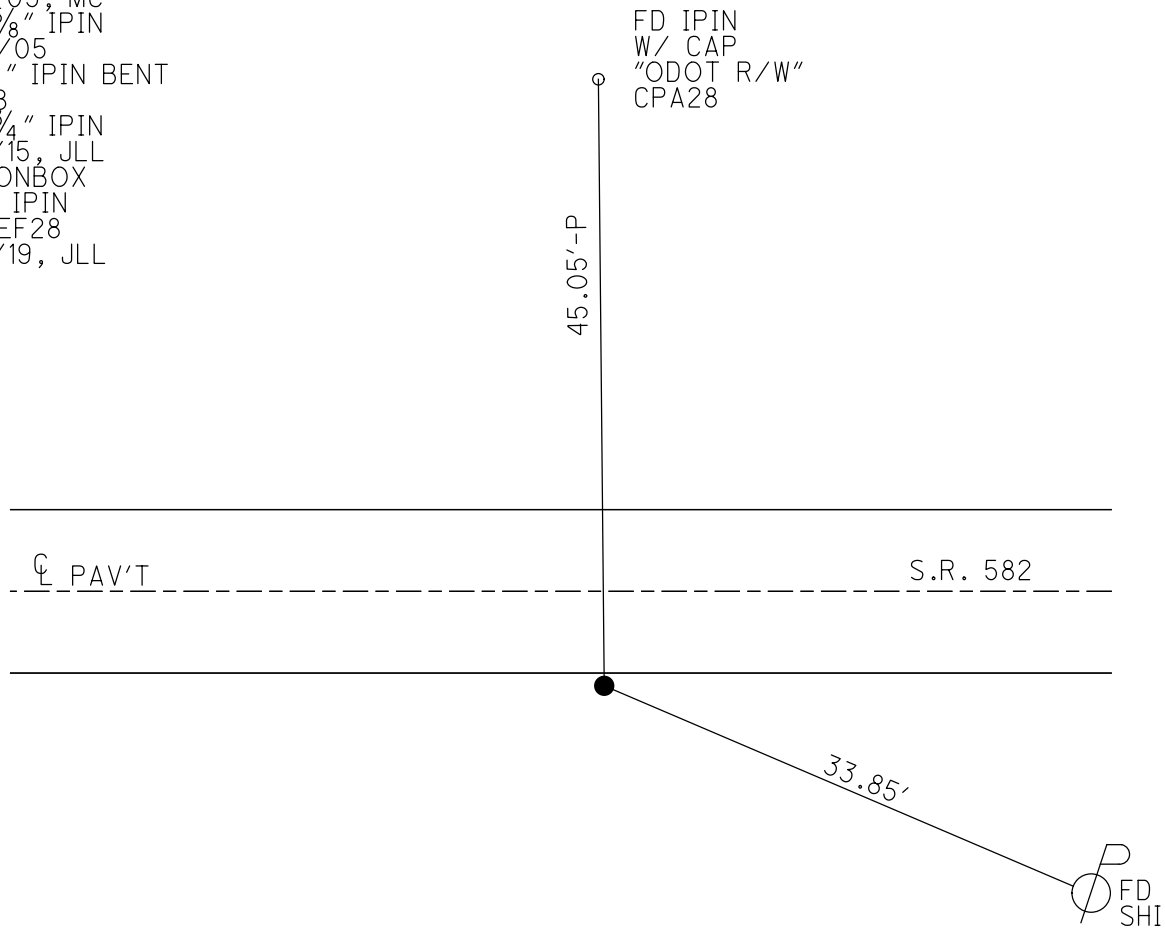

O.D.O.T. DISTRICT 2 SURVEY OFFICE

PERSONNEL

REFERENCE NO. 28

SHEET 6 OF 20

NOTES BARNHISEL

DATE 04/15/05

ROUTE S.R. 582

H.C. CANTERBURY

WEATHER CLEAR

COUNTY WOOD

R.C. BARNHISEL

TEMP. +50°

TOWNSHIP WEBSTER

SECTION 27

T 6 N R 11 E

TYPE MONUMENT Lg RR Spike

~~ON SURFACE~~ - BELOW 4"


~~LEFT~~ - Q PAV'T - RIGHT 9.7'

1.6' TO RT EDGE PAVEMENT

S.L.M. 474+44


GRID: NORTHING:

EASTING:

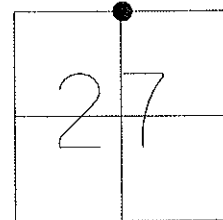

Set (5/8) inch iron rod
on south edge of paved berm
08/23/05

Fd Shi
Triple 10"
Hickory
S/S

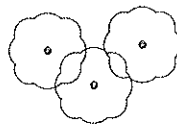

35.45'

Q PAV'T

S.R. 582



Set mag nails NW and
NE of iron rod

33.87'

Fd Shi
NW/S

O.D.O.T. DISTRICT 2 SURVEY OFFICE

PERSONNEL

REFERENCE NO. 28

SHEET 7 OF 21

NOTES BARNHISEL

DATE 04/15/05

ROUTE S.R. 582

H.C. CANTERBURY

WEATHER CLEAR

COUNTY WOOD

R.C. BARNHISEL

TEMP. +50°

TOWNSHIP WEBSTER

SECTION 27

T 6 N R 11 E


TYPE MONUMENT Lg RR Spike

~~ON SURFACE~~ - BELOW 4"


~~LEFT~~ - Q PAV'T - RIGHT 9.7'

1.6' Rt of Rt EDGE PAVEMENT

S.L.M. 474+44

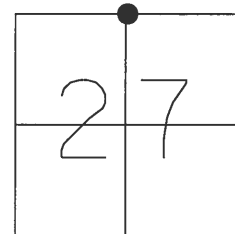

Set (5/8) inch iron rod
on south edge of paved berm
08/23/05

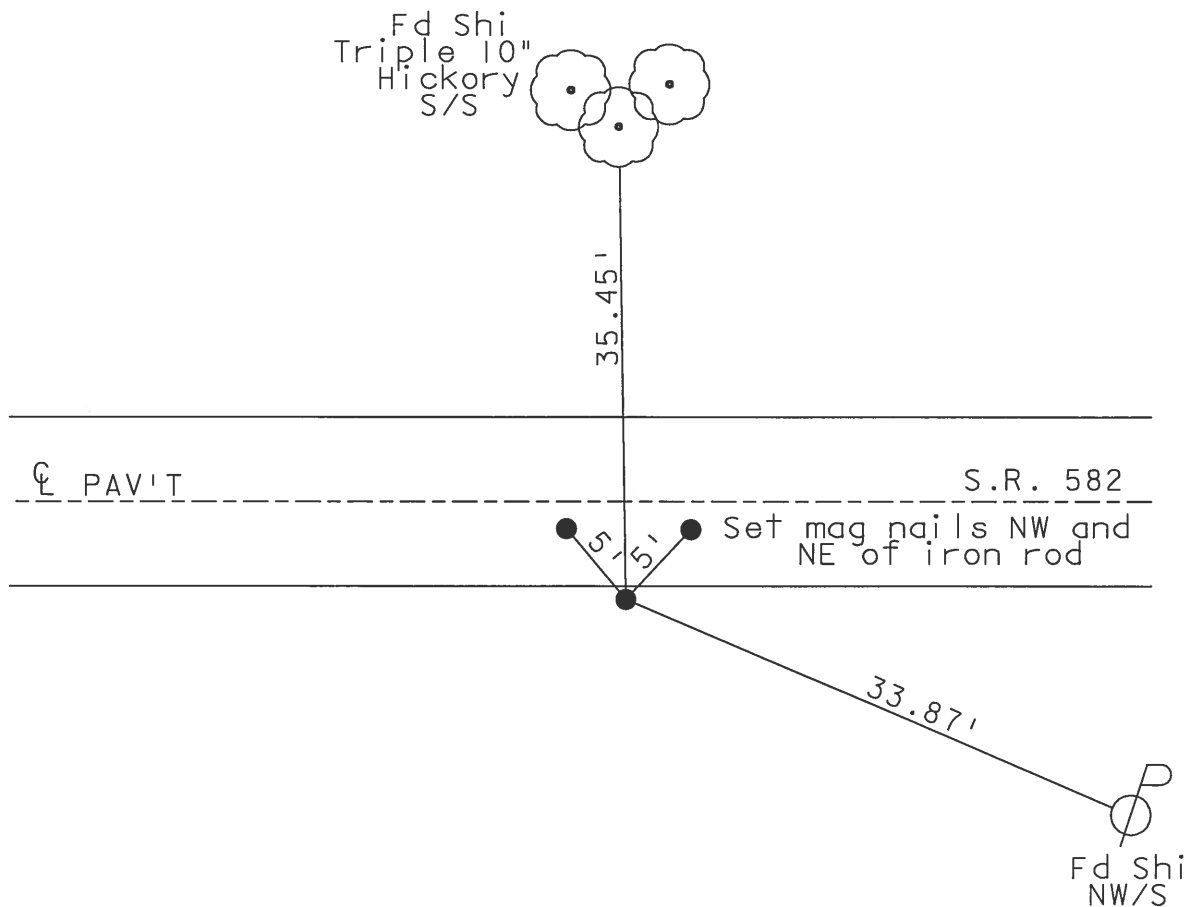

O.D.O.T. DISTRICT 2 SURVEY OFFICE

PERSONNEL

REFERENCE NO. 28

SHEET OF

NOTES

H.C.

LOEHRIKE

R.C.

HOFFMAN

STEINHAUSER

BARNHISEL

DATE

7-12-90

WEATHER

cloudy

TEMP.

+65°

ROUTE

SR. 582

COUNTY

WOOD

TOWNSHIP

WEBSTER

SECTION

27

T. 6 N. R. 11 E.

TYPE MONUMENT

Lg. R.R. Spk

ON SURFACE - BELOW

4"


LEFT - OF PAV'T. - RIGHT

11.7

1/4 FT. TO FT EDGE PAVEMENT


S.L.M.

474 + 44

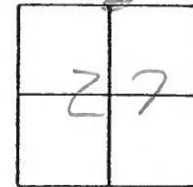

Set P.K./Washer
10-25-90
m/b

TRILE
8" Hickory
Set Shi
S/S

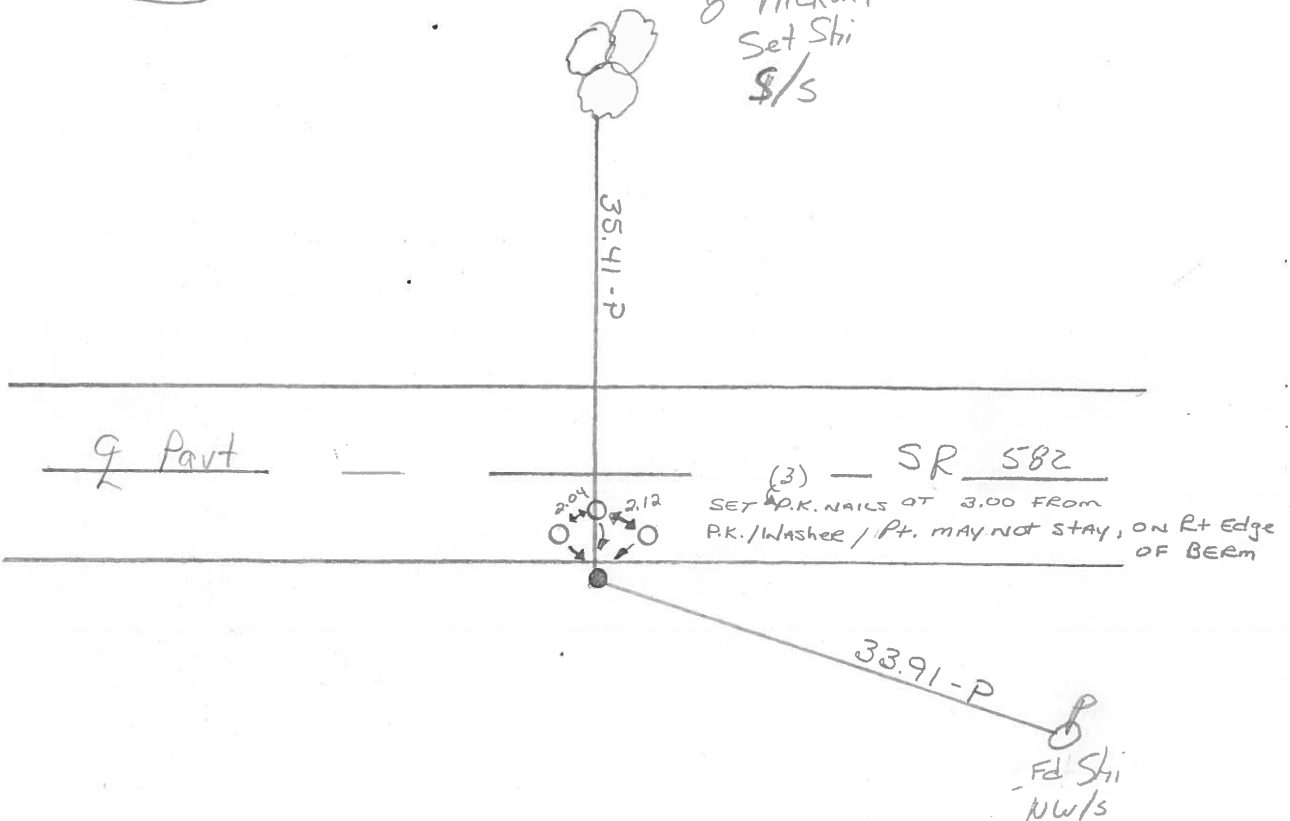

Q.D.O.T. DISTRICT 2 SURVEY OFFICE

SHEET 5 OF

County Wood S.R. 582

Township Webster

Section 27

T N, R E

Personnel I. Stone

P. Neusen


R. Michalek

D. Curtis

Date 13 July 83

Weather Windy

Temp. 85°

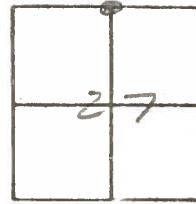

SLM STA. 474+60

REF. No. 28



shiner in
8" Triple Hickory

35.31

582

582

34.00'

39.10'

shiner

Hub & Tack

Fd RR Spt. 2" deep
1.9' N. to N. edge put.
in Beam
Dug 4" Found.

Q.D.O.T. DISTRICT 2 SURVEY OFFICE

SHEET 5 OF

County Wood S.R. 582

Township Webster

Section 27

T_N, R_E

Personnel I. Stone

P. Neuser


R. Michalek

D. Curtis

Date 13 July 83


Weather Warm

Temp. 85°

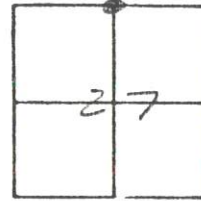

SLM STA. 474+60

REF. No. 28

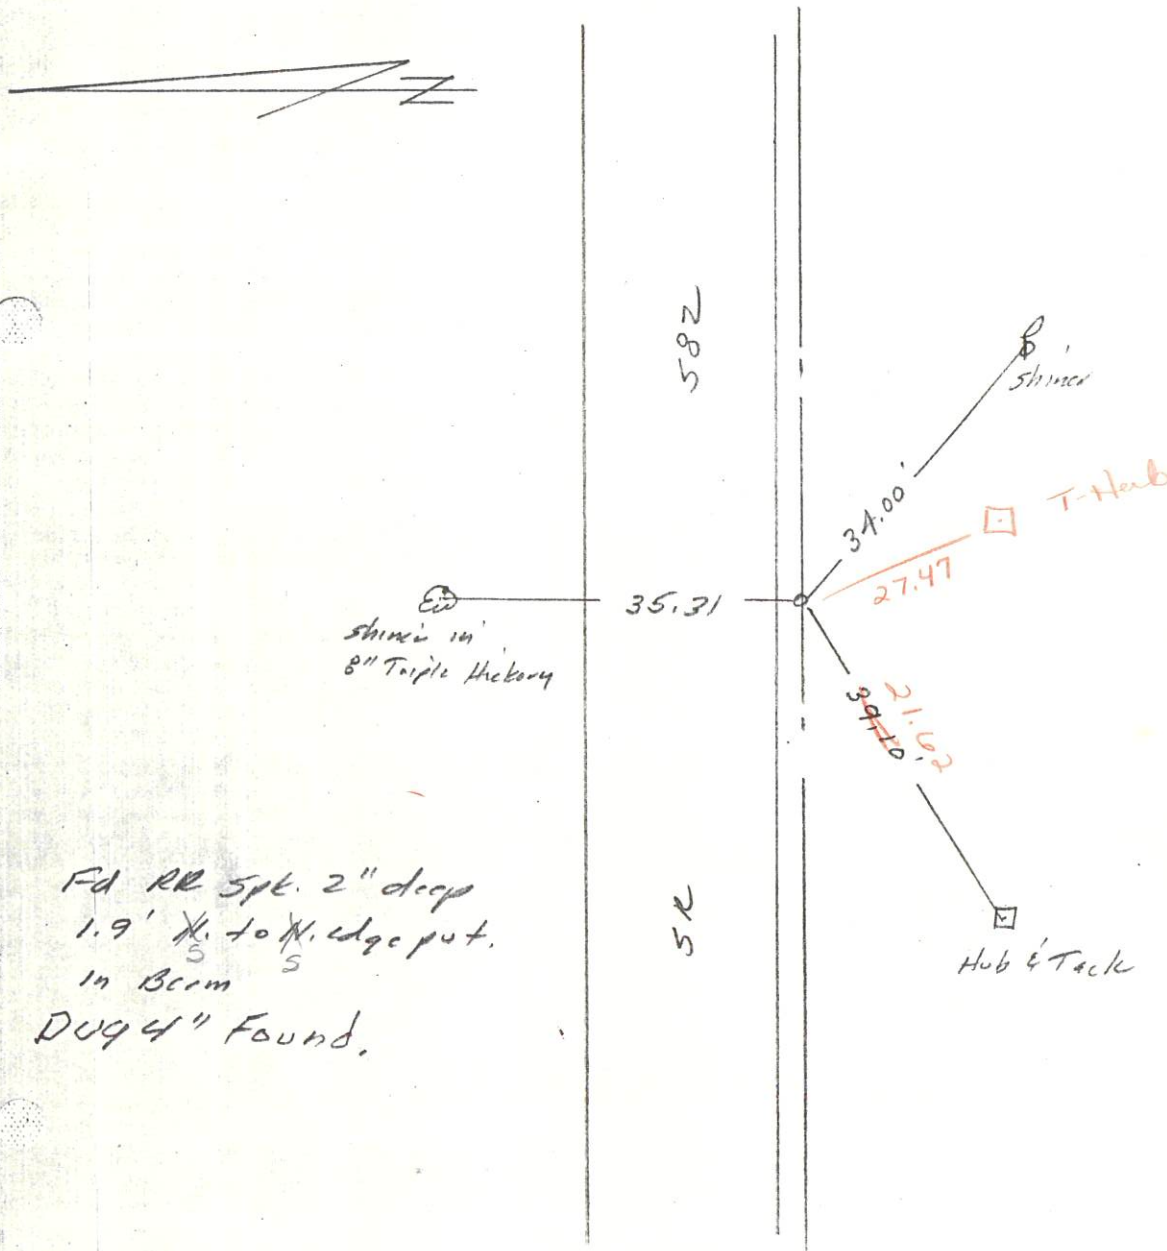


County Wood S.R. 582Township WEBSTERSection 27

T&N, R1E

Personnel HOFFMANLoehrkeHouseholder

28

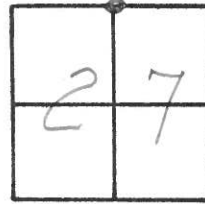
Date 6-22-82Weather clearTemp. +65°Fd. R.R. SPK 1" below surface of
stab. shoulder

SLM sta. 473+71.60

11.4' S. of & Pavt

1.8' S. of S.E.P.

opposite mile post #9

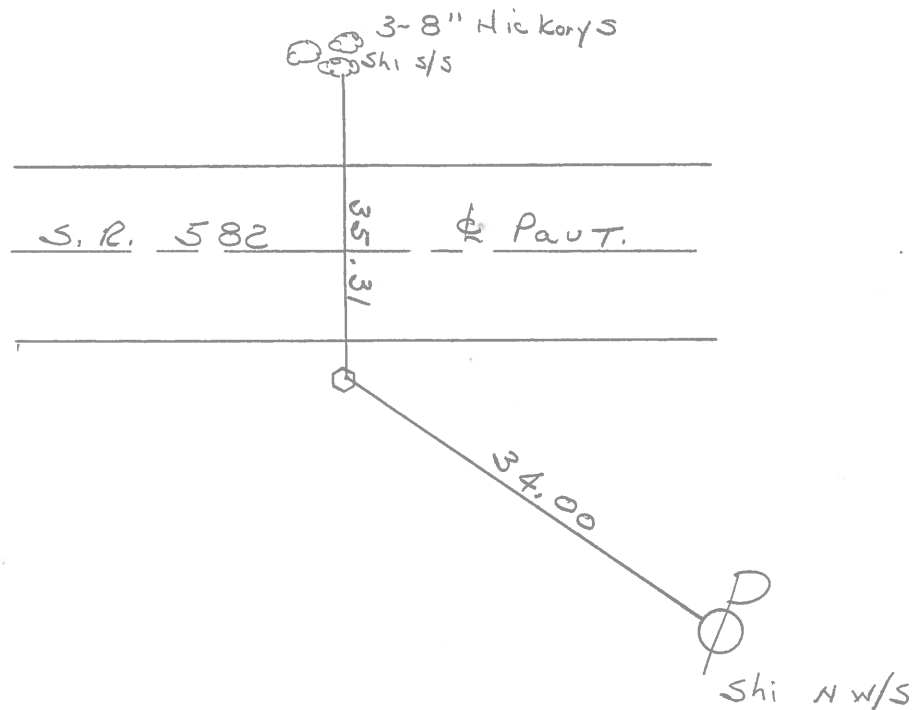


PERSONNEL TITLE PERSONNEL TITLE

COUNTY WoodDATE April, 17, 1969S. R. #582WEATHER CloudySEC. From I-75 to SR #199TEMP. +75°DESCRIPTION Ties to Control Points.JOB NO. 027300

LEFT

CENTER LINE

RIGHT

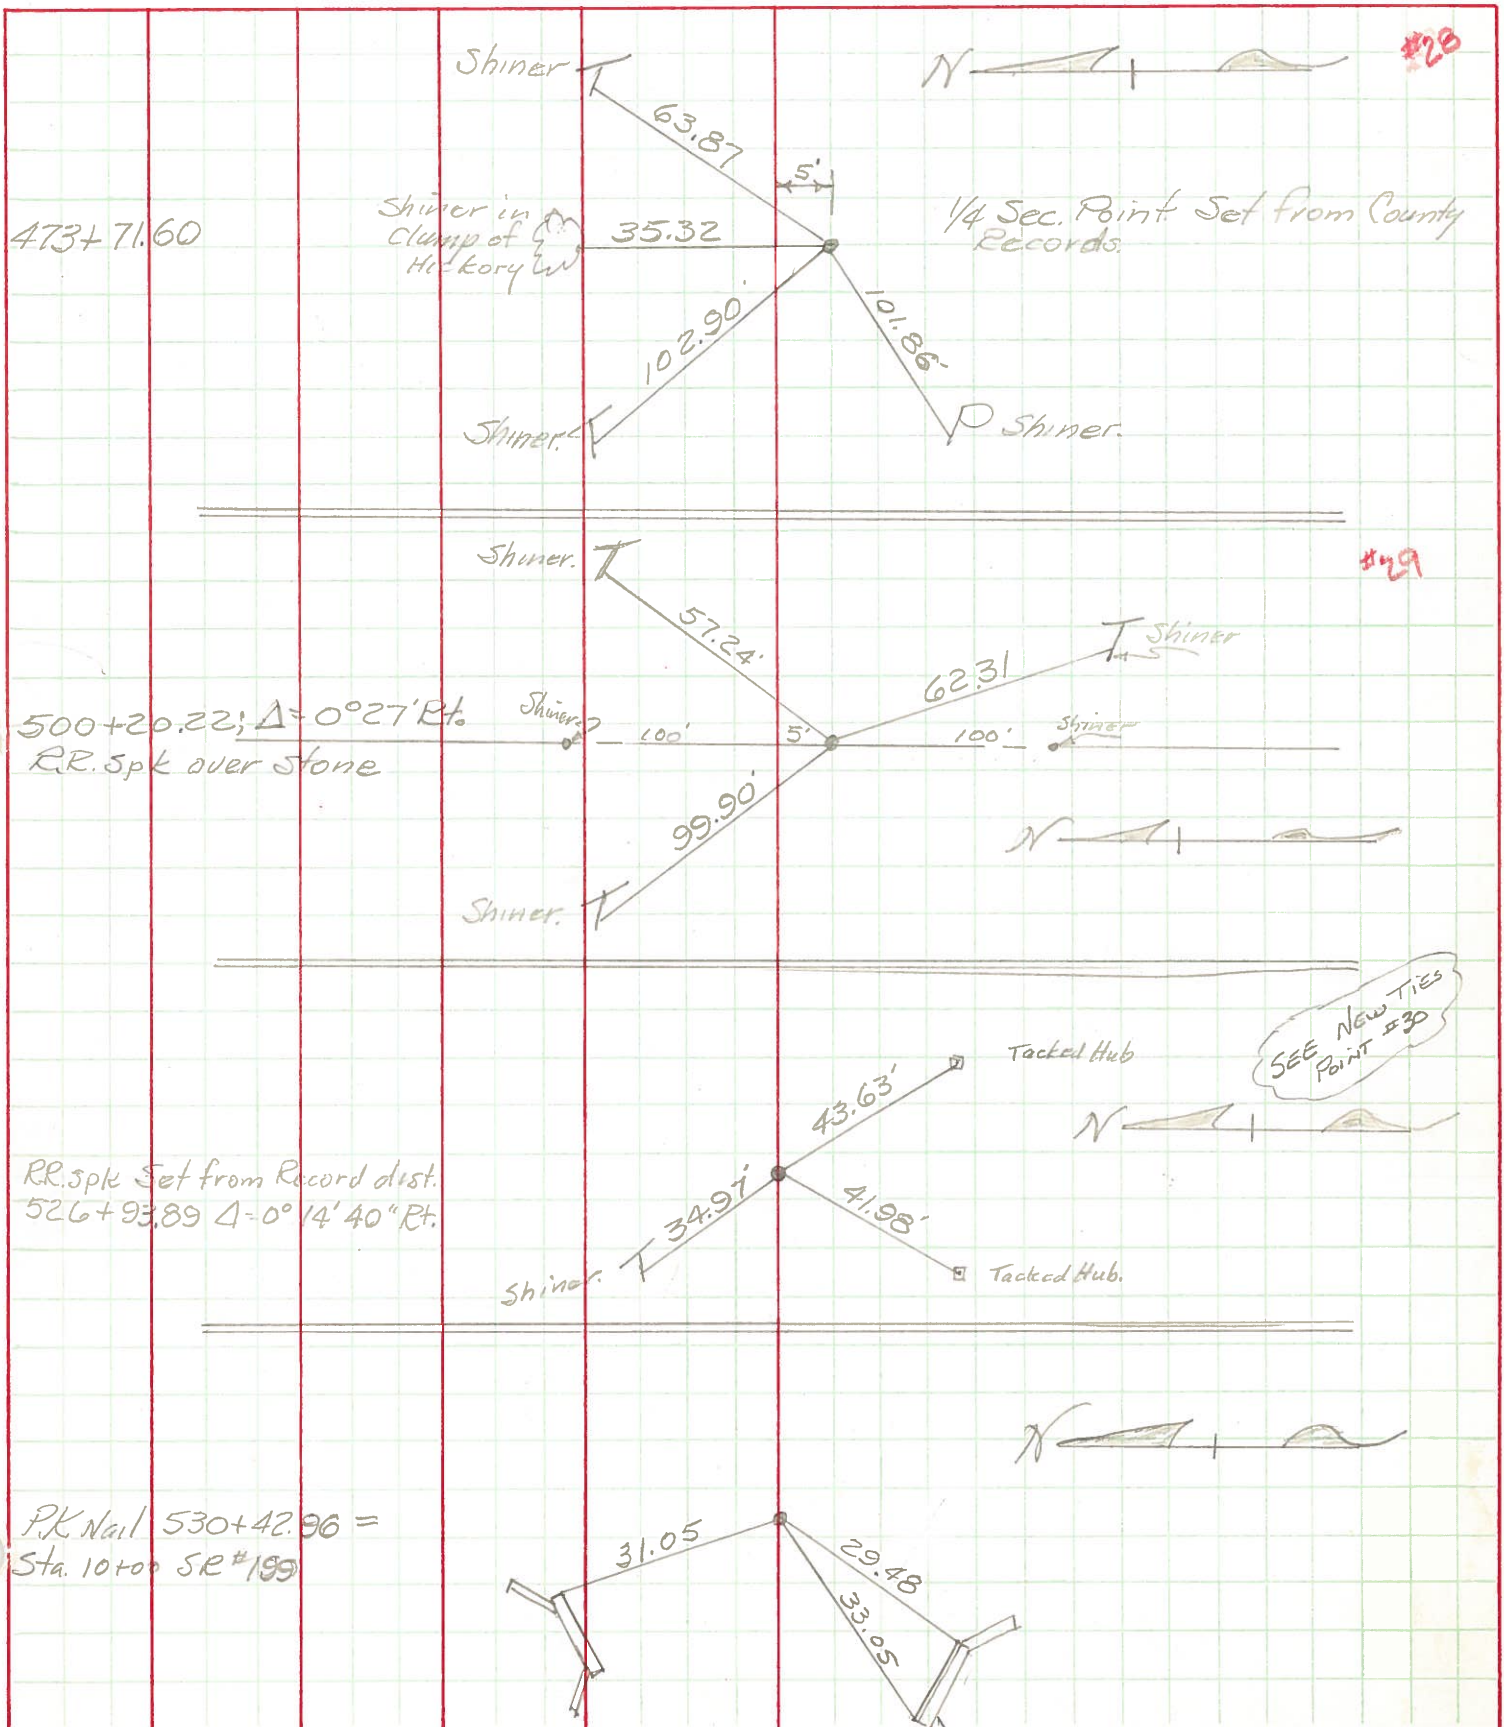

PERSONNEL	TITLE	PERSONNEL	TITLE
1	2	3	4
5	6	7	8
9	10	11	12
13	14	15	16
17	18	19	20
21	22	23	24
25	26	27	28
29	30	31	32
33	34	35	36
37	38	39	40
41	42	43	44
45	46	47	48
49	50	51	52
53	54	55	56
57	58	59	60
61	62	63	64
65	66	67	68
69	70	71	72
73	74	75	76
77	78	79	80
81	82	83	84
85	86	87	88
89	90	91	92
93	94	95	96
97	98	99	100

COUNTY Wood DATE April 17, 1940

S. R. 25 WEATHER 25

SEC. 1001751650-99 TEMP. +78°

DESCRIPTION Tree to Capital Point LEFT CENTER LINE RIGHT JOB NO. 007500

LEFT

CENTER LINE

RIGHT

