

O.D.O.T. DISTRICT 2 SURVEY OFFICE (USE ONLY)

PERSONNEL

REFERENCE NO. 31

SHEET 11 OF 21

NOTES JAMES

DATE 4/24/19

ROUTE SR 582

H.C. JAMES

WEATHER CLOUDY

COUNTY WOOD

R.C. LEU

TEMP. 55°

TOWNSHIP WEBSTER

SECTION 25

DWG BY BALBAUGH PID 81000

T 6 N R 11 E

TYPE MONUMENT MAG/WASHER

ON SURFACE - ~~BELOW~~ ON

OFFSET CL PAVEMENT 9.6' ~~LT~~ : RT

0.2' TO RT EDGE PAVEMENT


STATION: 554+32.24

HORZ.DATUM: NAD83 (2011)


GEOID: 2012A

GRID: NORTHING: 654006.583

EASTING: 1680251.676

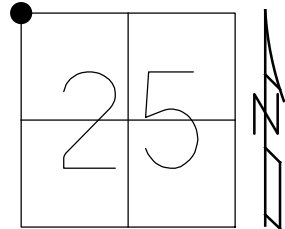

RECORD:
FD P.K./WASHER
4/19/05, MDB
FD 1" IPIN
10" DOWN
PROBED TO STONE
5' DOWN
SET 1" IPIN ATOP STONE
15" DOWN
5/20/05
SET MAG/WASHER
9/2/05, MDB
FD MONBOX
W/ 1" IPIN
NEWREF31
11/14/19, JLL

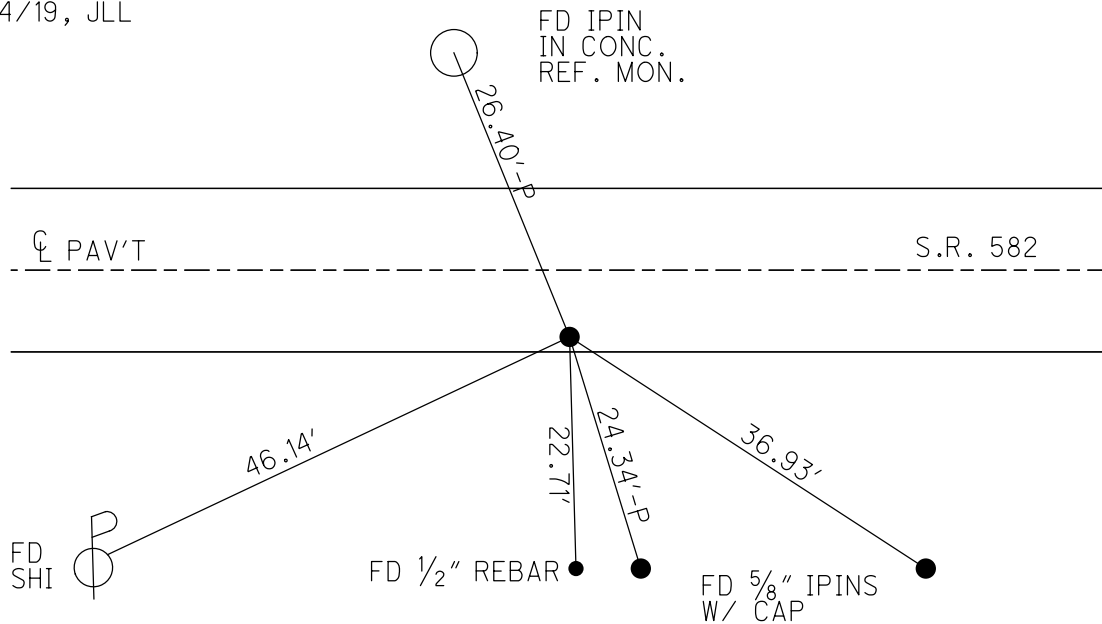

O.D.O.T. DISTRICT 2 SURVEY OFFICE

PERSONNEL

REFERENCE NO. 31

SHEET 10 OF 20

NOTES BARNHISEL

DATE 04/19/05

ROUTE S.R. 582

H.C. CANTERBURY

WEATHER CLOUDY

COUNTY WOOD

R.C. MIKLOVIC

TEMP. +55°

TOWNSHIP WEBSTER

SECTION 25

T 6 N R 11 E

TYPE MONUMENT PK & WASHER

ON SURFACE - ~~BELOW~~ YES


~~LEFT~~ - Q PAV'T - RIGHT 9.6'

0.2' TO RT EDGE PAVEMENT

S.L.M. 554+53


GRID: NORTHING:

EASTING:

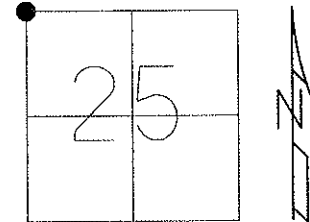

Note: On 05/20/05 dug down, fd 1" iron rod at 10", continued down 2.5' found nothing. We probed further down, found what we believed to be the stone around 5' down from surface. Reset 1" iron rod atop of assumed stone at same location as found. The 1" iron rod is 15" down from surface.

RESET MAG NAIL & WASHER
09/02/05
MDB

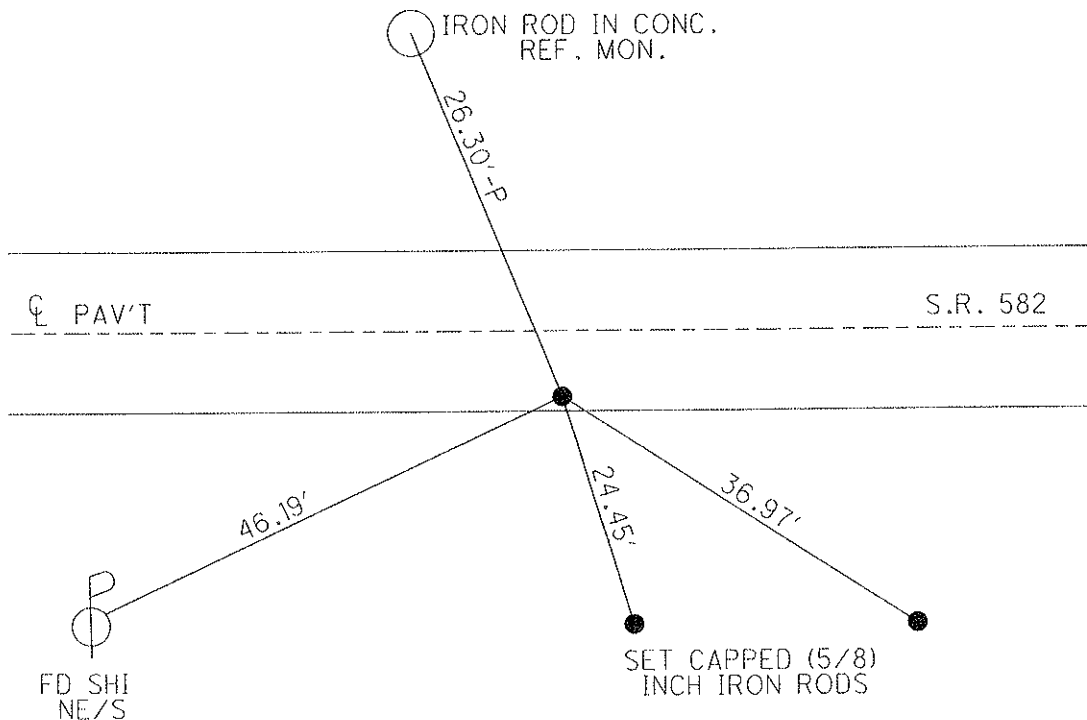

O.D.O.T. DISTRICT 2 SURVEY OFFICE

PERSONNEL

REFERENCE NO. 31

SHEET 11 OF 21

NOTES BARNHISEL

DATE 04/19/05

ROUTE S.R. 582

H.C. CANTERBURY

WEATHER CLOUDY

COUNTY WOOD

R.C. MIKLOVIC

TEMP. +55°

TOWNSHIP WEBSTER

SECTION 25

T 6 N R 11 E


TYPE MONUMENT PK & WASHER

ON SURFACE - ~~BELOW~~ YES

~~LEFT~~ - Q PAV'T - RIGHT 9.6'


0.2' RT OF RT EDGE PAVEMENT

S.L.M. 554+53

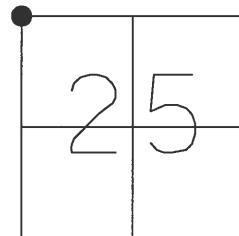

Note: On 05/20/05 dug down, fd 1" iron rod at 10", continued down 2.5' found nothing. We probed further down, found what we believed to be the stone around 5' down from surface. Reset 1" iron rod atop of assumed stone at same location as found. The 1" iron rod is 15" down from surface.

RESET MAG NAIL & WASHER
09/02/05
MDB

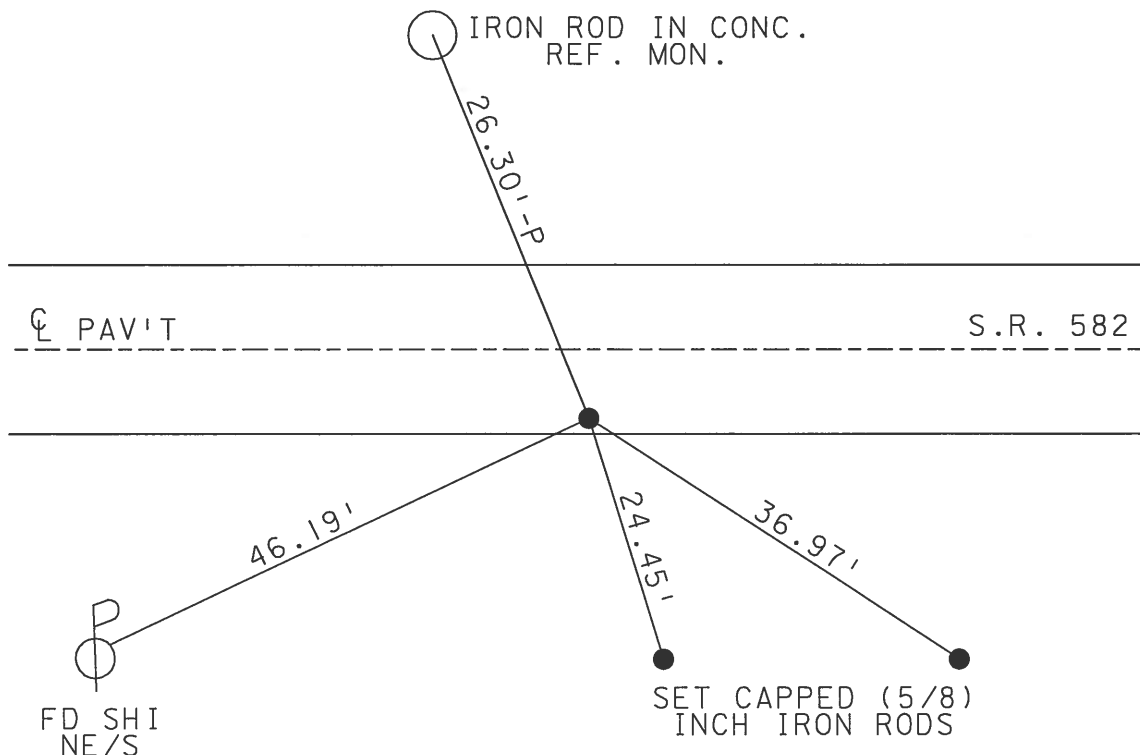

O.D.O.T. DISTRICT 2 SURVEY OFFICE

PERSONNEL

REFERENCE NO. 31

SHEET OF

NOTES LOEHKE

H.C. HOFFMAN

R.C. STEINHAUSER

BARNHISEL

DATE 7-12-90

WEATHER cloudy

TEMP. +70°

ROUTE S.R. 582

COUNTY Wood

TOWNSHIP Webster

SECTION 25

T 6 N R 11 E


TYPE MONUMENT R.R. Spike

ON SURFACE - BELOW Yes


LEFT - 0 PAV'T. - RIGHT 9.6


0.2 RT TO ET EDGE PAVEMENT

S.L.M. 554+53

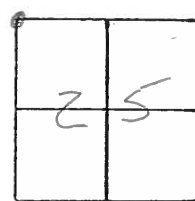


Set P.R. / WASHER
10-25-90
MB

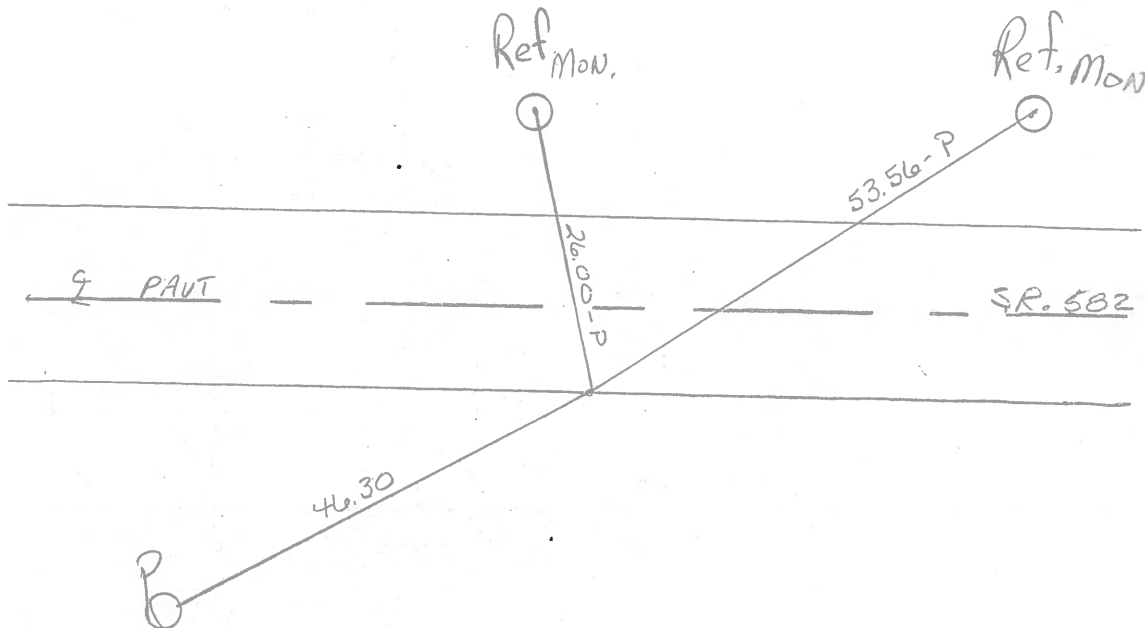

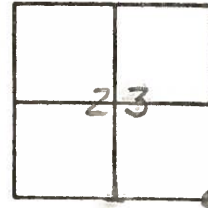County Wood S.R. 582Township WebsterSection 23T N, R EPersonnel J. StoneP. NeuseR. MichalakD. CurtisDate 13 July 83Weather WarmTemp. 85°

SLM Sta. 554+61

REF. NO. 31

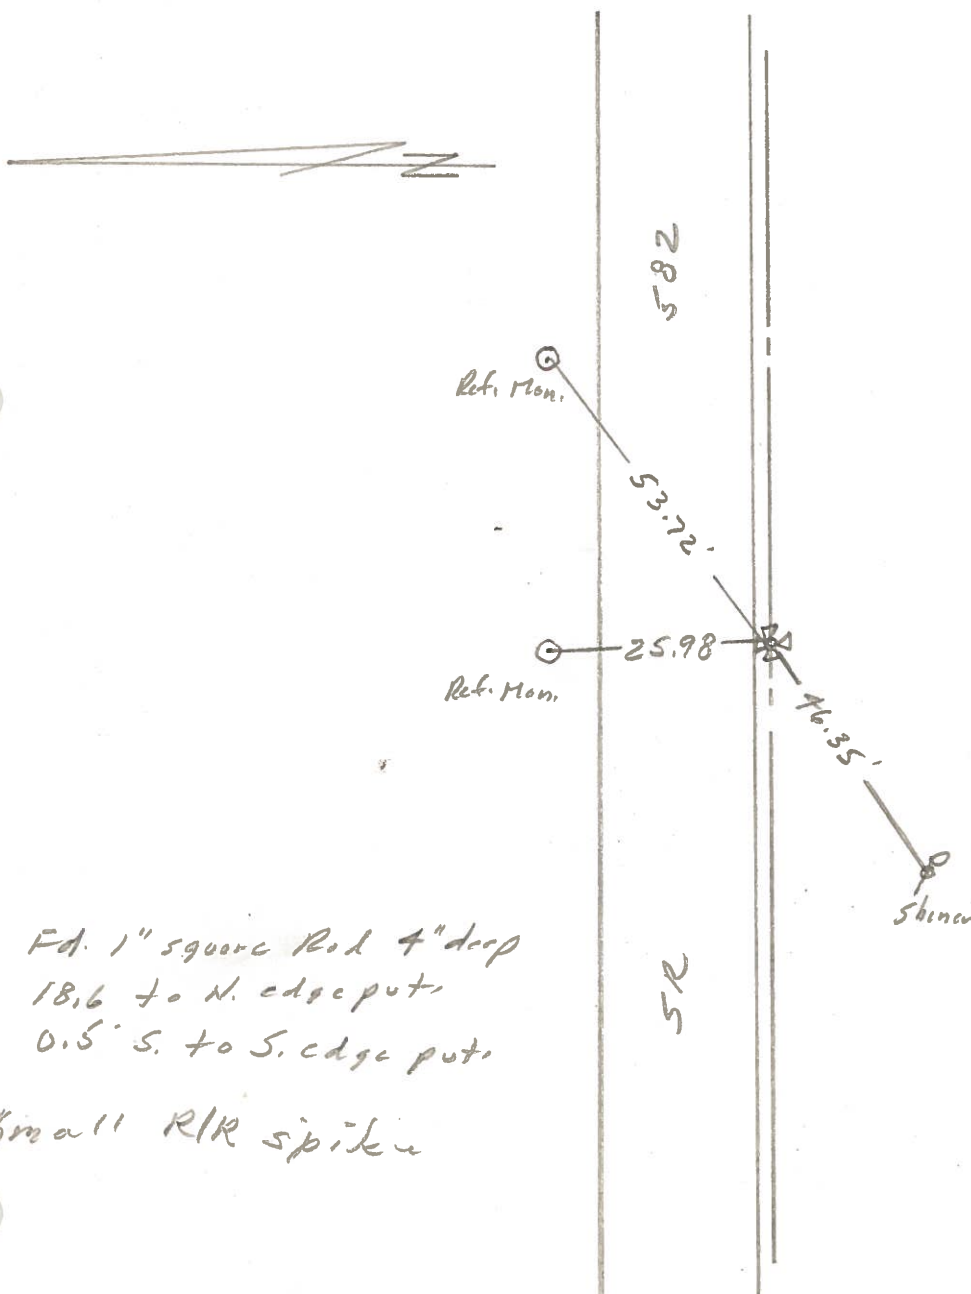

Q.D.O.T. DISTRICT 2 SURVEY OFFICE

SHEET 8 OF

County Wood S.R. 582

Township Webster

Section 23

T N, R E

Personnel J. Stone

P. Neuse


R. Michelak

D. Curtis

Date 13 July 83


Weather Warm

Temp. 85°

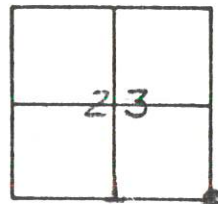

SLM Sta. 554+61

REF. NO. 31

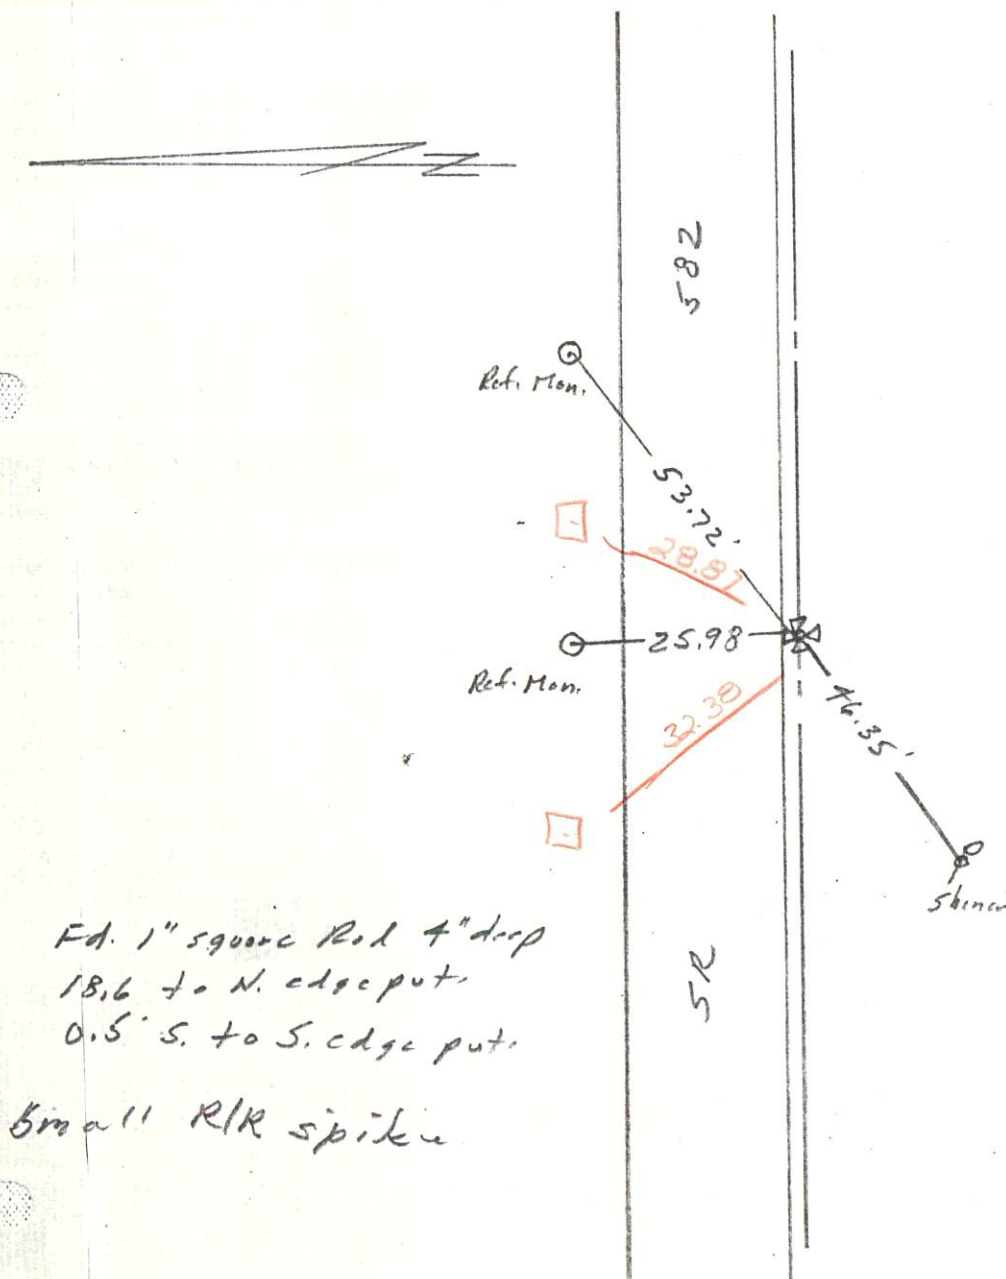

Q.D.O.T. DISTRICT 2 SURVEY OFFICE

SHEET 7 OF 7

County Wood S.R. 582

Township Webster

Section 26

T N, R E

Personnel J. Stone

P. Newser

R. Michalak

D. Curtis

Date 13 July 83


Weather Warm

Temp. 85°



SLM STA. 527+82

REF. NO. 30

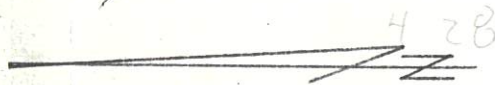

1. Pin in
Con. Mon.



63.20'

1. Pin in
Con. Mon.



26.45'

61.80'

1. Pin in
Con. Mon.



Fd. Iron Bolt
6' ± N. of E. pt.
1/4 Cor. Sec. 23/26

PERSONNEL	TITLE	PERSONNEL	TITLE	COUNTY	DATE	WEATHER	TEMP.
BURNSIDE				Wood	9-25-74	CLEAR	+70°
SMITH				S. R. 582			
BOWERS				SEC. S.E. COR. SEC. 23			
MEAD							

DESCRIPTION REF. TO SEC. CORNER JOB NO. _____

