

O.D.O.T. DISTRICT 2 SURVEY OFFICE

PERSONNEL

REFERENCE NO. 32

SHEET 11 OF 20

NOTES BARNHISEL

DATE 04/19/05

ROUTE S.R. 582

H.C. CANTERBURY

WEATHER CLOUDY

COUNTY WOOD

R.C. MIKLOVIC

TEMP. +60°

TOWNSHIP WEBSTER

SECTION 25

T 6 N R 11 E


TYPE MONUMENT PK & WASHER

ON SURFACE - BELOW YES

~~LEFT~~ - Q PAV'T - RIGHT 0.7'


9.1' TO RT EDGE PAVEMENT

S.L.M. 581+13

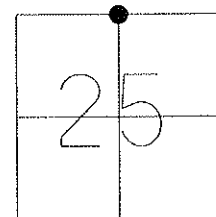

GRID: NORTHING:

EASTING:

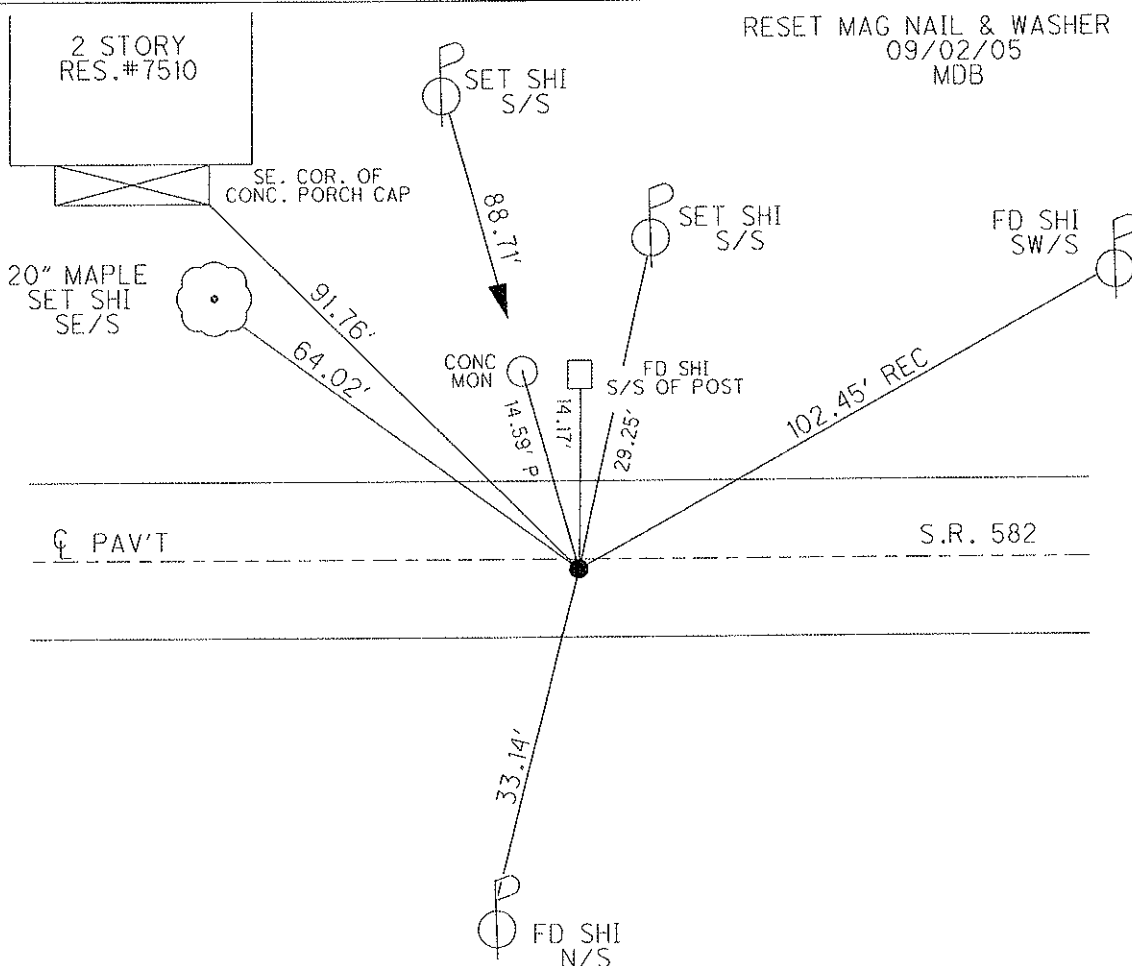

O.D.O.T. DISTRICT 2 SURVEY OFFICE

PERSONNEL

REFERENCE NO. 32

SHEET 12 OF 21

NOTES BARNHISEL

DATE 04/19/05

ROUTE S.R. 582

H.C. CANTERBURY

WEATHER CLOUDY

COUNTY WOOD

R.C. MIKLOVIC

TEMP. +60°

TOWNSHIP WEBSTER

SECTION 25

T 6 N R 11 E



TYPE MONUMENT PK & WASHER

ON SURFACE - ~~BELOW~~ YES

~~LEFT~~ - Q PAV'T - RIGHT 0.7'

9.1' TO RT EDGE PAVEMENT

S.L.M. 581+13

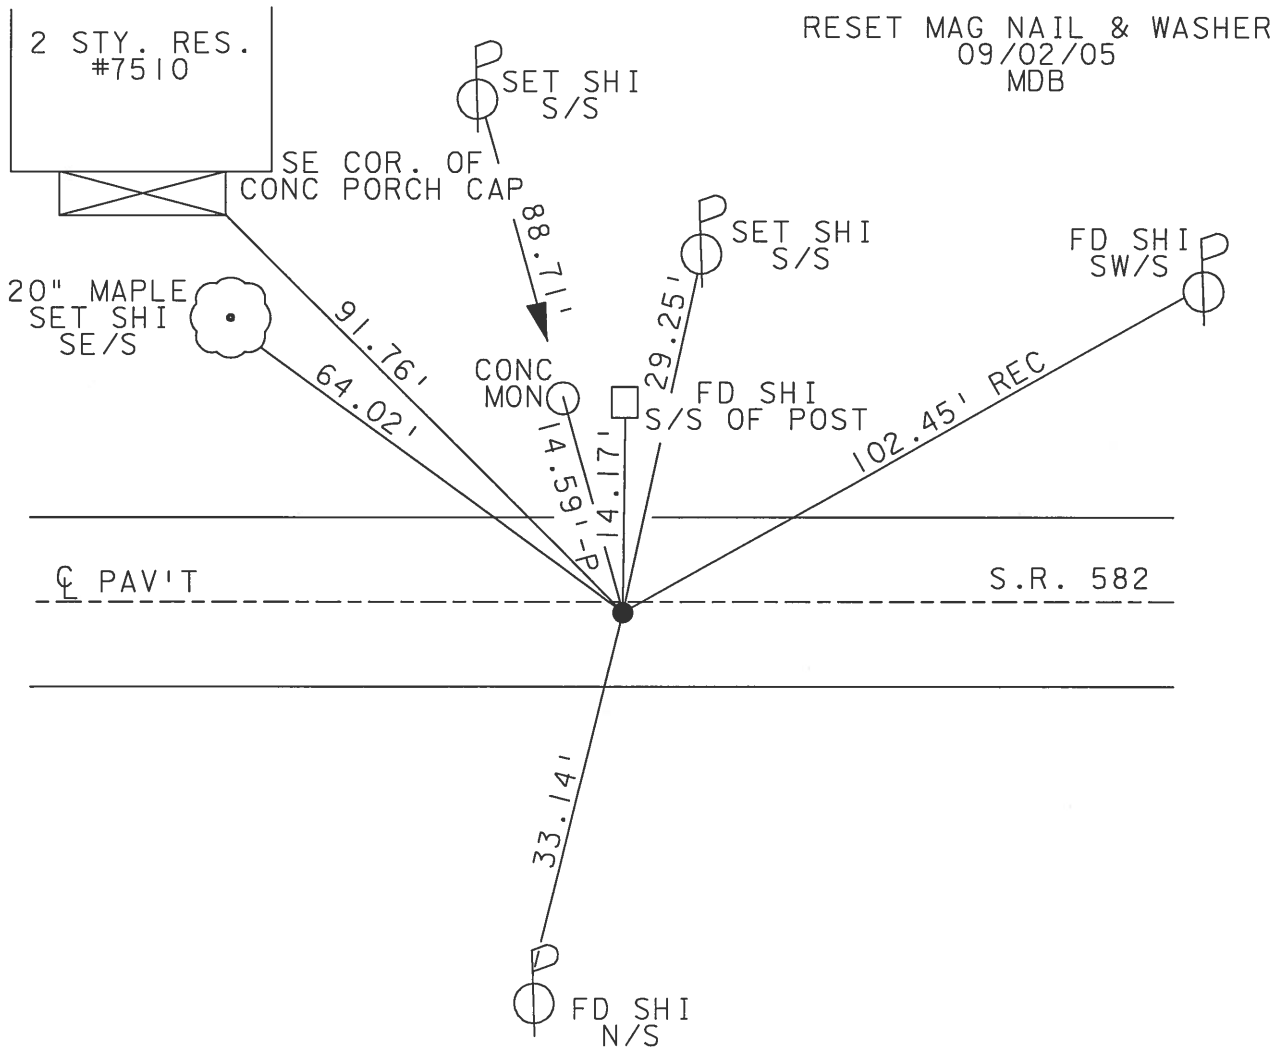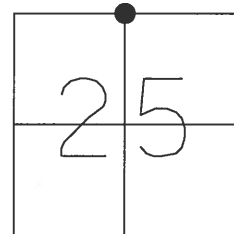

O.D.O.T. DISTRICT 2 SURVEY OFFICE

PERSONNEL

REFERENCE NO. 32

SHEET OF

NOTES LOGHRKE

H.C. HOFFMAN

DATE 7-12-90

ROUTE S.R. 582

R.C. STEINHAUSER

WEATHER cloudy

COUNTY WOOD

BAERNHISEL

TEMP. +70°

TOWNSHIP Webster

SECTION 25

T. 6 N R. 11 E


TYPE MONUMENT (Hex) Bolt

ON SURFACE - BELOW 3"

LEFT - & PAV'T. - RIGHT 0.7

9.1 TO RT EDGE PAVEMENT


S.L.M. 581+13

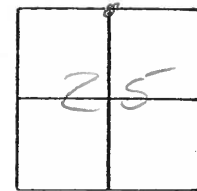

2 Story #7510
WOOD FRAME
RES.

SE CORNER
of CONC Cap
of Porch

Set P.K. Mulashee
10-25-90
m/b

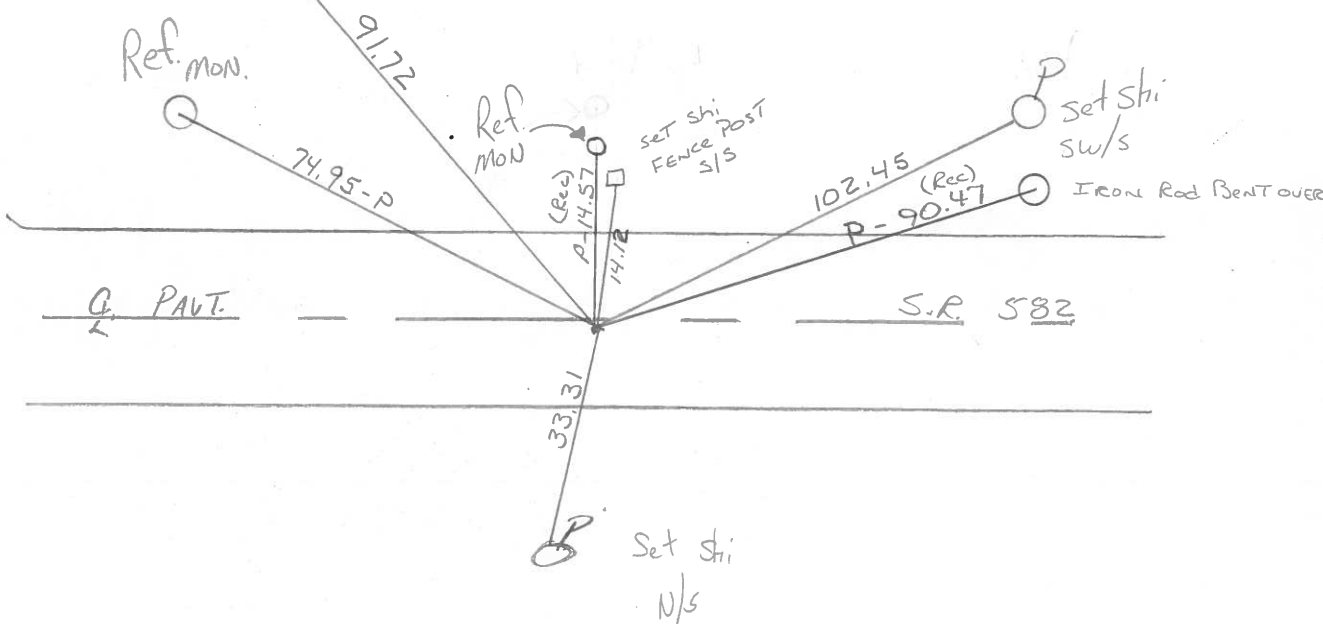

Q.D.O.T. DISTRICT 2 SURVEY OFFICE

SHEET 9 OF

County Wood S.R. 582

Township Webster

Section 24

T N, R E

Personnel I. Stone

P. Neuse


R. Michalak

D. Lottis

Date 13 July 83


Weather Warm

Temp. 80°

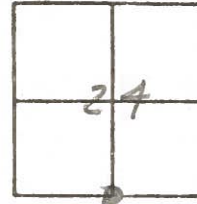

SLM Sta. 581 + 21

REF. No. 32

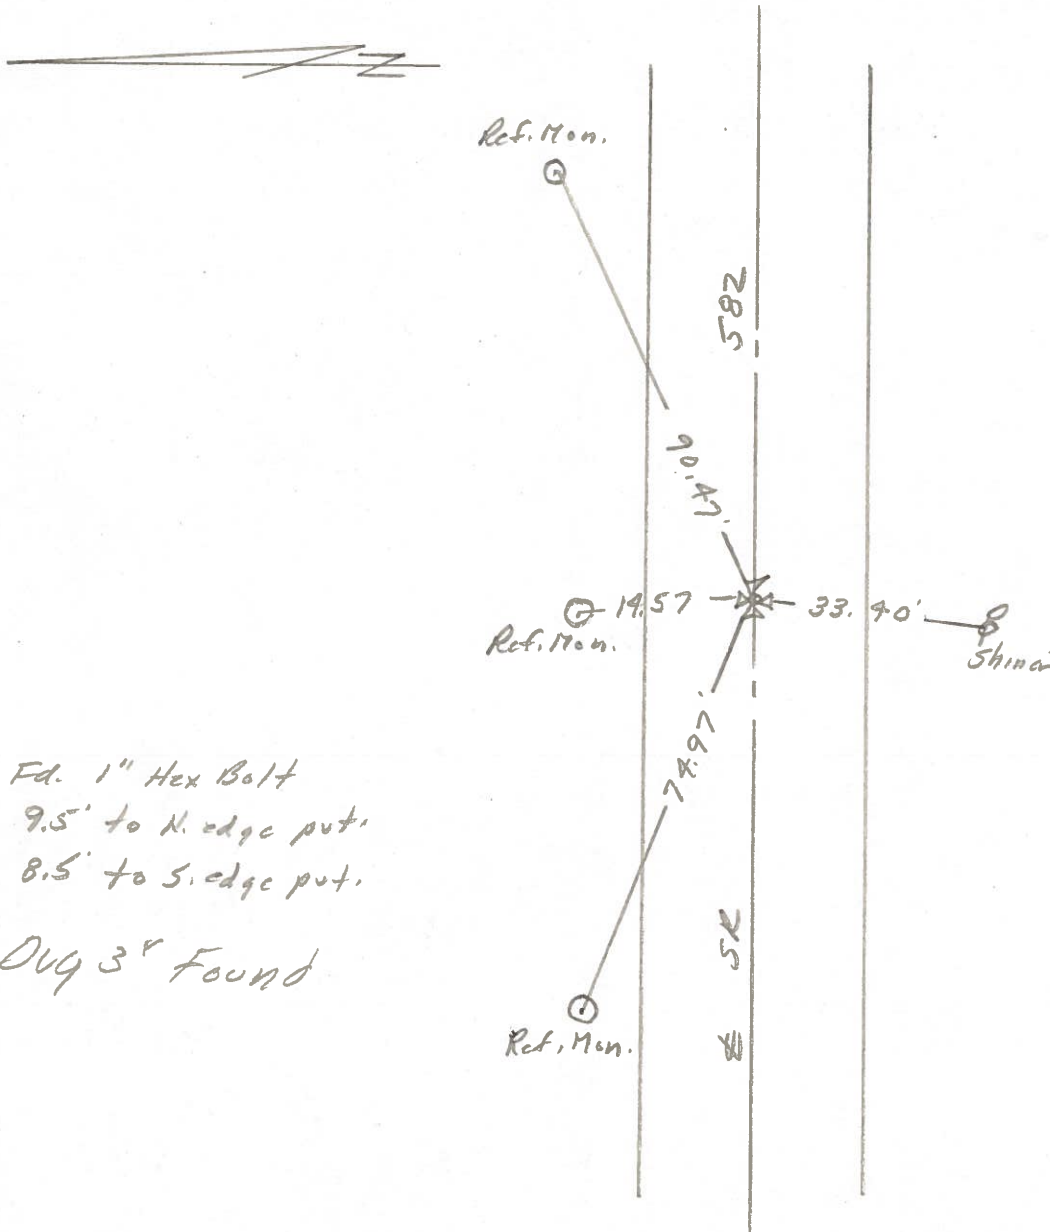

SHEET 9 OF

Date 13 July 83

Weather Windy

Temp. 80°


2	7

N
A

27

D. Curtis

REF. No. 32

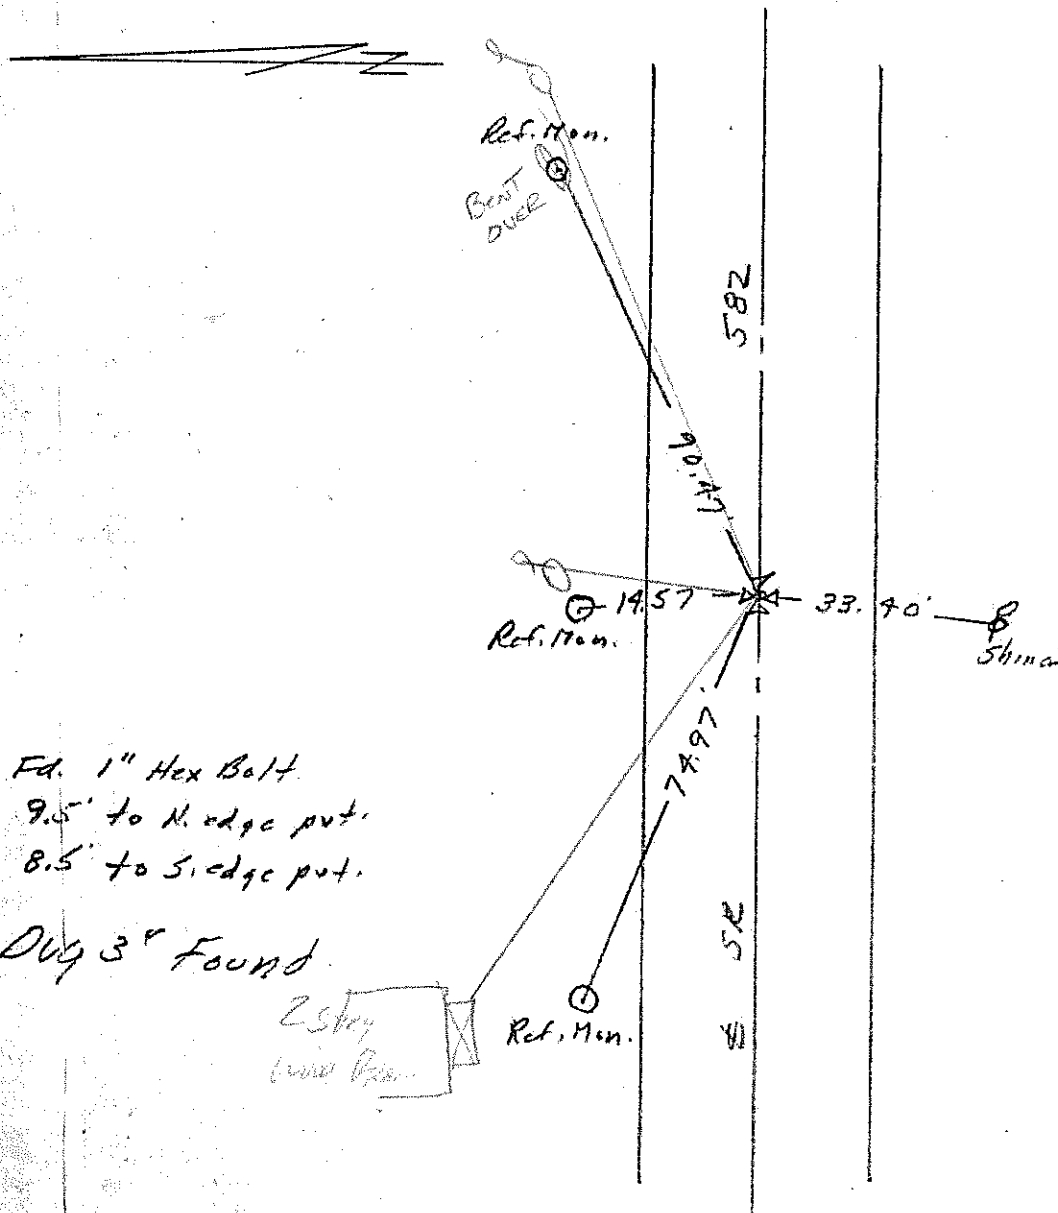

PERSONNEL	TITLE	PERSONNEL	TITLE
BURNSIDE			
SMITH			
BOWERS			
MEAD			

COUNTY WOOD DATE 9-25-74

S. R. 582 WEATHER CLEAR

SEC. 24 TEMP. +70°

DESCRIPTION REF. TO SEC. CORNER. JOB NO. _____

