

O.D.O.T. DISTRICT 2 SURVEY OFFICE

PERSONNEL

REFERENCE NO. 33

SHEET 12 OF 20

NOTES BARNHISEL

DATE 05/20/05

ROUTE S.R. 582

H.C. CANTERBURY

WEATHER CLOUDY

COUNTY WOOD

R.C. MIKLOVIC

TEMP. +60°

TOWNSHIP WEBSTER

SECTION 30

T 6 N R 11 E


TYPE MONUMENT PK NAIL

ON SURFACE - ~~BELOW~~ ON

~~LEFT~~ - CL PAV'T - RIGHT 1.9'


TO EDGE PAVEMENT

S.L.M. 607+83

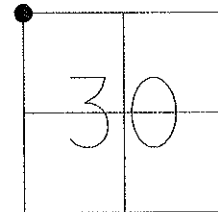

GRID: NORTHING:

EASTING:

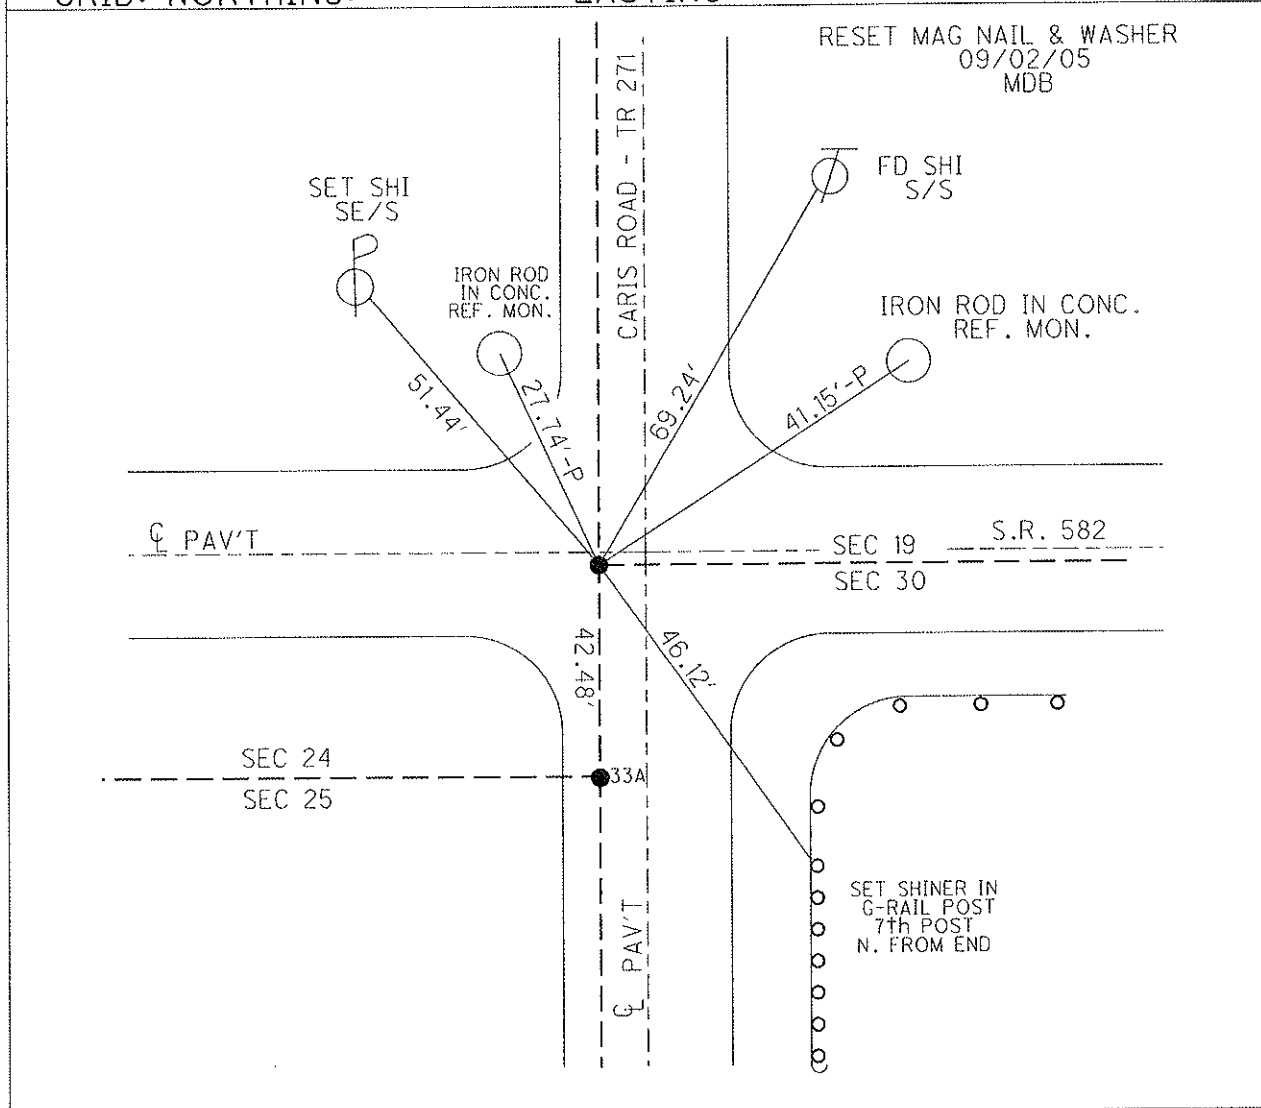

O.D.O.T. DISTRICT 2 SURVEY OFFICE

PERSONNEL

REFERENCE NO. 33

SHEET OF

NOTES LOEHRKE

H.C. HOFFMAN

DATE 7-12-90

ROUTE S.R. 582

R.C. STEINHAUSER

WEATHER cloudy

COUNTY WOOD

BARNHISEL

TEMP. +70°

TOWNSHIP Webster

SECTION 30

T. 6 N. R. 17 E.


TYPE MONUMENT R.R. Spike

ON SURFACE - BELOW 1 1/2"


LEFT - CL PAV'T. - RIGHT 1.0' / 4' W & Road to South

- TO - EDGE PAVEMENT

S.L.M. 607 + 83

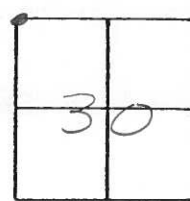

Set P.K. & Washer
10-25-90
MB

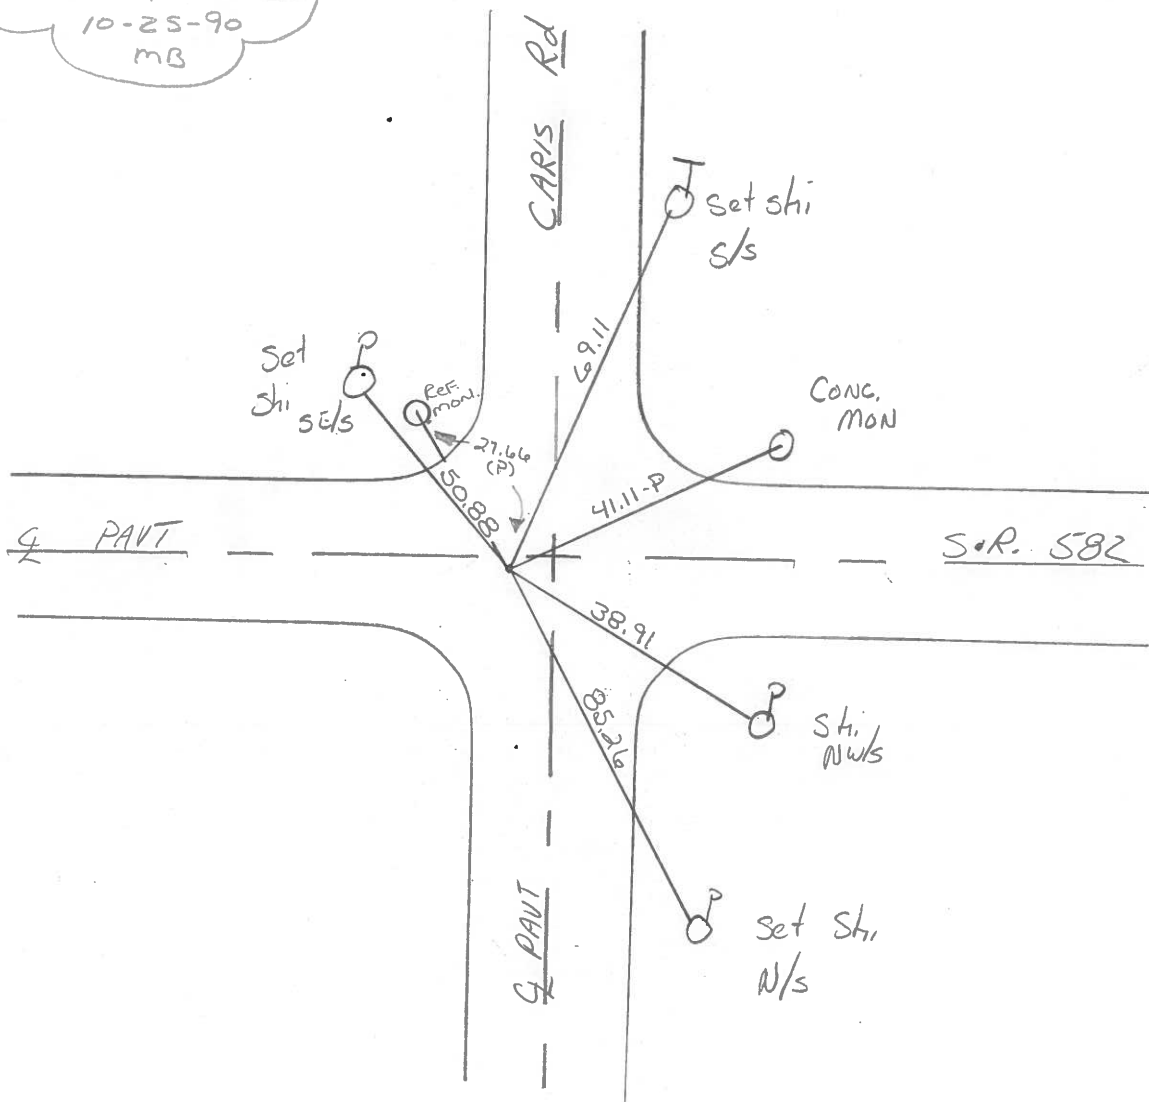

Q.D.O.T. DISTRICT 2 SURVEY OFFICE

SHEET 10 OF

County Wood S.R. 582

Township Webster

Section 19-24-25-30

T N, R E

Personnel I. Stone

P. Neuser

R. Michalak

D. Curtis

Date 12 July 82

Weather Warm


Temp. 85°

24	19
25	30



SLM Sta. 607 + 89

REF. NO. 33

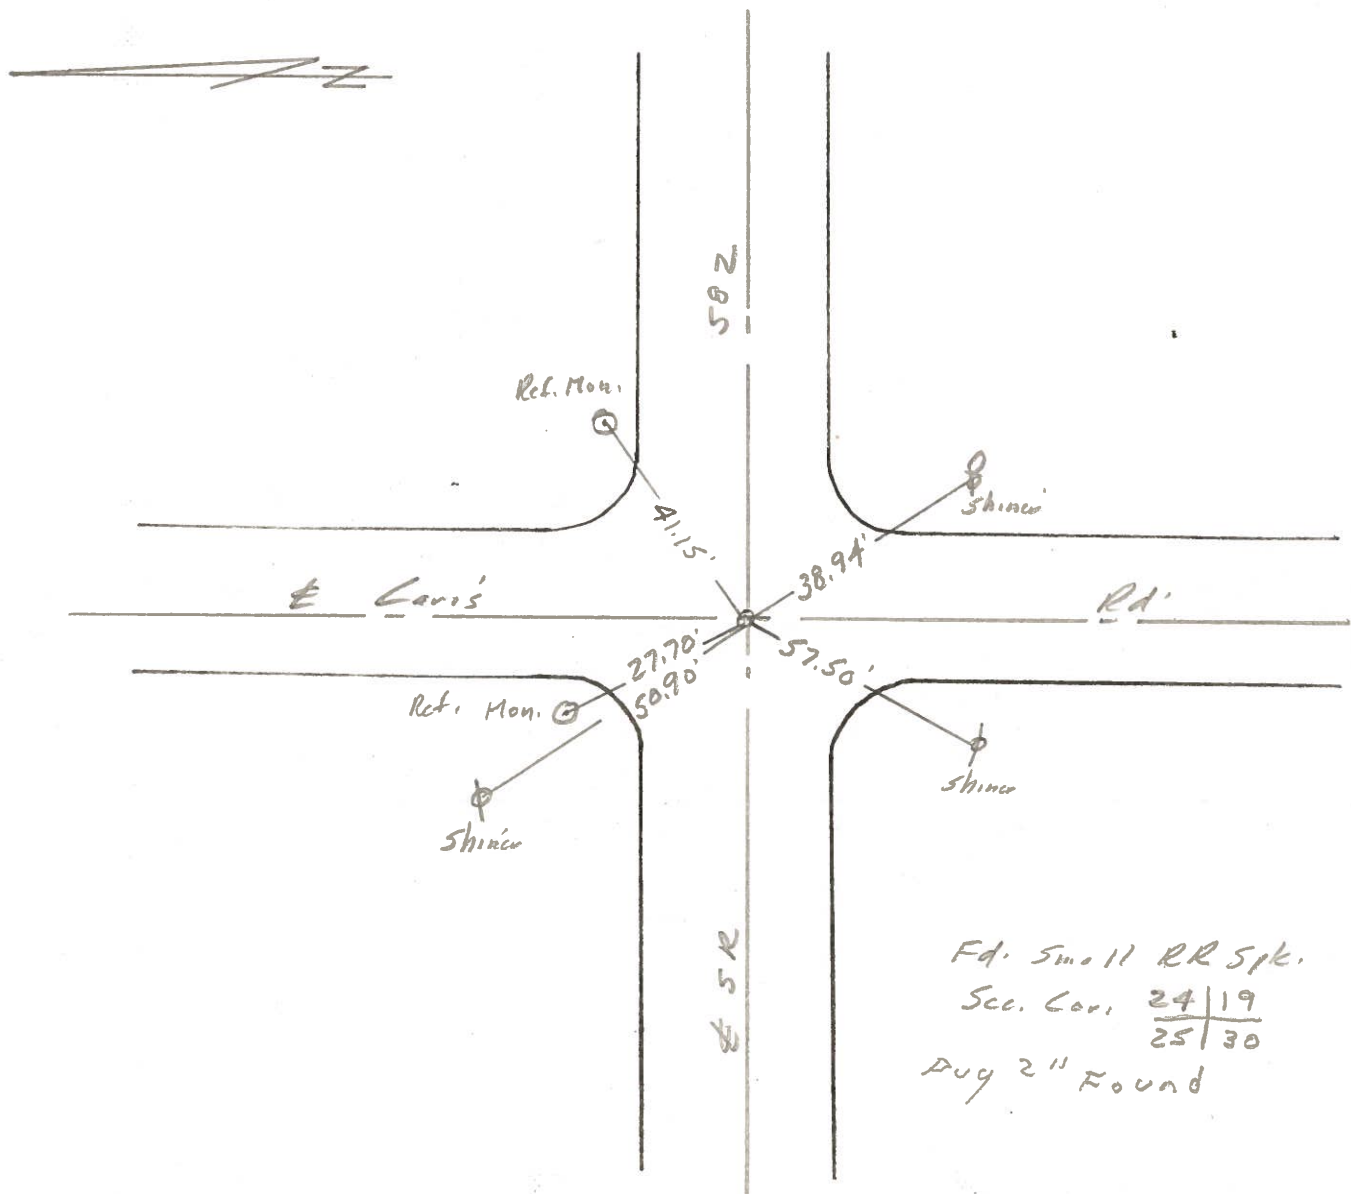

Q.D.O.T. DISTRICT 2 SURVEY OFFICE

SHEET 10 OF

County Wood S.R. 582

Date 12 July 82

Township Webster

Weather Warm

Section 19-24-25-30

Temp. 85°

T N, R E

Personnel I. Stone

24	19
25	30




P. Newser

R. Michalak


D. Curtis

SLM Sta. 607 +89
+83

REF. No. 33

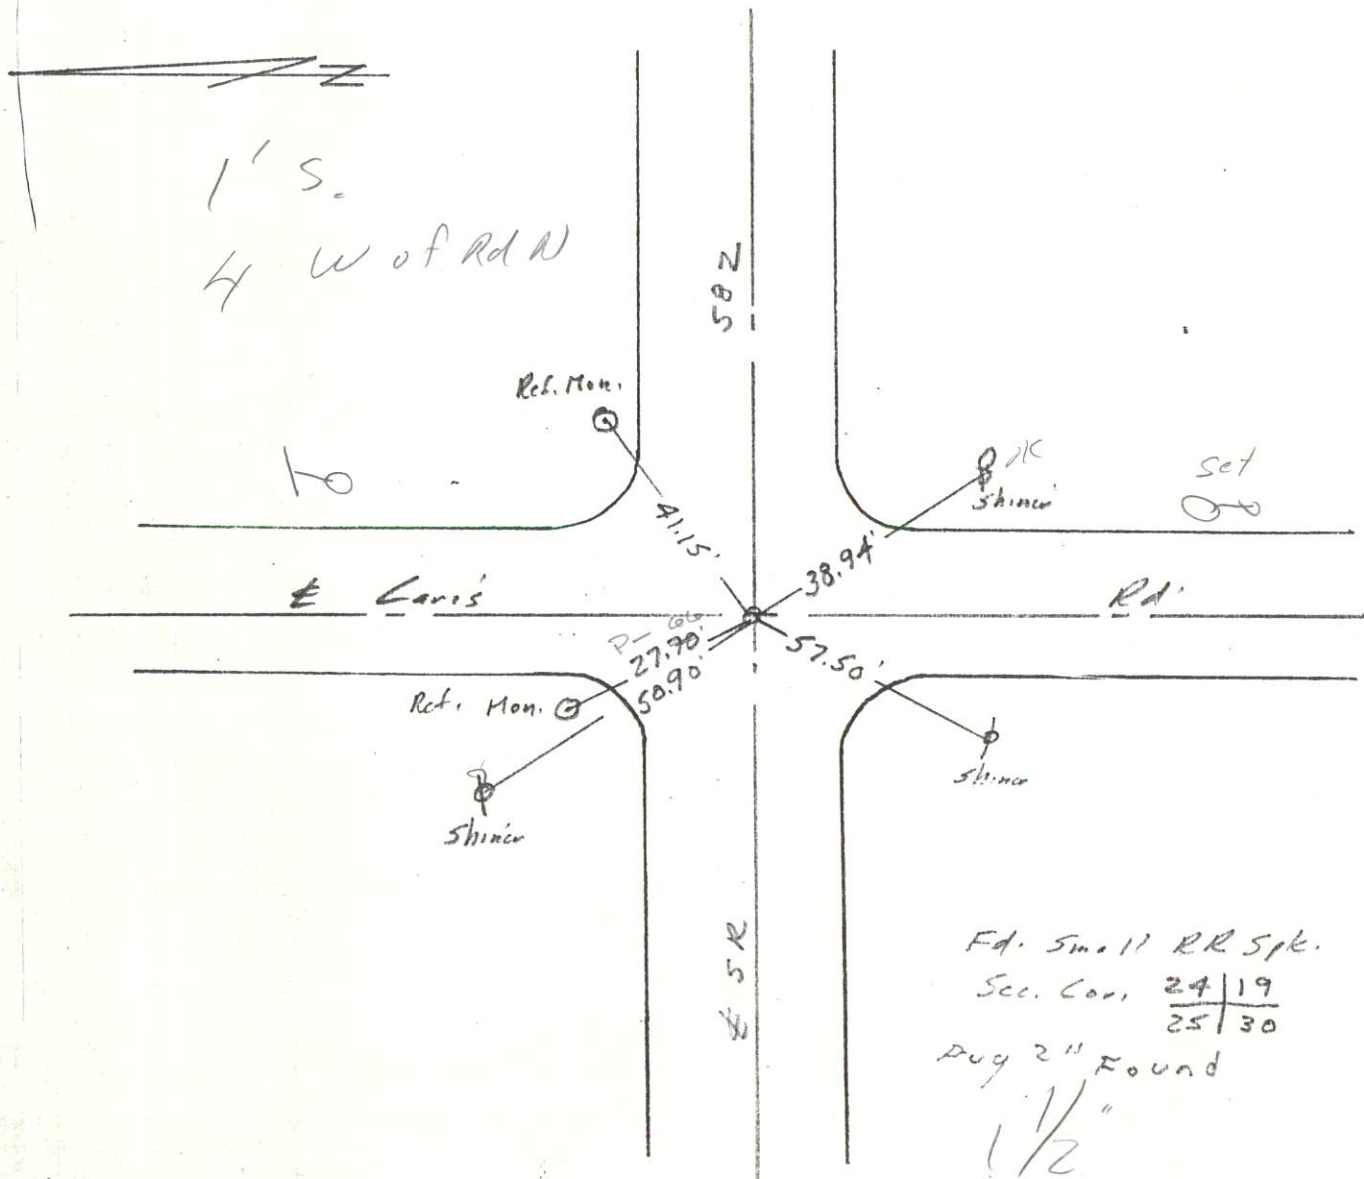

PERSONNEL TITLE PERSONNEL TITLE

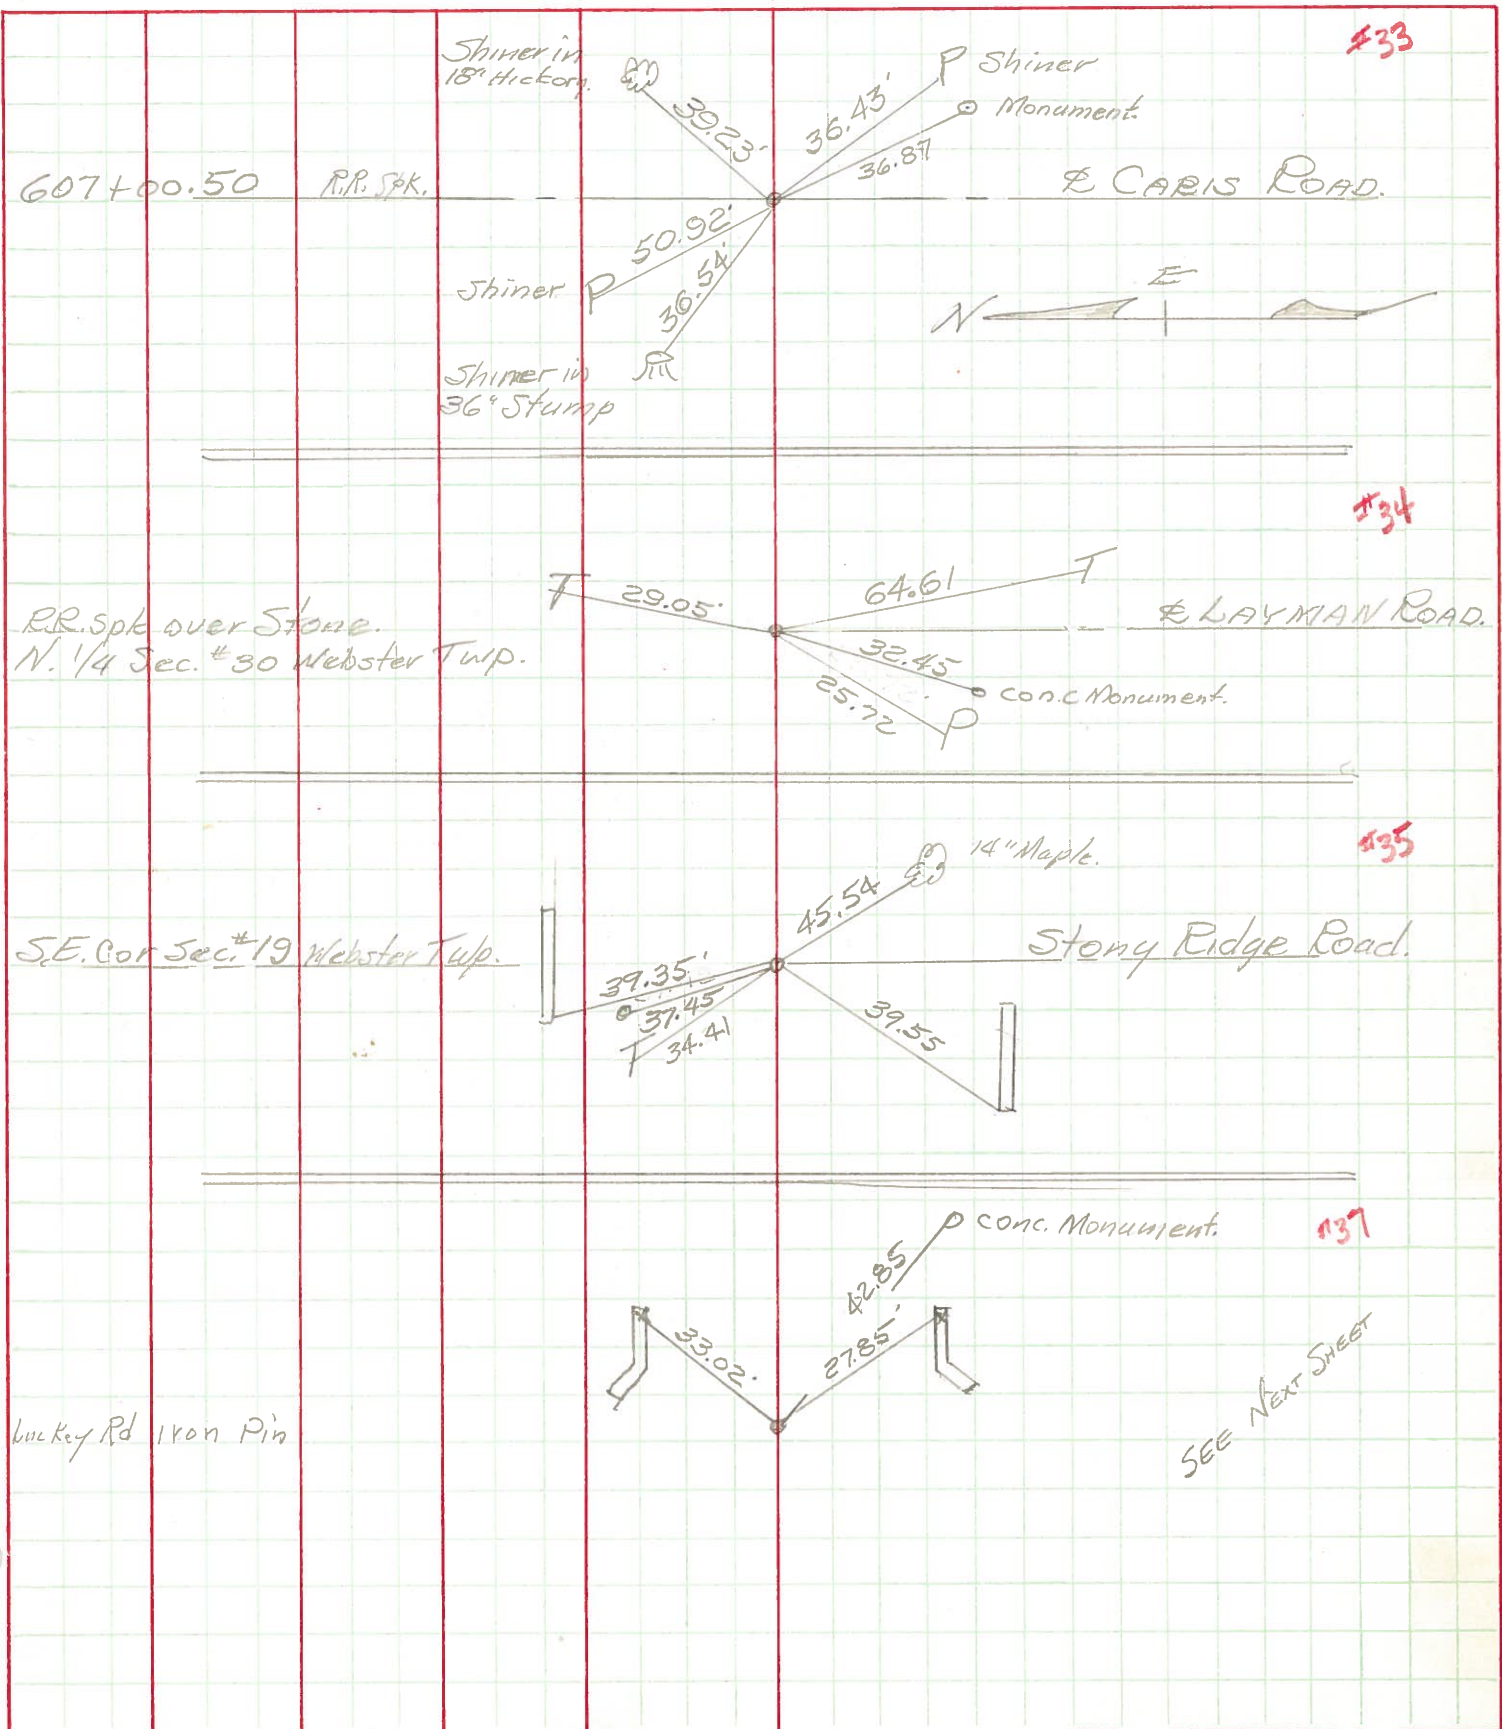COUNTY Wood. DATE April, 17, 1969S. R. #582 WEATHER Cloudy & WindySEC. 199 East. TEMP. +70°DESCRIPTION Ties to Control Points JOB NO. _____

PERSONNEL

TITLE

PERSONNEL

TITLE

COUNTY

Wood

DATE

12-27-57

S. R.

#582

WEATHER

Grorden 4-4-60

SEC.

TEMP.

DESCRIPTION

LEFT

CENTER LINE

RIGHT

JOB NO.

Stone wit.

(10) Co. record (Caris Rd)

R.R. Spk. (2" below part.) #456

9/14/65

33

S.E. cor. sec. 24-6-11

Webster Twp. Fd. P.K.

Stone 2.0' deep 9/14/65

(2) Co. record

42.50' S. of Caris Rd. Inter.

#456-A

33A

N. 1/4 post. sec. 30 Webster
Twp. (Layman Rd.)

R.R. Spk. over Stone

R.R. Spk. (1" below part.)

9/14/65

#457 34

S.E. cor. sec. 19 Webster
Twp. (Stony Ridge Rd.)

R.R. spike

R.R. Spk. (1" below part.)

9/14/65

#458

35

Shiner in P. Pole S.S.E. 87.45'

Shiner in 18" Hickory N.E. 39.22'

Shiner in 36" ^{stump} Catalpa N.W. 36.50'

New Culvert (Hend of W. Bridge Girder 13.40' 13.5'

(Hend of E. Bridge Girder 17.35' 17.6'

Conc. mon. S.E. 37.0'

Shiner in P.P. N.W. 50.92' 50.95'

Shiner in P.P. S.E. 36.45'

S. point of S.E. wing 19.0'

S. point of S.W. wing 13.5'

Conc. monument N.E. 25.55'

Conc. monument N.W. 12.8'

Sh. in P. Pole S.S.E. 46.45'

Sh. 18" Hickory N.N.E. 74.45'

Shiner Tele. Pole S.E. 64.60'

Conc. mon. S.E. 48.9'

Conc. mon. S.W. 32.45' 32.47'

X in N.E. Cor. C.B. Twp. N.E. 21.40' 21.37'

Shiner in P. Pole S.W. 25.67'

Shiner in Tele Pole N.E. 28.75'

Conc. marker N.W. 37.36' 40'

Round ditch marker S.W. 35.58' 60'

E. point Conc. coping on S.E. wing 45'

S.W. 33.76'

N.W. Cor. Conc. coping on S

bulkhead S.W. 39.57' 59'

S.W. Cor. Conc. coping on N

bulkhead N.W. 39.35'

E. point Conc. coping on N.E

wing N.W. 31.37'

S.E. Shiner 14" Maple 45.55' 45.61'

N.W. Shiner Tele. Pole 34.40'

PERSONNEL	TITLE	PERSONNEL	TITLE

COUNTY Wood DATE 12-27-57
Grorden 4-4-60
 S. R. #582 WEATHER _____
 SEC. _____ TEMP. _____

DESCRIPTION	LEFT	CENTER LINE	RIGHT	JOB NO.
Stone wit.			Shiner in P. Pole S.S.E. 87.45'	
(10) - Co. record (Caris Rd)			Shiner in 18" Hickory N.E. 39.22'	
#456			Shiner in 36" Catalpa N.W. 36.50'	
33			N. end of W. Bridge Girder 13.40' + 3.5'	
S.E. cor. sec. 24-6-11			N. end of E. Bridge Girder 17.35' + 7.6'	
Webster twp.			Conc. mon. S.E. 37.0'	
Stone 2.0' deep			Shiner in P.P. N.W. 50.92' 50.95'	
(2) - Co. record				
#456			S. point of S.E. wing 19.0'	
33A			S. point of S.W. wing 13.5'	
N. 1/4 post sec. 30 Webster			Conc. monument N.E. 25.35'	
Twp. (Layman Rd.)			Conc. monument N.W. 12.8'	
E.R. spok. over stone				
#457			Shiner Tele. Pole S.E. 64.60'	
34			Conc. mon. S.E. 48.9'	
S.E. cor. sec. 19 Webster			Conc. mon. S.W. 32.45' 32.49'	
Twp. (Stony Ridge Rd.)			X in N.E. Cor. C.B. Tap. N.E. 21.40' 21.37'	
E.R. spike			Shiner in P. Pole S.W. 25.67'	
#458			Shiner in Tele. Pole N.E. 28.75'	
35			Conc. marker N.W. 37.36'	
			Round ditch marker S.W. 35.68'	
			E. point Conc. Coping on S.E. Wing S.W. 33.40'	
			N.W. Cor. Conc. Coping on S. bulkhead S.W. 39.57'	
			S.W. Cor. Conc. Coping on N. bulkhead N.W. 39.35'	
			E. point Conc. Coping on N.E. wing N.W. 31.37'	
			S.E. Shiner 14" Maple 45.61'	
			N.W. Shiner Tele. Pole 34.40'	