

O.D.O.T. DISTRICT 2 SURVEY OFFICE (USE ONLY)

PERSONNEL

REFERENCE NO. 36

SHEET 17 OF 21

NOTES MILLER

DATE 10/1/24

ROUTE SR 582

H.C. MILLER

WEATHER CLOUDY

COUNTY WOOD

R.C. BARRIERE

TEMP. 71°

TOWNSHIP WEBSTER

SECTION 29

DWG BY PRESTON-COLVIN PID PAVING TRAIN

T 6 N R 11 E

TYPE MONUMENT LG RR SPIKE

ON SURFACE - ~~BELOW~~ ON

OFFSET CL PAVEMENT 6.3' ~~LT~~ : RT

9' TO LT EDGE PAVEMENT

STATION: 663+35.82

HORIZ.DATUM: NAD83 (2011)


GEOID: NAVD88 2018

GRID: NORTHING: 653833.779


EASTING: 1693825.223

LDP: NORTHING: 476221.69

EASTING: 204587.511

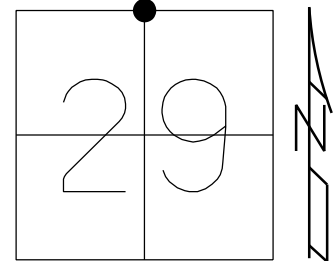

SET MAG/WASHER
9/02/05, MDB
FD MAG SHANK
REF36
10-2-2020, DSA
SET LG.R.R.SPIKE
12-3-2020, DSA
FD LG RR SPIKE
10/1/24, JAM
SET MAG/WASHER
10/10/24, TDN

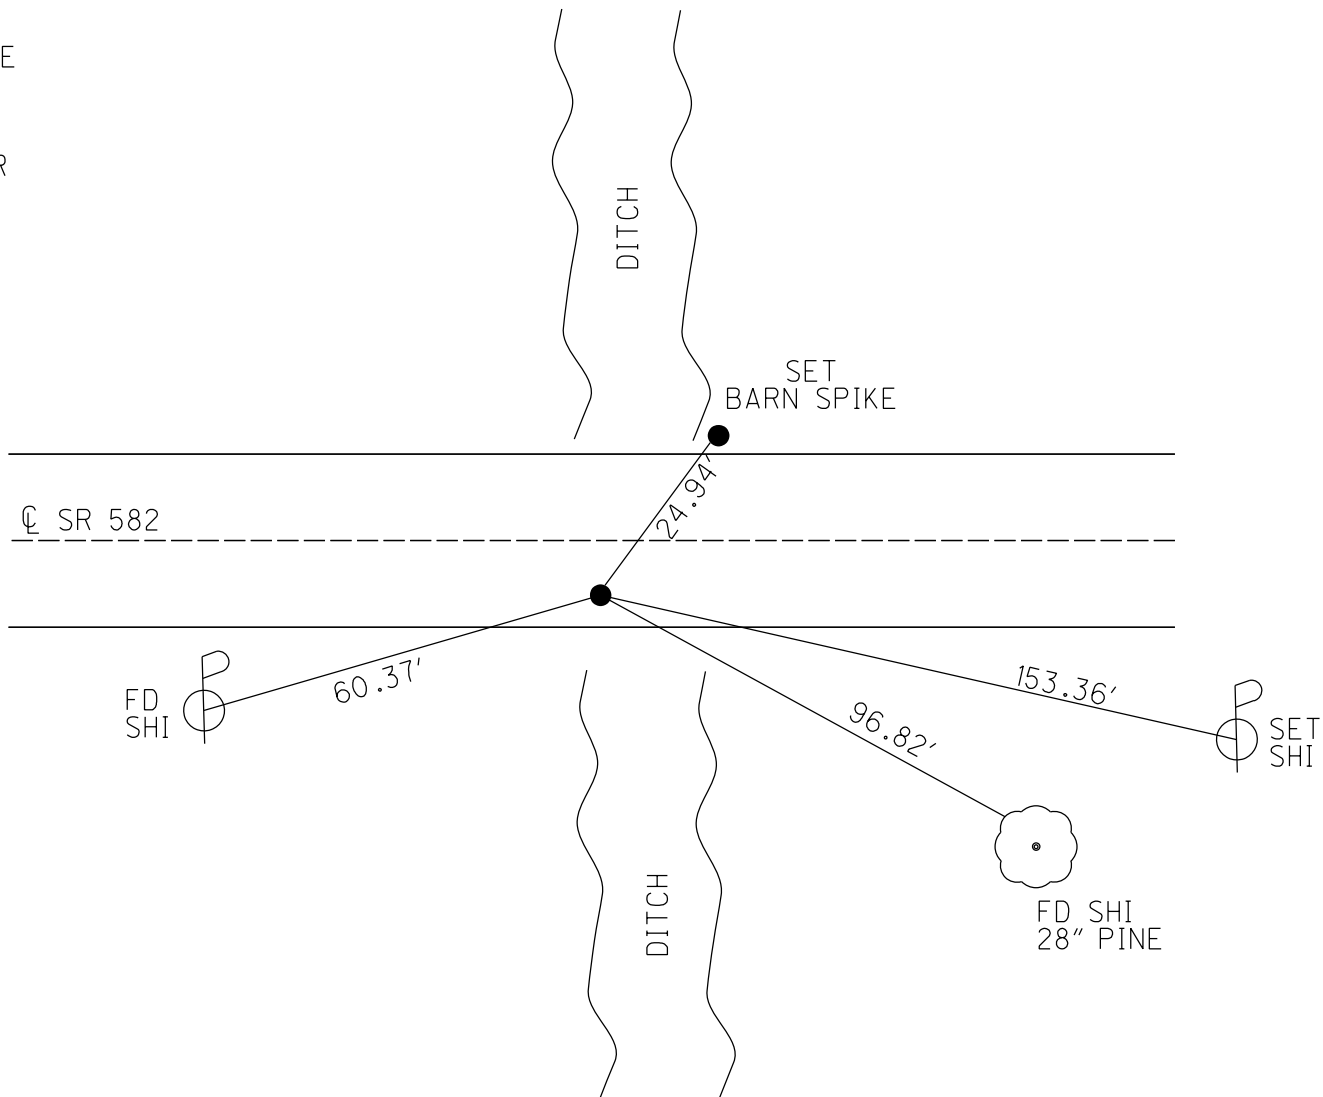

O.D.O.T. DISTRICT 2 SURVEY OFFICE (USE ONLY)

PERSONNEL

REFERENCE NO. 36

SHEET 17 OF 21

NOTES RHOADES

DATE 10-2-2020

ROUTE SR 582

H.C. AUBLE

WEATHER SUNNY

COUNTY WOOD

R.C. O'DONNELL

TEMP. 41° F

TOWNSHIP WEBSTER

SECTION 29

DWG BY AUBLE

PID NO PID

T 6 N R 11 E

TYPE MONUMENT MAG SHANK

ON SURFACE - ~~BELOW~~ ON

OFFSET CL PAVEMENT 6.3' ~~LT~~ : RT

3.4' TO RT EDGE PAVEMENT


STATION: 690+38

HORIZ.DATUM: NAD83 (2011)

GEOID: 2012A

GRID: NORTHING: 653833.779

EASTING: 1693825.223

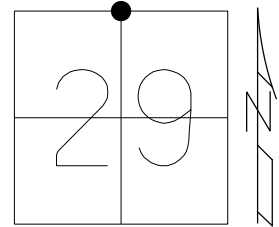

SET MAG/WASHER
9/02/05, MDB
FD MAG SHANK
REF36
10-2-2020, DSA
SET LG.R.R.SPIKE
12-3-2020, DSA

DITCH

CL SR 582

FD
SHI

60.38'

96.87'

153.38'

SET
SHI

FD SHI
28" PINE

DITCH

O.D.O.T. DISTRICT 2 SURVEY OFFICE

PERSONNEL

NOTES BARNHISEL
H.C. CANTERBURY
R.C. MIKLOVIC


REFERENCE NO. 36

DATE 05/23/05
WEATHER CLOUDY
TEMP. +65°

SHEET 16 OF 20

ROUTE S.R. 582
COUNTY WOOD
TOWNSHIP WEBSTER
SECTION 29
T. 6 N R. 11 E


TYPE MONUMENT PK & WASHER
ON SURFACE - ~~BELOW~~ YES
~~LEFT~~ - Q PAV'T - RIGHT 6.3'
3.4' TO RT EDGE PAVEMENT
S.L.M. 690+38

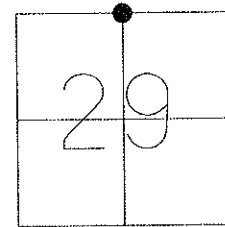

GRID: NORTHING:

EASTING:

RESET MAG NAIL & WASHER
09/02/05
MDB

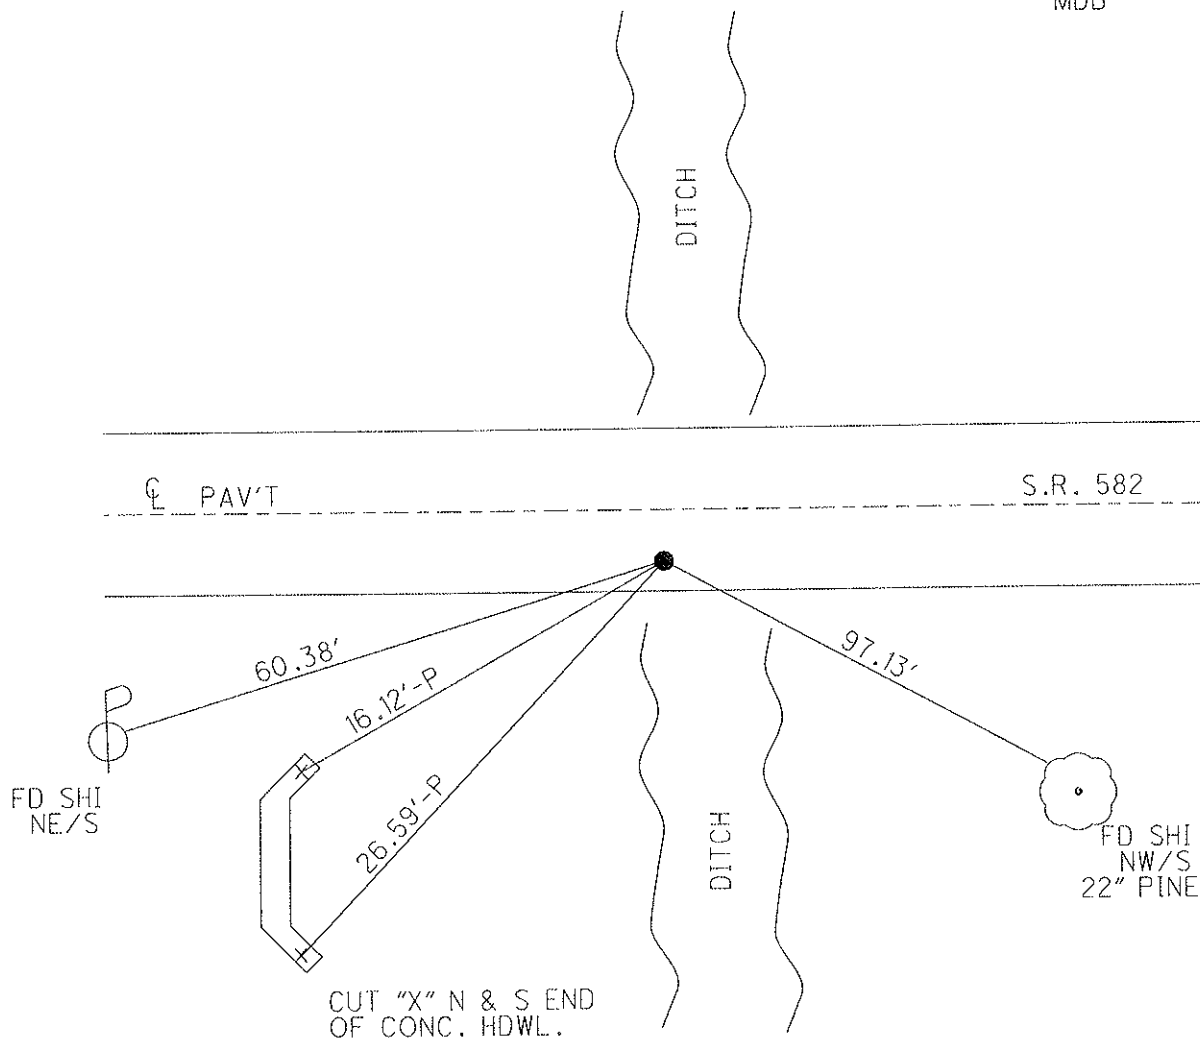

O.D.O.T. DISTRICT 2 SURVEY OFFICE

PERSONNEL

REFERENCE NO. 36

SHEET 16 OF 21

NOTES BARNHISEL

DATE 05/23/05

ROUTE S.R. 582

H.C. CANTERBURY

WEATHER CLOUDY

COUNTY WOOD

R.C. MIKLOVIC

TEMP. +65°

TOWNSHIP WEBSTER

SECTION 29

T 6 N R 11 E


TYPE MONUMENT PK & WASHER

ON SURFACE - ~~BELOW~~ YES

~~LEFT~~ - Q PAV'T - RIGHT 6.3'

3.4' TO RT EDGE PAVEMENT


S.L.M. 690+38

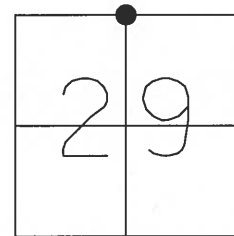

RESET MAG NAIL & WASHER
09/02/05
MDB



Q PAV'T S.R. 582

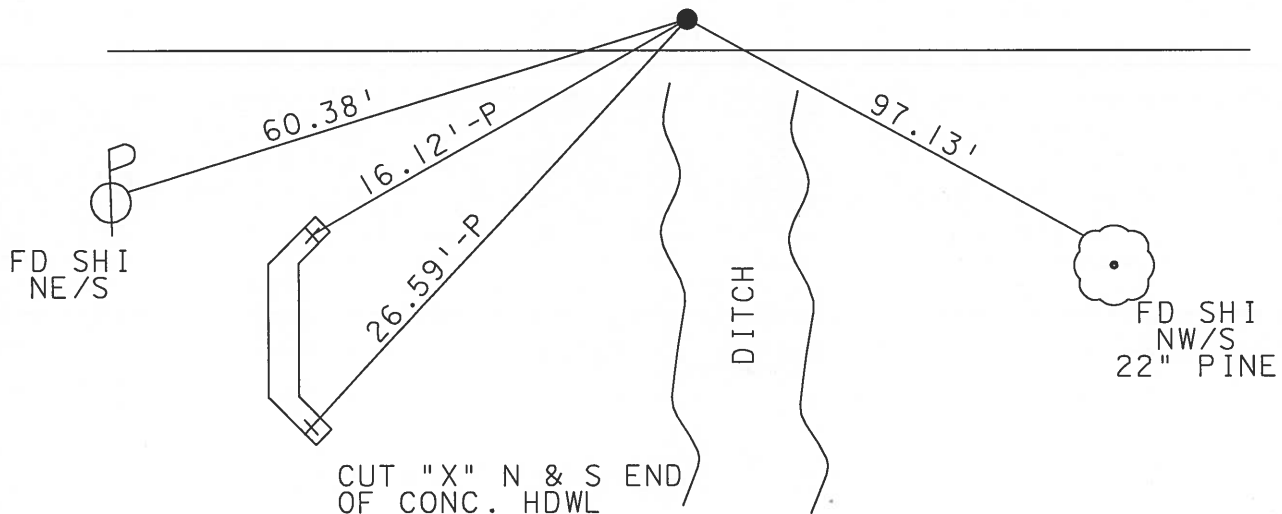

O.D.O.T. DISTRICT 2 SURVEY OFFICE

PERSONNEL

REFERENCE NO. 36

SHEET OF

NOTES LOGHRKE

H.C. Hoffman

R.C. Steinhauser

DATE 7-13-90

WEATHER WINDY-Cloudy

TEMP. +65

ROUTE S.R. 582

COUNTY WOOD

TOWNSHIP Webster

SECTION 29

T. 6 N R. 11 E


TYPE MONUMENT Sm. R.R. Spike

ON SURFACE - BELOW YES


~~LEFT~~ - C PAV'T. - RIGHT 6.7

3.2 TO R+ EDGE PAVEMENT

S.L.M. 690 + 38

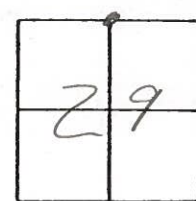

Set P.K. / Washer
10-25-90
MB

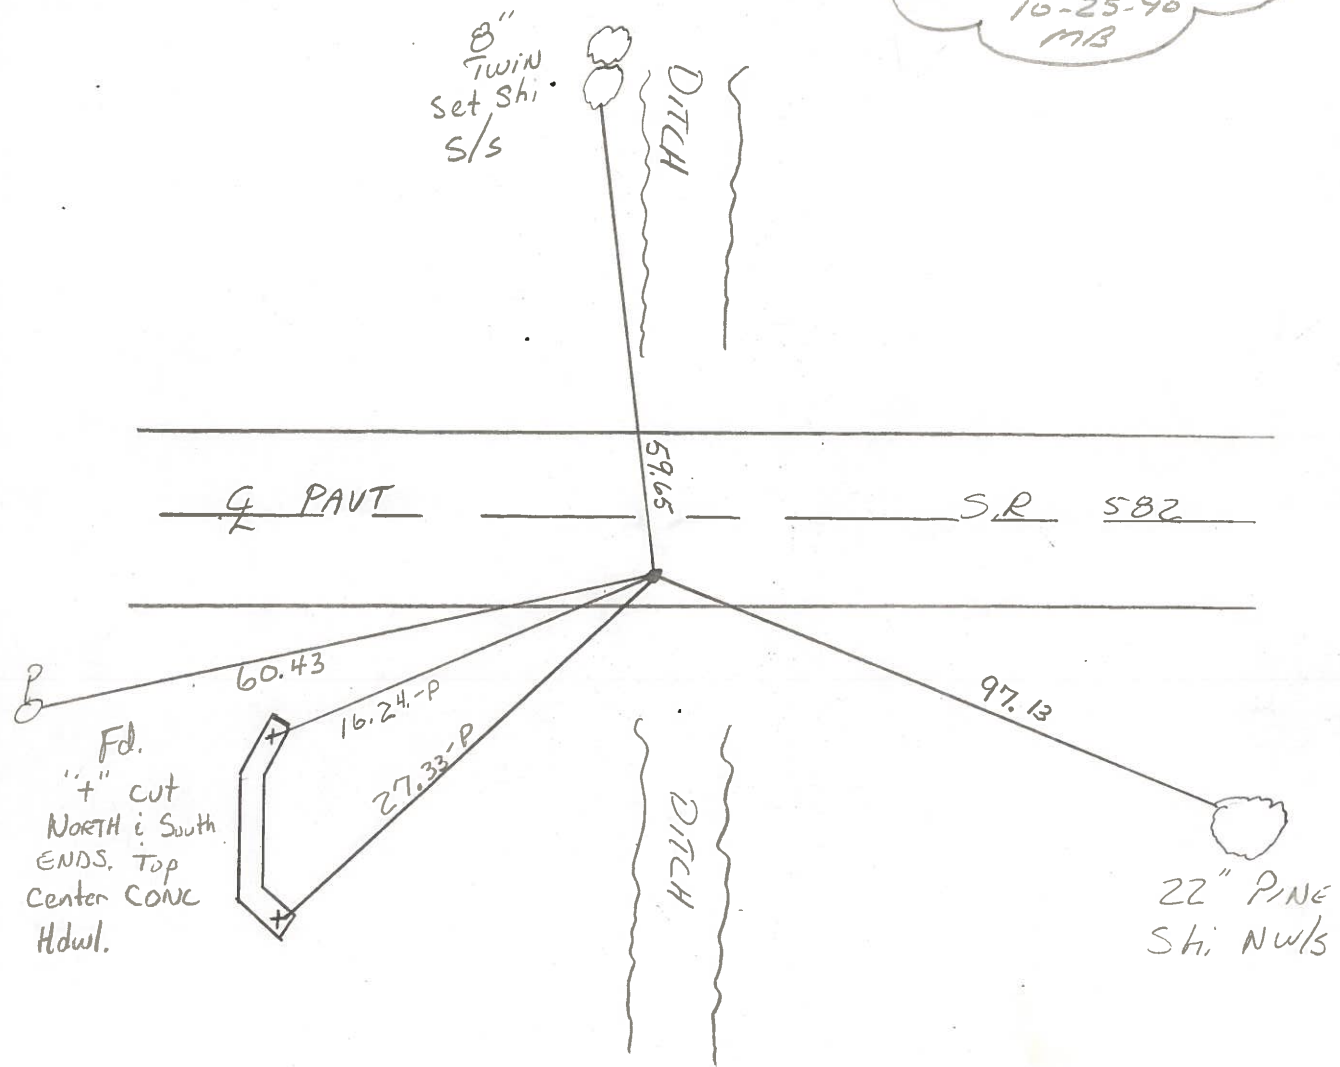

Q.D.O.T. DISTRICT 2 SURVEY OFFICE

SHEET 13 OF

County Wood S.R. 582

Township Webster

Section 20

T N, R E

Personnel L. Stone

P. Newson


R. Michalak

D. Curtis

Date 12 July 83


Weather Wet

Temp. 85°

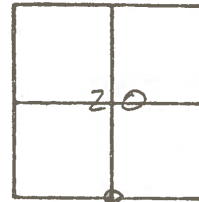

SLM Sta. 690+40

REF. No. 36

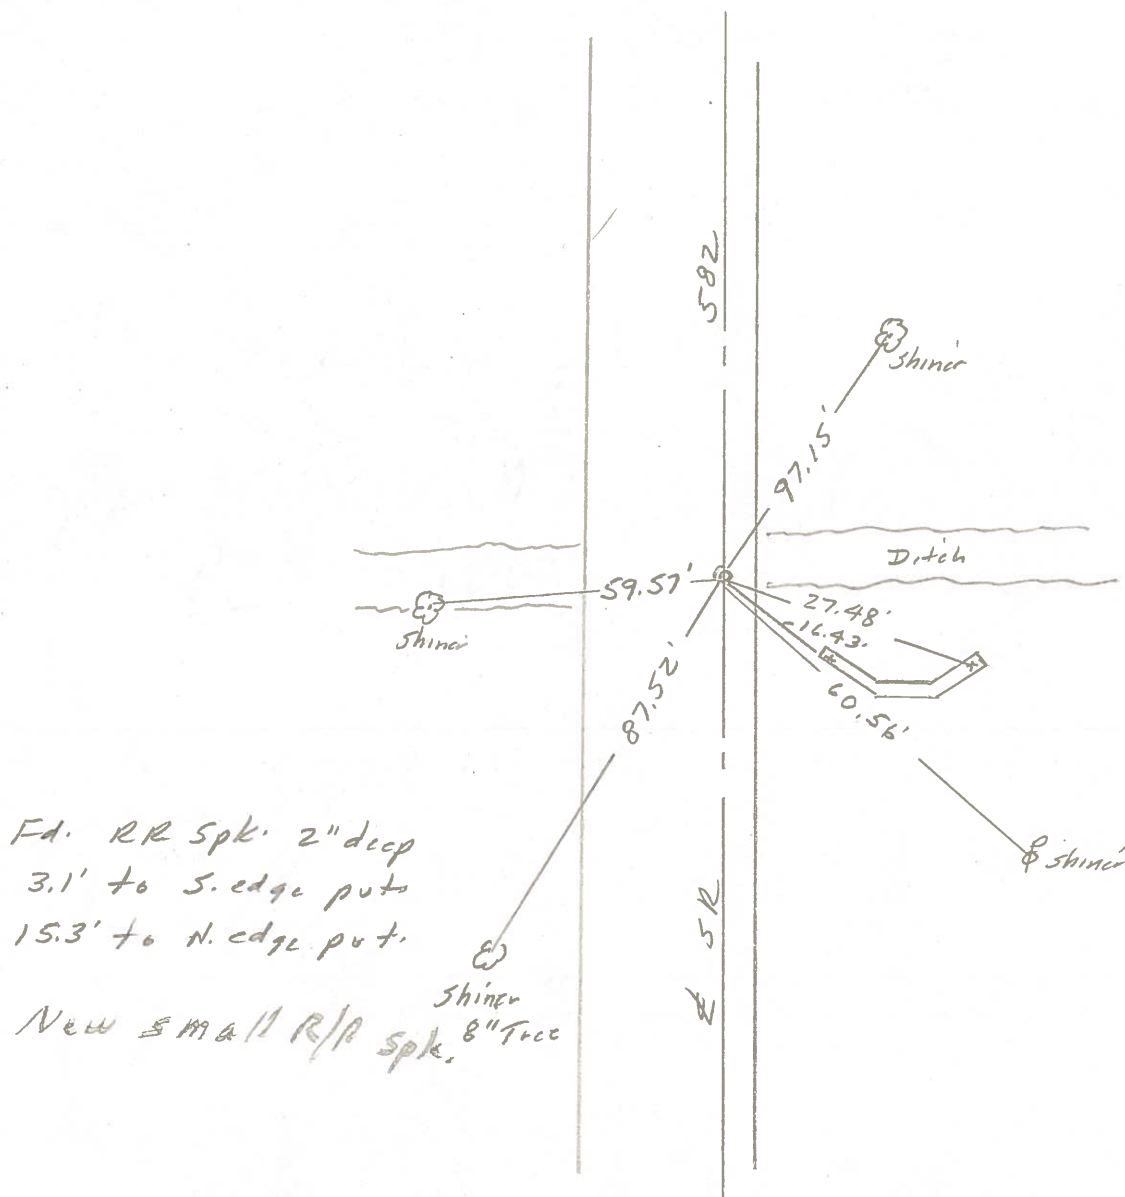

Q.D.O.T. DISTRICT 2 SURVEY OFFICE

SHEET 13 OF

County Wood S.R. 582

Township Webster

Section 20

T.N, R.E

Personnel L. Stone

P. Newser


R. Michalak

D. Curtis

Date 12 July 83

Weather Windy

Temp. 85°

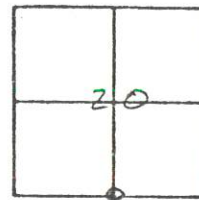

SLM Sta. 690+40


REF. NO. 36

690+38

3.2 REP

6.7 CL

24

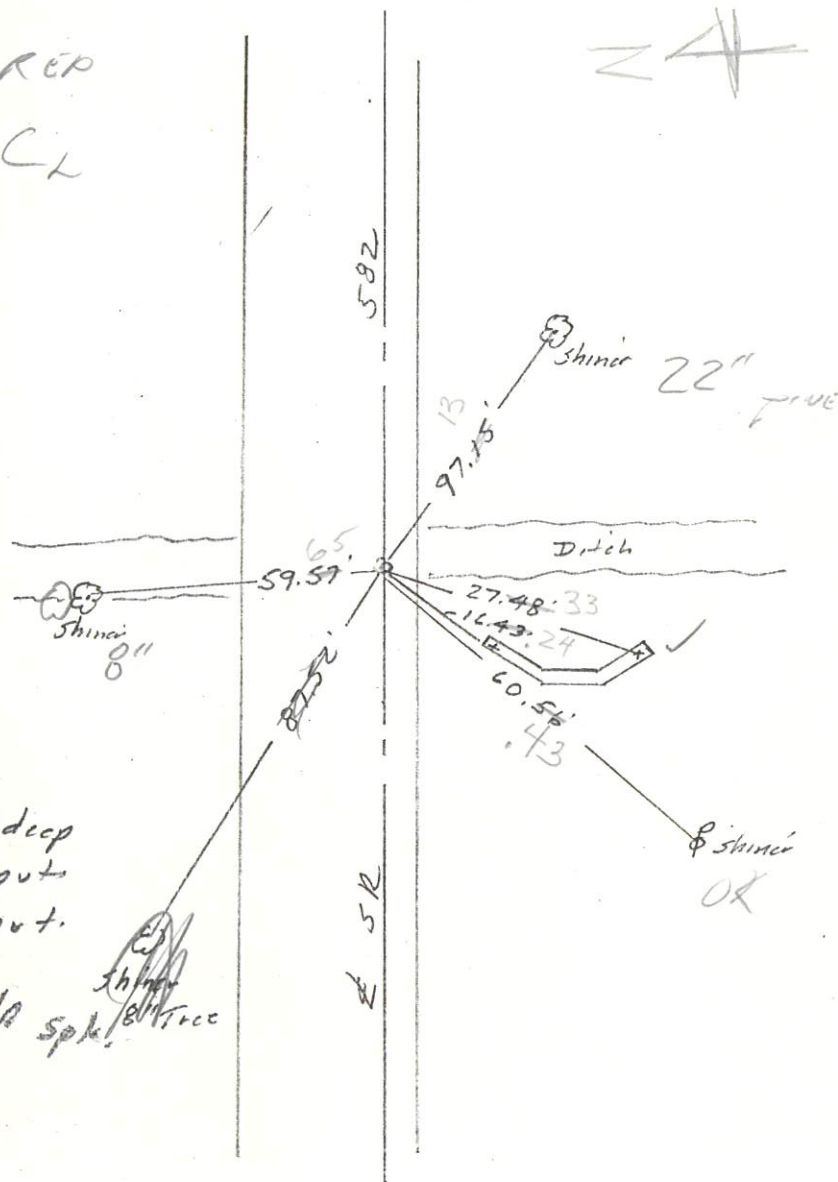

Fd. RR Spk. 2" deep
3.1' to S. edge put.
15.3' to N. edge put.

New small R/R Spk. Shiner
ON SUR.