

O.D.O.T. DISTRICT 2 SURVEY OFFICE (USE ONLY)

PERSONNEL

REFERENCE NO. 36 A

SHEET 18 OF 21

NOTES MILLER
H.C. MILLER
R.C. BARRIERE

DATE 10/1/24
WEATHER CLOUDY
TEMP. 71°

ROUTE SR 582
COUNTY WOOD
TOWNSHIP WEBSTER
SECTION 29

DWG BY PRESTON-COLVIN PID PAVING TRAIN

T 6 N R 12 E

TYPE MONUMENT MAG SHANK

ON SURFACE - ~~BELOW~~ ON

OFFSET CL PAVEMENT 5.7' ~~LT~~ : RT

3.8' TO RT EDGE PAVEMENT

STATION: 703+67

HORIZ.DATUM: NAD83 (2011)


GEOID: NAVD88 2018

GRID: NORTHING:

EASTING:

LDP: NORTHING: 476229.855


EASTING: 205915.861

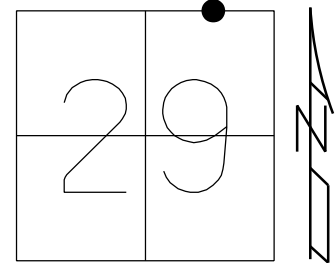

RESET MAG NAIL & WASHER
09/02/05, MDB

FD MAG SHANK
REF36A
10/1/24, JAM

FD MAG SHANK
10/10/24, TDN

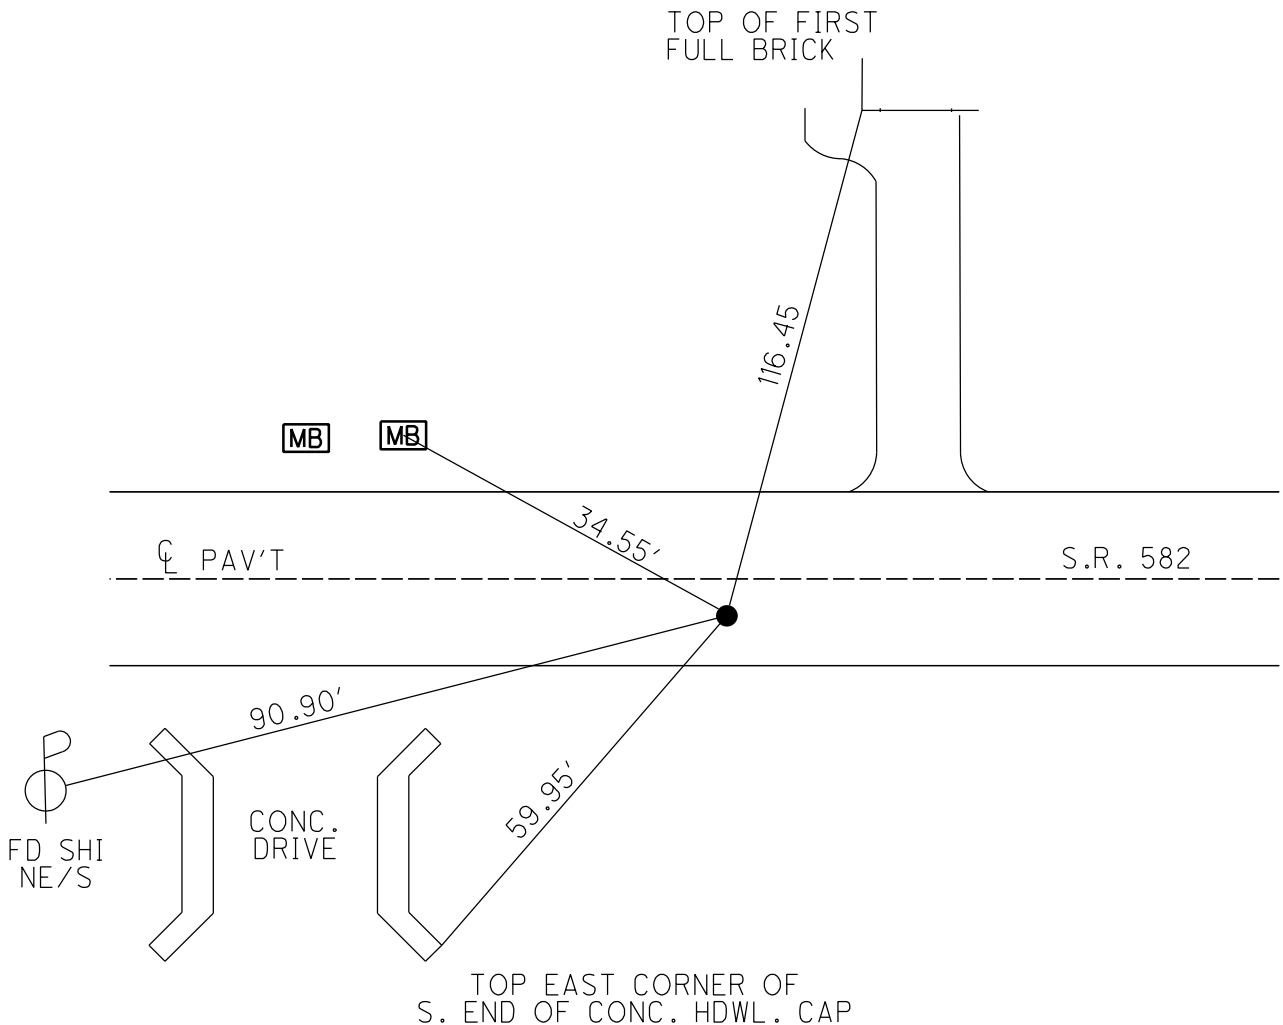

O.D.O.T. DISTRICT 2 SURVEY OFFICE

PERSONNEL

NOTES

H.C.

R.C.

BARNHISEL

CANTERBURY

MIKLOVIC

REFERENCE NO. 36 A

DATE

05/23/05

WEATHER

CLOUDY

TEMP.

+65°

SHEET 17 OF 20

ROUTE

S.R. 582

COUNTY

WOOD

TOWNSHIP

WEBSTER

SECTION

29

T 6 N R 12 E

TYPE MONUMENT

PK & WASHER

ON SURFACE - ~~BELOW~~

YES

~~LEFT~~ - C PAV'T - RIGHT

5.7'


3.8' TO RT. EDGE PAVEMENT

S.L.M.

703+67

GRID: NORTHING:


EASTING:

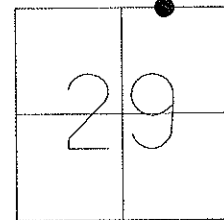

RESET MAG NAIL & WASHER

09/02/05

MDB

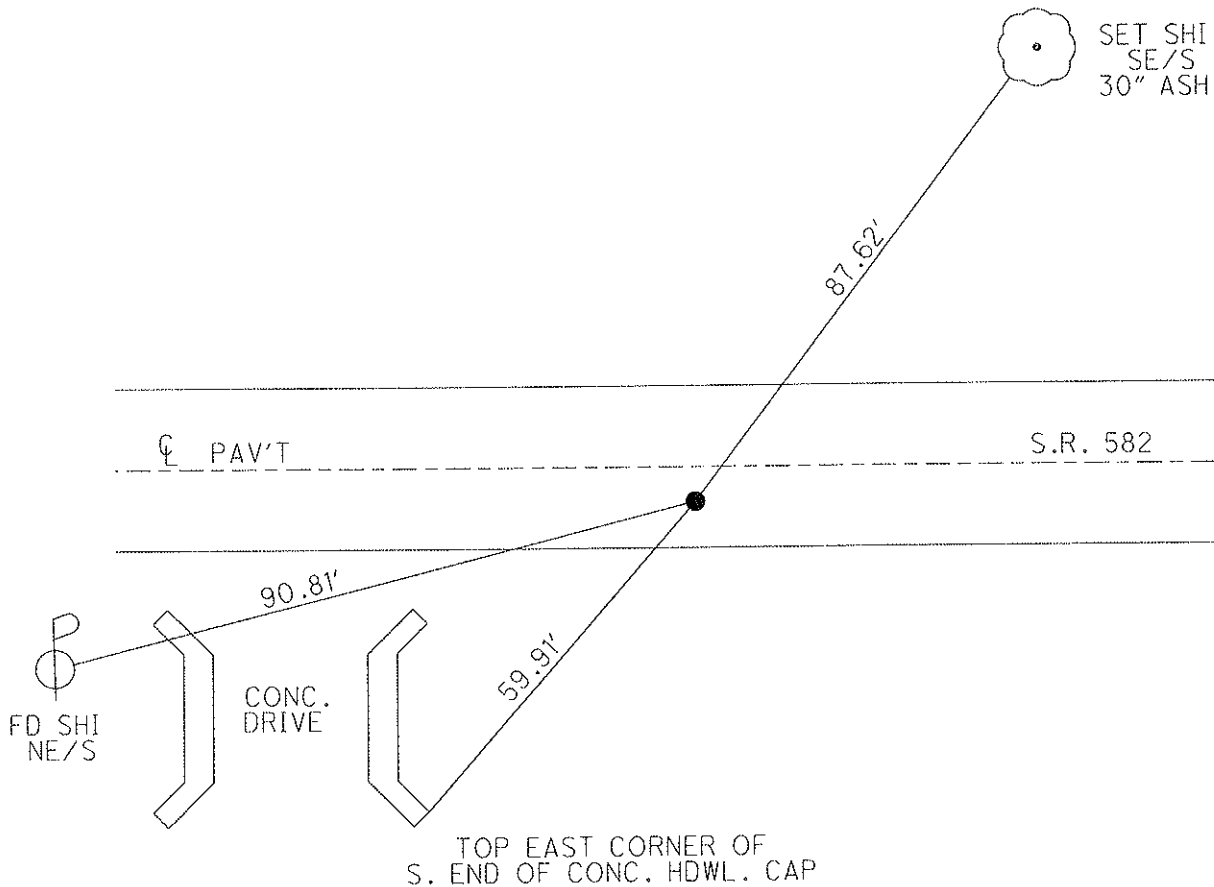

O.D.O.T. DISTRICT 2 SURVEY OFFICE

PERSONNEL

REFERENCE NO. 36 A

SHEET 17 OF 21

NOTES BARNHISEL

DATE 05/23/05

ROUTE S.R. 582

H.C. CANTERBURY

WEATHER CLOUDY

COUNTY WOOD

R.C. MIKLOVIC

TEMP. +65°

TOWNSHIP WEBSTER

SECTION 29

T 6 N R 12 E


TYPE MONUMENT PK & WASHER

ON SURFACE - ~~BELOW~~ YES


~~LEFT~~ - Q PAV'T - RIGHT 5.7'

3.8' TO RT EDGE PAVEMENT

S.L.M. 703+67

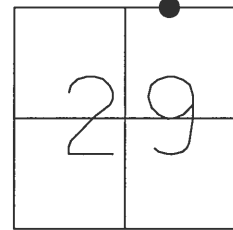

RESET MAG NAIL & WASHER
09/02/05
MDB

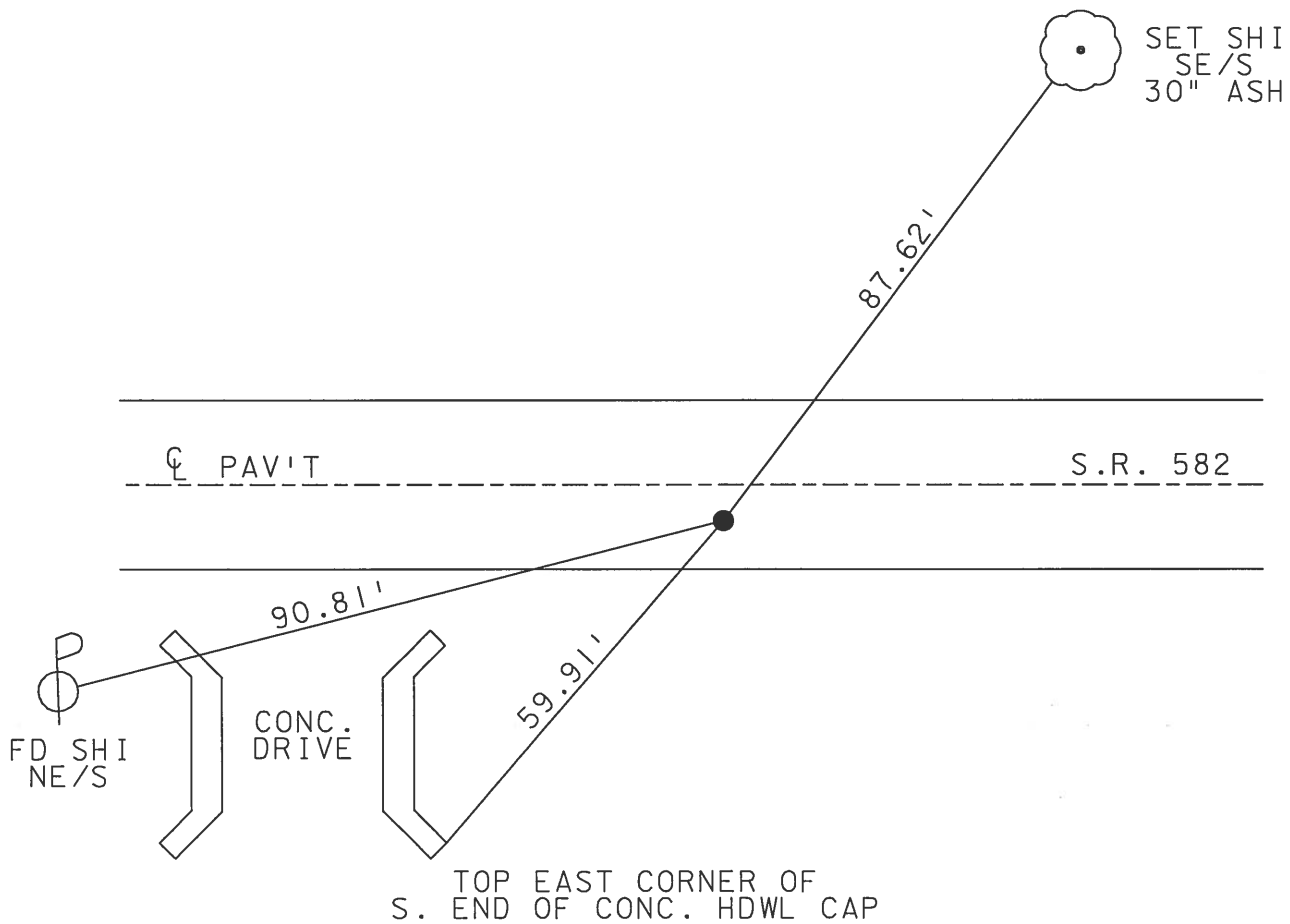

O.D.O.T. DISTRICT 2 SURVEY OFFICE

PERSONNEL

REFERENCE NO. 36 A

SHEET ____ OF ____

NOTES LOEHRKE

H.C. Hoffman

R.C. STEINHAUSER

DATE 7-13-90

WEATHER CLOUDY, WINDY

TEMP. +65

ROUTE S.R. 582

COUNTY Wood

TOWNSHIP Webster

SECTION 29

T6 N12 E


TYPE MONUMENT R.R. Spike

ON SURFACE - BELOW 2 1/2"


LEFT - C PAV'T. - RIGHT S,3

4.2 TO RT EDGE PAVEMENT

S.L.M. 703 + 67

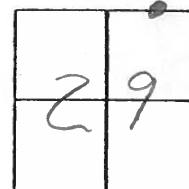

Set P.K. & Washer
10-25-90
MB

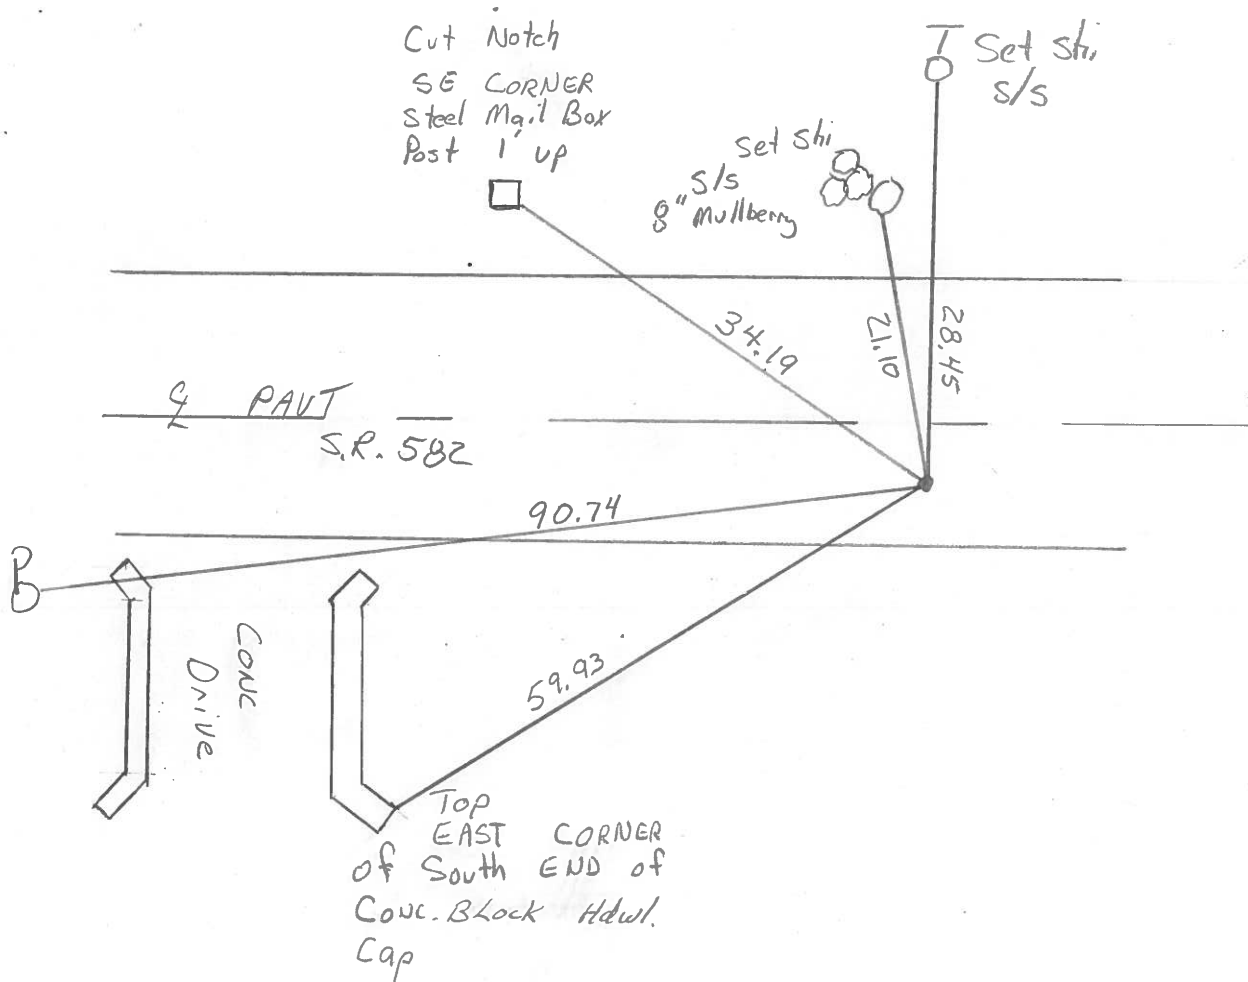

ODOT. DISTRICT 2 SURVEY OFFICE

SHEET 14 OF

County Wood S.R. 582

Township Webster

Section 20

T N, R E

Personnel I. Stone

P. Neuser

R. Michalak

D. Curtis

Date 12 July 83

Weather Warm

Temp. 85°



SLM Sta. 703+66

REF. NO. 36A



Shiner's
M. Box
post

62.75'

22.15'

Shiner
Tree

85.62'

90.95'

Shiner

Con.
Drive

FA, RR Spk. Surface
14.7' to N. edge put.
5.0' to S. edge put

SR

Q.D.O.T. DISTRICT 2 SURVEY OFFICE

SHEET 14 OF 14

County Wood S.R. 582

Township Webster

Section 20

T N, R E

Personnel L. Stone

P. Newser


R. Michalak

D. Curtis

Date 12 July 83

Weather Warm

Temp. 85°

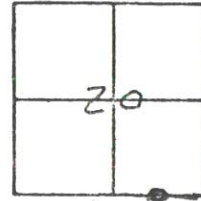

SLM Sta. 703+66
+67

REF. NO. 36A

4.7 REP
5.3 L

2 1/2"
 F.A. RR Spk. Surface
14.7' to N. edge put.
5.0' to S. edge put

Shiner
Mail
Post

Set Shi
s/s T

28.45

Milbary

Shiner
Tree

22.15
21.10

34.19

Cut Notch
1' up
Steel Mail
Box Post

582

20.00

Shiner Set Shi NE/s

Con.
Drive

59.93

85.62