

O.D.O.T. DISTRICT 2 SURVEY OFFICE

PERSONNEL

REFERENCE NO. 37



SHEET 18 OF 20

NOTES BARNHISEL
H.C. CANTERBURY
R.C. MIKLOVIC

DATE 05/20/05
WEATHER SUNNY
TEMP. +65°

ROUTE S.R. 582
COUNTY WOOD
TOWNSHIP TROY
SECTION 28
T 6 N R 12 E

TYPE MONUMENT PK & WASHER
ON SURFACE - BELOW YES
LEFT - Q PAV'T RIGHT 5.9'
TO EDGE PAVEMENT
S.L.M. 716+96, 5.8' S. OF Q PAV'T WEST
GRID: NORTHING: EASTING:

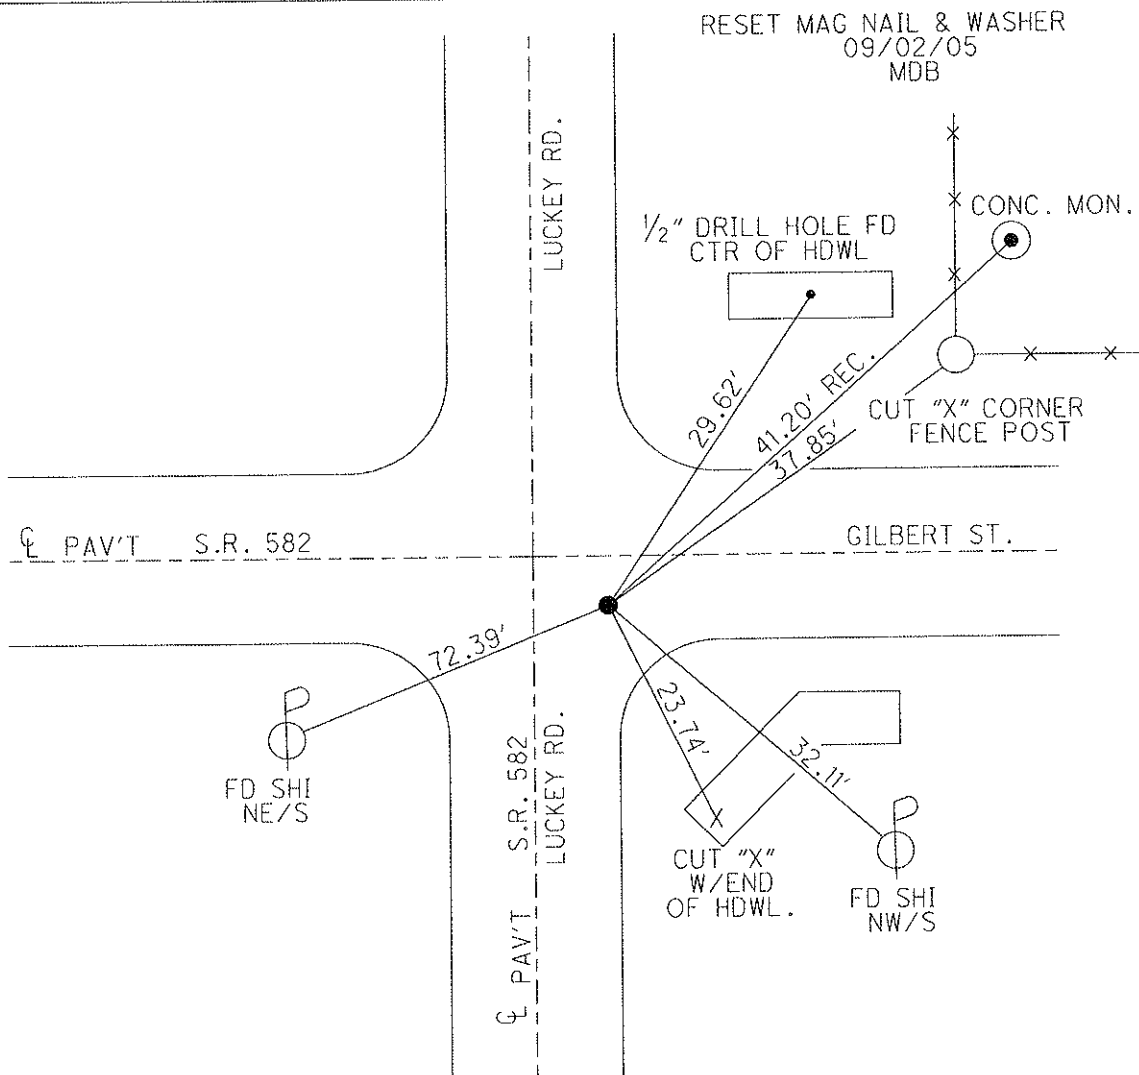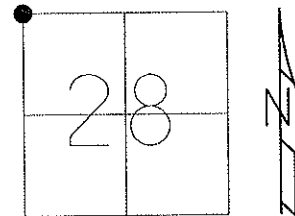

O.D.O.T. DISTRICT 2 SURVEY OFFICE

PERSONNEL

REFERENCE NO. 37

SHEET 18 OF 21

NOTES BARNHISEL

DATE 05/20/05

ROUTE S.R. 582

H.C. CANTERBURY

WEATHER SUNNY

COUNTY WOOD

R.C. MIKLOVIC

TEMP. +65°

TOWNSHIP TROY

SECTION 28

T 6 N R 12 E



TYPE MONUMENT PK & WASHER

ON SURFACE - ~~BELOW~~ YES

LEFT - Q PAV'T - ~~RIGHT~~ 5.9'

TO EDGE PAVEMENT 5.8' S. OF CL
PAV'T WEST

S.L.M. 716+96

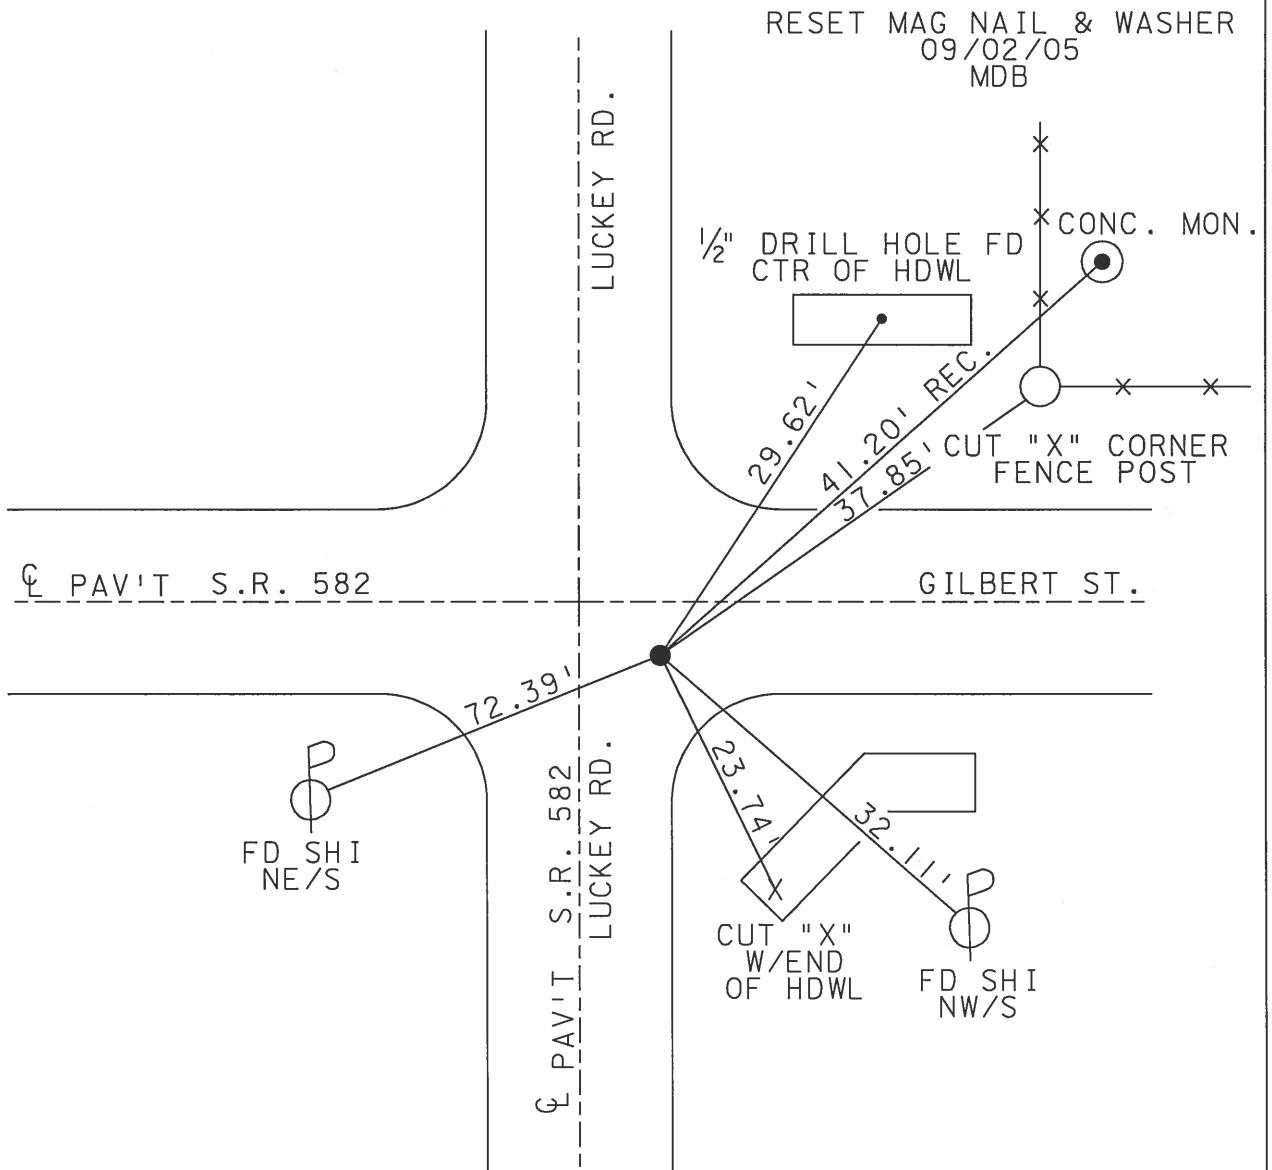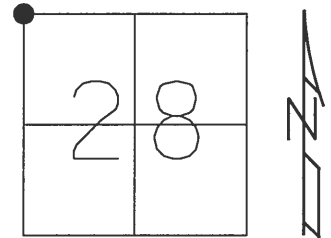

O.D.O.T. DISTRICT 2 SURVEY OFFICE

PERSONNEL

REFERENCE NO. 37

SHEET OF

NOTES LOEHRKE

H.C. HOPFMAN

R.C. Steinhouser

DATE 7-13-90

WEATHER CLOUDY - WINDY

TEMP. +65

ROUTE S.R. 582

COUNTY WOOD

TOWNSHIP TROY

SECTION 28

T. 6 N. R. 12 E.

TYPE MONUMENT R.R. SPIKE


ON SURFACE - BELOW 1 1/2"

LEFT - 6 PAV'T. - RIGHT 5.6 / 6.1

TO EDGE PAVEMENT

S.L.M. 716 + 96


of 6 PAVT Rd to West

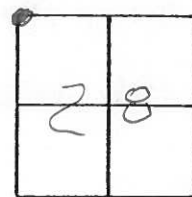

Set P.R./WASHEE
10-25-90
MB

Fd Conc. Ret
MON. Behind
fence. Did Not
USE.
RECORDED
Distance
of
41.20

Drill 1/2" Drill hole
Top Center
CONC. Hdwl

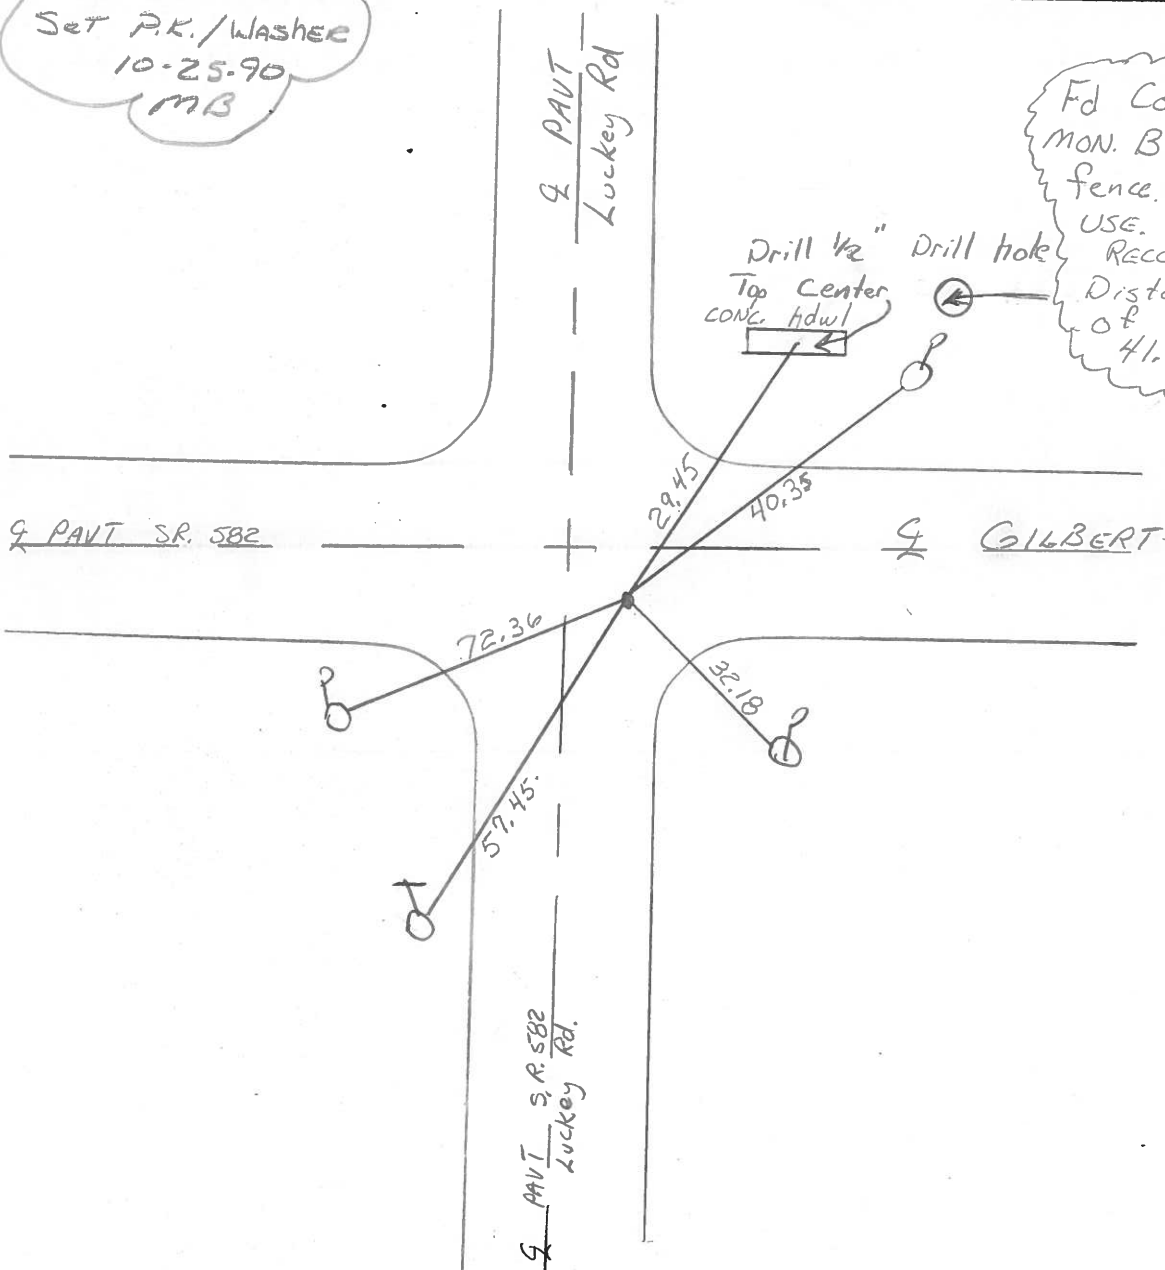

Q.D.O.T. DISTRICT 2 SURVEY OFFICE

SHEET 15 OF

County Wood S.R. 582

Township Webster

Section 20-21-28-29

T N, R E

Personnel I. Stone

P. Neuser

R. Michalske

D. Curtis

Date 12 July 83

Weather Windy


Temp. 85°

20	21
29	28



S.L.M. Sta. 716+95

REF. No. 37

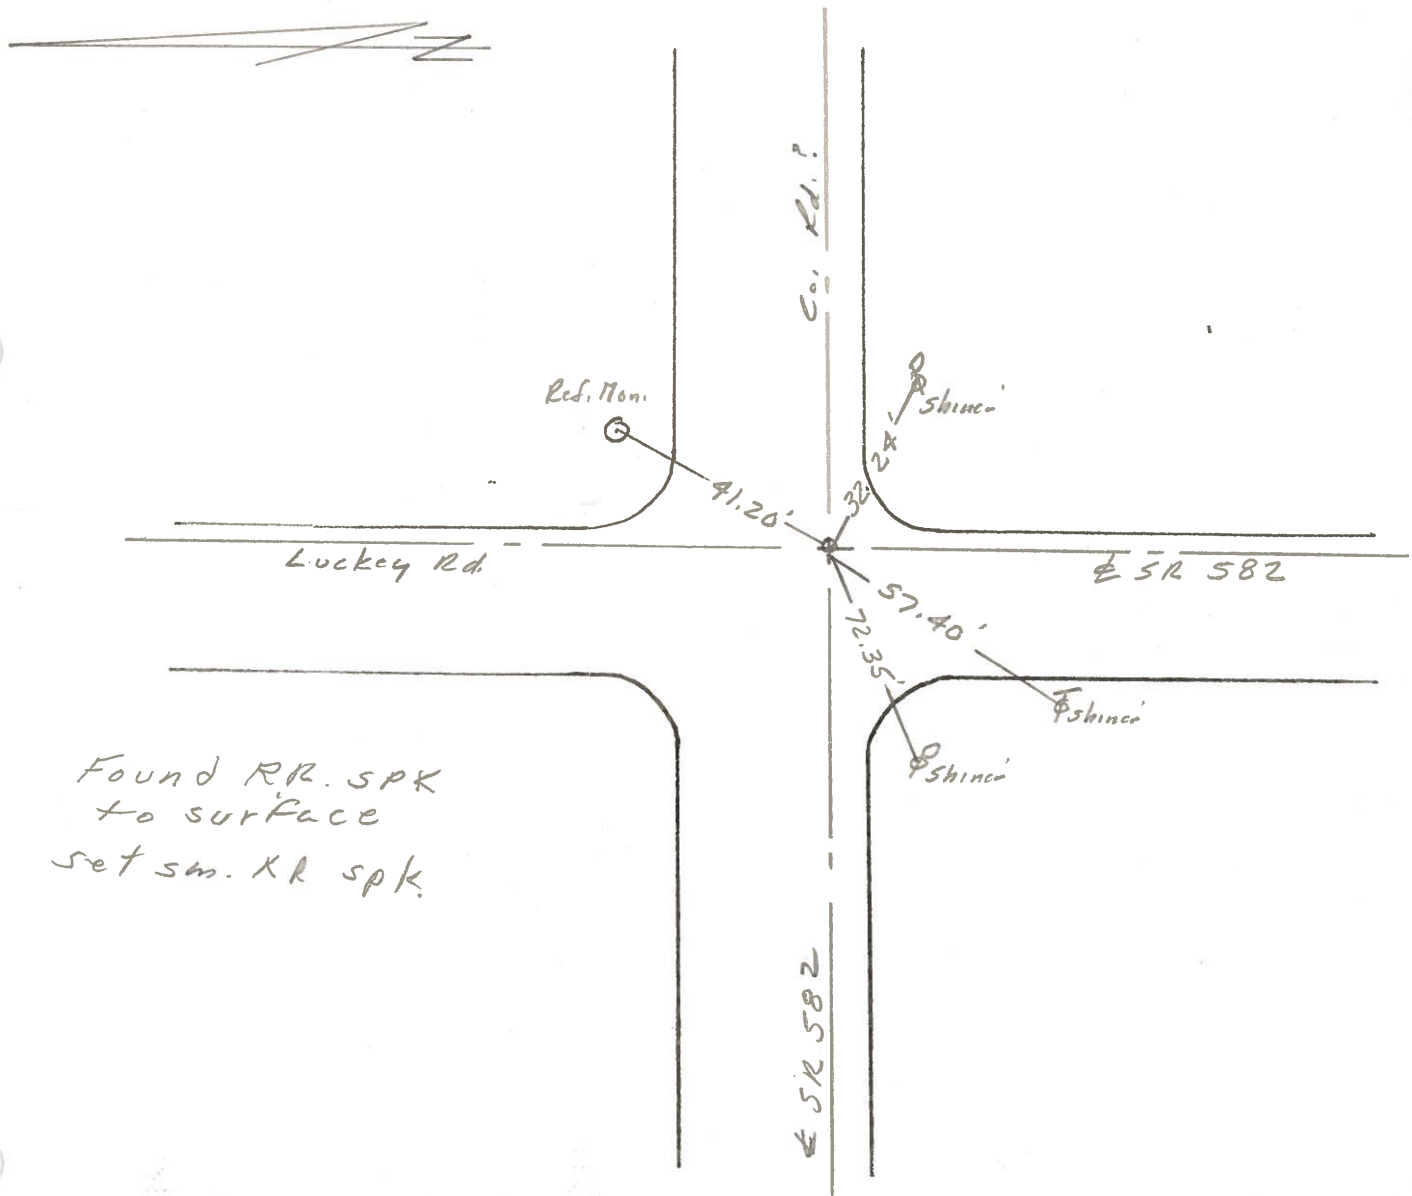

Q.D.O.T. DISTRICT 2 SURVEY OFFICE

SHEET 15 OF

County Wood S.R. 582

Date 12 July 83

Township Webster

Weather W + rain

Section 20-21-28-29

Temp. 85°

T N, R E

Personnel I. Stone

20	21
29	28




P. Neuser

R. Michalak

D. Curtis

S.L.M. Sta. 716+95
+ 96

REF. No. 37

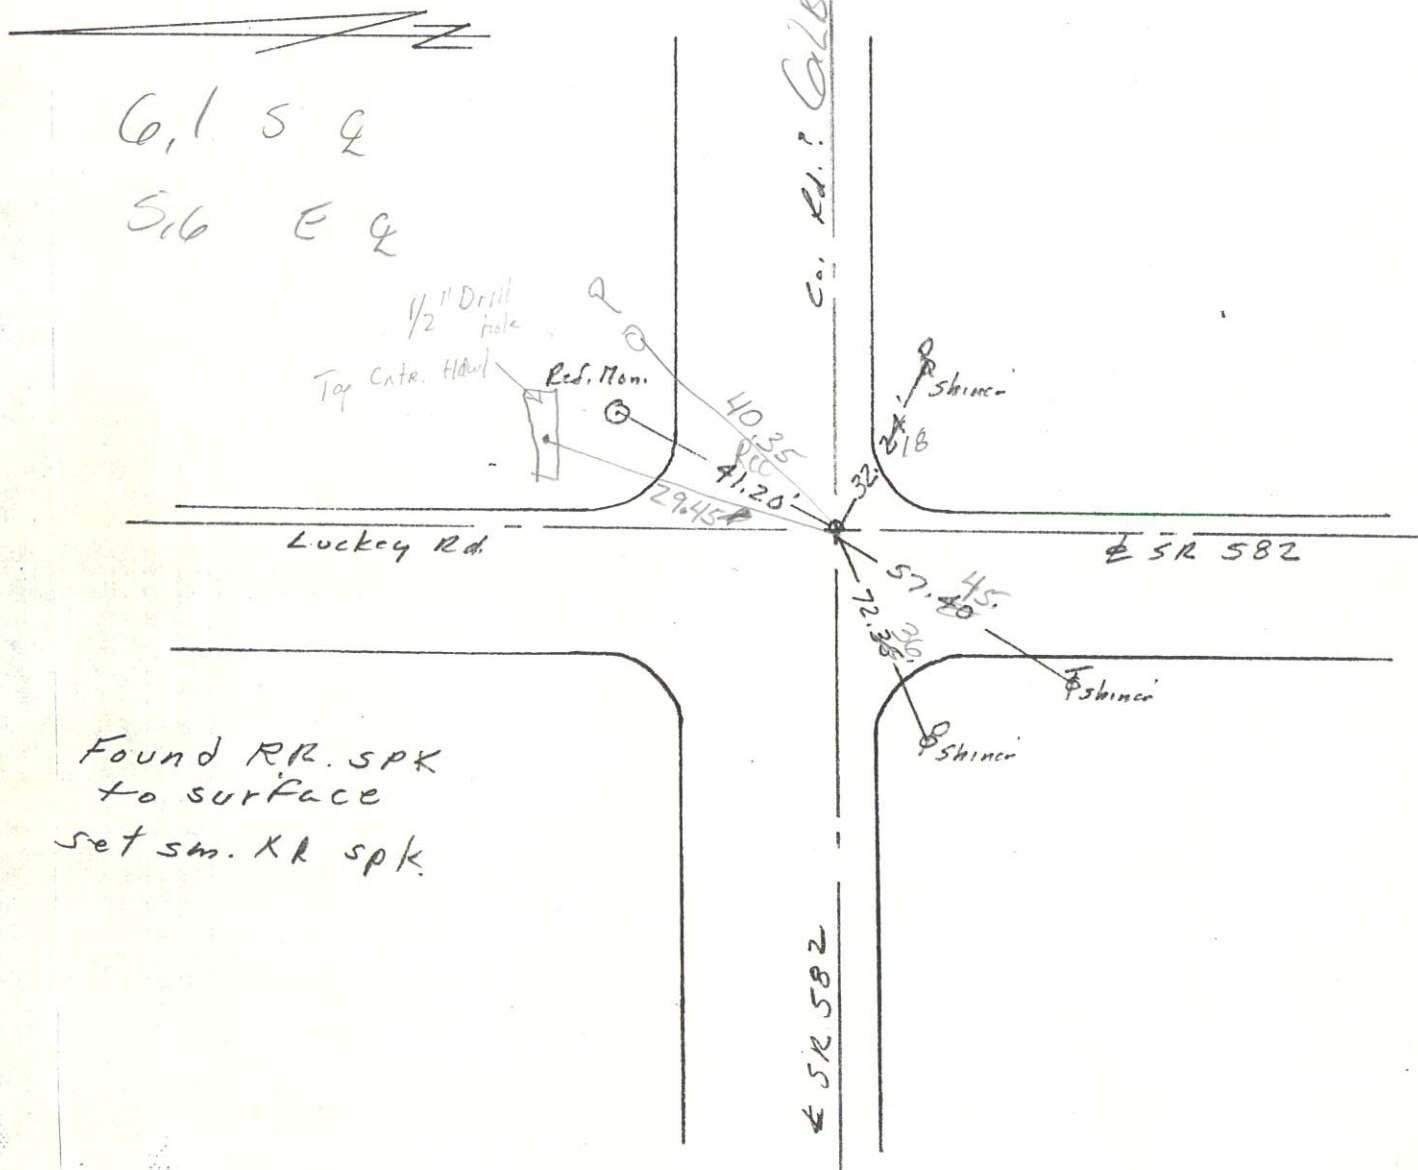

PERSONNEL TITLE PERSONNEL TITLE


COUNTY Wood.DATE April, 17, 1969S. R. #582WEATHER Cloudy & WindySEC. 199 East.TEMP. +70°DESCRIPTION Ties to Control Points

JOB NO. _____


LEFT

CENTER LINE

RIGHT

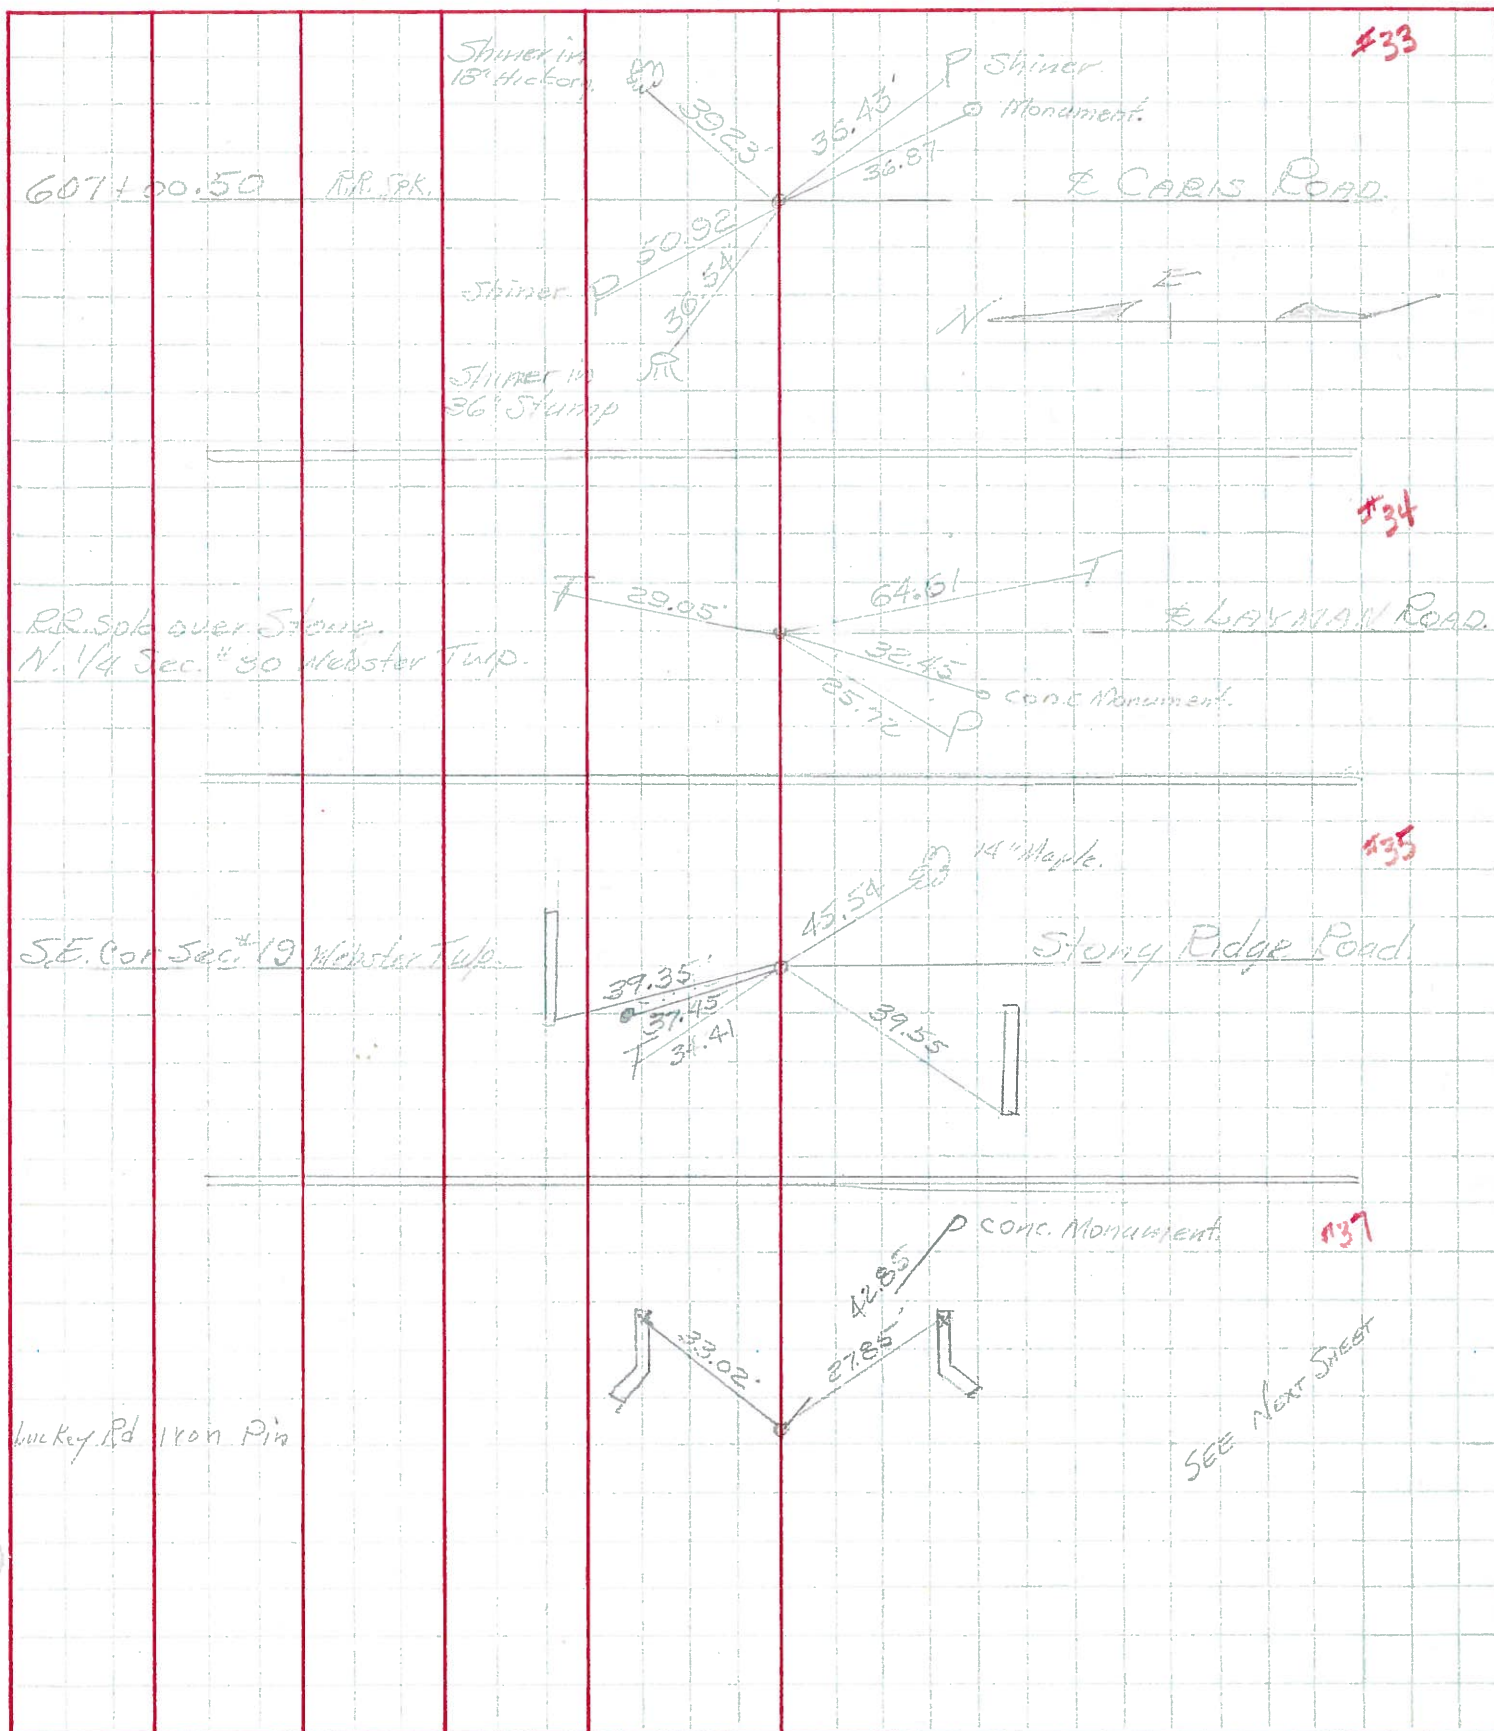

PERSONNEL	TITLE	PERSONNEL	TITLE	COUNTY	DATE	WEATHER	TEMP.
Morrison				Wood.	April, 11, 1968	Clear.	+50°
Bowers.				#582			
Holcombe.				SEC. Luckey			
DESCRIPTION				Ties to Control points		JOB NO.	

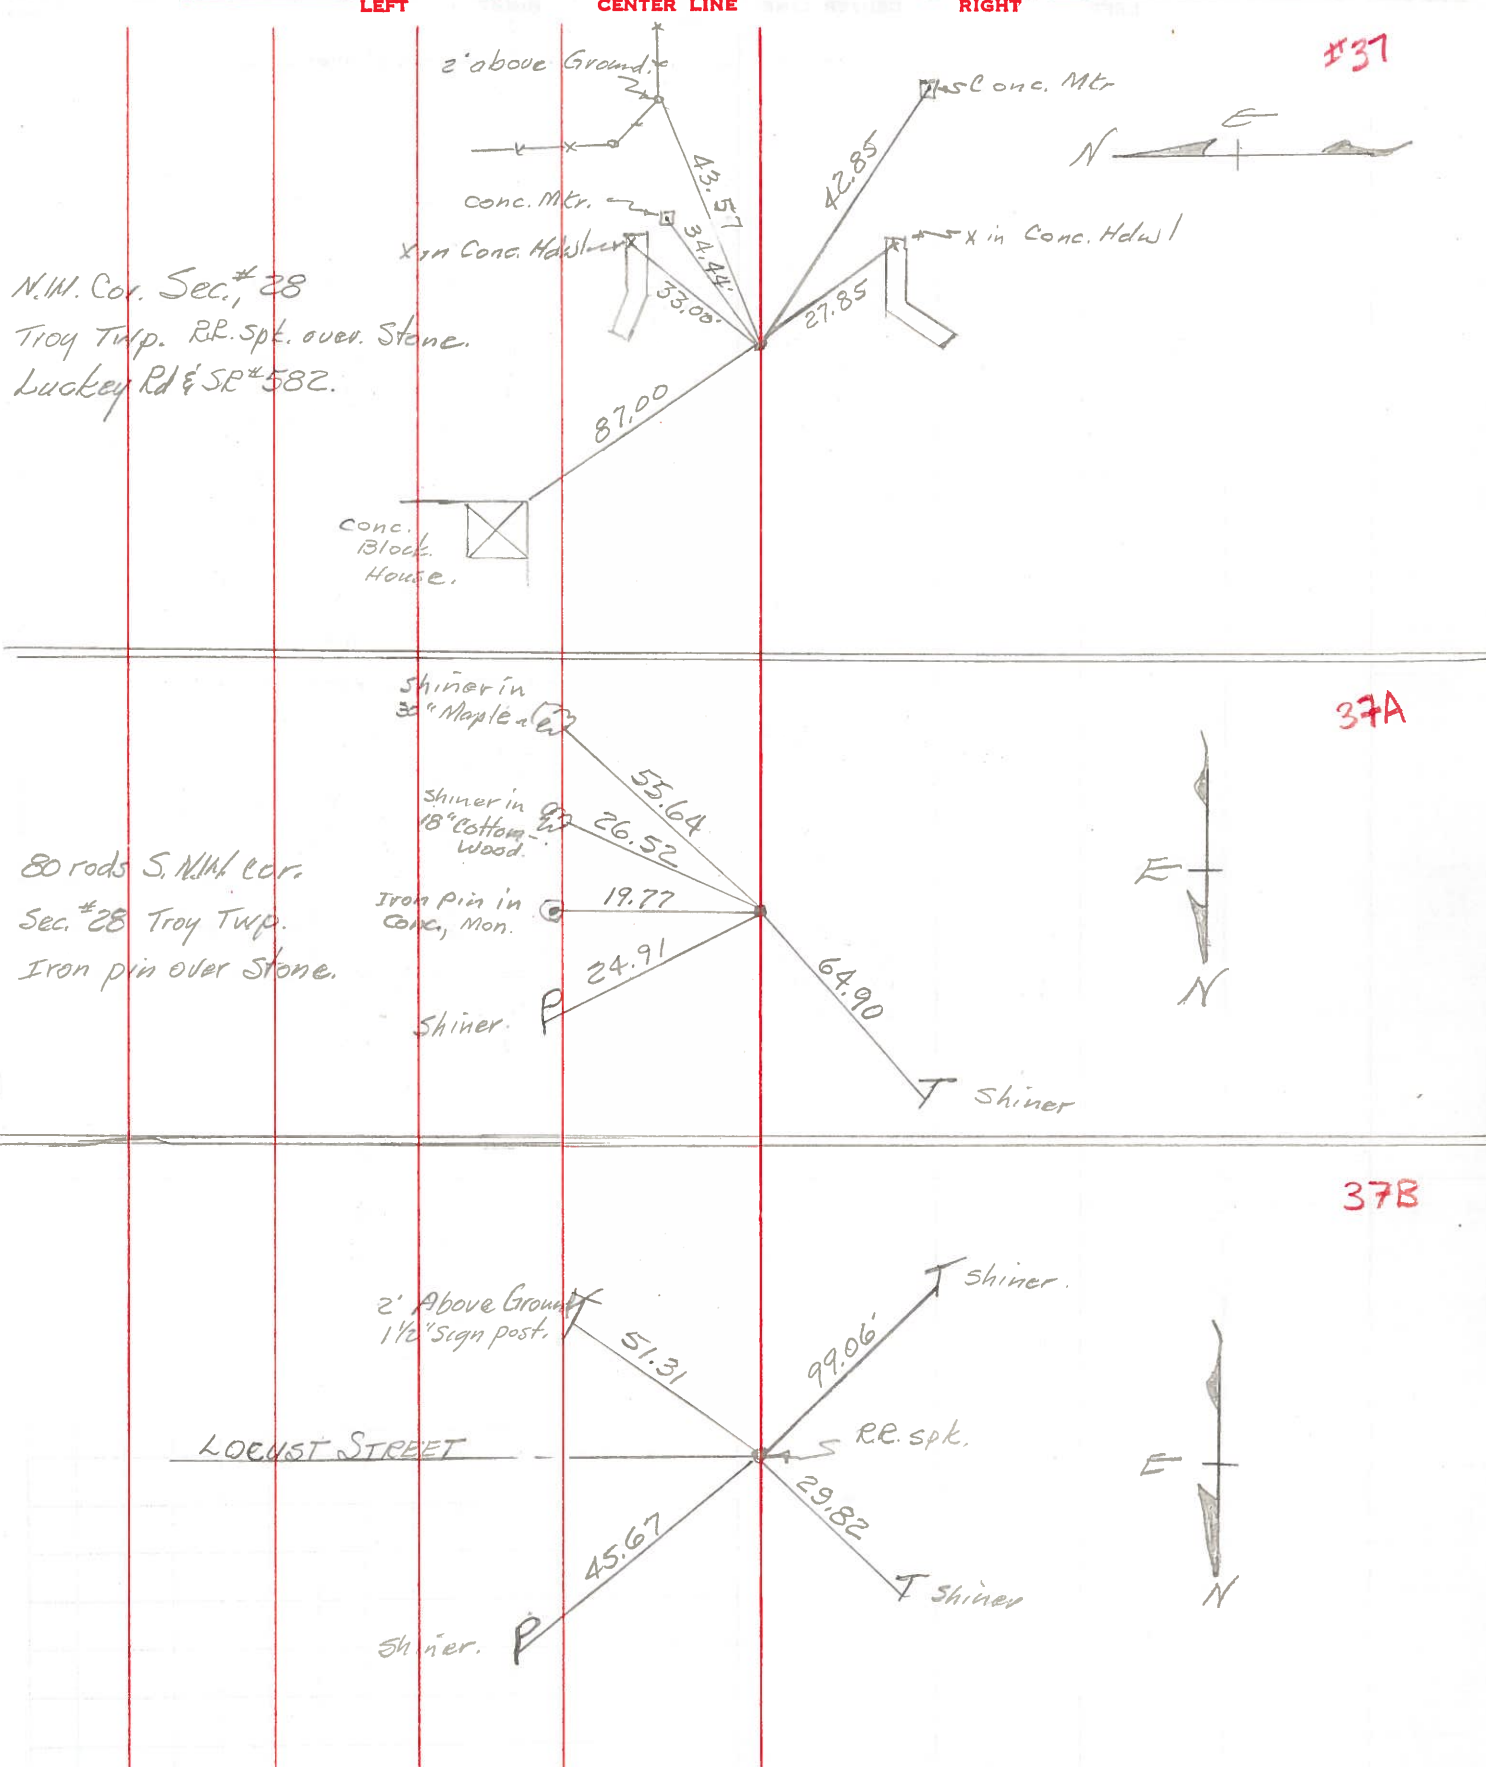

PERSONNEL

TITLE

PERSONNEL

TITLE

COUNTY Wood

DATE

12-27-57Sworden 4-6-60S. R. #582

WEATHER

SEC.

TEMP.

DESCRIPTION

LEFT

CENTER LINE

RIGHT

JOB NO.

9/14/65
Fd. Iron pin 1 1/2' below Part.

N.W. Cor. sec. 28 Troy Twp.

E.R. spike over stone

Luckey Rd & S.R. #582

#460 37

1338.90

OK

Face Cor. Post 2' above G.C. E.N.E. 43.34

Conc. marker N.E. 34.44'

Conc. marker S.E. 42.85'

S.E. cor. House fdn. N.W. 87.0'

X in N.E. Cor. N. Hdwl. N.E. 33.00' ~~33.00~~X in N.E. Cor. S. Hdwl. S.E. 27.85' ~~27.82~~

80 rods S. N.W. cor. sec. 28

Troy Twp.

Boat spk. over stone

Iron Rod

9/14/65 #461 37A

Shiner in 30" maple S.S.E. 55.64'

Cor. of frame house S.E. 57.0'

Shiner in 18" cottonwood S.E. 26.52'

Shiner in P.P. E. 24.91'

Shiner in Tele. Pole N.W. 64.90'

IRON PIN IN CONC. E. 19.77'

Luckey Rd & Main St.

160 rods S. N.W. cor. sec

28 Troy twp.

Fd. E.R. spike Iron Pin

Luckey Rd & S.E. #582 9/14/65

#462

38

Iron Pin

N Cor. Ho. NW 46.19

NW Cor. Ho Fdn SE 50.90

Face Curh N E 68.57

Ties from
F. Gossman's notes

Shi. 10" maple N.W.

S.H. 582

39 #462

S.W. cor.

ho. fdn.

Shi. in 3rd Post From N.
N.W. cor top house fdn.

W. S.E. 23.68'

East point N.E. 21.96'

P.P. brace pole S.W. 35.24'

T.P. brace pole N.W. 26.70'

P.P. S.E. 37.01' ~~36.72~~~~36.95~~

S.H. 582 Keotzer Ave.

O.K.

20.36'

31.75'

32.39'

Shi. S.E.



PERSONNEL TITLE PERSONNEL TITLE

COUNTY Wood

DATE

12-27-57

Sworden 4-6-60

S. R.

#582

WEATHER

SEC.

TEMP.

DESCRIPTION

LEFT

CENTER LINE

RIGHT

JOB NO.

N.W. Cor. sec. 28 Troy Twp.
 E.R. spike over stone
 Luckey Rd & S.R. #582

#460

37

Iron Pin

O.K.

Face Cor. Post 2' above G.E. E.N.E. 43.54
 Conc. marker N.E. 34.44
 Conc. marker S.E. 42.85
 S.E. cor. House fdn. N.W. 87.0'
 X in N.E. Cor. N. Hdwl. N.E. 33.00' ~~33.00~~
 X in N.E. Cor. S. Hdwl. S.E. 27.85' ~~27.82~~

80 rods S. N.W. cor. sec. 28
 Troy Twp.
 Boat spk. over stone

#461

37A

O.K.

Shiner in 30" maple S.S.E. 55.67'
 Cor. of frame house S.E. 57.0'
 Shiner in 18" Cottonwood S.E. 26.52
 Shiner in P.P. E. 24.91'
 Shiner in Tele. Pole N.W. 64.90'

160 rods S. N.W. cor. sec
 28 Troy twp.
 Fd. E.R. spike
 Luckey Rd & S.R. #582

#462

38

O.K.

East point N.E. 21.96'
 P.P. brace pole S.W. 35.13' ~~35.20~~
 T.P. brace pole N.W. 26.71'
 P.P. S.E. 36.92' ~~36.95~~

Shi. 10"
 maple N.W.

S.H. 582

63.08'

S.H. 582

31.75'

Shi. S.E.

S.W. cor.
 ho. Adn.

Res.



39

#462-A