

O.D.O.T. DISTRICT 2 SURVEY OFFICE

PERSONNEL

REFERENCE NO. 37 A

SHEET 19 OF 20

NOTES BARNHISEL

DATE 05/20/05

ROUTE S.R. 582

H.C. CANTERBURY

WEATHER SUNNY

COUNTY WOOD

R.C. MIKLOVIC

TEMP. +65°

TOWNSHIP TROY

SECTION 28

T 6 N R 12 E

TYPE MONUMENT PK & WASHER

ON SURFACE - ~~BELOW~~ YES



LEFT - Q PAV'T ~~RIGHT~~ 6.7'

3.2' TO LT EDGE PAVEMENT

S.L.M. 730+37


GRID: NORTHING:

EASTING:

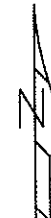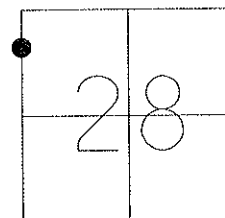

RECORD: $\frac{1}{16}$ COR. OF SEC 28

RESET MAG NAIL & WASHER
09/02/05
MDB

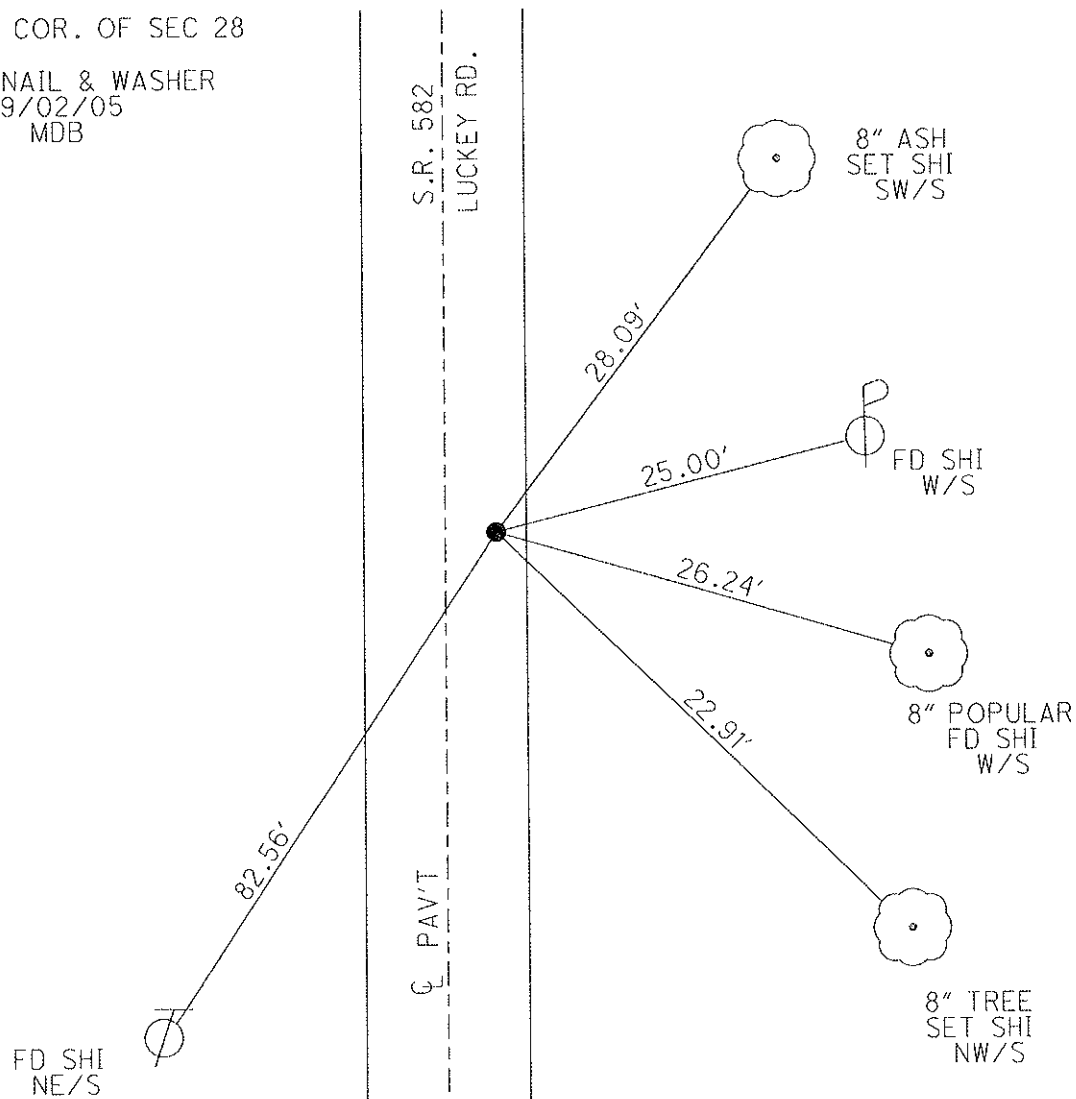

O.D.O.T. DISTRICT 2 SURVEY OFFICE

PERSONNEL

REFERENCE NO. 37 A

SHEET 19 OF 21

NOTES BARNHISEL

DATE 05/20/05

ROUTE S.R. 582

H.C. CANTERBURY

WEATHER SUNNY

COUNTY WOOD

R.C. MIKLOVIC

TEMP. +65°

TOWNSHIP TROY

SECTION 28

T 6 N R 12 E


TYPE MONUMENT PK & WASHER

ON SURFACE - ~~BELOW~~ YES

LEFT - Q PAV'T - ~~RIGHT~~ 6.7'


3.2' TO L EDGE PAVEMENT

S.L.M. 730+37

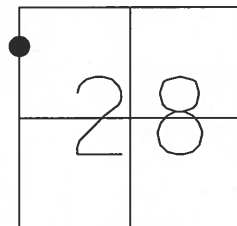

RECORD: $\frac{1}{16}$ COR. OF SEC 28

RESET MAG NAIL & WASHER
09/02/05
MDB

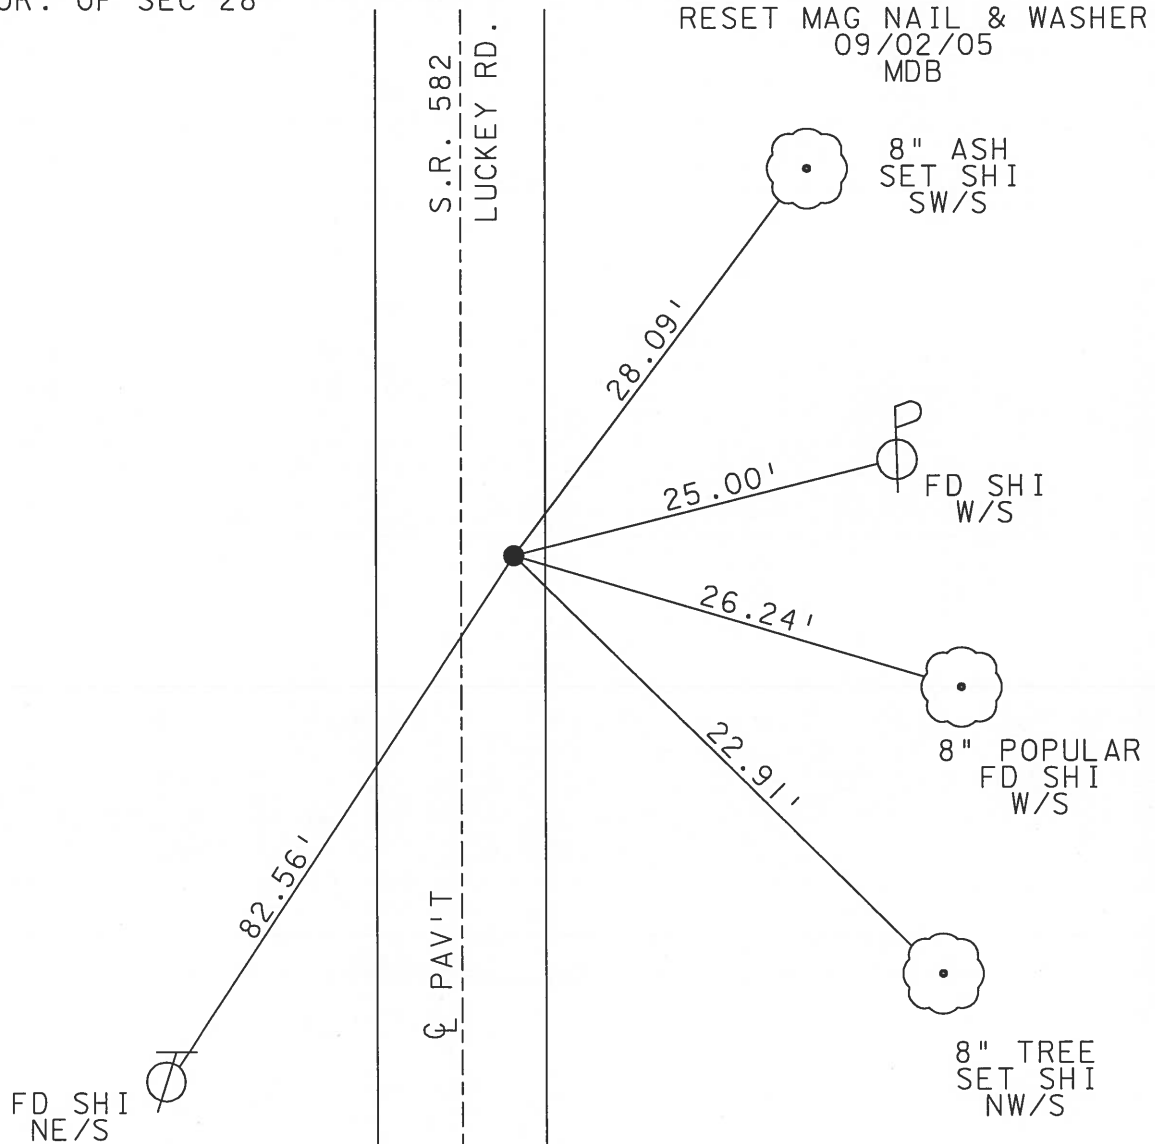

O.D.O.T. DISTRICT 2 SURVEY OFFICE

PERSONNEL

REFERENCE NO. 37-A

SHEET OF

NOTES LOEHRIKE

H.C. Hoffman

R.C. Steinhauer

DATE 7-13-90

WEATHER CLOUDY-WINDY

TEMP. +65

ROUTE S.R. 582

COUNTY WOOD

TOWNSHIP TROY

SECTION 28

T. 6 N. R. 12 E.


TYPE MONUMENT Sm R.R. Spike

ON SURFACE - BELOW Yes

LEFT - 0 PAV'T. - RIGHT 6.7


3.2 TO Lt EDGE PAVEMENT

S.L.M. 730+37

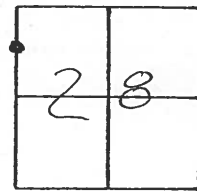

Set P.K./Washer
11-6-90
mB

1/16 COR. Sec. 28

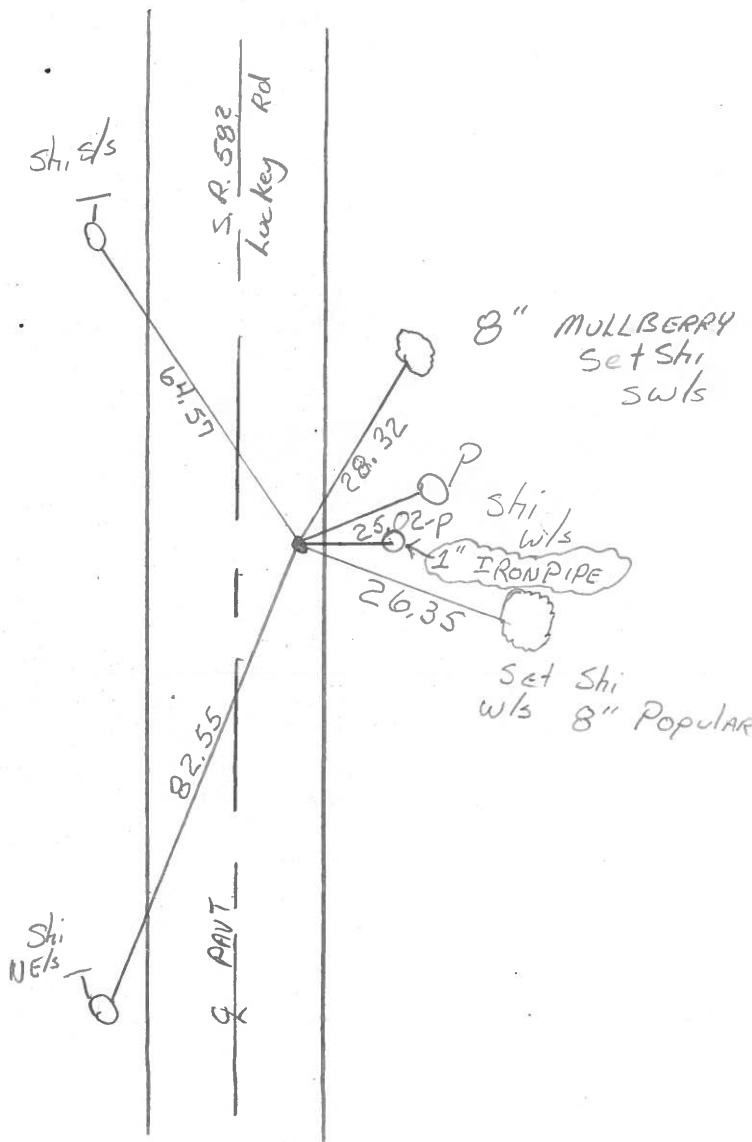

Q.D.O.T. DISTRICT 2 SURVEY OFFICE

SHEET 16 OF

County Wood S.R. 582

Township Troy

Section 28

T N, R E

Personnel L. Stone

P. Neuse


R. Michalak

D. Curtis

Date 12 July 83

Weather Warm

Temp. 90°

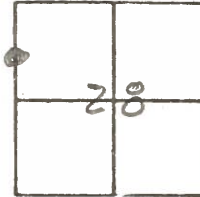

SLM STA. 730+34

REF. NO. 37 A



1" I. pin in
con. hole (P)
19.69'

25.00'
Shiner

82.54'

Shiner

64.58'

Shiner

Ed. 1" I. pin 4" deep

1/16 con. Sec. 28

4.2' to E. edge put.

15.9' to W. edge put.

582

582

Q.D.O.T. DISTRICT 2 SURVEY OFFICE

SHEET 16 OF

County Wood S.R. 582

Township Troy

Section 28

T N, R E

Personnel 1. Stone

P. Neuser


R. Michalak

D. Curtis

Date 12 July 83

Weather Warm

Temp. 90°

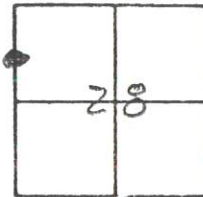


SLM STA. 730+34

REF. NO. 37 A




SM Rd gpk
6.7 E
3.2 to LHP
730+37

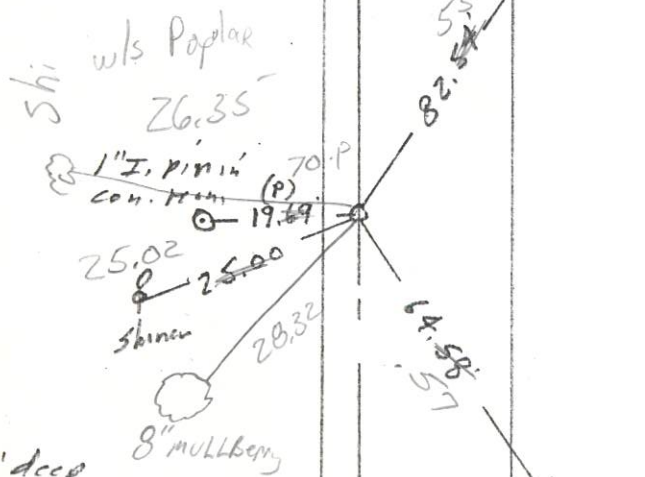

Ed. 1" I. pin 4" deep
1/16 con. Sec. 28
4.2' to E edge put.
15.9' to W edge put.

PERSONNEL	TITLE	PERSONNEL	TITLE	COUNTY	DATE	WEATHER	TEMP.
Morrison				Wood	April, 11, 1968	Clear	+50°
Bowers				S. R. #582			
Holcombe				SEC. Luckey			
DESCRIPTION				Ties to Control points		JOB NO.	

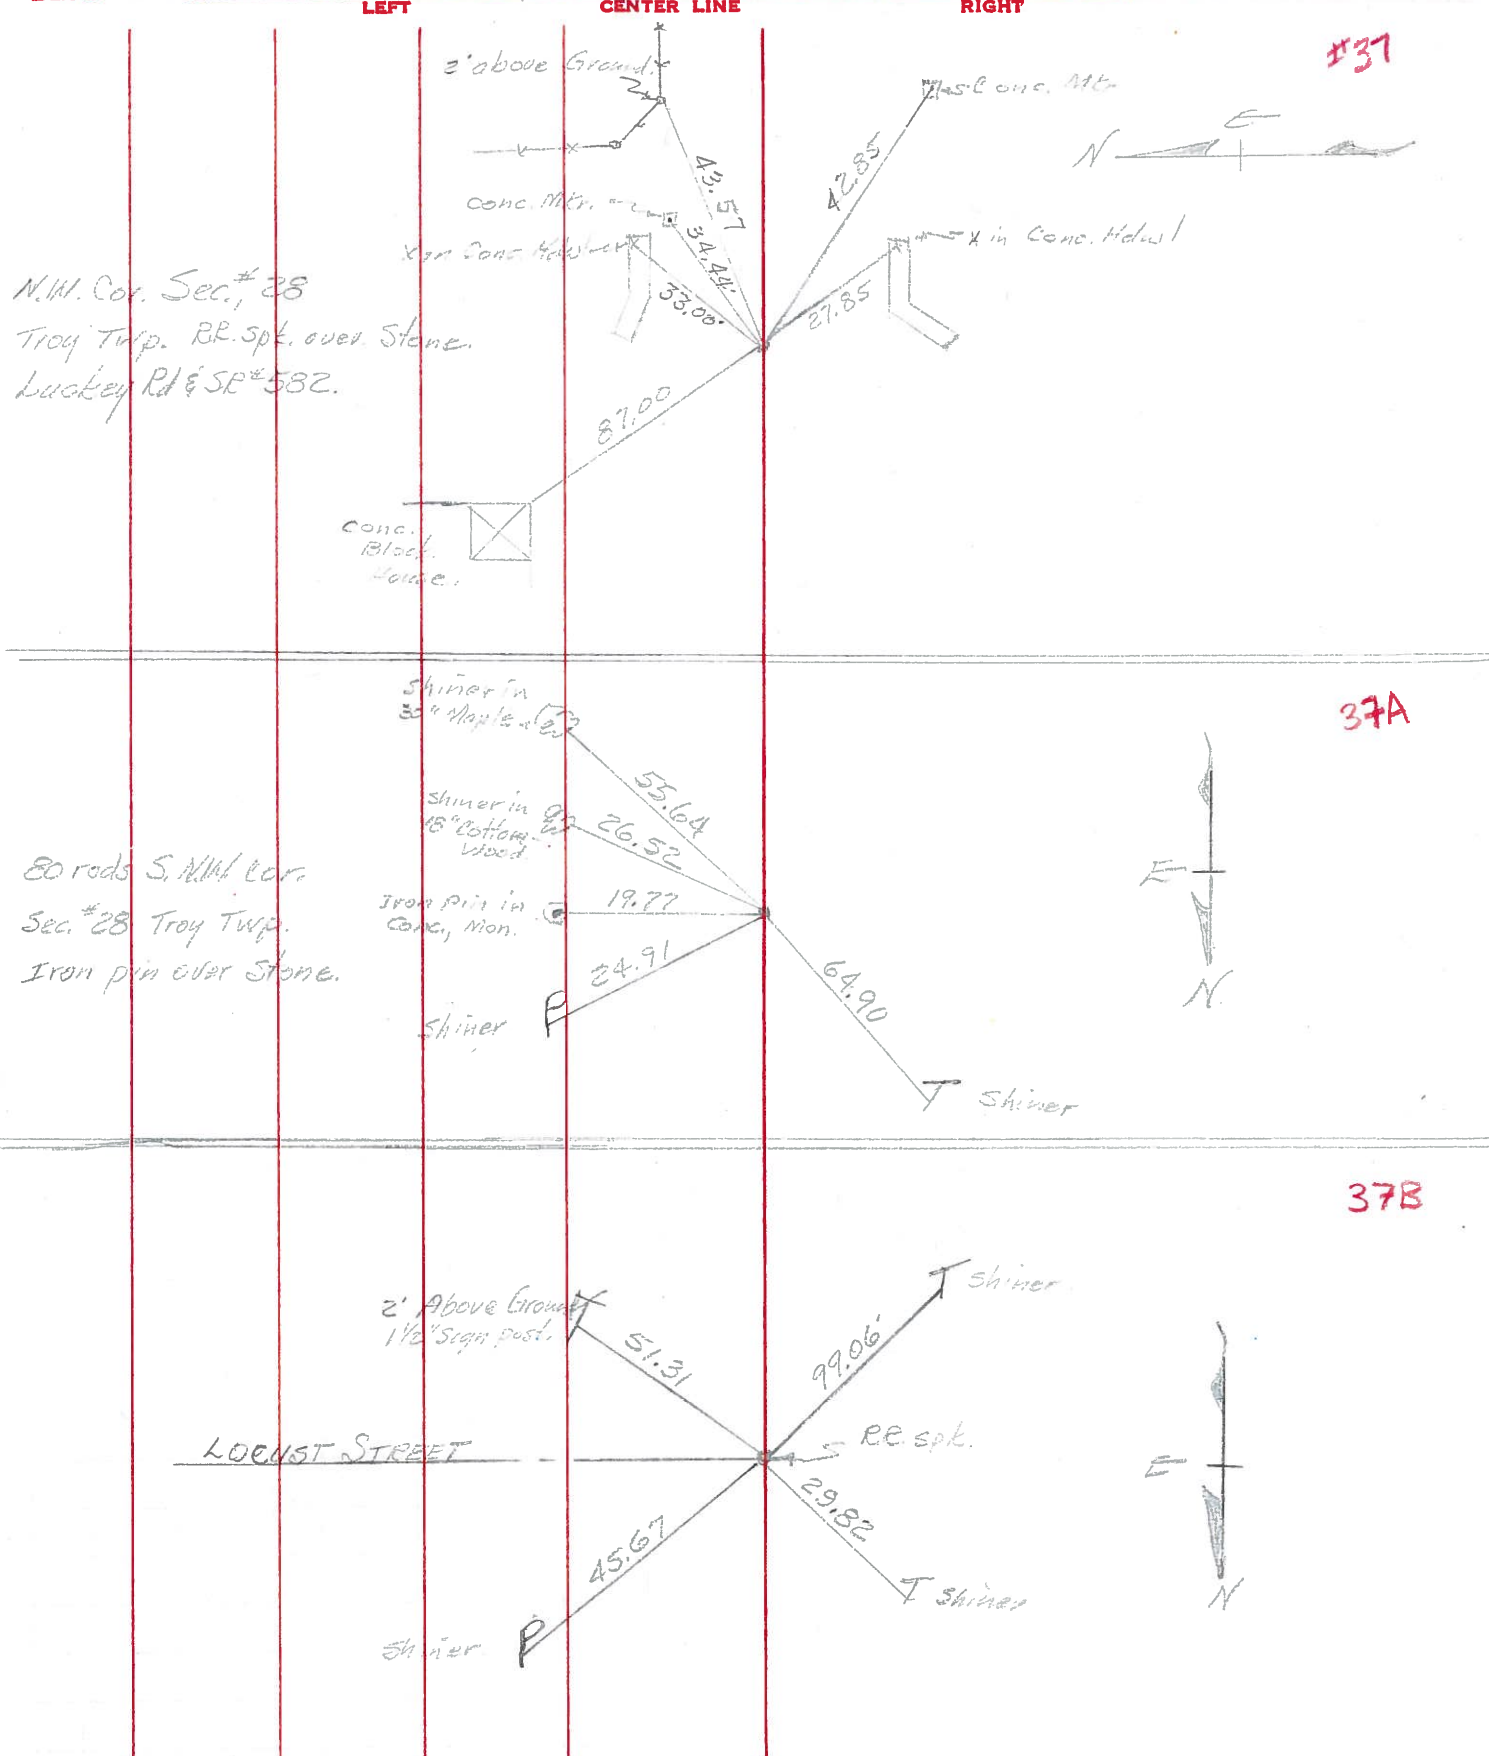

PERSONNEL	TITLE	PERSONNEL	TITLE	COUNTY	DATE
				Wood	12-27-57
				S. R. #582	Sworden 4-6-60
				SEC.	WEATHER
					TEMP.

DESCRIPTION LEFT CENTER LINE RIGHT JOB NO.

9/14/65
F.I. Iron pin 1/2" below Post.
N.W. Cor. sec. 28 Troy Twp.
R.R. spike over stone Iron Pin
Luckey Rd & S.R. #582
OK
Face Cor. Post 2' above Gr. E.N.E. 43.34
Conc. marker N.E. 34.44
Conc. marker S.E. 42.85
S.E. cor. House fln. N.W. 87.0
X in N.E. Cor. H. Hdwl. N.E. 33.00
X in N.E. Cor. S. Hdwl. S.E. 27.85
#460 37
1338.90

80 rods S. N.W. cor. sec. 28
Troy Twp.
Boat spike over stone
Iron End
9/14/65 #461 37A
Shiner in 30" maple S.E. 55.84
Cor. of frame house S.E. 57.0
Shiner in 18" cottonwood S.E. 26.52
Shiner in P.P. E. 24.91
Shiner in Tele. Pole N.W. 64.90
IRON PIN IN CONC. E. 19.77

Luckey Rd & Main St.
160 rods S. N.W. cor. sec.
28 Troy Twp.
F.I. R.R. spike Iron Pin
Luckey Rd & S.E. #582 9/14/65
OK
Sh. in 3rd Post From N.
N.W. cor top house fln. W. 23.68
S.E. 65.95
East point N.E. 21.96
P.P. brace pole S.W. 35.24
T.P. brace pole N.W. 26.70
P.P. S.E. 37.01
36.25

Iron Pin
N Cor. Ho. NW 46.19
NW Cor. Ho Fdn SE 50.90
Face Curh N E 68.57

Ties from
F. Grossman's notes

Sh. 10"
maple N.W.
S.H. 582

39 #462

S.W. cor.
H. fln.

20.36
62.57

S.H. 582
Keotsee Ave.

32.39
Sh. S.E.

N.

PERSONNEL TITLE PERSONNEL TITLE

COUNTY Wood

DATE 12-27-57
Sworden 4-6-60

S. R. #582

WEATHER

SEC.

TEMP.

DESCRIPTION

LEFT

CENTER LINE

RIGHT

JOB NO.

N.W. Cor. sec. 28 Troy Twp.
F.R. spike over stone
Lucky Ed & S.R. #582

#460

37

Iron Pin

O.K.

Face Cor. Post 2' above Gr. E.N.E. 43.54
Conc. marker N.E. 34.44
Conc. marker S.E. 42.85
S.E. cor. House fdn. N.W. 87.0'
X in N.E. Cor. N. Hdwl. N.E. 33.00' ~~33.00~~
X in N.E. cor. S. Hdwl. S.E. 27.85' ~~27.82~~

80 rods S. N.W. cor. sec. 28
Troy Twp.
Boat spk. over stone

#461

37A

O.K.

Shiner in 30" maple S.E. 55.67'
Cor. of frame house S.E. 55.95
Shiner in 18" Cottonwood S.E. 57.0'
Shiner in P.P. E. 26.52
Shiner in P.P. E. 24.91'
Shiner in Tele. Pole N.W. 64.90'

160 rods S. N.W. cor. sec.
28 Troy twp.
Fd. F.R. spike
Lucky Ed & S.R. #582

#462

38

O.K.

East point N.E. 21.96'
P.P. brace pole S.W. 35.13' ~~35.20~~
T.P. brace pole N.W. 26.71'
P.P. S.E. 36.92'
36.95'

Shi. 10"
maple N.W.

S.H. 582

20.36'

S.H. 582

O.K.

31.75'

Shi. S.E.

39

#462-A

S.W. cor.
ho. Adn.

Res.

