

O.D.O.T. DISTRICT 2 SURVEY OFFICE

PERSONNEL

REFERENCE NO. 38

SHEET 1 OF 29

NOTES HOMAN

DATE 4/27/10

ROUTE S.R. 582

H.C. HOMAN

WEATHER SUNNY

COUNTY WOOD

R.C. ROUSOS

TEMP. 40°

TOWNSHIP TROY

SECTION 28

T 6 N R 12 E

TYPE MONUMENT MAG & WASHER



ON SURFACE - BELOW YES

LEFT - Q PAV'T - RIGHT 6.6'

15.5' TO RT EDGE PAVEMENT

S.L.M. 740+50 6.4' N. OF Q MAIN ST.

GRID: NORTHING: 651464.0772 EASTING: 1696457.7877

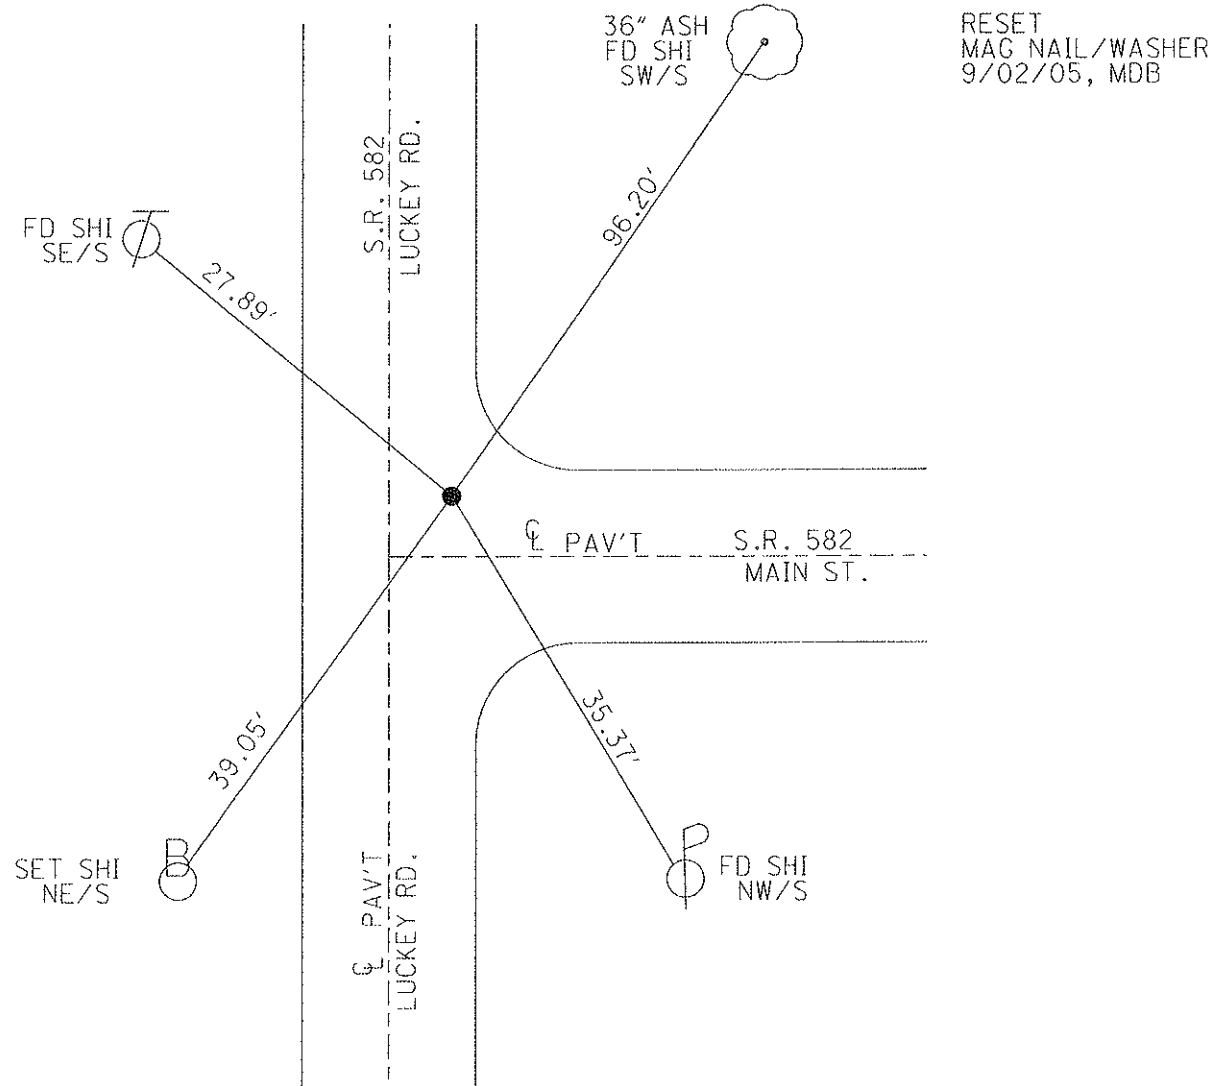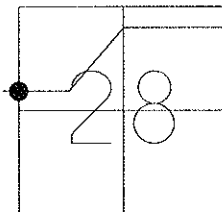

O.D.O.T. DISTRICT 2 SURVEY OFFICE

PERSONNEL

REFERENCE NO. 38

SHEET 21 OF 21

NOTES BARNHISEL

DATE 05/20/05

ROUTE S.R. 582

H.C. CANTERBURY

WEATHER SUNNY

COUNTY WOOD

R.C. MIKLOVIC

TEMP. +65°

TOWNSHIP TROY

SECTION 28

T 6 N R 12 E


TYPE MONUMENT PK & WASHER

ON SURFACE - ~~BELOW~~ YES


LEFT - Q PAV'T - ~~RIGHT~~ 6.6'

15.5' TO RT EDGE PAVEMENT

S.L.M. 740+50 6.4' N. OF CL MAIN ST.

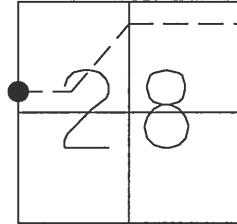

RESET MAG NAIL & WASHER
09/02/05
MDB

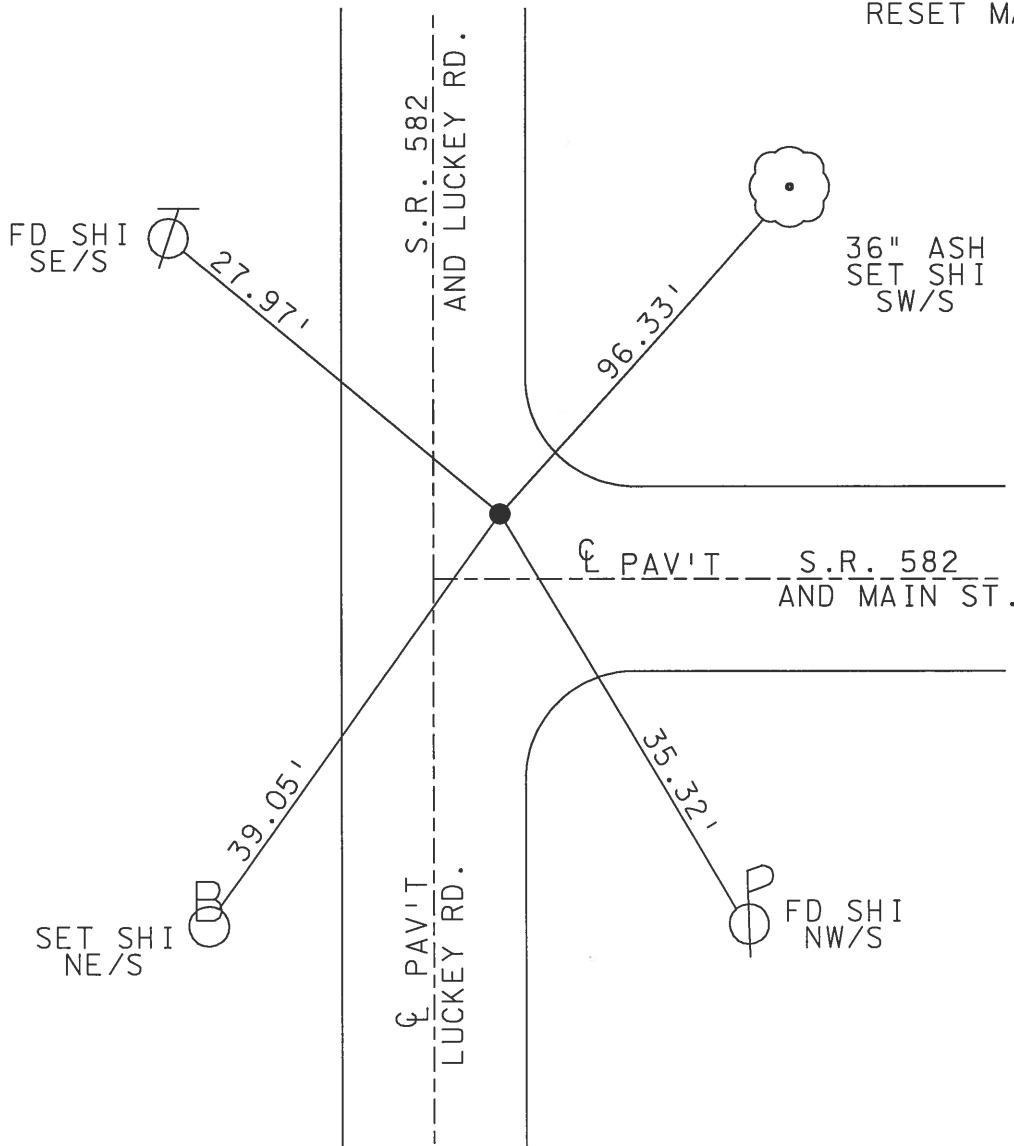

O.D.O.T. DISTRICT 2 SURVEY OFFICE

PERSONNEL

REFERENCE NO. 38

SHEET OF

NOTES LOEHRKE

H.C. Hoffman

R.G. Steinhause

DATE 7-13-90

WEATHER CLOUDY - WINDY

TEMP. +65

ROUTE S.R 582

COUNTY WOOD

TOWNSHIP TROY

SECTION 28

T 6 N R 12 E



TYPE MONUMENT Sm. R.R. Spike

ON SURFACE - BELOW Yes

LEFT- & PAV'T. - RIGHT 6.9' E of & Luckey Rd / 6.4' N of & MAIN ST.

16.4' TO RT. EDGE PAVEMENT

S.L.M. 740 +50

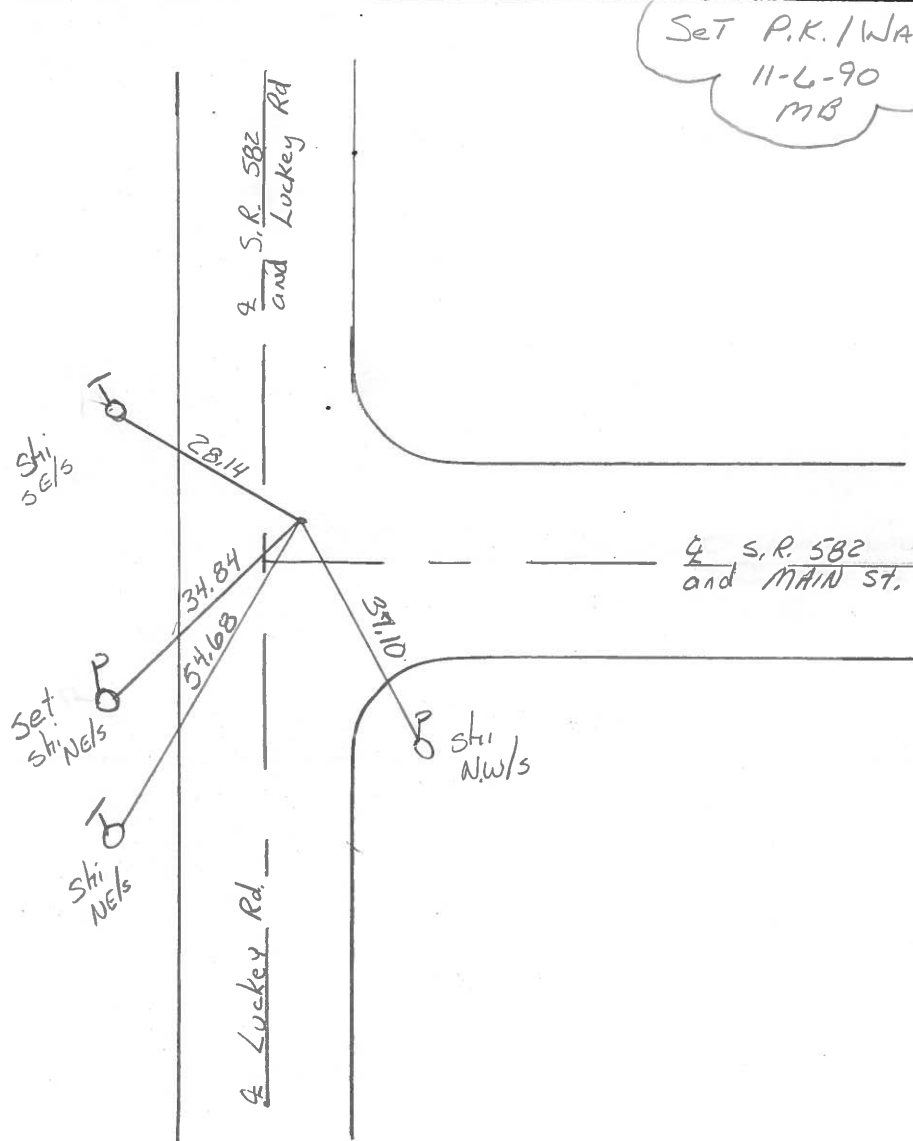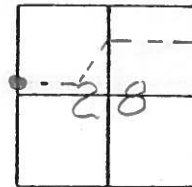

County Wood S.R. 582

Township Troy

Section 28

T N, R E

Personnel I. Stone

P. Neuser


R. Michalak

D. Curtis

Date 12 July 83


Weather Warm

Temp. 90°

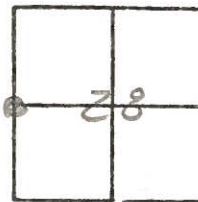

SLM STA. 740+46

REF. NO. 38

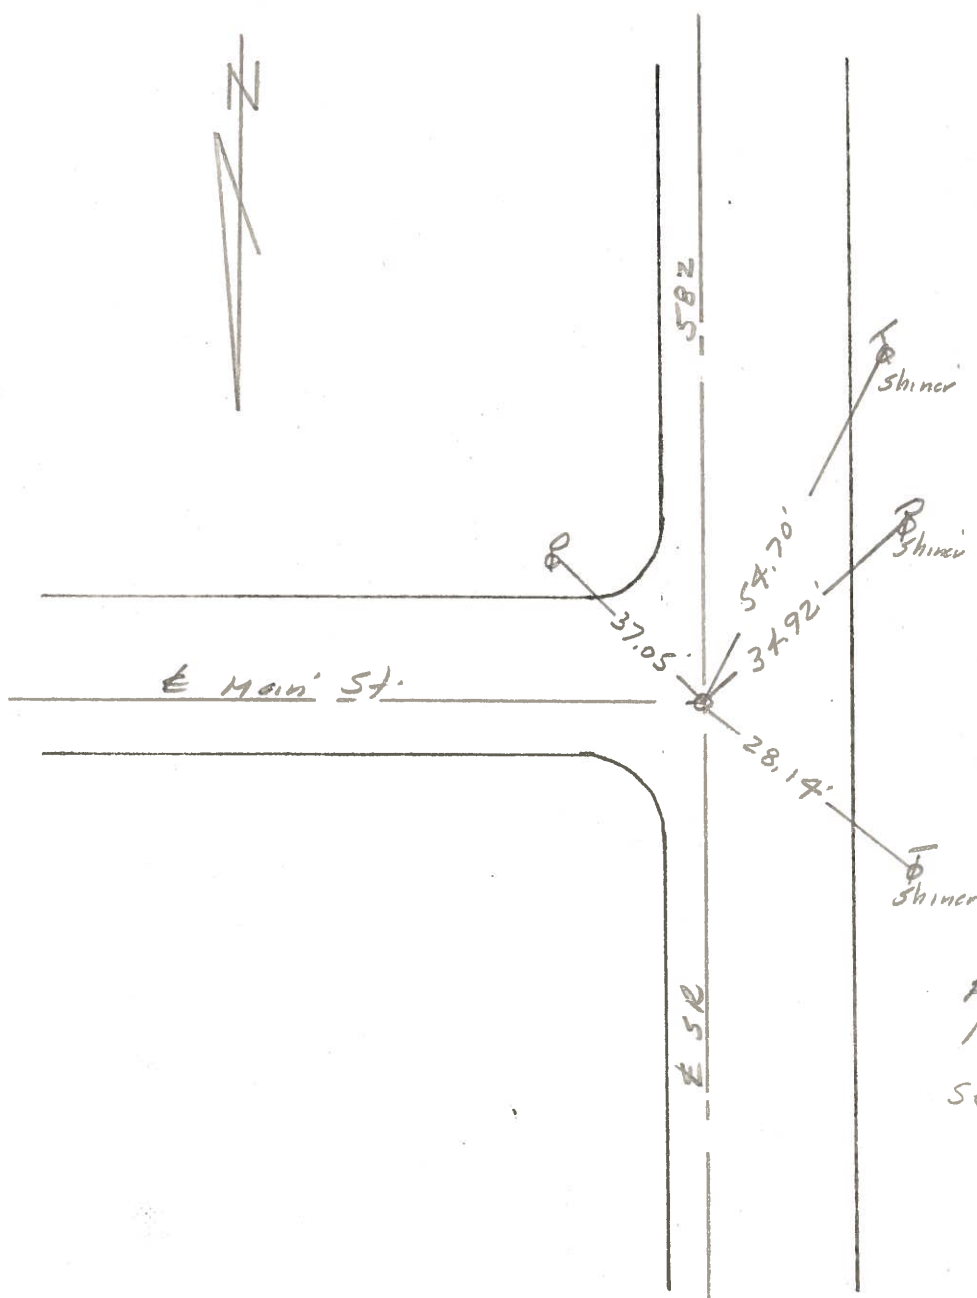

Ed. 1" I. Pin 2" deep
15.9' to W. edge put.
Set small R.R. Sph.

Q.D.O.T. DISTRICT 2 SURVEY OFFICE

SHEET 18 OF

County Wood S.R. 582

Township Troy

Section 28

T N, R E

Personnel I. Stone

P. Neuser


R. Michalak

D. Curtis

Date 12 July 83

Weather Warm

Temp. 90°

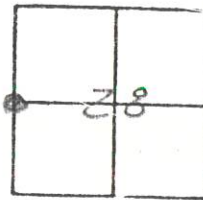

SLM STA. 740+46

REF. NO. 38



740+50

6.9 E of &

6.4 N of &

16.4 to REF

E Main St.

S.R.

S.R.

Shiner

Shiner

Shiner

37.05
54.70
34.92
28.14

FD. 1" I. Pin 2" deep
15.9' to W. edge put.
Set small R.R. Sph.

PERSONNEL TITLE PERSONNEL TITLE

Morrison

COUNTY Wood.

DATE April 11, 1968

Bowers.

S. R. #382

WEATHER Clear.

Holcombe.

SEC. Luckey

TEMP. +50°

DESCRIPTION Ties to Control Points.

JOB NO.

LEFT

CENTER LINE

RIGHT


160 rods, S. of N.W. Cor. Sec. #28

Troy Twp.

Iron pin

Luckey Rd. & SR #582.

Main Street.

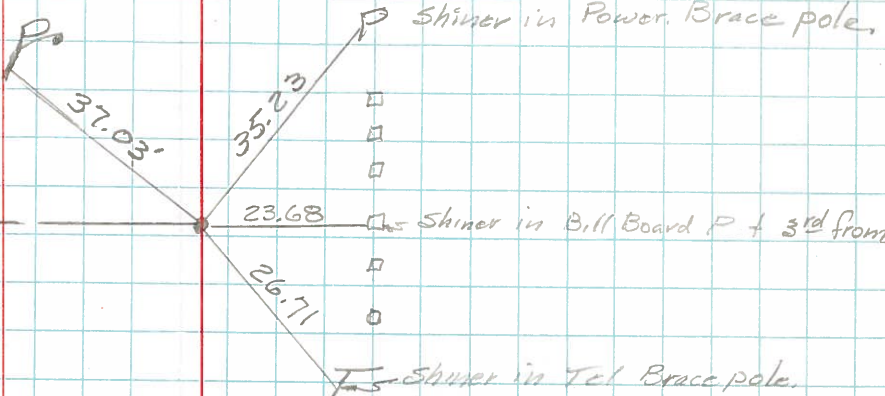


#38

Shiner in 14" Elm

38A

Maple Street

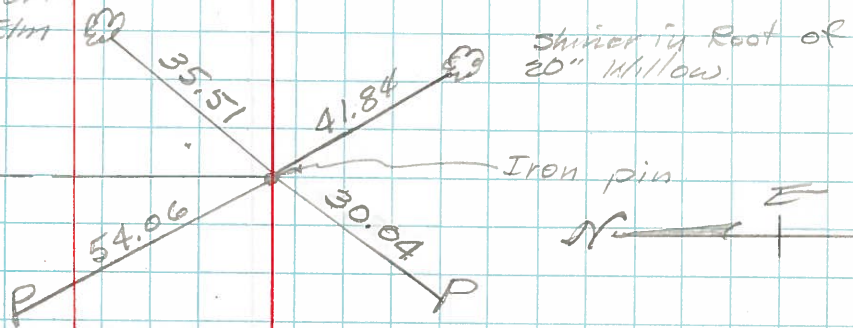


38B

Shiner in 20" Box E.

Shiner.

Park Drive.

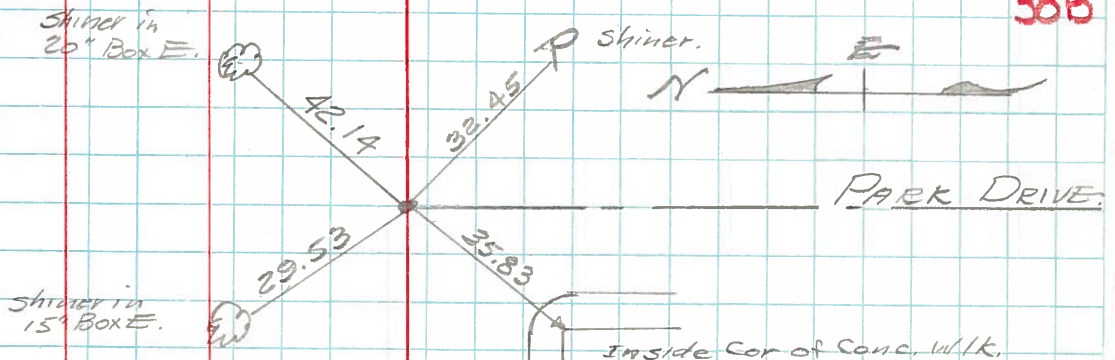

PERSONNEL	TITLE	PERSONNEL	TITLE

COUNTY WoodDATE 12-27-57Sworden 4-6-60S. R. #582

WEATHER

SEC.

TEMP.

DESCRIPTION

LEFT

CENTER LINE

RIGHT

JOB NO.

9/14/65
 Fd. Iron pin 1/2" below Post.
 N.W. Cor. sec. 28 Troy Twp.
 E.R. spike over stone
 Luckey Rd & S.R. #582

OK

Face Cor. Post 2' above Gr. E.N.E. 43.34'
 Conc. marker N.E. 34.44'
 Conc. marker S.E. 42.85'
 S.E. cor. House P.M. N.W. 87.0'
 X in N.E. Cor. N. Hdwl. N.E. 33.00' ~~33.32~~
 X in N.E. cor. S. Hdwl. S.E. 27.85' ~~27.82~~

1
 #460 **37**
 1338.90

80 rods S. N.W. cor. sec. 28
 Troy Twp.
 Boat spike over stone
 Iron Rod

OK

Shiner in 30" maple S.E. 55.64'
 Cor. of frame house S.E. 57.0'
 Shiner in 18" cottonwood S.E. 26.52'
 Shiner in P.P. E. 24.91'
 Shiner in Tele. Pole N.W. 64.90'
 IRON PIN IN CONC. E. 19.77'

9/14/65 #461 **37A**

Luckey Rd & Main St.
 160 rods S. N.W. cor. sec.
 28 Troy Twp.
 Fd. E.R. spike Iron Pin
 Luckey Rd & S.R. #582 9/14/65

OK

S.H. in 3rd Post From N. W. 23.68'
 N.W. cor top house P.M. S.E. 65.95'
 East point N.E. 21.96'
 P.P. brace pole S.W. 35.24'
 T.P. brace pole N.W. 26.70'
 P.P. S.E. 37.01' ~~37.72~~
 35.95'

Iron Pin
 N Cor. No. ~~46~~ NW 46.19
 NW Cor. Ho P.M. SE 50.90
 Face Cor. N.E. 68.57

#462

Ties from
 F. G. Gorman's notes

Shi. 10"
 maple N.W.

S.H. 582

39 #462

S.W. cor.
 br. 1/4 in.

5.H. 582
 KROTZER AVE.

OK

20.36'

42.65'

62.57'

32.39'

Shi. S.E.

N.

PERSONNEL TITLE PERSONNEL TITLE

COUNTY Wood

DATE 12-27-57
Sworden 4-6-60

S. R. #582

WEATHER

SEC.

TEMP.

DESCRIPTION

LEFT

CENTER LINE

RIGHT

JOB NO.

N.W. Cor. sec. 28 Troy Twp.
E.R. spike over stone
Luckey Rd & S.R. #582

#460

37

Iron Pin

O.K.

Face Cor. Post 2' above Gc. E.N.E. 43.54
Conc. marker N.E. 34.44
Conc. marker S.E. 42.85
S.E. cor. House fdn. N.W. 87.0'
X in N.E. Cor. N. Hdwl. N.E. 33.00' ~~33.00~~
X in N.E. Cor. S. Hdwl. S.E. 27.85' 27.82

80 rods S. N.W. cor. sec. 28
Troy Twp.
Boat spk. over stone

#461

37A

O.K.

Shiner in 30" maple S.S.E. 55.67'
Cor. of frame house S.E. 55.95
Shiner in 18" Cottonwood S.E. 26.52
Shiner in P.P. E. 24.91'
Shiner in Tele. Pole N.W. 64.90'

160 rods S. N.W. cor. sec.
28 Troy twp.
Fd. E.R. spike
Luckey Rd & S.E. #582

#462

38

O.K.

East point N.E. 21.96'
P.P. brace pole S.W. 35.13' ~~35.20~~
T.P. brace pole N.W. 26.71'
P.P. S.E. 36.92'
36.95'

Shi. 10"
maple N.W.

S.H. 582

20.36'

S.H. 582

O.K.

63.08'

31.75'

Shi. S.E.

S.W. cor.
hn. Adn.

Res.



39

#462-A