

O.D.O.T. DISTRICT 2 SURVEY OFFICE

PERSONNEL

REFERENCE NO. 38 A

SHEET 2 OF 29

NOTES HOMAN

DATE 4/27/10

ROUTE SR 582

H.C. HOMAN

WEATHER SUNNY

COUNTY WOOD

R.C. ROUSOS

TEMP. 40°

TOWNSHIP TROY

SECTION 28

T 6 N R 12 E

TYPE MONUMENT SM. R.R. SPK.


~~ON SURFACE~~ - BELOW 2"

~~LEFT~~ - Q PAV'T - RIGHT 3' RIGHT / 4' EAST OF Q MAPLE

12.4' TO RT EDGE PAVEMENT

S.L.M. 744+81.22 REC


GRID: NORTHING: 651462.247 EASTING: 1696966.224

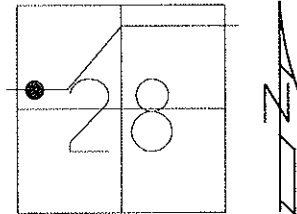

SET PK/WASHER
11-06-90 MB

RESET MAG & WASHER
NEWREFA38 7-8-10 DCH

NOTE: FILE 84803 CTNL

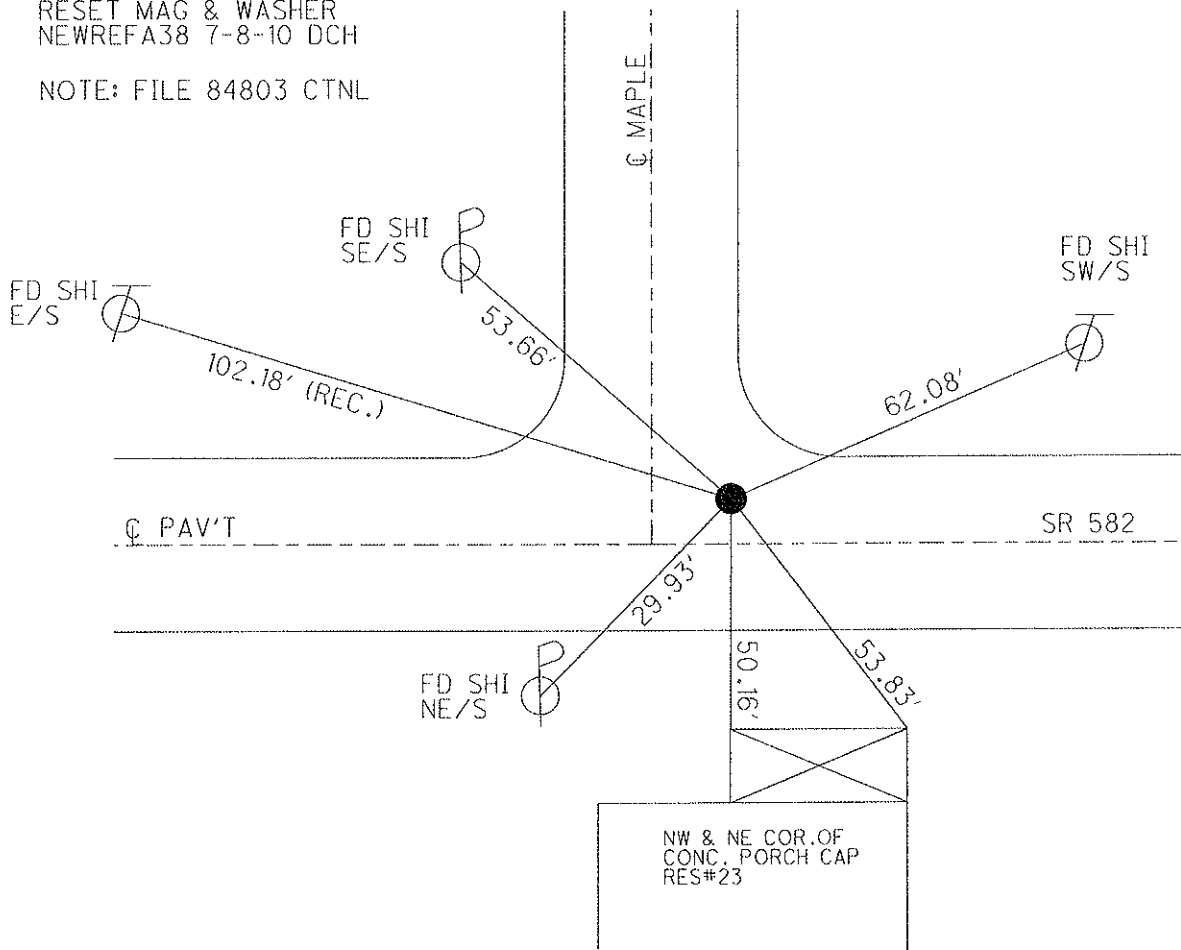

O.D.O.T. DISTRICT 2 SURVEY OFFICE

PERSONNEL

REFERENCE NO. 38-A

SHEET ____ OF ____

NOTES LOGHRKE

H.C. Hoffman

R.C. Stein hauser

DATE 7-13-90

WEATHER Cloudy - Windy

TEMP. +65

ROUTE S.R. 582

COUNTY Woods

TOWNSHIP TRO 4

SECTION 28

T. 6 N R. 12 E



TYPE MONUMENT Sm. R.R. spike

ON SURFACE - BELOW Yes

LEFT - PAV'T. - RIGHT 3.0' / 4.0' East of Maple

12.4 TO R+ EDGE PAVEMENT

S.L.M. 745 + 71

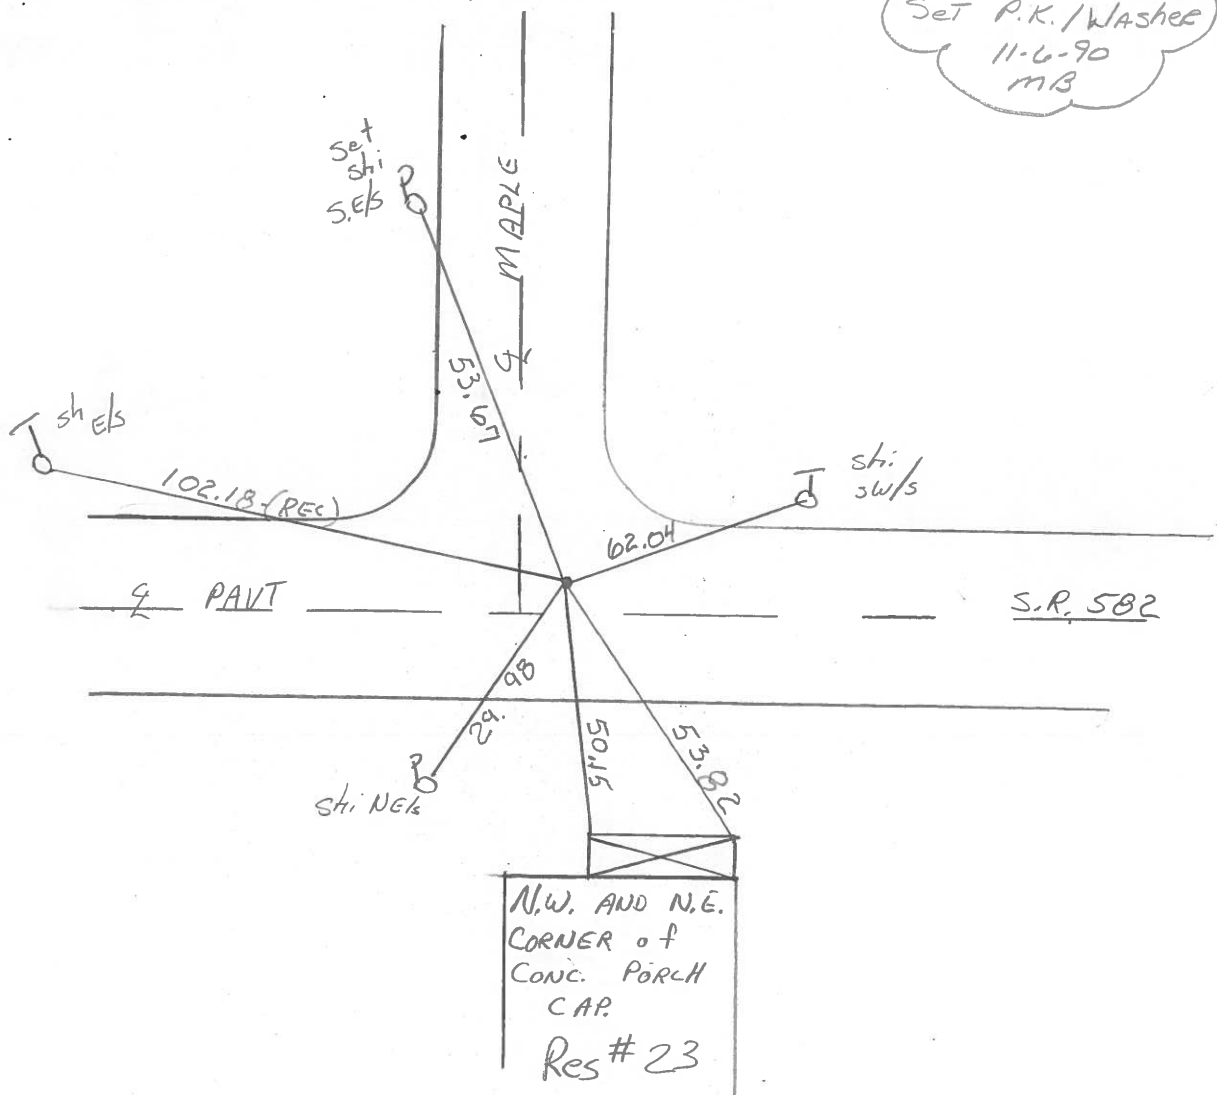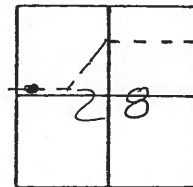

Q.D.O.T. DISTRICT 2 SURVEY OFFICE

SHEET 19 OF

County Wood S.R. 582

Township Troy

Section 28

T.N, R.E

Personnel L. Stone

P. Newson


R. Michalak

D. Curtis

Date 12 July 83


Weather Warm

Temp. 91°

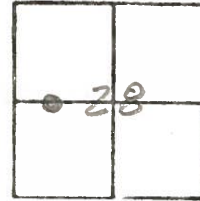

SLM Sta.

REF. NO. 38A

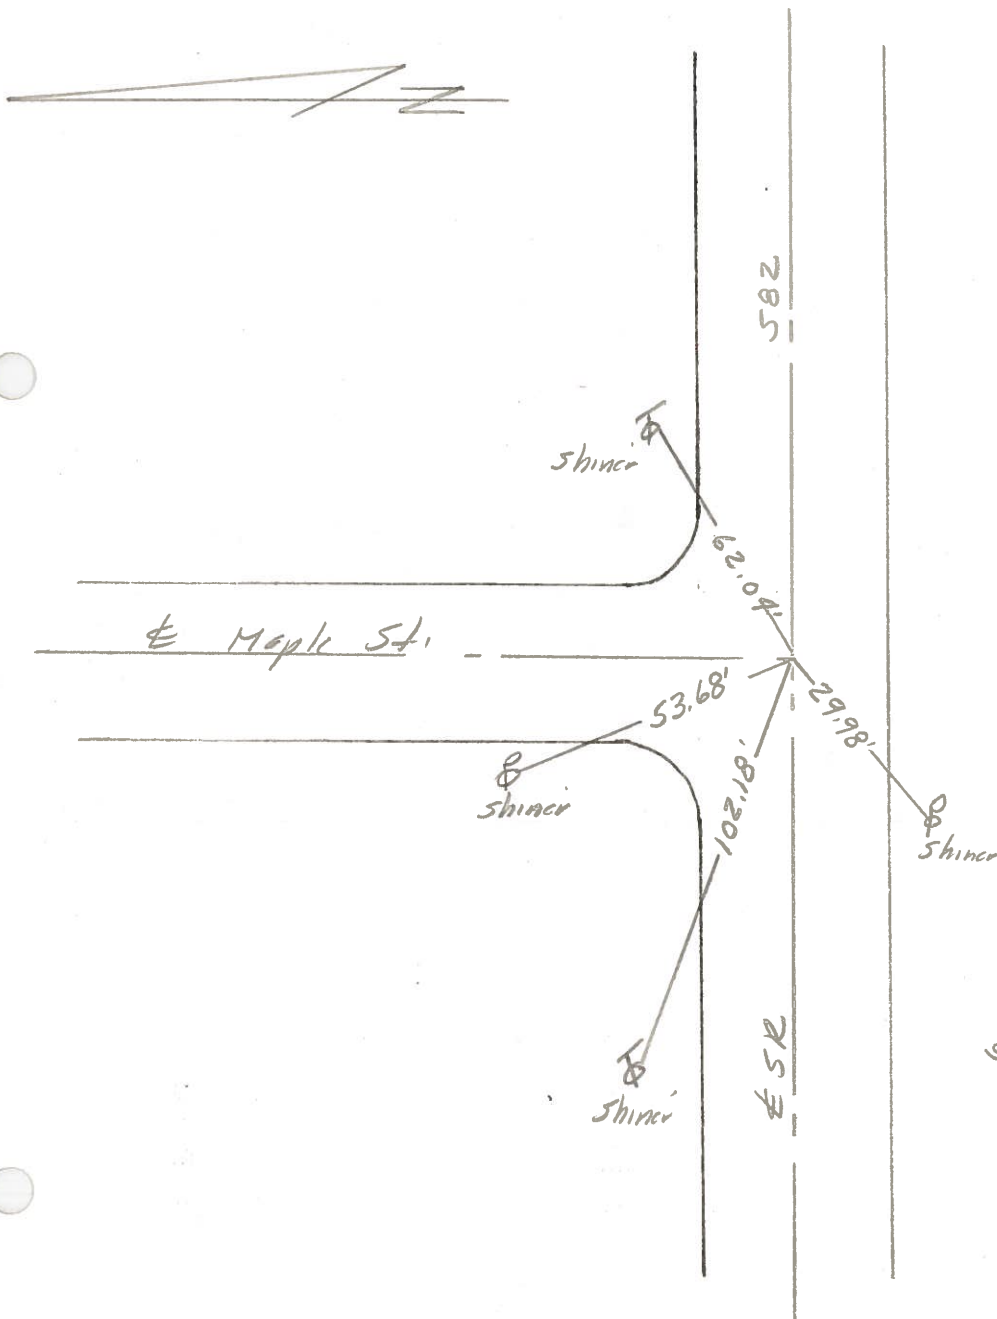

Fd. 1" I. pin 4" deep
12.5' to S. edge put.
set 5m. R-R. Spk.

Q.D.O.T. DISTRICT 2 SURVEY OFFICE

SHEET 19 OF

County Wood S.R. 582

Township Troy

Section 28

T N, R E

Personnel L. Stone

P. Newson


R. Michalak

D. Curtis

Date 12 July 83


Weather Warm

Temp. 91°

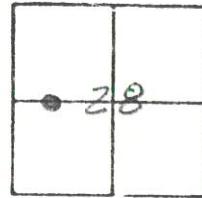

SLM Sta.

REF. NO. 38A

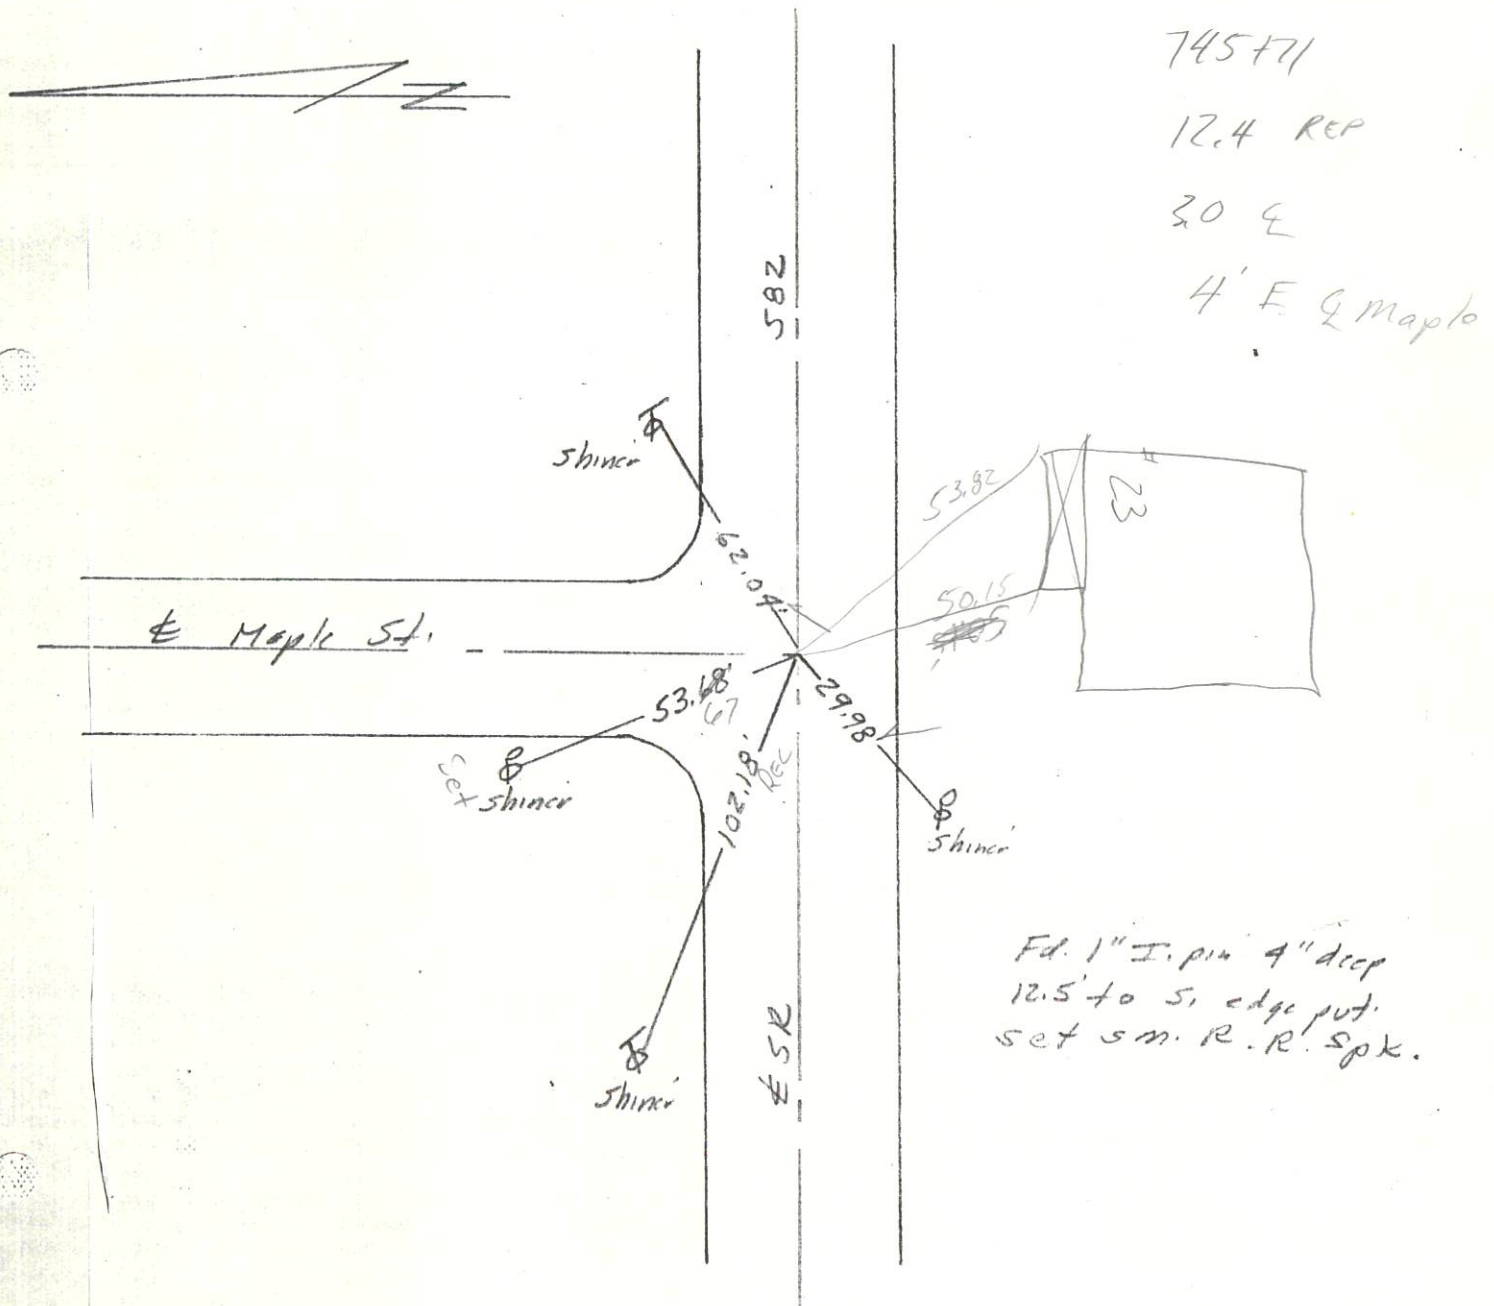

PERSONNEL TITLE PERSONNEL TITLE

Morrison

COUNTY Wood.

DATE April 11, 1968

Bowers

S. R. #582

WEATHER Clear.

Holcombe

SEC. Lucky

TEMP. +50°

DESCRIPTION Ties to Control Points.

JOB NO. _____

LEFT

CENTER LINE

RIGHT

160 rods S. of NW Cor. Sec. #28

Troy Twp.

Iron pin

Lucky Rd. E SR #582

Main Street.



P

37.03'

P

35.63'

Shiner in Power Brace pole.

23.68

26.71

Shiner in Power Brace pole.

#38

Shiner in 14" Elm.

P

35.51'

P

41.84'

Shiner in 20" Elm.

38A

Maple Street.

P

54.06'

P

30.04'

Iron pin



Shiner in 20" Box E.

P

42.14'

P

28.45'

Shiner.

38B

Shiner in 15" Box E.

P

29.53'

P

35.83'

Inside Cor of Conc. Walk.

Park Drive.

