

O.D.O.T. DISTRICT 2 SURVEY OFFICE

PERSONNEL

REFERENCE NO. 38 B

SHEET 3 OF 29

NOTES HOMAN

DATE 4-27-10

ROUTE SR 582

H.C. HOMAN

WEATHER SUNNY

COUNTY WOOD

R.C. ROUSOS

TEMP. 40°

TOWNSHIP TROY

SECTION 28

T 6 N R 12 E

TYPE MONUMENT P.K. NAIL


~~ON SURFACE~~ - BELOW 2"

LEFT - Q PAV'T - ~~RIGHT~~ 1.0', (2.5' E OF Q PARK)

9.8' TO LT. EDGE PAVEMENT


S.L.M. 747+59.08

GRID: NORTHING: 651461.262 EASTING: 1697244.118

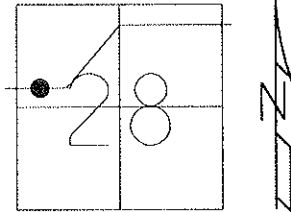

SET PK/WASHER
11-6-90 MB

RESET MAG/WASHER
NEWREFB38 7-08-10 DCH

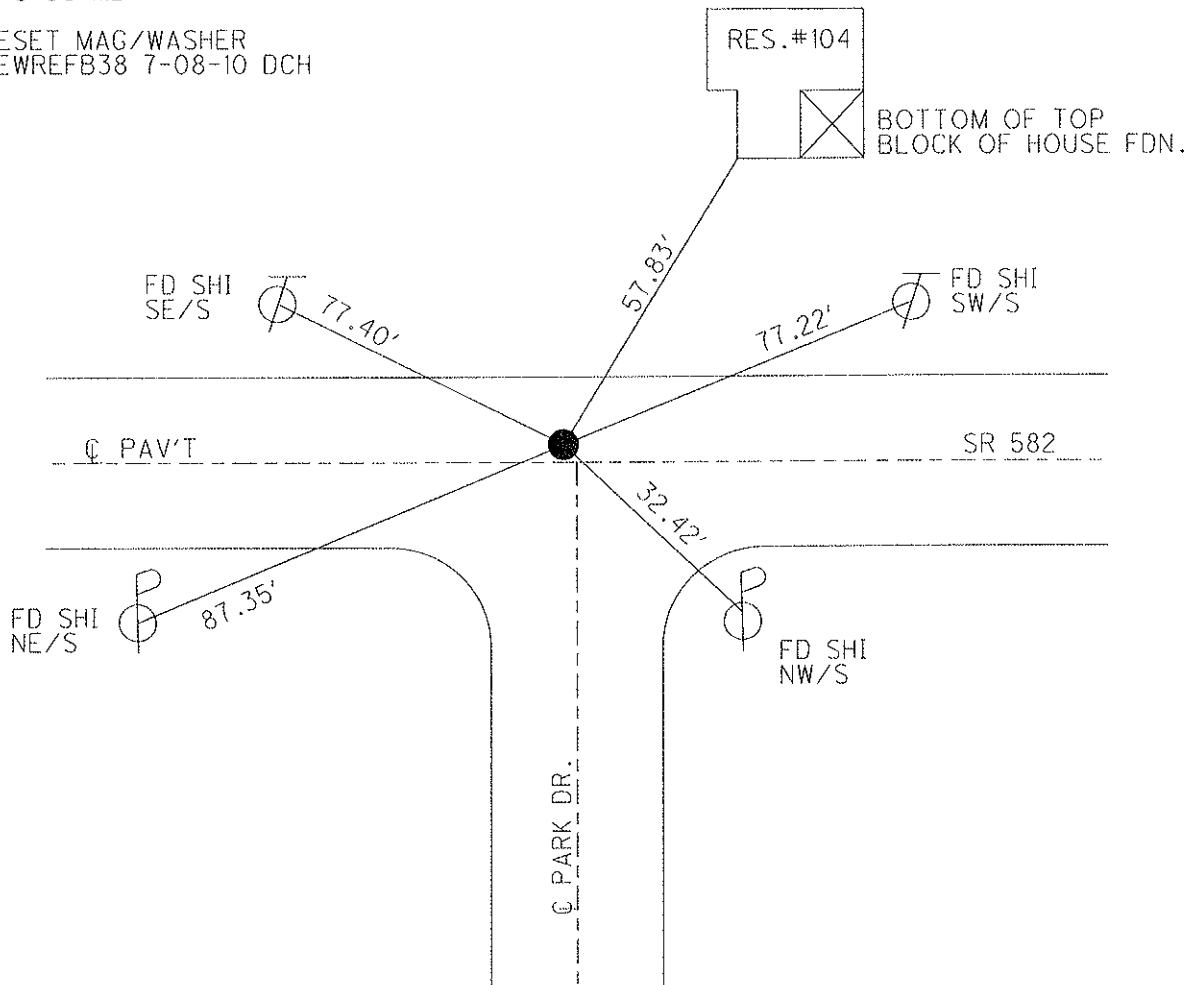

O.D.O.T. DISTRICT 2 SURVEY OFFICE

PERSONNEL

REFERENCE NO. 38-3

SHEET OF

NOTES LOEHRKE

H.C. Hoffman

R.C. Steinhäuser

DATE 7-13-90

WEATHER Cloudy-Windy

TEMP. +65

ROUTE S R 582

COUNTY WOOD

TOWNSHIP TROY

SECTION 28

T 6 N R 12 E


TYPE MONUMENT P.K. NAIL

ON SURFACE - BELOW yes


LEFT-C PAV'T. - RIGHT 1.0 / 2.5' E of C PARK

9.8 TO Lt EDGE PAVEMENT

S.L.M. 748149

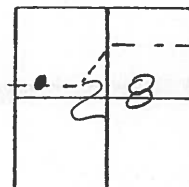

Set P.K. / Washer
11-6-90
MB

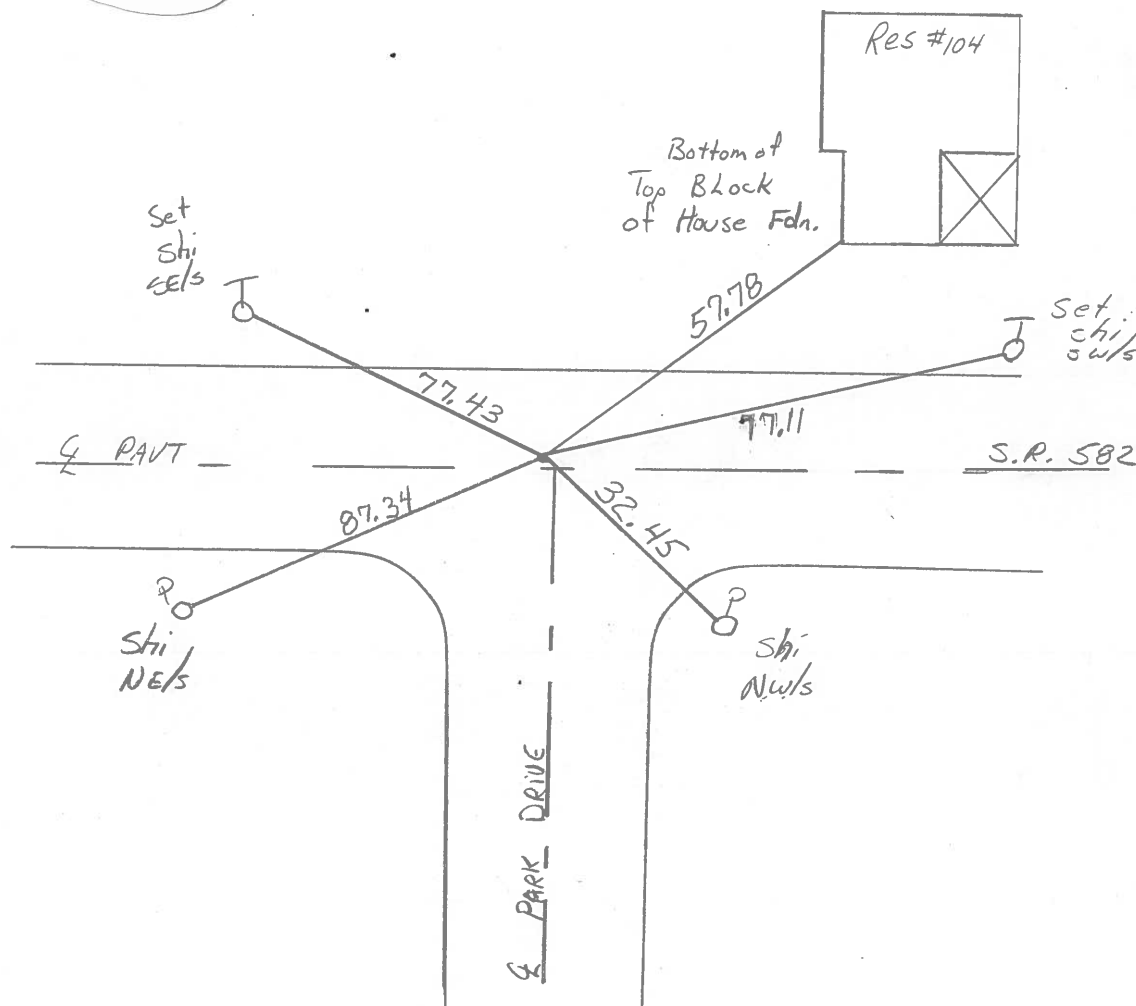

County Wood S.R. 582

Township Troy

Section 28

T N, R E

Personnel I. Stone

P. Newser


R. Michalak

D. Curtis

Date 12 July 83


Weather Warm

Temp. 91°

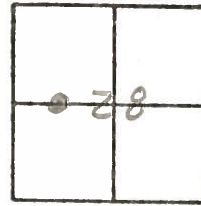

SLM STA. 748+43

REF. NO. 388

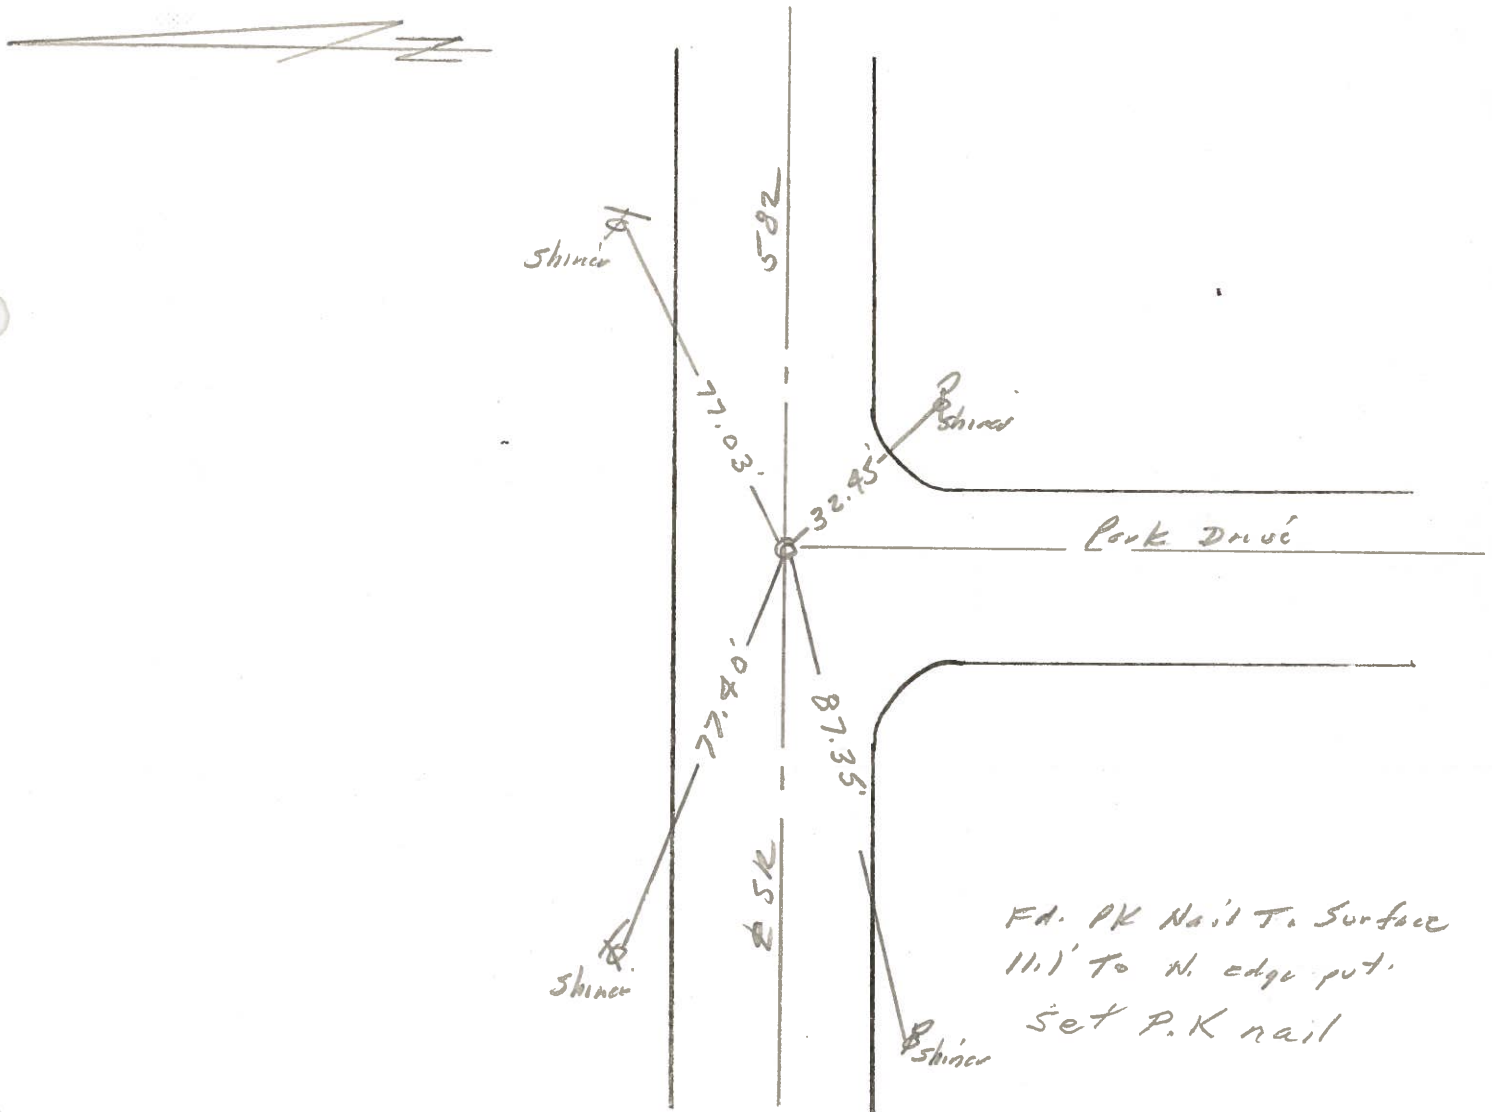

SHEET 20 OF

Date 12 July 83

Weather Warm


Temp. 91°

N

D. Curtis

D. Curtis

REF. No. 388

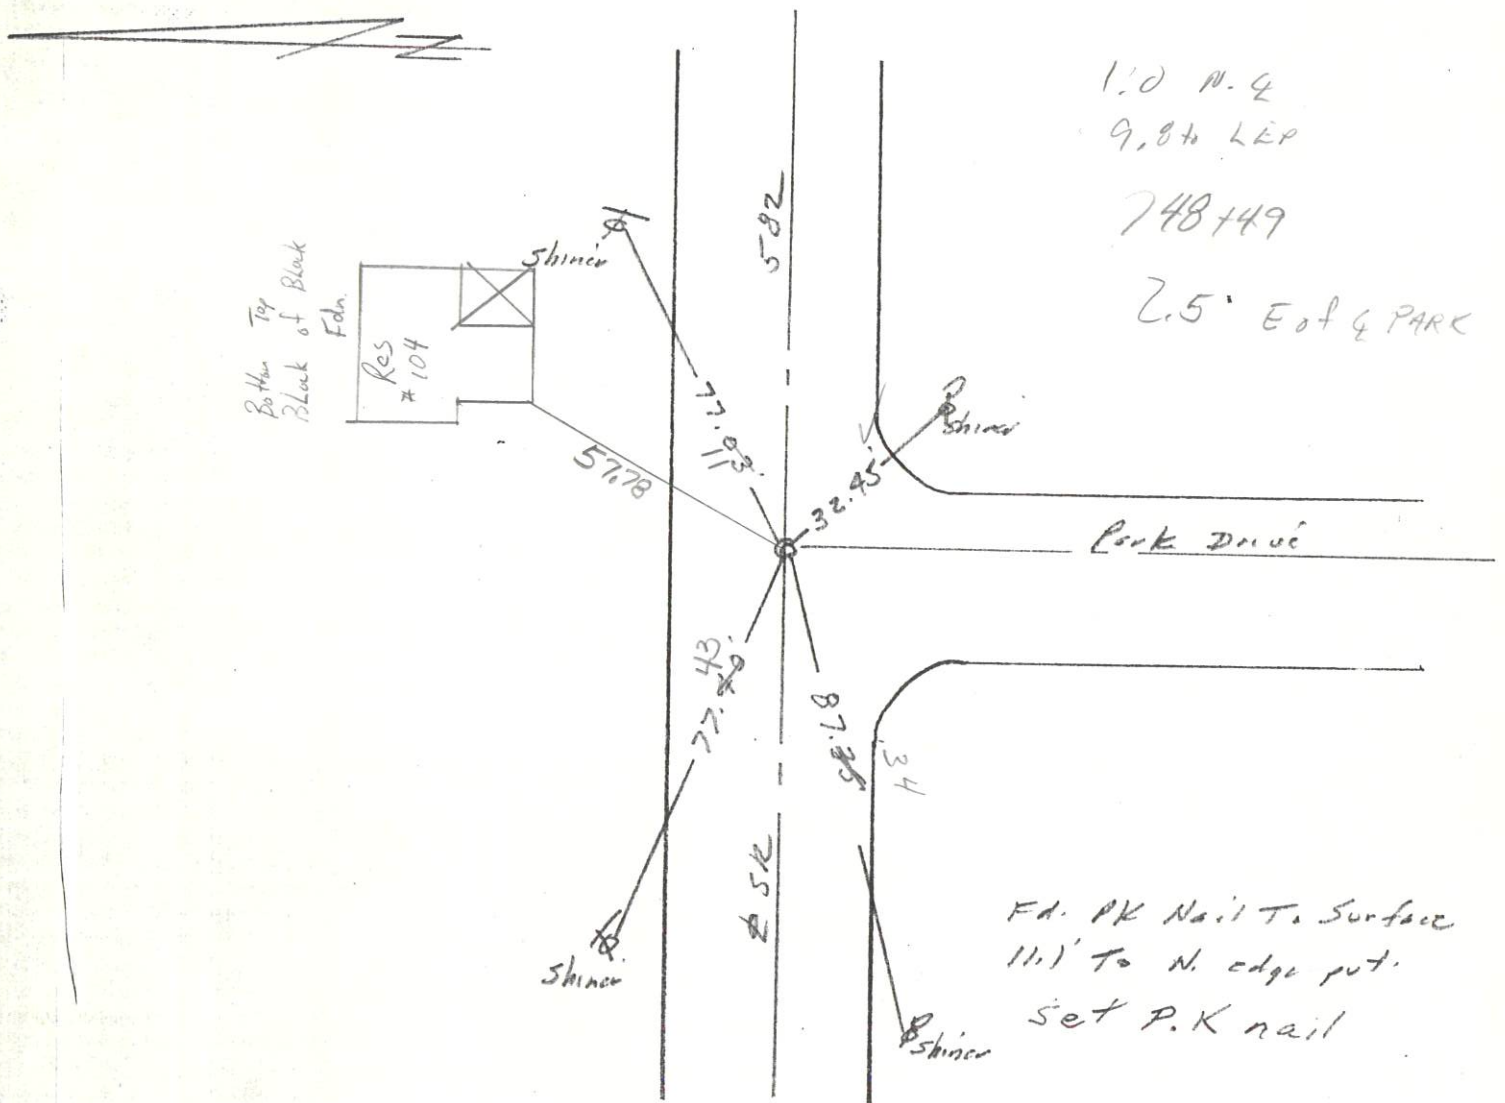

PERSONNEL	TITLE	PERSONNEL	TITLE	COUNTY	DATE
Morrison				Wood	April 11, 1968
Bowers				S. R. #382	WEATHER Clear
Holcombe				SEC. Lucky	TEMP +50°

DESCRIPTION Ties to Control Points. JOB NO. _____

