

O.D.O.T. DISTRICT 2 SURVEY OFFICE

PERSONNEL

NOTES _____
H.C. _____
R.C. _____

REFERENCE NO. 38 C

DATE 4-27-10
WEATHER SUNNY
TEMP. 40°

SHEET 4 OF 29

ROUTE SR 582
COUNTY WOOD
TOWNSHIP TROY
SECTION 28
T 6 N R 12 E

TYPE MONUMENT _____ PK _____



ON SURFACE - ~~BELOW~~ _____ On Surface _____

LEFT - CL PAV'T - ~~RIGHT~~ _____ 1.1'

9.5' TO LT. EDGE PAVEMENT

S.L.M. 752+50

GRID: NORTHING: 651459.844 EASTING: 1697644.001

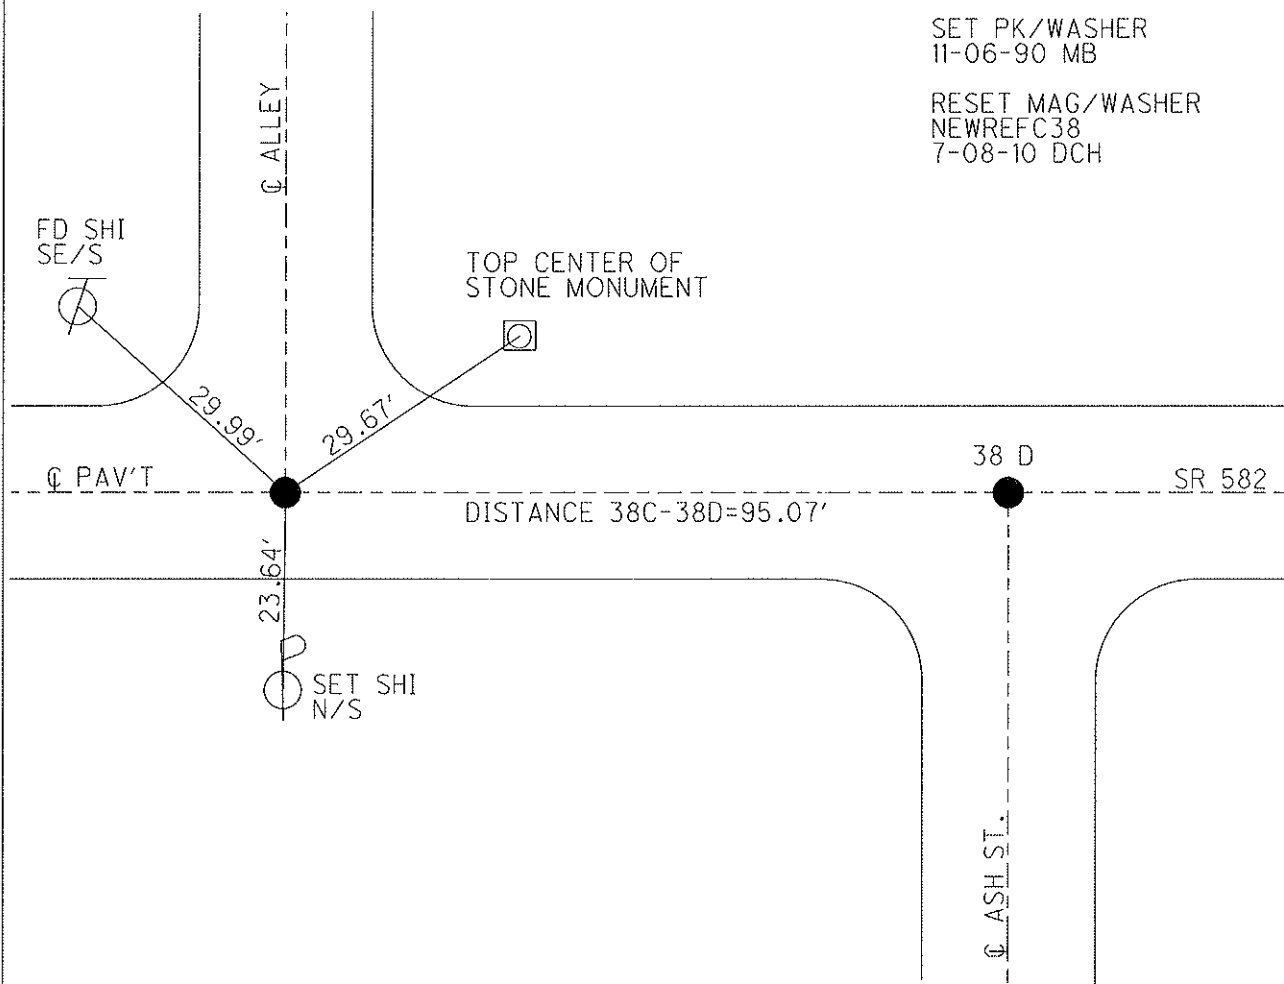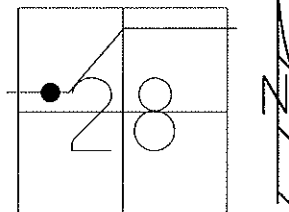

SET PK/WASHER
11-06-90 MB

RESET MAG/WASHER
NEWREFC38
7-08-10 DCH

O.D.O.T. DISTRICT 2 SURVEY OFFICE

PERSONNEL

REFERENCE NO. 38C-38P SHEET OF

NOTES LOEHRKE

H.C. Hoffman

R.C. Steinhauser

DATE 7-13-90

WEATHER CLOUDY - WINDY

TEMP. +105

ROUTE S.R. 582

COUNTY WOOD

TOWNSHIP TR04

SECTION 28

T. 6 N. R. 12 E.


TYPE MONUMENT PK & PK

ON SURFACE - BELOW Yes


LEFT - PAV'T. - RIGHT L.I.

9.5 TO Lt EDGE PAVEMENT

S.L.M. 752+50 & 753+45

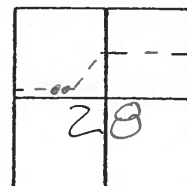

Set P.K. / Washer
11-6-90
MB

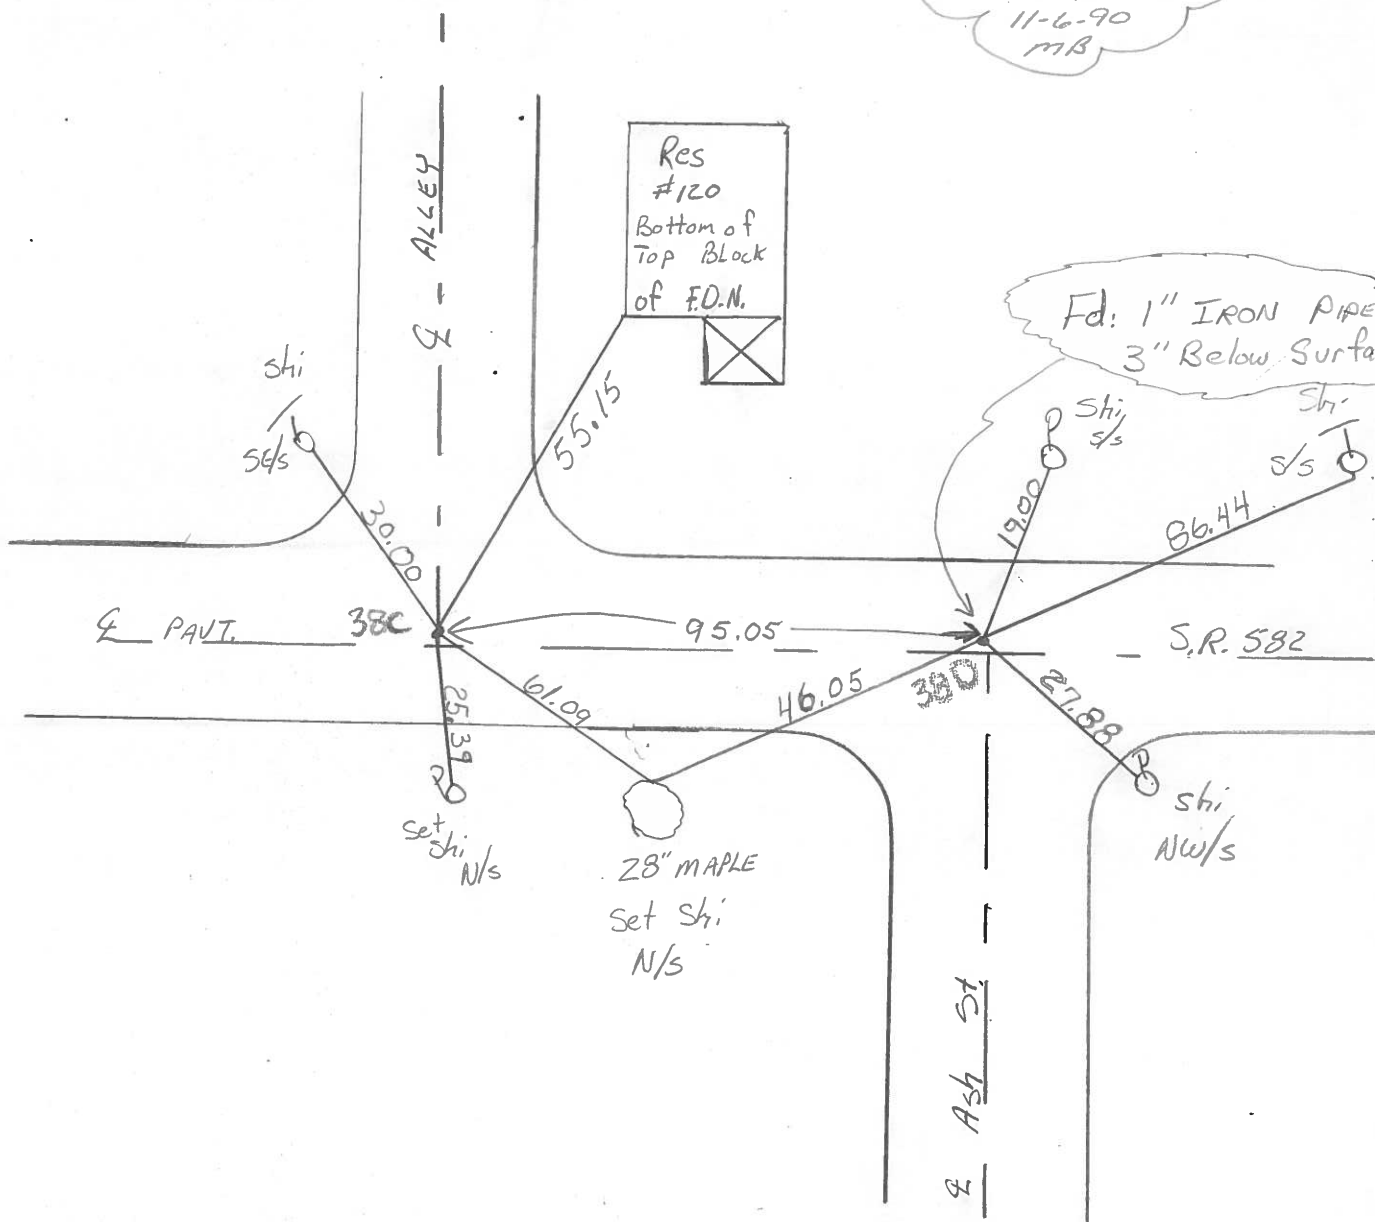

Q.D.O.T. DISTRICT 2 SURVEY OFFICE

SHEET 21 OF

County Wood S.R. 582

Township Troy

Section 28

T N, R E

Personnel J. Stone

P. Neuser


R. Michalak

D. Curtis

Date 12 July 83

Weather Warm

Temp. 90°

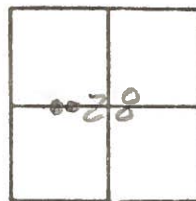

SLM STA.

REF. NO. 38C & 38D

#38D

Fd. 1" I. pin

10.9' to N. edge put.

SLM Sta. 753+38

Set P.K. nail

Shiner

86.47'

Shiner

19.00'

27.88'

Shiner

Ash St.

45.99'

95.02' S.R. 582

Shiner

24" Tree

Shiner 18" Tree

40.68'

61.04'

25.39'

Shiner

No Name St.

30.00'

Shiner

#38C

Fd. 1/2" I. pin

11.7' to S. edge put.

SLM Sta. 752+43

Set P.K. nail

SHEET 21 OF

Date 12 July 83

Weather Warm

Temp. _____ 90°

N

P. Neuser

R. Michalak

De Cuatris

SLM STM

REF. NO. 38C & 38D

38 D

3" Deep

Ed. J. "Trim"

10.9' to N₁ edge pvt.

SLM sta. 753438

Set PK. na, /

 $753 + 45$

1.0 west

P. B. N.

9.1 to $\angle EP$

#120

Bottom
Top Block

FD:

55.15
Spoken 18"

~~Spencer 18" Tree~~

No Name St.

70.15



✓

5h10

10

 $752 + 50$

1.1. N. 99

9.5 to 2EP

380

Fd $\frac{1}{2}$ " I. p. n.

11.7' to 5. edge part.

SLH Sta. 752+43

Set P.K, nail

PERSONNEL TITLE PERSONNEL TITLE

Morrison
Bowers.
Holcombe.

COUNTY Wood. DATE April 11, 1968

S. R. #582 WEATHER Clear.

SEC. Luckey TEMP. +50°

DESCRIPTION Ties to Control Points

JOB NO. _____

