

O.D.O.T. DISTRICT 2 SURVEY OFFICE

PERSONNEL

REFERENCE NO. 39 A

SHEET 7 OF 29

NOTES HOMAN

DATE 4-27-10

ROUTE SR 582

H.C. HOMAN

WEATHER SUNNY

COUNTY WOOD

R.C. ROUSOS

TEMP. 40°

TOWNSHIP TROY

SECTION 28

T 6 N R 12 E

TYPE MONUMENT P.K. NAIL


ON SURFACE - ~~BELOW~~ On Surface

~~LEFT~~ - C PAV'T - ~~RIGHT~~ ON

TO EDGE PAVEMENT

S.L.M. 758+05.62


GRID: NORTHING: 651756.179 EASTING: 1698175.129

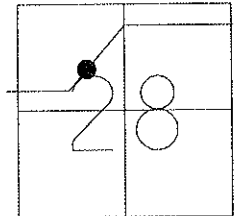

SET PK/WASHER
11-06-90 MB

RESET MAG/WASHER
NEWREFA39
7-08-10 DCH

DISTANCE BETWEEN
39A-39B= 27.62'

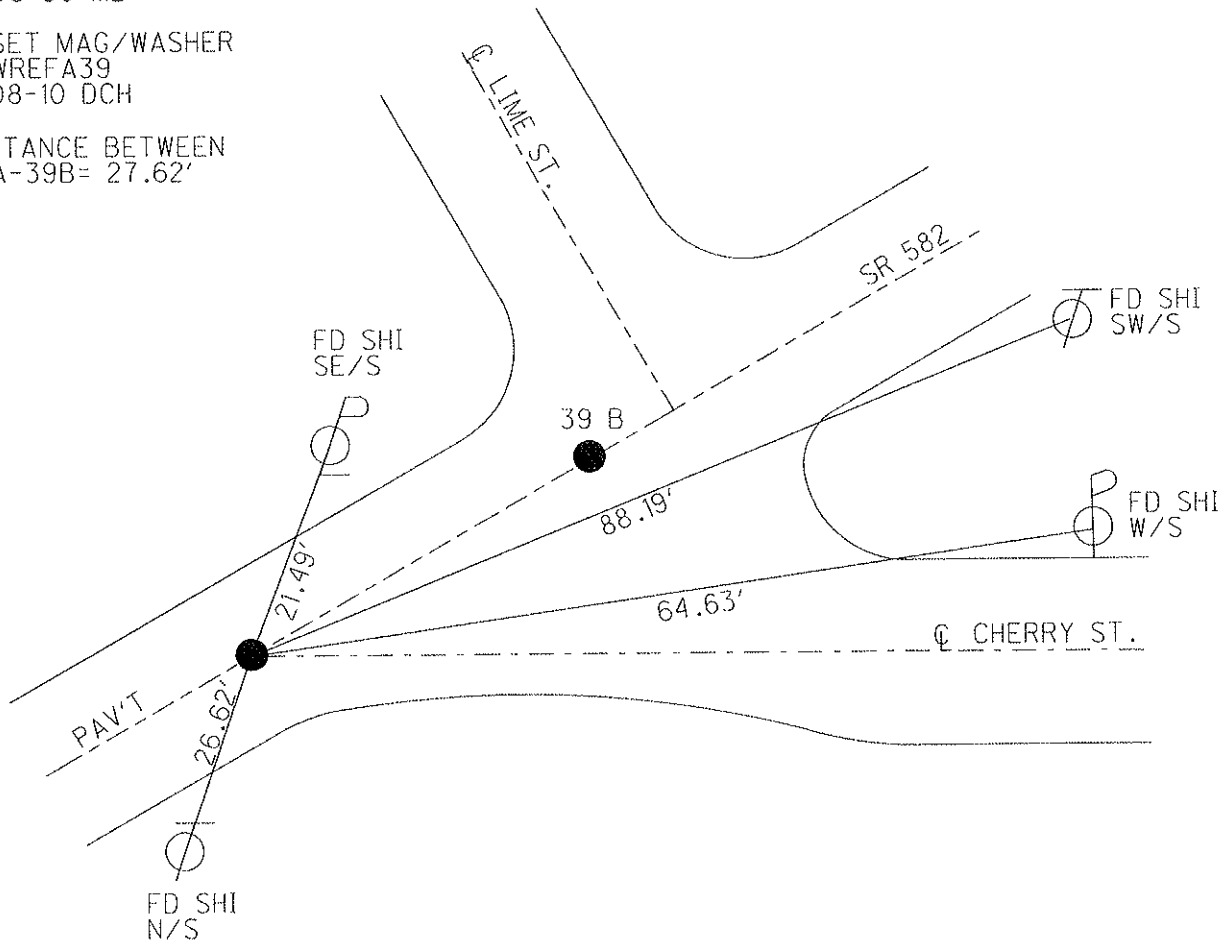

O.D.O.T. DISTRICT 2 SURVEY OFFICE

PERSONNEL

REFERENCE NO. 39A & 39B

SHEET _____ OF _____

NOTES LOHRKE

H.C. Hoffman

R.C. Steinhäuser

DATE 7-13-90

WEATHER CLOUDY-WINDY

TEMP. +6.8

ROUTE S.R. 582

COUNTY WOOD

TOWNSHIP TROY

SECTION 28

T 6 N R 12 E


TYPE MONUMENT P.K. Nails

ON SURFACE - BELOW YES

LEFT - CL PAV'T. - RIGHT YES


TO EDGE PAVEMENT

S.L.M. 758+98 759+26

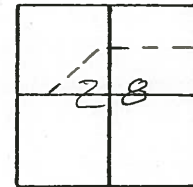

DISTANCE BETWEEN 27.60

Set P.K. / Washers
11-6-90
MB

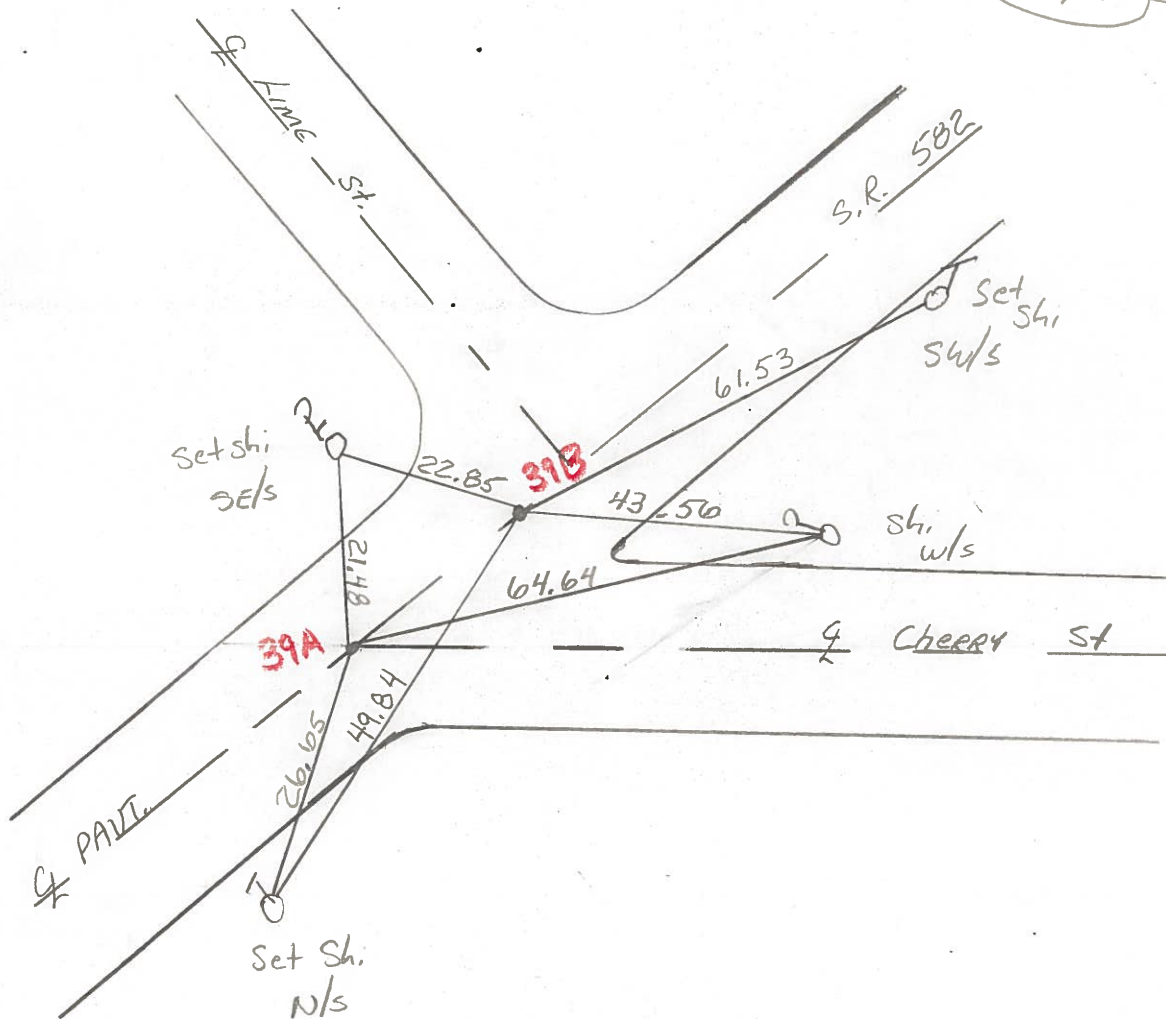

Q.D.O.T. DISTRICT 2 SURVEY OFFICE

SHEET 23 OF

County Wood S.R. 582

Township TROY

Section 28

T N, R E

Personnel J. Stone

P. Neuser


R. Michalak

D. Curtis

Date 12 July 83

Weather Warm

Temp. 90°

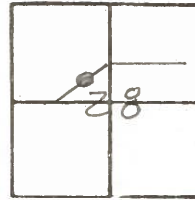

REF. No. 39A & 39B

#39B

Fd. 1" I. pin 3" deep
SLM Sta. 759 + 17

Set PK Nail


E Lime St.

#39A

Fd. 1" I. pin 3" deep
to W. edge put.

SLM Sta. 758 + 89


Set PK nail

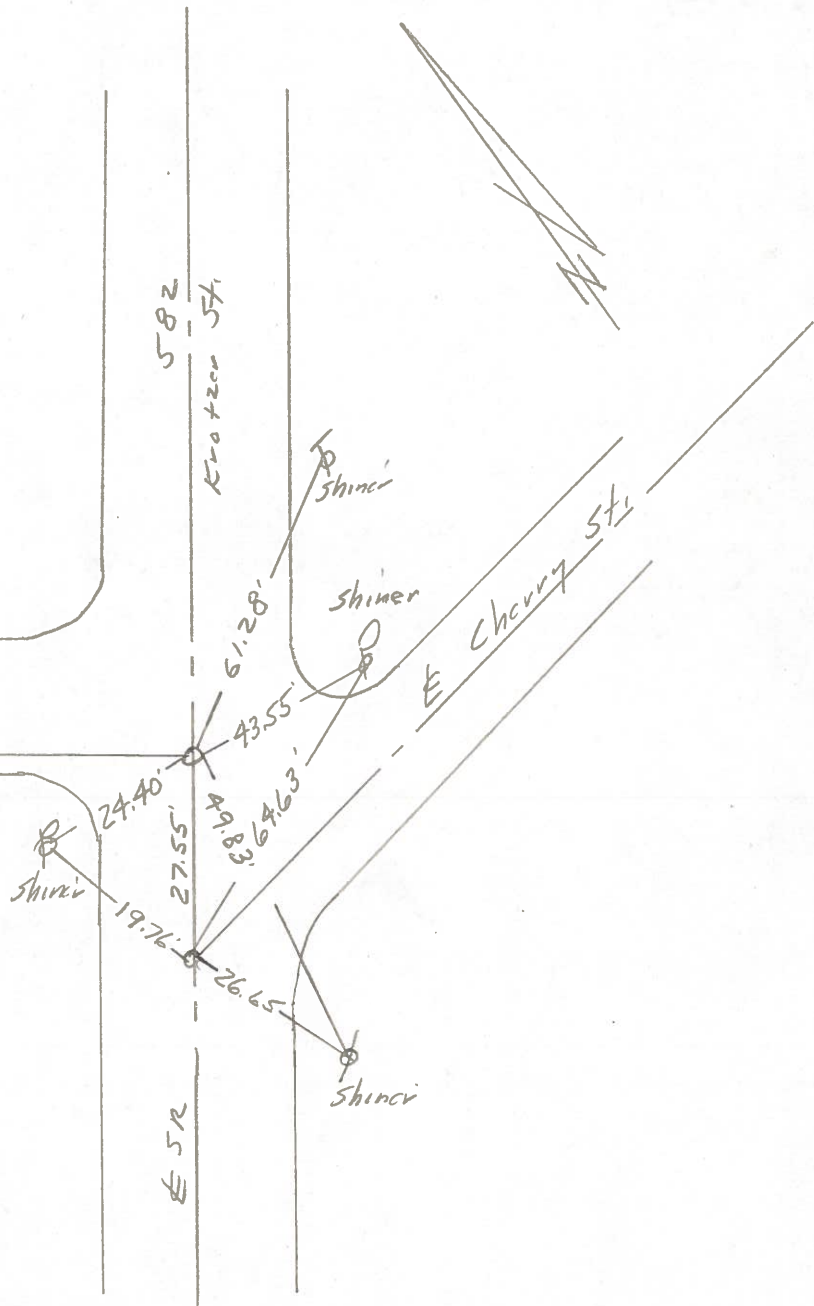

SHEET 23 OF

D. Curtis'

Temp. 90°

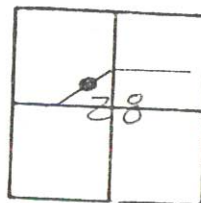

27.60 Between

REF. NO. 39A & 39B

39 B

Fd. 1" I. pin 3" deep
SLM Sta. 759 + 17

Set PK Na, 1

~~Lime~~ Sp.

#39A

Fd. 1" I. pin 3" deep
to W. edge put.
SLN Sta. 758 + 89

Set PK nail

758+98
759+26

Both
OW & 582
9.4W & Lime
ON & Cherry

PERSONNEL _____ TITLE _____ PERSONNEL _____ TITLE _____

COUNTY Wood

DATE April, 11, 1968

S. R. # 582

WEATHER Clear

SEC. Luckey

TEMP. +55°

DESCRIPTION Ties to Control Points.

JOB NO. _____

LEFT

CENTER LINE

RIGHT

