

O.D.O.T. DISTRICT 2 SURVEY OFFICE

PERSONNEL

REFERENCE NO. 40 A

SHEET 11 OF 29

NOTES HOMAN

DATE 4-27-10

ROUTE SR 582

H.C. HOMAN

WEATHER SUNNY

COUNTY WOOD

R.C. ROUSOS

TEMP. 40°

TOWNSHIP TROY

SECTION 28

T 6 N R 12 E

TYPE MONUMENT 1" IRON PIN


~~ON SURFACE~~ - BELOW 5"

~~LEFT - C PAV'T~~ - RIGHT 11.5'

1.2' TO RT EDGE PAVEMENT


S.L.M. 770+98 (PT. IS SOUTH OF S.E.P.)

GRID: NORTHING: 6652453.808 EASTING: 1699104.548

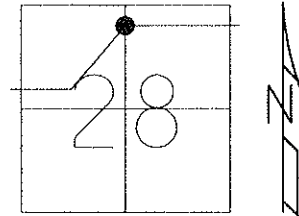

DID NOT COVER
11-06-90 MB

DID NOT COVER
7-08-10 DCH

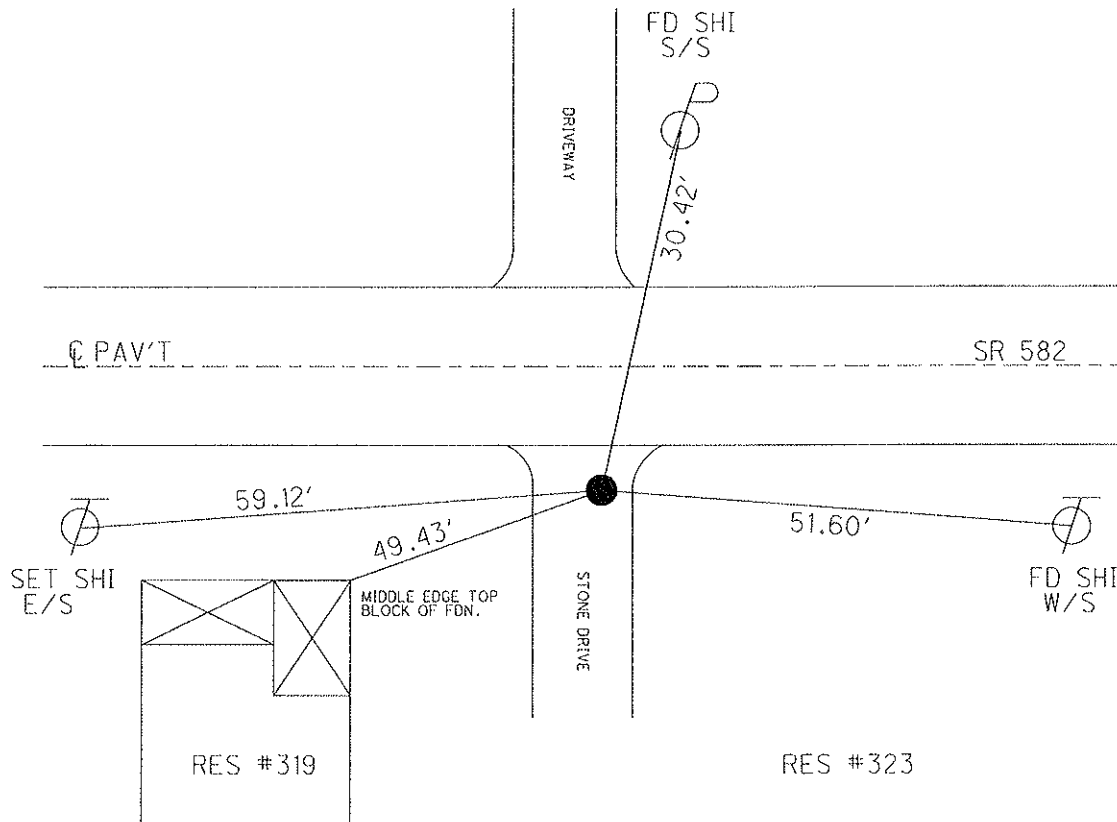

O.D.O.T. DISTRICT 2 SURVEY OFFICE

PERSONNEL

REFERENCE NO. 40-A

SHEET OF

NOTES LOEHRKE

H.C. Hoffman

R.C. BARNHISEL

DATE 7-23-90

WEATHER pt Cloudy

TEMP. +75

ROUTE S.R. 582

COUNTY WOOD

TOWNSHIP TROY

SECTION 28

T6 N R 12 E


TYPE MONUMENT 1" IRON ROD

~~ON SURFACE~~ - BELOW 5" Below


~~LEFT~~ - & PAV'T. - RIGHT 11.5


1.2 TO R+ EDGE PAVEMENT pt. 15 south of S.E.P.

S.L.M. 770 +98

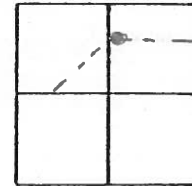


Did NOT COVER
11-6-90
MB

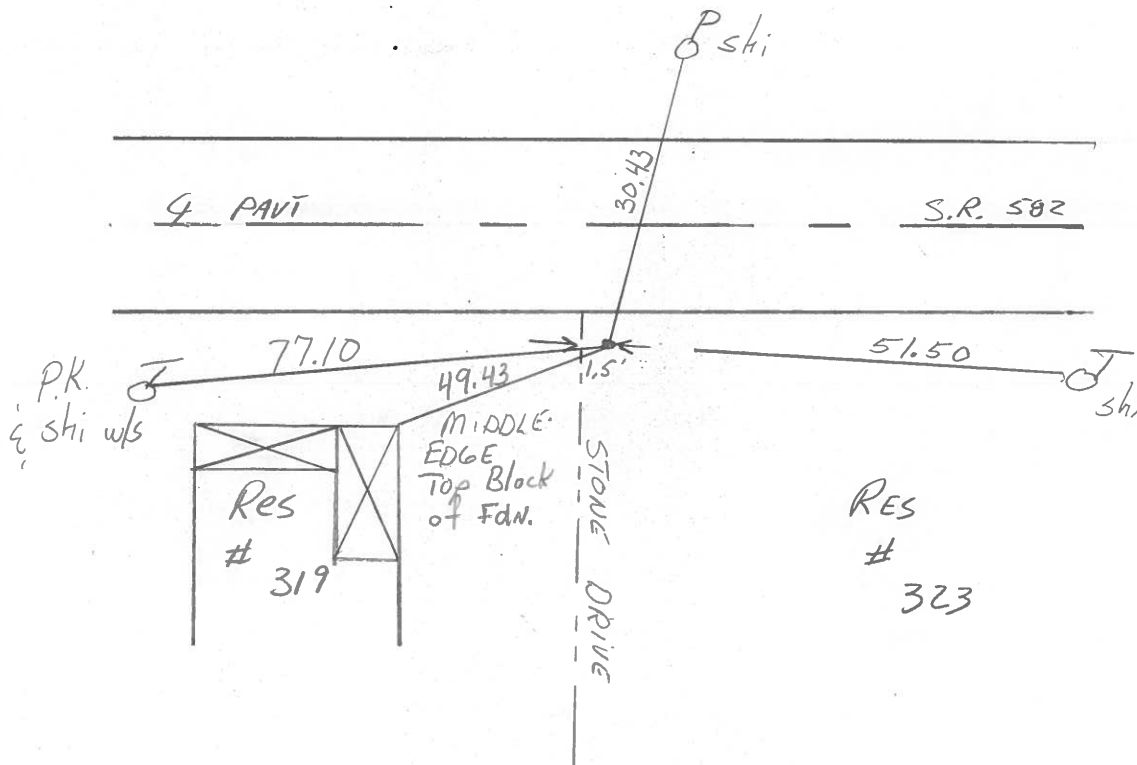

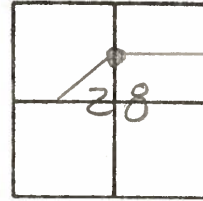County Wood S.R. 582Township TroySection 28T N, R EPersonnel J. StoneP. NeusserR. MichalakD. CurtisDate 13 July 83Weather WarmTemp. 86°

SLM STA. 770+91

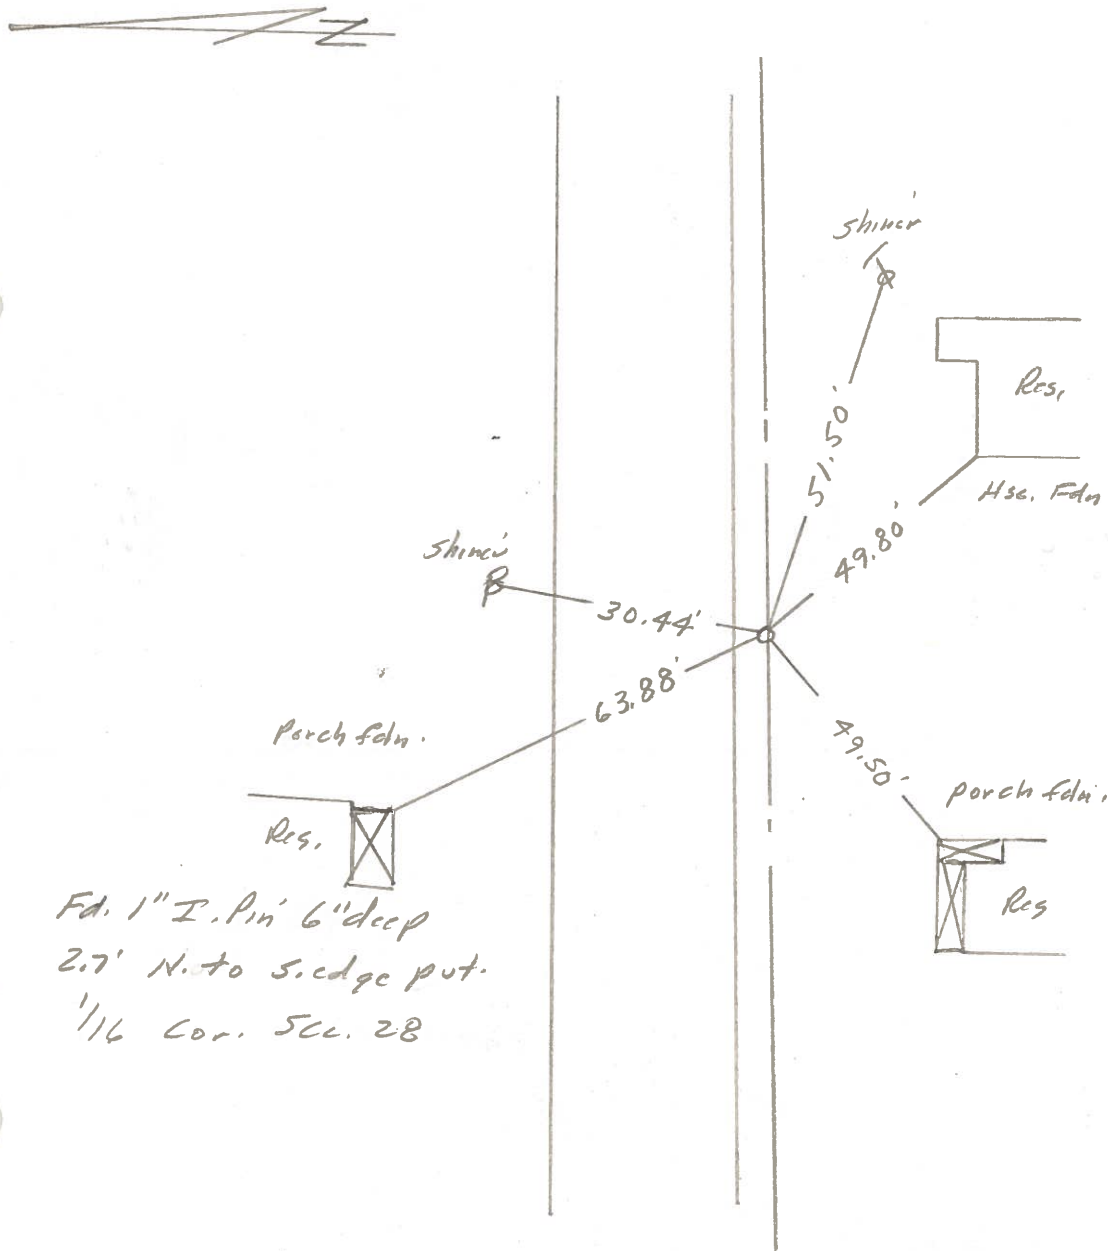REF NO. 40 A

Q.D.O.T. DISTRICT 2 SURVEY OFFICE

SHEET 26 OF

County Wood S.R. 582

Township Troy

Section 28

T.N., R.E.

Personnel J. Stone

P. Neuser


R. Michalak

D. Curtis

Date 13 July 83

Weather Warm

Temp. 86°

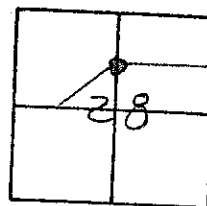

SLM STA. 770+91

REF NO. 70 A

