

O.D.O.T. DISTRICT 2 SURVEY OFFICE

PERSONNEL

REFERENCE NO. 40 D

SHEET 14 OF 29

NOTES HOMAN

DATE 4-27-10

ROUTE SR 582

H.C. HOMAN

WEATHER SUNNY

COUNTY WOOD

R.C. ROUSOS

TEMP. 40°

TOWNSHIP TROY

SECTION 28

T 6 N R 12 E

TYPE MONUMENT Shank


ON SURFACE - ~~BELOW~~ On Surface

~~LEFT - C PAV'T~~ - RIGHT 6.5'

16.0' TO LT EDGE PAVEMENT

S.L.M. 779+06.46, ON C PAV'T AT RUCH ST.

GRID: NORTHING: 652449.102 EASTING: 1700003.863

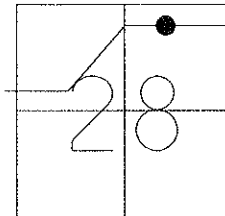

SET PK/WASHER
11-06-90 MB

RESET MAG/WASHER
NEWREFD40 7-08-10 DCH

FD SHI
SE/S

89.95'

C PAV'T

53.01'

FD SHI
SW/S

SR 582

SET SHI
NE/S

23.65'

27.65'

FD. N/SHI
ON C PAV'T

RUCH ST

O.D.O.T. DISTRICT 2 SURVEY OFFICE

PERSONNEL

REFERENCE NO. 40 D

SHEET OF

NOTES LOEHRKE

H.C. HOFFMAN

R.C. BAENHISEL

DATE 7-23-90

WEATHER cloudy

TEMP. +75°

ROUTE S.R. 582

COUNTY WOOD

TOWNSHIP TROY

SECTION 28

T 6 N R 12 E


TYPE MONUMENT P.K. NAIL

ON SURFACE - BELOW YES


~~LEFT~~ - & PAV'T. - RIGHT 6.5


16.0 TO Lt EDGE PAVEMENT ON & PAVT Ruch st.

S.L.M. 779 + 98

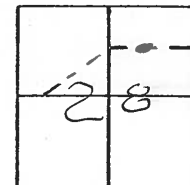


Set P.K. / Washer
11-6-90
MB

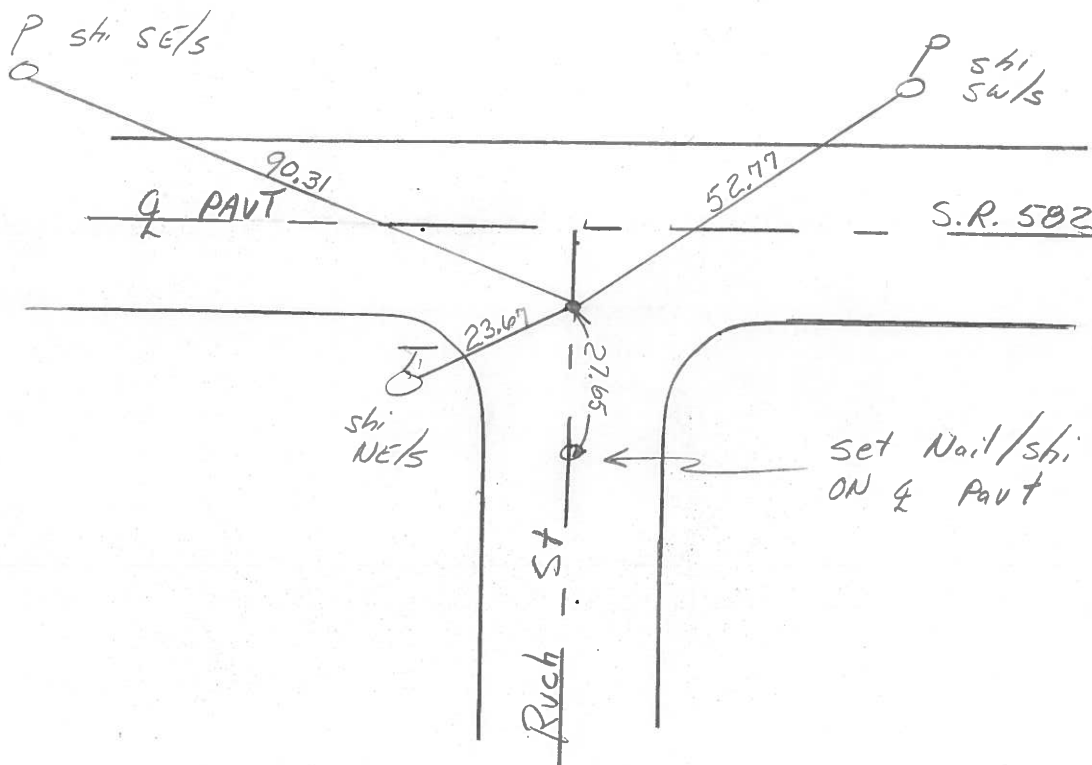

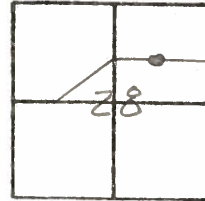County Wood S.R. 582Township TroySection 28T N, R EPersonnel L. StoneP. NeuserR. MichalekD. CurtisDate 13 July 83Weather WarmTemp. 88°

SLM Sta. 779+92

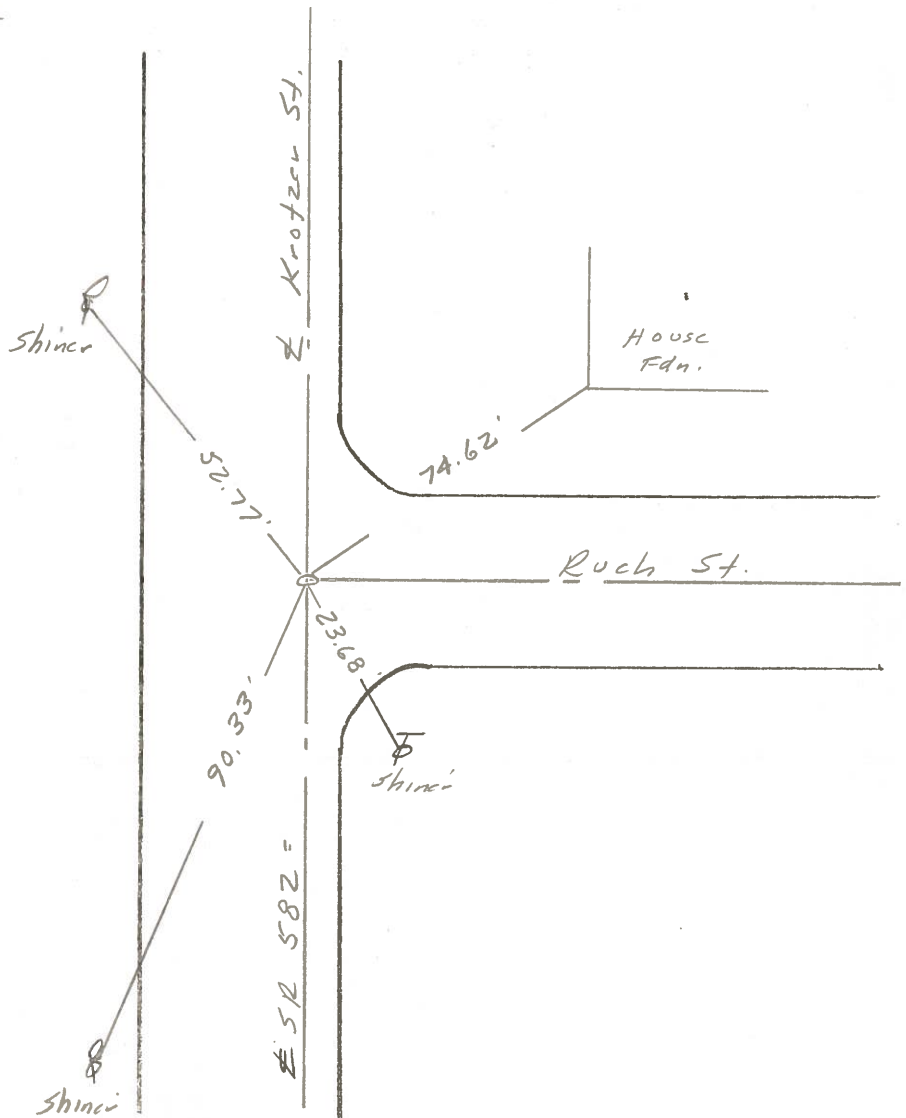REF. NO. 40DFd. 1" I. P. in 3" drop
16.7' to N. edge put.

set PK nail

Q.D.O.T. DISTRICT 2 SURVEY OFFICE

SHEET 28 OF

County Wood S.R. 582

Township Troy

Section 28


T.N, R.E

Personnel L. Stone
P. Neuser
R. Michalek
D. Curtis

Date 13 July 83


Weather Warm

Temp. 88°

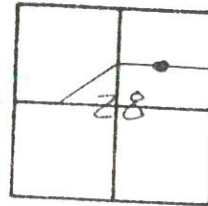

SLM Sta. 779+92

REF. NO. 40 D

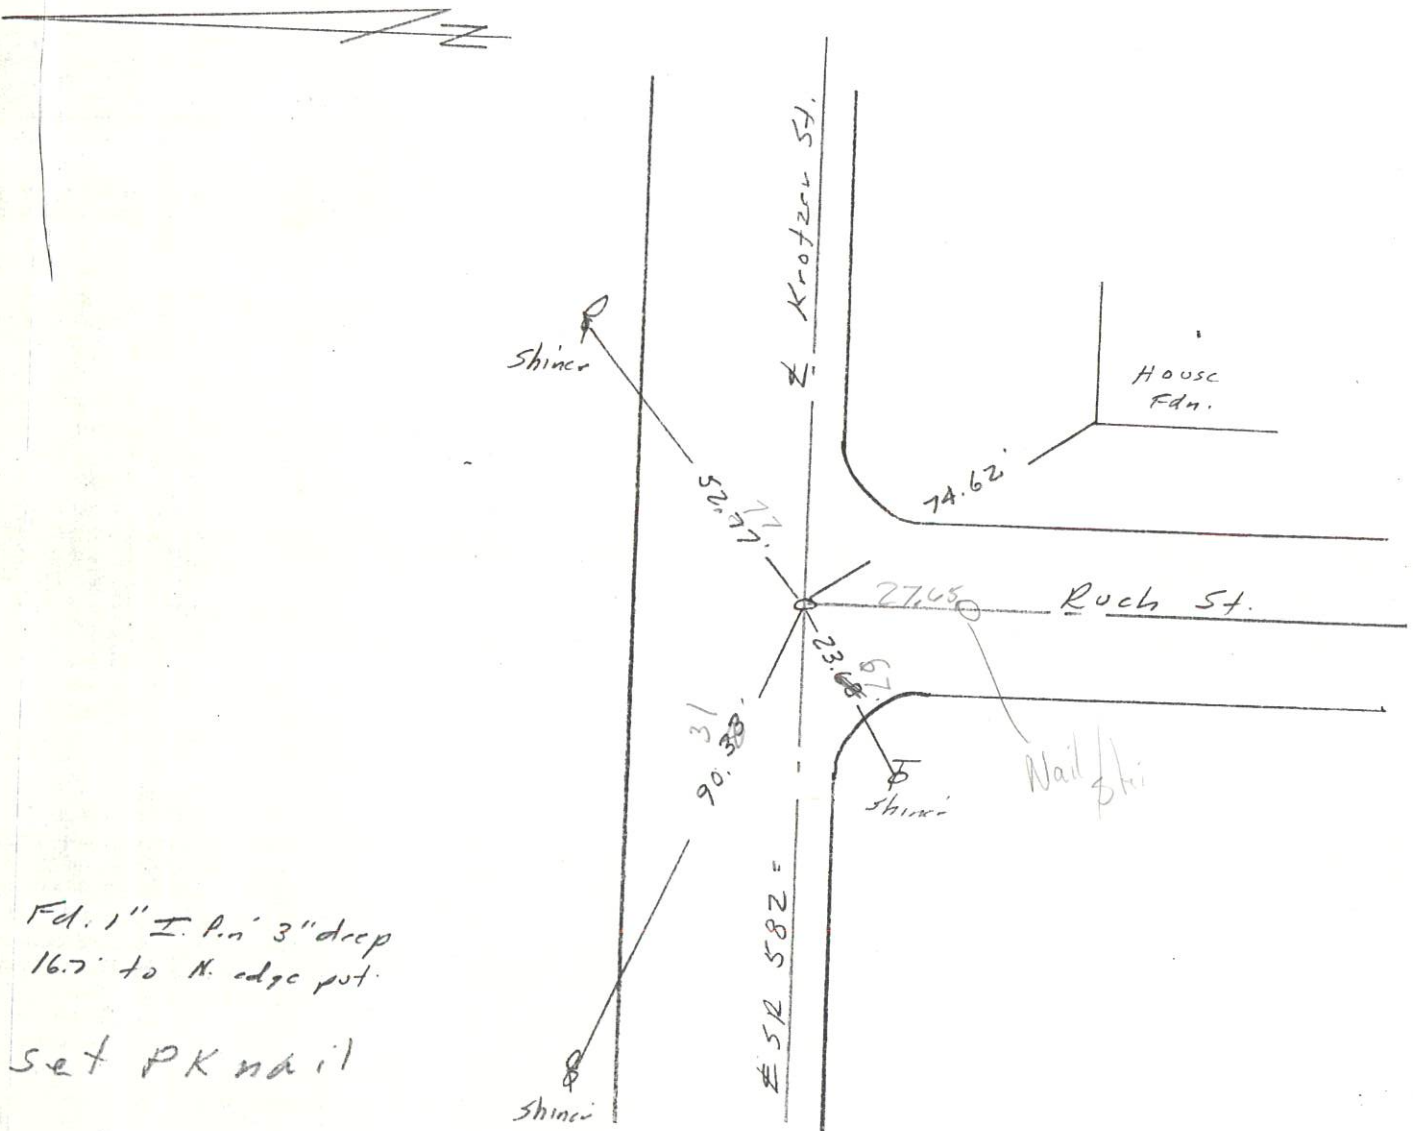

PERSONNEL

TITLE

PERSONNEL

TITLE

COUNTY WoodDATE April, 12, 1968MorrisonBowersHelcombeKernS. R. # 582WEATHER ClearSEC. LuckyTEMP. +60°DESCRIPTION Ties to Control Points.

JOB NO. _____

LEFT

CENTER LINE

RIGHT

