

O.D.O.T. DISTRICT 2 SURVEY OFFICE

PERSONNEL

REFERENCE NO. 40 E

SHEET 15 OF 29

NOTES HOMAN

DATE 4-27-10

ROUTE SR 582

H.C. HOMAN

WEATHER SUNNY

COUNTY WOOD

R.C. ROUSOS

TEMP. 40°

TOWNSHIP TROY

SECTION 28

T 6 N R 12 E

TYPE MONUMENT 3/4" IRON ROD


ON SURFACE - ~~BELOW~~ On Surface

~~LEFT - C PAV'T~~ - RIGHT 6.2'

15.7' TO LT. EDGE PAVEMENT


S.L.M. 781+75.85, 1.0' E. C SCHOOL ST.

GRID: NORTHING: 652447.172 EASTING: 1700273.357

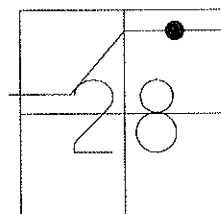

SET PK/WASHER
11-06-90 MB

RESET MAG/WASHER
NEWREFE40 7-08-10 DCH

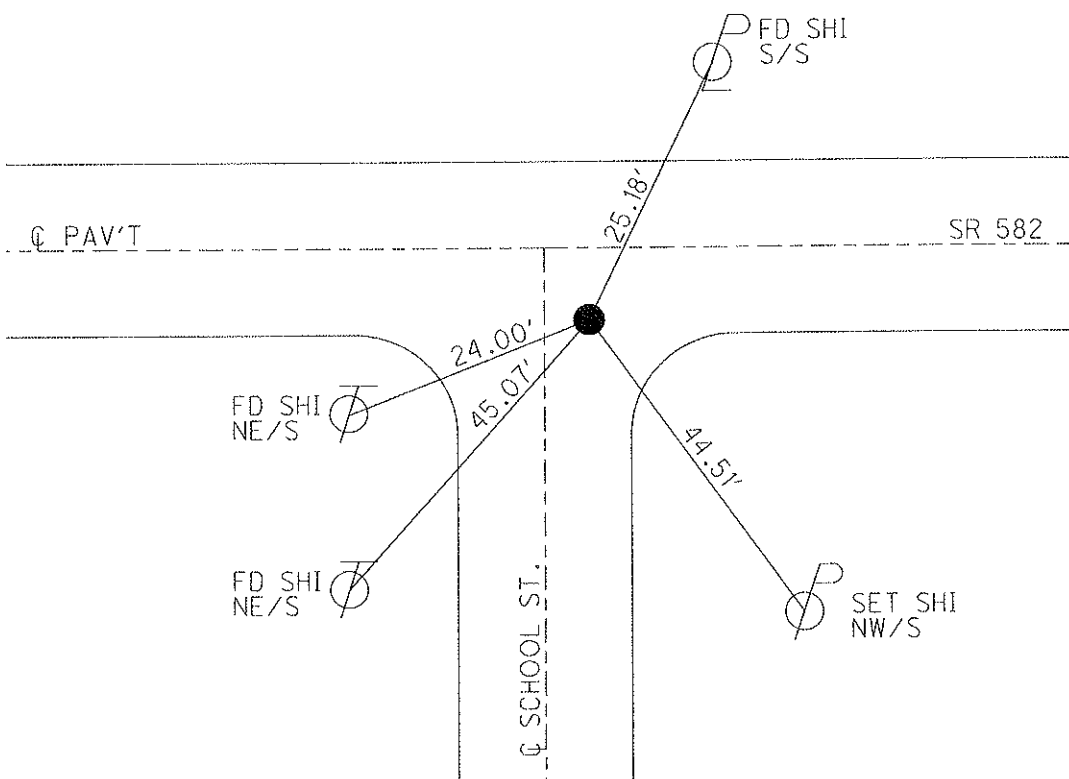

O.D.O.T. DISTRICT 2 SURVEY OFFICE

PERSONNEL

REFERENCE NO. 40 E

SHEET OF

NOTES LOEHRKE

H.C. HORIMAN

R.C. BARNHISEL

DATE 7-23-90

WEATHER Cloudy

TEMP. +78

ROUTE SR 582

COUNTY WOOD

TOWNSHIP TROY

SECTION 28

T. 6 N. R. 12 E


TYPE MONUMENT 3/4" IRON ROD

ON SURFACE - BELOW 1 INCH


~~LEFT - & PAV'T. - RIGHT~~ 6.2

15.7 TO Lt EDGE PAVEMENT 1.0' E & School St.

S.L.M. 782 + 67

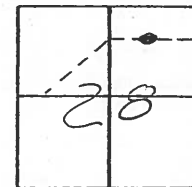

Set P.K. / Washer
11-6-90
mB

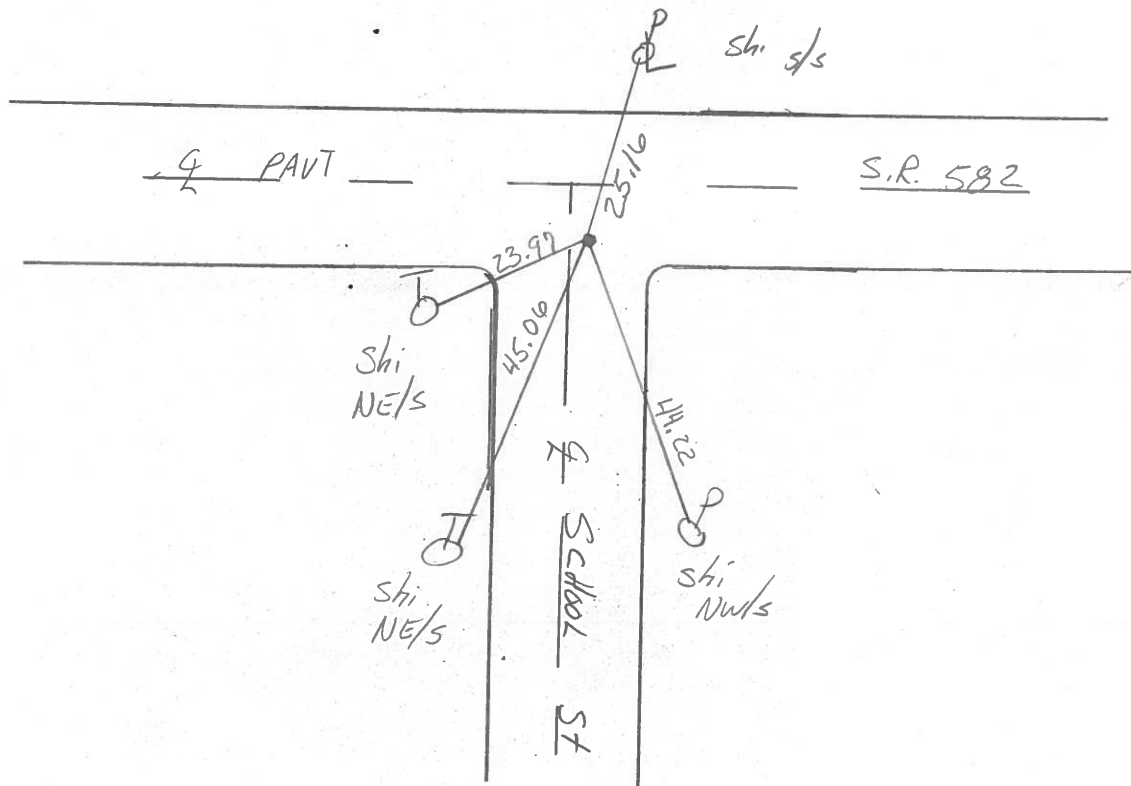

SHEET 29 OF

Date 13 July 83

Weather Warm


Temp. 87°

2

R. Michalek

D. Curtis

REF. NO. 40E

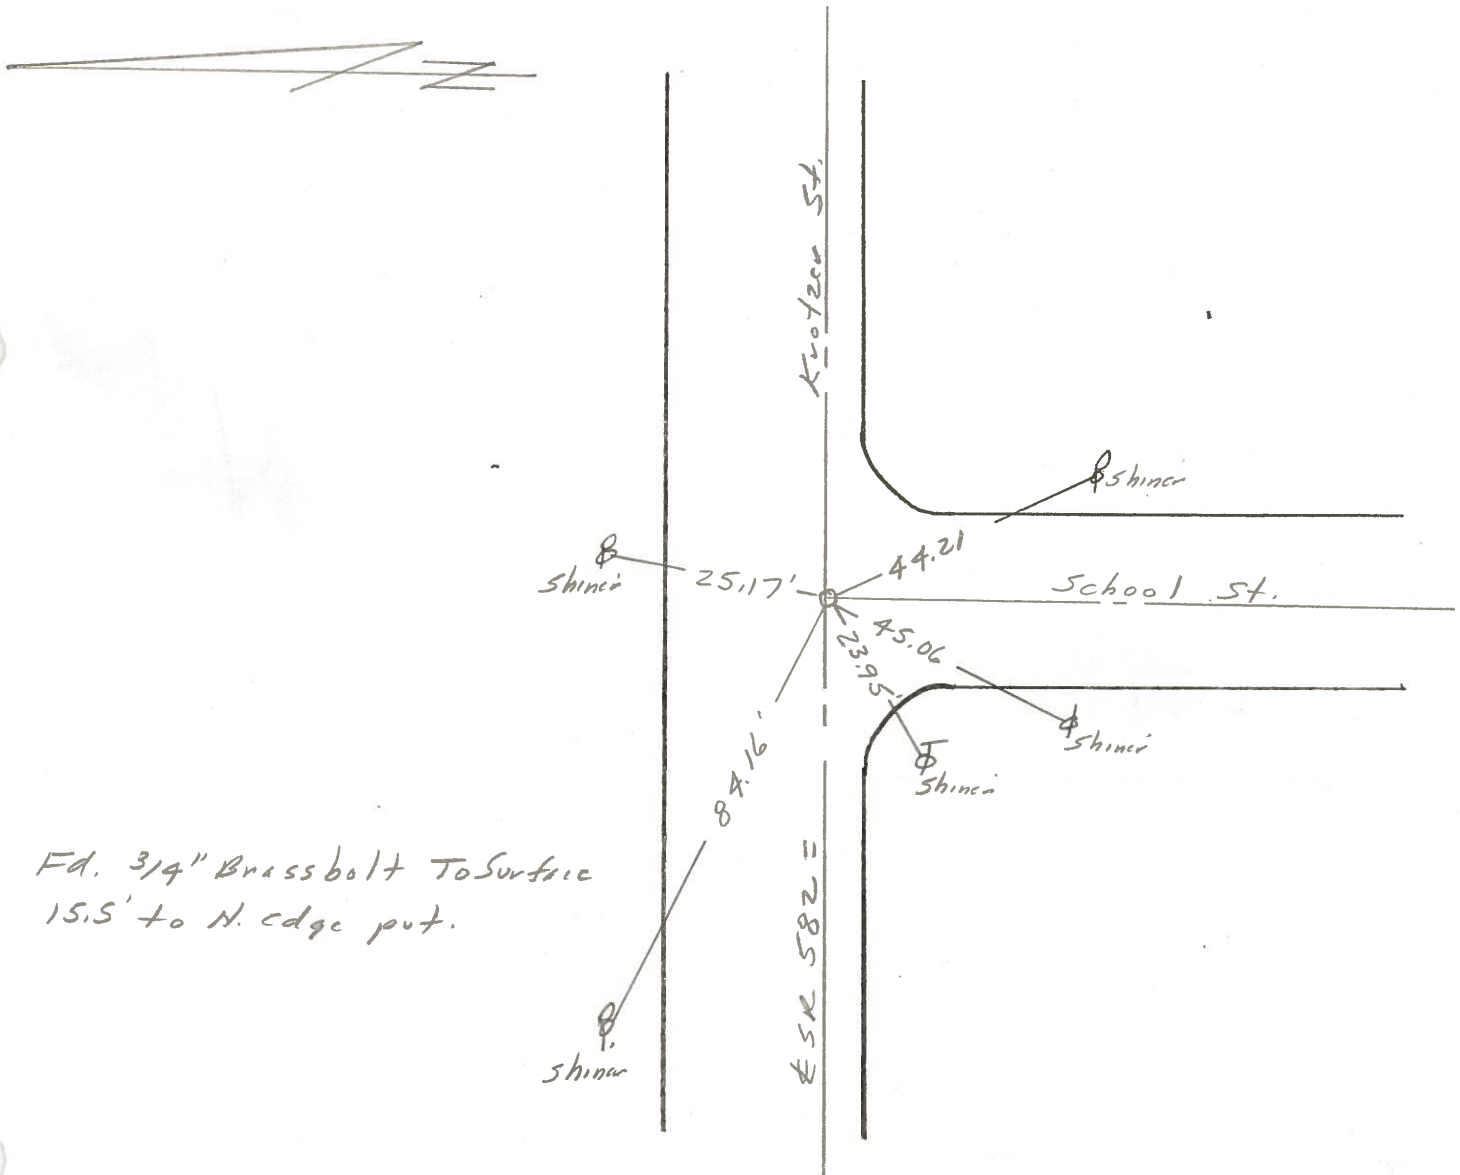

Q.D.O.T. DISTRICT 2 SURVEY OFFICE

SHEET 29 OF

County Wood S.R. 582

Township Troy

Section 28


T_N, R_E

Personnel L. Slone
P. Newson
R. Michalek
D. Curtis

Date 13 July 83


Weather Windy

Temp. 87°

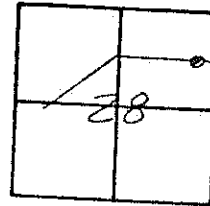

SLM STA. 782+61

REF. NO. 40E

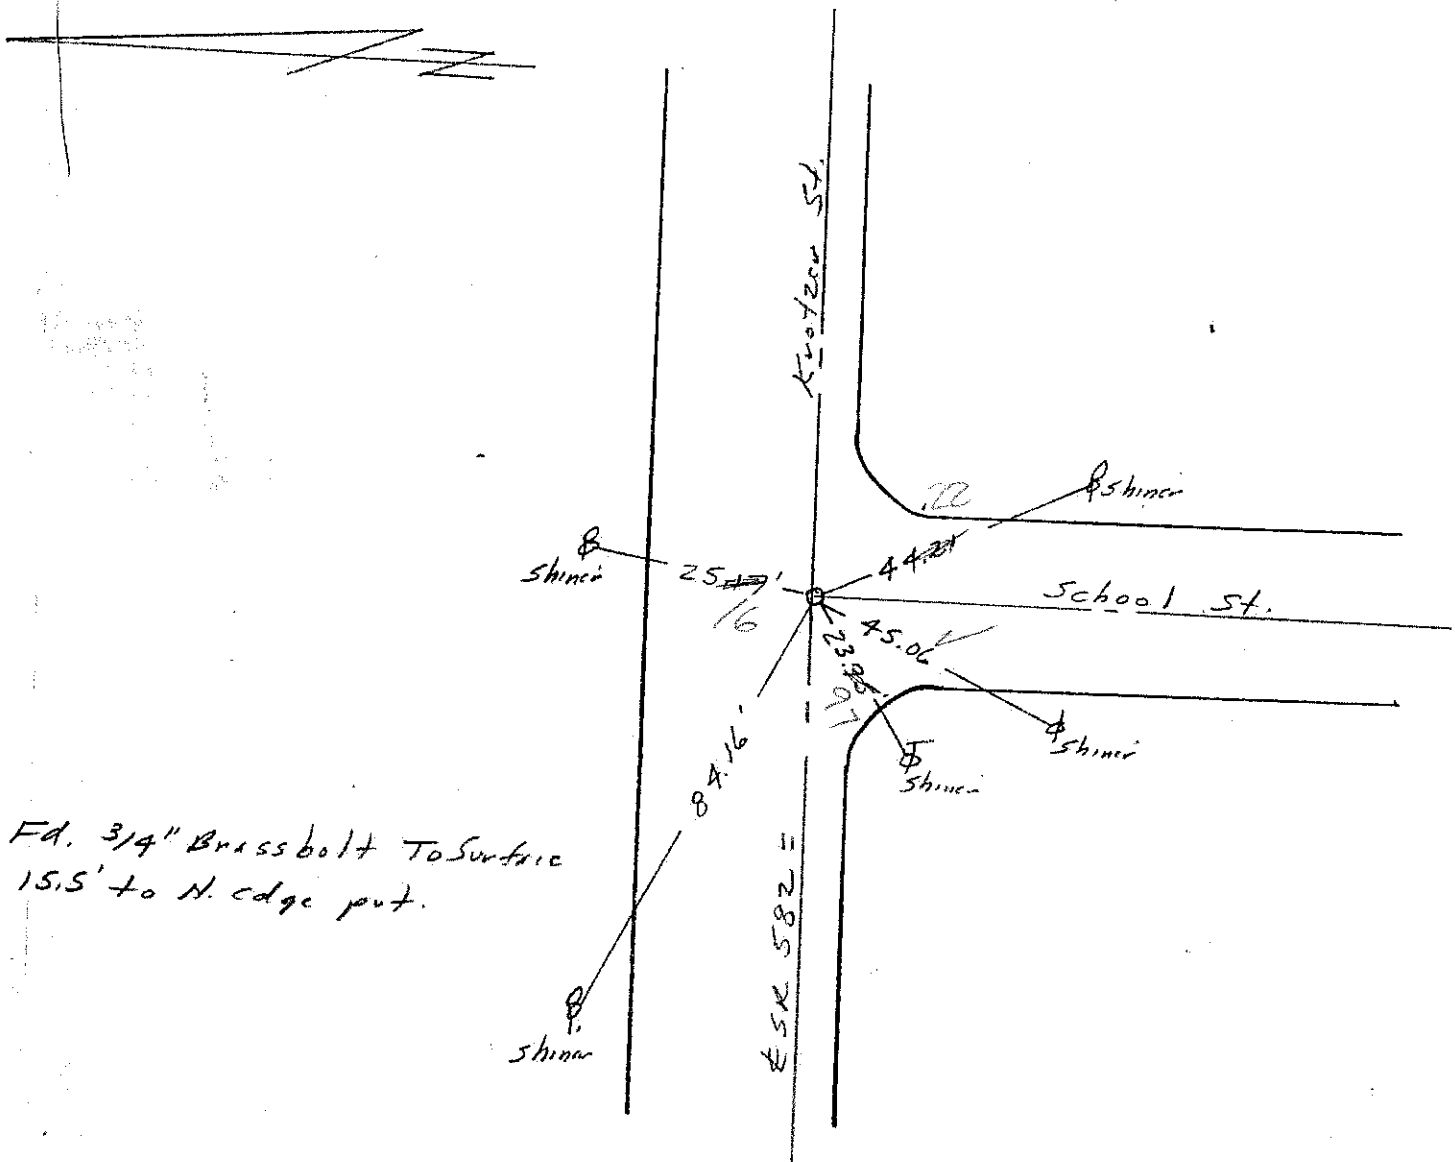

PERSONNEL

TITLE

PERSONNEL

TITLE

COUNTY WoodDATE April, 12, 1968NorrisonBowersHolcombeKernS. R. # 582WEATHER ClearSEC. Lucky.TEMP. +60°

DESCRIPTION

Ties to Control Points.

JOB NO. _____

LEFT

CENTER LINE

RIGHT

