

O.D.O.T. DISTRICT 2 SURVEY OFFICE

PERSONNEL

NOTES HOMAN
H.C. HOMAN
R.C. ROUSOS

REFERENCE NO. 40 F

DATE 4-27-10
WEATHER SUNNY
TEMP. 45°

SHEET 16 OF 29

ROUTE SR 582
COUNTY WOOD
TOWNSHIP TROY
SECTION 28
T 6 N R 12 E

TYPE MONUMENT MAG/WASHER


ON SURFACE - ~~BELOW~~ On Surface

~~LEFT - C PAV'T~~ - RIGHT 5.8'

3.5' TO RT EDGE PAVEMENT


S.L.M. 784+22 REC

GRID: NORTHING: 652446.240 EASTING: 1700427.183

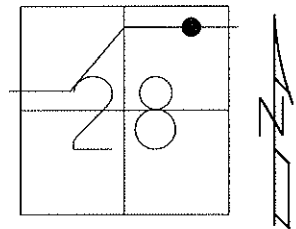

SET PK/WASHER
11-06-90 MB

RESET MAG/WASHER
NEWREFF40
7-08-10 DCH

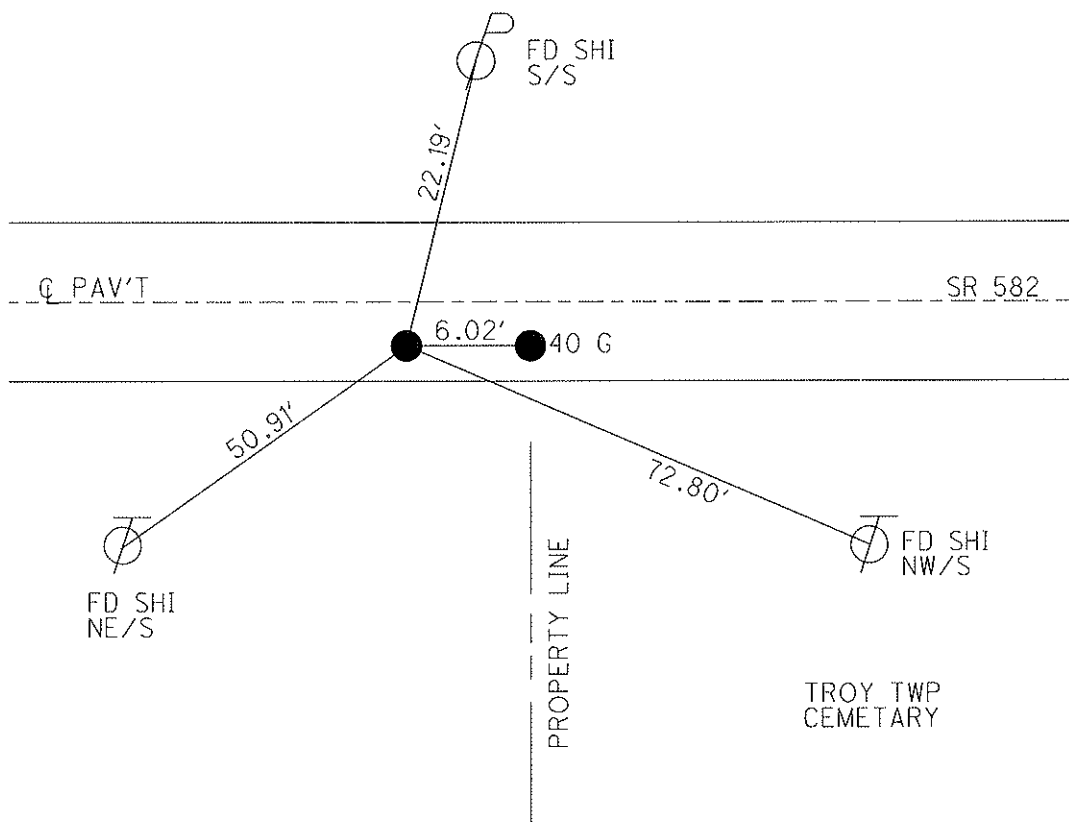

O.D.O.T. DISTRICT 2 SURVEY OFFICE

PERSONNEL

REFERENCE NO. 40 F

SHEET _____ OF _____

NOTES LOEHRKE

H.C. Hoffman

R.C. BARNHISEL

DATE 7-23-90

WEATHER Pt Cloudy

TEMP. +78

ROUTE 582

COUNTY WOOD

TOWNSHIP TROY

SECTION 28

T 6 N R 12 E

TYPE MONUMENT P.K. Nails

ON SURFACE - ~~BELOW~~ yes


LEFT - & PAW'T. - RIGHT 5.8


3.5 TO Rt EDGE PAVEMENT

S.L.M. 784+22 784+28




Set P.K. / Walshe
11-6-90
MB

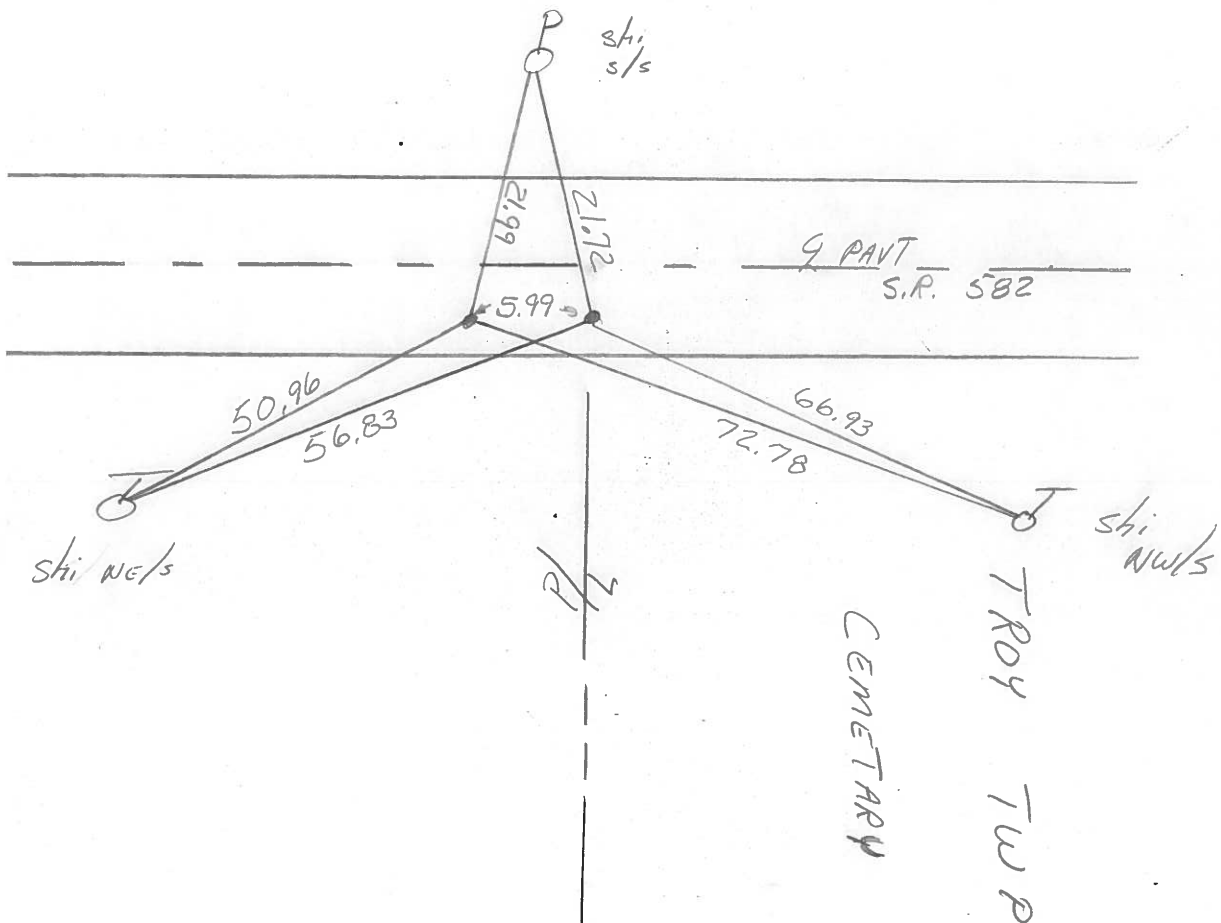

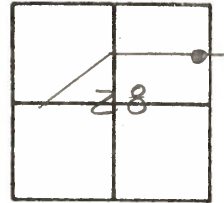County Wood S.R. 582Township TroySection 28T N, R EPersonnel L. StoneR. NeuserR. MichalakD. CurtisDate 13 July 83Weather W c mTemp. 88°

SLM STA. 784+14 & +20

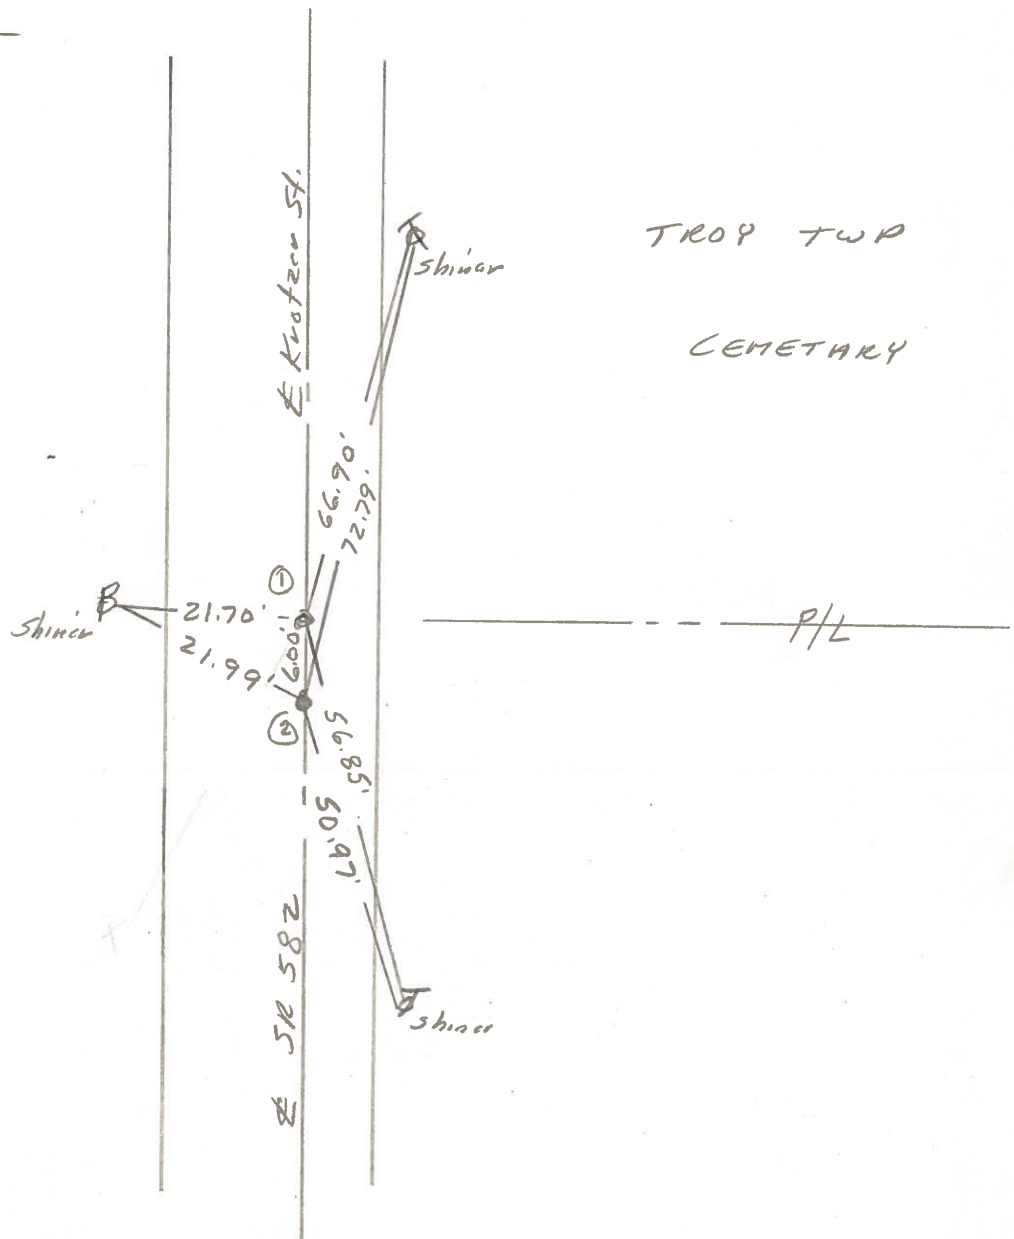REF. NO. 40F

Set PK Nail

- ① Fd 1" I. Pin 3" deep
15.6' to N. edge put.
3.2' to S. edge put.

- ② Fd RR Spk 6" deep
15.2' to N. edge put.
3.5' to S. edge put.

Set PK Nail

Q.D.O.T. DISTRICT 2 SURVEY OFFICE

SHEET 30 OF

County Wood S.R. 582

Township Troy

Section 28

T_N, R_E

Personnel 1. Stone

P. Neuser


R. Michalak

D. Curtis

Date 13 July 83

Weather Warm

Temp. 83°

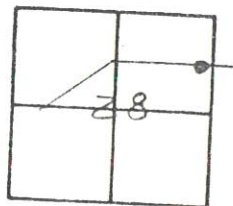

SLM STA. 784 + 14 E + 20
+ 22 + 28

REF. NO. 40 F

TROY TWP

CEMETARY

~~P/L~~

Set PK Mail

- ① Fd 1" I, Pin 3" deep
15.6' to N. edge put.
3.2' to S. edge put.
- ② Fd RR Spk 6" deep
15.2' to N. edge put.
3.5' to S. edge put.

5¢ PK Nail

PERSONNEL

TITLE

PERSONNEL

TITLE

COUNTY WoodDATE April, 12, 1968NorrisonBowersHolcombeKerrS. R. # 582WEATHER ClearSEC. LuckyTEMP 160°

DESCRIPTION

Ties to Control Points.

LEFT

CENTER LINE

RIGHT

JOB NO.

