

O.D.O.T. DISTRICT 2 SURVEY OFFICE

PERSONNEL

REFERENCE NO. 42

SHEET 20 OF 29

NOTES HOMAN

DATE 4-27-10

ROUTE SR 582

H.C. HOMAN

WEATHER SUNNY

COUNTY WOOD

R.C. ROUSOS

TEMP. 45°

TOWNSHIP TROY

SECTION 27

T 6 N R 12 E

TYPE MONUMENT LARGE R.R. SPIKE


ON SURFACE - ~~BELOW~~ On Surface

~~LEFT - C PAV'T~~ - RIGHT 2.8'

6.6' TO RT EDGE PAVEMENT

S.L.M. 823+87.5 REC


GRID: NORTHING: 652456.236 EASTING: 1705719.050

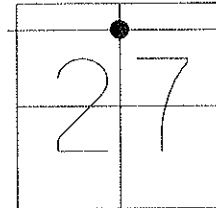

NOTE: PT. 42A ORIGIN UNKNOWN

SET PK/WASHER
11-07-90 MB

NEED TO DIG
4-27-10 DCH

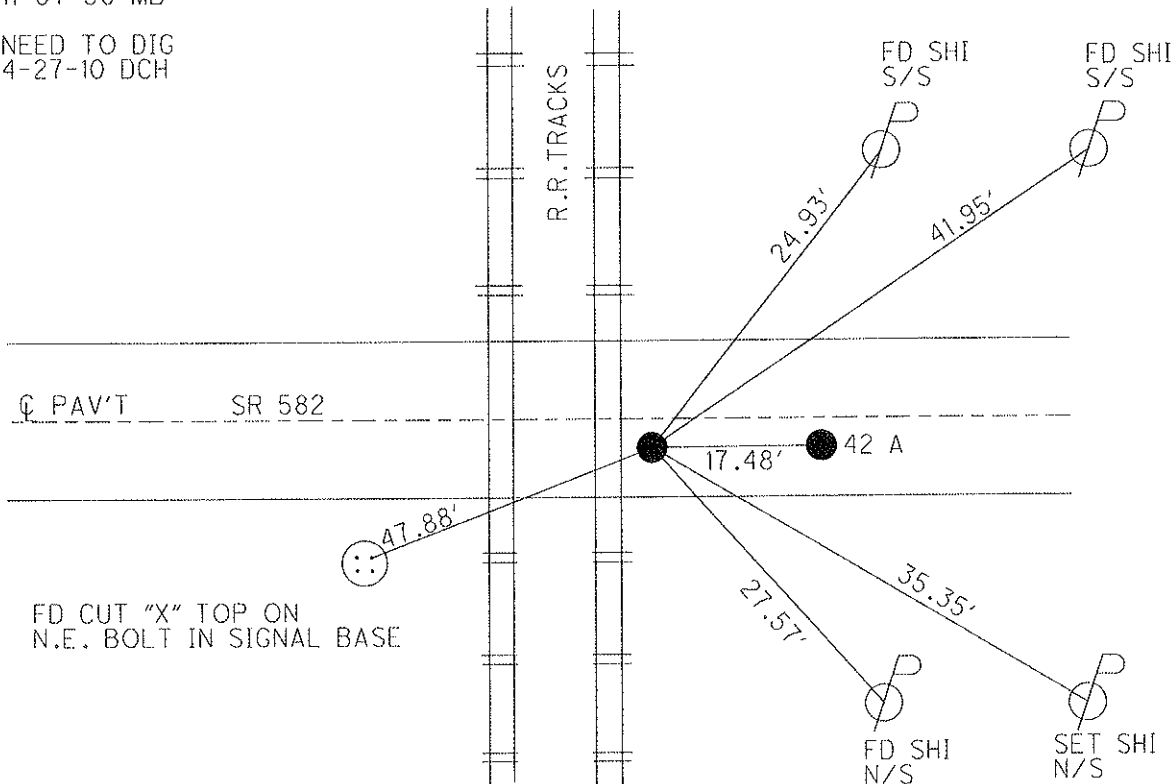

O.D.O.T. DISTRICT 2 SURVEY OFFICE

PERSONNEL

REFERENCE NO. 42

SHEET OF

NOTES LOEHRE

H.C. LOEHRE

R.C. BARNHISEL

DATE 7-26-90

WEATHER Cloudy

TEMP. +80

ROUTE SR 582

COUNTY WOOD

TOWNSHIP TROY

SECTION 27

T 6 N R 12 E


TYPE MONUMENT "A" LARGE RR SPIKE "B" Sm RR Spike

ON SURFACE - BELOW yes

LEFT - & PAV'T. - RIGHT A - 2.8' B - 2.9'

6.6 TO RT EDGE PAVEMENT


S.L.M. A = 823+87.5 B = 824+05

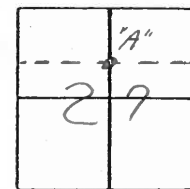


Between - 17.48

Set P.K. & Washers
11-7-90
MB


NOTE: PT 'B'
ORIGIN UNKNOWN

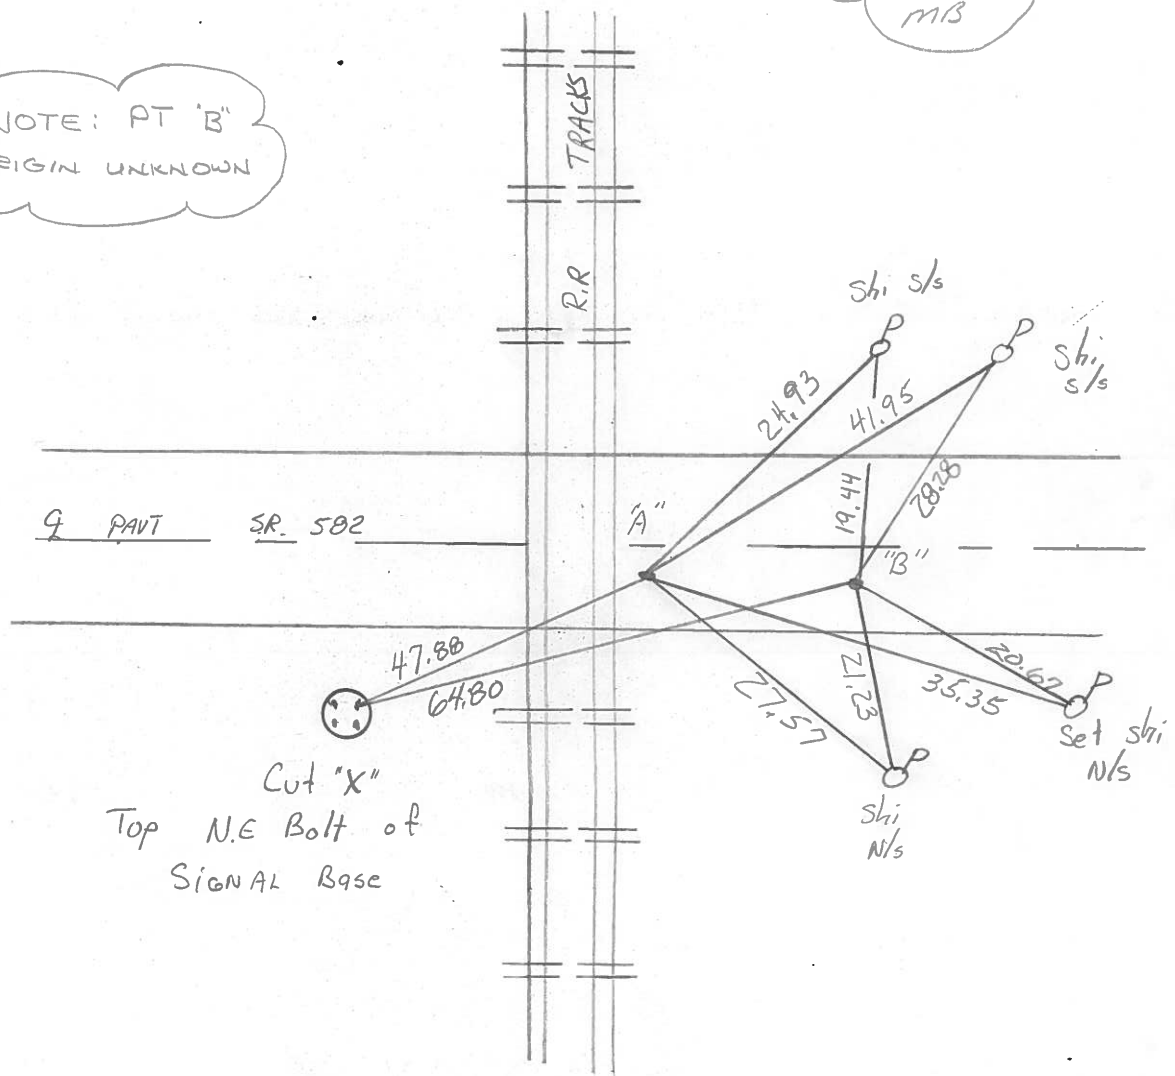

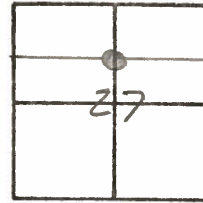County Wood S.R. 582Township TroySection 27T N, R EPersonnel L. StoneP. NeuserR. MichalakD. CurtisDate 13 July 83Weather WarmTemp. 88°

JLM Sta. 823+79

REF. No. 42

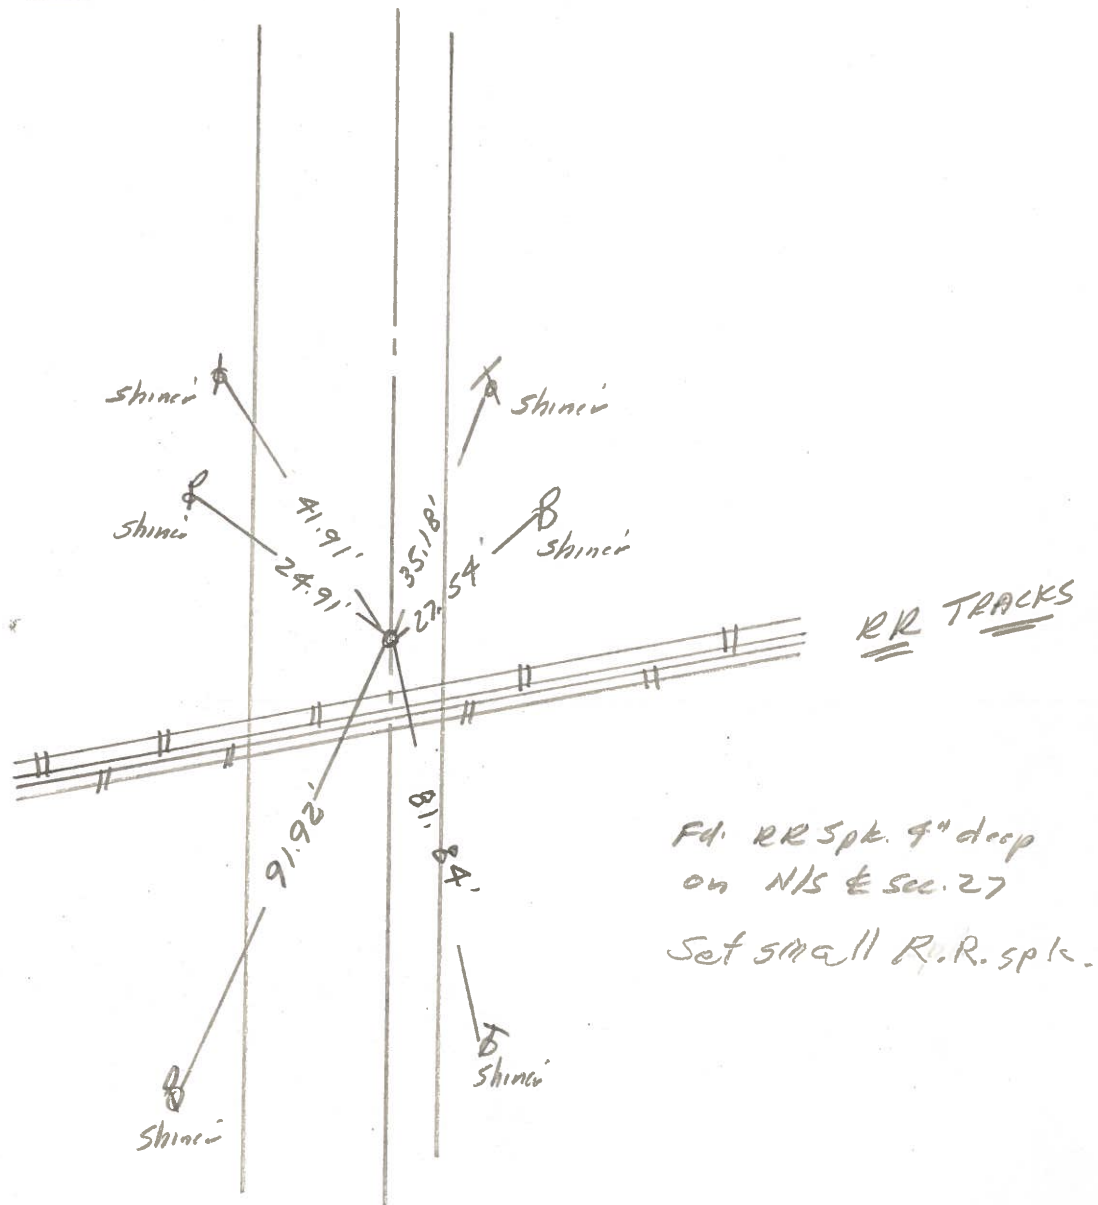

Q.D.O.T. DISTRICT 2 SURVEY OFFICE

SHEET 32 OF

County Wood S.R. 582

Township Troy

Section 27

T N, R E

Personnel I. Stone

P. Neuser


R. Michalak

D. Curtis

Date 13 July 83


Weather Warm

Temp. 88°

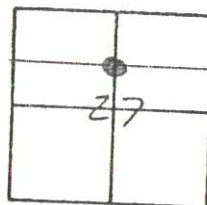

SLM Sta. 823+79

REF. No. 42

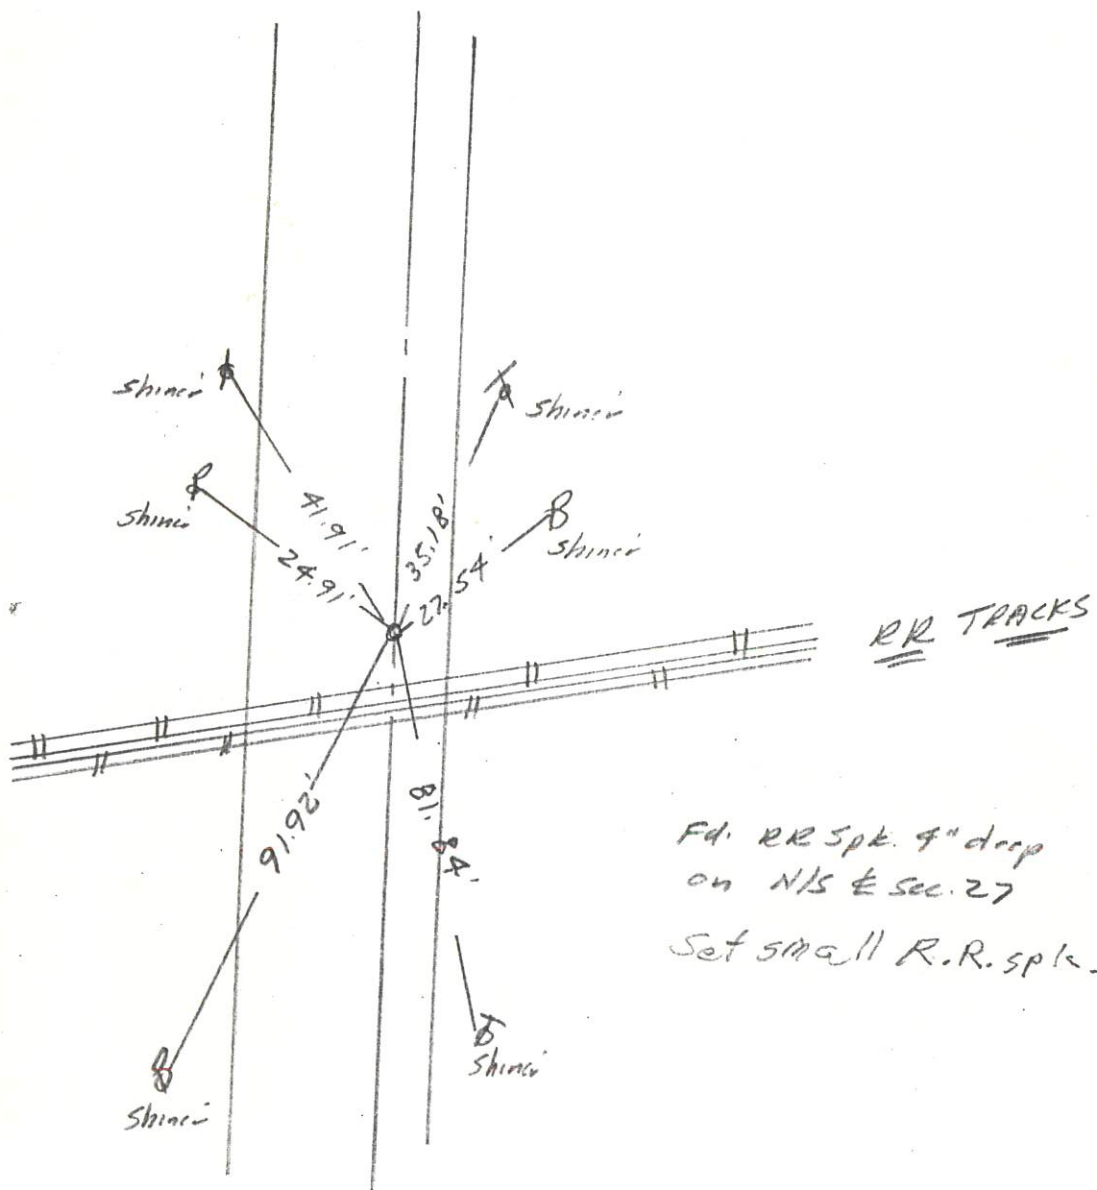

PERSONNEL	TITLE	PERSONNEL	TITLE	COUNTY	DATE	WEATHER	TEMP.
Stone		Grenada		Wood	17 June 76		
Michalak				S. R.	582		
Curtis				SEC.	27 - Troy Twp.		75°
Neuser				DESCRIPTION	References to Control Points	JOB NO.	

