

O.D.O.T. DISTRICT 2 SURVEY OFFICE (USE ONLY)

PERSONNEL

REFERENCE NO. 45

SHEET 18 OF 25

NOTES TRENKA
H.C. LEU
R.C. TRENKA

DATE 7/31/18
WEATHER RAIN
TEMP. 73°

ROUTE SR 582
COUNTY WOOD
TOWNSHIP TROY
SECTION 26

DWG BY BARRIERE PID 107717

T 6 N R 12 E

TYPE MONUMENT MAG/WASHER

ON SURFACE - BELOW ON

OFFSET $\varnothing$ PAVEMENT 1.6' LT

TO EDGE PAVEMENT

STATION: 889+25.97

HORIZ.DATUM: NAD83 (2011)


GEOID: 18

GRID: NORTHING: 651100.557


EASTING: 1709675.026

LDP: NORTHING: 473697.774

EASTING: 220473.062

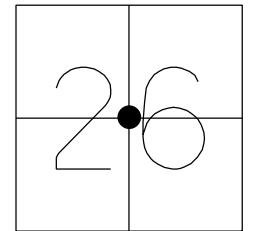

RECORD:
SET P.K./WASHER
6-17-82, SWH
SET MAG/WASHER
NEWREF45
7-09-10, DCH
FD MAG/WASHER
REF45
7-31-18, JLL
8-20-19, JFOFD MAG/WASH
REF45
12/9/22, TDN
FD MAG/WASH
REF45
7/25/24, TDN

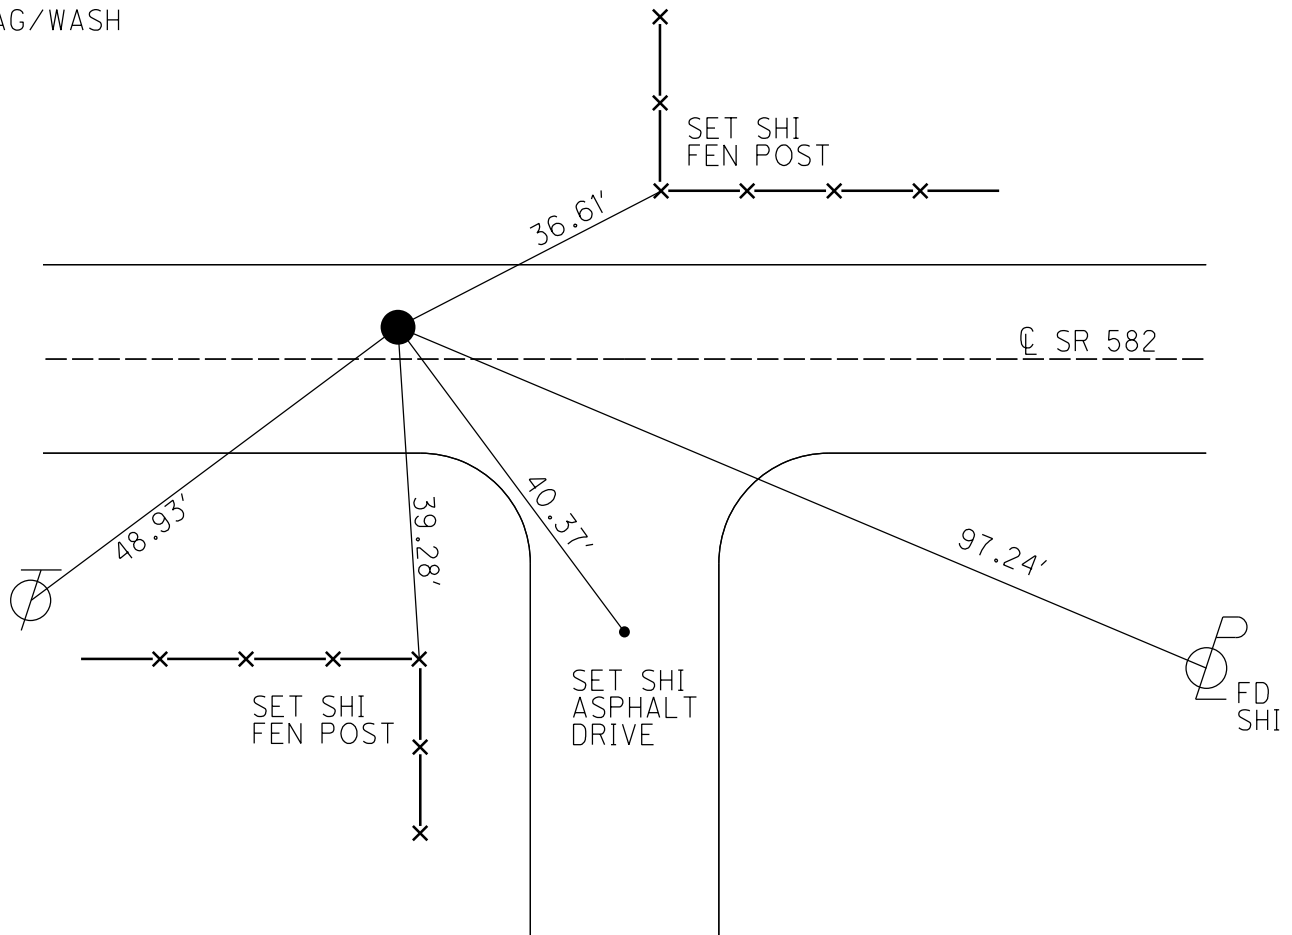

O.D.O.T. DISTRICT 2 SURVEY OFFICE (USE ONLY)

PERSONNEL

REFERENCE NO. 45

SHEET 26 OF 29

NOTES TRENKA

DATE 7-31-18

ROUTE SR 582

H.C. LEU

WEATHER RAIN

COUNTY WOOD

R.C. TRENKA

TEMP. 73°

TOWNSHIP TROY

SECTION 26

DWG BY NIESE PID NO PID

T 6 N R 12 E

TYPE MONUMENT MAG/WASHER

ON SURFACE - ~~BELOW~~ ON

OFFSET CL PAVEMENT 1.6' LT : RT

8.9' TO N EDGE PAVEMENT


STATION: 889+25.97

HORZ.DATUM: NAD83(2011)


GEOID: 2012A

GRID: NORTHING: 651100.529

EASTING: 1709675.064

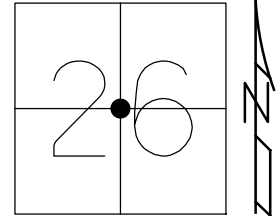

RECORD:
SET P.K./WASHER
6-17-82, SWH
SET MAG/WASHER
NEWREF45
7-09-10, DCH
FD MAG/WASHER
REF45
7-31-18, JLL
8-20-19, JFO

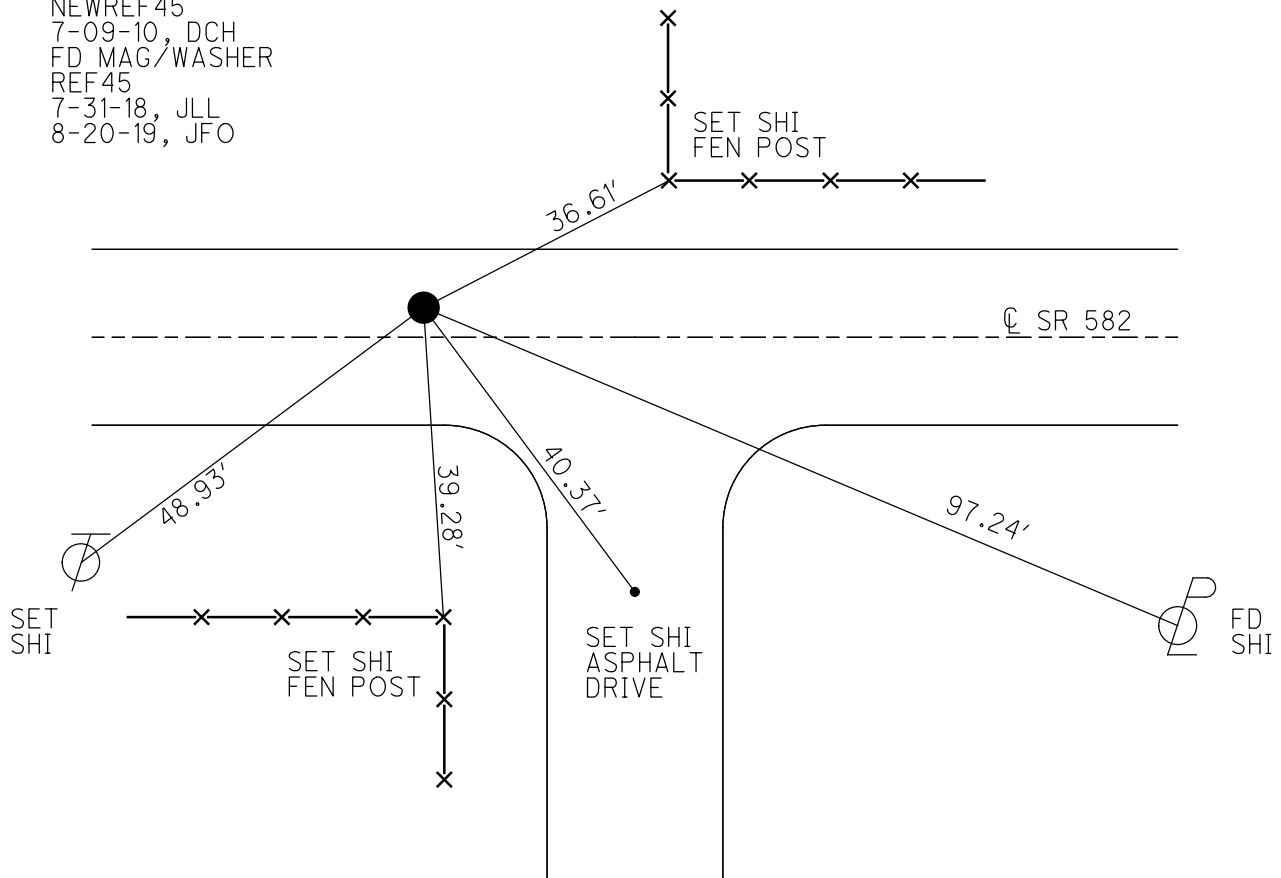

O.D.O.T. DISTRICT 2 SURVEY OFFICE

PERSONNEL

REFERENCE NO. 45

SHEET 26 OF 29

NOTES HOMAN

DATE 4-28-10

ROUTE SR 582

H.C. Homan

WEATHER SUNNY

COUNTY WOOD

R.C. ROUSOS

TEMP. 35°

TOWNSHIP TROY

SECTION 26

T_6_N R_12_E

TYPE MONUMENT SQUARE HEAD BOLT


ON SURFACE - BELOW 3"

LEFT - ~~C~~ PAV'T - RIGHT 1.6'

8.9' TO ^LN EDGE PAVEMENT

S.L.M. 889+25.97, 10.6' TO S. E.P.

GRID: NORTHING: 651100.553 EASTING: 1709674.952

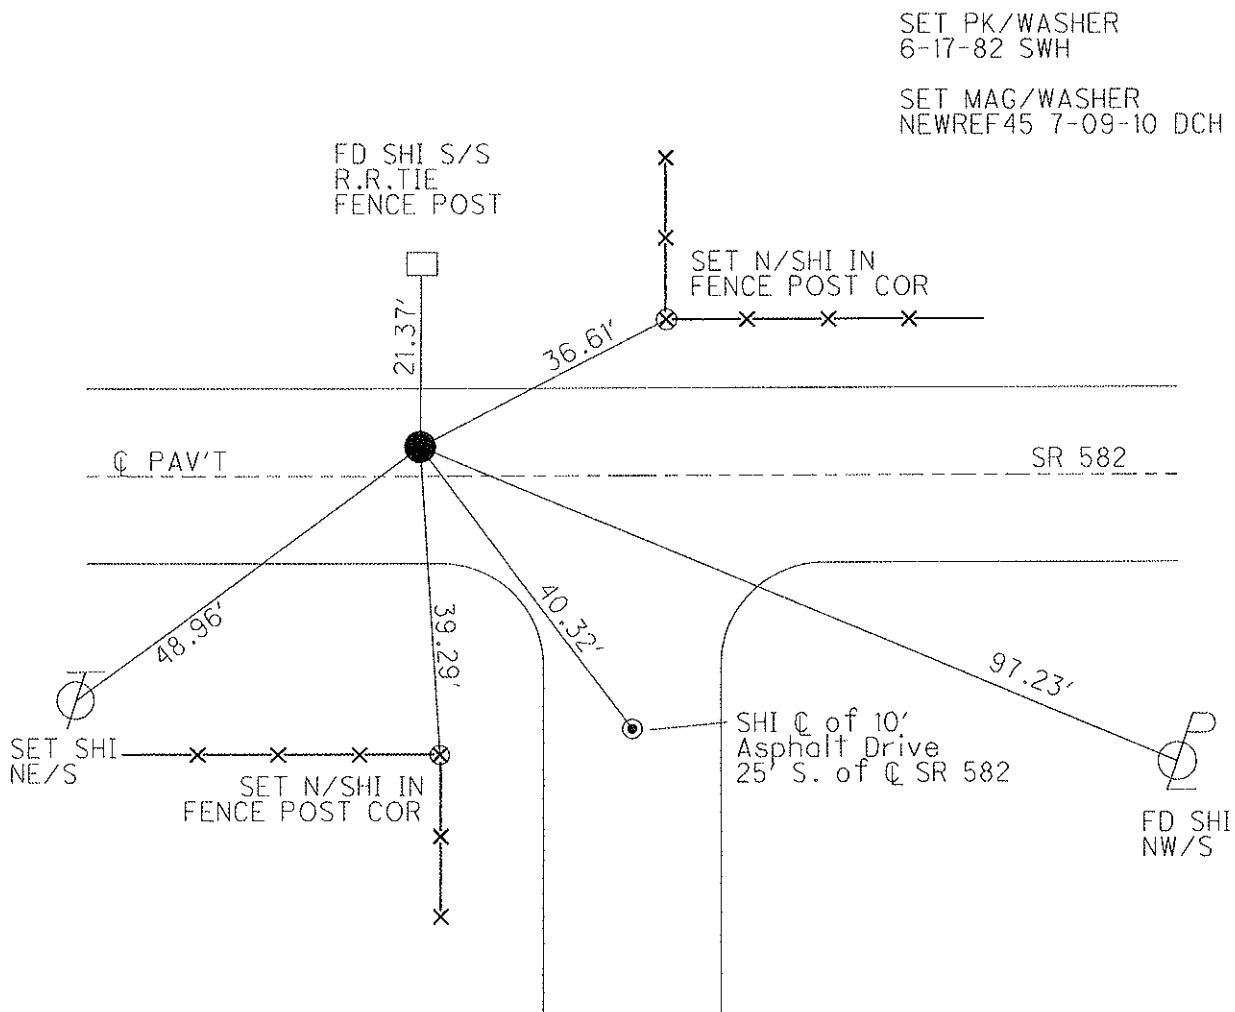

County Wood S.R. 582Township TroySection 26


T6N, R12E

Personnel Hoffman

F

Crew

#45

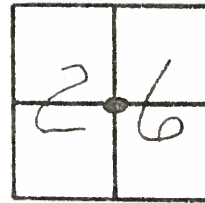Date 5-7-82Weather RainTemp. +70



Ed. "D" Head Bolt 1/2" Below surface

S.L.M. Sta ± 869 + 32

1.6' Lt. of & PAUT

8.9' TO N.E.P.

10.6' TO S.E.P.

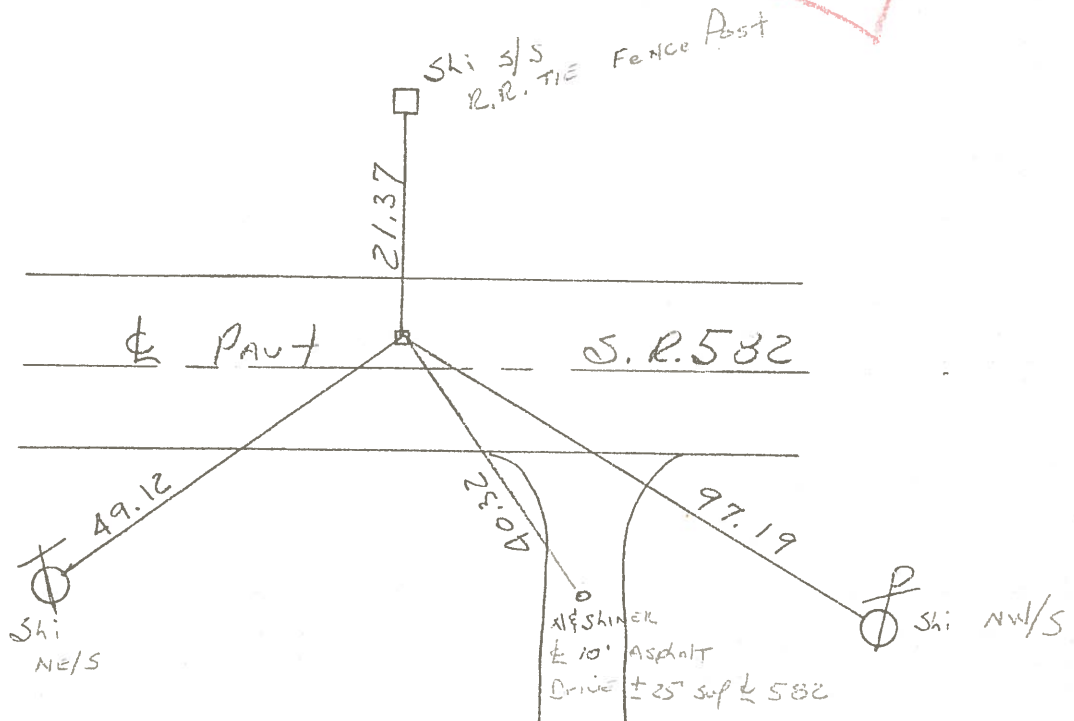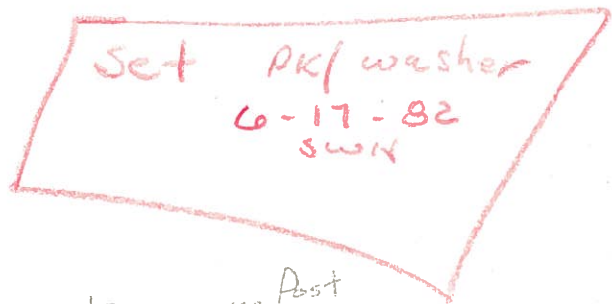

County Wood S.R. 582

Township TROY

Section 26

T6N, R12E

Personnel HOFFMAN


F

Crew

Date 5-7-82

Weather Rain

Temp. +70

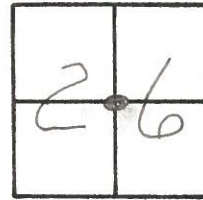

#45

Fd. "D" HEAD BOLT 1/2" Below surface


S.L.M. Sta ± 869 + 32

1.6' Lt. of & PAUT

8.9' TO N.E.P.

10.6' TO S.E.P.

SET P.K./WASHER
6-17-82
S.W.H.

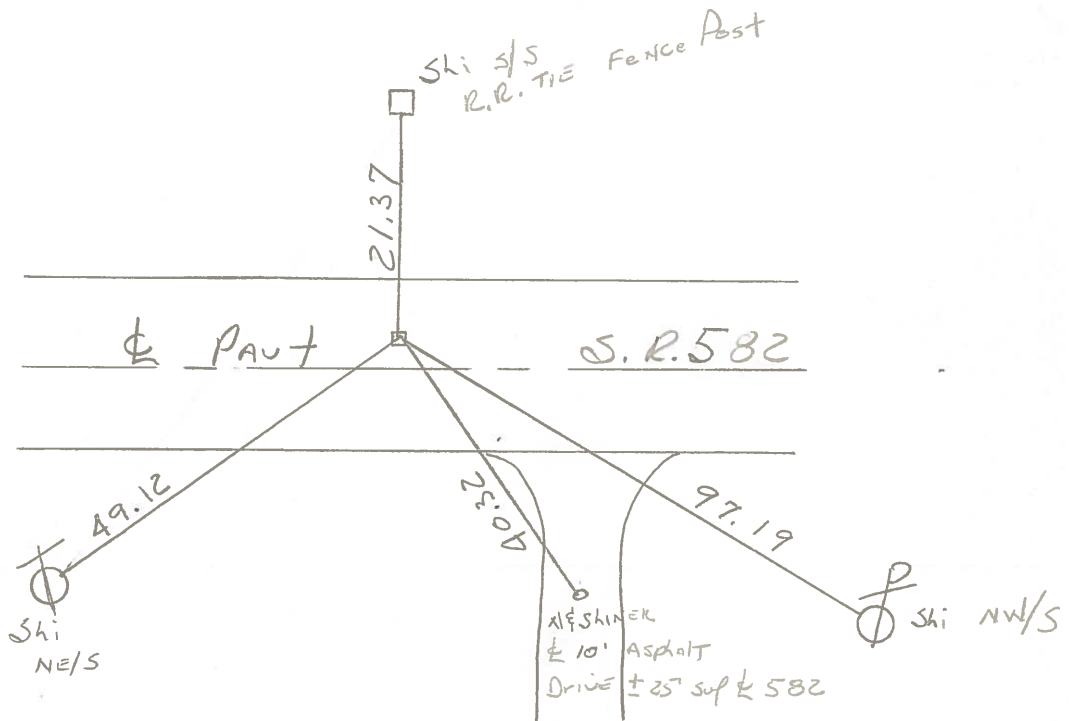

Town 6 N. Range 12 E.

1/4 Corner of Sections 26, 27 T20Y 2W

Kind of Monument R.R. SPK Remarks

FOUND SET 12-23-1968 BY COUNTY

N. & S. Road PEMBERVILLE F. B. P.


E. & W. Road ST. RT. 582 F. B. P.

44

N



Date Checked:

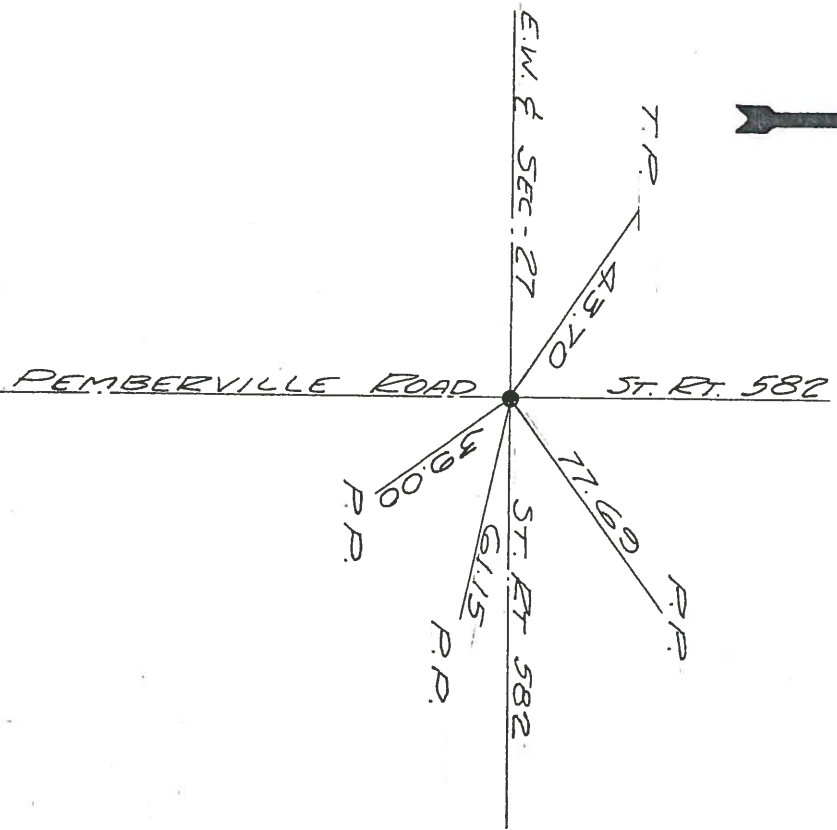

Town 6 N Range 12 E.

INT. Corner of Sections 26 T20Y

Kind of Monument BOLT Remarks

FOUND SET 12-14-1970 BY

N. & S. Road PEMBERVILLE F. B. P.

E. & W. Road ST. RT. 582 F. B. P.

45

N



Date Checked:

