

O.D.O.T. DISTRICT 2 SURVEY OFFICE (USE ONLY)

PERSONNEL

REFERENCE NO. 19

SHEET 17 OF 19

NOTES

HUSS

DATE

5/23/12

ROUTE

SR 795

H.C.

CANTERBURY

WEATHER

SUNNY

COUNTY

WOOD

R.C.

HUSS

TEMP.

80°

TOWNSHIP

LAKE

SECTION

21

T 7 N R 12 E

TYPE MONUMENT P.K.NAIL


ON SURFACE - ~~BELOW~~ ON

LEFT - Q PAV'T - RIGHT -

- TO - EDGE PAVEMENT


S.L.M. 417+64

GRID: NORTHING: 690272.911 EASTING: 1699518.615

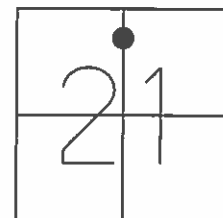

RECORD:
STA. 417+84 ±
FD P.K.NAIL
13.2' TO N/EP
9/10/71, I.S.
GPS, REF19
5/23/12, MC

TOP S/E COR.
ON E/S OF
ODOT CONTROL
BOX

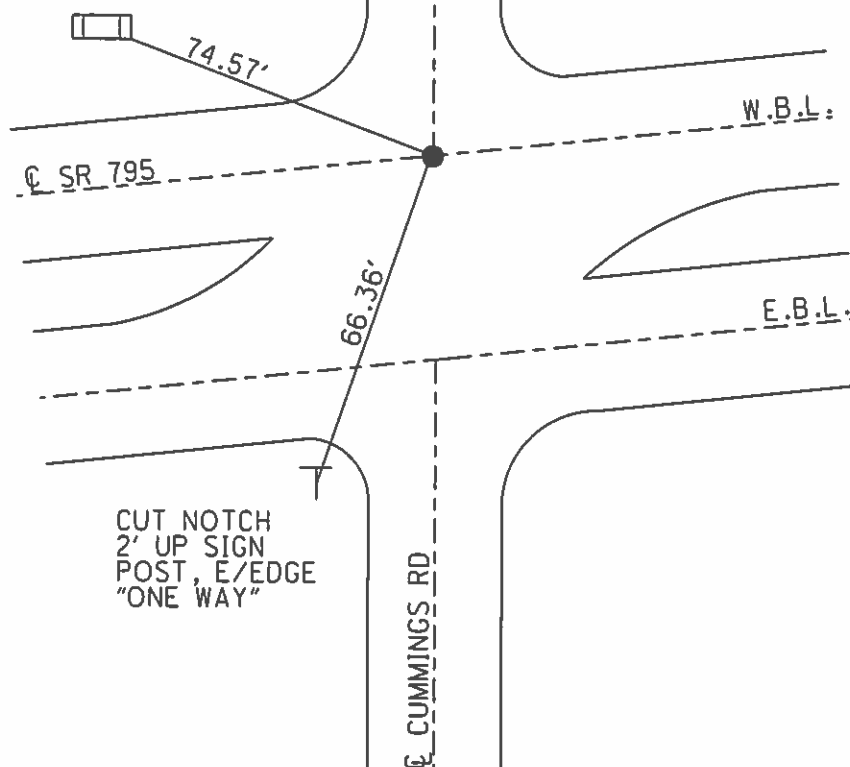

PERSONNEL	TITLE	PERSONNEL	TITLE	COUNTY	DATE	WEATHER	TEMP.
Stone	Notes			Wood	10 Sept. 71	Humid	85°
Michaelat	H.C.			S. R. #795			
Schroder	R.C.			SEC. Cummings Rd. East			
Farr	FD						

DESCRIPTION References to Control Points JOB NO. _____

LEFT CENTER LINE RIGHT

