


O.D.O.T. DISTRICT 2 SURVEY OFFICE (USE ONLY)


PERSONNEL	REFERENCE NO. <u>20</u>	SHEET <u>18</u> OF <u>19</u>
NOTES	DATE <u>5/23/12</u>	ROUTE <u>SR 795</u>
H.C. <u>HUSS</u>	WEATHER <u>SUNNY</u>	COUNTY <u>WOOD</u>
R.C. <u>HUSS</u>	TEMP. <u>80°</u>	TOWNSHIP <u>LAKE</u>
		SECTION <u>21</u>
		T <u>7</u> N R <u>12</u> E

TYPE MONUMENT R.R.SPIKE
~~ON SURFACE~~ - BELOW 2"
 LEFT - Q PAV'T - RIGHT -
- TO - EDGE PAVEMENT
 S.L.M. 444+57

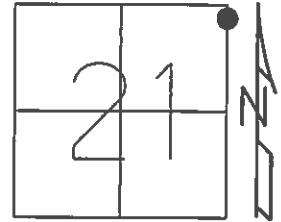

GRID: NORTHING: 690672.001 EASTING: 1702183.394

RECORD:
 STA. 444+86 ±
 FD R.R.SPIKE
 2" DOWN
 9/10/71, I.S.
 FD R.R.SPIKE
 CENTERED BETWEEN
 SR 795, 2 LANES
 GPS, REF20
 5/23/12, MC

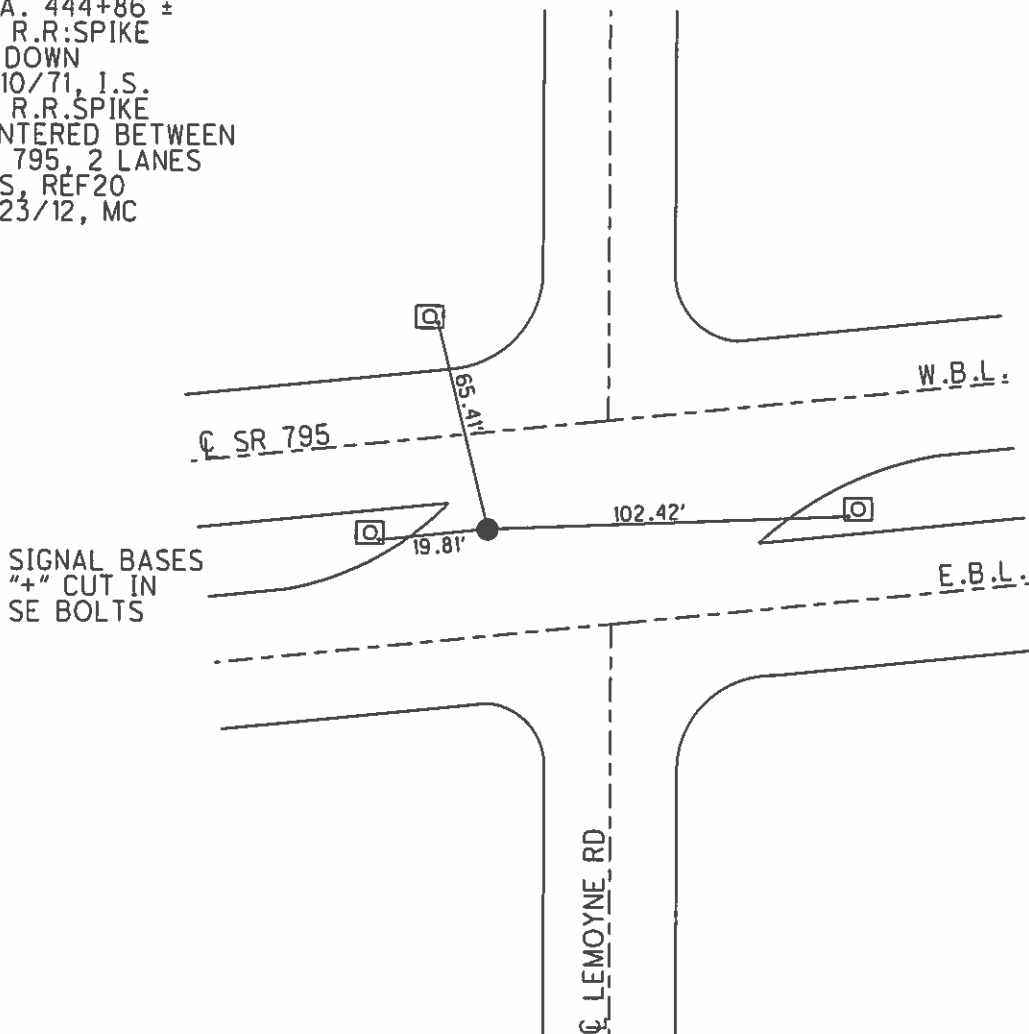

PERSONNEL	TITLE	PERSONNEL	TITLE	COUNTY	DATE	WEATHER	TEMP.
Stone	Notes			Wood	10 Sept. 71	Humid	85°
Michaelat	H.C.			S. R. #795			
Schroder	R.C.			SEC. Cummings Rd. East			
Farr	FD						

DESCRIPTION References to Central Points JOB NO. _____

LEFT CENTER LINE RIGHT

