

O.D.O.T. DISTRICT 2 SURVEY OFFICE (USE ONLY)

PERSONNEL

REFERENCE NO. 23

SHEET 1 OF 11

NOTES LOHRKE

DATE 7/18/88

ROUTE SR 795

H.C. REED

WEATHER HAZY, HUMID

COUNTY WOOD

R.C. BARNHISEL

TEMP. 85

TOWNSHIP LAKE

HOFFMAN

SECTION 22

T 7 N R 12 E

TYPE MONUMENT MONBOX


~~ON SURFACE~~ - BELOW BELOW

LEFT - Q PAV'T - ~~RIGHT~~ 9.6'

3.3' TO N. EDGE PAVEMENT

S.L.M. 487+53.44

Grid: Northing: 690894.779 Easting: 1706447.033

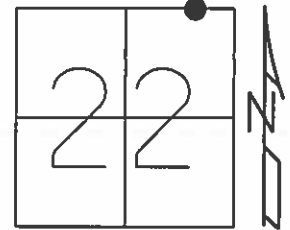

NOTE:
FD MONBOX W.OF
Q CONC.MED.OF
RAMPS

GPS, REF23
12/17/10, MC

SET SHI'S NEAR
FACE G.R.POSTS

S.W.COR.
CONC.BASE

77.9'
REC

54.0'
REC

17.0'
REC

OFF RAMP
N.B.I-280

ON RAMP
N.B.I-280

CONC.
MED.

Q SR 795

COMMERCIAL
DRIVE

O.D.O.T. DISTRICT 2 SURVEY OFFICE

PERSONNEL

REFERENCE NO. 23

SHEET OF

NOTES LOEHRKE

H.C. Reed

R.C. BARNHISEL

Hoffman

DATE 7-18-88

WEATHER HAZY Humid

TEMP. +85

ROUTE SR. 795

COUNTY WOOD

TOWNSHIP LAKE

SECTION 22

T 5 N R 12 E



TYPE MONUMENT MON BOX

ON SURFACE - BELOW BELOW

LEFT- & PAV'T. - RIGHT 26 LEFT

33 TO NORTH EDGE PAVEMENT

S.L.M. 492 + 74

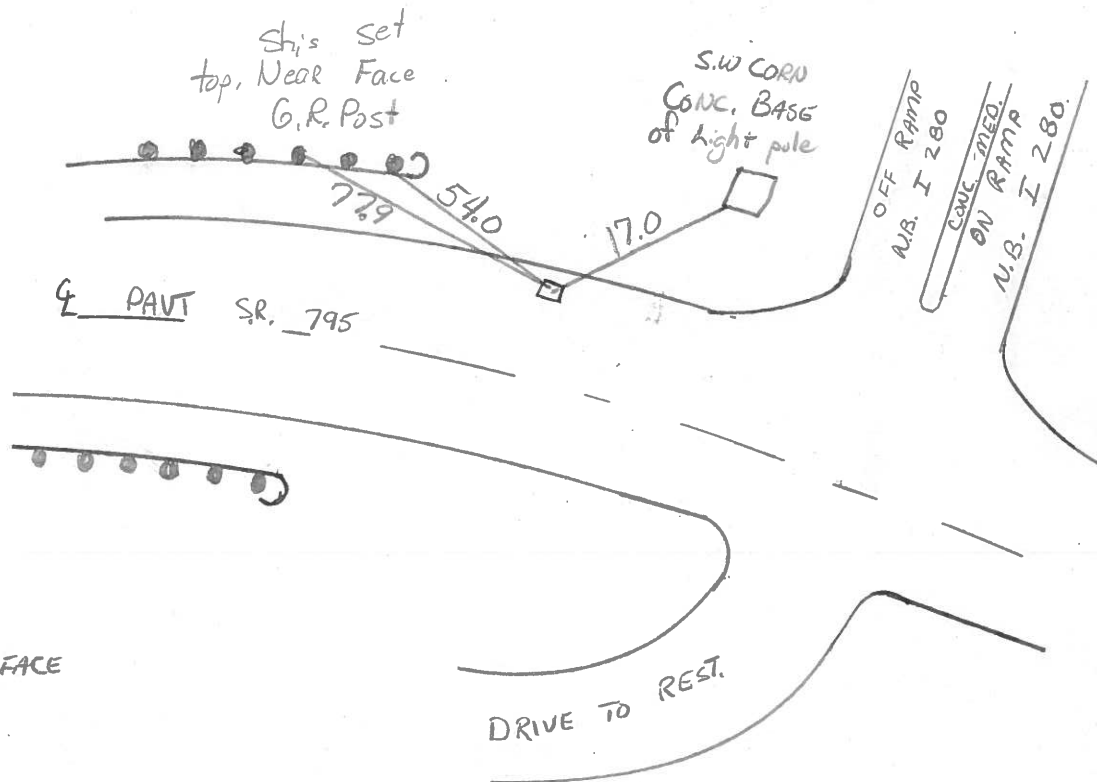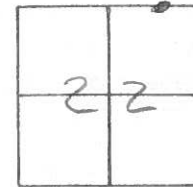

Fd. MON BOX
BELOW SURFACE

33 TO N.E.P

9.16 LF of &

W of &
CONC. MED. OF RAMPS.

PERSONNEL	TITLE	PERSONNEL	TITLE	COUNTY	DATE	WEATHER	TEMP.
Stone	Notes			Wood	13 Sept. 71		
Michalak	H.C.			S. R. 795		Cool	
Farr	R.C.			SEC. I-280 - East			68°

DESCRIPTION References to Control Points JOB NO. _____

LEFT CENTER LINE RIGHT

(22)

Ed. Mon. Box to Surface
 .54 Mile East of
 Lemoyne Rd. = P.I.
 2.5' to N. Edge Pnt.
 21.1' to S. Edge Pnt.

Guard rail

Guard Rail

Shiners in
guard post

± Const. SR-795

(23)

RAMP TO EXP.

CON.

RAMP FROM EXP.

Ed. Mon. Box. To Surface
 .80 Mile East of Lemoyne
 Rd. = P.I.

to N. Edge Pnt.
 to S. Edge Pnt.

± SR-795

- DRIVE TO REST.

PERSONNEL	TITLE	PERSONNEL	TITLE	COUNTY	DATE	WEATHER	TEMP.
Stear	Notes			Wood	13 Sept. 71		
Michaelak	H.C.			S. R. 795		Cool	
Farr	R.C.			SEC. I-280 - East			68°

DESCRIPTION References to Control Points LEFT CENTER LINE RIGHT JOB NO.

