

# O.D.O.T. DISTRICT 2 SURVEY OFFICE (USE ONLY)

PERSONNEL

REFERENCE NO. 23 A

SHEET 2 OF 11

NOTES HUSS

DATE 1/3/11

ROUTE SR 795

H.C. CANTERBURY

WEATHER CLEAR

COUNTY WOOD

R.C. HUSS

TEMP. 25°

TOWNSHIP LAKE

SECTION 22

T 7 N R 12 E

TYPE MONUMENT MONBOX



ON SURFACE - ~~BELOW~~ ON

~~LEFT~~ - Q PAV'T - RIGHT 9.7'

1.8' TO N. EDGE PAVEMENT

S.L.M. 494+09.84

Grid: Northing: 690774.672 Easting: 1707092.352

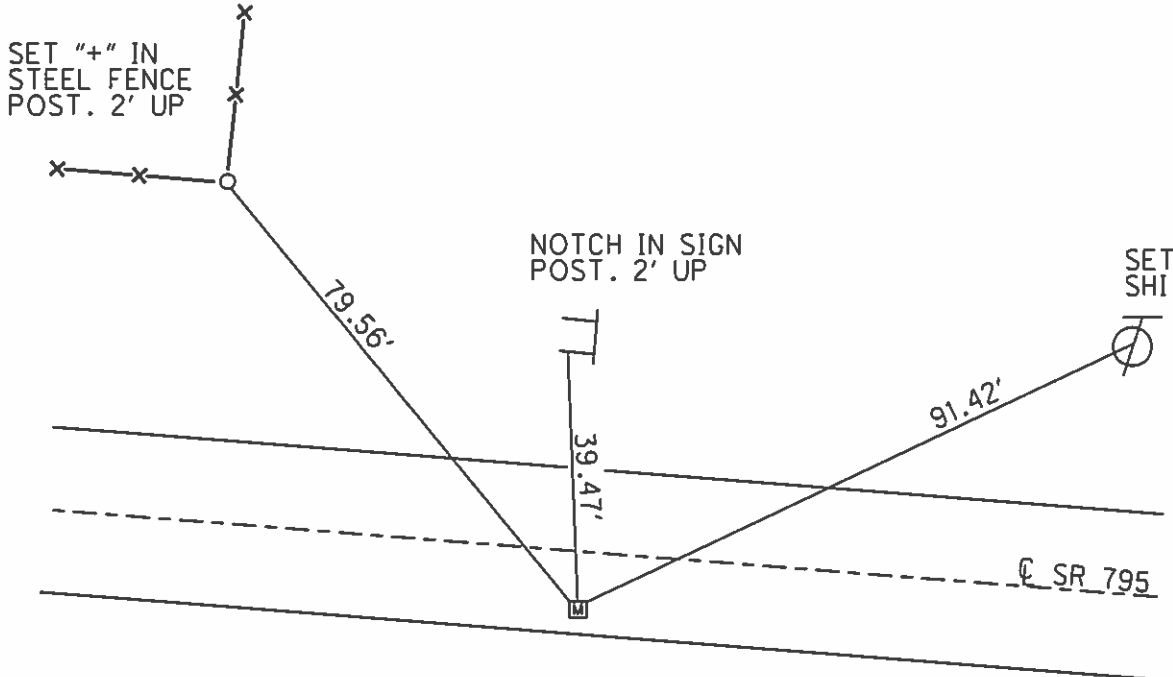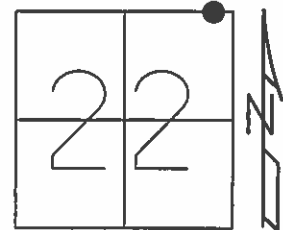

RECORD: 1988  
FD MONBOX BELOW  
SURFACE.  
SLM: 499+25  
380.73' W.OF  
PEMBERVILLE RD.

GPS, REFA23  
1/3/11, MC

O.D.O.T. DISTRICT 2 SURVEY OFFICE

## PERSONNEL

REFERENCE NO. 23-A & 24

SHEET \_\_\_\_\_ OF \_\_\_\_\_

NOTES LOEHRKE

H.C. Reed

R.C. BARNHISE

Hoffman

DATE 7-18-88

WEATHER HAZY Humid

TEMP. + 35

ROUTE S.R. 795

COUNTY WOOD

TOWNSHIP LAKE

SECTION 22

T 2 N R 12 E



TYPE MONUMENT P.R. State REL 21

ON SURFACE - BELOW 2" BLOW FACE

LEFT - & PAN'T. - RIGHT      6.6 RIGHT

TO 5.0 EDGE PAVEMENT 2.4 W. of Rd S. / 4.0 W. of Rd. N.

S.L.M. 503706

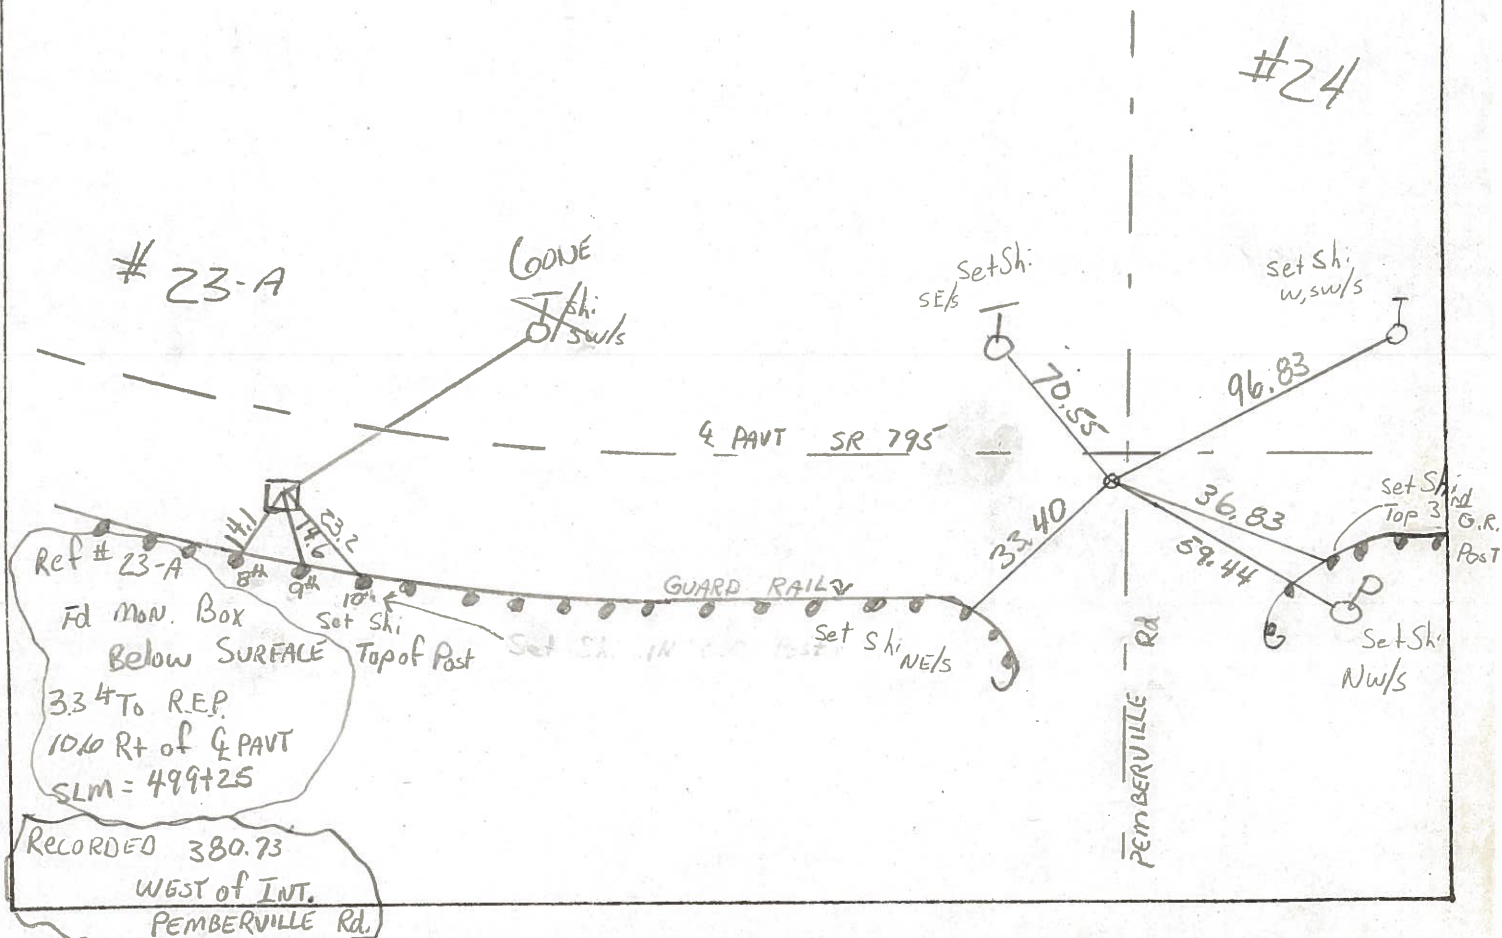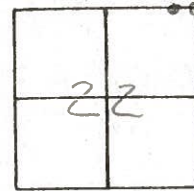

| PERSONNEL | TITLE | PERSONNEL | TITLE | COUNTY | DATE        | S. R. | WEATHER | SEC.         | TEMP. | DESCRIPTION                  | JOB NO. |
|-----------|-------|-----------|-------|--------|-------------|-------|---------|--------------|-------|------------------------------|---------|
| Stone     | Notes |           |       | Wood   | 13 Sept. 71 | 795   | Cool    | I 280 - East | 68°   | References to Control Points |         |
| Michalak  | H.C.  |           |       |        |             |       |         |              |       |                              |         |
| Karr      | R.C.  |           |       |        |             |       |         |              |       |                              |         |

