

O.D.O.T. DISTRICT 2 SURVEY OFFICE (USE ONLY)

PERSONNEL

REFERENCE NO. 25

SHEET 4 OF 11

NOTES HUSS

DATE 4/13/12

ROUTE SR 795

H.C. CANTERBURY

WEATHER CLEAR

COUNTY WOOD

R.C. HUSS

TEMP. 59°

TOWNSHIP LAKE

SECTION 23

T 7 N R 12 E

TYPE MONUMENT R.R.SPIKE


ON SURFACE - ~~BELOW~~ ON

~~LEFT~~ - Q PAV'T - RIGHT 4.3'

13' TO RT EDGE PAVEMENT

S.L.M. 524+21.50


Grid: Northing: 690749.036 Easting: 1710104.802

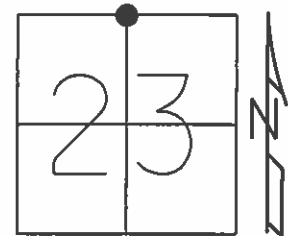

RECORD: 1988
FD R.R.SPIKE, 7/18/88
RESET SM.R.R.SPIKE, 9/28/88
SLM: 528+84

FD SM.R.R.SPIKE
12/16/10
GPS, REF25
12/17/10, MC

SET MAG/WASHER
10/22/12, SAH
GPS, NEWREF25
4/17/13, SDC

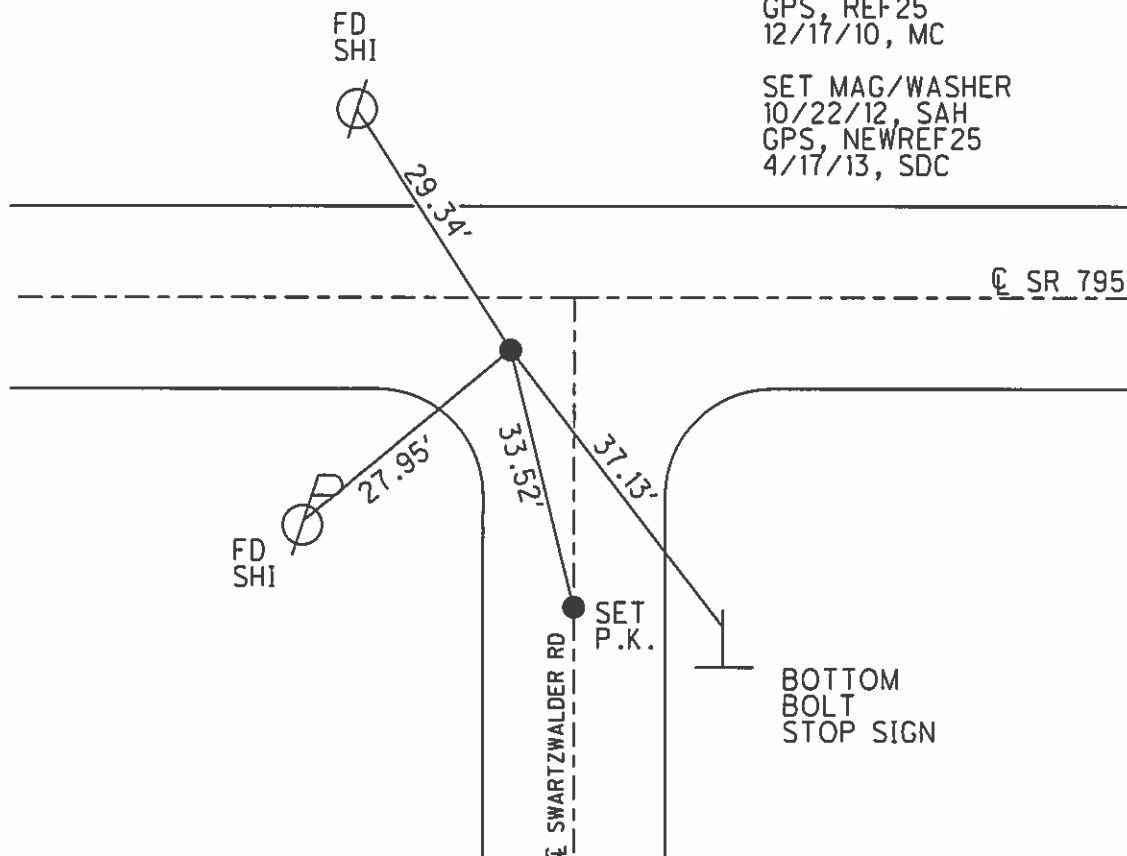

O.D.O.T. DISTRICT 2 SURVEY OFFICE

PERSONNEL

REFERENCE NO. 25

SHEET OF

NOTES LOEHRKE

H.C. Reed

R.C. BARUHISEL

HOTTMAN

DATE 7-18-88

WEATHER 14 Cloudy

TEMP. +70

Set Sm. R.R. Spike
9-20-88
C.L.

ROUTE SR 795

COUNTY Woon

TOWNSHIP LAKE

SECTION 23

T 7 N R 12 E

TYPE MONUMENT R.R. Spike



ON SURFACE - BELOW 2" Below

LEFT - 4.2 PAV'T. - RIGHT 4.2 Rt &

13.2 TO Lt EDGE PAVEMENT

S.L.M. 528 + 84


5.5 w & Road South

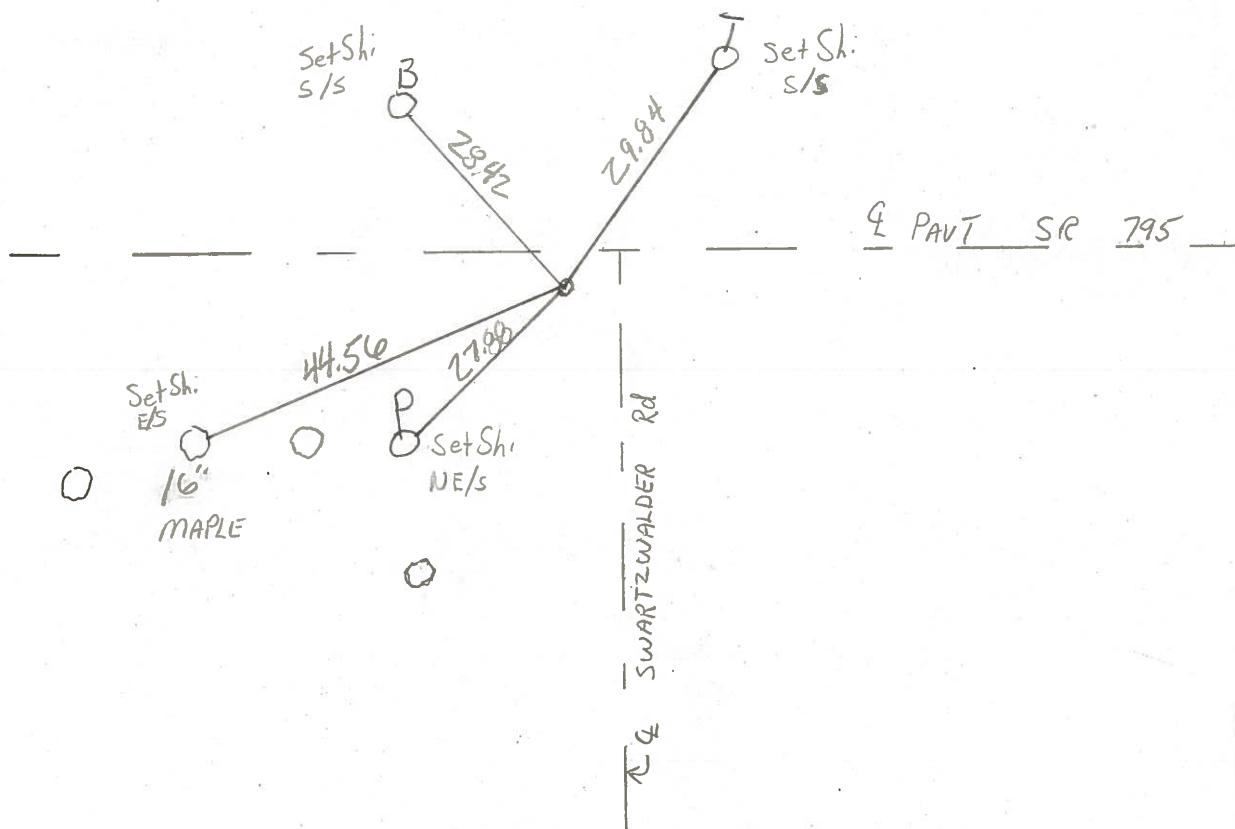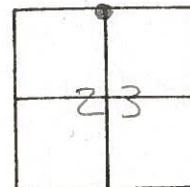

PERSONNEL	TITLE	PERSONNEL	TITLE	COUNTY	DATE	WEATHER	TEMP.
Stone	Notes			Wood	13 Sept. 71		
Michalak	H.C.			S. R. 795		Cool	
Farr	R.C.			SEC. Pemberville Rd. East			68°

DESCRIPTION References to Control Points JOB NO. _____

LEFT CENTER LINE RIGHT

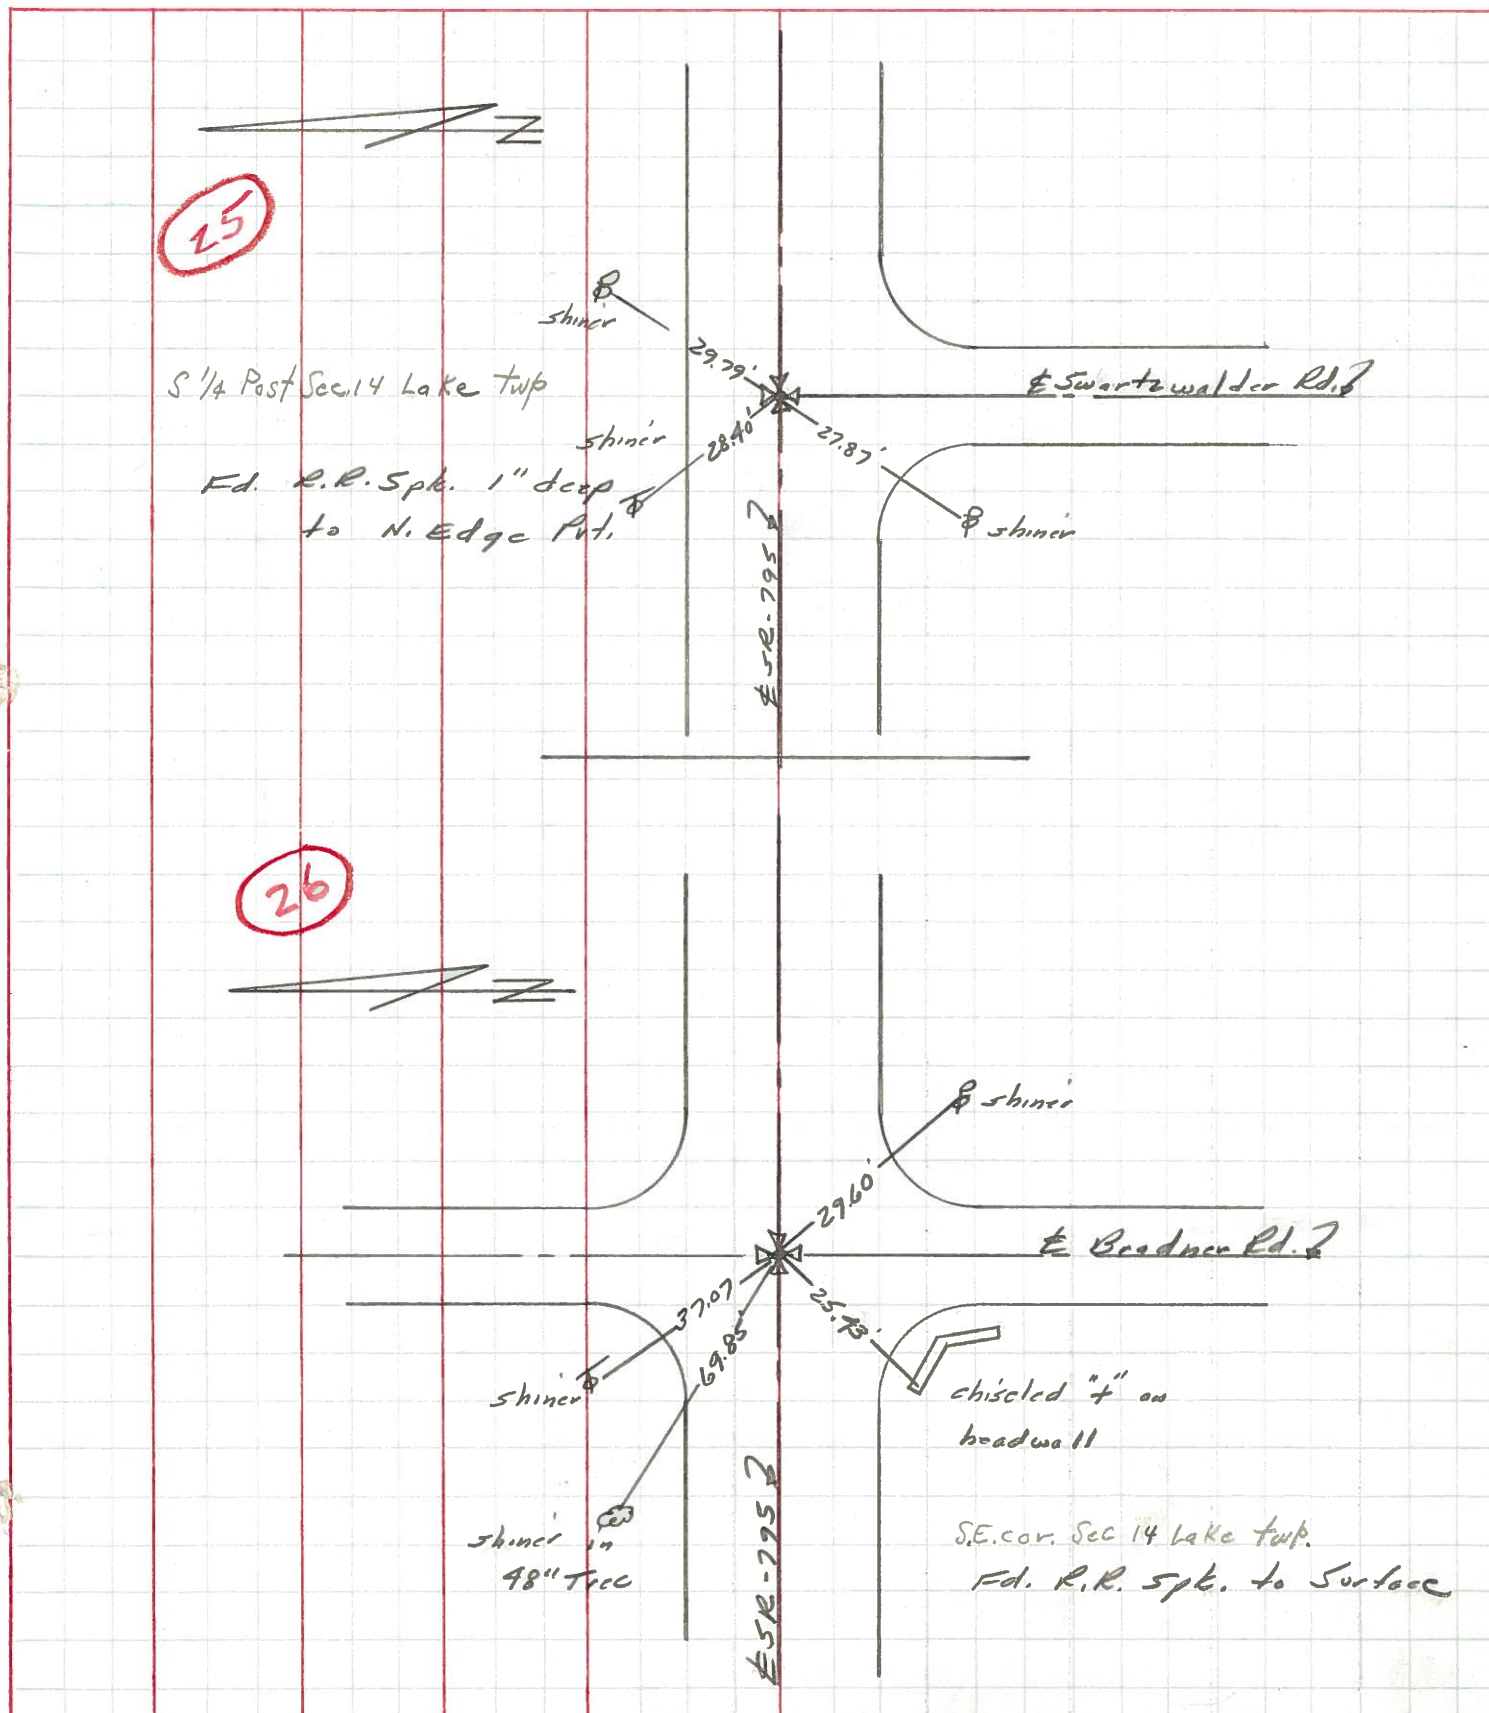

PERSONNEL TITLE PERSONNEL TITLE

COUNTY WoodDATE May 1, 1962SworderHolcombeS. R. # 795WEATHER CloudySageGarnoNew BR. # 0998TEMP. 65°DESCRIPTION Ties for Control Points

JOB NO.

LEFT

CENTER LINE

RIGHT

