

O.D.O.T. DISTRICT 2 SURVEY OFFICE (USE ONLY)

PERSONNEL

REFERENCE NO. 26 B

SHEET 8 OF 11

NOTES HUSS

DATE 4/19/12

ROUTE SR 795

H.C. CANTERBURY

WEATHER CLEAR

COUNTY WOOD

R.C. HUSS

TEMP. 60°

TOWNSHIP LAKE

SECTION 24

T 7 N R 12 E

TYPE MONUMENT LG.R.R.SPIKE


ON SURFACE - ~~BELOW~~ ON

~~LEFT~~ - Q PAV'T - RIGHT 3.0'

7.8' TO RT EDGE PAVEMENT

S.L.M. 577+08.01

Grid: Northing: 690654.572 Easting: 1715389.260

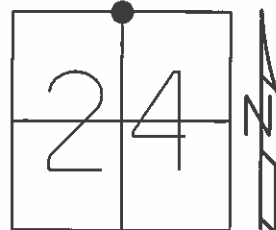

RECORD: 1988

FD R.R.SPIKE, 7/14/88

RESET SM.R.R.SPIKE, 9/28/88

SLM: 581+70

FD LG.R.R.SPIKE

12/16/10

GPS, SVB26


12/17/10, MC

SET MAG/WASHER

12/24/12, MC

GPS, NEWREFB26

4/16/13, SDC

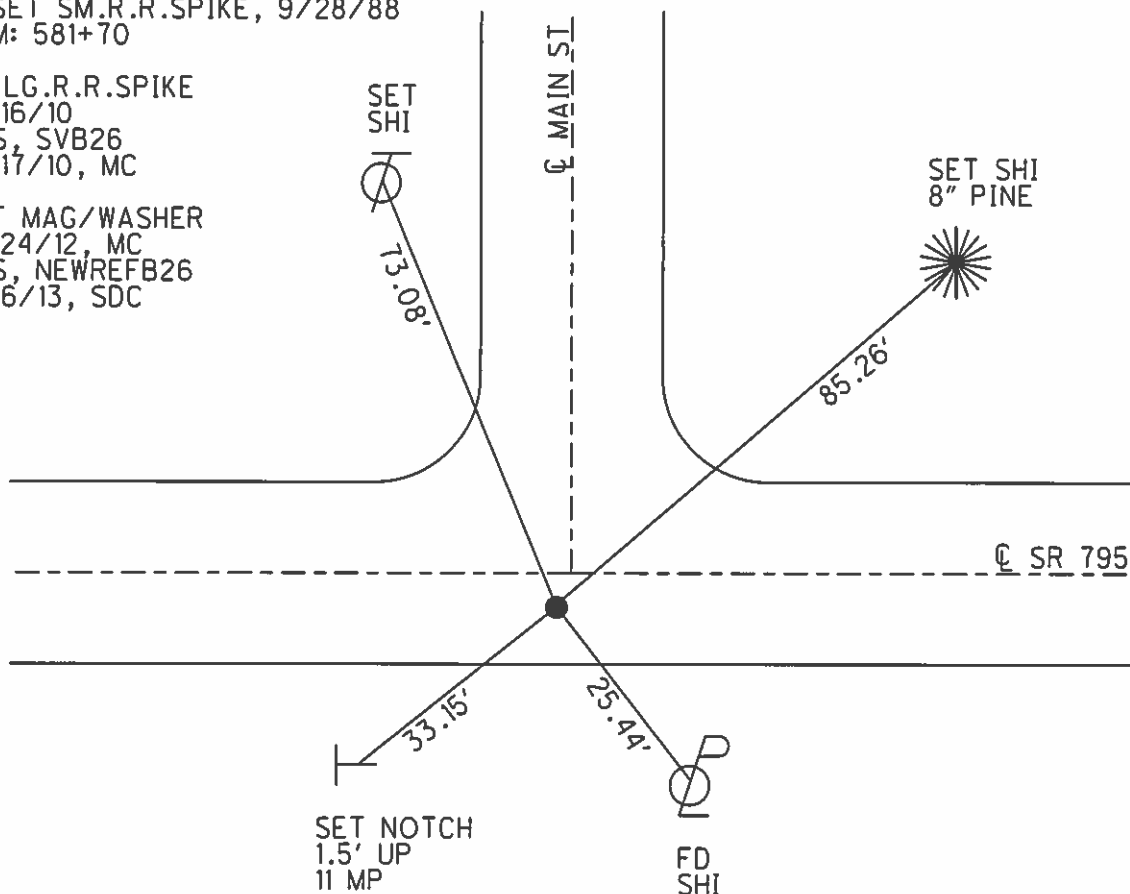

O.D.O.T. DISTRICT 2 SURVEY OFFICE

PERSONNEL

REFERENCE NO. 26-B

SHEET OF

NOTES LOEHRKE

H.C. Reed

R.C. BARNHISEL

DATE 7-14-88

WEATHER Calm Breezy

TEMP. +90

ROUTE S.R. 795

COUNTY WOOD

TOWNSHIP LAKE

SECTION 24

T 7 N R 12 E

TYPE MONUMENT Lg RR Spike

ON SURFACE - BELOW 4" Below


LEFT - & PAV'T. - RIGHT 2.3

6.7 TO RT EDGE PAVEMENT


S.L.M. 581+70

Reset SMALL RR
Spike 9-28-88
L.L.


1.0 W & MAIN ST.

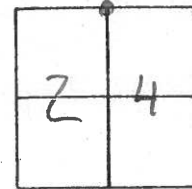

MILLBURY

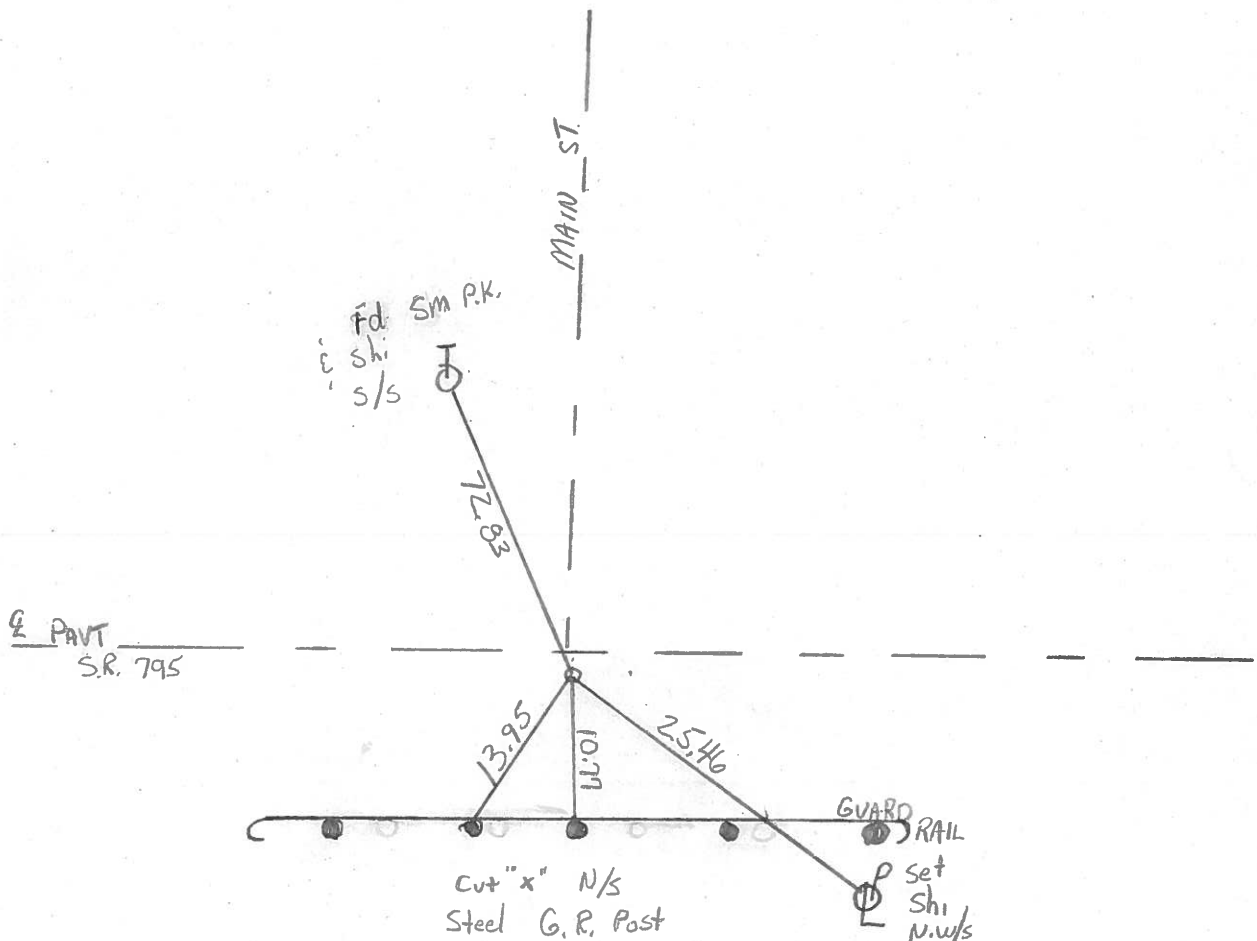

PERSONNEL	TITLE	PERSONNEL	TITLE	COUNTY	DATE	WEATHER	TEMP.
Stone	Notes			Wood	13 Sept. 71		
Michalak	H.C.			S. R.	795		
Farr	R.C.			SEC.	Millbury		68°
DESCRIPTION				References to Control Points		JOB NO.	
LEFT		CENTER LINE		RIGHT			

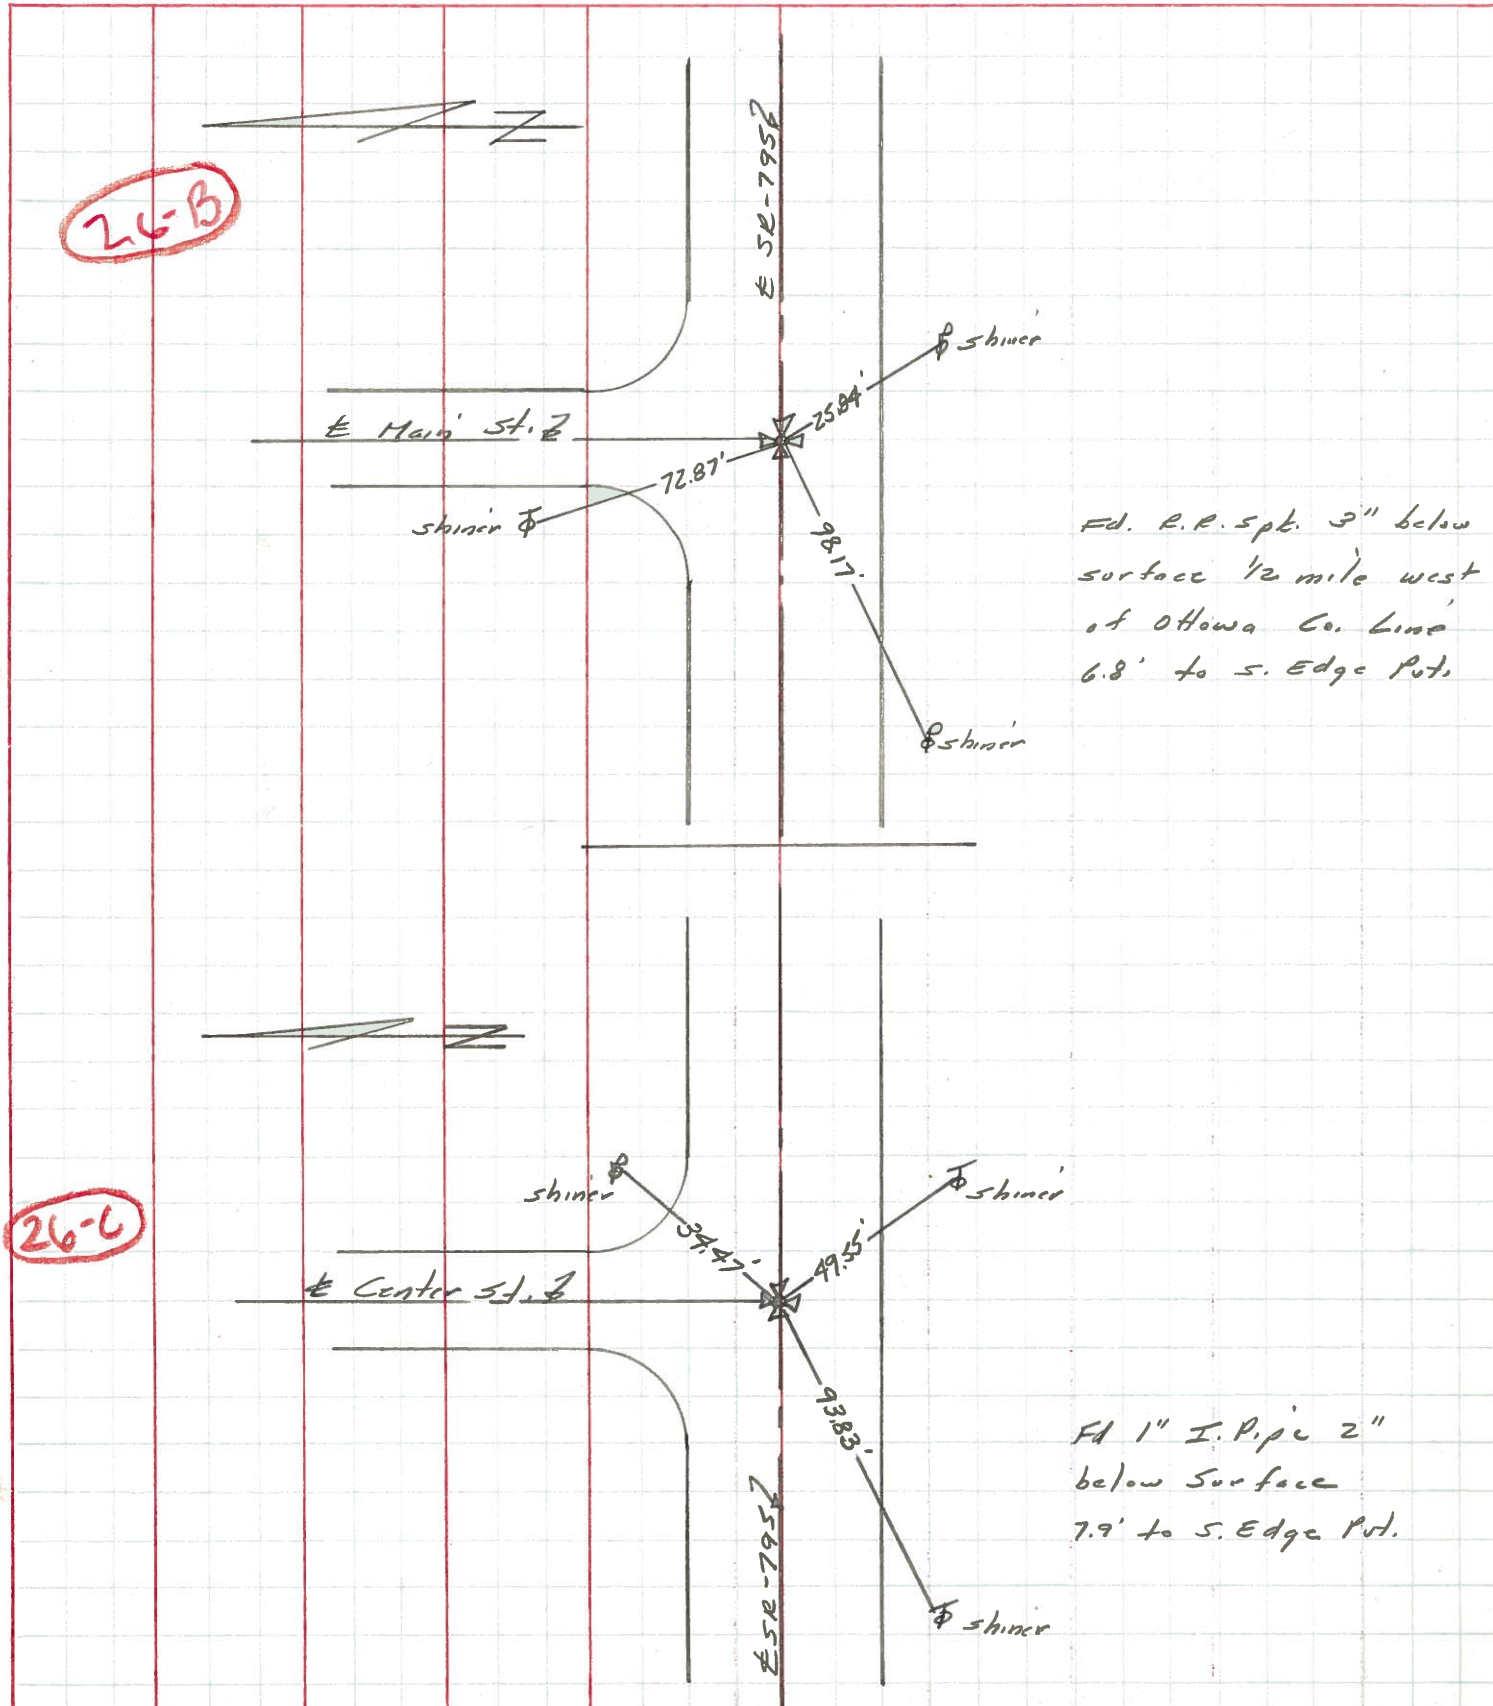

PERSONNEL TITLE PERSONNEL TITLE

Stone

Notes

Michalak

H.C.

Farr

R.C.

COUNTY Wood

DATE 13 Sept. 71

S. R. 795

WEATHER Cool

SEC. Millbury

TEMP. 68°

DESCRIPTION

Reference to Control Points

JOB NO.

LEFT

CENTER LINE

RIGHT

26-B

6.7
2.3

81+70

E Main St. 2

shiner

72.81
83

E SR-795

46

25.94

10.77

13.95

98.11

shiner

shiner

Fd. R.R. Spt. 3" below surface 1/2 mile west of Ottawa Co. Line 6.8' to S. Edge Pnt.

87A

73 22

E Center St. 2

shiner

32" G.W. Spt.

45.21

39.70

37.49

35

48.74

49.45

43.83

shiner

+ cut
Near Face

+42

Fd 1" I. Pipe 2" below surface 7.9' to S. Edge Pnt.

E SR-795

shiner