

# O.D.O.T. DISTRICT 2 SURVEY OFFICE (USE ONLY)

PERSONNEL

REFERENCE NO. 27

SHEET 10 OF 11

NOTES HUSS

DATE 4/19/12

ROUTE SR 795

H.C. CANTERBURY

WEATHER CLEAR

COUNTY WOOD

R.C. HUSS

TEMP. 62°

TOWNSHIP LAKE

SECTION 24

T 7 N R 12 E

TYPE MONUMENT SM.R.R.SPIKE



ON SURFACE - ~~BELOW~~ ON

~~LEFT~~ - C PAV'T - RIGHT 2.1'

14.5' TO E. EDGE PAVEMENT

S.L.M. 603+50.35

Grid: Northing: 690543.948 Easting: 1718029.302

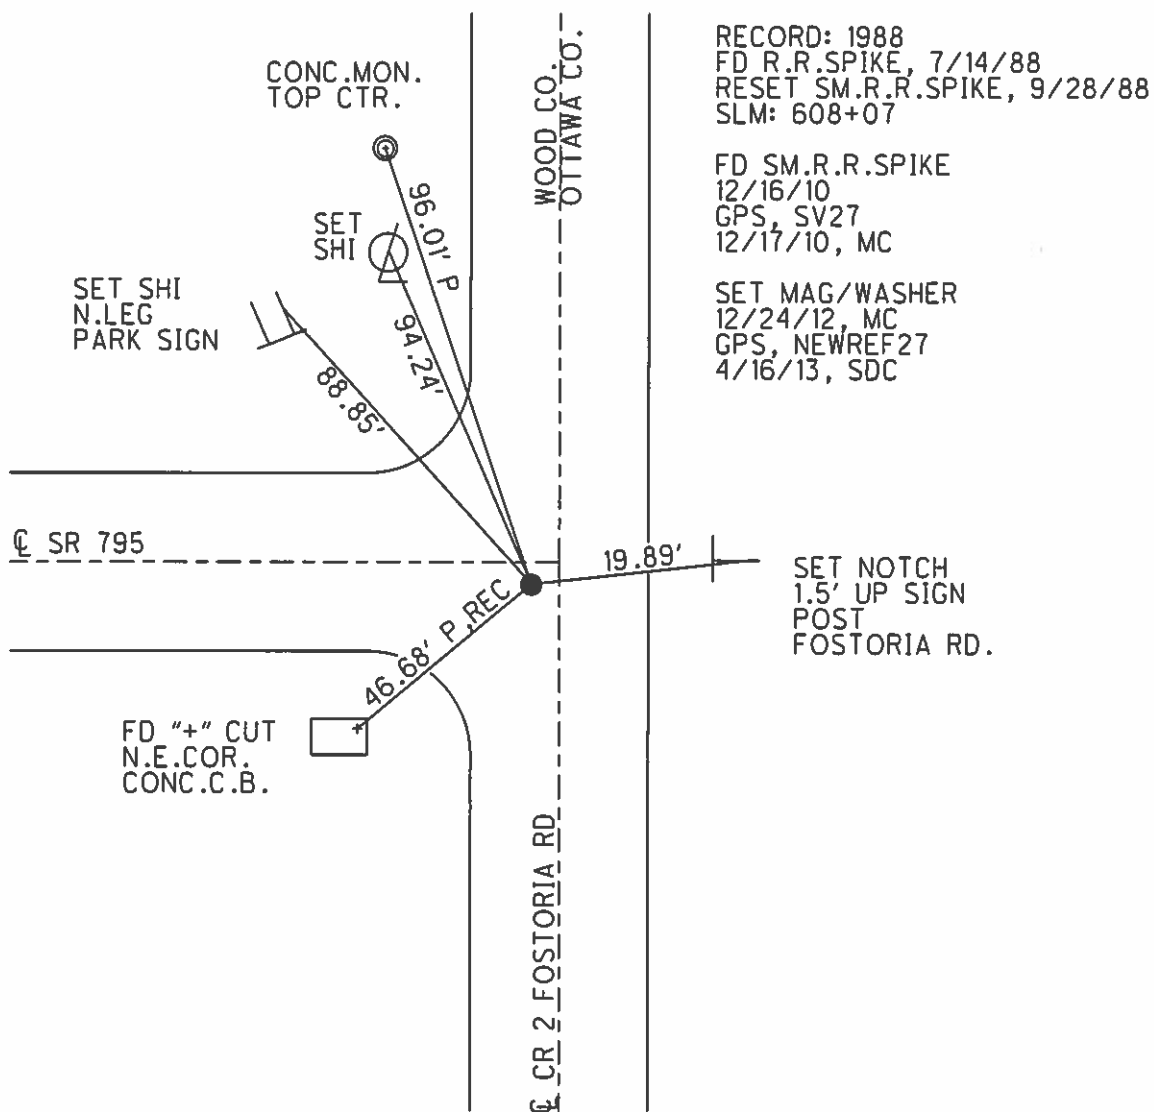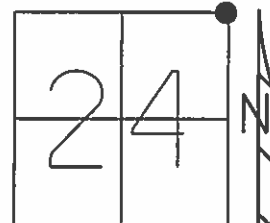

# O.D.O.T. DISTRICT 2 SURVEY OFFICE

PERSONNEL

REFERENCE NO. 27

SHEET      OF     

NOTES LOEHRKE

H.C. Reed

R.C. Borahisel

DATE 7-14-88

WEATHER Clear-Hazy

TEMP. +90

ROUTE SR 795

COUNTY WOOD

TOWNSHIP LAKE

SECTION 24

T 2 N R 12 E

TYPE MONUMENT RR SPIKE


ON SURFACE - BELOW 5 1/2" BELOW

LEFT - & PAW'T. - RIGHT 2.1 R+ & 795 3.1 W & Fostoria


TO EAST EDGE PAVEMENT

S.L.M. 608+07

Reset Small  
R.R. Spike

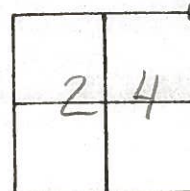


MILL BURY

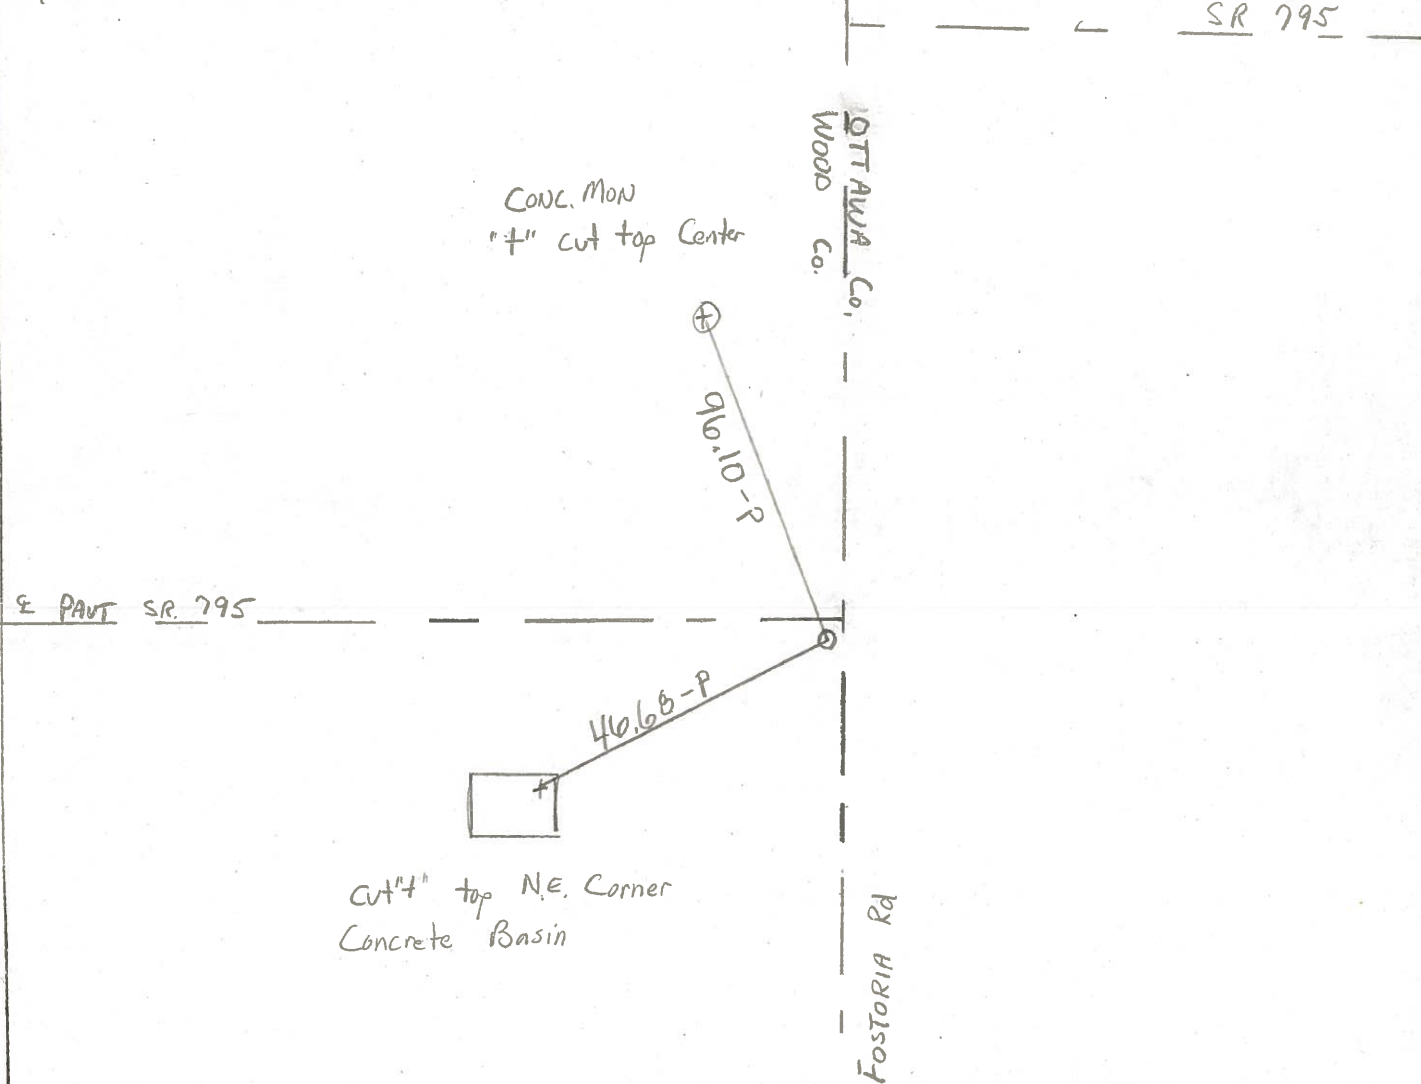

| PERSONNEL | TITLE | PERSONNEL | TITLE | COUNTY        | DATE        | WEATHER | TEMP. |
|-----------|-------|-----------|-------|---------------|-------------|---------|-------|
| Stone     | Notes |           |       | Wood          | 13 Sept. 71 | Fair    | 70°   |
| Michalak  | H.C.  |           |       | S. R. 795     |             |         |       |
| Farr      | R.C.  |           |       | SEC. Millbury |             |         |       |

DESCRIPTION References to Control Points JOB NO. \_\_\_\_\_

LEFT CENTER LINE RIGHT

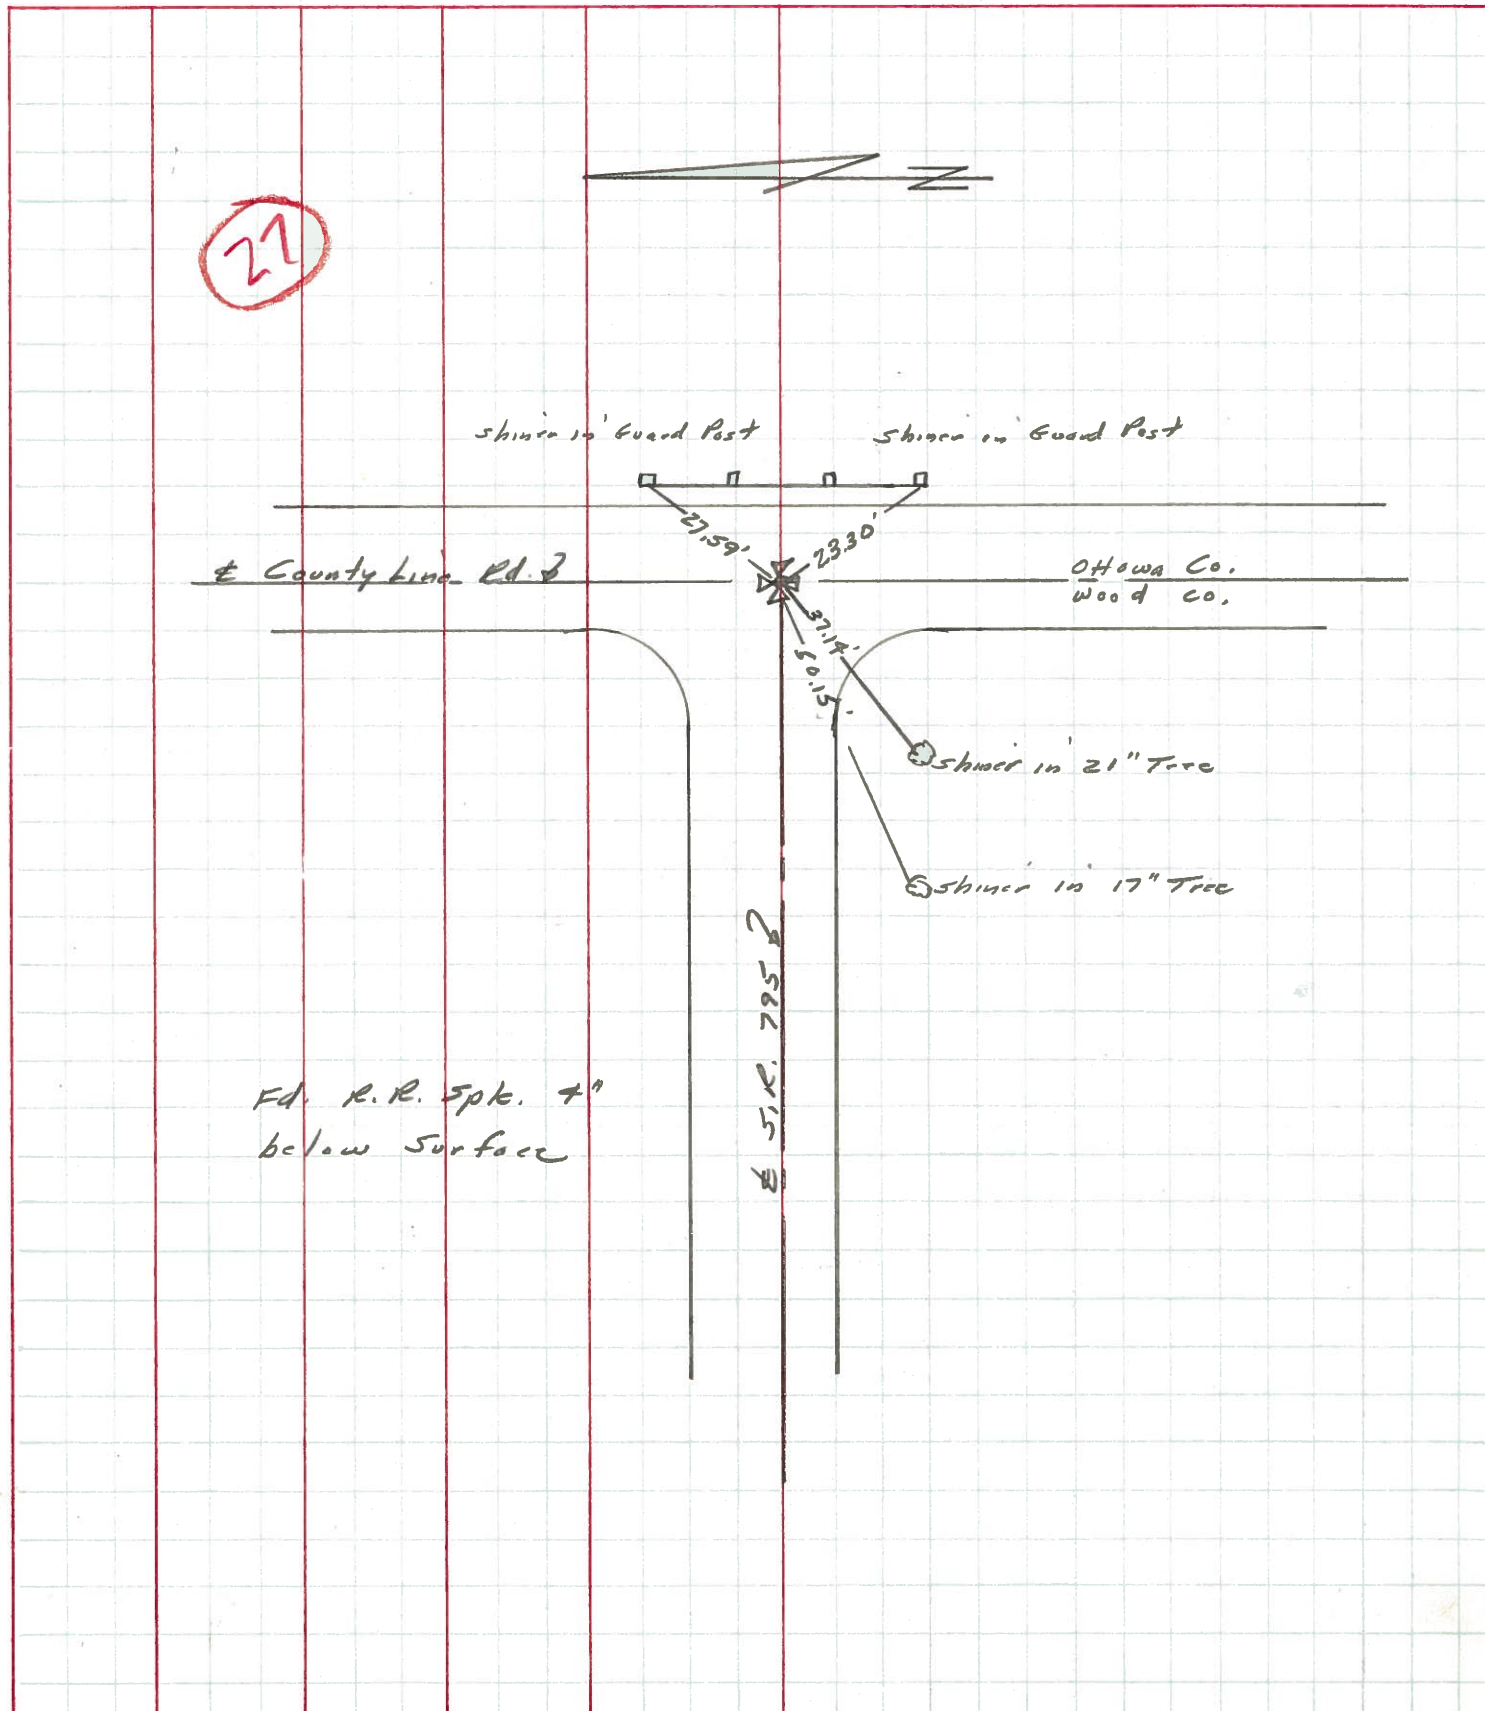

| PERSONNEL | TITLE | PERSONNEL | TITLE | COUNTY        | DATE         |
|-----------|-------|-----------|-------|---------------|--------------|
| Stone     | Notes |           |       | Wood          | 13 Sept. 71  |
| Michalak  | H.C.  |           |       | S. R. 795     | WEATHER Fair |
| Fane      | R.C.  |           |       | SEC. Millbury | TEMP. 70°    |

DESCRIPTION References to Control Points JOB NO. \_\_\_\_\_

LEFT CENTER LINE RIGHT

