

O.D.O.T. DISTRICT 2 SURVEY OFFICE (USE ONLY)

PERSONNEL

REFERENCE NO. C

SHEET 3 OF 17

NOTES BURNSIDE

DATE 11/3/70

ROUTE OLD US 6

H.C. SMITH

WEATHER

COUNTY WOOD

R.C. BOWERS

TEMP.

TOWNSHIP PLAIN

HOLCOMBE

SECTION 26

DWG BY RHOADES PID

T 5 N R 10 E

TYPE MONUMENT P.K.NAIL

ON SURFACE - ~~BELOW~~ ON


OFFSET Q PAVEMENT ON LT : RT

- TO - EDGE PAVEMENT


STATION: 533+06.11

HORIZ.DATUM: GEOID:

GRID: NORTHING: EASTING:

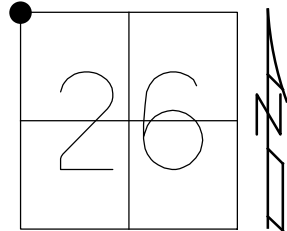

RECORD:
 $\Delta = 0^\circ 16' \text{ RT}$
STA. 533+12.9
SET R.R.SPIKE
1960
FD BRASS MON.
2/21/68
 $\Delta = 0^\circ 15' \text{ RT}$
11/3/70
SET P.K.NAIL
11/3/70, SH

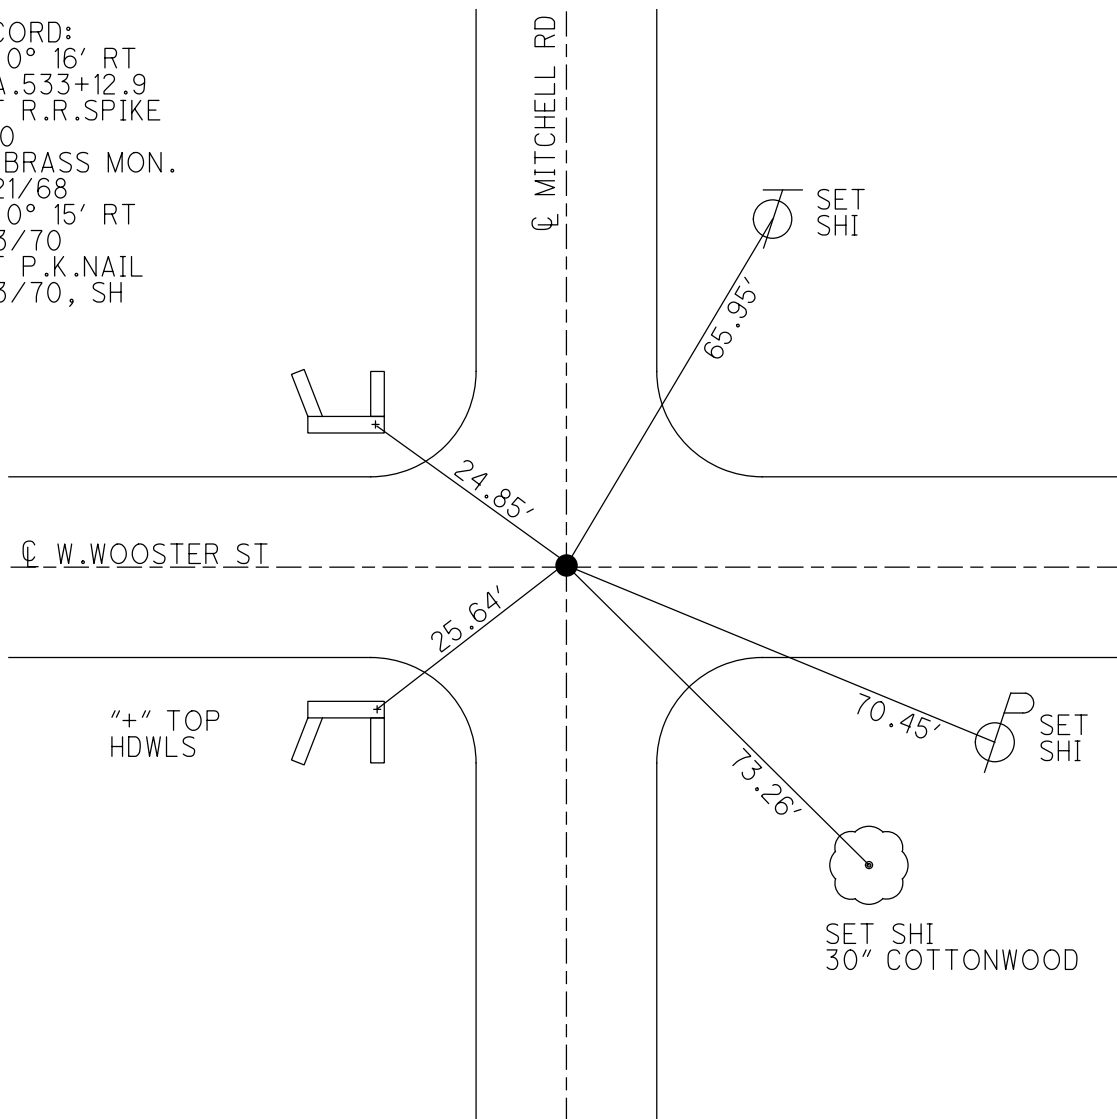

DESCRIPTION	CENTER LINE	RIGHT	JOB NO.
CONTROL TIES			

POINT GONE
TIES No Good
2-21-68