

O.D.O.T. DISTRICT 2 SURVEY OFFICE (USE ONLY)

PERSONNEL

REFERENCE NO. E

SHEET 5 OF 17

NOTES BURNSIDE

DATE 11/3/70

ROUTE OLD US 6

H.C. SMITH

WEATHER

COUNTY WOOD

R.C. HOLCOMBE

TEMP.

TOWNSHIP PLAIN

BOWERS

SECTION 26

DWG BY RHOADES PID

T 5 N R 10 E

TYPE MONUMENT P.K.NAIL

ON SURFACE - ~~BELOW~~ ON


OFFSET CL PAVEMENT ON LT : RT

- TO - EDGE PAVEMENT

STATION: 569+73.93

HORZ.DATUM: GEOID:

GRID: NORTHING: EASTING:

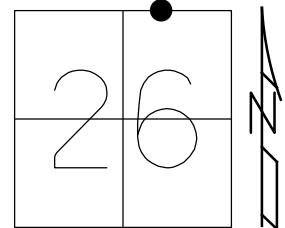

SET SHI
30" BOXELDER




91.35'

SET
SHI



40.80'

CL W.WOOSTER ST

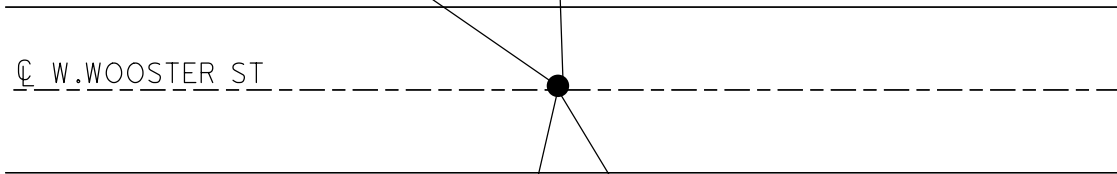

18.33'



SET
SHI

23.57'



SET
SHI

PERSONNEL	TITLE	PERSONNEL	TITLE
BURNSIDE			
SMITH			
HOLCOMBE			
BOWERS			

COUNTY WOOD DATE 11-3-70
 OLD U.S. #6
 S. R. NEW BOWLING GREEN R. WEATHER _____
 SEC. _____ TEMP. _____

DESCRIPTION CONTROL TIES JOB NO. _____


LEFT

CENTER LINE

RIGHT

E

STA. 569+73.93
 966.75' E. OF N¹/₄
 Post SEC. 26
 PLAIN TWP.
 T-5-N R-10-E
 MON SET
 SET P.K.

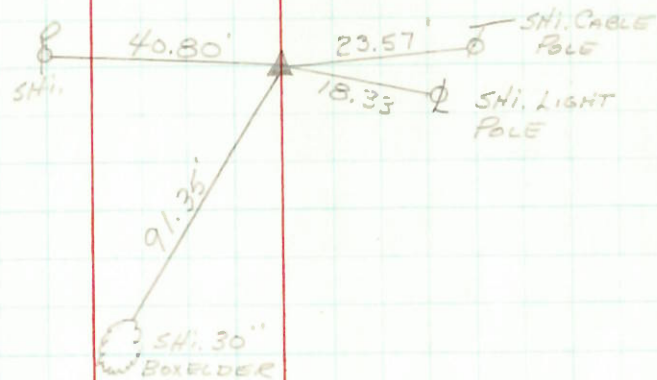

D

STA. 560+06.78
 N¹/₄ Post SEC. 26
 PLAIN TWP.
 T-5-N R-10-E
 $\Delta = 1^{\circ} 51' \text{ LT. FWD.}$
 BRASS MON
 SET. P.K.

