

O.D.O.T. DISTRICT 2 SURVEY OFFICE (USE ONLY)

PERSONNEL

REFERENCE NO. G

SHEET 7 OF 17

NOTES BURNSIDE

DATE 11/3/70

ROUTE OLD US 6

H.C. SMITH

WEATHER

COUNTY WOOD

R.C. HOFFMAN

TEMP.

TOWNSHIP PLAIN

DWG BY RHOADES PID

SECTION 23

T 5 N R 10 E

TYPE MONUMENT P.K.NAIL

ON SURFACE - ~~BELOW~~ ON

OFFSET Q PAVEMENT ON LT : RT

- TO - EDGE PAVEMENT


STATION: 581+03

HORZ.DATUM:


GEOID:

GRID: NORTHING:

EASTING:

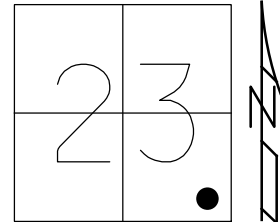

RECORD:
 $\Delta = 12^\circ 15' \text{ LT}$
STA. 581+03
FD P.K.NAIL
2/23/68
SET P.K.NAIL
11/3/70, SH

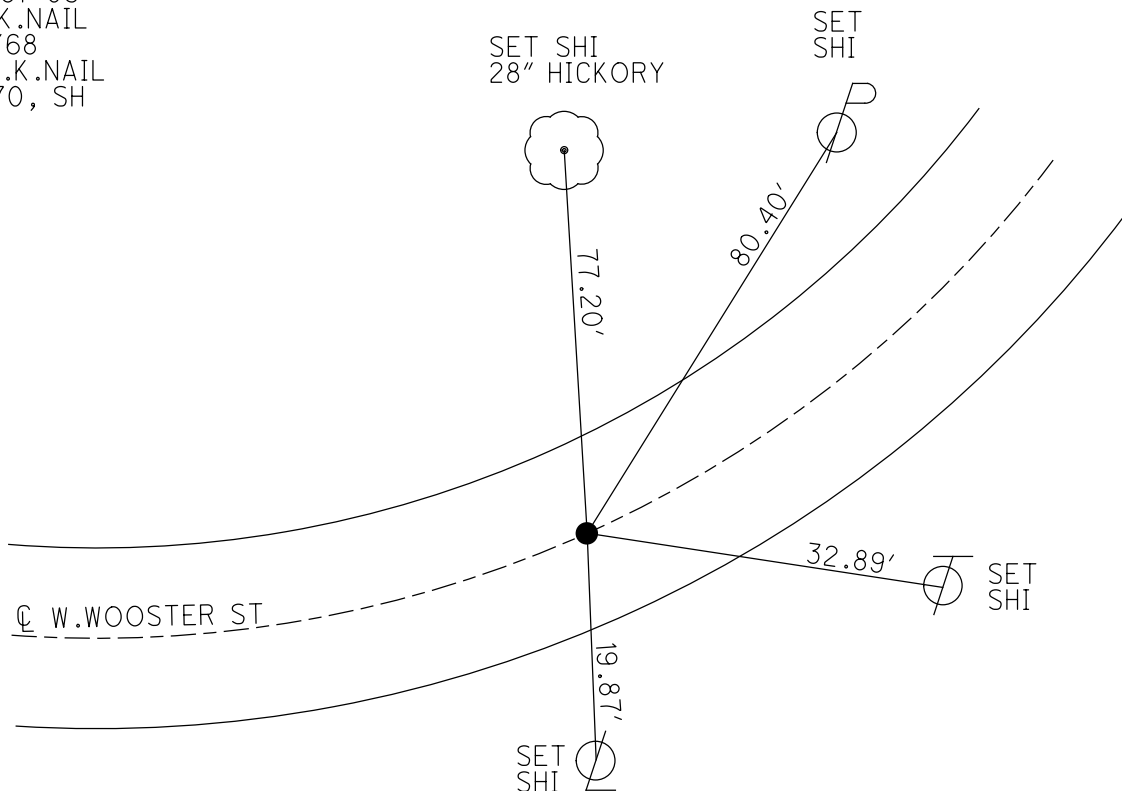

PERSONNEL TITLE PERSONNEL TITLE

COUNTY WoodDATE 11-3-70BURNSIDESMITHHOFFMANS. R. BOWLING GREEN RD. WEATHER

SEC.

TEMP.

DESCRIPTION CON-ROL TIES

JOB NO.

LEFT

CENTER LINE


RIGHT

G

STA. 581+03

P.I. Δ = 12° 15' LT

SET. P.K.

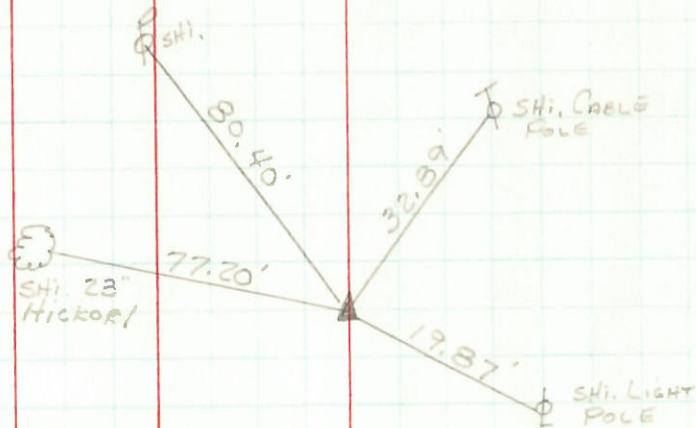

F

STA. 573+97.07

BOWLING GREEN RD.
WINTERGARDEN RD.
CONC. MONUMENT