

O.D.O.T. DISTRICT 2 SURVEY OFFICE (USE ONLY)

PERSONNEL

REFERENCE NO. H

SHEET 8 OF 17

NOTES BURNSIDE

DATE 11/3/70

ROUTE OLD US 6

H.C. SMITH

WEATHER

COUNTY WOOD

R.C. HOFFMAN

TEMP.

TOWNSHIP BOWLING GREEN

SECTION 23

DWG BY RHOADES

PID

T 5 N R 10 E

TYPE MONUMENT P.K.NAIL

ON SURFACE - ~~BELOW~~ ON

OFFSET Q PAVEMENT ON LT : RT

- TO - EDGE PAVEMENT


STATION: 587+49.58

HORZ.DATUM:

GEOID:

GRID: NORTHING:

EASTING:

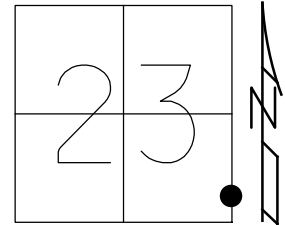

RECORD:
BOWLING GREEN
CORP. LINE
STA. 587+49.58
FD P.K.NAIL
2/23/68
11/3/70, SH

SET SHI
24" TREE
OF HEAVEN

SET SHI
15" BOXELDER

SET SHI
12" ELM

SET
SHI

60.57'

65.25'

45.22'

82.48'

Q W. WOOSTER ST.

24.10'

STEEL COR.
POST

46.16'

SET
SHI

PERSONNEL TITLE PERSONNEL TITLE

R.P. SIDE

COUNTY Wood DATE 11-3-70SMITHS. R. BOWLING GREEN RD. WEATHERHOFFMAN

SEC. TEMP.

DESCRIPTION CONTROL TIES JOB NO.


LEFT

CENTER LINE

RIGHT



STA. 587+85.04
P.I. A = 11°26' LT.
P.K. NAIL

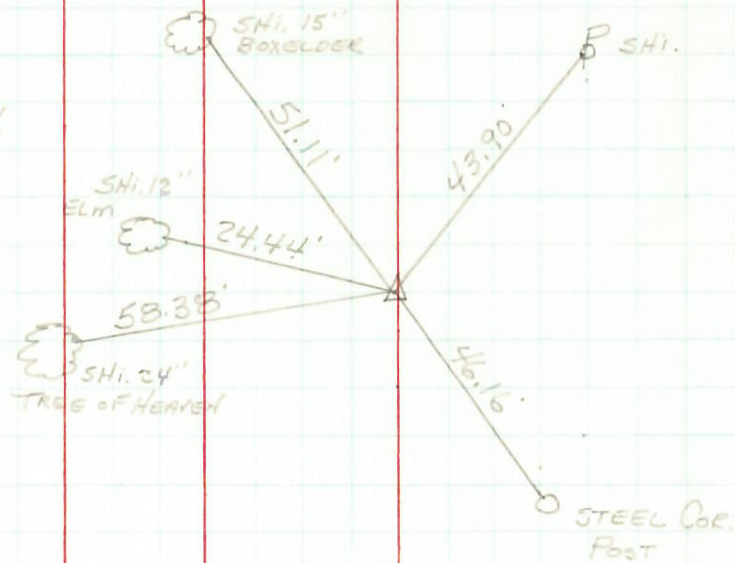

H

STA. 587+49.58
BOWLING GREEN
CORP.
P.K. NAIL

