

O.D.O.T. DISTRICT 2 SURVEY OFFICE (USE ONLY)

PERSONNEL

REFERENCE NO. 1

SHEET 9 OF 17

NOTES BURNSIDE

DATE 11/3/70

ROUTE OLD US 6

H.C. SMITH

WEATHER

COUNTY WOOD

R.C. HOFFMAN

TEMP.

TOWNSHIP BOWLING GREEN

SECTION 24

DWG BY RHOADES PID

T 5 N R 10 E

TYPE MONUMENT P.K.NAIL

ON SURFACE - ~~BELOW~~ ON


OFFSET Q PAVEMENT ON LT : RT

- TO - EDGE PAVEMENT

STATION: 587+85.04

HORIZ.DATUM: GEOID:

GRID: NORTHING: EASTING:

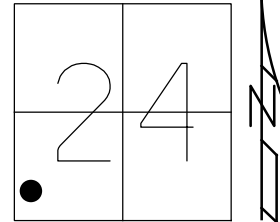


RECORD:
 $\Delta = 11^\circ 26'$ LT
STA. 587+85.04
FD P.K.NAIL
2/23/68
11/3/70, SH

SET SHI
24" TREE
OF HEAVEN

SET SHI
15" BOXELDER

SET SHI
12" ELM

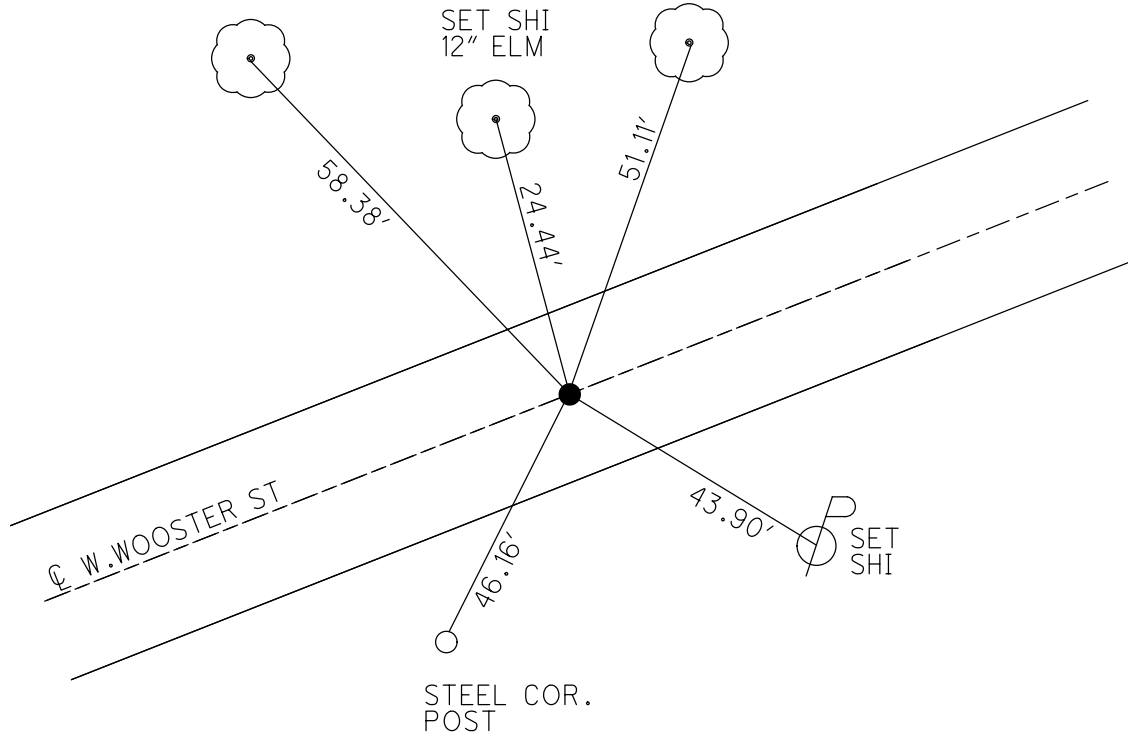

PERSONNEL TITLE PERSONNEL TITLE

R.P. SIDE

COUNTY Wood DATE 11-3-70SMITHS. R. BOWLING GREEN RD. WEATHERHOFFMAN

SEC. TEMP.

DESCRIPTION CONTROL TIES JOB NO.


LEFT

CENTER LINE

RIGHT



STA. 587+85.04
P.I. A = 11°26' LT.
P.K. NAIL

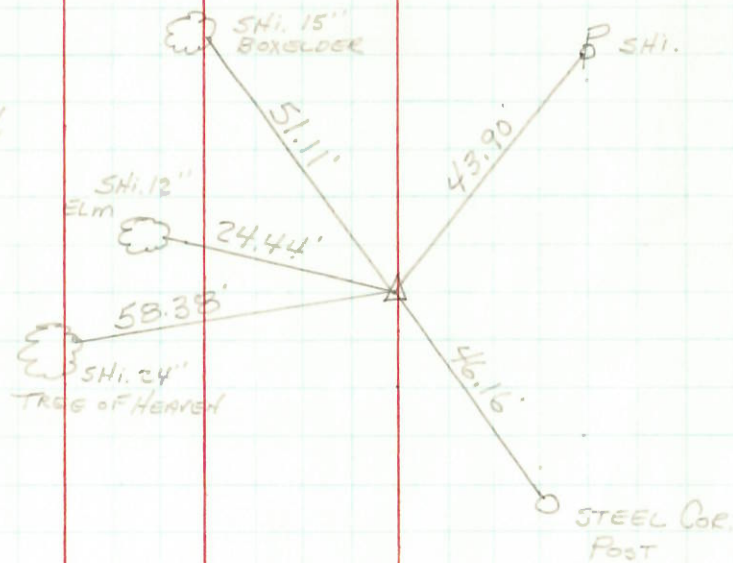

H

STA. 587+49.58
BOWLING GREEN
CORP.
P.K. NAIL

