

O.D.O.T. DISTRICT 2 SURVEY OFFICE (USE ONLY)

PERSONNEL

REFERENCE NO. J

SHEET 10 OF 17

NOTES BURNSIDE

DATE 5/14/70

ROUTE OLD US 6

H.C. SMITH

WEATHER

COUNTY WOOD

R.C. HOFFMAN

TEMP.

TOWNSHIP BOWLING GREEN

SECTION 24

DWG BY RHOADES

PID

T 5 N R 10 E

TYPE MONUMENT P.K.NAIL

ON SURFACE - ~~BELOW~~ ON

OFFSET Q PAVEMENT ON LT : RT

- TO - EDGE PAVEMENT


STATION: 592+89.12

HORIZ.DATUM:


GEOID:

GRID: NORTHING:

EASTING:

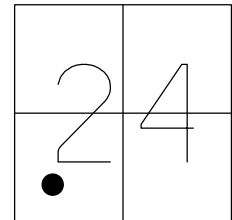

RECORD:
STA. 592+89.12
FD R.R.SPIKE
2/23/68
FD P.K.NAIL
5/14/70, SH

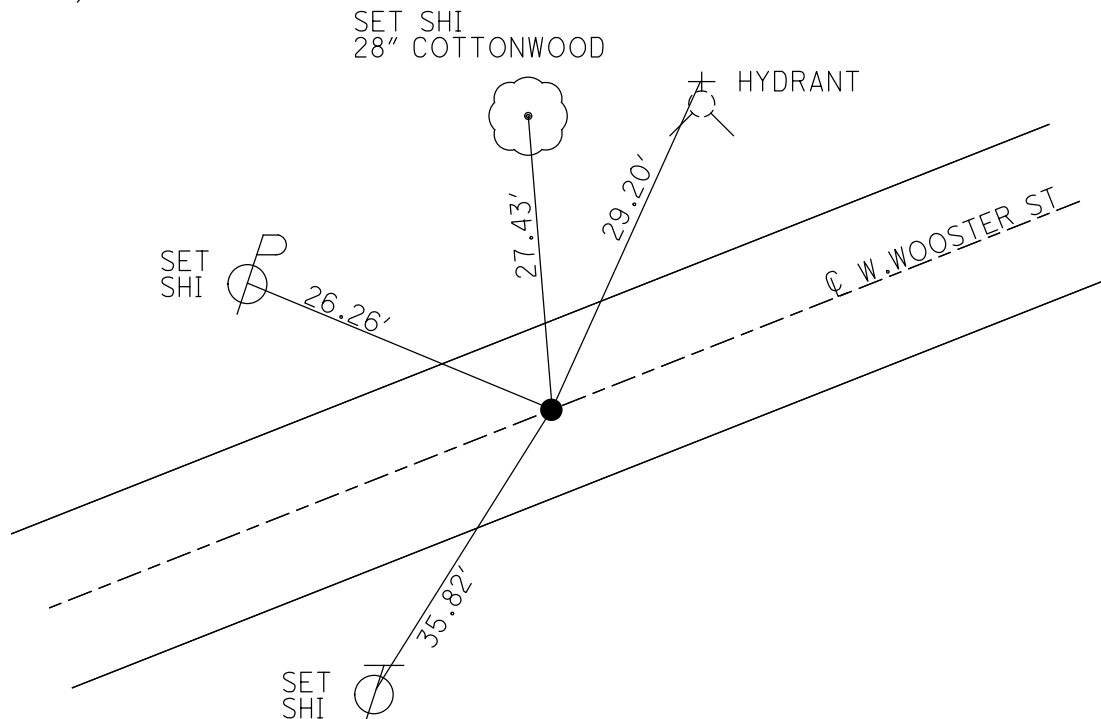

PERSONNEL TITLE PERSONNEL TITLE

BURNSIDECOUNTY WOODDATE 5-14-70SMITHS. R. OLD U.S. 6WEATHER CLOUDYHOFFMANSEC. BOWLING GREENTEMP. +62°

DESCRIPTION

CONTROL TIES

LEFT

CENTER LINE

RIGHT

JOB NO.

STA. 601+48
FD. P.K.
#789

(DID NOT FIND)
#788

STA. 595+78.60
P.I. $\Delta = 59.57'$ RT.
#787

FD. 1" IRON ROD ON $\frac{1}{2}$ PAVE.
(1" BELOW SURFACE)

FD. P.K. ON WEST $\frac{1}{2}$
VOLNEY L. WRIGHT PROPERTY
STA. 592+89.12
#786

