

O.D.O.T. DISTRICT 2 SURVEY OFFICE (USE ONLY)

PERSONNEL

REFERENCE NO. L

SHEET 12 OF 17

NOTES BURNSIDE

DATE 5/14/70

ROUTE OLD US 6

H.C. SMITH

WEATHER

COUNTY WOOD

R.C. HOFFMAN

TEMP.

TOWNSHIP BOWLING GREEN

SECTION 24

DWG BY RHOADES PID

T 5 N R 10 E

TYPE MONUMENT P.K.NAIL

ON SURFACE - ~~BELOW~~ ON


OFFSET C PAVEMENT ON LT : RT

 - TO - EDGE PAVEMENT


STATION: 601+48

HORIZ.DATUM: GEOID:

GRID: NORTHING: EASTING:

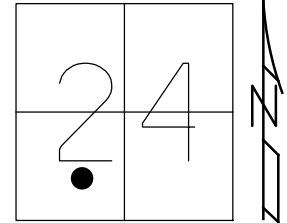

RECORD:
STA. 601+48
FD P.K.NAIL
5/14/70, SH

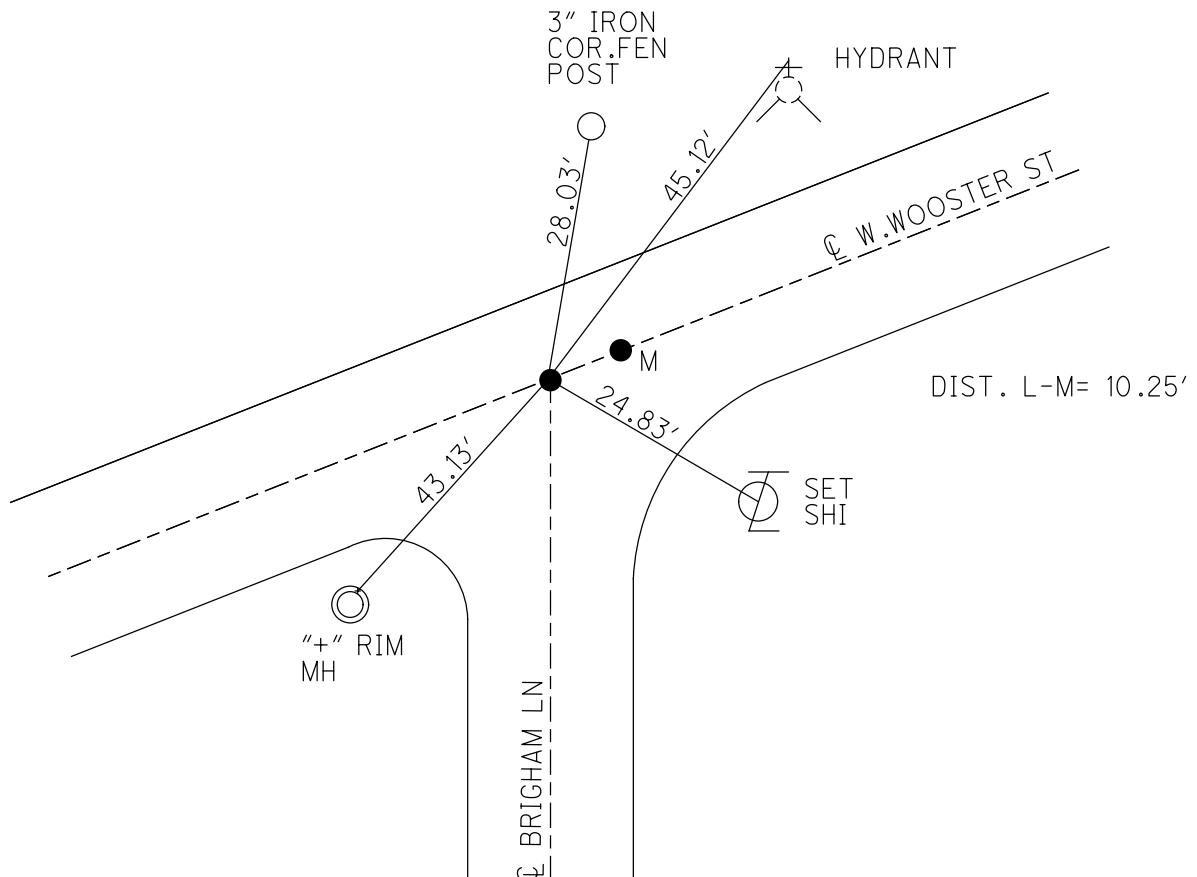

PERSONNEL TITLE PERSONNEL TITLE

BURNSIDECOUNTY WoodDATE 5-14-70SMITHS. R. OLD U.S. 6WEATHER CLOUDYHOFFMANSEC. BOWLING GREENTEMP. +62°

DESCRIPTION

CONTROL TIES

LEFT

CENTER LINE

RIGHT

JOB NO.

STA. 601+48
F.D. P.K.
#789

(DID NOT FIND)
#788

STA. 595+78.60
P.I. Δ = 59° 57' RT.
#787

F.D. 1" IRON ROD ON E PAVE.
(1" BELOW SURFACE)

F.D. P.K. ON WEST FB
VOLNEY L. WRIGHT PROPERTY
STA. 592+89.12
#786

