

O.D.O.T. DISTRICT 2 SURVEY OFFICE (USE ONLY)

PERSONNEL

REFERENCE NO. Q

SHEET 17 OF 17

NOTES BURNSIDE

DATE 6/22/70

ROUTE OLD US 6

H.C. BURNSIDE

WEATHER

COUNTY WOOD

R.C. HOFFMAN

TEMP.

TOWNSHIP BOWLING GREEN

SECTION 24

DWG BY RHOADES

PID

T 5 N R 10 E

TYPE MONUMENT P.K.NAIL

ON SURFACE - ~~BELOW~~ ON

OFFSET Q PAVEMENT ON LT : RT

- TO - EDGE PAVEMENT


STATION: 611+30.40

HORZ.DATUM:


GEOID:

GRID: NORTHING:

EASTING:

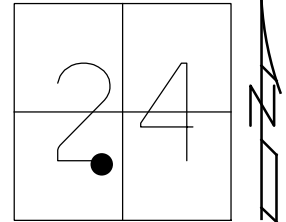

RECORD:
STA. 611+30.40
MON SET
FD P.K.NAIL
6/22/70, SH

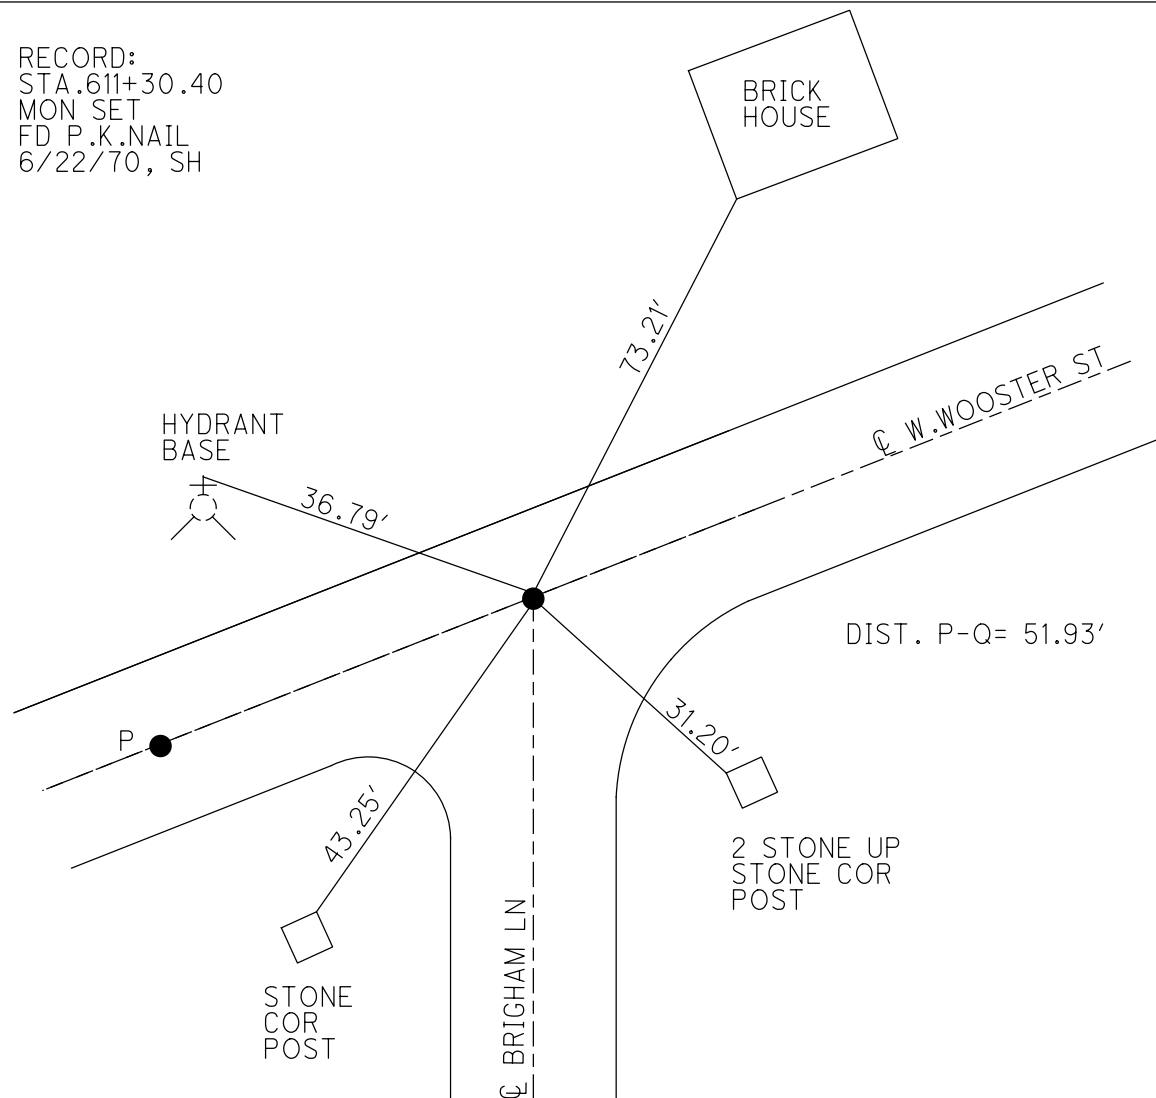

PERSONNEL

TITLE

PERSONNEL

TITLE

BURNSIDE

COUNTY

WOOD

DATE 06-22-70

HOFFMAN

S. R.

OLD U.S. #6

WEATHER

CLEAR

SEC.

POWELL GREEN

TEMP.

+73°

DESCRIPTION

CONTROL POINTS

LEFT

CENTER LINE

RIGHT

JOB NO.

STA 611+30.4
MON. SET. - FD. P.K.

#794

BRICK
HOUSE

73.21'

31.20'

N.W. COR. OF S.E.
STONE COR. POST
(2-STONE UP)

WINFIELD DRIVE

BASE HD.
A

36.79'

43.25'

STONE COR.
FENCE POST
S.W.

STA. 610+73.47
MON. SET. - FD. P.K.

#793

S.E. COR.
FENCE FDN.
(No. #838)

BASE HD.
A

28.68'

31.95'

31.50'

STONE COR POST

50.49'

33.38'

SHI. 38" MAPLE