



PERSONNEL	TITLE	PERSONNEL	TITLE
Red Beach			
W. Knope			

COUNTY Fulton DATE 5 Sept 74

S. R. Gorham Twp. Rds "S" & "27" WEATHER _____

SEC. 13/24 T-9-S R-1-W TEMP. _____

DESCRIPTION CONTROL POINTS JOB NO. _____

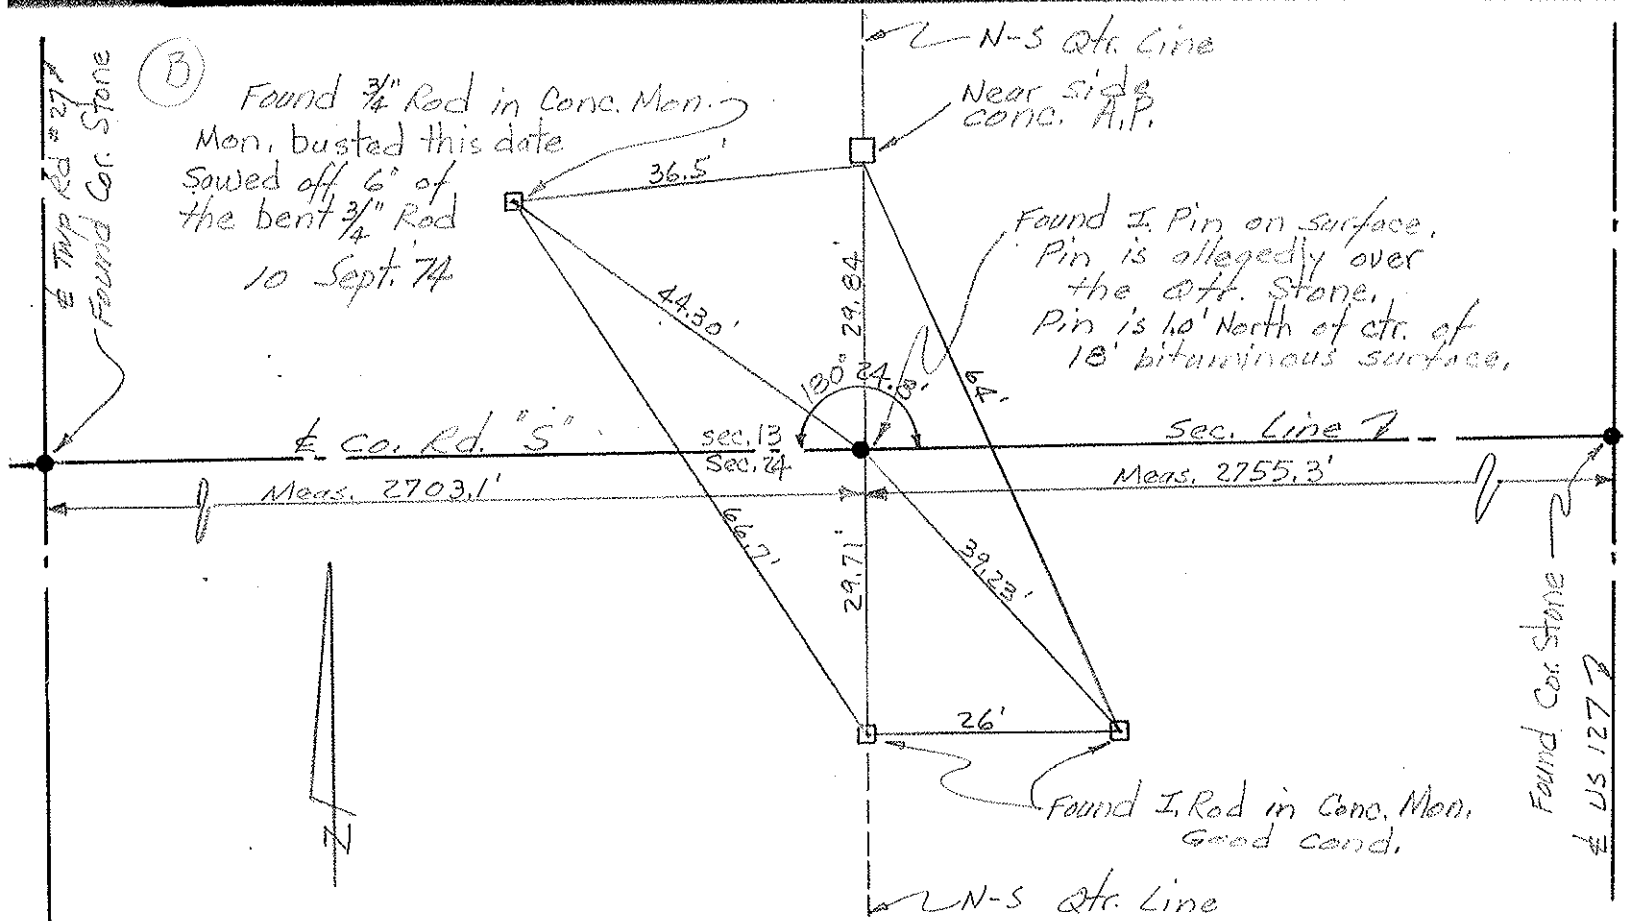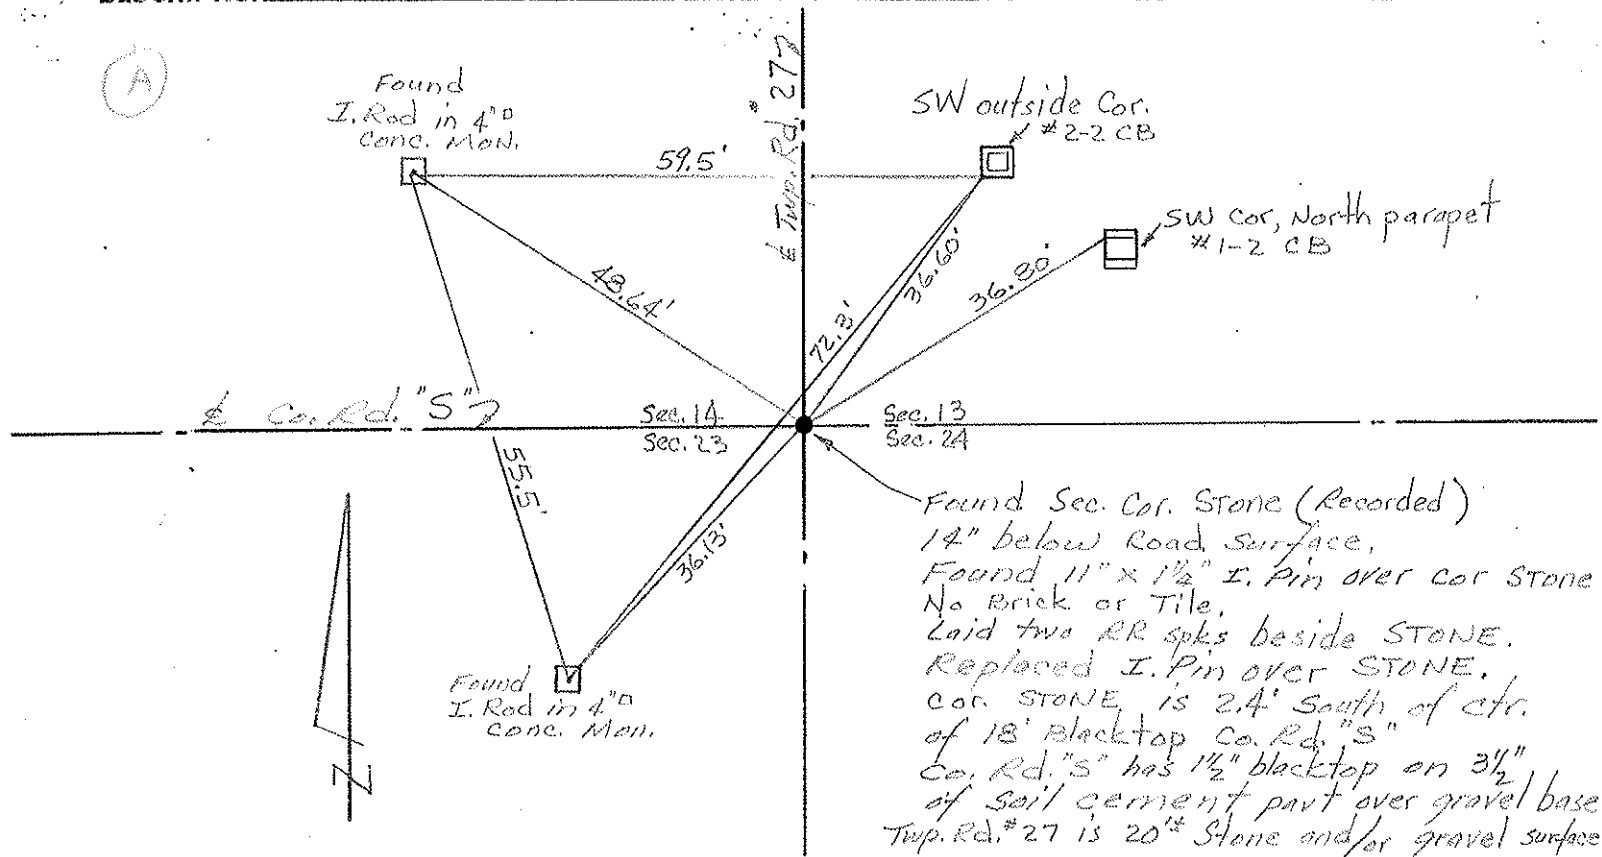

PERSONNEL TITLE PERSONNEL TITLE

Red Beach

W. Krape

COUNTY FultonDATE 6 Sept 74S. R. Gorham Twp Rd. #27 WEATHER _____SEC. 23/24 T-9-S R-1-W TEMP _____


DESCRIPTION

CONTROL POINTS

JOB NO. _____

Co. Rd. "S" ASec. 14
Sec. 23Sec. 13
Sec. 24Stone Sec. Cor. N

(C)

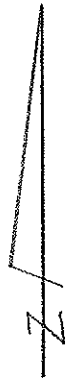Est. 30"x 3/4" Rod
below sd3'x 8" RCP
"+" top ctr. each endE-W ctr. Line, Sec. 23

Found recorded Qtr. STONE w/brick
Qtr. STONE is 14 1/2" below gravel
road surface.
Found beat-up 30"x 3/4" pipe 2" below
road surface and 0.8' east of
the Qtr. STONE. Did not replace
the beat-up 3/4" pipe.
Est. 12" x 1" pipe over the
Qtr. STONE.
Qtr. STONE is in ctr. of
20' ± gravel road

30.00'

2630.2'

10.97'

44.96'

64.53'

26.84'

22.6'

27.46'

Sec. 23
Sec. 24

2642.7'

24.63'

E-W ctr. Line, Sec. 24

Est. Shiner NW Cor. Corpost
Cor. post leans 8° to south
but is solid

Found recorded RR R/W Stone
with glazed tile. Found recorded
RR spk under ctr of Stone.
placed the 5 1/2" RR spk in a 7"x1" pipe
and replaced the 1 1/2 qt. sized stone
over ctr of RR spk.
The RR spk is 21" below surface
The STONE is 16" below surface
placed a 14"x1" pipe over the
Stone marker and the RR spk
and the glazed tile.


T&W RR 65' R/W

Sec. Cor., I pin in base conc. part.

U/S 207Sec. 23
Sec. 26Sec. 24
Sec. 25

PERSONNEL	TITLE	PERSONNEL	TITLE	COUNTY	DATE	WEATHER	TEMP.
Red Beach				FULTON	SEPT. 1974		
W. Krape				S. R. Gorham Twp			
				SEC. 24 T-9-S R-1-W			

DESCRIPTION _____ JOB NO. _____

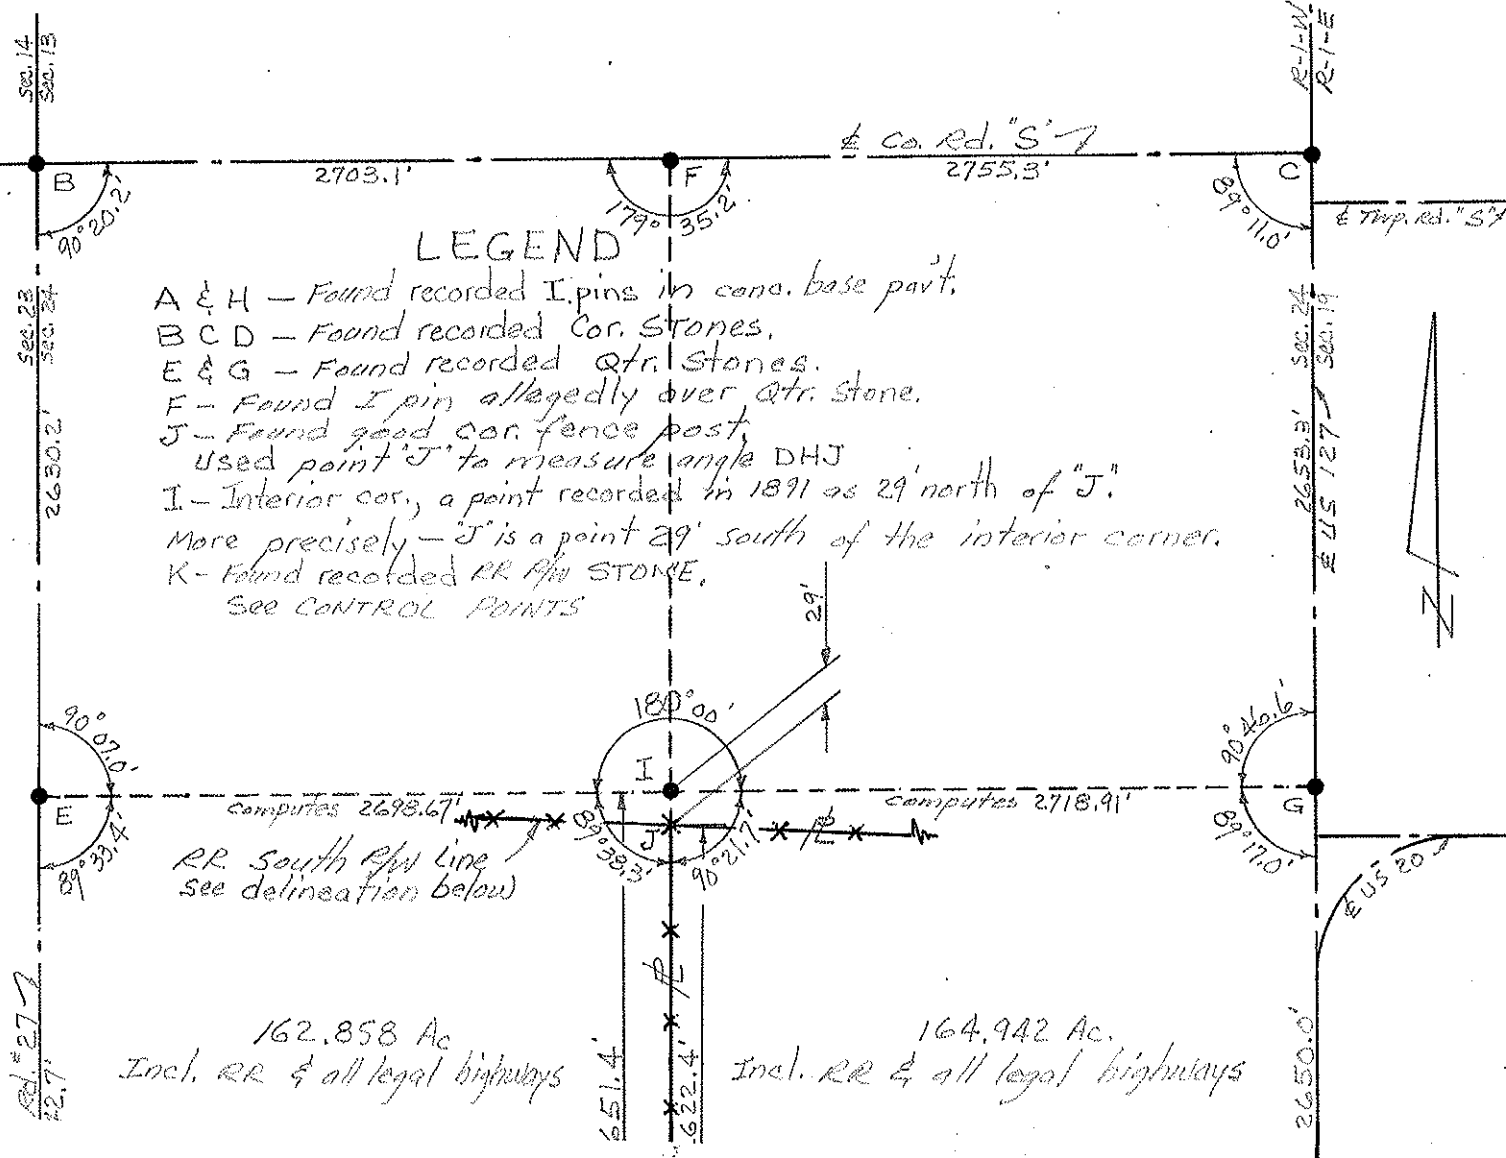

PERSONNEL TITLE PERSONNEL TITLE

Red Beach

W. Knope

COUNTY FultonDATE 1974S. R. Gorham Twp R-1-W

WEATHER _____

SEC. 13 & 24 T-9-5

TEMP. _____

DESCRIPTION

CONTROL POINTS

JOB NO. _____

P

L Co. Rd. "T"

sec. 12

sec. 13

J

Twp. Rd. "T"

Found recorded STONES BCDFGHI
 Found recorded $\frac{3}{4}$ " pipe "A"
 Found recorded pins in cane. L & K
 Found recorded Rods allegedly
 over STONES at M & N
 Found RR spk at "E"
 No STONE under "E"
 Found Recorded STONE "R" on north R/W line of T & W. RR

Sec. 14
Sec. 13R-1-W
R-1-E

ST = 2620.51'

127.82'

13

H

G

2641.04' - FH

101.05'

2703.1'

180° 24' 00"

2755.3'

90° 32.8'

PERSONNEL	TITLE	PERSONNEL	TITLE
1	2	3	4
5	6	7	8
9	10	11	12
13	14	15	16
17	18	19	20
21	22	23	24
25	26	27	28
29	30	31	32
33	34	35	36
37	38	39	40
41	42	43	44
45	46	47	48
49	50	51	52
53	54	55	56
57	58	59	60
61	62	63	64
65	66	67	68
69	70	71	72
73	74	75	76
77	78	79	80
81	82	83	84
85	86	87	88
89	90	91	92
93	94	95	96
97	98	99	100

Red Beach

W. Knabe

COUNTY FULTON DATE JUNE 74

S. R. US 20 & Co. Rd. 26 WEATHER

SEC. R-1-W, R-1-E Gorham Twp TEMP. _____

DESCRIPTION.

Section Line Measurements

JOB NO.

atr, line

Recorded Distance

4990.5'

US 205

off line.

Made diligent search for the recorded E $\frac{1}{2}$ STONE at "H" Sec. 24 R-1-W. Did not find.

56

255.06

26.000

10.11' sec. Line Overlap

2702.9' Recorded

sec. 24
sec. 25

£ 115 20/-

Sec. 24
Sec. 25

Sec. 19
Sec. 30

4 Trwp. Rd. "R"

2625, 2'

72.0'

5

0.19' overlap

1319.52

1334.20'

2

of

PERSONNEL TITLE PERSONNEL TITLE

Red Beach

COUNTY FultonDATE 4 June 1974

W. Knappe

S. R. Co. Rd. #26

WEATHER _____


SEC. 25-30 Gorham

TEMP. _____

DESCRIPTION

CONTROL POINTS

JOB NO. _____

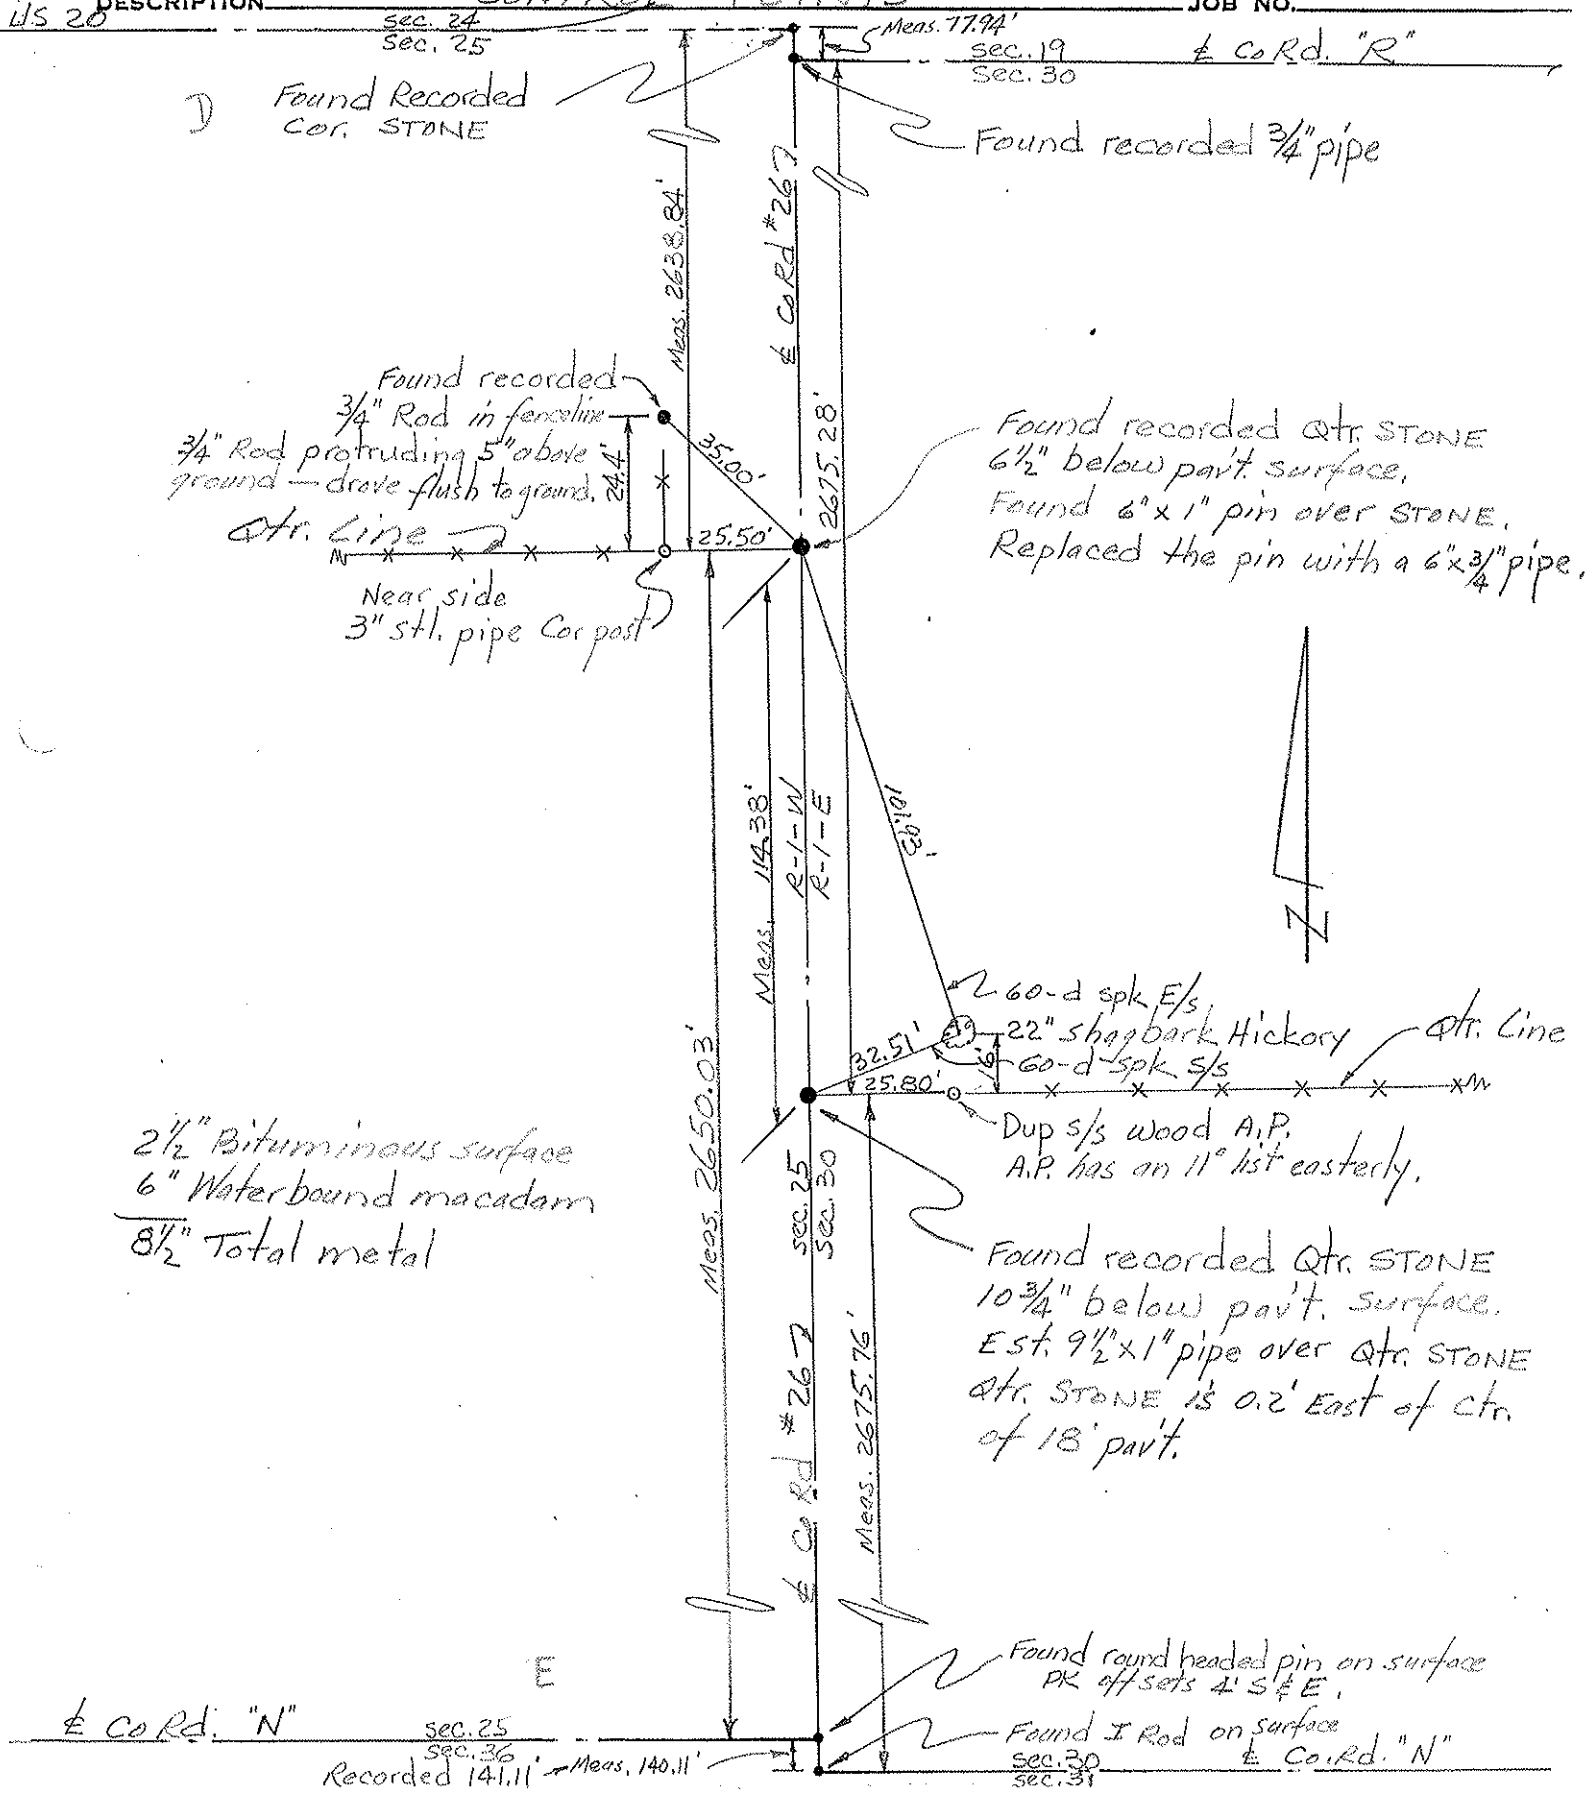


PERSONNEL	TITLE	PERSONNEL	TITLE
Red Beach			
W. Knappe			

COUNTY FULTON DATE JUNE 74

S. R. TWP. Rd. "R" WEATHER _____

SEC. Garham R-1-E TEMP. _____

DESCRIPTION SECTION LINE MEASUREMENTS JOB NO. _____

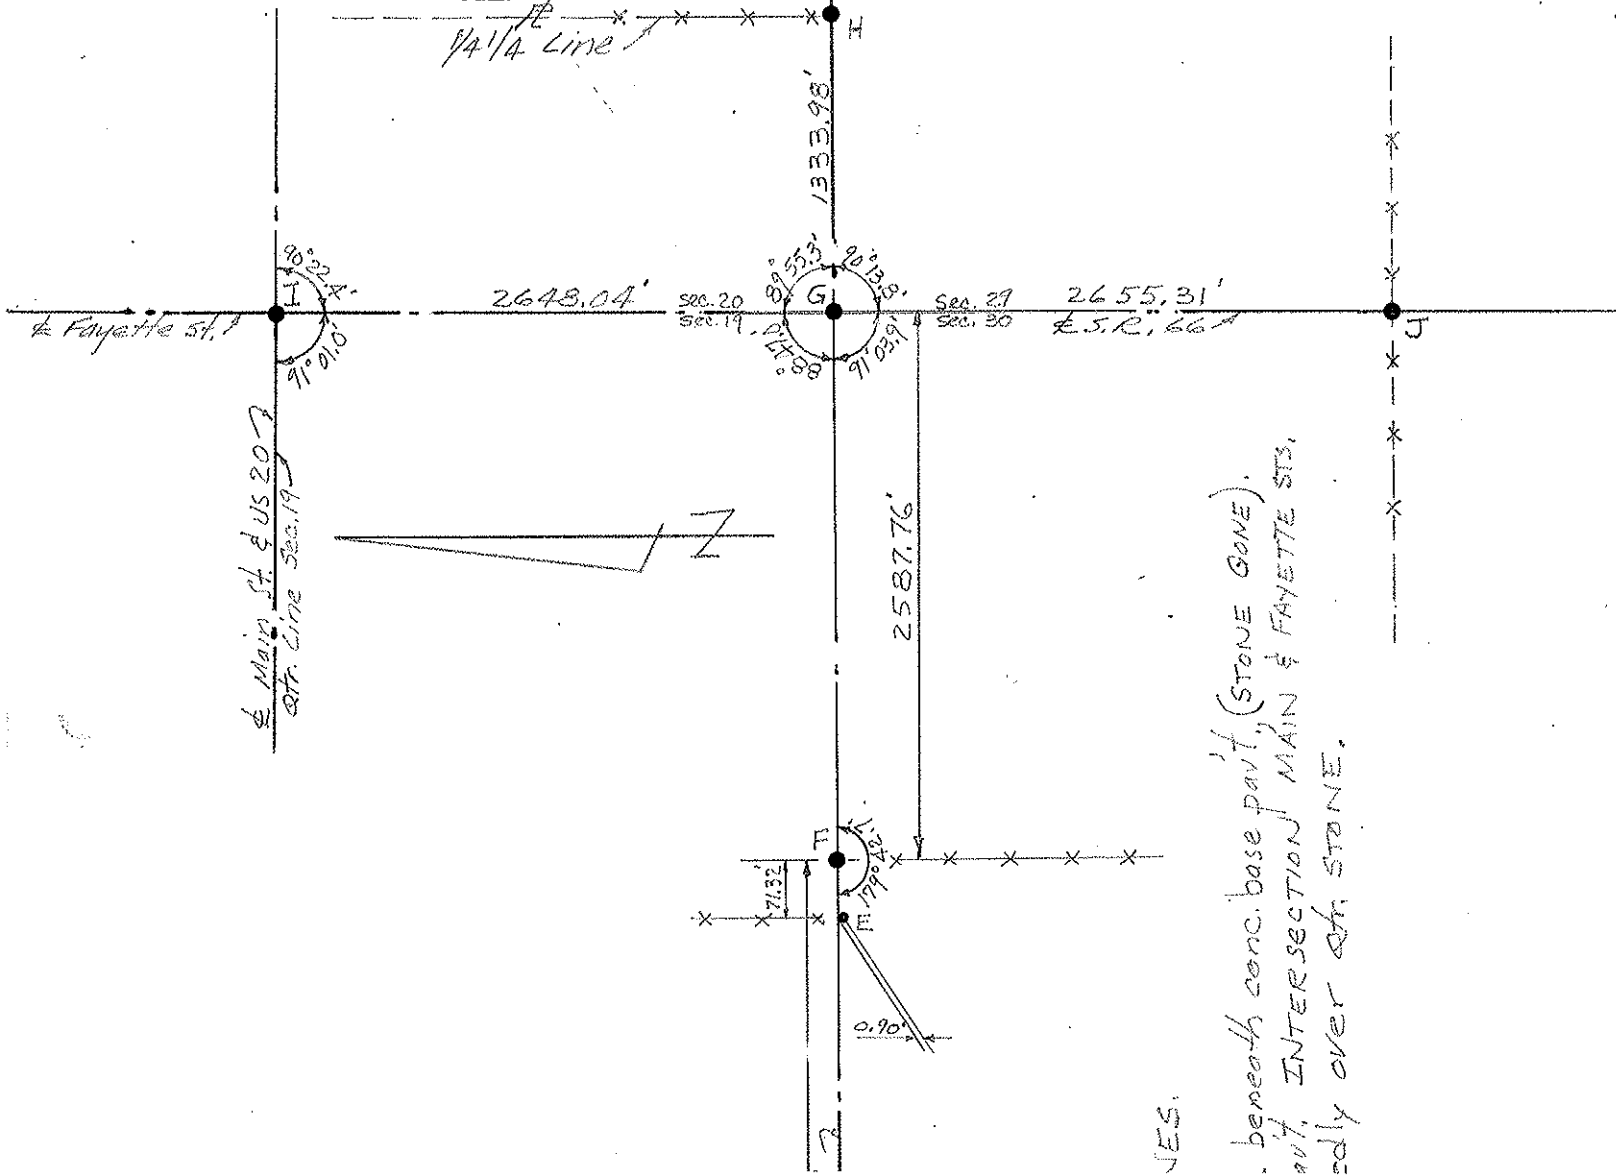

[illegible]

Red Beach

W. Knappe

COUNTY FULTON DATE JUNE 1974

S. R. Twp. Rd. "R" WEATHER

SEC. Garham R-1-E TEMP. _____

DESCRIPTION SECTION LINE MEASUREMENTS JOB NO.

4 Co. Rd. #237

2661.41

sec. 21

See 20

Sec. 23

Sec. 29

\$ US 207
Cdr. Line 7.

Qtr. Line

H
89° 19.7'

29.8'

100

de Temp. red. "R"

い



Q
Z
W
V
U

and recorded STONES
4" pipe, with wood stake & brick beneath conc. base part,
of this point from old pine tree reference. — STONE GONE,
recorded R.R. spk. allegedly over conc. STONE,
recorded I. Rod in brick part, Intersection Main & Fayette Sts.,
"pipe from prev. surv., allegedly over old STONE,
1/2" rod recorded from previous surveys.

PERSONNEL TITLE PERSONNEL TITLE

COUNTY

DATE

Red Beach
W. Knape
Don Boyle

S. R.

WEATHER



SEC.

TEMP.

DESCRIPTION

CONTROL POINTS

JOB NO.

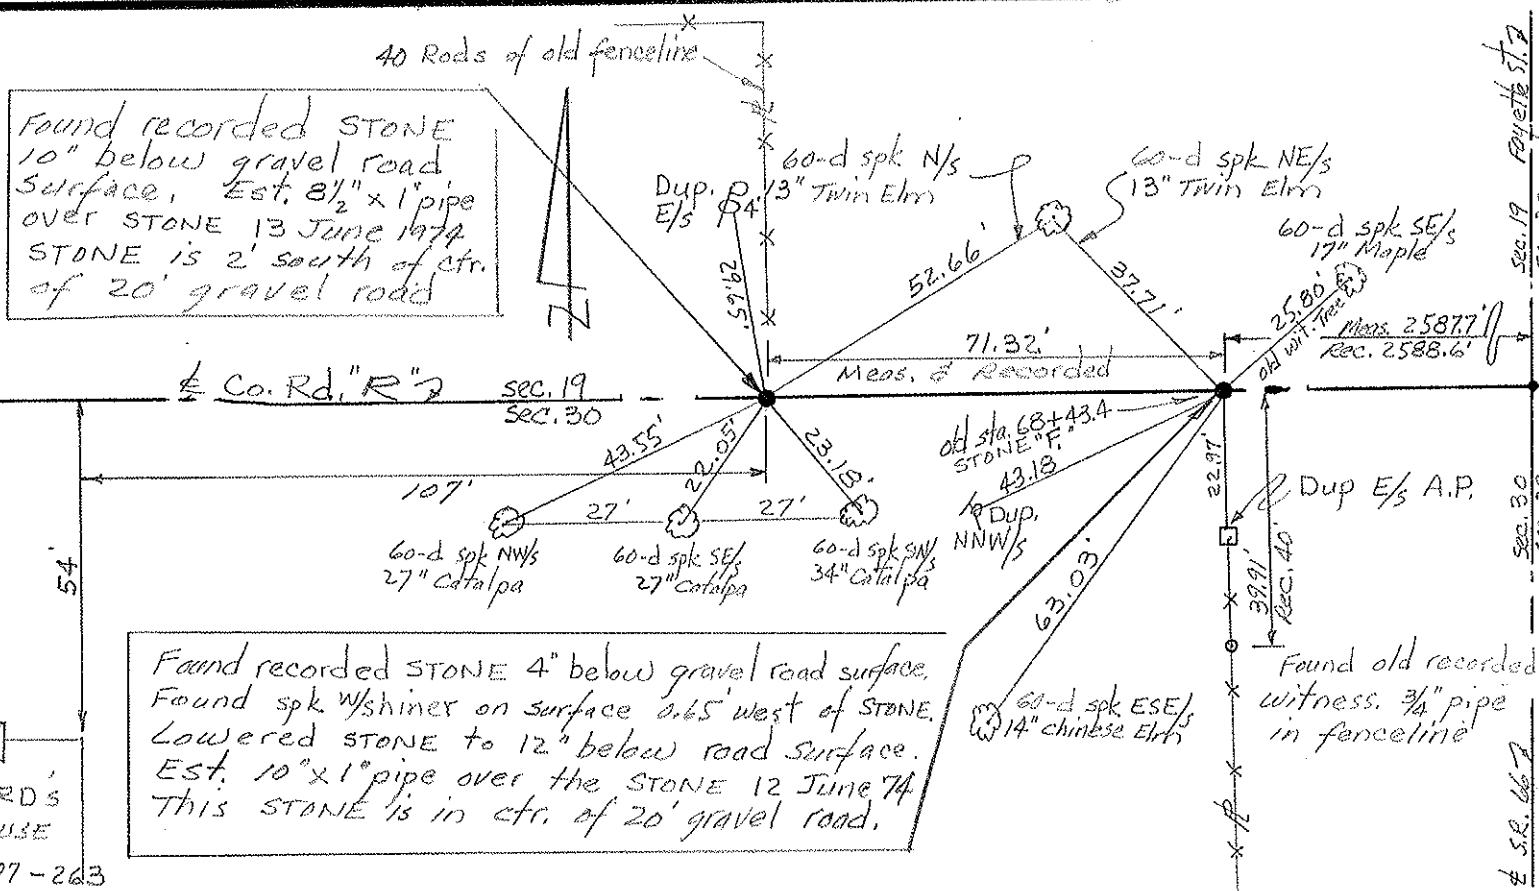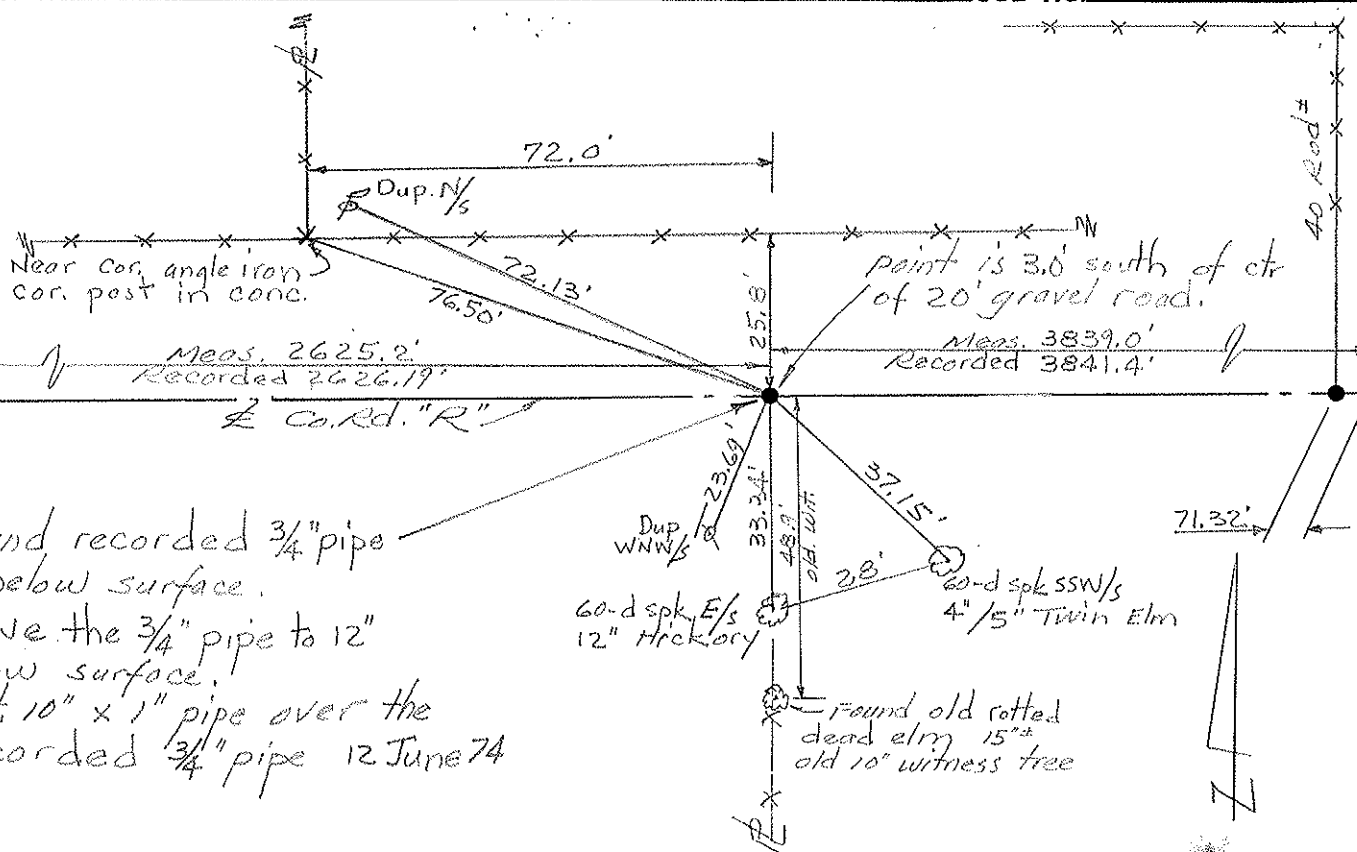BIRDS
HOUSE

#407-263


PERSONNEL	TITLE	PERSONNEL	TITLE
Red Beach			
W. Knappe			

COUNTY FULTON DATE JUNE 74

S. R. Gorham Twp. R-1-E WEATHER _____

SEC. South 1/2, Fr. Sec. 19 TEMP. _____

DESCRIPTION HALF SECTION DETAIL JOB NO. _____

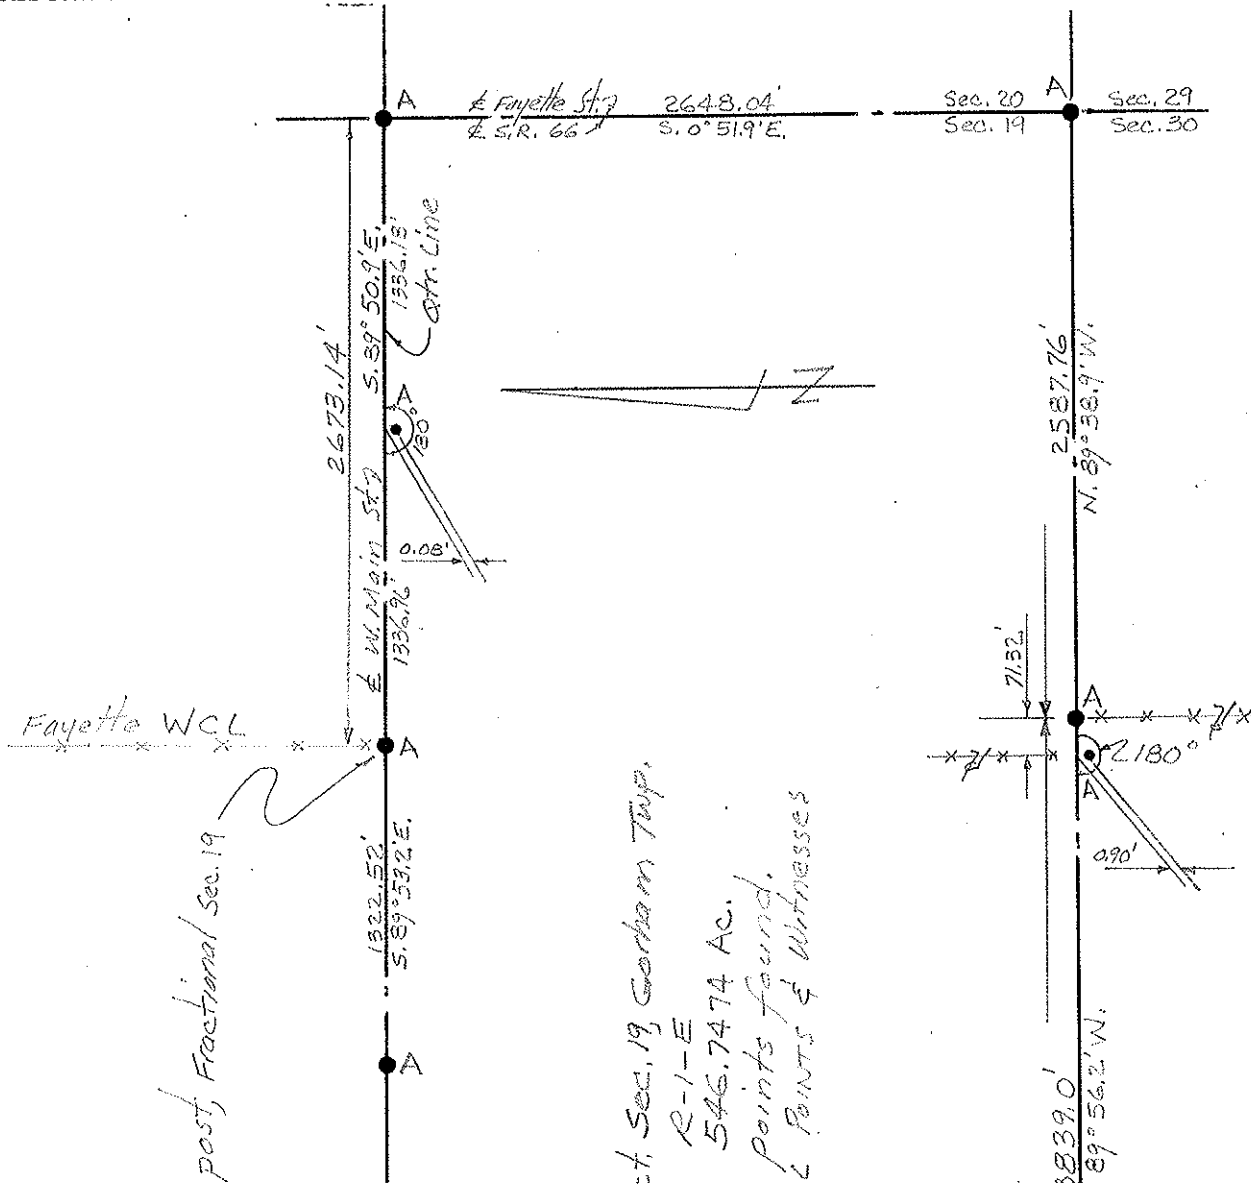


PERSONNEL	TITLE	PERSONNEL	TITLE
Red Beach			
W. Knape			

COUNTY Fulton DATE JUNE 74

S. R. Gorham Twp. R-1-E WEATHER _____

SEC. South 1/2, Sec. 20 TEMP. _____

DESCRIPTION HALF SECTION DETAIL JOB NO. _____

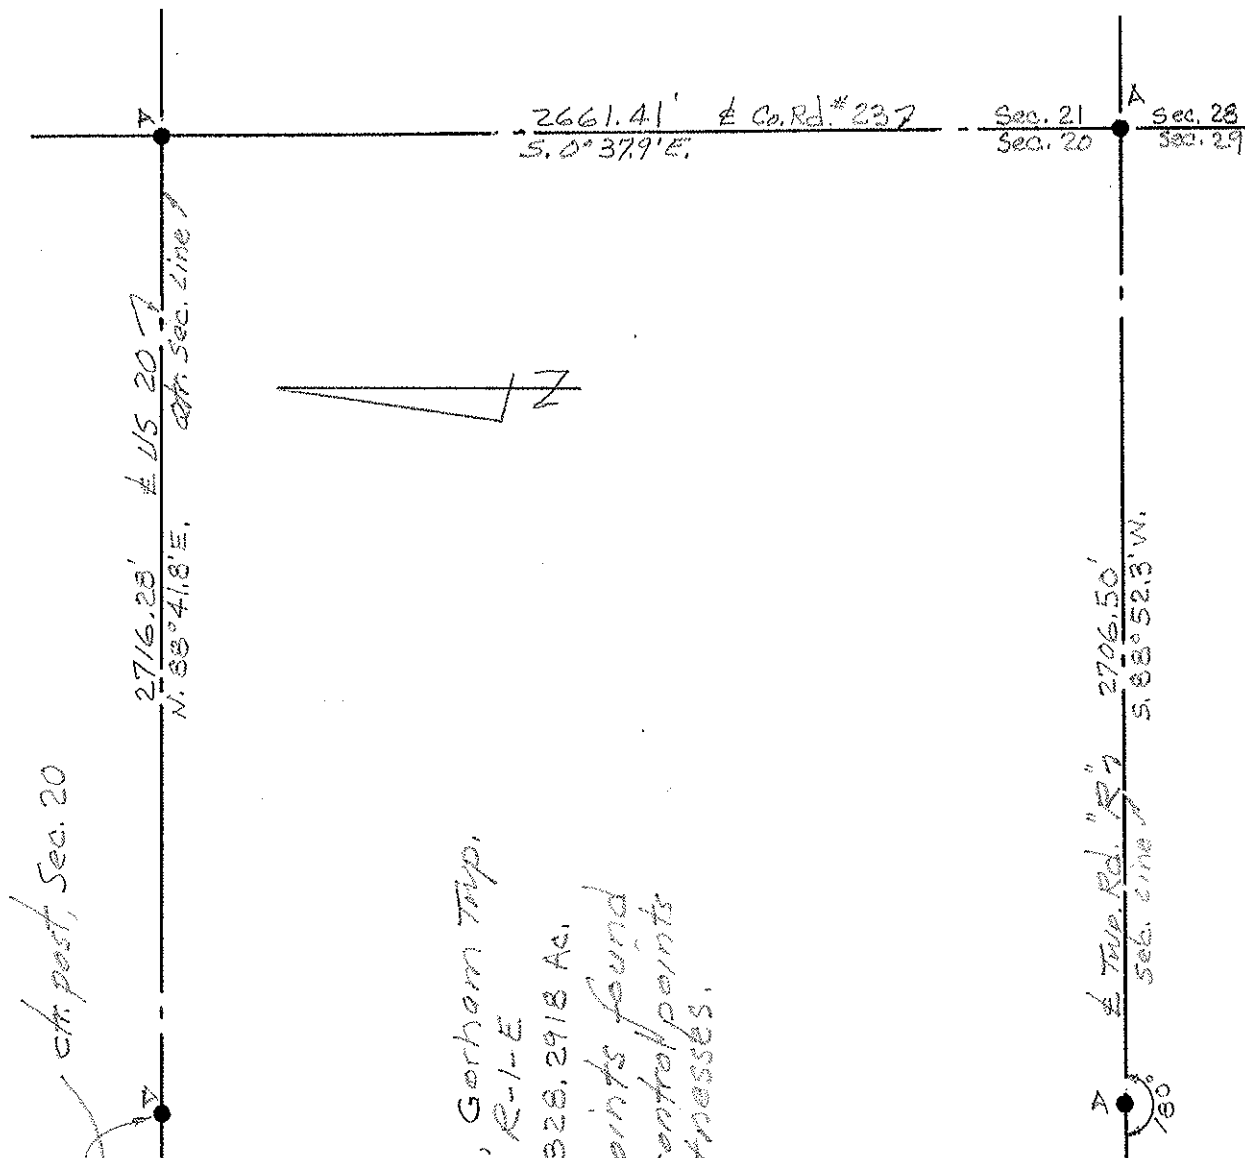

COUNTY

Fulton

DATE 21 June 74

S. R.

66 at Twp. Rd. "R"

WEATHER

SEC. Fayette South line



TEMP

JOB NC


CHURCH
of the
NAZARENE
Cong. Foundat
Brick Veneer

DESCRIPTION

CONTROL POINTS

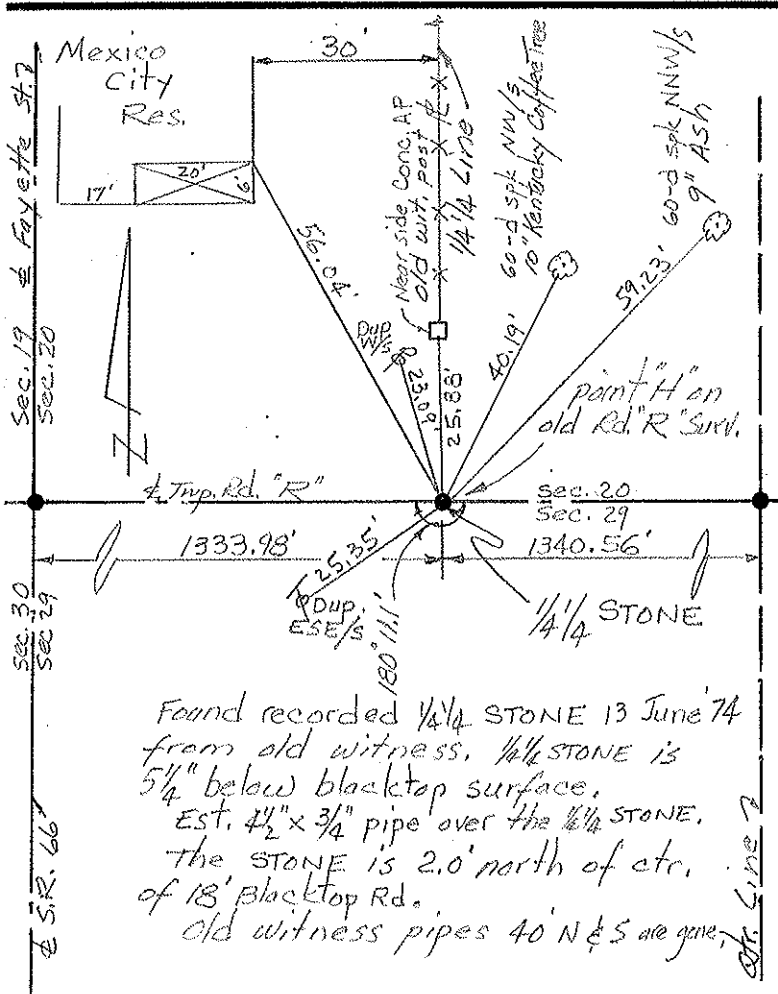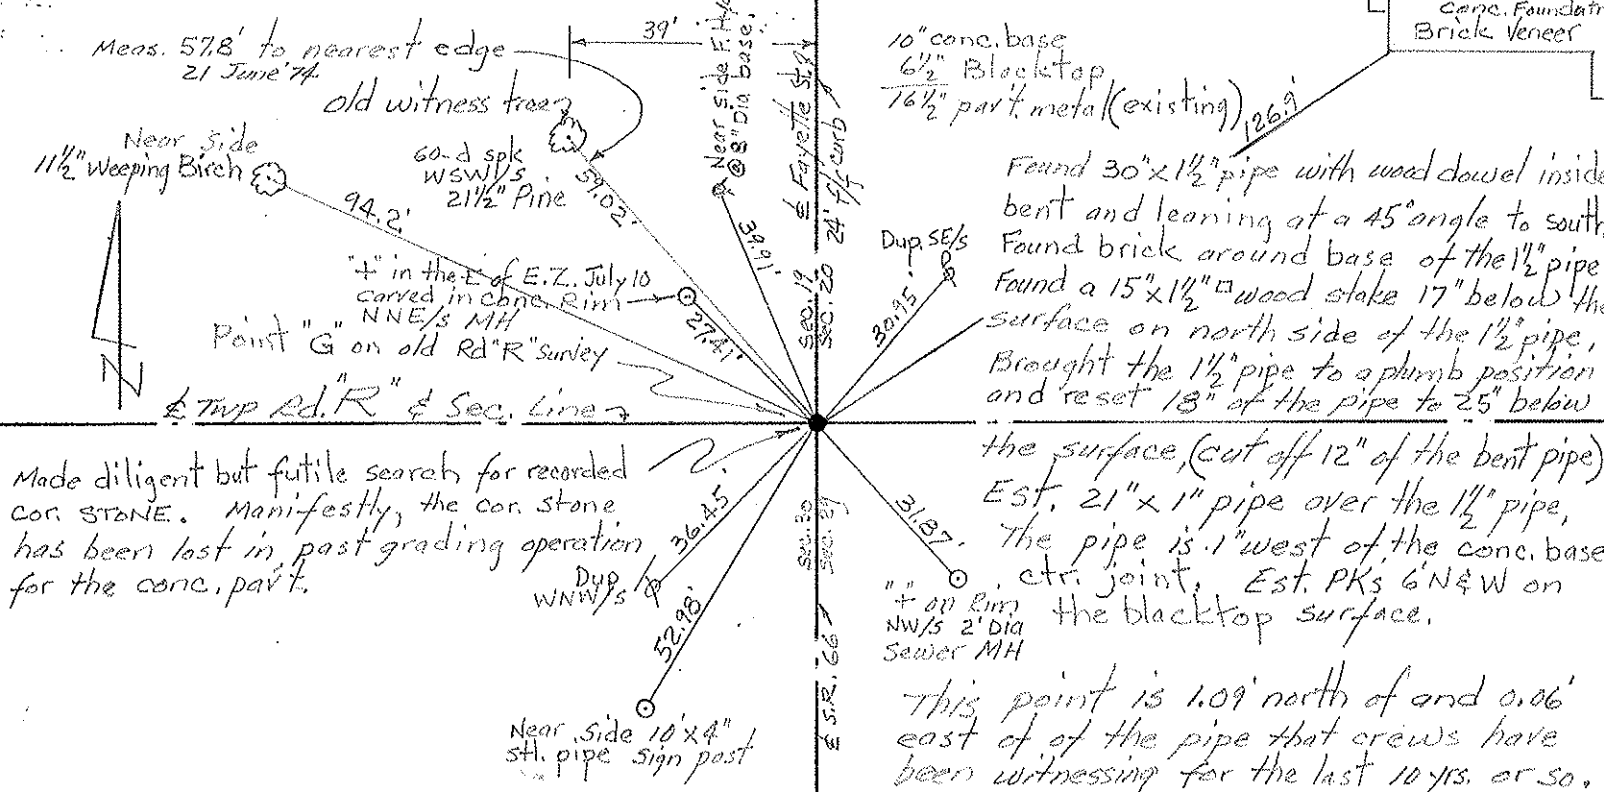

This Qtr. STONE is 3' south of ctr. of 20' gravel road.
The buggy axle is $18\frac{1}{2} \times 1$ " dia. with a 2" Nut 3" below
the top of the axle.

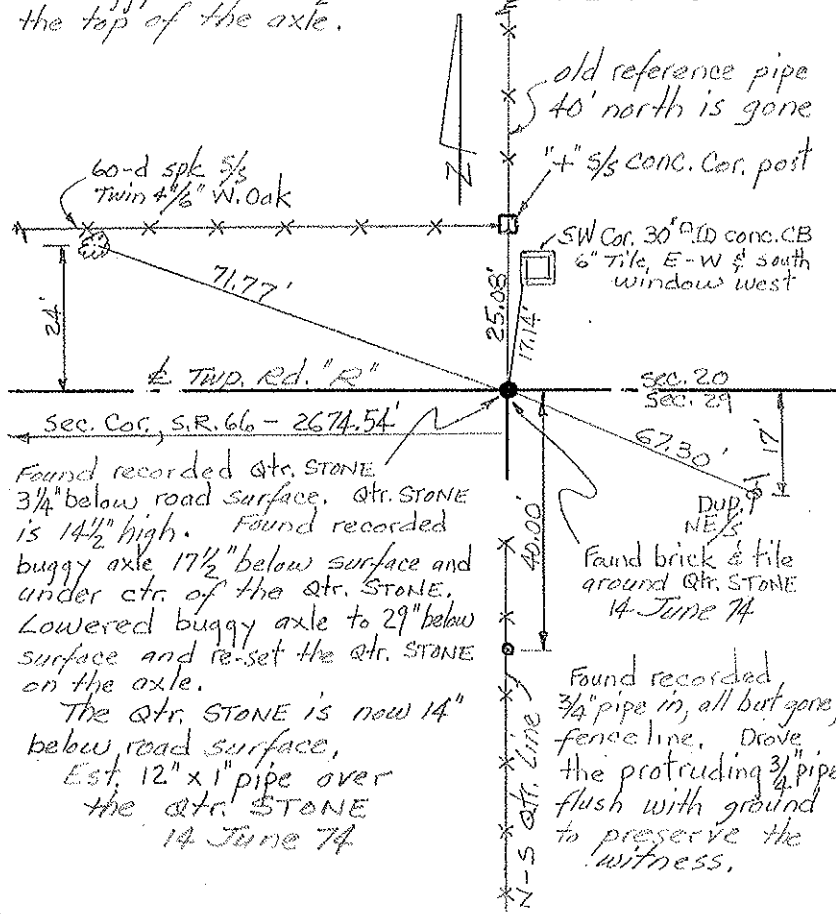

PERSONNEL	TITLE	PERSONNEL	TITLE
1	2	3	4
5	6	7	8
9	10	11	12
13	14	15	16
17	18	19	20
21	22	23	24
25	26	27	28
29	30	31	32
33	34	35	36
37	38	39	40
41	42	43	44
45	46	47	48
49	50	51	52
53	54	55	56
57	58	59	60
61	62	63	64
65	66	67	68
69	70	71	72
73	74	75	76
77	78	79	80
81	82	83	84
85	86	87	88
89	90	91	92
93	94	95	96
97	98	99	100

Red Beach


W. Knabe

COUNTY FULTON DATE July 1974

S. R. Two Rd. "R" WEATHER

SEC. Gorham R-1-E TEMP. _____

DESCRIPTION Section Line Measurements JOB NO.

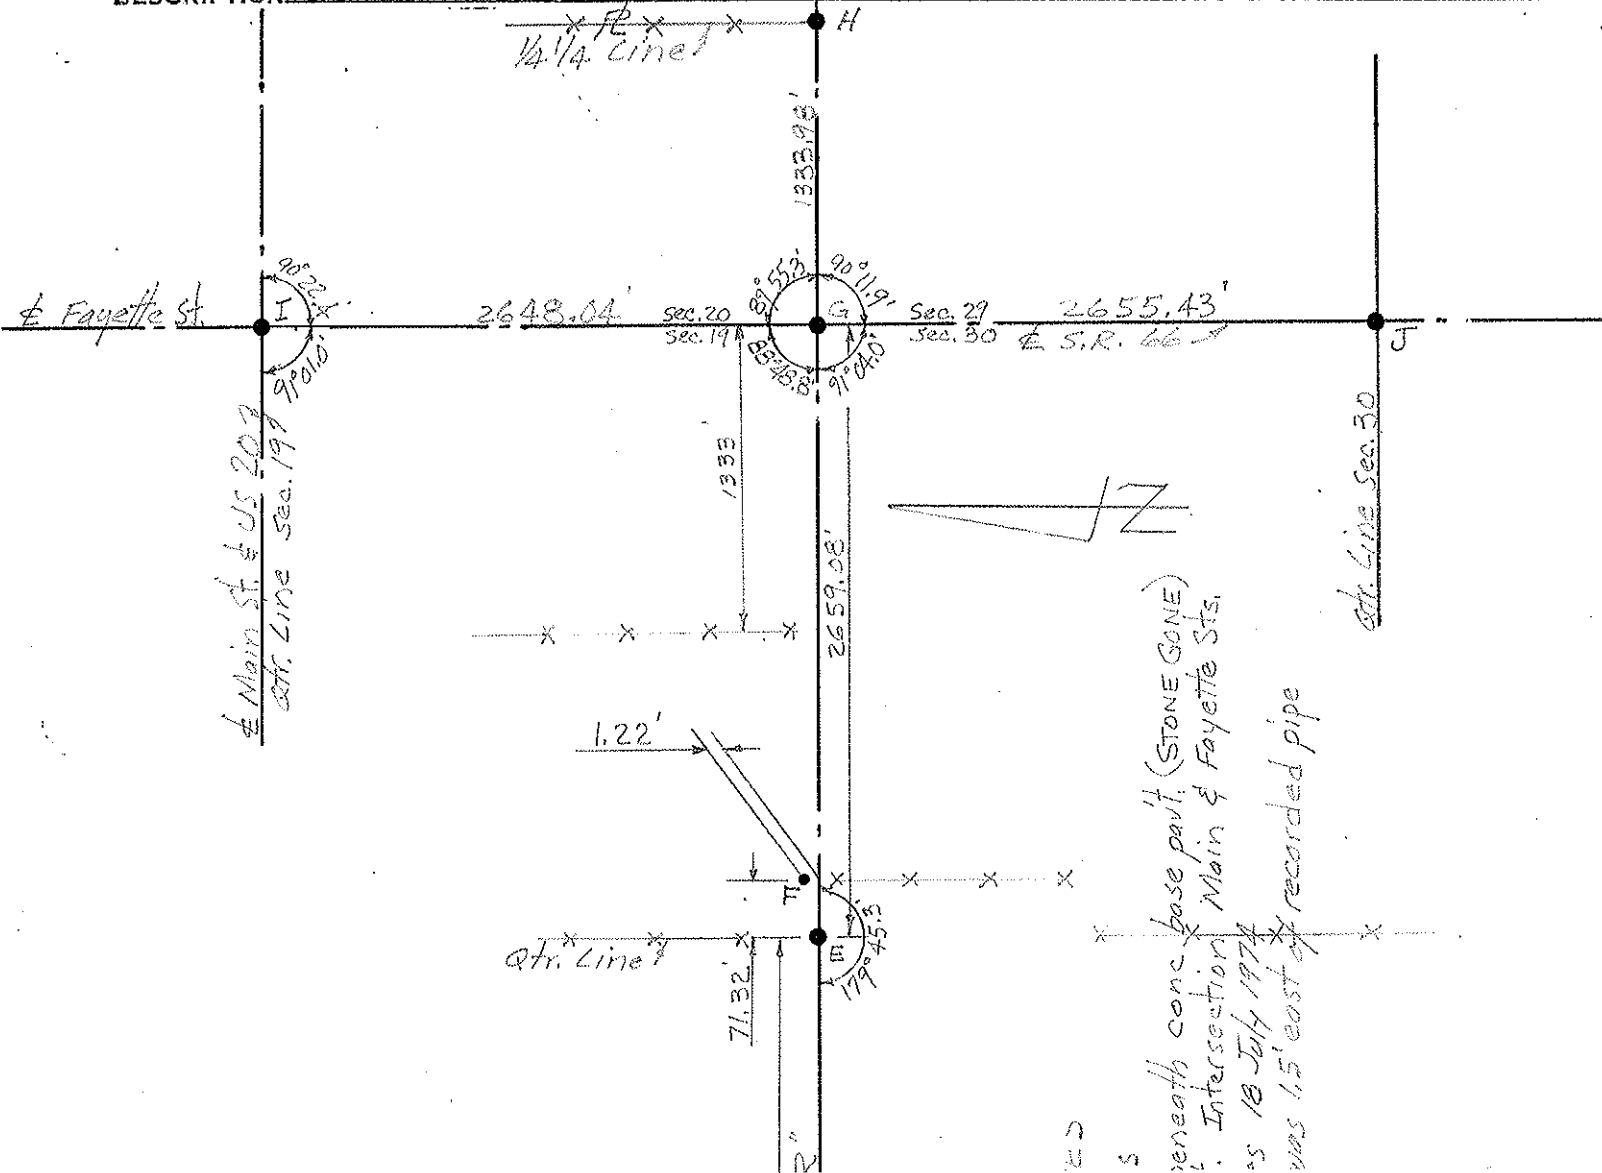


O.D.O.T. DISTRICT 2 SURVEY OFFICE (USE ONLY)

PERSONNEL _____ REFERENCE NO. 1 SHEET 1 OF 38
NOTES HOMAN DATE 4/12/17 ROUTE US 20
H.C. HOMAN WEATHER SUNNY COUNTY FULTON
R.C. LEU TEMP. 42°F TOWNSHIP GORHAM
SECTION 23
T 9 S R 1 W


TYPE MONUMENT P.K./WASHER
ON SURFACE - ~~BELOW~~ ON _____
~~LEFT~~ - CL PAV'T - RIGHT 0.5'
12.9' TO RT EDGE PAVEMENT
S.L.M. 0+00

Grid: Northing: 734080.677 Easting: 1449631.269

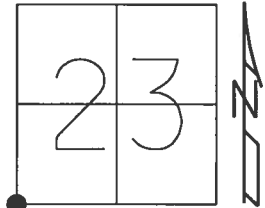

RECORD:
FD 3/4" IPIPE
3" DOWN
5/21/97, CL
SET P.K./WASHER
8/12/97, CL
FD P.K./WASHER
REF58
4/12/17
SET MAG/WASHER
8-11-2017, DCH

NOTE: REF 58 WIL CO.

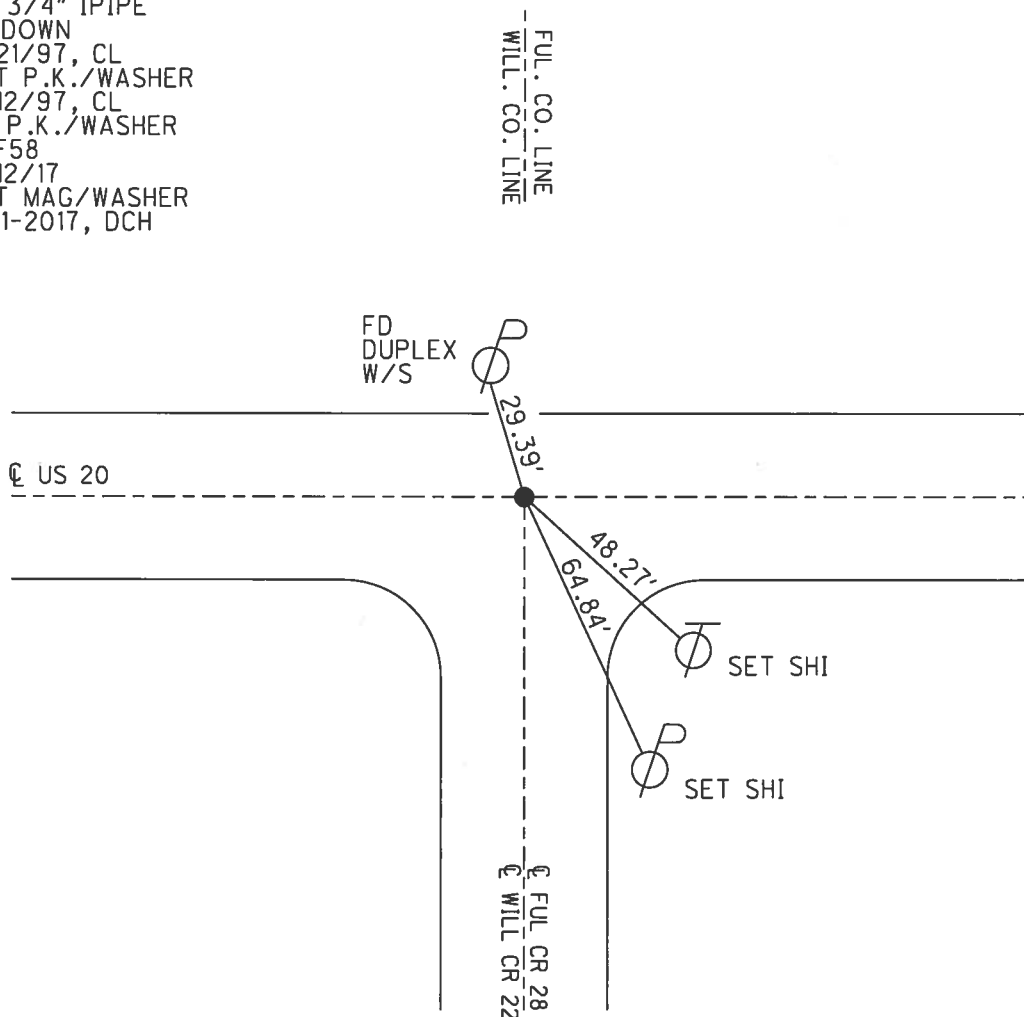

O.D.O.T. DISTRICT 2 SURVEY OFFICE (USE ONLY)

PERSONNEL

REFERENCE NO. 2

SHEET 2 OF 38

NOTES LEU

DATE 4/12/17

ROUTE US 20

H.C. HOMAN

WEATHER SUNNY

COUNTY FULTON

R.C. LEU

TEMP. 42°F

TOWNSHIP GORHAM

SECTION 23

T 9 S R 1 W

TYPE MONUMENT P.K.NAIL


ON SURFACE - ~~BELOW~~ ON

~~LEFT~~ - CL PAV'T - RIGHT 1'


- TO - EDGE PAVEMENT

S.L.M. 26+40

Grid: Northing: 734046.294 Easting: 1452257.534

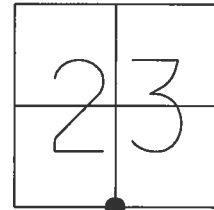

RECORD:
SET P.K. NAIL
1-30-86
FD P.K. NAIL
REF2
4-12-17, DCH
SET MAG/WASHER
08-11-2017, DCH

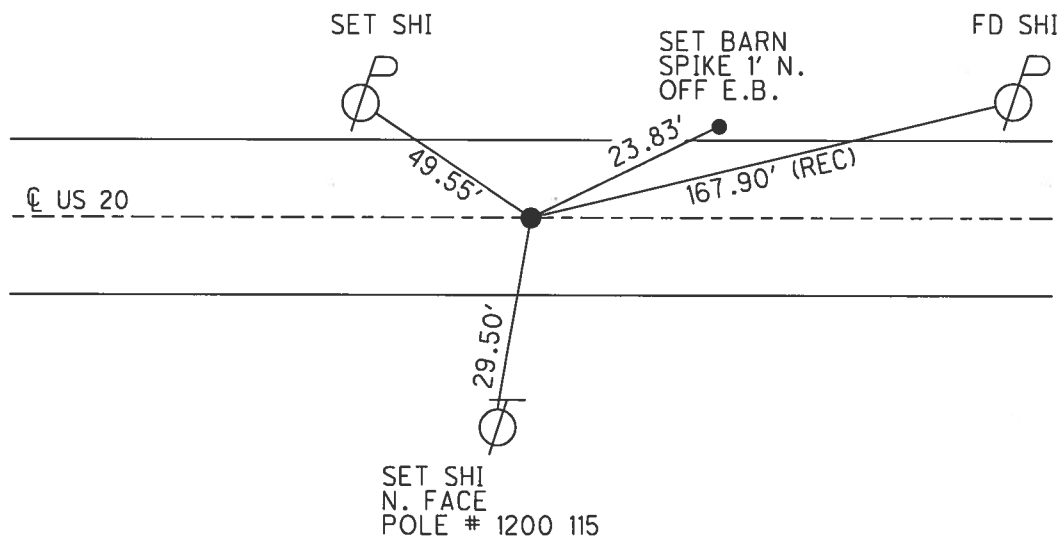


O.D.O.T. DISTRICT 2 SURVEY OFFICE (USE ONLY)


PERSONNEL _____ REFERENCE NO. 3 SHEET 3 OF 38
 NOTES LEU DATE 4/12/17 ROUTE US 20
 H.C. HOMAN WEATHER PARTLY CLOUDY COUNTY FULTON
 R.C. LEU TEMP. 42°F TOWNSHIP GORHAM
 _____ SECTION 23
 _____ T 9 S R 1 W

TYPE MONUMENT P.K./WASHER
 ON SURFACE - ~~BELOW~~ ON
~~LEFT~~ - CL PAV'T - RIGHT 1.5'
TO - EDGE PAVEMENT
 S.L.M. 52+80

Grid: Northing: 733997.525 Easting: 1454890.942

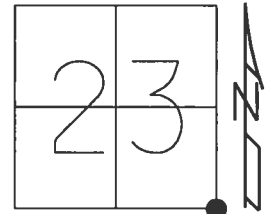

RECORD:
 FD P.K. NAIL
 10-2-85, IRS
 SET P.K. NAIL
 1-30-86
 FD P.K./WASHER
 REF3
 4-12-17, DCH
 SET MAG/WASHER
 08-11-2017, DCH

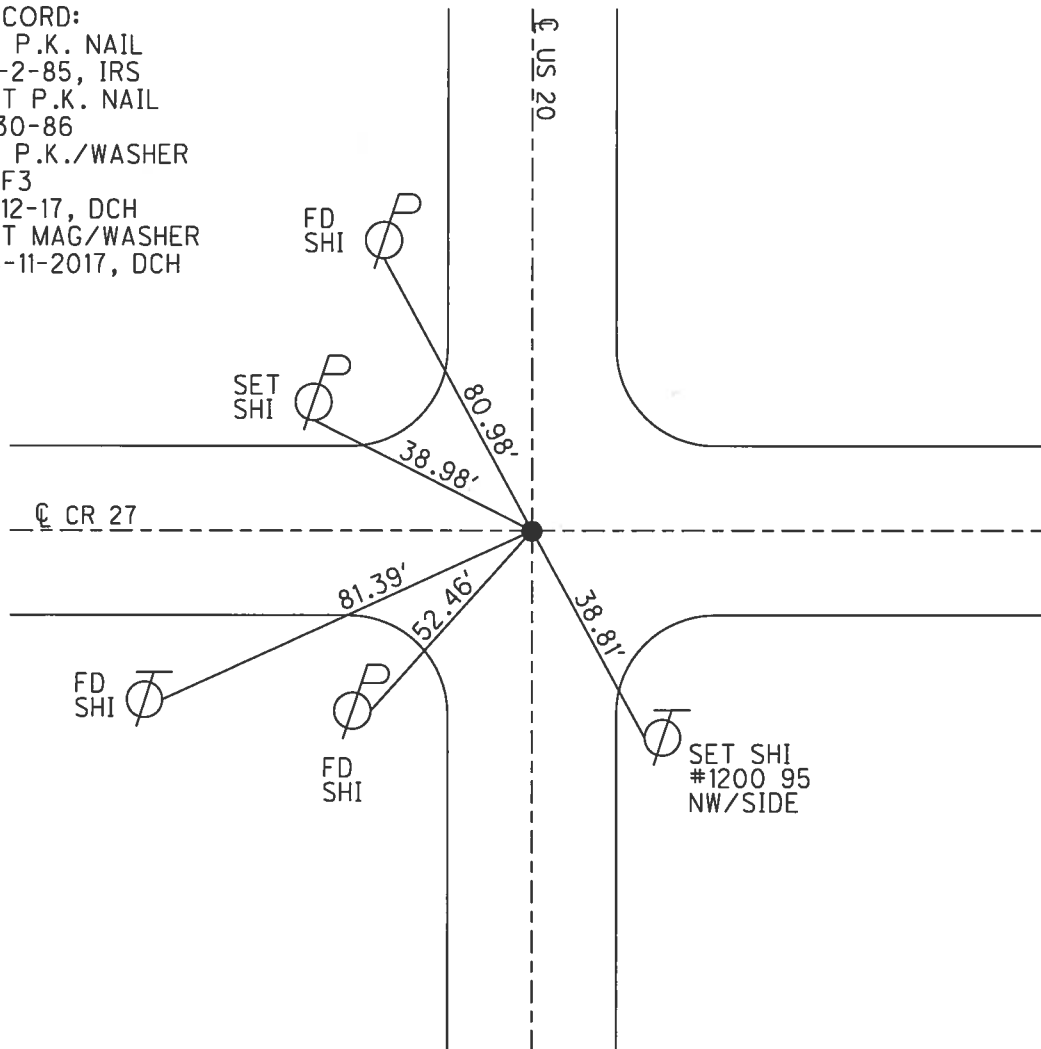

O.D.O.T. DISTRICT 2 SURVEY OFFICE (USE ONLY)

PERSONNEL _____ REFERENCE NO. 4 SHEET 4 OF 38
 NOTES LEU DATE 4/12/17 ROUTE US 20
 H.C. HOMAN WEATHER SUNNY COUNTY FULTON
 R.C. LEU TEMP. 42°F TOWNSHIP GORHAM
 SECTION 24
 T 9 S R 1 W

TYPE MONUMENT 1" IPIPE


~~ON SURFACE~~ - BELOW 3"

~~LEFT - C~~ PAV'T - RIGHT 1.4'


10.9 TO LT EDGE PAVEMENT

S.L.M. 79+30

Grid: Northing: 733969.141 Easting: 1457552.043

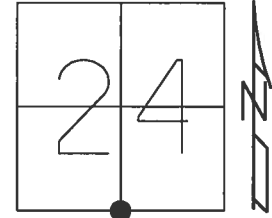

RECORD:
 1/2" I. PIPE
 4" DEEP
 7-24-91
 FD PK/WASHER
 5-16-02, MB
 FD 1" I PIPE
 4-12-2017, DCH
 SET MAG/WASHER
 08-11-2017, DCH

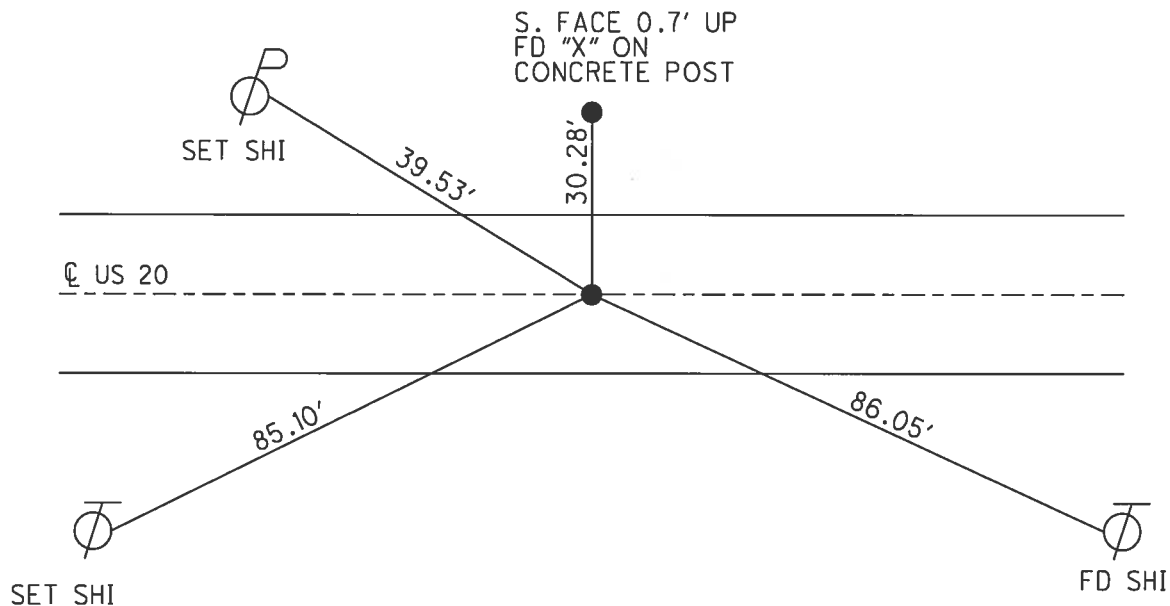


O.D.O.T. DISTRICT 2 SURVEY OFFICE (USE ONLY)


PERSONNEL	REFERENCE NO. <u>5</u>	SHEET <u>5</u> OF <u>38</u>
NOTES <u>LEU</u>	DATE <u>4/12/17</u>	ROUTE <u>US 20</u>
H.C. <u>HOMAN</u>	WEATHER <u>PARTLY CLOUDY</u>	COUNTY <u>FULTON</u>
R.C. <u>LEU</u>	TEMP. <u>42°F</u>	TOWNSHIP <u>GORHAM</u>
		SECTION <u>24</u>
		T <u>9</u> S R <u>1</u> W

TYPE MONUMENT P.K./WASHER
 ON SURFACE - ~~BELOW~~ ON
 LEFT - ℄ PAV'T - RIGHT ON
12.4 TO RT EDGE PAVEMENT
 S.L.M. 92+87

Grid: Northing: 733959.779 Easting: 1458917.224

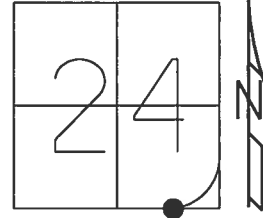


RECORD:
 1" I. PIPE
 4" DEEP
 7-24-91
 FD P.K./WASHER
 5-16-02, MB
 SET P.K./WASHER
 6-6-02, MB
 FD P.K./WASHER
 REF5
 4-12-2017, DCH
 SET MAG/WASHER
 08-11-2017, DCH

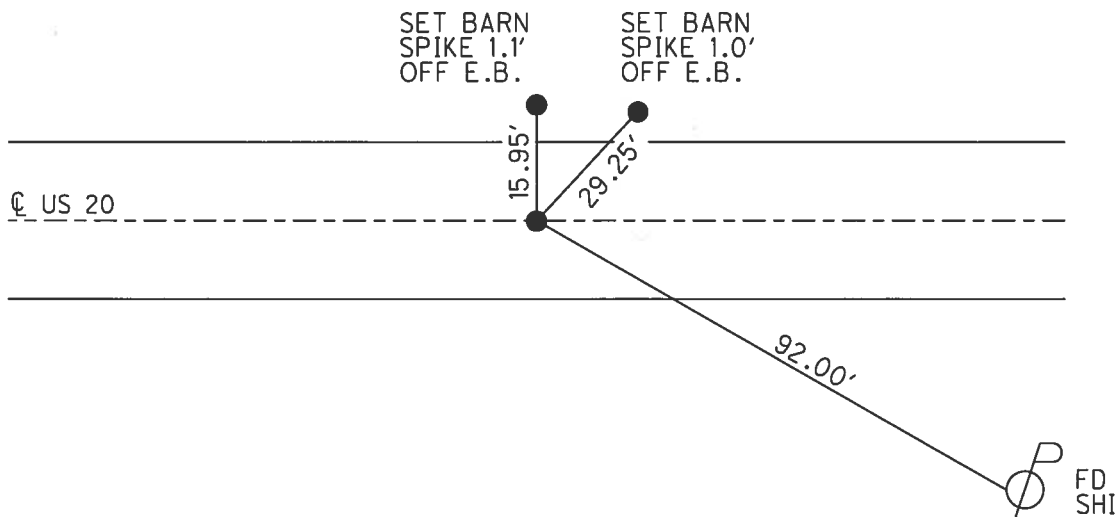


O.D.O.T. DISTRICT 2 SURVEY OFFICE (USE ONLY)

PERSONNEL _____ REFERENCE NO. 5 B SHEET 6 OF 38
 NOTES LEU DATE 4/12/17 ROUTE US 20
 H.C. HOMAN WEATHER Partly Cloudy COUNTY FULTON
 R.C. LEU TEMP. 42°F TOWNSHIP GORHAM
 _____ SECTION 24
 _____ T 9 S R 1 W

TYPE MONUMENT P.K./WASHER
 ON SURFACE - ~~BELOW~~ ON _____
~~LEFT - C~~ PAV'T - RIGHT 1.1'
11.5 TO RT EDGE PAVEMENT
 S.L.M. 114+74
 Grid: Northing: 735287.834 Easting: 1460280.073

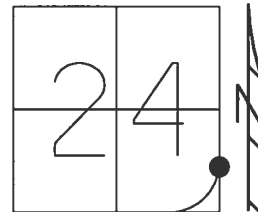


RECORD:
 1" I. PIPE
 4" DEEP
 7-24-91
 FD P.K./WASHER
 5-16-02, MB
 SET P.K./WASHER
 6-6-02, MB
 SET MAG/WASHER
 REFB5
 08-14-2017, DCH

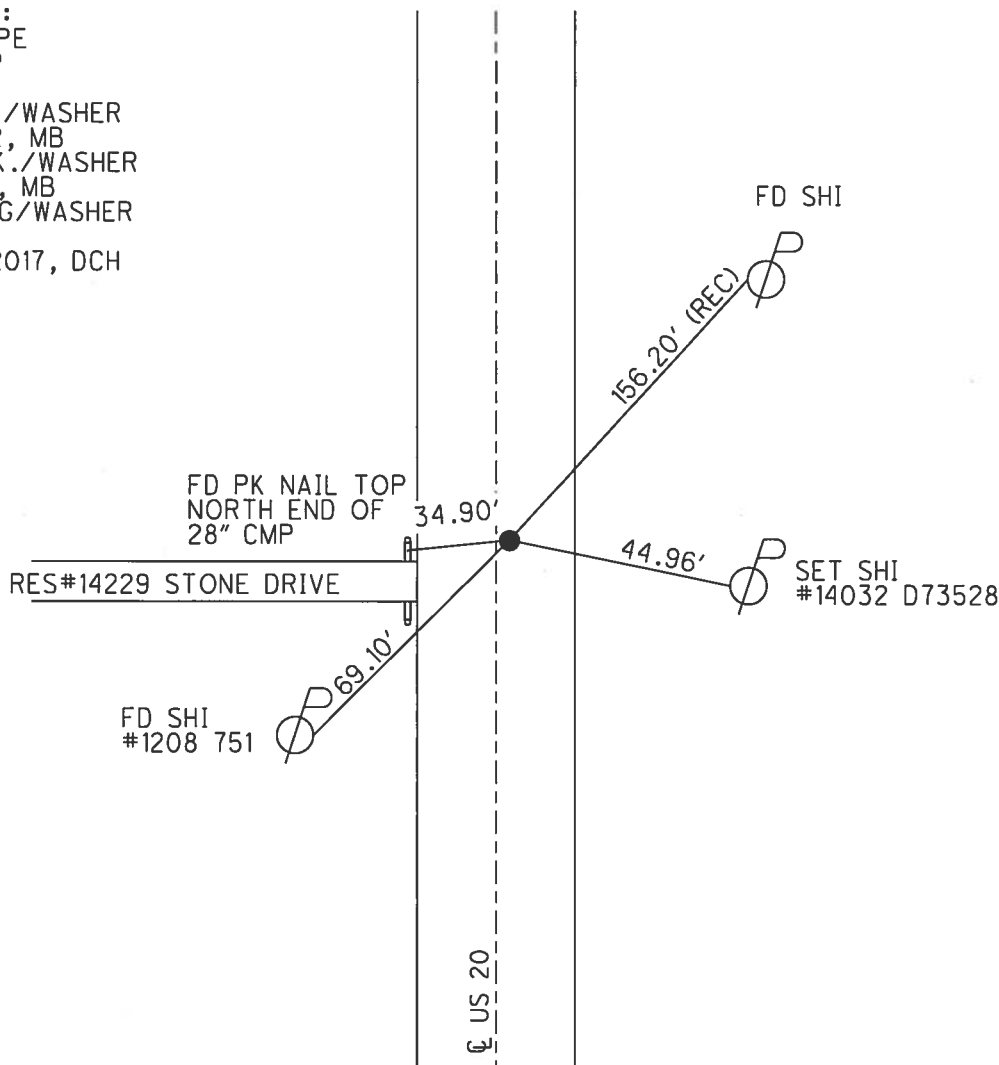


O.D.O.T. DISTRICT 2 SURVEY OFFICE (USE ONLY)

PERSONNEL	REFERENCE NO.	<u>7 A</u>	SHEET	<u>7</u>	OF	<u>38</u>
NOTES	LEU	DATE	<u>4/12/17</u>	ROUTE	<u>US 20</u>	
H.C.	<u>HOMAN</u>	WEATHER	<u>SUNNY</u>	COUNTY	<u>FULTON</u>	
R.C.	<u>LEU</u>	TEMP.	<u>51°F</u>	TOWNSHIP	<u>GORHAM</u>	
				SECTION	<u>19</u>	
				T	<u>9</u>	S
				R	<u>1</u>	E

TYPE MONUMENT P.K./WASHER
ON SURFACE - BELOW ON
~~LEFT~~ - CL PAV'T - RIGHT 1.5'
10.6 TO RT EDGE PAVEMENT
S.L.M. 134+95
Grid: Northing: 736496.962 Easting: 1461309.886

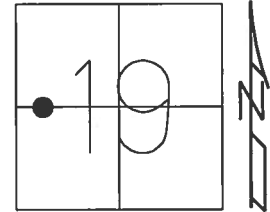

RECORD: 1932 P.I.
STA. 5+00
1 1/2" IPIPE
1 & 1/2" DEEP
7-24-91
FD IPIPE
5-16-02, MB
SET P.K./WASHER
6-6-02, MB
FD P.K./WASHER
REFA7
4-12-2017, DCH
SET MAG/WASHER
08-14-2017, DCH

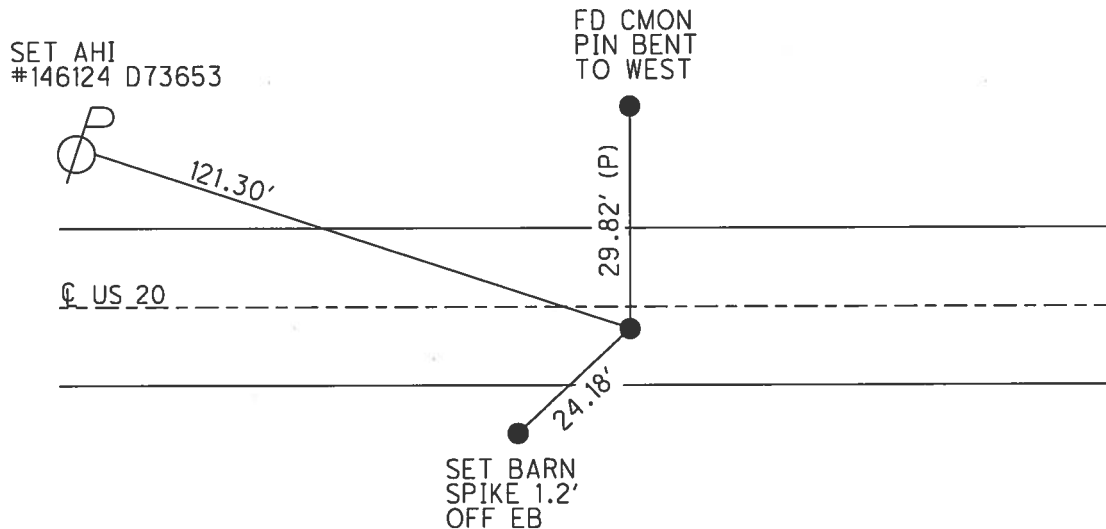

O.D.O.T. DISTRICT 2 SURVEY OFFICE (USE ONLY)

PERSONNEL

REFERENCE NO.

7 B

SHEET

8

OF 38

NOTES

LEU

DATE

4/12/17

ROUTE

US 20

H.C.

HOMAN

WEATHER

SUNNY

COUNTY

FULTON

R.C.

LEU

TEMP.

51°F

TOWNSHIP

GORHAM

SECTION

19

T 9 S R 1 E

TYPE MONUMENT

P.K.NAIL

ON SURFACE - ~~BELOW~~

ON

~~LEFT~~ - CL PAV'T - RIGHT 1.4'

10.3 TO RT EDGE PAVEMENT

S.L.M.


155+09

Grid: Northing:

736467.556

Easting:

1463309.713

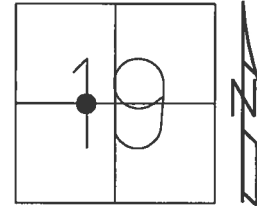

RECORD:

1/2" IPIPE

1 1/2" DOWN

7-24-91

FD IPIPE

5-16-02, MB

SET P.K./WASHER

6-6-02, MB

FD P.K.NAIL

REFB7

4-12-2017, DCH

SET MAG/WASHER

08-14-2017, DCH

DIST. 7B-7C= 0.72'

SET SHI
WOOD
FEN POST

112.83'

CL US 20

75.78'

FD
SHI

CL R/W


7C

SET BARN
SPIKE 1.2'
OFF EB
15.18'

O.D.O.T. DISTRICT 2 SURVEY OFFICE (USE ONLY)


PERSONNEL _____ REFERENCE NO. 7 C SHEET 9 OF 38
 NOTES LEU DATE 4/12/17 ROUTE US 20
 H.C. HOMAN WEATHER SUNNY COUNTY FULTON
 R.C. LEU TEMP. 51°F TOWNSHIP GORHAM
 SECTION 19
 T 9 S R 1 E

TYPE MONUMENT 1/2" IPIPE
~~ON SURFACE~~ - BELOW 3"
~~LEFT -~~ CL PAV'T - RIGHT 2.1'
9.6 TO RT EDGE PAVEMENT
 S.L.M. 155+09
 Grid: Northing: 736466.839 Easting: 1463309.689

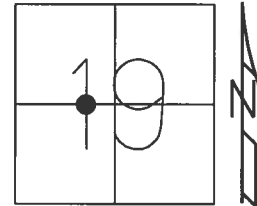

RECORD:
 1/2" IPIPE
 1 1/2" DEEP
 7-24-91
 FD IPIPE
 5-16-02, MB
 SET P.K./WASHER
 6-6-02, MB
 FD 1/2" IPIPE
 3" DOWN
 REFC7
 4-12-2017, DCH
 SET MAG/WASHER
 08-14-2017, DCH

DIST. 7B-7C= 0.72'

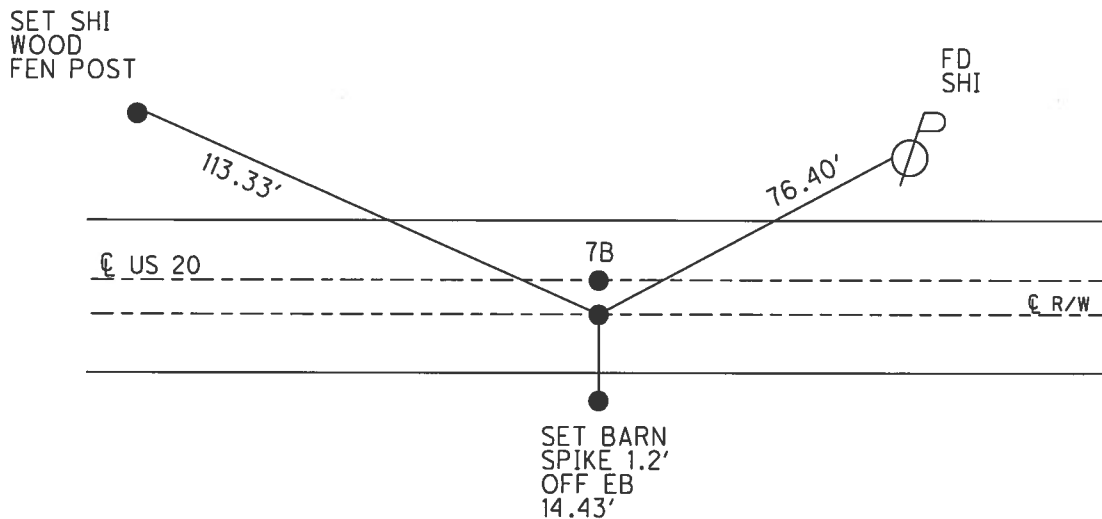

O.D.O.T. DISTRICT 2 SURVEY OFFICE (USE ONLY)

PERSONNEL _____ REFERENCE NO. 8 SHEET 10 OF 38
NOTES LEU DATE 4/12/17 ROUTE US 20
H.C. HOMAN WEATHER SUNNY COUNTY FULTON
R.C. LEU TEMP. 51°F TOWNSHIP GORHAM
SECTION 19
T 9 S R 1 E

TYPE MONUMENT P.K./WASHER


ON SURFACE - ~~BELOW~~ ON _____

~~LEFT~~ - CL PAV'T - RIGHT 3.0'

8.5 TO RT EDGE PAVEMENT


S.L.M. 174+85

Grid: Northing: 736442.696 Easting: 1465294.649

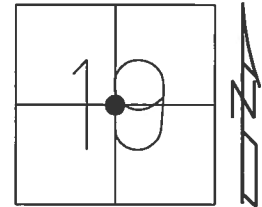

RECORD:
1" IPIPE
1 1/2" DOWN
7-24-91
P.K./WASHER
5-16-02, MB
SET P.K./WASHER
6-6-02, MB
FD P.K./WASHER
REF8
4-12-2017, DCH
SET MAG/WASHER
08-14-2017, DCH

DIST. 8-8A= 5.80'

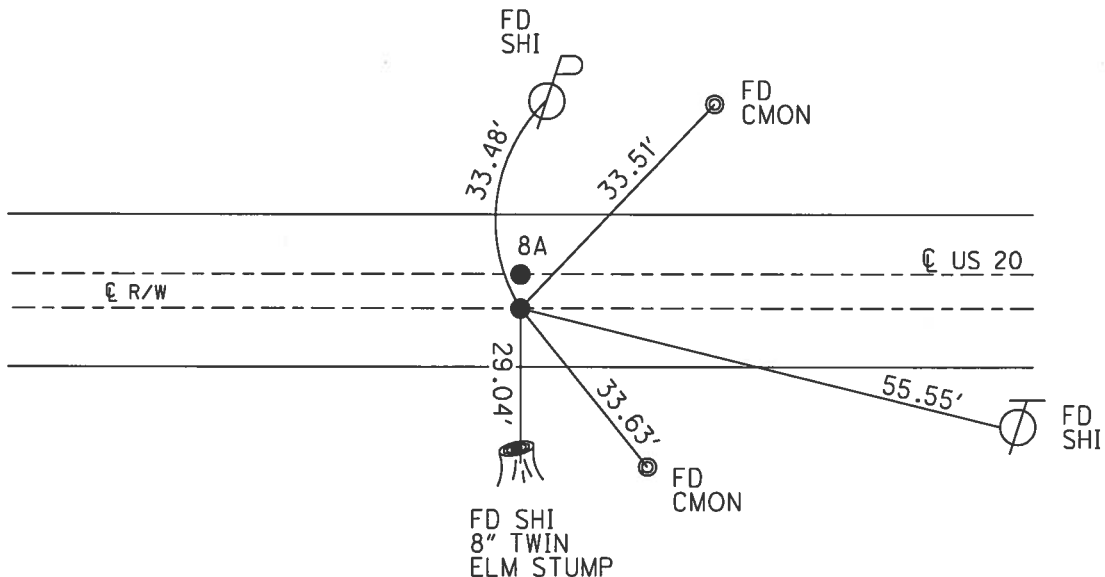

O.D.O.T. DISTRICT 2 SURVEY OFFICE (USE ONLY)

PERSONNEL

REFERENCE NO. 8 A

SHEET 11 OF 38

NOTES LEU

DATE 4/12/17

ROUTE US 20

H.C. HOMAN

WEATHER SUNNY

COUNTY FULTON

R.C. LEU

TEMP. 51°F

TOWNSHIP GORHAM

SECTION 19

T 9 S R 1 E

TYPE MONUMENT P.K./WASHER


~~ON SURFACE~~ - BELOW ON

LEFT - CL PAV'T - ~~RIGHT~~ 2.8'

14.2 TO RT EDGE PAVEMENT

S.L.M. 174+85

Grid: Northing: 736436.967 Easting: 1465295.129

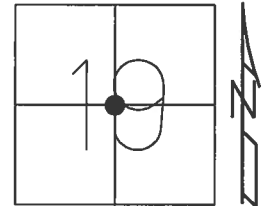

DIST. 8-8A= 5.80'

RECORD:

1" IPIPE

1 1/2" DOWN

CL RW & CONST. US20

7-24-91

FD I PIPE

BELOW SURFACE

5-16-02, MB

SET P.K./WASHER

6-6-02, MB


FD P.K./WASHER

REFA8

4-12-2017, DCH

SET MAG/WASHER

08-14-2017, DCH

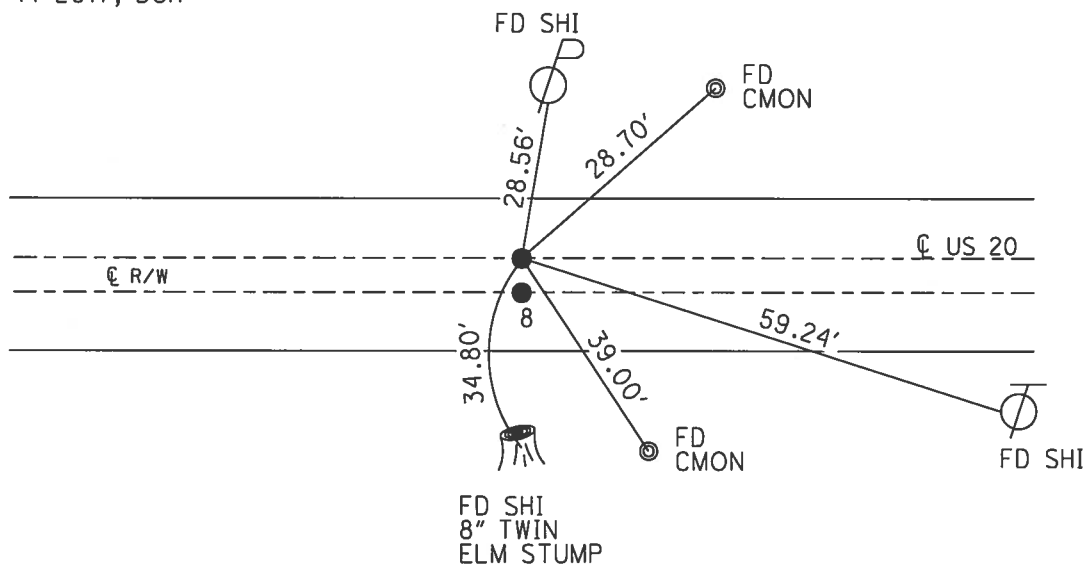


O.D.O.T. DISTRICT 2 SURVEY OFFICE (USE ONLY)


PERSONNEL	REFERENCE NO.	9	SHEET	12	OF	38
NOTES	LEU	DATE	4/12/17	ROUTE	US 20	
H.C.	HOMAN	WEATHER	SUNNY	COUNTY	FULTON	
R.C.	LEU	TEMP.	51°F	TOWNSHIP	GORHAM	
				SECTION	19	
				T 9 S	R 1 E	

TYPE MONUMENT 1" IPIPE
~~ON SURFACE~~ - BELOW 3"
 LEFT - ℄ PAV'T - ~~RIGHT~~ 0.6'
10.9 TO LT EDGE PAVEMENT
 S.L.M. 188+08

Grid: Northing: 736426.713 Easting: 1466617.034

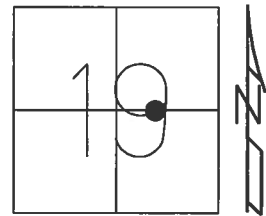

RECORD:
 1" IPIPE
 1 1/2" DOWN
 7-24-91
 FD 1" IPIPE
 5-17-02, MB
 SET P.K./WASHER
 6-6-02, MB
 FD 1" IPIPE
 REF9
 4-12-2017, DCH
 SET MAG/WASHER
 08-14-2017, DCH

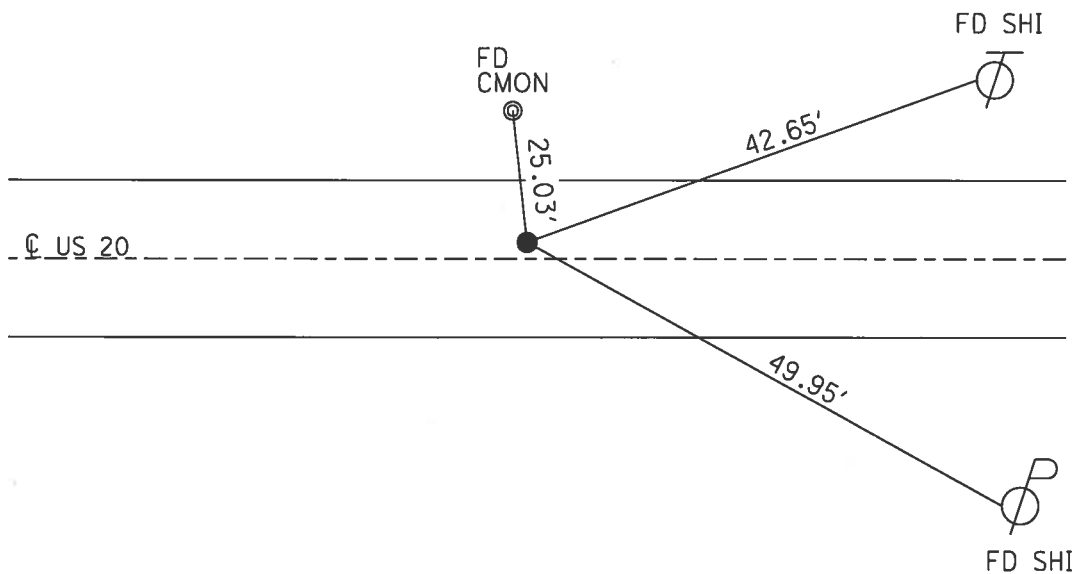

O.D.O.T. DISTRICT 2 SURVEY OFFICE (USE ONLY)

PERSONNEL

REFERENCE NO.

9 A

SHEET

13

OF 38

NOTES LEU

DATE 4/13/17

ROUTE US 20

H.C. HOMAN

WEATHER OVERCAST

COUNTY FULTON

R.C. LEU

TEMP. 48°F

TOWNSHIP GORHAM

SECTION 19

T 9 S R 1 E

TYPE MONUMENT P.K./WASHER


ON SURFACE - ~~BELOW~~ ON

LEFT - $\odot$ PAV'T - RIGHT ON


14.7 TO LT EDGE PAVEMENT

S.L.M. 196+29

Grid: Northing: 736416.109 Easting: 1467435.932

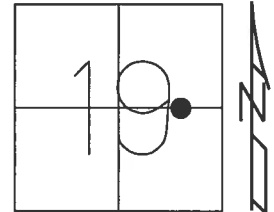

RECORD:
LG R.R.SPIKE
5-17-02, MB
SET P.K./WASHER
6-6-02, MB
FD P.K./WASHER
REFA9
4-13-2017, DCH
SET MAG/WASHER
08-14-2017, DCH

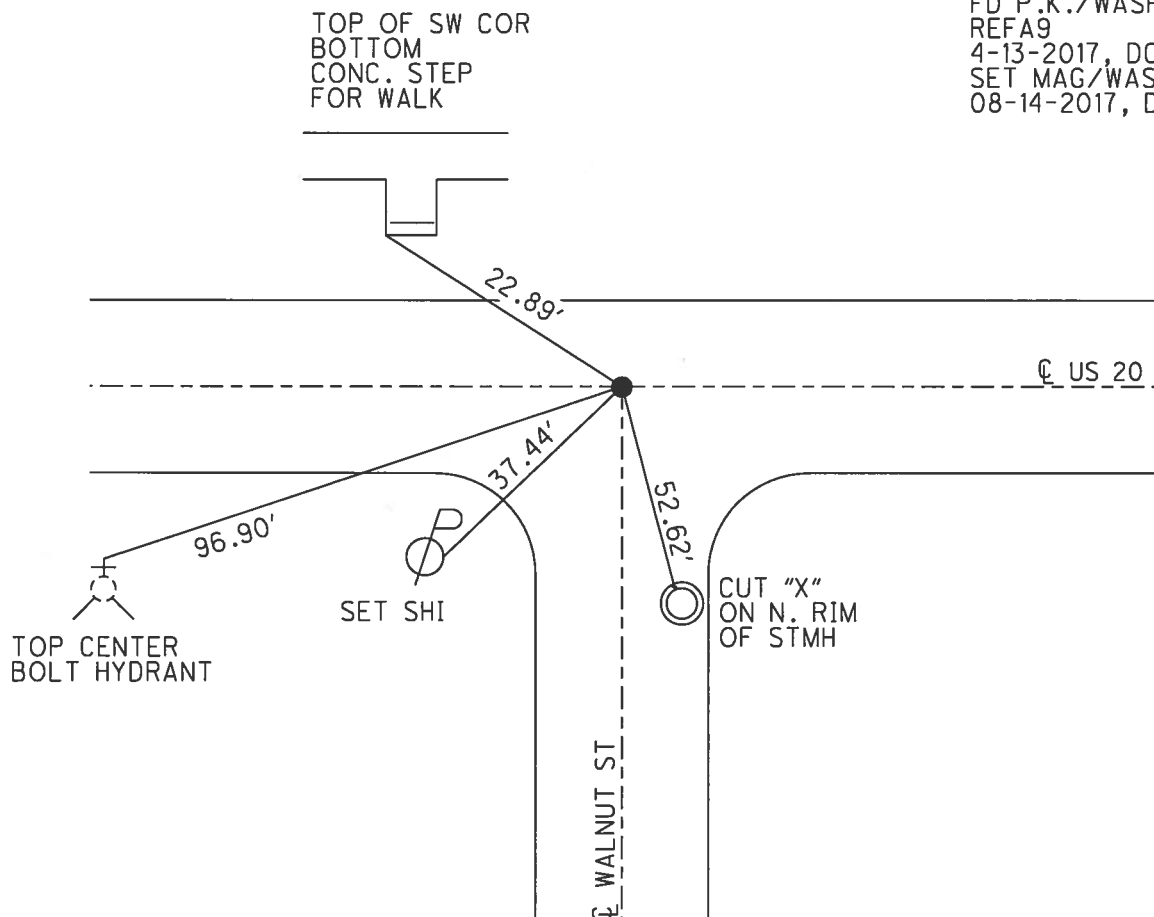

O.D.O.T. DISTRICT 2 SURVEY OFFICE (USE ONLY)

PERSONNEL

REFERENCE NO.

9 B

SHEET 14 OF 38

NOTES LEU

DATE 4/13/17

ROUTE US 20

H.C. HOMAN

WEATHER OVERCAST

COUNTY FULTON

R.C. LEU

TEMP. 48°F

TOWNSHIP GORHAM

SECTION 19

T 9 S R 1 E

TYPE MONUMENT 5/8" IPIN


~~ON SURFACE~~ - BELOW 6"

~~LEFT~~ - CL PAV'T - RIGHT 0.3', 1.9' W OF CL S


14.9 TO LT EDGE PAVEMENT

S.L.M. 199+53

Grid: Northing: 736412.126 Easting: 1467759.787

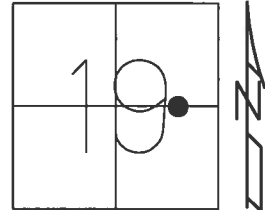

RECORD:
P.K. NAIL
5-17-02, MB
SET P.K./WASHER
6-6-02, MB
FD 5/8" I.PIN
LEANING NW
REFB9
4-13-2017, DCH
SET MAG/WASHER
08-14-2017, DCH

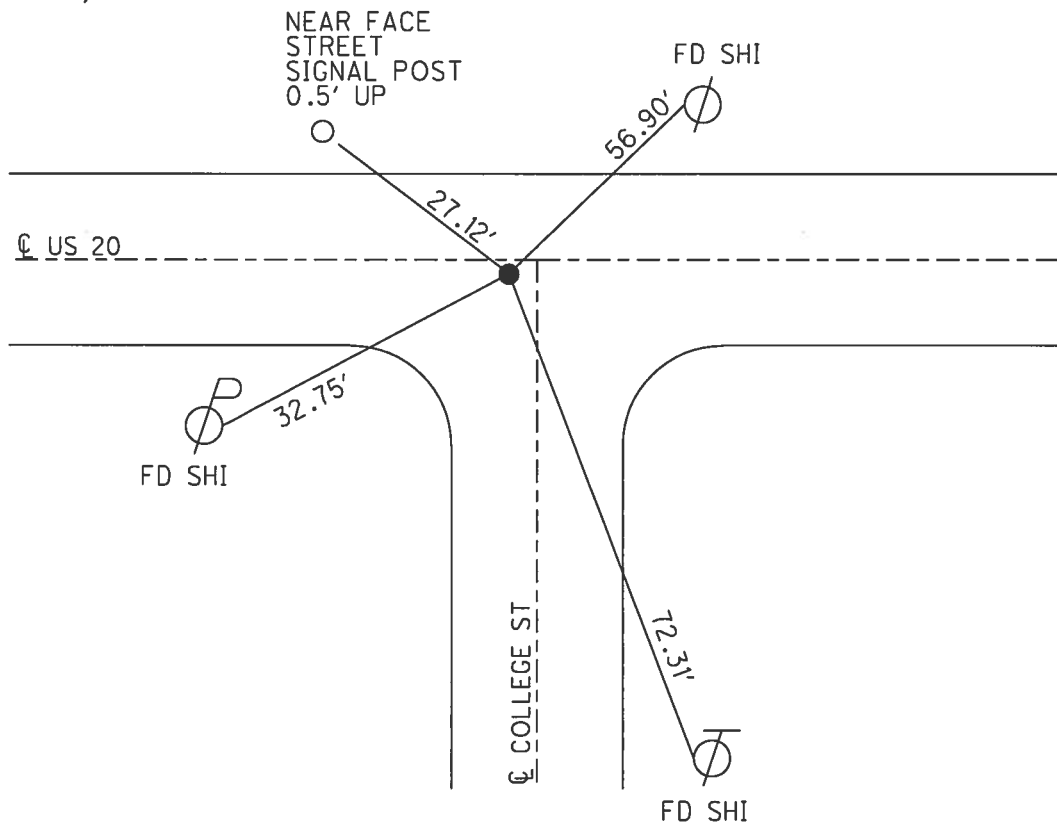


O.D.O.T. DISTRICT 2 SURVEY OFFICE (USE ONLY)


PERSONNEL _____ REFERENCE NO. 10 SHEET 15 OF 38
NOTES LEU DATE 4/13/17 ROUTE US 20
H.C. HOMAN WEATHER OVERCAST COUNTY FULTON
R.C. LEU TEMP. 48°F TOWNSHIP GORHAM
SECTION 19
T 9 S R 1 E

TYPE MONUMENT P.K./WASHER
ON SURFACE - ~~BELOW~~ ON
LEFT - CL PAV'T - RIGHT ON
15.3 TO RT EDGE PAVEMENT
S.L.M. 201+46

Grid: Northing: 736409.652 Easting: 1467953.901

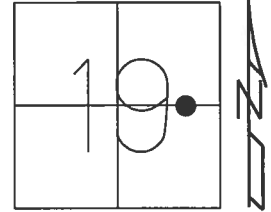

RECORD:
1/2" IPIPE
1 1/2" DOWN
7-24-91
FD 1/2" IPIPE
5-17-02, MB
SET P.K./WASHER
6-6-02, MB
FD P.K./WASHER
REF10
4-13-2017
SET MAG/WASHER
08-14-2017, DCH

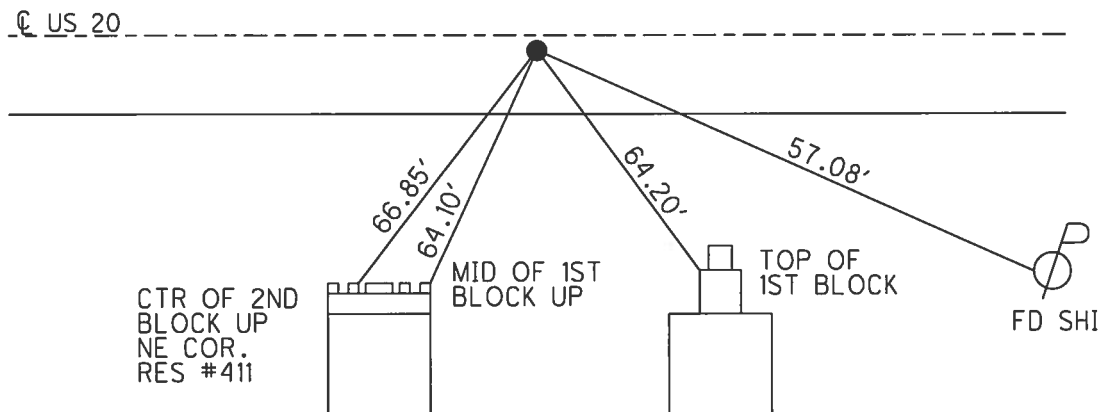


O.D.O.T. DISTRICT 2 SURVEY OFFICE (USE ONLY)


PERSONNEL _____ REFERENCE NO. 10 A SHEET 16 OF 38
NOTES LEU DATE 4/13/17 ROUTE US 20
H.C. HOMAN WEATHER OVERCAST COUNTY FULTON
R.C. LEU TEMP. 48°F TOWNSHIP GORHAM
SECTION 19
T 9 S R 1 E

TYPE MONUMENT P.K.NAIL
ON SURFACE - ~~BELOW~~ ON
LEFT - CL PAV'T - RIGHT ON
15.0 TO LT EDGE PAVEMENT
S.L.M. 205+12

Grid: Northing: 736405.036 Easting: 1468320.259

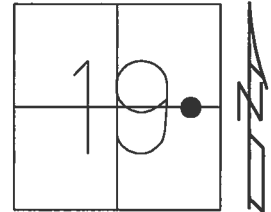

RECORD:
FD SM. R.R.SPIKE
5-17-02, MB
SET P.K./WASHER
6-6-02, MB
FD P.K.NAIL
REFA10
4-13-2017, DCH
SET MAG/WASHER
08-14-2017, DCH

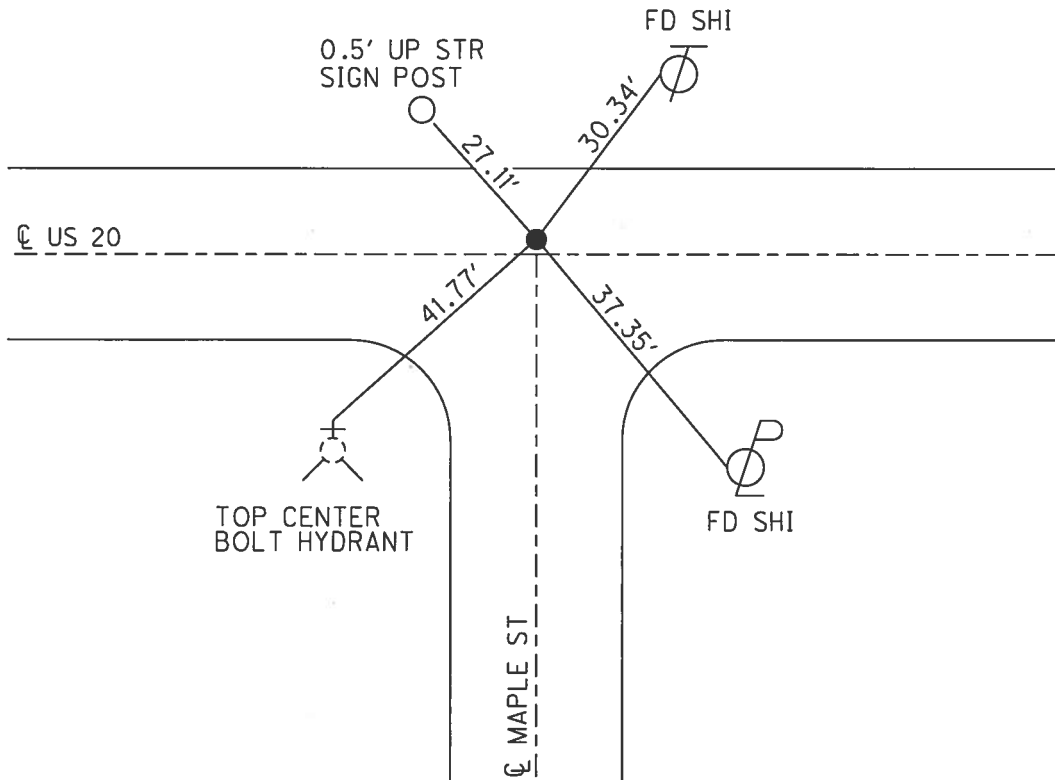

O.D.O.T. DISTRICT 2 SURVEY OFFICE (USE ONLY)

PERSONNEL _____ REFERENCE NO. 10 B SHEET 17 OF 38
 NOTES LEU DATE 4/13/17 ROUTE US 20
 H.C. HOMAN WEATHER OVERCAST COUNTY FULTON
 R.C. LEU TEMP. 48°F TOWNSHIP GORHAM
 SECTION 19
 T 9 S R 1 E

TYPE MONUMENT P.K.SHANK


~~ON SURFACE~~ - BELOW 1"

LEFT - ℄ PAV'T - ~~RIGHT~~ 0.3


- TO - EDGE PAVEMENT

S.L.M. 208+39

Grid: Northing: 736401.000 Easting: 1468644.388

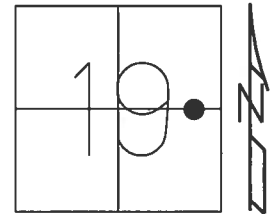

RECORD:
 FD P.K. NAIL
 5-17-02, MB
 SET P.K./WASHER
 6-6-02, MB
 FD P.K.SHANK
 REFBIO
 4-13-2017, DCH
 SET MAG/WASHER
 08-14-2017, DCH

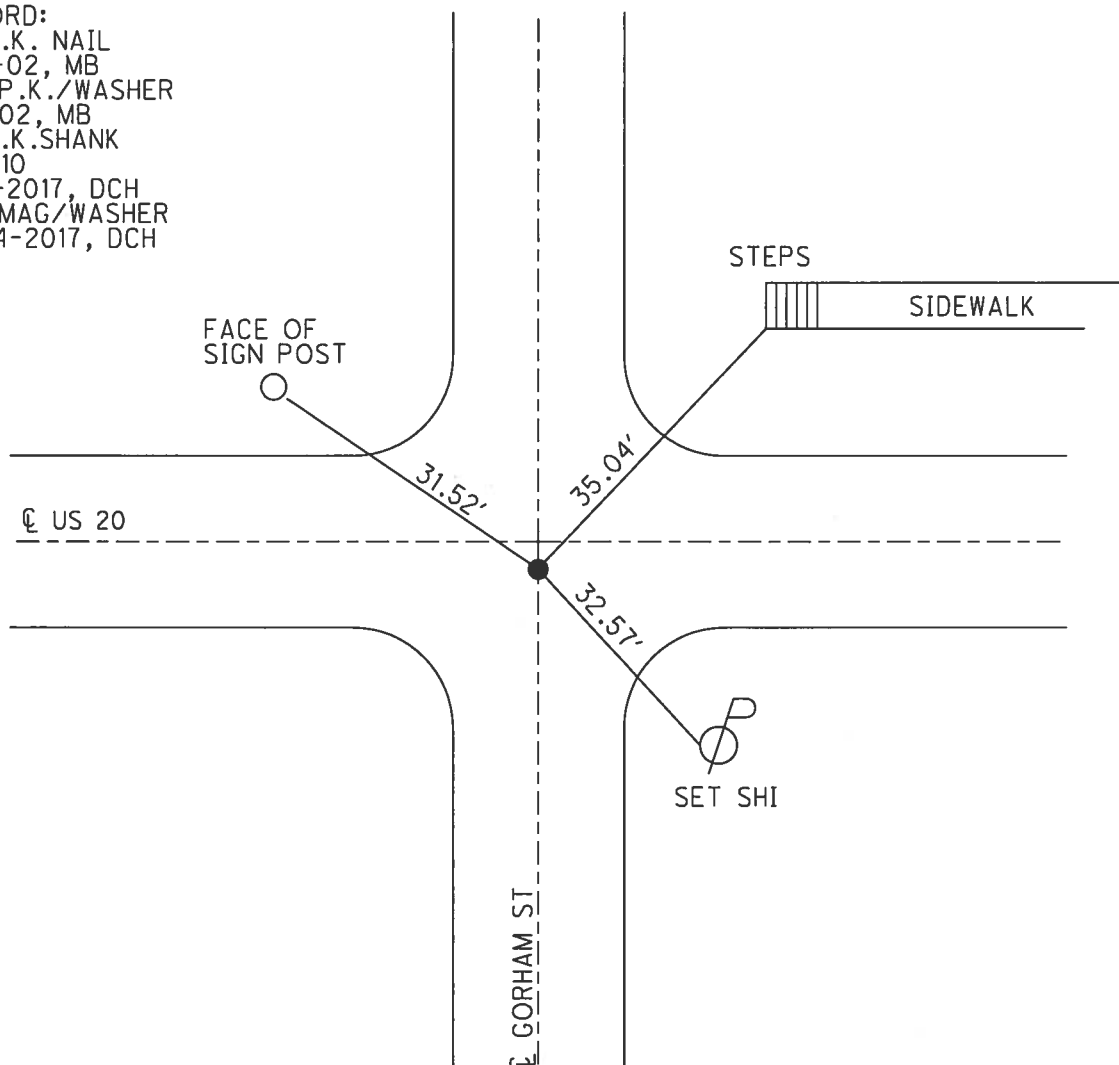

O.D.O.T. DISTRICT 2 SURVEY OFFICE (USE ONLY)

PERSONNEL _____ REFERENCE NO. 10 C SHEET 18 OF 38
NOTES LEU DATE 4/13/17 ROUTE US 20
H.C. HOMAN WEATHER OVERCAST COUNTY FULTON
R.C. LEU TEMP. 48°F TOWNSHIP GORHAM
SECTION 19
T 9 S R 1 E

TYPE MONUMENT MAG NAIL


~~ON SURFACE~~ - BELOW ON

LEFT - Q PAV'T - RIGHT ON

- TO - EDGE PAVEMENT


S.L.M. 214+86

Grid: Northing: 736392.803 Easting: 1469290.002

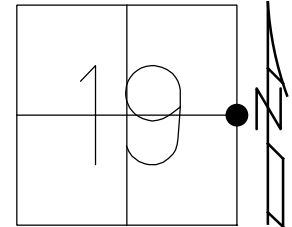

RECORD:
FD SM.R.R.SPIKE
5-17-02, MB
SET P.K./WASHER
6-6-02, MB
FD MAG NAIL
REFC10
4-13-2014, DCH
FD MAG NAIL
REF30
12/2/16, JFO
SET MAG/WASHER
8-14-17, DCH

NOTE: REF 30 SR 66

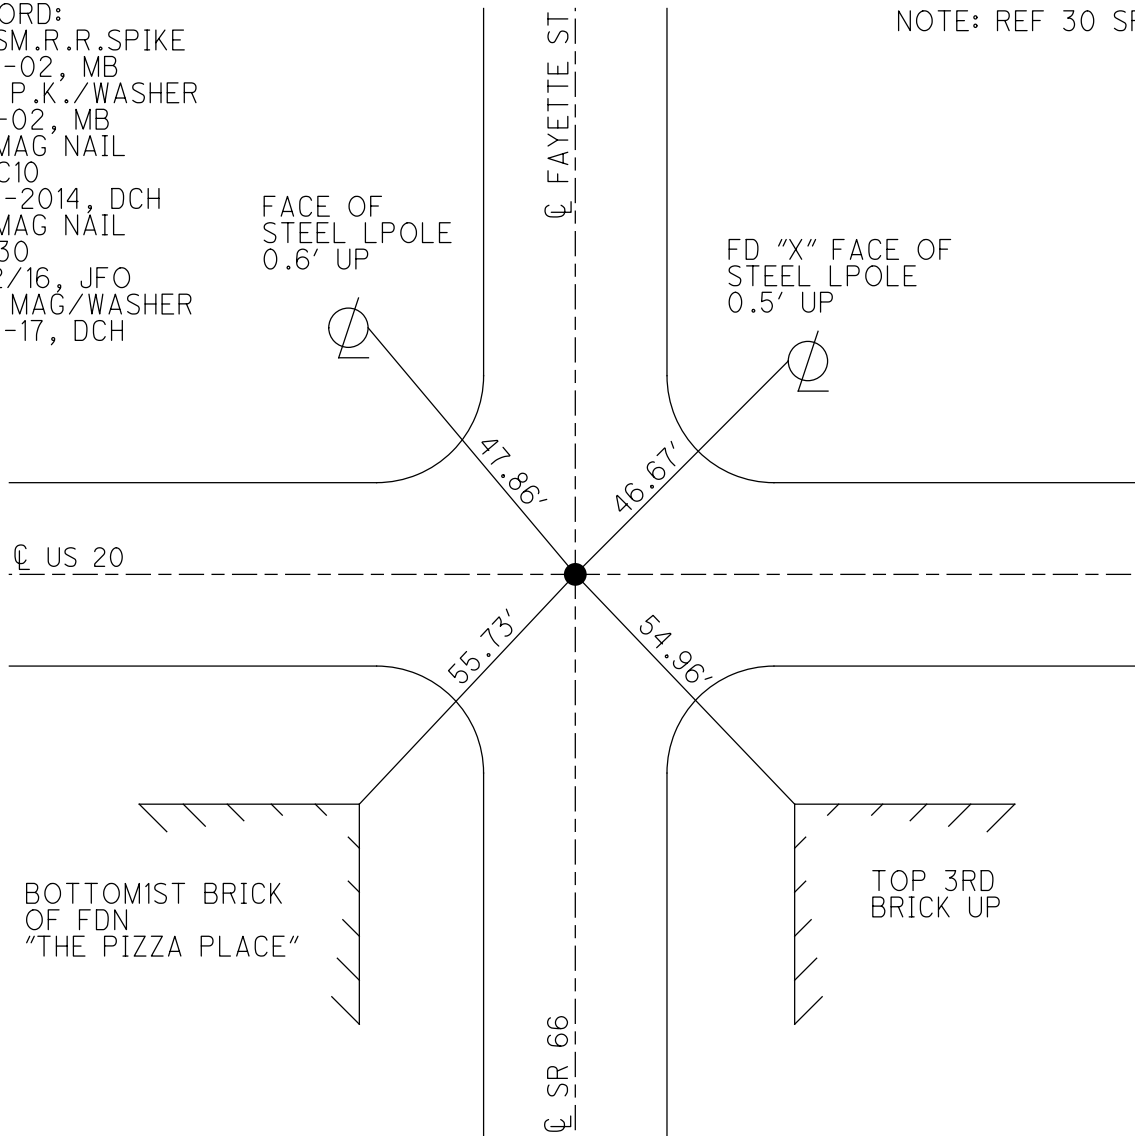


O.D.O.T. DISTRICT 2 SURVEY OFFICE (USE ONLY)


PERSONNEL _____ REFERENCE NO. 11 SHEET 19 OF 38
 NOTES LEU DATE 4/17/17 ROUTE US 20
 H.C. HOMAN WEATHER SUNNY COUNTY FULTON
 R.C. LEU TEMP. 65°F TOWNSHIP GORHAM
 SECTION 20
 T 9 S R 1 E

TYPE MONUMENT SM.R.R.SPIKE
~~ON SURFACE~~ - BELOW 3"
 LEFT - ℄ PAV'T - RIGHT ON
- TO - EDGE PAVEMENT
 S.L.M. 234+53

Grid: Northing: 736408.264 Easting: 1470629.132

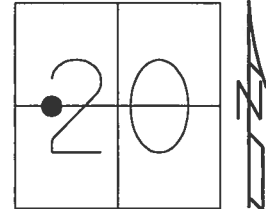

RECORD:
 FD R.R. SPIKE
 2" DOWN
 SET P.K./WASHER
 8-16-91, IRS
 FD SM.R.R.SPIKE
 REF11
 4-17-2017, DCH
 SET MAG/WASHER
 08-14-2017, DCH

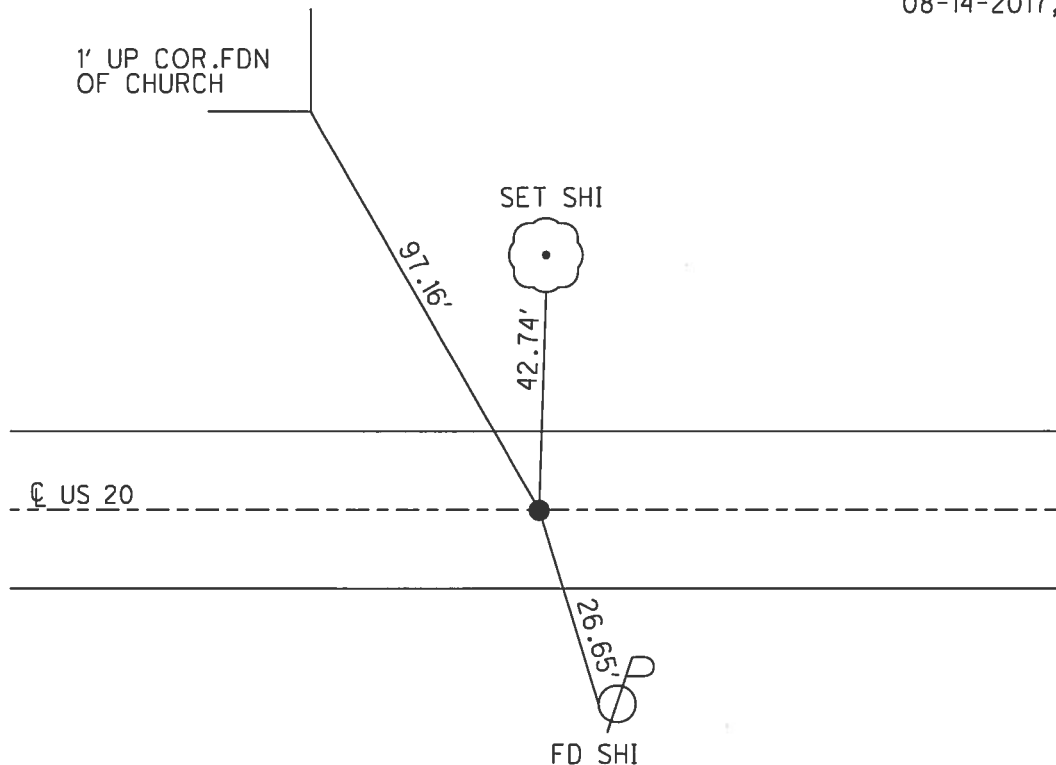


O.D.O.T. DISTRICT 2 SURVEY OFFICE (USE ONLY)


PERSONNEL _____ REFERENCE NO. 11 A SHEET 20 OF 38
NOTES LEU DATE 4/17/17 ROUTE US 20
H.C. HOMAN WEATHER SUNNY COUNTY FULTON
R.C. LEU TEMP. 65°F TOWNSHIP GORHAM
SECTION 20
T 9 S R 1 E

TYPE MONUMENT MONBOX
ON SURFACE - ~~BELOW~~ ON
LEFT - ℄ PAV'T - RIGHT ON
- TO - EDGE PAVEMENT
S.L.M. 247+88

Grid: Northing: 736419.472 Easting: 1471965.077

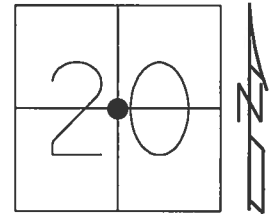

RECORD:
FD MONBOX W/"+"
4/17/17, DCH
SET PUNCH ON LID
0.06' S. OF "X"
0.10' W. OF "X"
REFA11
08-14-2017, DCH

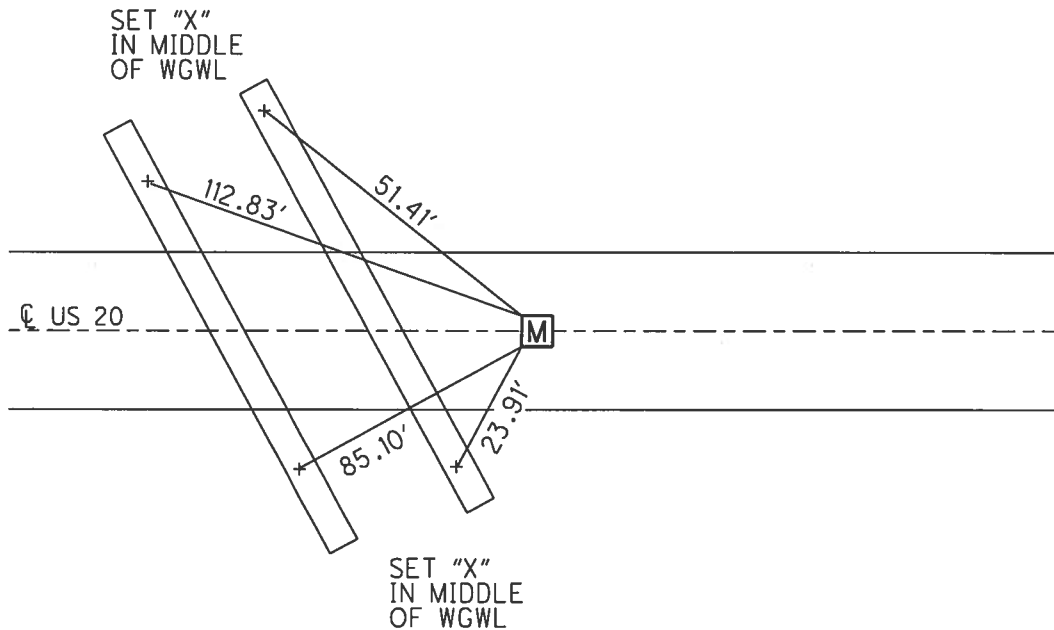


O.D.O.T. DISTRICT 2 SURVEY OFFICE (USE ONLY)


PERSONNEL _____ REFERENCE NO. 12 SHEET 21 OF 38
NOTES LEU DATE 4/17/17 ROUTE US 20
H.C. HOMAN WEATHER SUNNY COUNTY FULTON
R.C. LEU TEMP. 65°F TOWNSHIP GORHAM
SECTION 20
T 9 S R 1 E

TYPE MONUMENT MON BOX
ON SURFACE - ~~BELOW~~ ON
LEFT - ℄ PAV'T - RIGHT ON
- TO - EDGE PAVEMENT
S.L.M. 275+04

Grid: Northing: 736454.338 Easting: 1474680.796

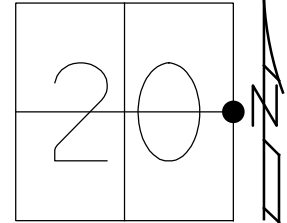

RECORD:
FD MONBOX
W/PUNCH ON LID
REF12
08-14-2017, DCH
FD "+" CUT ON LID
REF12
7-28-20, JFO

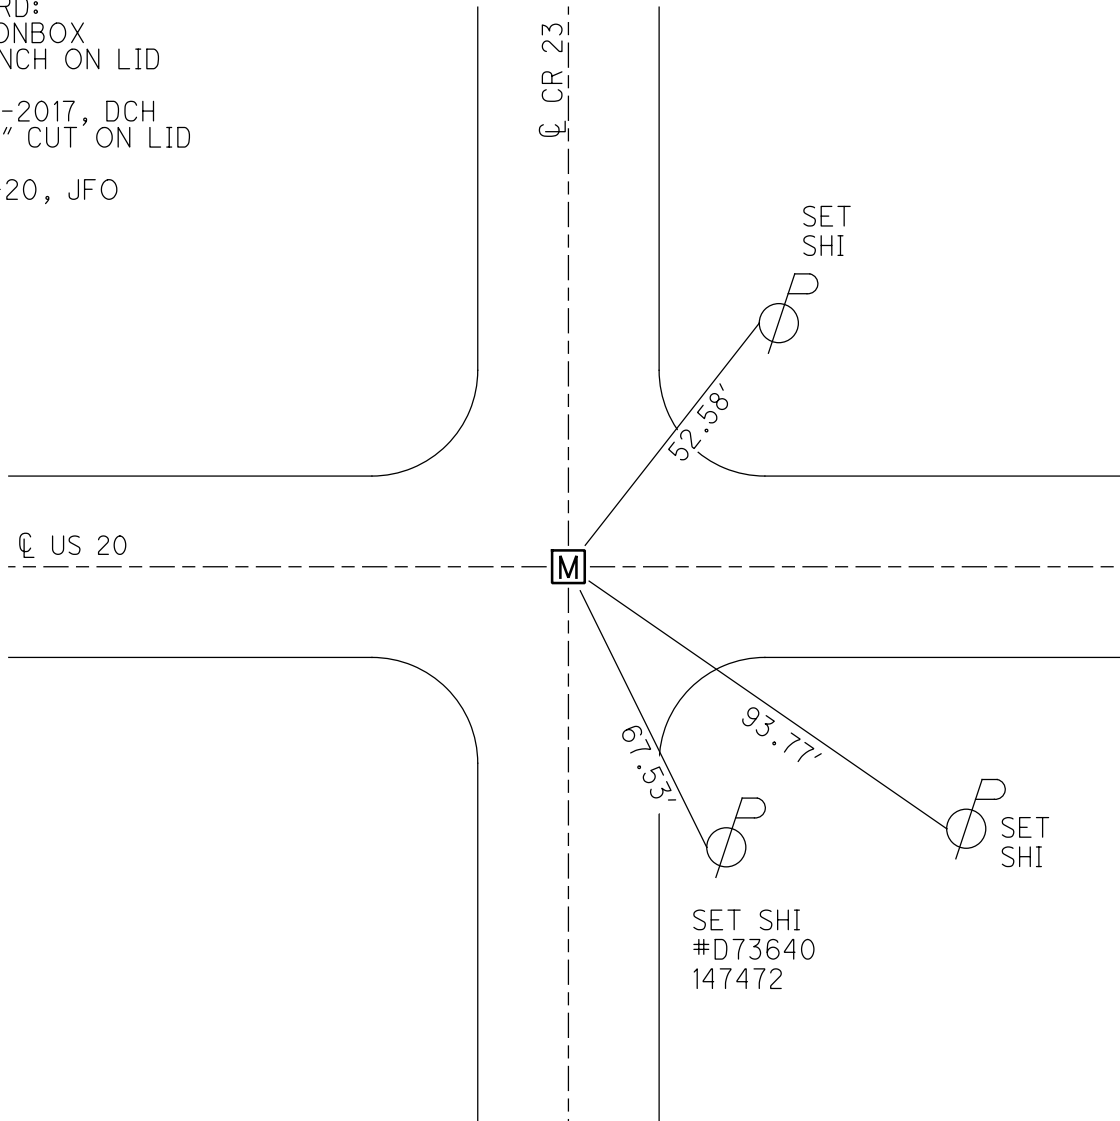


O.D.O.T. DISTRICT 2 SURVEY OFFICE (USE ONLY)


PERSONNEL _____ REFERENCE NO. 13 SHEET 22 OF 38
NOTES LEU DATE 4/17/17 ROUTE US 20
H.C. HOMAN WEATHER SUNNY COUNTY FULTON
R.C. LEU TEMP. 70°F TOWNSHIP GORHAM
SECTION 21
T 9 S R 1 E

TYPE MONUMENT SM.R.R.SPIKE
ON SURFACE - ~~BELOW~~ ON
LEFT - ℄ PAV'T - RIGHT ON
- TO - EDGE PAVEMENT
S.L.M. 301+43

Grid: Northing: 736463.771 Easting: 1477314.768

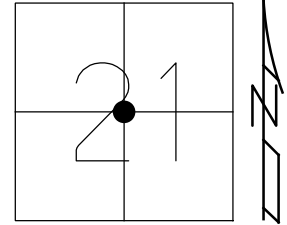

RECORD:
FD 1" IPIPE
6-18-90, IRS
SET SM.R.R.SPIKE
8-9-90, IRS
FD SM.R.R.SPIKE
REF13
4-17-2017, DCH
SET MAG/WASHER
8-15-17, DCH
FD MAG NAIL
REF13
7-28-20, JFO

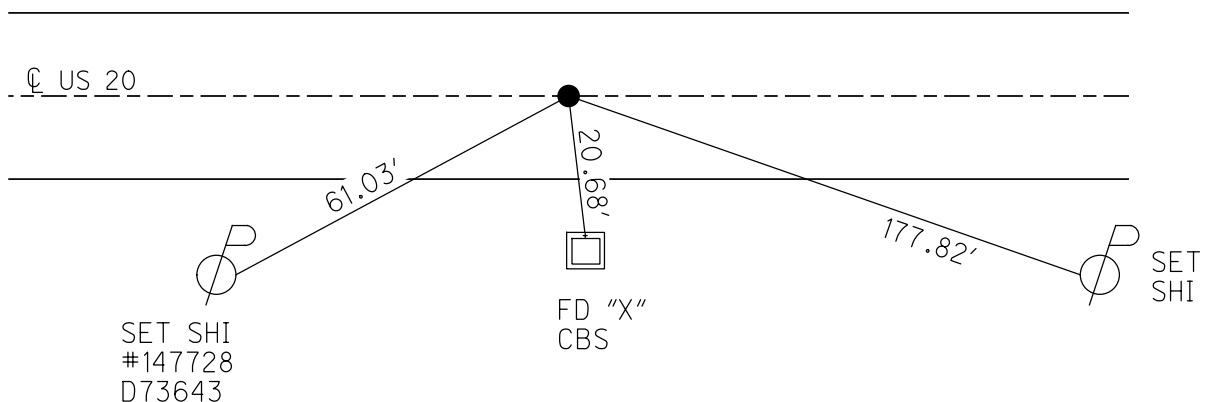

O.D.O.T. DISTRICT 2 SURVEY OFFICE (USE ONLY)

PERSONNEL

REFERENCE NO.

14

SHEET

23

OF 38

NOTES

LEU

DATE

4/17/17

ROUTE

US 20

H.C.

HOMAN

WEATHER

SUNNY

COUNTY

FULTON

R.C.

LEU

TEMP.

70°F

TOWNSHIP

GORHAM

SECTION

21

T 9 S R 1 E

TYPE MONUMENT

SM.R.R.SPIKE

ON SURFACE - ~~BELOW~~

ON

LEFT - ~~C~~ PAV'T - ~~RIGHT~~ 1.5'

- TO - EDGE PAVEMENT

S.L.M.


327+79

Grid: Northing:

736481.843

Easting:

1479951.107

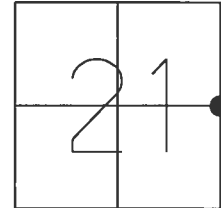

RECORD:

FD R.R.SPIKE

6-18-90, IRS

SET SM.R.R.SPIKE

8-9-90, IRS


FD SM.R.R.SPIKE

REF14

4-17-2017, DCH

SET MAG/WASHER

8-15-17, DCH

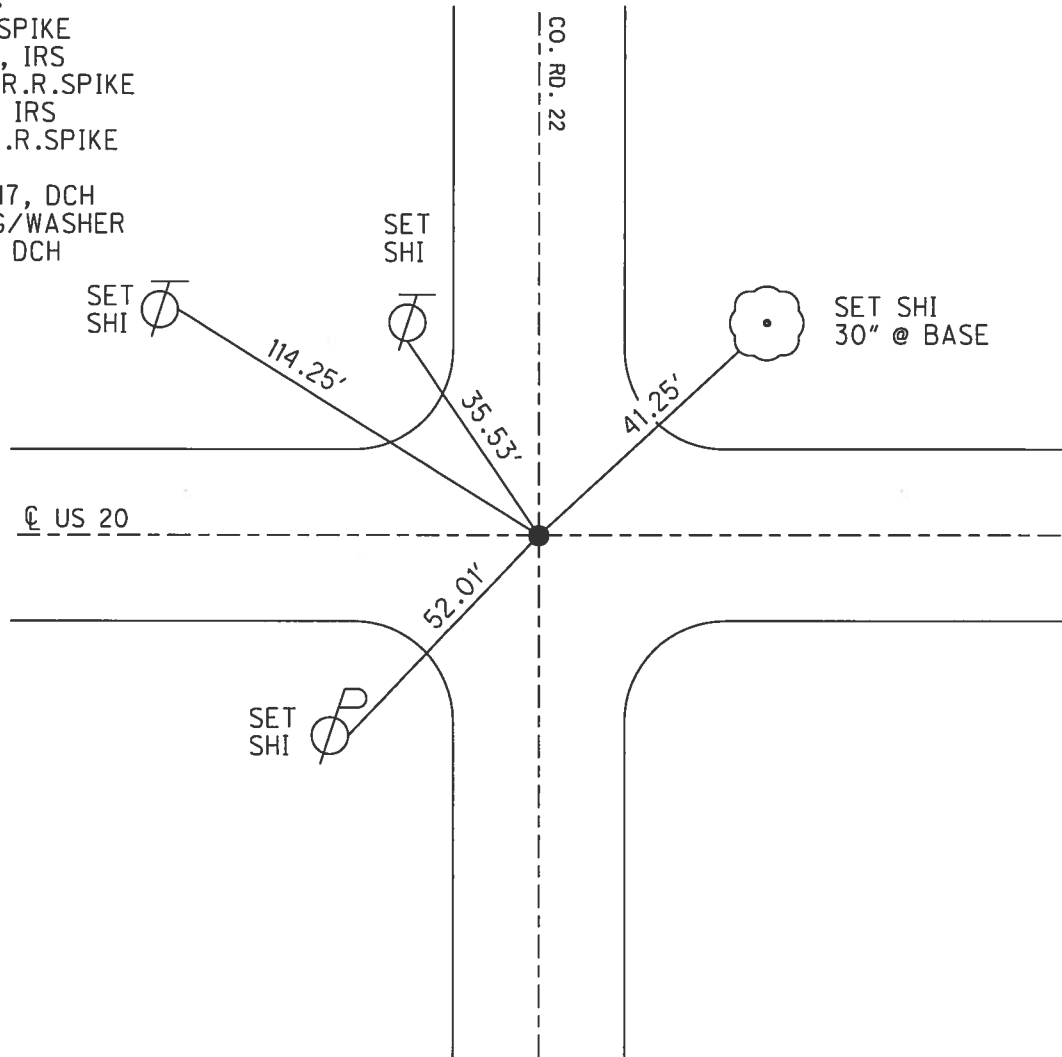

O.D.O.T. DISTRICT 2 SURVEY OFFICE (USE ONLY)

PERSONNEL

REFERENCE NO. 15

SHEET 24 OF 38

NOTES LEU

DATE 4/17/17

ROUTE US 20

H.C. HOMAN

WEATHER SUNNY

COUNTY FULTON

R.C. LEU

TEMP. 70°F

TOWNSHIP GORHAM

SECTION 22

T 9 S R 1 E

TYPE MONUMENT SM.R.R.SPIKE


ON SURFACE - ~~BELOW~~ ON

LEFT - CL PAV'T - ~~RIGHT~~ 0.8'

- TO - EDGE PAVEMENT

S.L.M. 354+09


Grid: Northing: 736410.029 Easting: 1482580.832

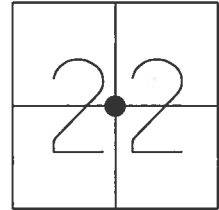

RECORD:

FD 1" IPIPE
6-18-90, IRS
SET SM.R.R.SPIKE
8-9-90, IRS
FD SM.R.R.SPIKE
REF15
4-17-2017, DCH
SET MAG/WASHER
8-15-17, DCH

DIST. 15-15A= 7.97'

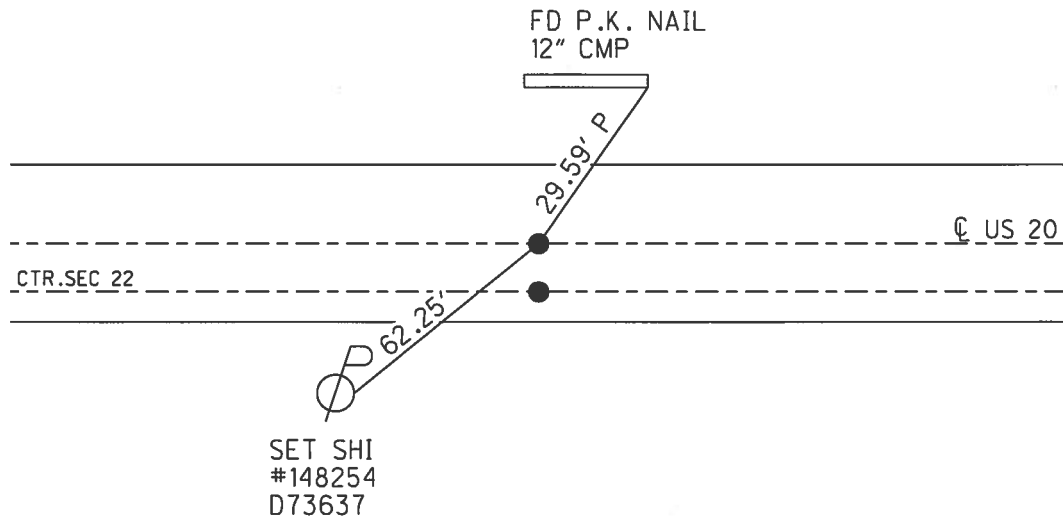


O.D.O.T. DISTRICT 2 SURVEY OFFICE (USE ONLY)

PERSONNEL	REFERENCE NO.	<u>15 A</u>	SHEET	<u>25</u>	OF	<u>38</u>
NOTES	DATE	<u>4/17/17</u>	ROUTE	<u>US 20</u>		
H.C.	WEATHER	<u>SUNNY</u>	COUNTY	<u>FULTON</u>		
R.C.	TEMP.	<u>70°F</u>	TOWNSHIP	<u>GORHAM</u>		
			SECTION	<u>22</u>		
			T	<u>9</u>	S	R
				<u>1</u>	E	

TYPE MONUMENT SM.R.R.SPIKE
ON SURFACE - ~~BELOW~~ ON
~~LEFT~~ - ℄ PAV'T - RIGHT 7.2'
- TO - EDGE PAVEMENT
S.L.M. 354+09


Grid: Northing: 736402.085 Easting: 1482580.819

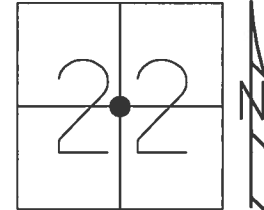

RECORD:
FD 1" IPIPE
6-18-90, IRS
SET SM.R.R.SPIKE
8-9-90, IRS
FD SM.R.R.SPIKE
REFA15
4-17-2017, DCH
SET MAG/WASHER
8-15-17, DCH

DIST. 15-15A= 7.97'

36.25' P

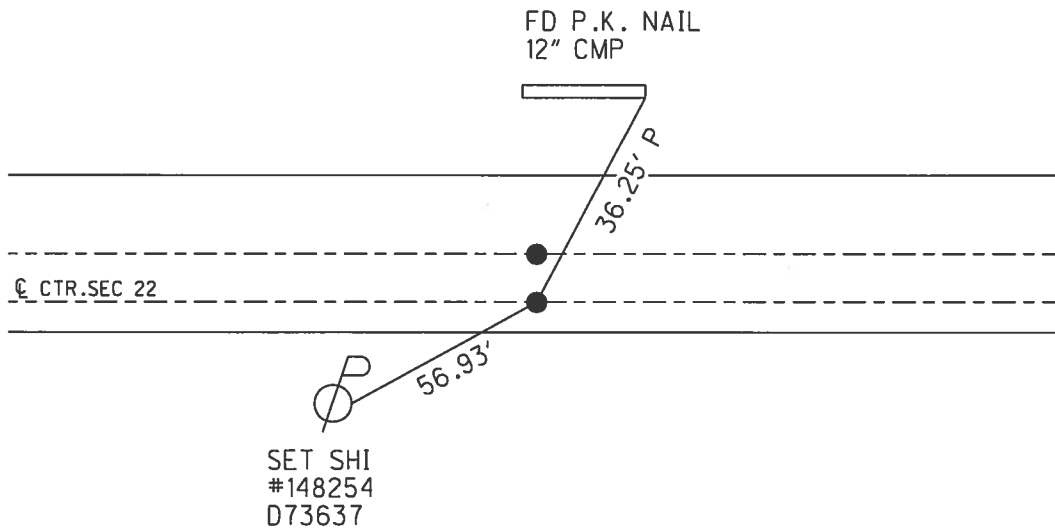


O.D.O.T. DISTRICT 2 SURVEY OFFICE (USE ONLY)


PERSONNEL	REFERENCE NO. <u>16</u>	SHEET <u>26</u> OF <u>38</u>
NOTES <u>LEU</u>	DATE <u>4/17/17</u>	ROUTE <u>US 20</u>
H.C. <u>HOMAN</u>	WEATHER <u>SUNNY</u>	COUNTY <u>FULTON</u>
R.C. <u>LEU</u>	TEMP. <u>70°F</u>	TOWNSHIP <u>GORHAM</u>
		SECTION <u>22</u>
		T <u>9</u> S R <u>1</u> E

TYPE MONUMENT 1" IPIPE
~~ON SURFACE~~ - BELOW 5 1/2"
~~LEFT~~ - ℄ PAV'T - RIGHT 12.8'
1.7' TO RT EDGE PAVEMENT
 S.L.M. 379+21

Grid: Northing: 736322.455 Easting: 1485208.971

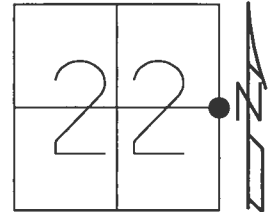

RECORD: P.I.
 FD 1" IPIPE
 3" DOWN
 SET SM.R.R.SPIKE
 11-05-84
 FD SM.R.R.SPIKE
 5-7-98, HUSS
 SET P.K./WASHER
 11-13-98, SAH
 FD 1" IPIPE
 REF16
 4-17-2017, DCH
 SET MAG/WASHER
 8-14-2017, DCH

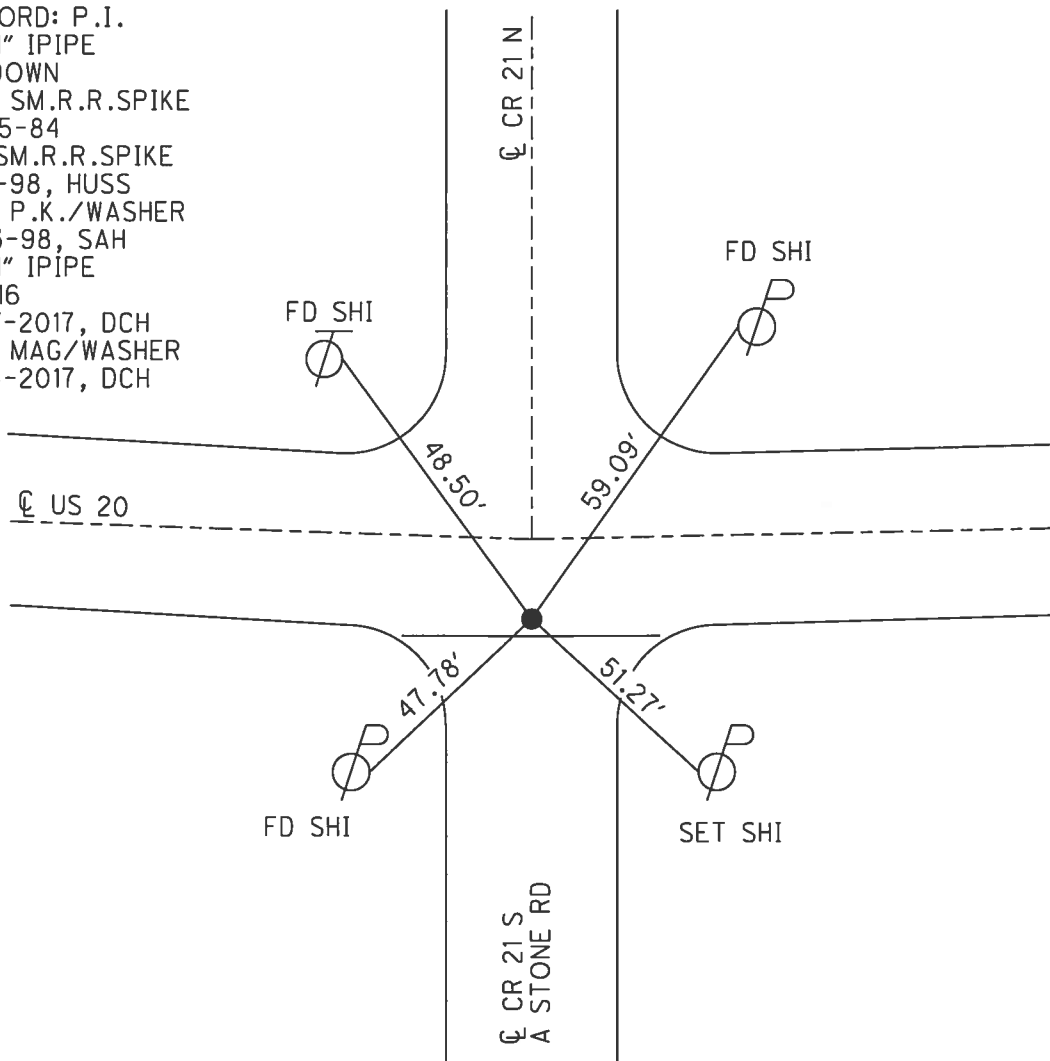


O.D.O.T. DISTRICT 2 SURVEY OFFICE (USE ONLY)


PERSONNEL _____ REFERENCE NO. 16 A SHEET 27 OF 38
NOTES LEU DATE 4/18/17 ROUTE US 20
H.C. HOMAN WEATHER SUNNY COUNTY FULTON
R.C. LEU TEMP. 44°F TOWNSHIP GORHAM
SECTION 23
T 9 S R 1 E

TYPE MONUMENT SM.R.R.SPIKE
~~ON SURFACE~~ - BELOW 3 1/2"
LEFT - C PAV'T - RIGHT 1.5'
9.7 TO LT EDGE PAVEMENT
S.L.M. 388+36

Grid: Northing: 736583.996 Easting: 1486086.911

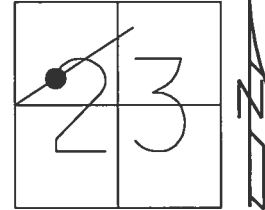

RECORD: P.I.
FD SM.R.R.SPIKE
2" DEEP
SET P.K./WASHER
11-05-84, IRS
P.K.NAIL
5-7-98, SAH
SET P.K./WASHER
11-13-98
FD SM.R.R.SPIKE
REFA16
4-17-2017, DCH
SET MAG/WASHER
8-15-2017, DCH

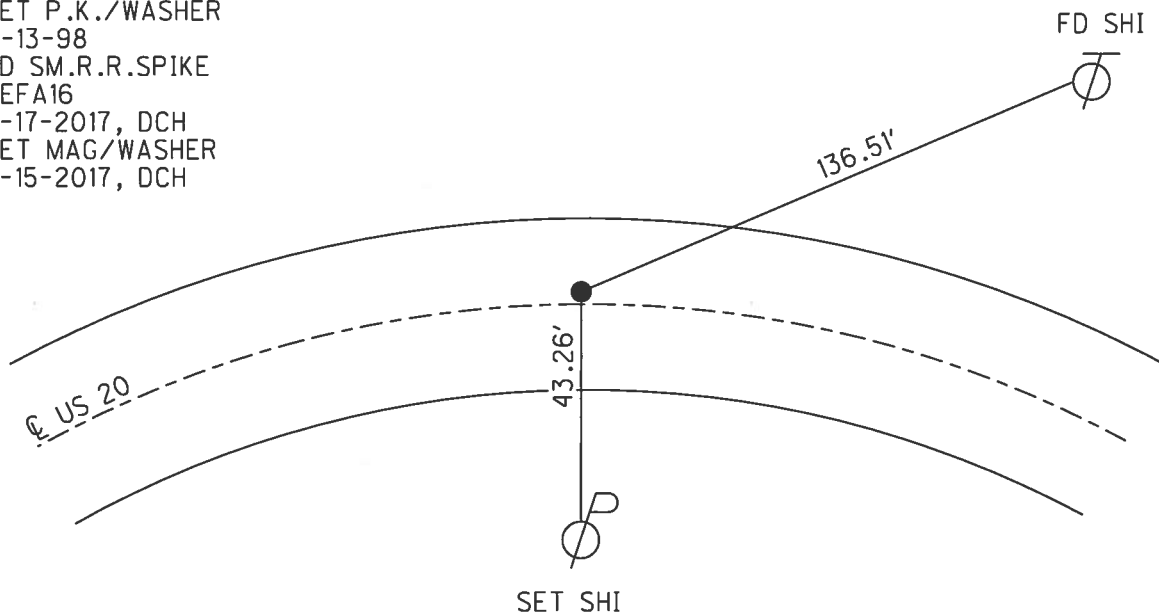

O.D.O.T. DISTRICT 2 SURVEY OFFICE (USE ONLY)

PERSONNEL _____ REFERENCE NO. 16 B SHEET 28 OF 38
NOTES LEU DATE 4/18/17 ROUTE US 20
H.C. HOMAN WEATHER SUNNY COUNTY FULTON
R.C. LEU TEMP. 44°F TOWNSHIP GORHAM
SECTION 23
T 9 S R 1 E

TYPE MONUMENT CMON W/IPIN


~~ON SURFACE~~ - BELOW 3 1/2"

LEFT - ℄ PAV'T - RIGHT -


- TO - EDGE PAVEMENT

S.L.M. 389+14

Grid: Northing: 737668.537 Easting: 1490241.780

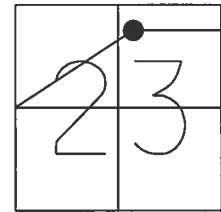

RECORD:
FD CMON W/IPIN
3 1/2" DOWN
REFB16
4/18/17, DCH

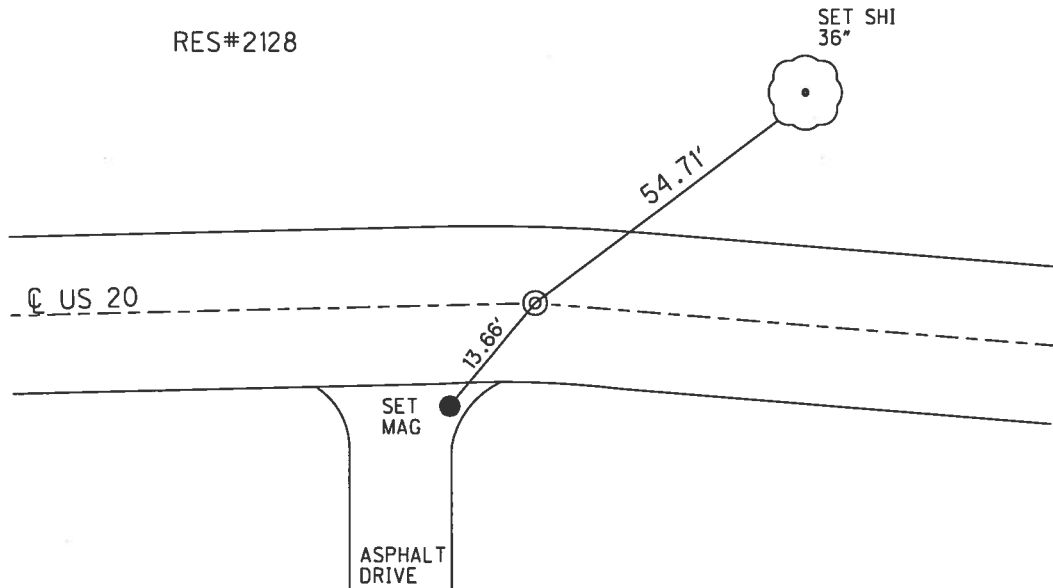

PERSONNEL

SHEET _____ OF _____

ROUTE	US 20
COUNTY	FULTON
TOWNSHIP	GORHAM
SECTION	24

T_9_S R_1_E

ON SURFACE - BELOW ON


_____TO_____EDGE PAVEMENT

STATION: 435+90

HORZ.DATUM: NAD83-2011/FUL LDP GEOID: 18

GRID: NORTHING: 737653.383 EASTING: 1490735.381

LDP: NORTHING: 393027.710 EASTING: 136997.198

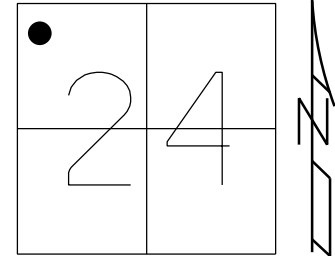

The diagram is a site plan of the intersection of US 20 and CR 20. A central point is marked with a square containing the letter 'M'. A dashed line labeled 'US 20' runs horizontally through the center, and a dashed line labeled 'CR 20' runs vertically through the center. A label '4' STRATTLERS' is placed near the intersection. Several points are marked with circles and labeled 'FD SHI'. One point is labeled 'SET SHI'. Distances and angles are provided for several points: 97.32' P, 66.71', 73.30', 92.96', 74.37' P, and 71.06'. A small 'x' marks a point labeled 'FD SHI FEN POST'.

O.D.O.T. DISTRICT 2 SURVEY OFFICE (USE ONLY)

PERSONNEL	REFERENCE NO.	17 A	SHEET	30	OF	38
NOTES	LEU	DATE	4/18/17	ROUTE	US 20	
H.C.	HOMAN	WEATHER	SUNNY	COUNTY	FULTON	
R.C.	LEU	TEMP.	50°F	TOWNSHIP	GORHAM	
				SECTION	24	
				T	9	S
				R	1	E

TYPE MONUMENT 1" IPIPE


~~ON SURFACE~~ - BELOW 4"

~~LEFT~~ - Q PAV'T - RIGHT 1.3'


9.4' TO RT EDGE PAVEMENT

S.L.M. 449+29

Grid: Northing: 737612.544 Easting: 1492068.510

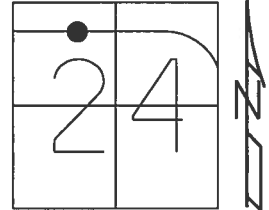


RECORD:
FD 1" IPIPE
2" DEEP
11-05-84
FD SM.R.R.SPIKE
5-8-98, SAH
FD 1" IPIPE
REFA17
4-18-2017, DCH
SET MAG/WASHER
8-15-2017, DCH

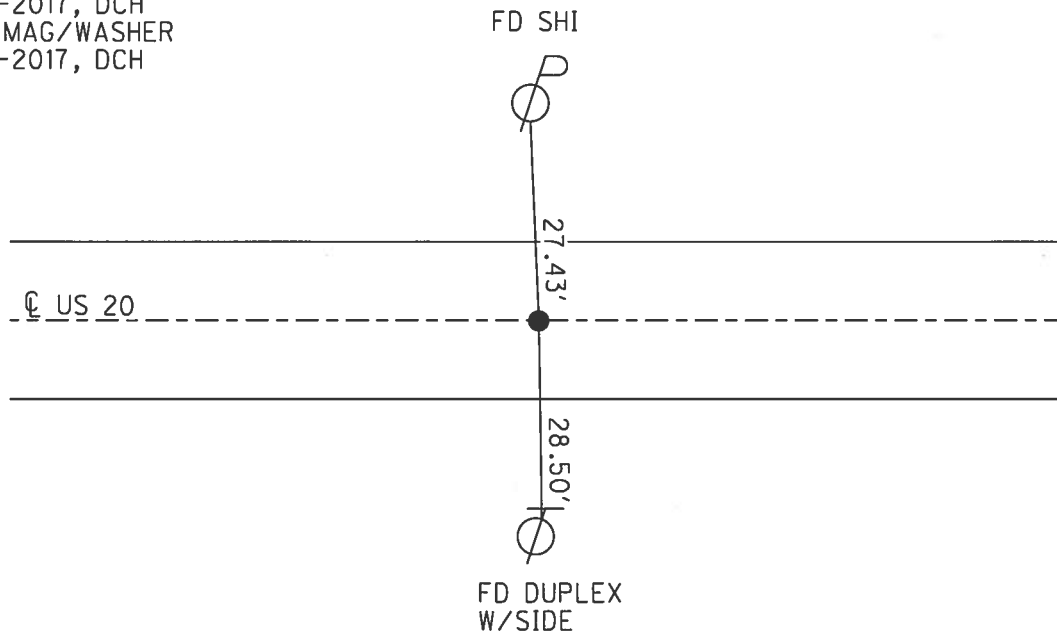

O.D.O.T. DISTRICT 2 SURVEY OFFICE (USE ONLY)


PERSONNEL	REFERENCE NO.	<u>18</u>	SHEET	<u>31</u>	OF	<u>38</u>
NOTES	DATE	<u>4/18/17</u>	ROUTE	<u>US 20</u>		
H.C.	WEATHER	<u>SUNNY</u>	COUNTY	<u>FULTON</u>		
R.C.	TEMP.	<u>50°F</u>	TOWNSHIP	<u>GORHAM</u>		
			SECTION	<u>24</u>		
			T	<u>9</u>	S	R
				<u>1</u>	E	

TYPE MONUMENT P.K.NAIL
~~ON SURFACE~~ - BELOW ON
~~LEFT - C~~ PAV'T - ~~RIGHT~~ ON
- TO - EDGE PAVEMENT
S.L.M. 462+66

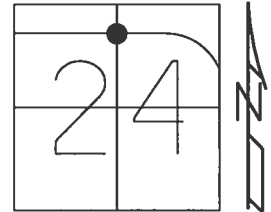

Grid: Northing: 737618.100 Easting: 1493398.711

RECORD:
FD 1" IPIPE
2" DEEP
11-05-84
FD MAG NAIL
5-8-98, SAH
SET P.K./WASHER
11-13-98, SAH
FD P.K.NAIL
REF18
4-18-2017, DCH
SET MAG/WASHER
8-15-2017, DCH

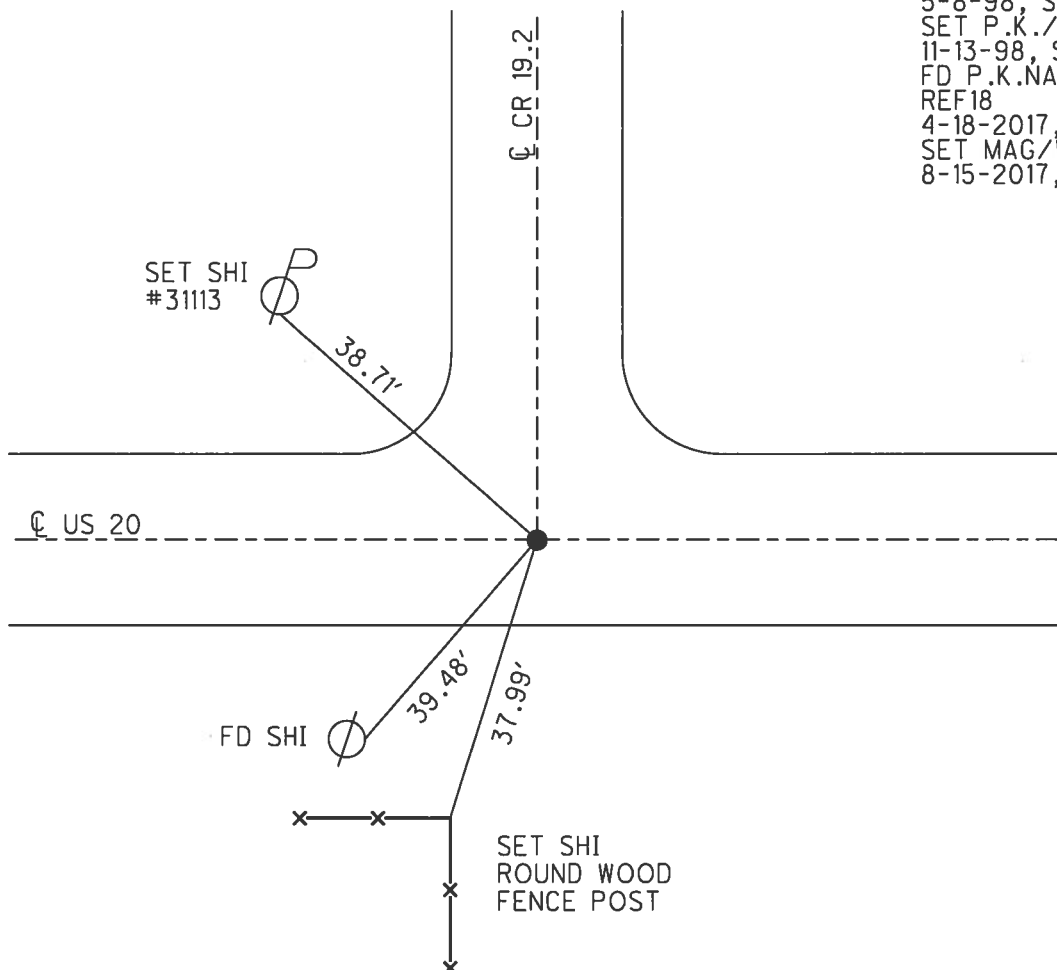

O.D.O.T. DISTRICT 2 SURVEY OFFICE (USE ONLY)

PERSONNEL

REFERENCE NO.

19

SHEET 32 OF 38

NOTES LEU

DATE 4/18/17

ROUTE US 20

H.C. HOMAN

WEATHER SUNNY

COUNTY FULTON

R.C. LEU

TEMP. 55°F

TOWNSHIP GORHAM

SECTION 24

T 9 S R 1 E

TYPE MONUMENT 1" IPIPE


~~ON SURFACE~~ - BELOW 3 1/2"

LEFT - ℄ PAV'T - ~~RIGHT~~ 0.2


11.0 TO LT EDGE PAVEMENT

S.L.M. 477+47

Grid: Northing: 737602.311 Easting: 1494872.569

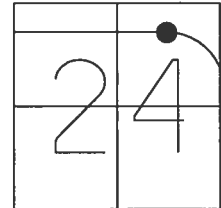

RECORD: P.C.
1934 STA.177+32.24
FD 1" IPIPE
2" DOWN
STA.STA 477+76
7-24-84, IRS
FD SM.R.R.SPIKE
5-8-98, SAH
SET P.K./WASHER
11-16-98, SAH
FD 1" IPIPE
REF19
4-18-2017, DCH
SET MAG/WASHER
8-15-2017, DCH

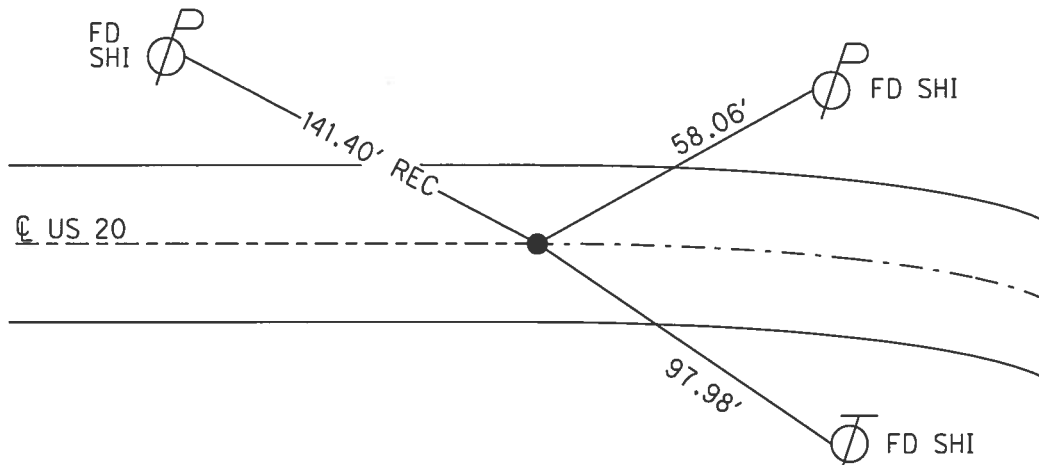


O.D.O.T. DISTRICT 2 SURVEY OFFICE (USE ONLY)

PERSONNEL	REFERENCE NO. <u>20</u>	SHEET <u>33</u> OF <u>38</u>
NOTES <u>LEU</u>	DATE <u>4/18/17</u>	ROUTE <u>US 20</u>
H.C. <u>HOMAN</u>	WEATHER <u>SUNNY</u>	COUNTY <u>FULTON</u>
R.C. <u>LEU</u>	TEMP. <u>55°F</u>	TOWNSHIP <u>GORHAM</u>
		SECTION <u>24</u>
		T <u>9</u> S R <u>1</u> E


TYPE MONUMENT P.K.NAIL
 ON SURFACE - ~~BELOW~~ ON
 LEFT - ℄ PAV'T - ~~RIGHT~~ 0.8'
11.3 TO LT EDGE PAVEMENT
 S.L.M. 494+00

Grid: Northing: 736559.353 Easting: 1495902.819

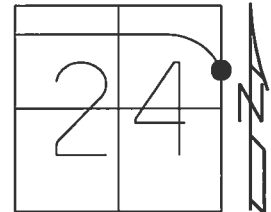

RECORD: P.T.
 SET P.K.NAIL
 1934 STA 193+57.69
 SLM STA 494+01.45
 FD P.K.NAIL
 5-8-98, SAH
 SET P.K./WASHER
 11-16-98, SAH
 SET MAG/WASHER
 8-16-2017, DCH

DIST. 20-21= 197.14'

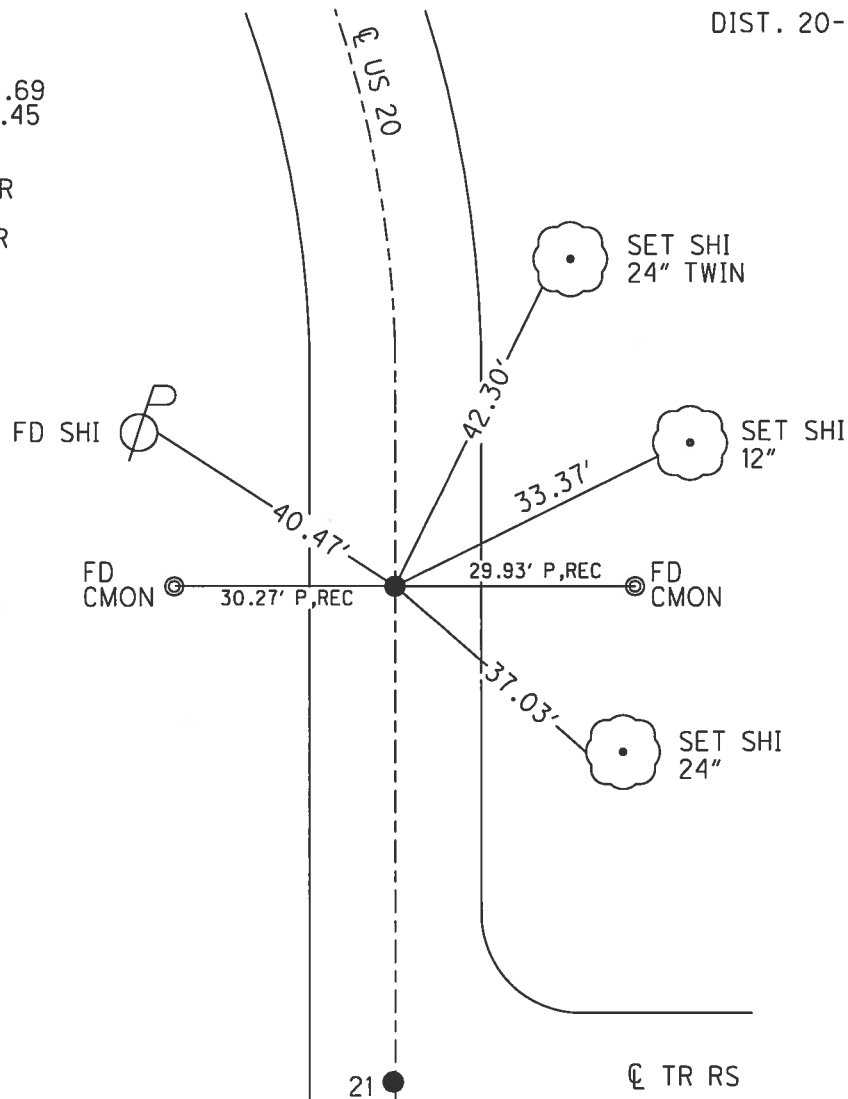


O.D.O.T. DISTRICT 2 SURVEY OFFICE (USE ONLY)

PERSONNEL	REFERENCE NO.	<u>21</u>	SHEET	<u>34</u>	OF	<u>38</u>
NOTES	LEU	DATE	<u>4/18/17</u>	ROUTE	<u>US 20</u>	
H.C.	HOMAN	WEATHER	<u>SUNNY</u>	COUNTY	<u>FULTON</u>	
R.C.	LEU	TEMP.	<u>75°F</u>	TOWNSHIP	<u>GORHAM</u>	
				SECTION	<u>19</u>	
				T	<u>9</u>	R
				S		E


TYPE MONUMENT P.K.NAIL
ON SURFACE - ~~BELOW~~ ON
LEFT - ℄ PAV'T - RIGHT ON
- TO - EDGE PAVEMENT
S.L.M. 495+99

Grid: Northing: 736362.212 Easting: 1495903.431

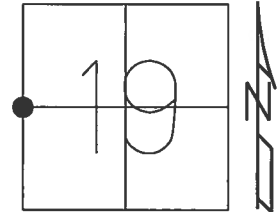

RECORD:
STA. 495+98.66
FD 1" IPIPE
3" DOWN
SET P.K./WASHER
10-17-84
FD P.K.NAIL
5-8-98, SAH
SET P.K./WASHER
11-16-98, SAH
FD P.K.NAIL
REF21
4-18-2017, DCH
SET MAG/WASHER
08-16-2017, DCH

DIST. 20-21= 197.14'

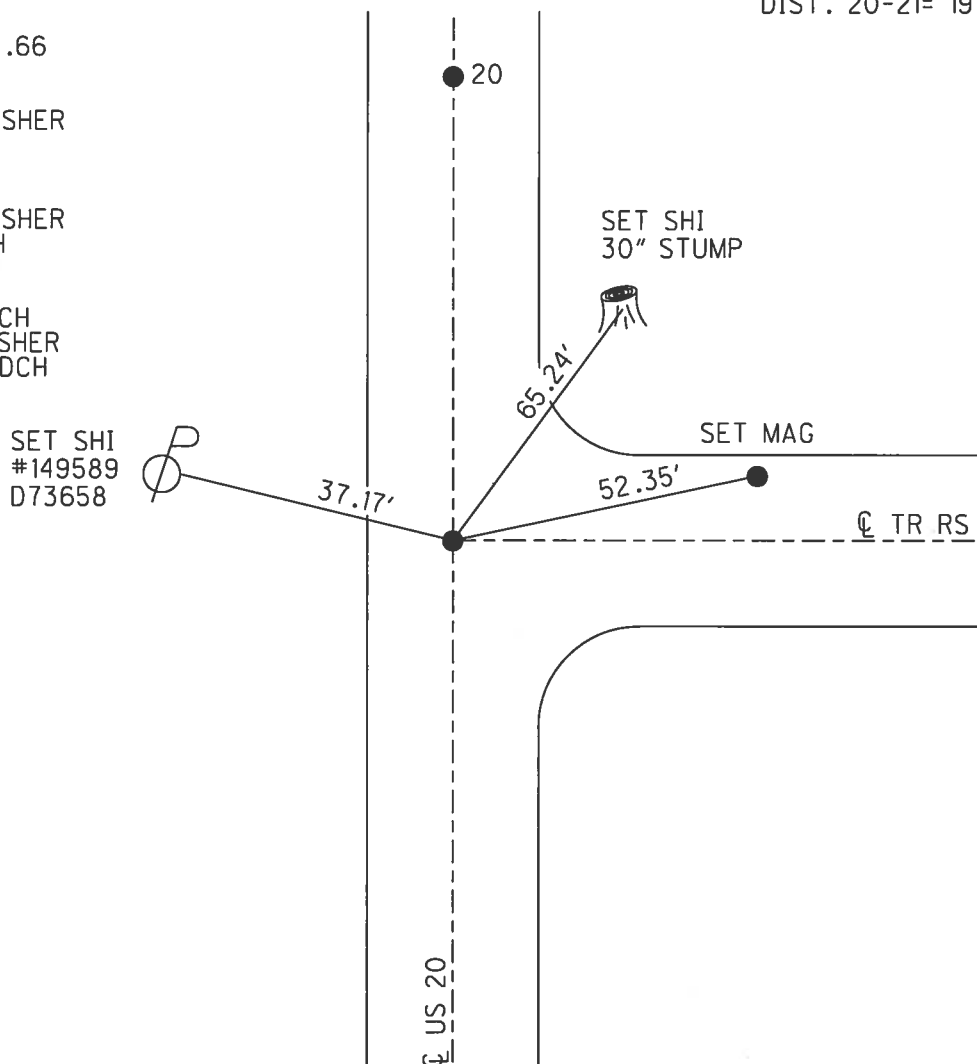

O.D.O.T. DISTRICT 2 SURVEY OFFICE (USE ONLY)

PERSONNEL

REFERENCE NO. 21 A

SHEET 35 OF 38

NOTES AUBLE

DATE 12/21/23

ROUTE SR 20

H.C. NIESE

WEATHER CLOUDY

COUNTY FULTON

R.C. ASTON

TEMP. 45°

TOWNSHIP CHESTERFIELD

DWG BY RHOADES

PID PAVING TRAIN

SECTION 30

T 9 N R 2 E

TYPE MONUMENT MAG/WASHER

ON SURFACE - ~~BELOW~~ ON

OFFSET Q PAVEMENT 1.1' LT : ~~RT~~

9.5' TO LT EDGE PAVEMENT


STATION: 533+77

HORIZ.DATUM: NAD83 2011

GEOID: NAVD88 2018


GRID: NORTHING: 733678.479

EASTING: 1497227.061

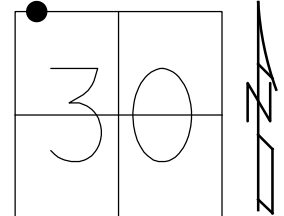

RECORD:
FD 1/2" IPIPE
4" DOWN
10-17-84
FD 1/2" IPIPE
11-16-98, SAH
SET P.K./WASHER
11/16/98, SAH
FD 1/2" IPIPE
REFA21
4-18-17, DCH
SET MAG/WASHER
8/16/17, DCH
FD MAG/WASHER
FUL20REF21A
6/9/23, JAM
12/21/23, DSA

FULTON LPD:
N: 389176.135
E: 143563.107

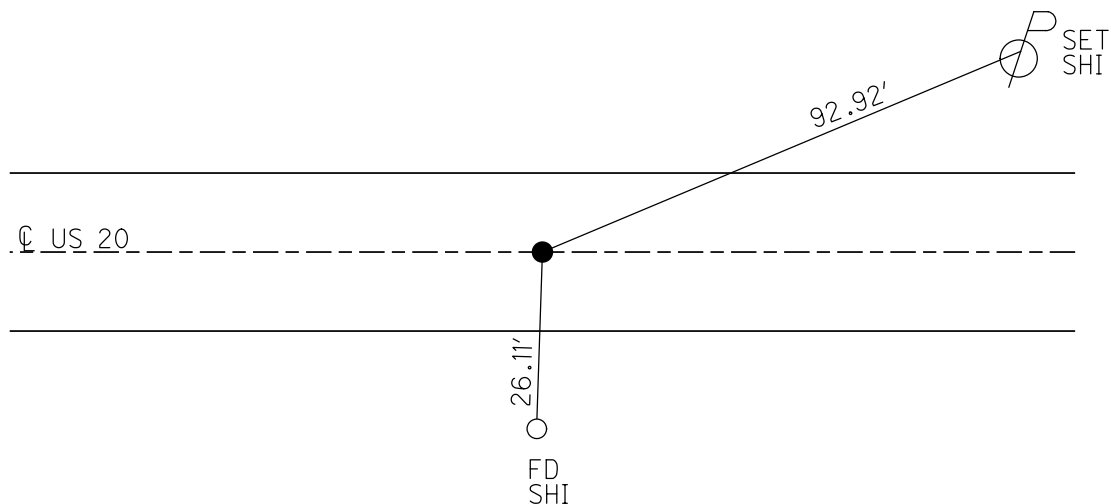

O.D.O.T. DISTRICT 2 SURVEY OFFICE (USE ONLY)

PERSONNEL

REFERENCE NO. 22

SHEET 36 OF 38

NOTES AUBLE

DATE 12/21/23

ROUTE SR 20

H.C. NIESE

WEATHER CLOUDY

COUNTY FULTON

R.C. ASTON

TEMP. 45°

TOWNSHIP CHESTERFIELD

DWG BY RHOADES

PID PAVING TRAIN

SECTION 30

T 9 N R 2 E

TYPE MONUMENT MAG/WASHER

ON SURFACE - ~~BELOW~~ ON

OFFSET CL PAVEMENT ON LT : RT

9.5' TO LT EDGE PAVEMENT


STATION: 547+04

HORZ.DATUM: NAD83 2011

GEOID: NAVD88 2018


GRID: NORTHING: 733676.280

EASTING: 1498552.268

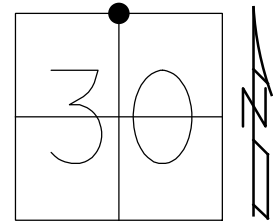

FULTON LPD:
N: 389198.998
E: 144888.164

RECORD:
FD 1/2" IPIPE
2" DOWN
SET P.K.NAIL
10-17-84
FD 1/2" IPIPE
5-8-98, SAH
SET P.K./WASHER
11-16-98, SAH
FD P.K./WASHER
REF22
4-18-17, DCH
SET MAG/WASHER
8-16-17, DCH
FD MAG/WASHER
FUL20REF22
6/9/23, JAM

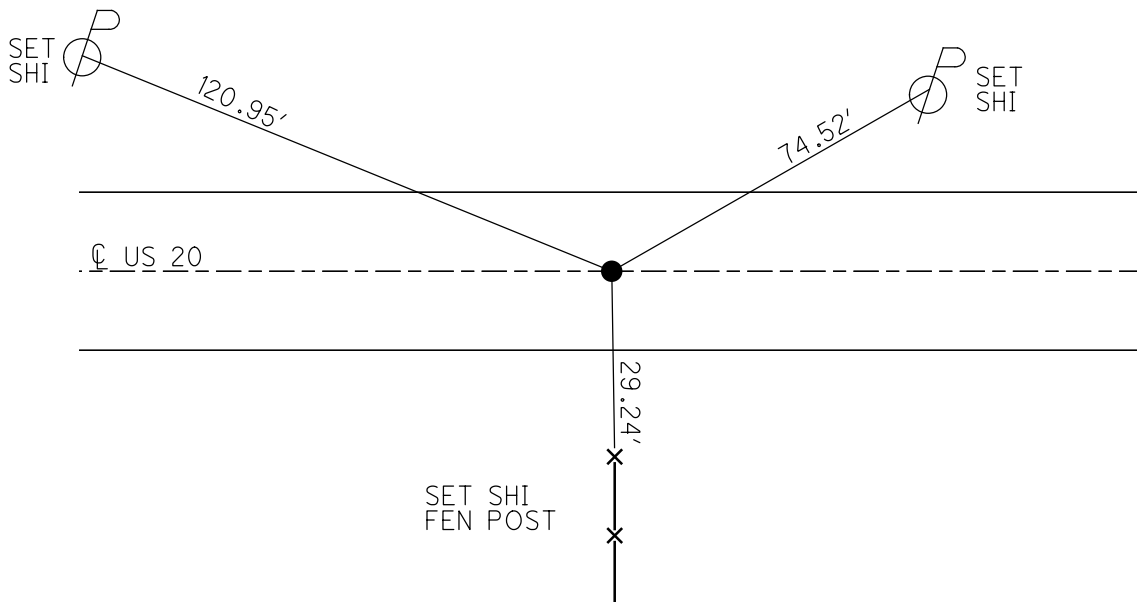

O.D.O.T. DISTRICT 2 SURVEY OFFICE (USE ONLY)

PERSONNEL

REFERENCE NO. 23

SHEET 37 OF 38

NOTES LEU

DATE 8-16-17

ROUTE US 20

H.C. HOMAN

WEATHER SUNNY

COUNTY FULTON

R.C. LEU

TEMP. 75°F

TOWNSHIP CHESTERFIELD

DWG BY JAMES PID 101272

SECTION 30

T 9 N R 2 E

TYPE MONUMENT 1" IPIPE

~~ON SURFACE~~ - BELOW 0.45'

OFFSET Q PAVEMENT ON LT : RT

- TO - EDGE PAVEMENT


STATION: 573+41

HORIZ.DATUM: NAD83 2011

GEOID: NAVD88 2012A


GRID: NORTHING: 733670.865

EASTING: 1501202.468

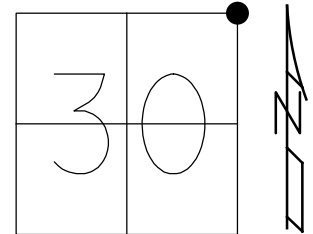

RECORD:
SET SM. R.R.SPIKE
6-17-88
FD SM.R.R.SPIKE
11-16-98, SAH
SET P.K./WASHER
11-16-98, SAH
SET MAG/WASHER
08-16-2017, DCH
FD MAG/WASHER
4-26-19, JLL

DIST. 23-23A= 10.21' REC

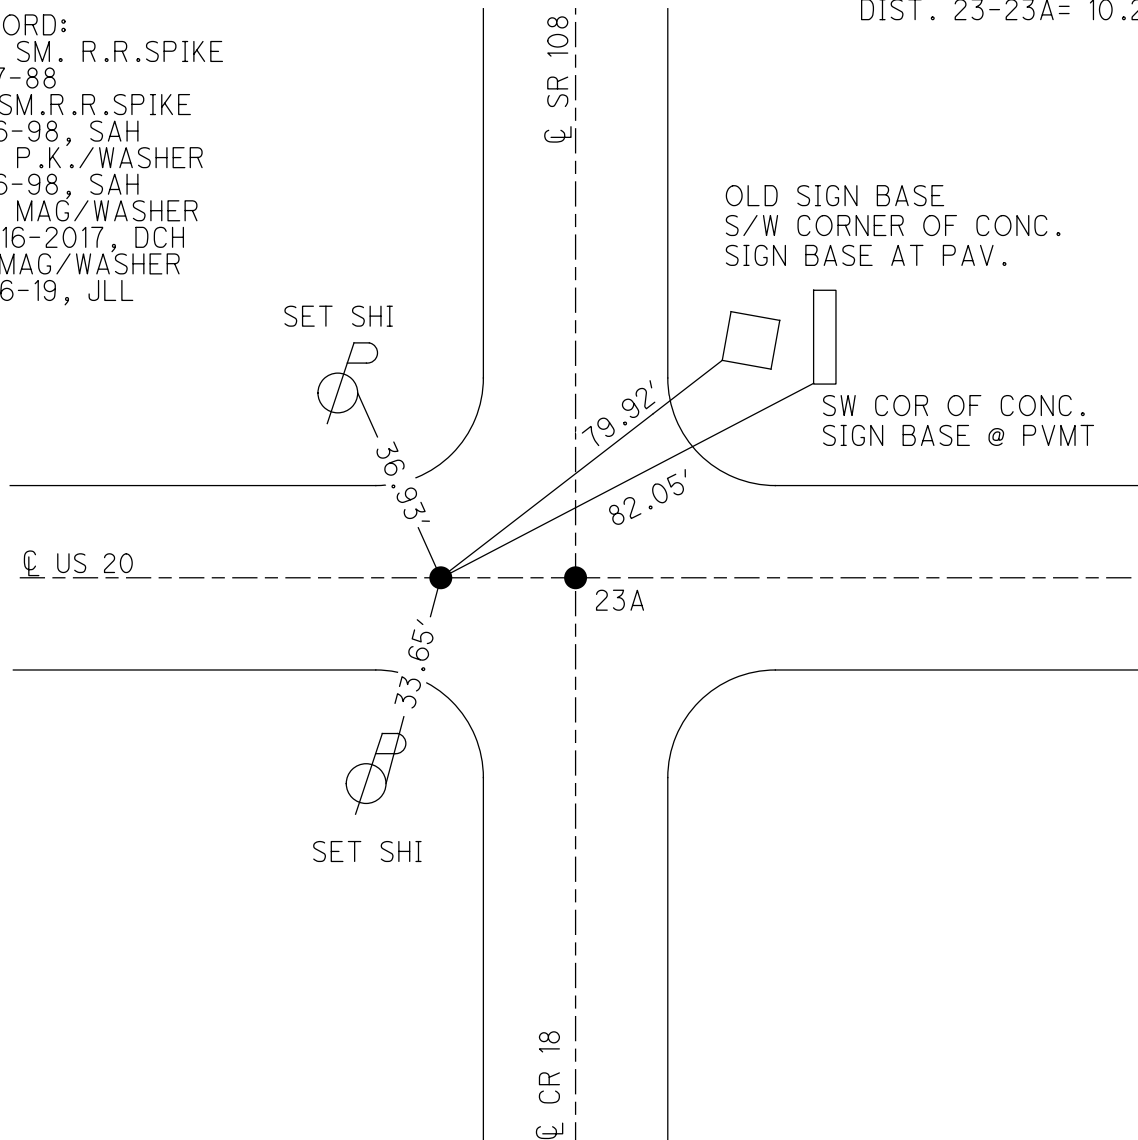

O.D.O.T. DISTRICT 2 SURVEY OFFICE (USE ONLY)

PERSONNEL

REFERENCE NO. 23 A

SHEET 38 OF 38

NOTES HUSS

DATE 11-16-98

ROUTE US 20

H.C. VANDUSEN

WEATHER CLOUDY

COUNTY FULTON

R.C. MOSER

TEMP. 55°F

TOWNSHIP CHESTERFIELD

DWG BY JAMES

PID 101272

T 9 N R 2 E

TYPE MONUMENT SM. R.R. SPIKE

ON SURFACE - ~~BELOW~~ ON

OFFSET Q PAVEMENT ON LT : RT

- TO - EDGE PAVEMENT


STATION: 573+51

HORZ.DATUM: NAD83 2011

GEOID: NAVD88 2012A


GRID: NORTHING: -

EASTING: -

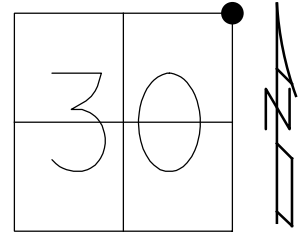

RECORD:
SET SM.R.R.SPIKE
6-17-88
FD SM.R.R.SPIKE
11-16-98, SAH
SET P.K./WASHER
11-16-98, SAH
DNF
DUG DOWN 9"
FD IPIN
LAYING HORIZONTAL
8-16-17, JLL

DIST. 23-23A= 10.21' REC

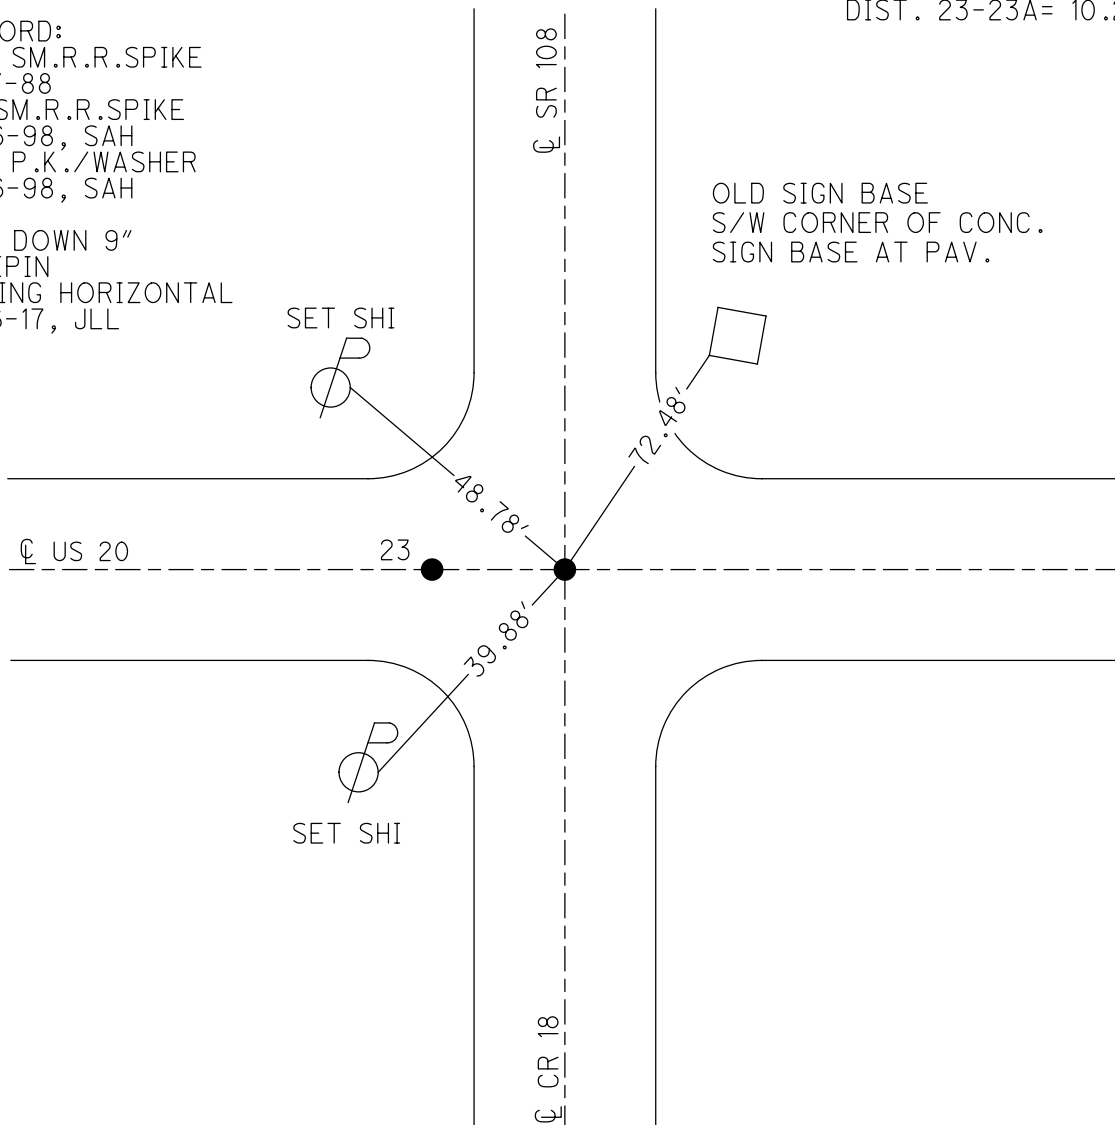

O.D.O.T. DISTRICT 2 SURVEY OFFICE (USE ONLY)

PERSONNEL

REFERENCE NO. 24

SHEET 1 OF 4

NOTES STONE

DATE 5/19/82

ROUTE US 20

H.C. NEUSER

WEATHER WARM

COUNTY FULTON

R.C. CURTIS

TEMP. 75°

TOWNSHIP CHESTERFIELD

MICHALAK

SECTION 20

DWG BY RHOADES

PID _____

T 9 N R 2 E

TYPE MONUMENT UNKNOWN

ON SURFACE - ~~BELOW~~ ON

OFFSET ℄ PAVEMENT ON LT : RT

- TO - EDGE PAVEMENT


STATION: 599+81

HORZ.DATUM: _____


GEOID: _____

GRID: NORTHING: _____

EASTING: _____

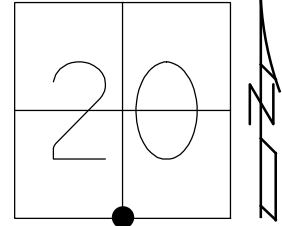

RECORD: P.I.
STA. 44+00
 $\Delta = 0^{\circ} 0'$
1931

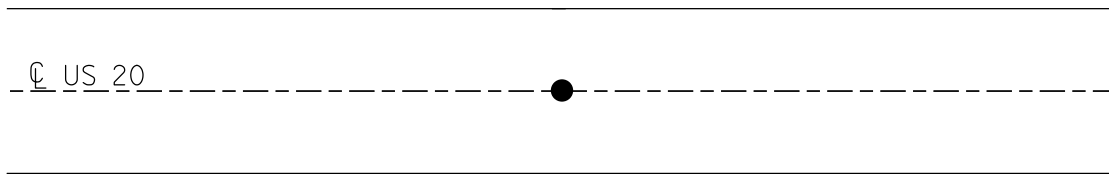

O.D.O.T. DISTRICT 2 SURVEY OFFICE (USE ONLY)

PERSONNEL

REFERENCE NO. 25

SHEET 1 OF 3

NOTES LEU

DATE 7-5-18

ROUTE US 20

H.C. LEU

WEATHER PT.CLOUDY,FAIR

COUNTY FULTON

R.C. HAGEMEYER

TEMP. 80°F

TOWNSHIP CHESTERFIELD

DWG BY JAMES

PID 101272

SECTION 20

T 9 N R 2 E

TYPE MONUMENT P.K./WASHER

ON SURFACE - ~~BELOW~~ ON

OFFSET Q PAVEMENT 0.7' ~~LT~~ : RT

10.5' TO RT EDGE PAVEMENT


STATION: 626+22

HORIZ.DATUM: NAD83 2011


GEOID: NAVD88 2012A

GRID: NORTHING: 733675.240

EASTING: 1506474.210

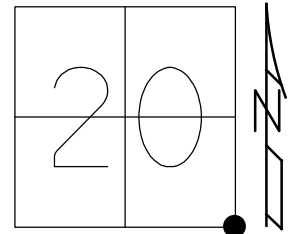

RECORD:
POSSIBLE
SEC.COR.
SET PK/WASHER
8-28-00, SAH
FD PK/WASHER
CP1
1-29-13, DH
FD PK/WASHER
REF25
7-5-18, JLL
SET MAG/WASHER
4-9-16, JLL

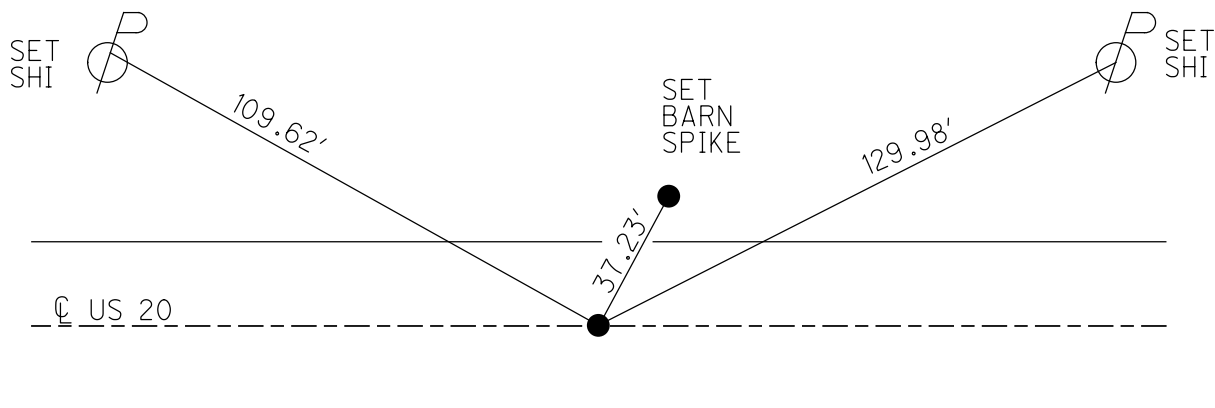

O.D.O.T. DISTRICT 2 SURVEY OFFICE (USE ONLY)

PERSONNEL

REFERENCE NO. 26

SHEET 2 OF 3

NOTES LEU

DATE 7-5-18

ROUTE US 20

H.C. LEU

WEATHER MUGGY

COUNTY FULTON

R.C. HAGEMEYER

TEMP. 82°F

TOWNSHIP CHESTERFIELD

DWG BY JAMES PID 101272

SECTION 21

T 9 N R 2 E

TYPE MONUMENT MAG NAIL

ON SURFACE - ~~BELOW~~ ON

OFFSET Q PAVEMENT ON LT : RT

TO EDGE PAVEMENT


STATION: 652+62

HORIZ.DATUM: NAD83 2011

GEOID: NAVD88 2012A

GRID: NORTHING: 733691.136

EASTING: 1509112.567

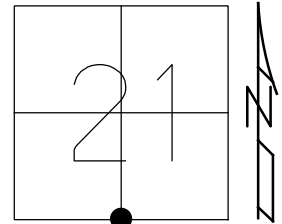

RECORD:

DNF

8-28-00, SAH

1-29-13, DCH


FD MAG NAIL

REF26

7-5-18, JLL

SET MAG/WASHER

4-26-19, JLL

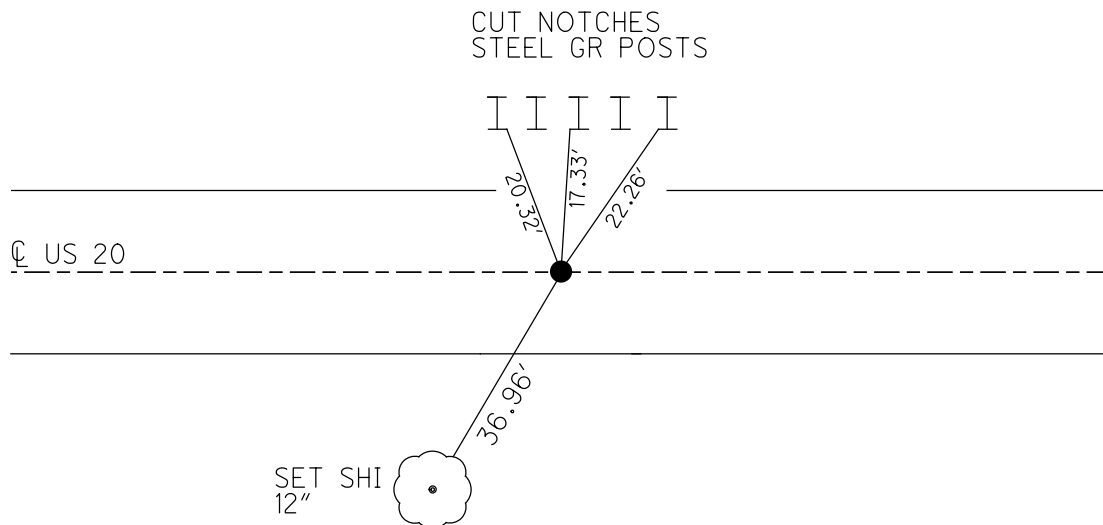

NOTE:

1923 PLANS P.O.T. CALL FOR THIS POINT TO BE ON THE SAME LINE AS REF25 TO REF27 WE MEASURED IT TO BE ONLY 4" OFF LINE. THEREFORE I DID NOT USE THIS POINT IN MY CHAIN FOR PROJECT "FUL-20-10.76" PID# 101272

O.D.O.T. DISTRICT 2 SURVEY OFFICE (USE ONLY)

PERSONNEL

REFERENCE NO. 27

SHEET 4 OF 4

NOTES LEU

DATE 7-5-18

ROUTE US 20

H.C. LEU

WEATHER PT.CLOUDY, FAIR

COUNTY FULTON

R.C. HAGEMeyer

TEMP. 84°F

TOWNSHIP CHESTERFIELD

SECTION 21

DWG BY JAMES

PID 101272

T 9 N R 2 E

TYPE MONUMENT P.K./WASHER

ON SURFACE - ~~BELOW~~ ON

OFFSET Q PAVEMENT 1.1' ~~LT~~ : RT

TO EDGE PAVEMENT


STATION: 679+22

HORZ.DATUM: NAD83 2011

GEOID: NAVD88 2012A

GRID: NORTHING: 733707.091

EASTING: 1511751.563

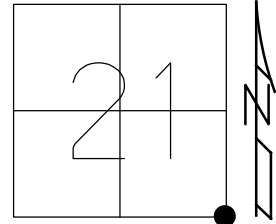

RECORD:
SET P.K./WASHER
8-28-00, SAH
FD PK/WASHER
CP2
1-29-13, DH
REF27
9/22/15, JFO
7-5-18, JLL
SET MAG/WASHER
4-9-19, JLL
FD MAG/WASHER
7/5/22, DSA



FD
SHI

44.80'

Q CR 16




SET SHI
34" MAPLE

72.78'

Q US 20

98.34'

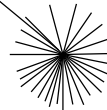

SET SHI
18" EVERGREEN

47.50'

CORNER CONC
FOUNDATION
UNDER SIDING

O.D.O.T. DISTRICT 2 SURVEY OFFICE (USE ONLY)

PERSONNEL

REFERENCE NO. 28

SHEET 2 OF 21

NOTES HAGEMEYER

DATE 7-5-18

ROUTE US 20

H.C. LEU

WEATHER SUNNY/HUMID

COUNTY FULTON

R.C. HAGEMEYER

TEMP. 86°FTOWNSHIP CHESTERFIELDSECTION 22

T_9_N R_2_E

DWG BY JAMES

PID 101272

TYPE MONUMENT P.K. NAIL

~~ON SURFACE - BELOW~~ 3"

OFFSET $\odot$ PAVEMENT 0.3' ~~LT~~ : RT


12.7' TO LT EDGE PAVEMENT

STATION: 726+52.83

HORZ.DATUM: NAD83 2011

GEOID: NAVD88 2012A

GRID: NORTHING: 733768.858

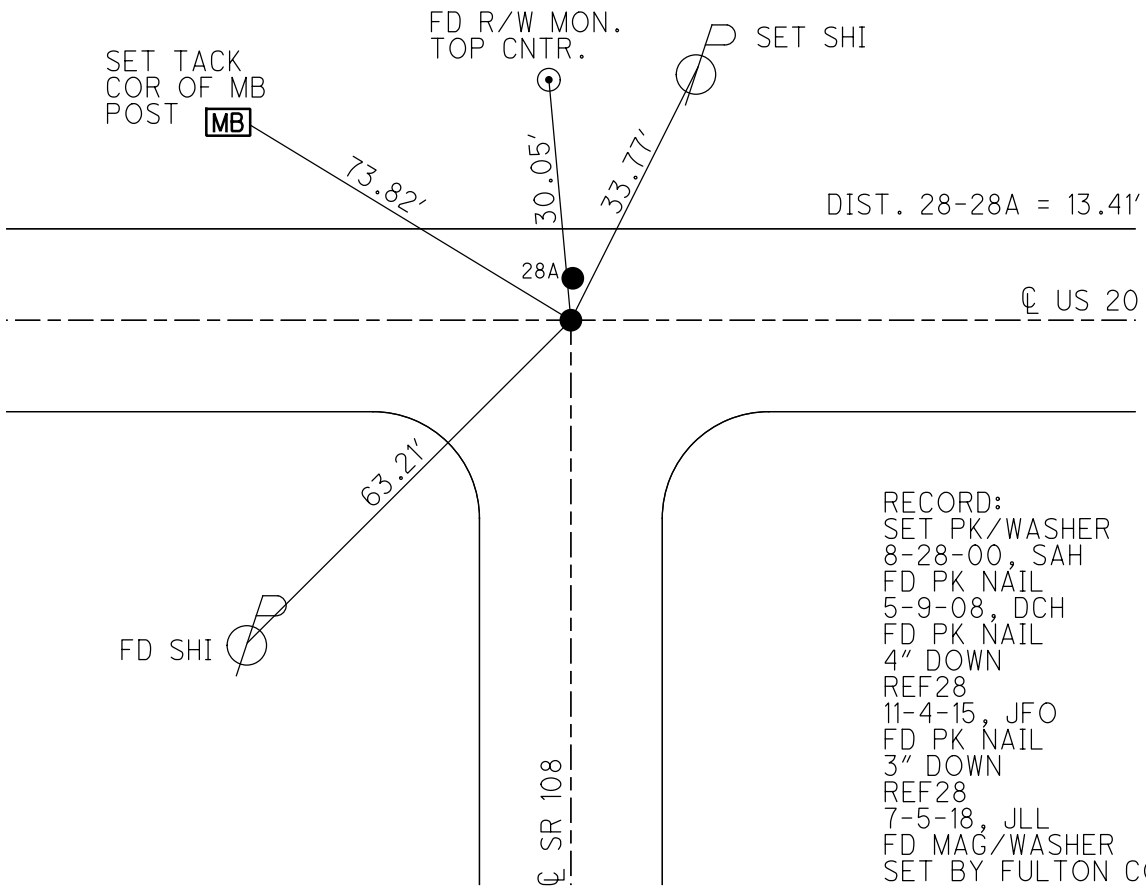EASTING: 1517061.539

RECORD:
SET PK/WASHER
8-28-00, SAH
FD PK NAIL
5-9-08, DCH
FD PK NAIL
4" DOWN
REF28
11-4-15, JFO
FD PK NAIL
3" DOWN
REF28
7-5-18, JLL
FD MAG/WASHER
SET BY FULTON CO.
4-26-19, JLL
FD MAG/WASHER
7/5/22, DSA

O.D.O.T. DISTRICT 2 SURVEY OFFICE (USE ONLY)

PERSONNEL

REFERENCE NO. 28 A

SHEET 3 OF 21

NOTES HAGEMEYER

DATE 7-5-18

ROUTE US 20

H.C. LEU

WEATHER SUNNY/HUMID

COUNTY FULTON

R.C. HAGEMEYER

TEMP. 86°F

TOWNSHIP CHESTERFIELD

DWG BY JAMES PID 101272

SECTION 22

T 9 N R 2 E

TYPE MONUMENT P.K. NAIL

ON SURFACE - ~~BELOW~~ ON

OFFSET CL PAVEMENT 13.7' ~~LT~~ : RT

12.7' TO LT EDGE PAVEMENT



STATION: 726+51.58

HORZ.DATUM: NAD83 2011

GEOID: NAVD88 2012A

GRID: NORTHING: 733782.180

EASTING: 1517060.132

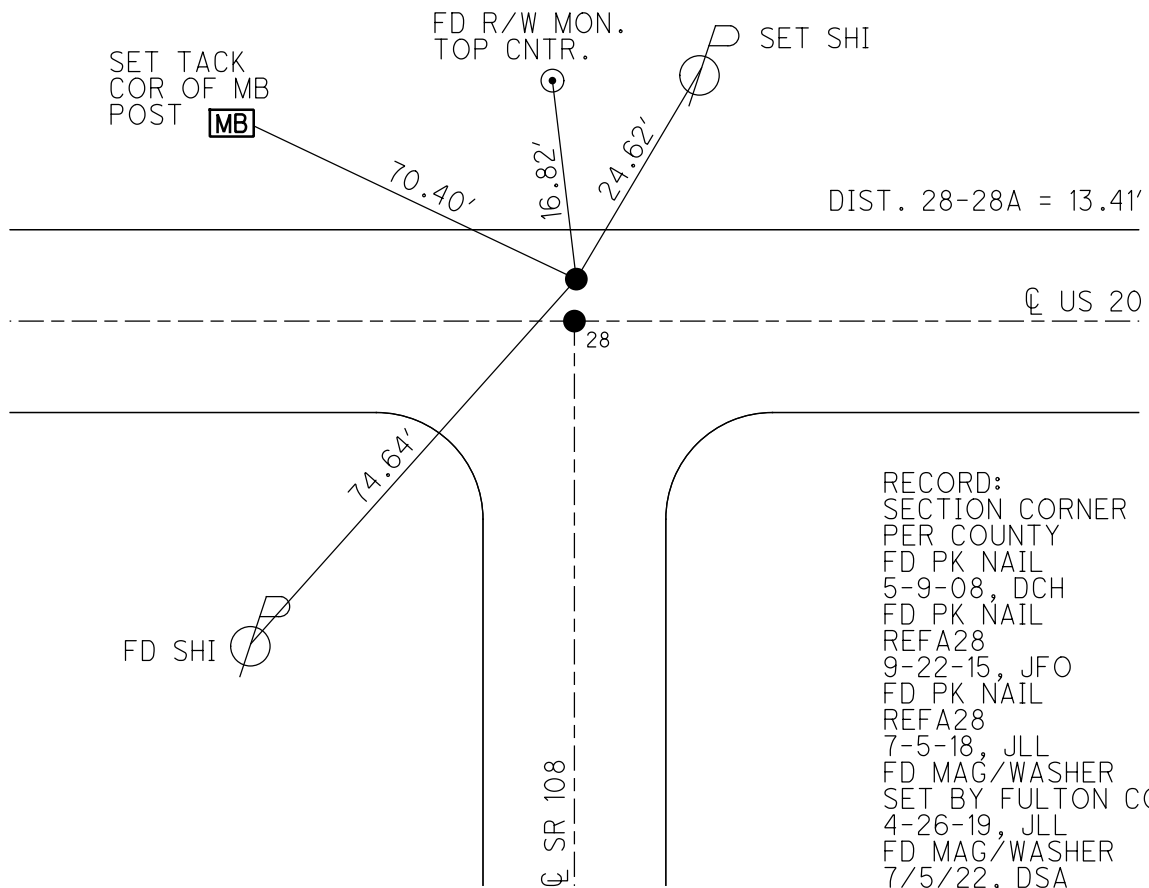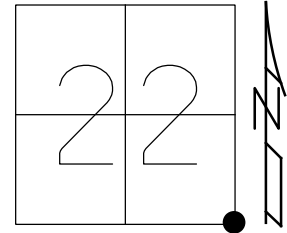


RECORD:
SECTION CORNER
PER COUNTY
FD PK NAIL
5-9-08, DCH
FD PK NAIL
REFA28
9-22-15, JFO
FD PK NAIL
REFA28
7-5-18, JLL
FD MAG/WASHER
SET BY FULTON CO.
4-26-19, JLL
FD MAG/WASHER
7/5/22, DSA

O.D.O.T. DISTRICT 2 SURVEY OFFICE (USE ONLY)

PERSONNEL		REFERENCE NO.	<u>29</u>	SHEET	<u>4</u>	OF	<u>21</u>
NOTES	<u>ROUSOS</u>	DATE	<u>5/26/09</u>	ROUTE	<u>US 20</u>		
H.C.	<u>HOMAN</u>	WEATHER	<u>CLEAR</u>	COUNTY	<u>FULTON</u>		
R.C.	<u>ROUSOS</u>	TEMP.	<u>68°</u>	TOWNSHIP	<u>CHESTERFIELD</u>		
				SECTION	<u>26</u>		
				T	<u>9</u>	S	R
							<u>2</u>
							<u>E</u>


TYPE MONUMENT _____ P.K. NAIL
 ON SURFACE - ~~BELOW~~ _____ ON
~~LEFT~~ - CL PAV'T - ~~RIGHT~~ _____ ON
 _____ TO _____ EDGE PAVEMENT
 S.L.M. 752+95.88

GRID: NORTHING: 733796.370 EASTING: 1519704.500

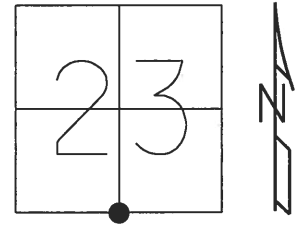

29 TO 29A = 19.89'

SET P.K. NAIL
 8-5-87
 FD P.K. NAILS
 5-9-09, DCH
 RESET MAG/WASHER
 8-3-09, DCH
 FD MAG/WASHER
 REF29
 9-22-15, JFO
 SET MAG/WASHER
 6-25-18, JLL

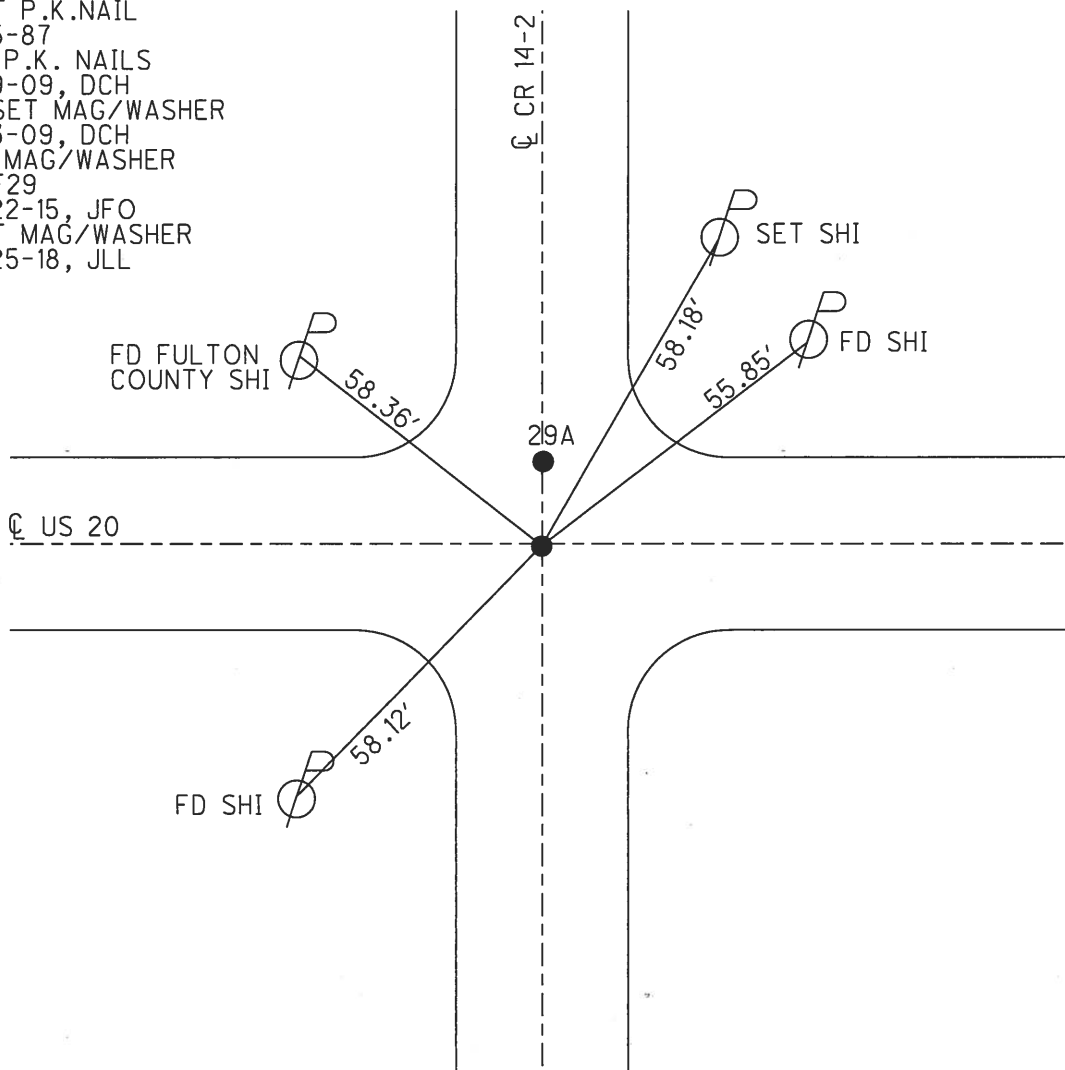


O.D.O.T. DISTRICT 2 SURVEY OFFICE (USE ONLY)

PERSONNEL	REFERENCE NO. <u>29A</u>	SHEET <u>5</u> OF <u>21</u>
NOTES	DATE <u>7/2/18</u>	ROUTE <u>US 20</u>
H.C. <u>RHOADES</u>	WEATHER <u>CLOUDY</u>	COUNTY <u>FULTON</u>
R.C. <u>O'DONNELL</u>	TEMP. <u>78°</u>	TOWNSHIP <u>CHESTERFIELD</u>
		SECTION <u>23</u>
		T <u>9</u> S R <u>2</u> E


TYPE MONUMENT MAG/WASHER
 ON SURFACE - ~~BELOW~~ ON
 LEFT - ℄ PAV'T - ~~RIGHT~~ 19.89'
TO EDGE PAVEMENT
 S.L.M. 752+95.88

GRID: NORTHING: 733816.206 EASTING: 1519704.141

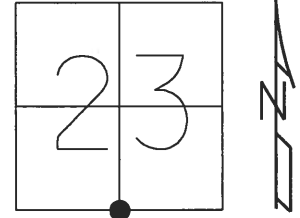

29 TO 29A = 19.89'


RECORD:
 SET P.K. NAIL
 8-5-87
 FD P.K. NAIL
 5-9-09, DCH
 (PER FULTON CO. SEC. COR.)
 5-26-08, DCH
 RESET MAG/WASHER
 8-3-09, DCH
 DNF
 3-29-15, JFO
 DMF
 9-22-15, JFO
 FD HOLE W/2 TIES
 11-4-15, JFO
 SET MAG/WASHER
 7-2-18, JFO

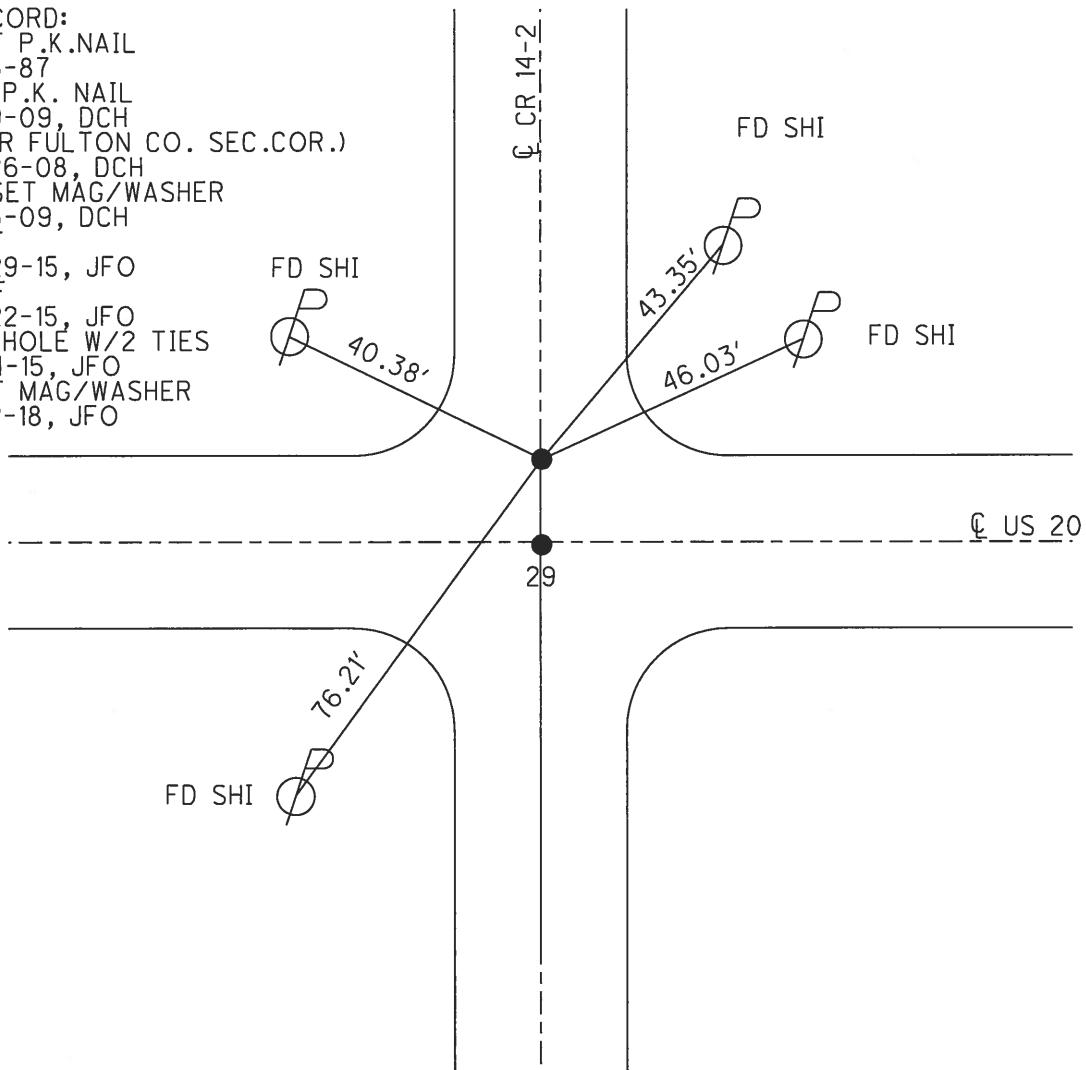

O.D.O.T. DISTRICT 2 SURVEY OFFICE (USE ONLY)

PERSONNEL	REFERENCE NO. <u>30</u>	SHEET <u>6</u> OF <u>21</u>
NOTES	DATE <u>3/29/17</u>	ROUTE <u>US 20</u>
H.C. <u>RHOADES</u>	WEATHER <u>CLEAR</u>	COUNTY <u>FULTON</u>
R.C. <u>O'DONNELL</u>	TEMP. <u>40°</u>	TOWNSHIP <u>CHESTERFIELD</u>
		SECTION <u>23</u>
		T <u>9</u> S R <u>2</u> E


TYPE MONUMENT _____ MAG/WASHER _____
 ON SURFACE - ~~BELOW~~ _____ ON _____
 LEFT - ℄ PAV'T - ~~RIGHT~~ _____ 0.6' _____
 _____ TO _____ EDGE PAVEMENT
 S.L.M. 779+24.48

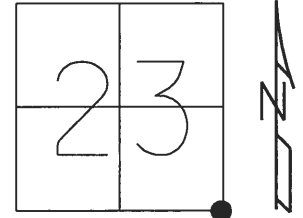

GRID: NORTHING: 733812.311 EASTING: 1522333.017

30 TO 30 A = 26.69'

RECORD:
 SET P.K. NAIL
 TO SURFACE
 8-5-87
 FD P.K. NAIL
 5-9-08, DCH
 SET MAG/WASHER
 8-3-09, DCH
 FD MAG/WASHER
 REF30
 9-22-15, JFO
 SET MAG/WASHER
 6-25-18, JLL

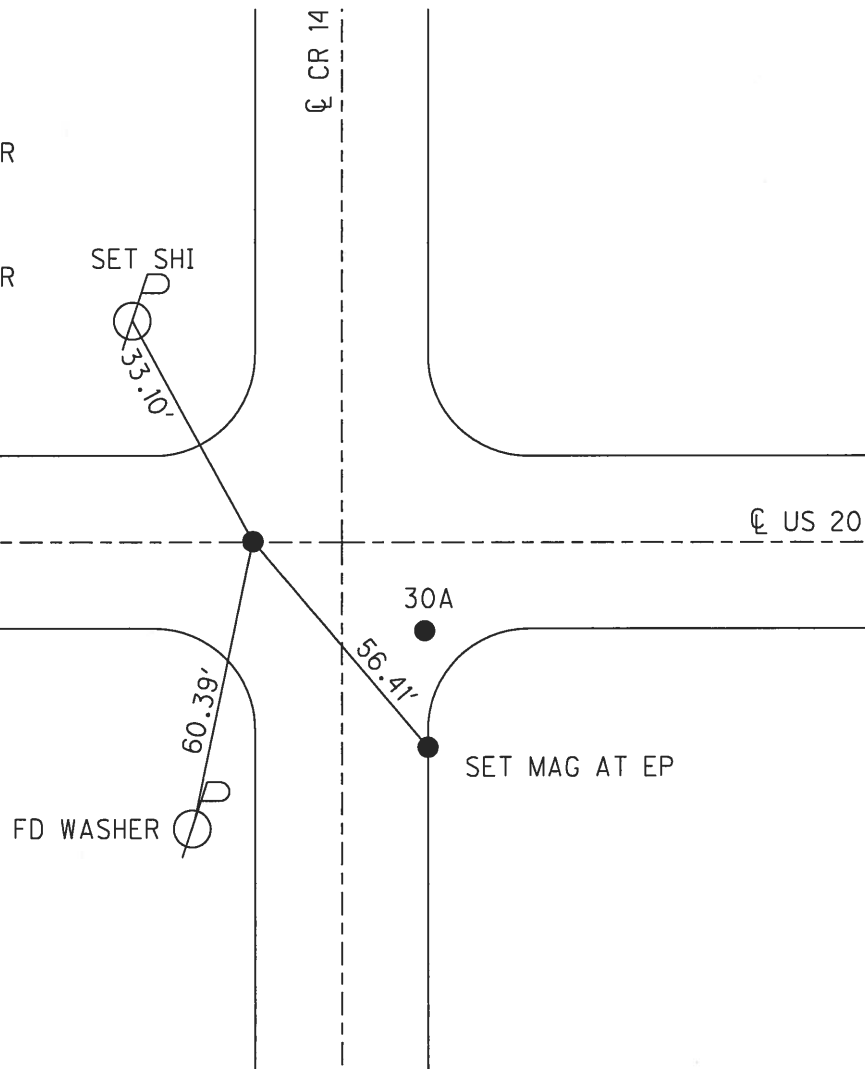

O.D.O.T. DISTRICT 2 SURVEY OFFICE (USE ONLY)

PERSONNEL

REFERENCE NO.

30 A

SHEET

7

OF

21

NOTES

H.C.

R.C.

RHOADES

O'DONNELL

HELDMAN

DATE

3/29/17

WEATHER

CLEAR

TEMP.

40°

ROUTE

US 20

COUNTY

FULTON

TOWNSHIP

CHESTERFIELD

SECTION

23

T 9 S R 2 E

TYPE MONUMENT

R.R. SPIKE

~~ON SURFACE~~ - BELOW

3"

~~LEFT~~ - CL PAV'T - RIGHT


19.8'

TO EDGE PAVEMENT

S.L.M. 779+41.75

GRID: NORTHING: 733791.986

EASTING: 1522350.374

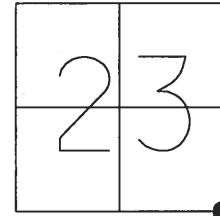

30 TO 30 A = 26.69'

RECORD:

FD R.R. SPIKE

SECTION COR.

PER FULTON CO.

RESET MAG/WASHER

8-03-09, DCH


FD MAG/WASHER

REFA30

3-29-17, JFO

SET MAG/WASHER

6-25-18, JLL

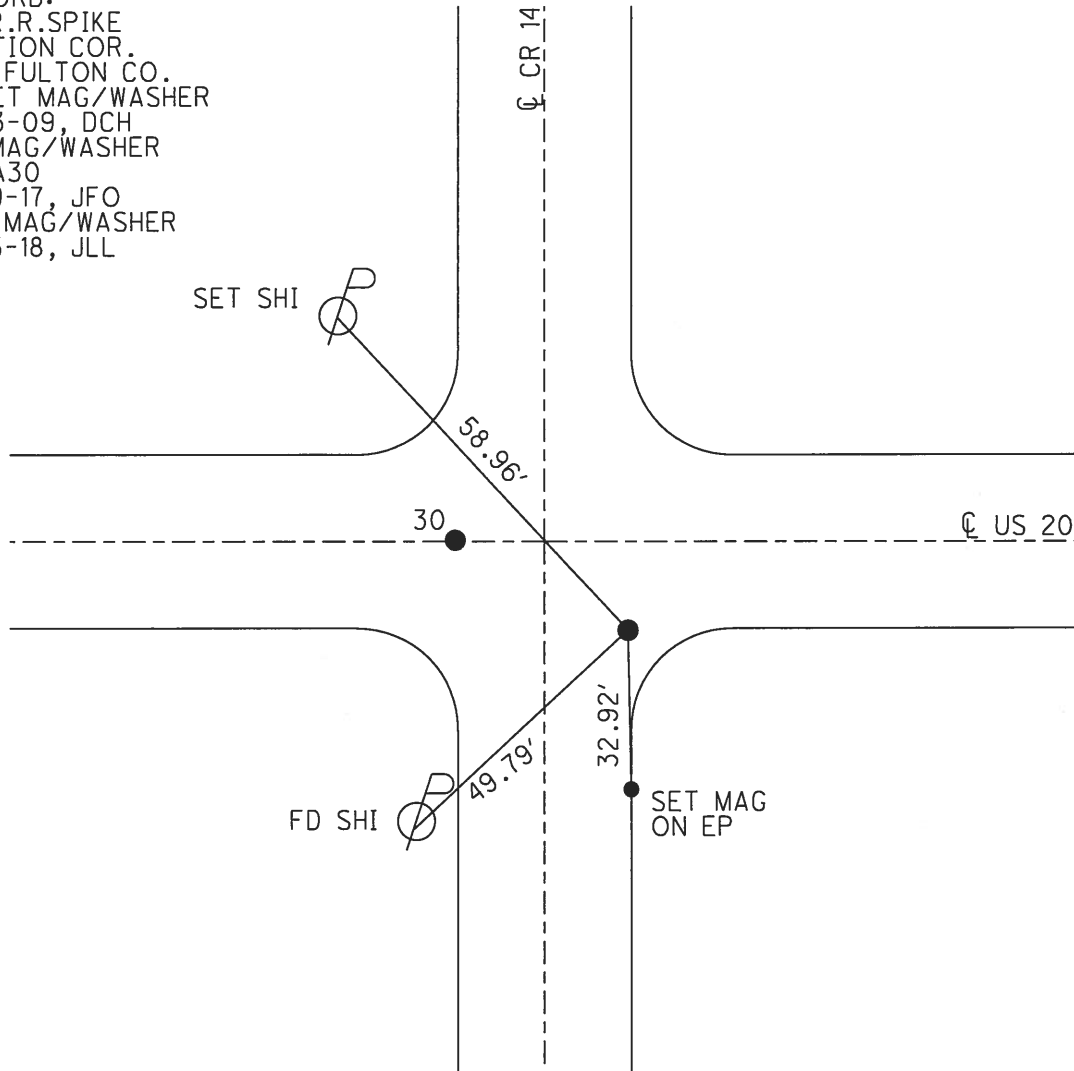

O.D.O.T. DISTRICT 2 SURVEY OFFICE (USE ONLY)

PERSONNEL

REFERENCE NO. 31

SHEET 8 OF 21

NOTES
H.C. RHOADES
R.C. O'DONNELL
HELDMAN

DATE 3/29/17
WEATHER CLEAR
TEMP. 40°

ROUTE US 20
COUNTY FULTON
TOWNSHIP CHESTERFIELD
SECTION 24
T 9 S R 2 E

TYPE MONUMENT MAG/WASHER


ON SURFACE - ~~BELOW~~ ON

~~LEFT~~ - CL PAV'T - RIGHT ON

12.3' TO LT EDGE PAVEMENT

S.L.M. 833+69.75

GRID: NORTHING: 733826.7740 EASTING: 1527778.259

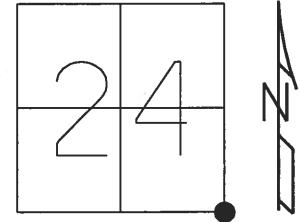

31 TO 31A = 26.71'

RECORD:

SET P.K. NAIL

TO SURFACE

8/5/87

FD P.K. NAIL

5/9/08, DCH

SET MAG/WASHER

8-3-09, DCH

FE MAG/WASHER


REF31

9-22-15, JFO

SET MAG/WASHER

REF31

6-25-18, JLL

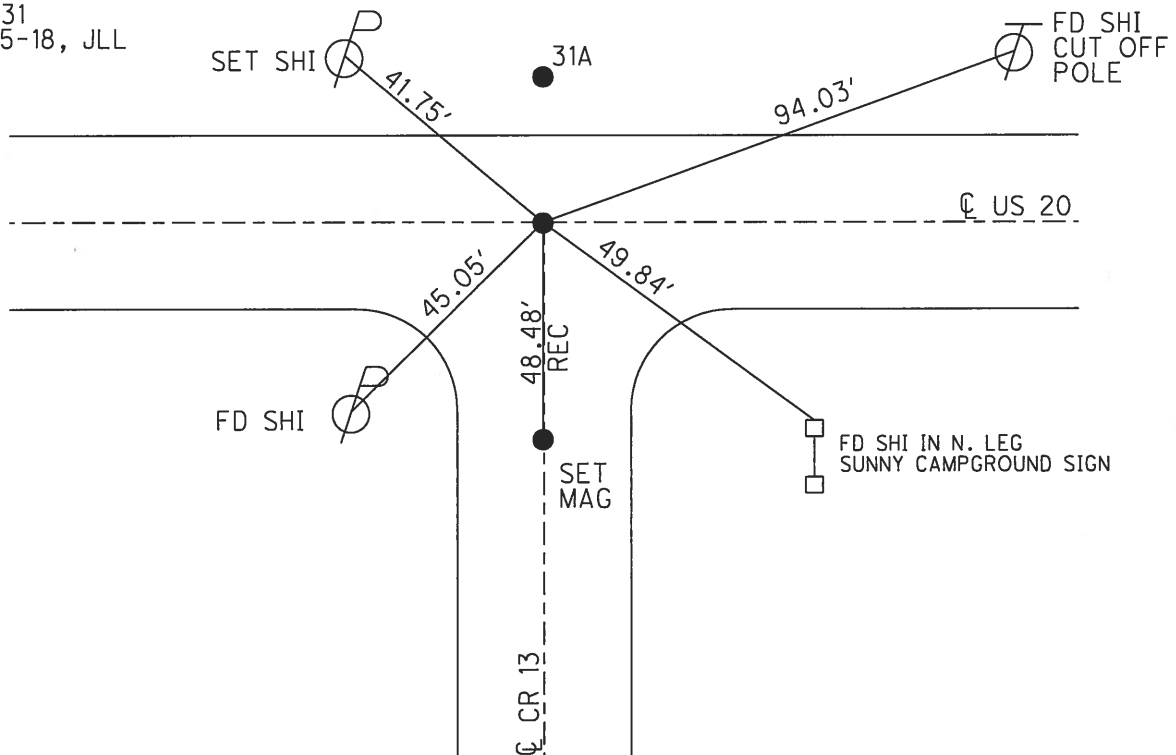

O.D.O.T. DISTRICT 2 SURVEY OFFICE (USE ONLY)

PERSONNEL

REFERENCE NO.

31 A

SHEET

9

OF

21

NOTES

RHOADES

DATE

3/29/17

ROUTE

US 20

H.C.

O'DONNELL

WEATHER

CLEAR

COUNTY

FULTON

R.C.

HELDMAN

TEMP.

40°

TOWNSHIP

CHESTERFIELD

SECTION

24

T 9 S

R 2 E

TYPE MONUMENT

1" IPIPE

~~ON SURFACE~~ - BELOW

13"

~~LEFT - C PAV'T - RIGHT~~

ON

8'


TO LT EDGE PAVEMENT

S.L.M.

833+70.19'

GRID: NORTHING: 733849.588

EASTING: 1527778.689

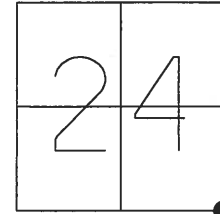

RECORD:


FD 1" IPIPE

13" DOWN

REFA31

9-22-15, JFO

31 TO 31A = 26.71'

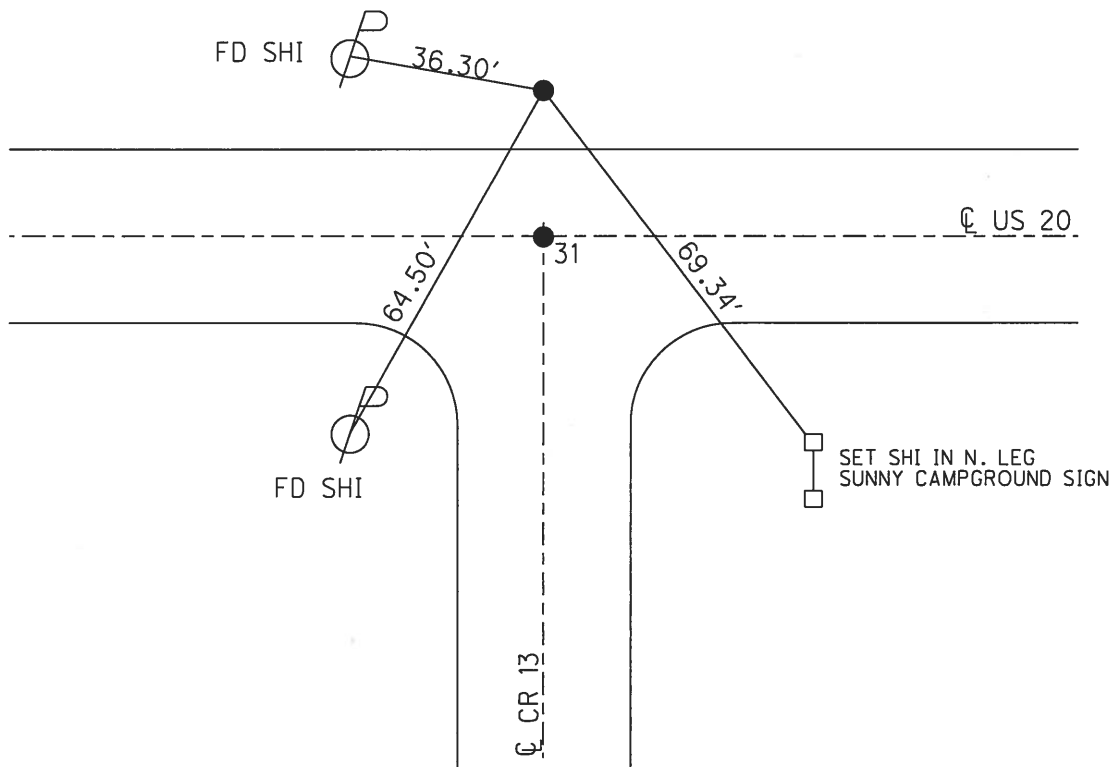

O.D.O.T. DISTRICT 2 SURVEY OFFICE (USE ONLY)


PERSONNEL _____ REFERENCE NO. 32 SHEET 10 OF 21
NOTES HAGEMeyer _____ DATE 6/25/18 ROUTE US 20
H.C. LEU _____ WEATHER CLEAR COUNTY FULTON
R.C. HAGEMeyer _____ TEMP. 68° TOWNSHIP ROYALTON

SECTION 19
T 9 S R 3 E


TYPE MONUMENT _____ SET MAG/WASHER
~~ON SURFACE~~ - BELOW _____ ON
~~LEFT~~ - Q PAV'T - RIGHT _____ 1'
10.1' TO RT EDGE PAVEMENT

S.L.M. 859+42.12

GRID: NORTHING: 733828.884 EASTING: 1530351.632

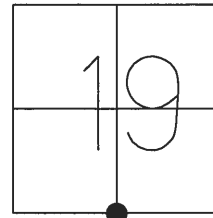

RECORD:
FD R.R.SPIKE
6/04/09, DCH
RESET MAG/WASHER
8/03/09M, DCH
FD MAG/WASHER
REF 32
9-22-15, JFO
SET MAG/WASHER
6-25-18, JLL

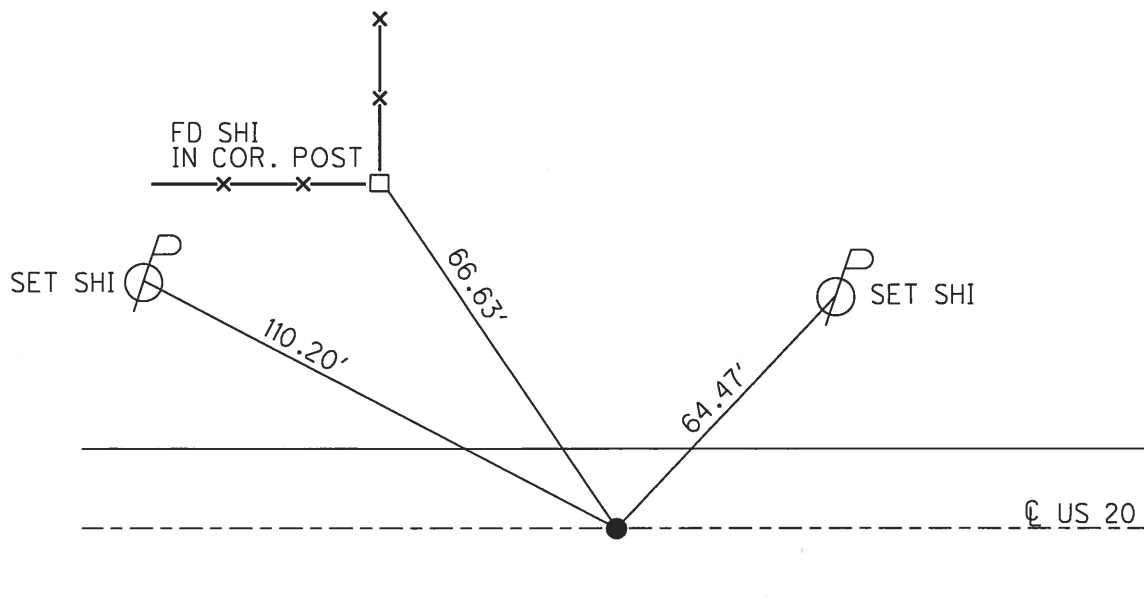


O.D.O.T. DISTRICT 2 SURVEY OFFICE (USE ONLY)


PERSONNEL _____ REFERENCE NO. 33 SHEET 11 OF 21
 NOTES RHOADES _____ DATE 3/29/17 ROUTE US 20
 H.C. O'DONNELL _____ WEATHER CLEAR COUNTY FULTON
 R.C. HELDMAN _____ TEMP. 40° TOWNSHIP ROYALTON
 _____ SECTION 19
 T 9 S R 3 E

TYPE MONUMENT _____ MAG/WASHER _____
 ON SURFACE - ~~BELOW~~ _____ ON _____
~~LEFT~~ - C PAV'T - RIGHT _____ 0.6'
 _____ TO _____ EDGE PAVEMENT
 S.L.M. 885+82.06

GRID: NORTHING: 733844.999 EASTING: 1532990.524

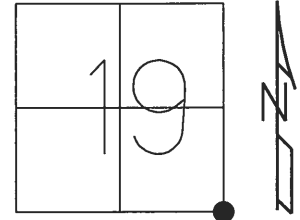

RECORD:
 SET P.K. NAIL
 8-5-87
 FD P.K. NAIL
 5-9-08, DCH
 RESET MAG/WASHER
 8-03-09, DCH
 FD MAG/WASHER
 REF33
 9-2-15, JFO
 SET MAG/WASHER
 06-25-18

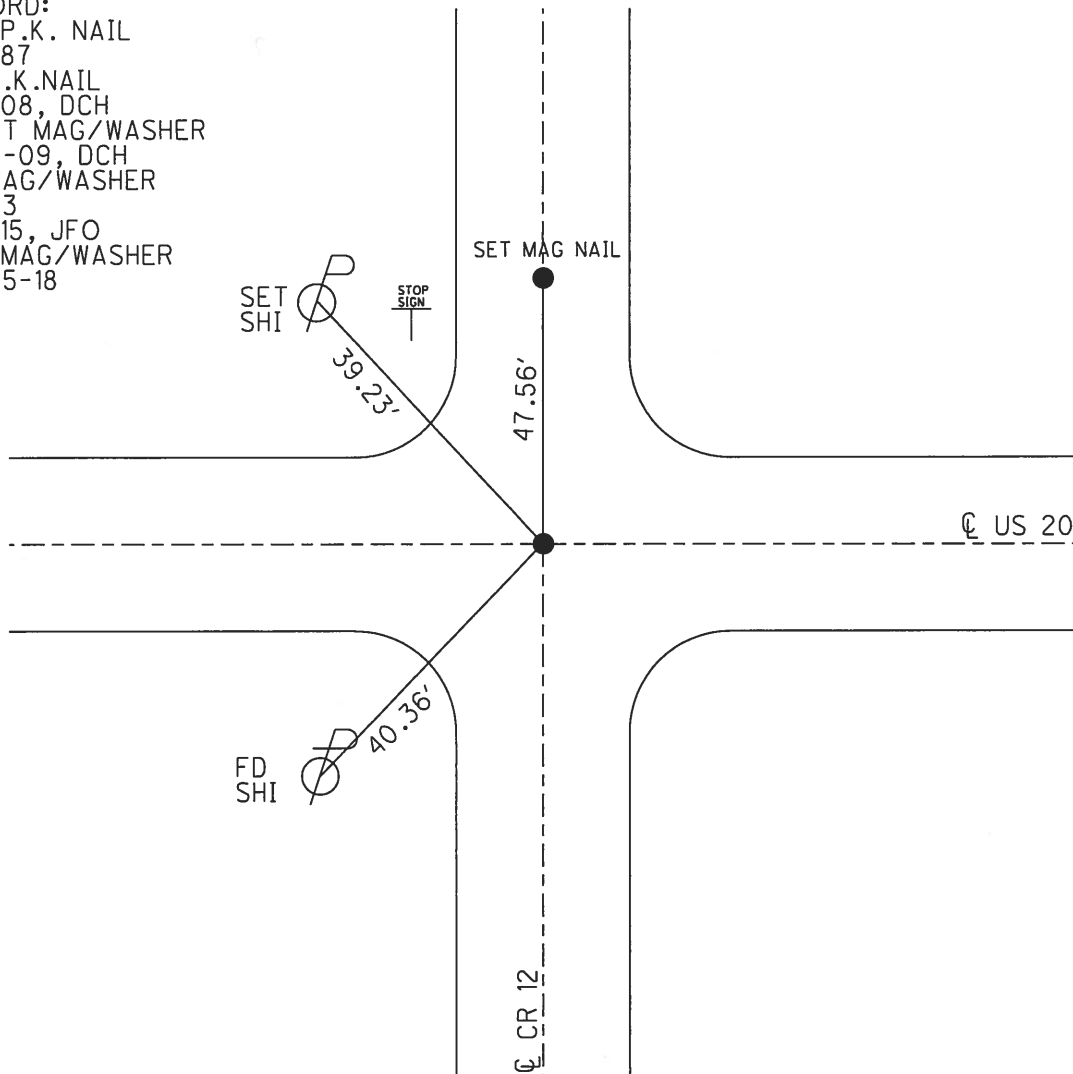

O.D.O.T. DISTRICT 2 SURVEY OFFICE (USE ONLY)

PERSONNEL

REFERENCE NO.

34

SHEET

12

OF 21

NOTES

RHOADES

DATE

3/29/17

ROUTE

US 20

H.C.

O'DONNELL

WEATHER

CLEAR

COUNTY

FULTON

R.C.

HELDMAN

TEMP.

40°

TOWNSHIP

ROYALTON

SECTION

20

T 9 S R 3 E

TYPE MONUMENT

MAG/WASHER

ON SURFACE - ~~BELOW~~

ON

LEFT - ℄ PAV'T - ~~RIGHT~~

3.15'


TO EDGE PAVEMENT

S.L.M.


912+44.32

GRID: NORTHING: 733858.345

EASTING: 1535652.755

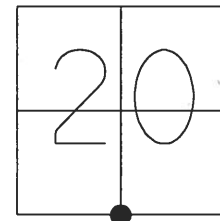

34 TO 34A = 3.17'

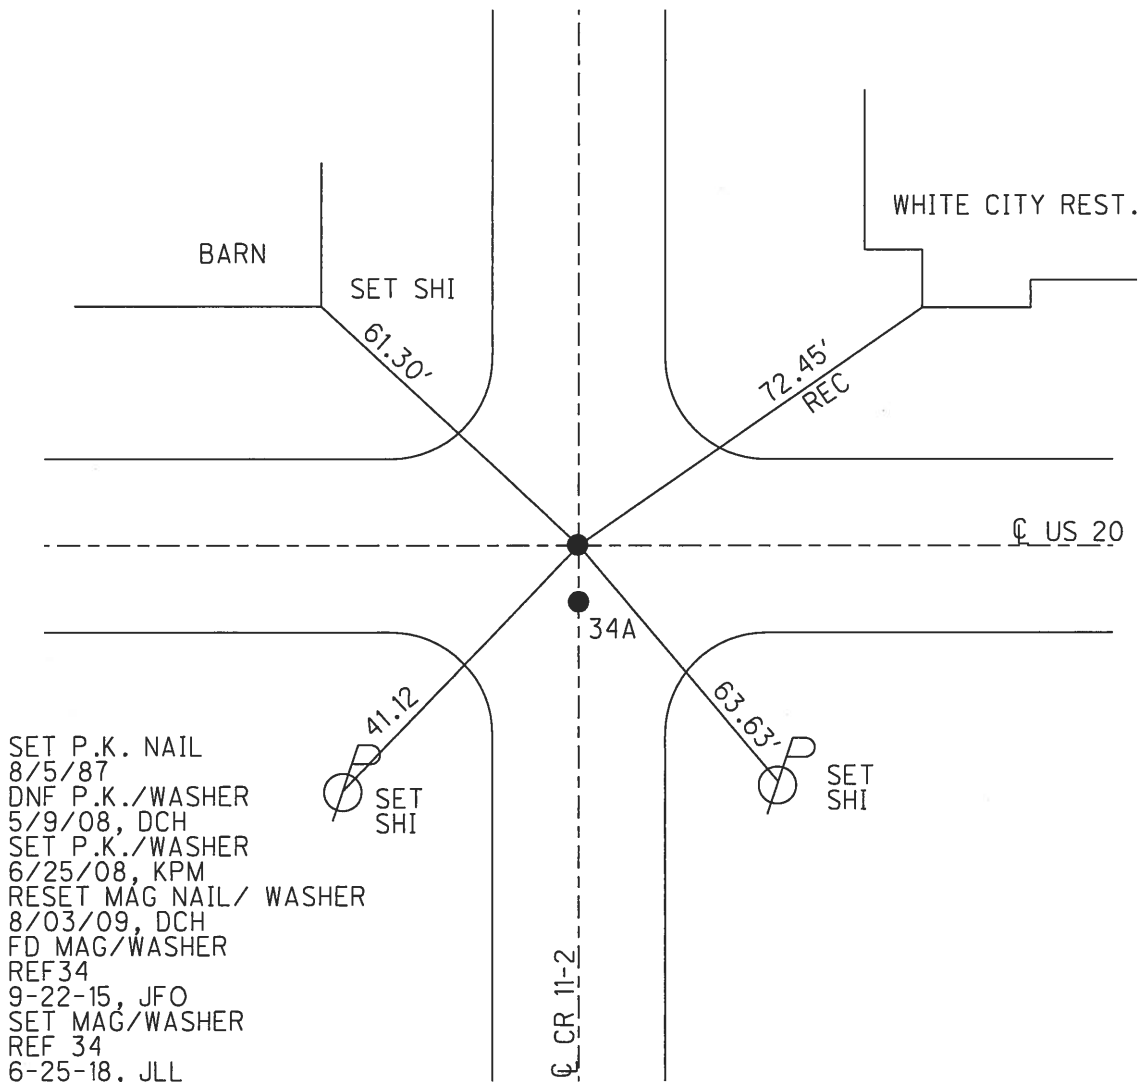

O.D.O.T. DISTRICT 2 SURVEY OFFICE (USE ONLY)

PERSONNEL

REFERENCE NO.

34A

SHEET

13

OF

21

NOTES

RHOADES

DATE

3/29/17

ROUTE

US 20

H.C.

O'DONNELL

WEATHER

CLEAR

COUNTY

FULTON

R.C.

HELDMAN

TEMP.

40°

TOWNSHIP

ROYALTON

SECTION

20

T 9 S R 3 E

TYPE MONUMENT

MAG/WASHER

ON SURFACE - ~~BELOW~~

ON

~~LEFT~~ - ℄ PAV'T - RIGHT


6"

TO EDGE PAVEMENT

S.L.M. 912+44.32


GRID: NORTHING: 733855.199

EASTING: 1535652.811

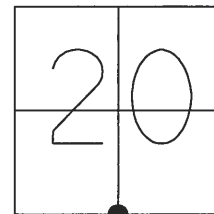

34 TO 34A = 3.17'

RECORD:
FD MAG NAIL
REF A34
9-22-15

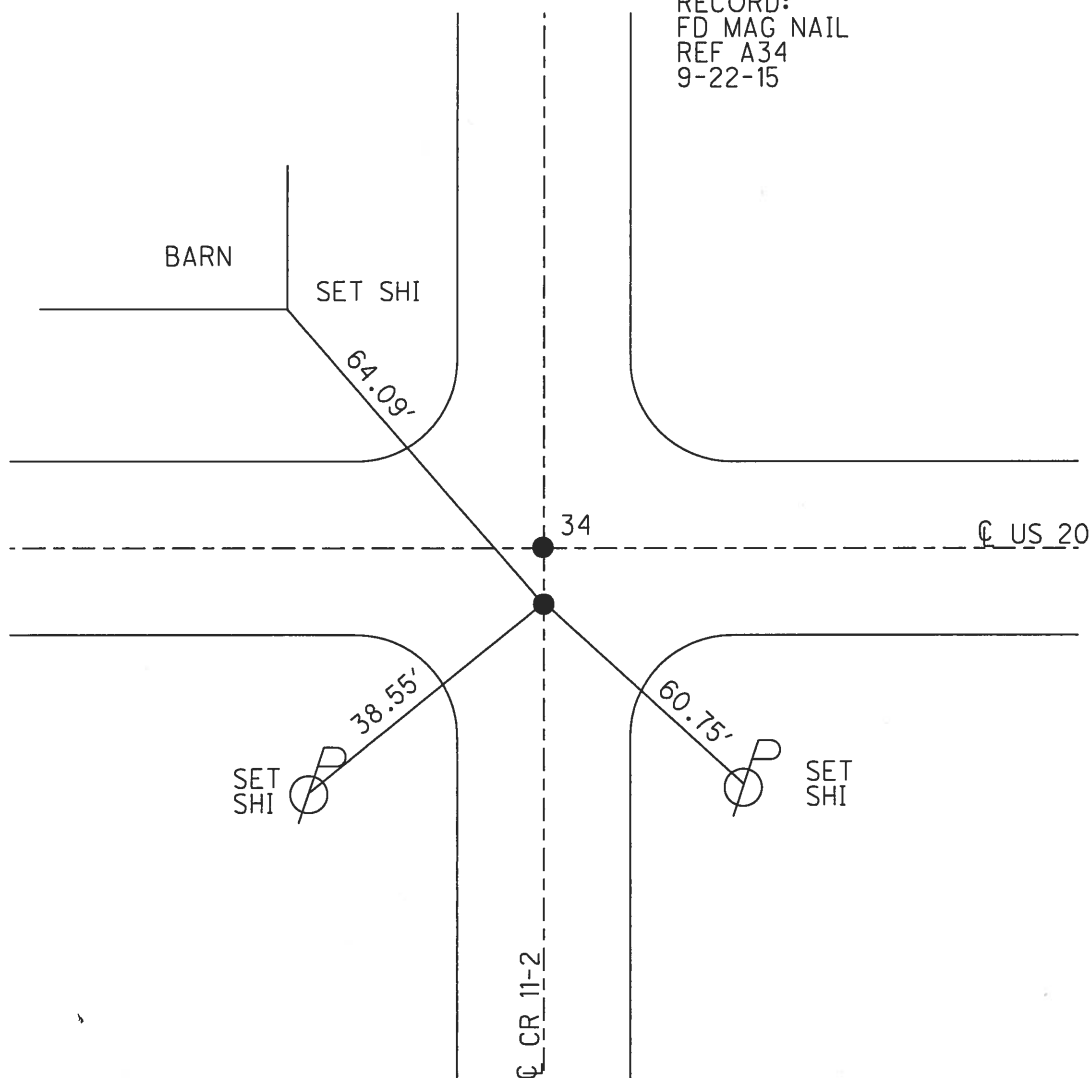

O.D.O.T. DISTRICT 2 SURVEY OFFICE (USE ONLY)

PERSONNEL

REFERENCE NO. 35

SHEET 14 OF 21

NOTES HOMAN
H.C. HOMAN
R.C. ROUSOS

DATE 5/9/08
WEATHER CLEAR
TEMP. 69°

ROUTE US 20
COUNTY FULTON
TOWNSHIP ROYALTON
SECTION 20
T 9 N R 3 E

DWG BY RHOADES PID 80672, 95725

TYPE MONUMENT P.K.NAIL

ON SURFACE - ~~BELOW~~ ON

OFFSET CL PAVEMENT ON LT : RT

- TO - EDGE PAVEMENT


STATION: 939+03.47

HORZ.DATUM: NAD83 2011

GEOID: NAVD88 2012A


GRID: NORTHING: 733863.994

EASTING: 1538311.890

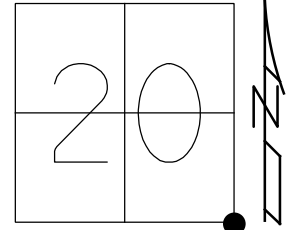

RECORD:
STA 944+61.5
FD P.K. NAIL
3-21-86, DC
SET P.K.NAIL
8-6-87
FD P.K.NAIL
5/9/08, DCH
D.N.F.
6-25-08, DCH
SET MAG/WASHER
RN11
PID #80672
STA: 939+05
10/29/09, DCH
D.N.F.
9-22-15, JFO
SET MAG/WASHER
4/12/17, JFO
PID #95725
SET MAG/WASHER
NEWREF35
6/25/18, JLL

NOTE:
SET MAG/SHINER
1/4/19, J.D.FENICLE
FULTON COUNTY
TIES=
N 30.02' FD "T" STAKE
NE 72.90' NEAR FACE 8" PVC WELL CASING
SW 32.01' SET FULTON CO. TAG PP
NW 110.96' SET "+" NE METAL CAGE F/GVALVE
NW 51.77' SET FULTON CO. TAG PP
N= 733864.373
E= 1538312.277

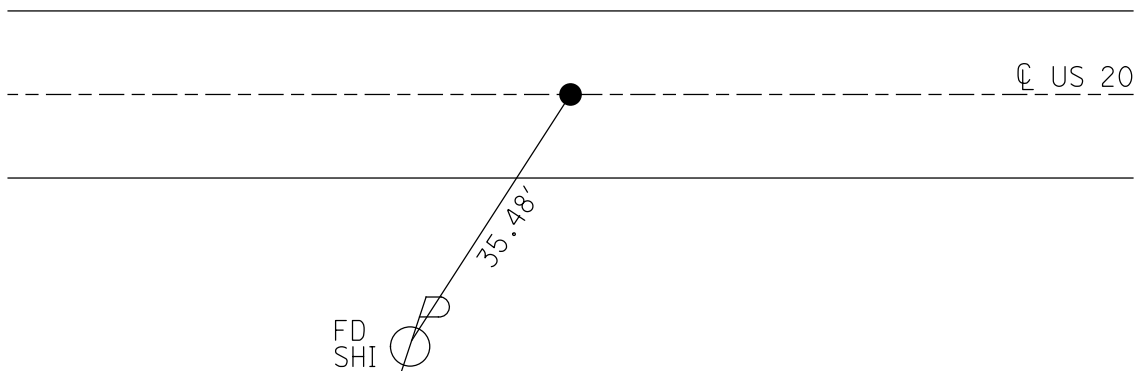

O.D.O.T. DISTRICT 2 SURVEY OFFICE (USE ONLY)

PERSONNEL

REFERENCE NO. 36

SHEET 15 OF 21

NOTES
H.C. RHOADES
R.C. O'DONNELL
HELDMAN

DATE 3/29/17
WEATHER CLEAR
TEMP. 40°

ROUTE US 20
COUNTY FULTON
TOWNSHIP ROYALTON
SECTION 21
T 9 S R 3 E

TYPE MONUMENT MAG/WASHER


ON SURFACE - ~~BELOW~~ ON

~~LEFT~~ - C PAV'T - ~~RIGHT~~ ON


TO EDGE PAVEMENT

S.L.M. 952+25.89

GRID: NORTHING: 733868.095 EASTING: 1539634.304

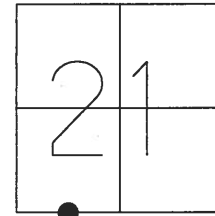

RECORD:
SET P.K. NAIL
8/6/87
FD P.K. NAIL
5/9/08, DCH
RESET MAG/WASHER
8/3/09, DCH
FD MAG/WASHER
REF36
9-22-15, JFO
SET MAG/WASHER
6-25-18, JLL

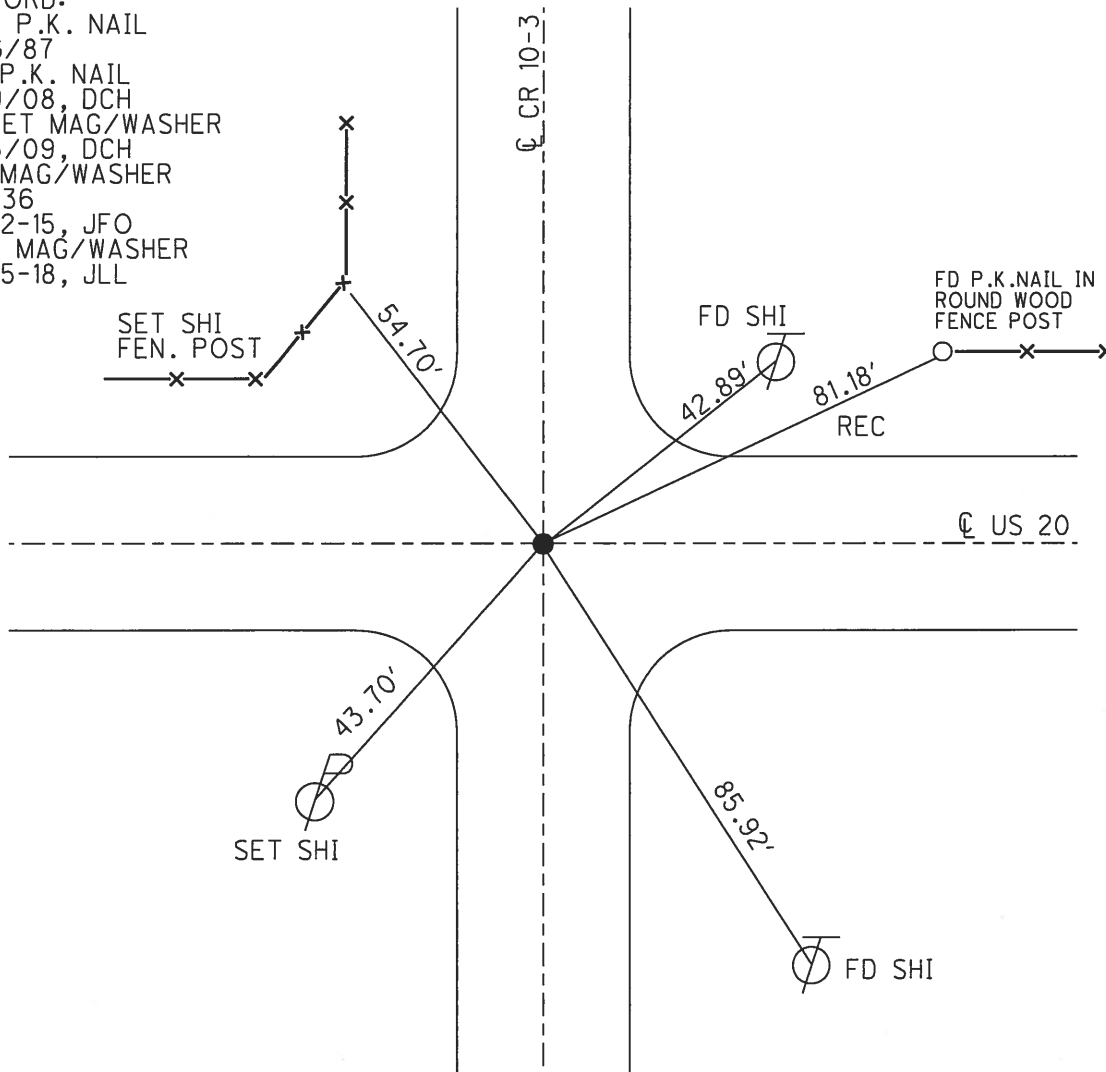

O.D.O.T. DISTRICT 2 SURVEY OFFICE (USE ONLY)

PERSONNEL

REFERENCE NO.

37

SHEET 16 OF 21

NOTES RHOADES

DATE 3/29/17

ROUTE US 20

H.C. O'DONNELL

WEATHER CLEAR

COUNTY FULTON

R.C. HELDMAN

TEMP. 40°

TOWNSHIP ROYALTONSECTION 21

T_9 S R_3 E

TYPE MONUMENT

MAG/WASHER

ON SURFACE - ~~BELOW~~ _____ ON


~~LEFT~~ - C PAV'T - ~~RIGHT~~ ON

11.9' TO RT EDGE PAVEMENT

S.L.M. 965+45.63

GRID: NORTHING: 733870.566 EASTING: 1540954.049

EASTING: 1540954.049

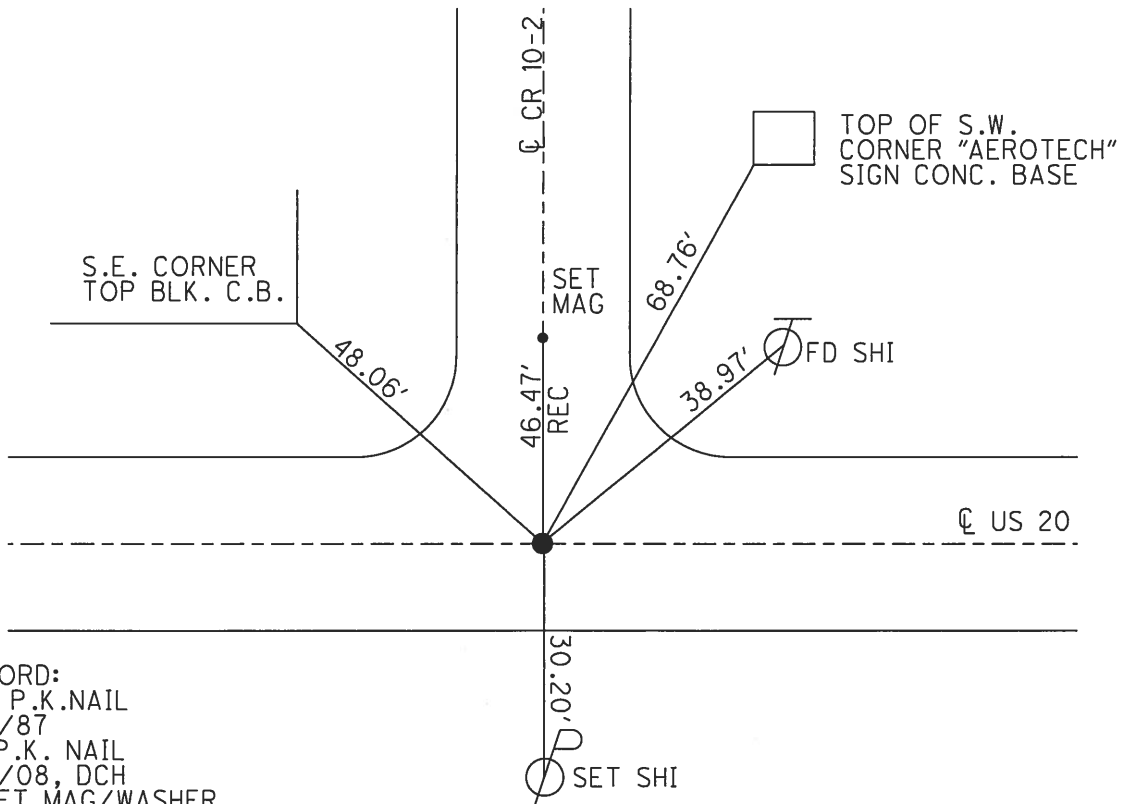

RECORD:

SET P.K.NAIL

8/6/87

FD P.K. NAIL

5/9/08, DCH

RESET MAG/WASHER

8/3/09, DCH

FD MAG/WASHER
25577

REF37

9-22-15, JFO

SET ,AH/WASHER

6-25-18, JLL

O.D.O.T. DISTRICT 2 SURVEY OFFICE (USE ONLY)

PERSONNEL

REFERENCE NO.

38

SHEET

17

OF

21

NOTES

RHOADES

DATE

3/29/17

ROUTE

US 20

H.C.

O'DONNELL

WEATHER

CLEAR

COUNTY

FULTON

R.C.

HELDMAN

TEMP.

52°

TOWNSHIP

ROYALTON

SECTION

21

T 9 S

R 3 E

TYPE MONUMENT

MAG/WASHER

ON SURFACE - ~~BELOW~~

ON

LEFT - ℄ PAV'T - ~~RIGHT~~

1'

TO EDGE PAVEMENT

S.L.M.


991+78.85

GRID: NORTHING:

733892.933

EASTING:

1543587.172

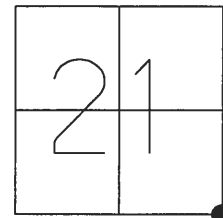

RECORD:

SET P.K. NAIL

8/6/87

FD P.K. NAIL

5/9/08, DCH

RESET MAG/WASHER

8/3/09, DCH


FD MAG/WASHER

REF38

9-22-15, JFO

SET MAG/WASHER

6-25-18, JLL

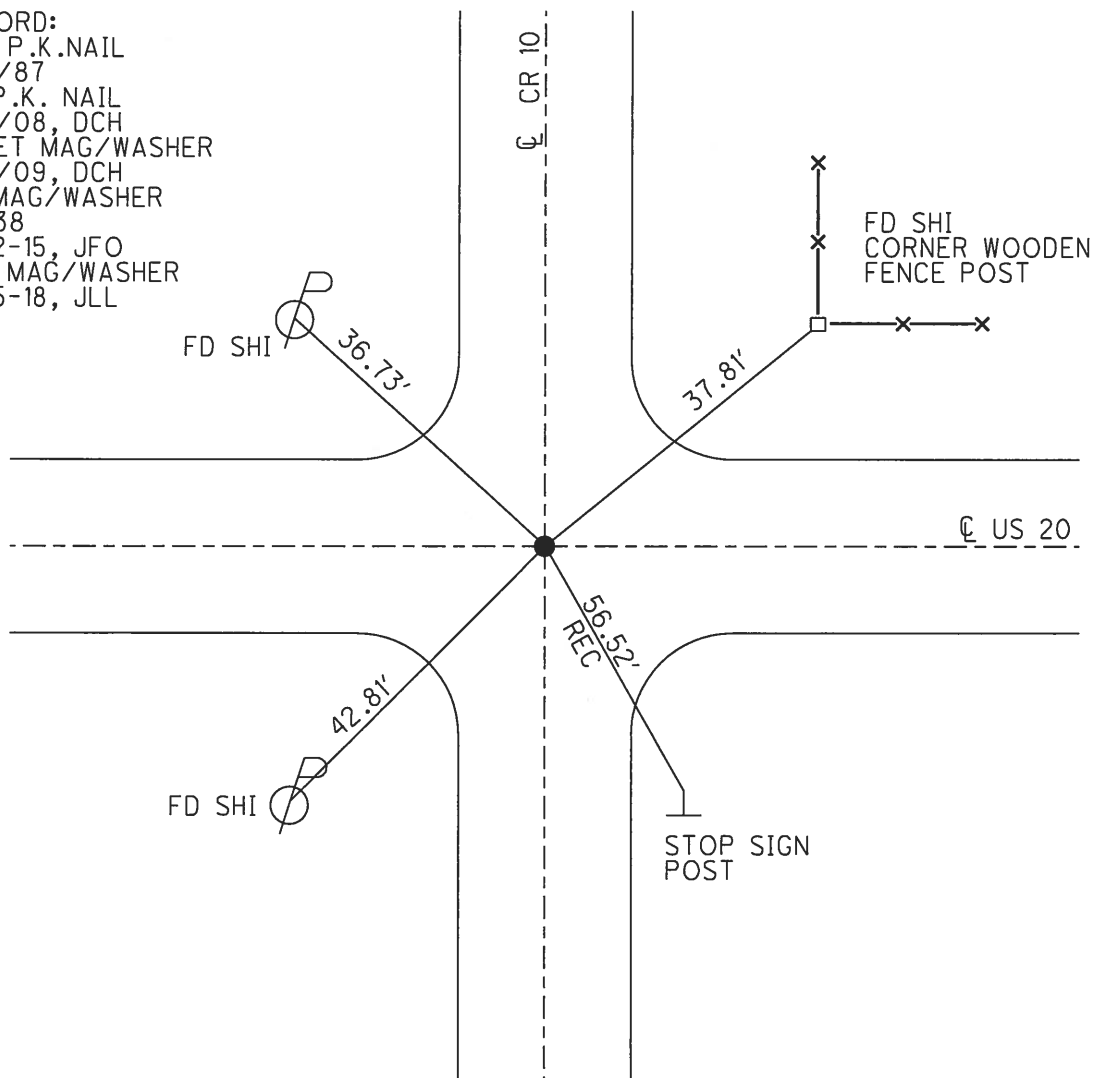


O.D.O.T. DISTRICT 2 SURVEY OFFICE (USE ONLY)


PERSONNEL	REFERENCE NO. <u>39</u>	SHEET <u>18</u> OF <u>21</u>
NOTES	DATE <u>3/29/17</u>	ROUTE <u>US 20</u>
H.C. <u>RHOADES</u>	WEATHER <u>CLEAR</u>	COUNTY <u>FULTON</u>
R.C. <u>O'DONNELL</u>	TEMP. <u>57°</u>	TOWNSHIP <u>ROYALTON</u>
		SECTION <u>22</u>
		T <u>9</u> N R <u>3</u> E

TYPE MONUMENT _____ MAG _____
 ON SURFACE - ~~BELOW~~ _____ ON _____
 LEFT - Q PAV'T - ~~RIGHT~~ _____ 0.4'
 _____ TO _____ EDGE PAVEMENT
 S.L.M. _____ 1018+37.95

GRID: NORTHING: 733891.432 EASTING: 1546246.270

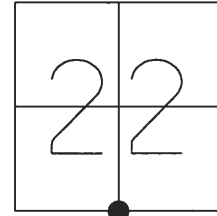

RECORD:
 SET P.K.NAIL
 8/6/87
 FD P.K. NAIL
 5/9/08, DCH
 RESET MAG/WASHER
 8/3/09, DCH
 FE MAG/WASHER
 REF39
 9-22-15, JFO
 SET MAG/WASHER
 6-25-18, JLL

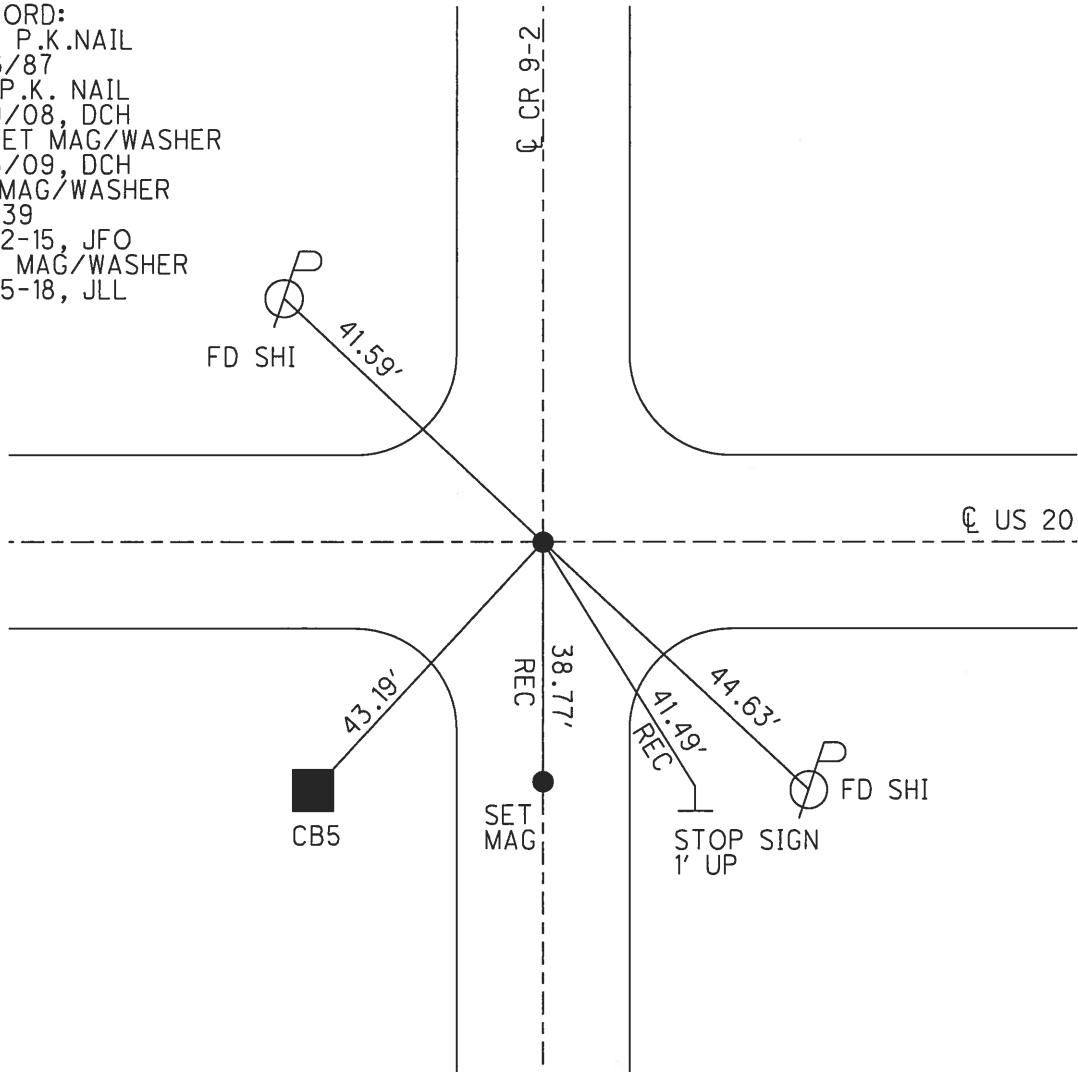


O.D.O.T. DISTRICT 2 SURVEY OFFICE (USE ONLY)


PERSONNEL _____ REFERENCE NO. 39 A SHEET 19 OF 21
NOTES RHOADES DATE 3/29/17 ROUTE US 20
H.C. O'DONNELL WEATHER CLEAR COUNTY FULTON
R.C. HELDMAN TEMP. 52° TOWNSHIP ROYALTON
SECTION 22
T 9 S R 3 E

TYPE MONUMENT _____ MAG/WASHER _____
ON SURFACE - ~~BELOW~~ _____ ON _____
~~LEFT~~ - Q PAV'T - ~~RIGHT~~ _____ ON _____
_____ TO _____ EDGE PAVEMENT
S.L.M. 1031+65.61

GRID: NORTHING: 733890.802 EASTING: 1547573.930

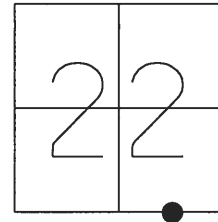


RECORD:
SET P.K.NAIL
8/6/87
DNF P.K. NAIL
5/12/08, DCH
RESET MAG/WASHER
8/3/09, DCH
FD MAG/WASHER
REFA39
9-24-15, JFO
SET MAG/WASHER
6-25-18, JLL

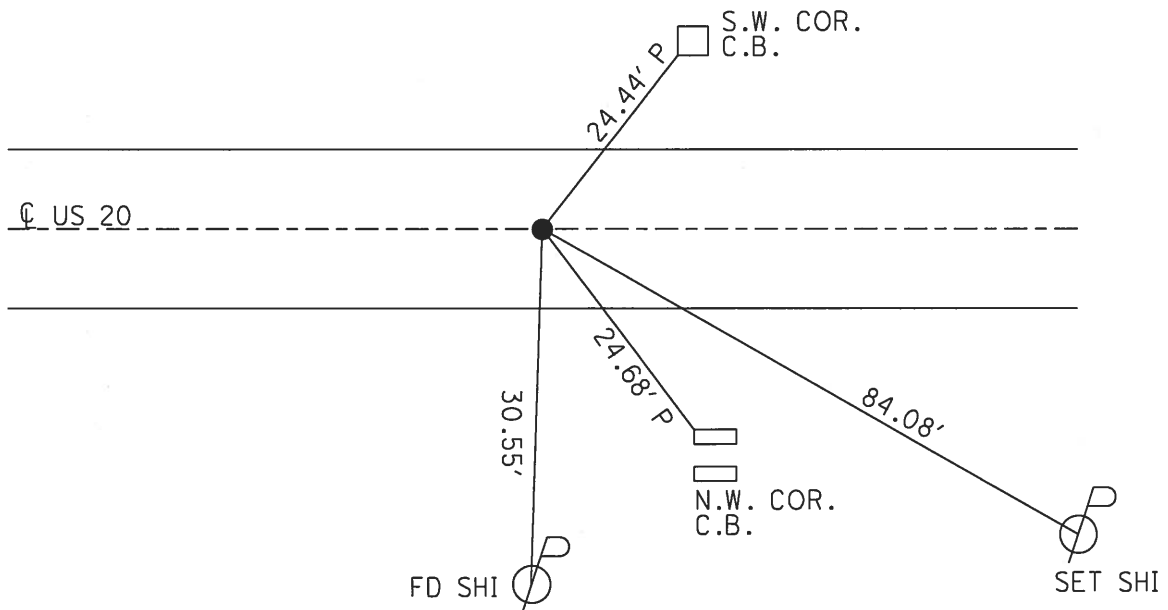

O.D.O.T. DISTRICT 2 SURVEY OFFICE (USE ONLY)

PERSONNEL	REFERENCE NO. <u>40</u>	SHEET <u>20</u> OF <u>21</u>
NOTES	DATE <u>6/5/09</u>	ROUTE <u>US 20</u>
H.C. <u>HOMAN</u>	WEATHER <u>CLEAR</u>	COUNTY <u>FULTON</u>
R.C. <u>ROUSOS</u>	TEMP. <u>69°</u>	TOWNSHIP <u>ROYALTON</u>
		SECTION <u>22</u>
		T <u>9</u> S R <u>3</u> E

TYPE MONUMENT MON BOX
 ON SURFACE - ~~BELOW~~ ON
~~LEFT - C~~ PAV'T - ~~RIGHT~~ ON
TO EDGE PAVEMENT
 S.L.M. 1044+93.31

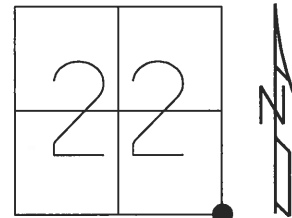


GRID: NORTHING: 733890.389 EASTING: 1548901.635

DIST. 40-40A= 6.11'

RECORD:
 SET PK./W
 8-6-87
 SET P.K./WASHER
 6/21/01, BVD
 FD P.K. NAILS
 5/12/08, DCH
 FD MON BOX
 COULD NOT OPEN
 9-24-15, JFO
 PULLED TIES TO
 MON BOX + SHOT LID
 REF40
 11-4-15, JFO

NOTE: AN OLD STONE WAS
 UNCOVERED BY THE CONTRACTOR
 WHILE DIGGING A HOLE TO SET
 A MON. BOX ON 7-10-01.
 A MON. ASSEMBLY WAS SET
 OVER STONE WITH SOME
 MINOR ADJUSTMENT ON THE
 LENGTH OF PIN.
 THE STONE WAS FOUND APPROX.
 24" DOWN WITH NO SIGNIFICANT
 DIFFERENCE IN LOCATION FROM
 PERPETUATED POINT.
 7-24-00 S.H.

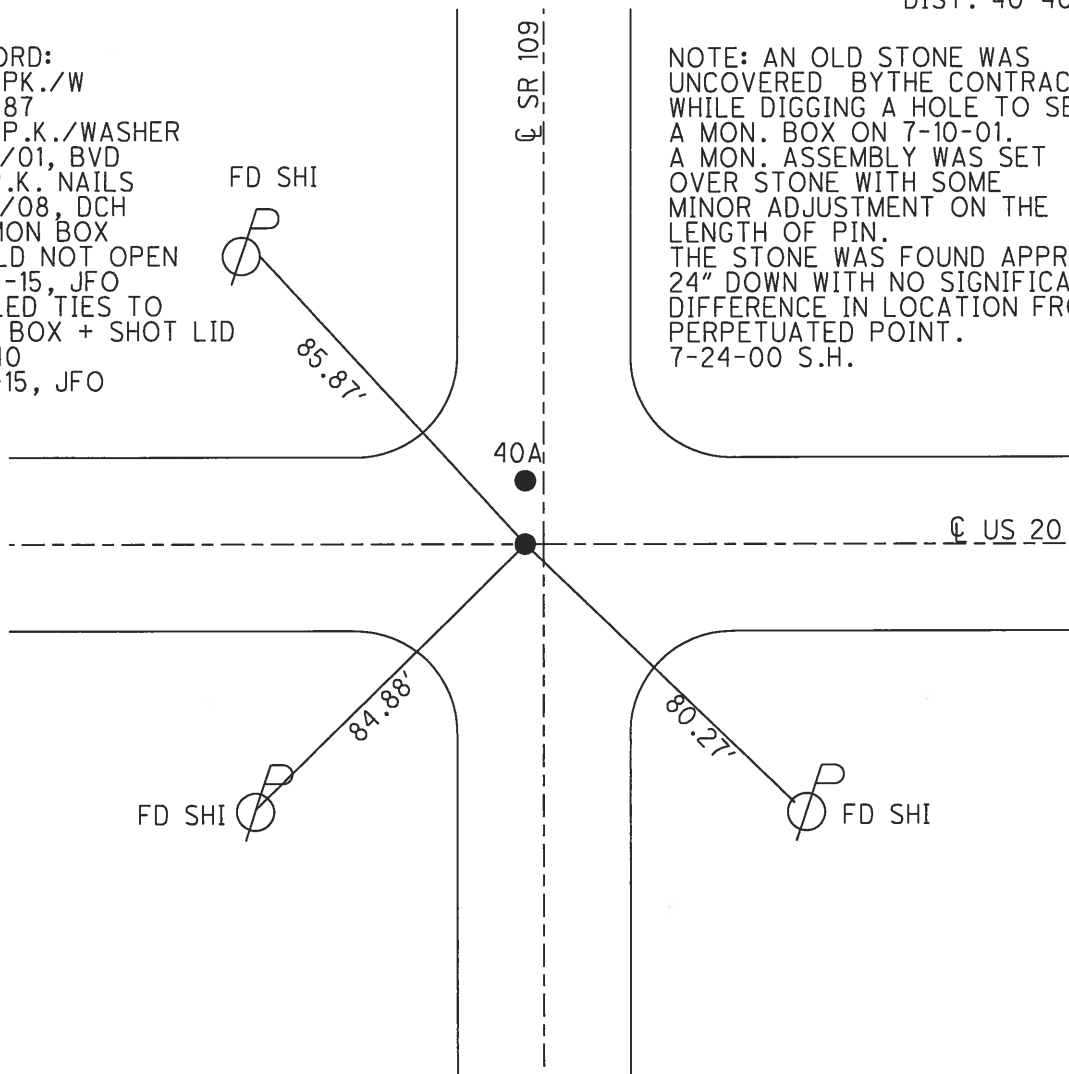

O.D.O.T. DISTRICT 2 SURVEY OFFICE (USE ONLY)

PERSONNEL

REFERENCE NO.

40 A

SHEET

21

OF

21

NOTES

RHOADES

DATE

4/11/17

ROUTE

US 20

H.C.

O'DONNELL

WEATHER

CLOUDY

COUNTY

FULTON

R.C.

HELDMAN

TEMP.

56°

TOWNSHIP

ROYALTON

SECTION

22

T 9 S

R 3 E

TYPE MONUMENT

P.K. & WASHER

ON SURFACE - ~~BELOW~~

ON

LEFT - ℄ PAV'T - ~~RIGHT~~


6.75'

TO EDGE PAVEMENT

S.L.M. 1044+93.04

GRID: NORTHING: 733896.487

EASTING: 1548901.358

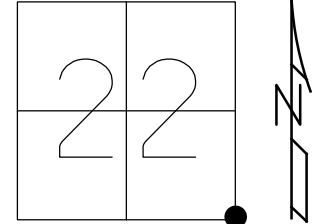

DIST. 40-40A= 6.11'

RECORD:

SET P.K./W

8-6-87

SET P.K./WASHER

6-21-01, BVD

FD P.K. NAILS

5-12-08, DCH


FD P.K./WASHER

REFA40

9-24-15, JFO

SET MAG/WASHER

6-29-18, JFO

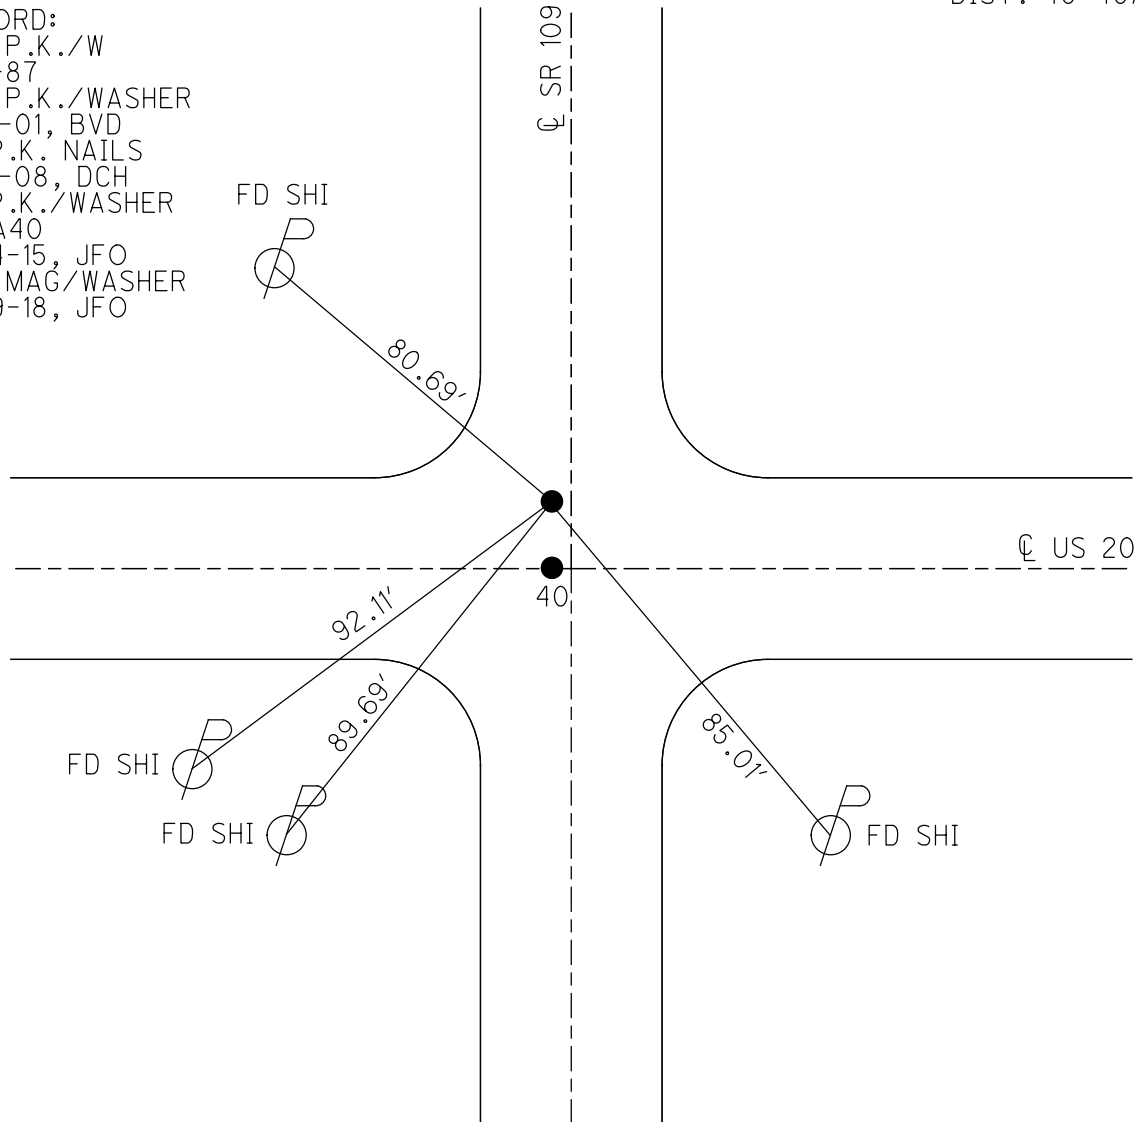

O.D.O.T. DISTRICT 2 SURVEY OFFICE (USE ONLY)

PERSONNEL

REFERENCE NO. 41

SHEET 1 OF 28


NOTES RHOADES
H.C. O'DONNELL
R.C. HELDMAN

DATE 4/11/17
WEATHER CLOUDY
TEMP. 56°


ROUTE US 20
COUNTY FULTON
TOWNSHIP ROYALTON
SECTION 23
T 9 S R 3 E

TYPE MONUMENT _____ MAG NAIL
ON SURFACE - ~~BELOW~~ _____ ON
~~LEFT -~~ ℄ PAV'T - ~~RIGHT~~ _____ ON
_____ TO _____ EDGE PAVEMENT
S.L.M. 1071+46.20

GRID: NORTHING: 733891.188 EASTING: 1551554.517

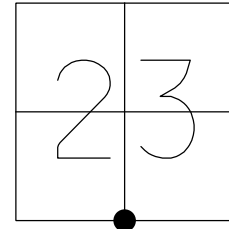

RECORD:
S 1/4 COR. SEC. 23
SET P.K./WASHER
6-21-01, BVD
FD HOLE WHERE PK/WASHER WERE
TIES GOOD. RESET AFTER PRPJECT
9-24-15, JFO
SET MAG/WASHER
REF41
11-4-15, JFO
SET MAG/WASHER
6-29-18, JFO

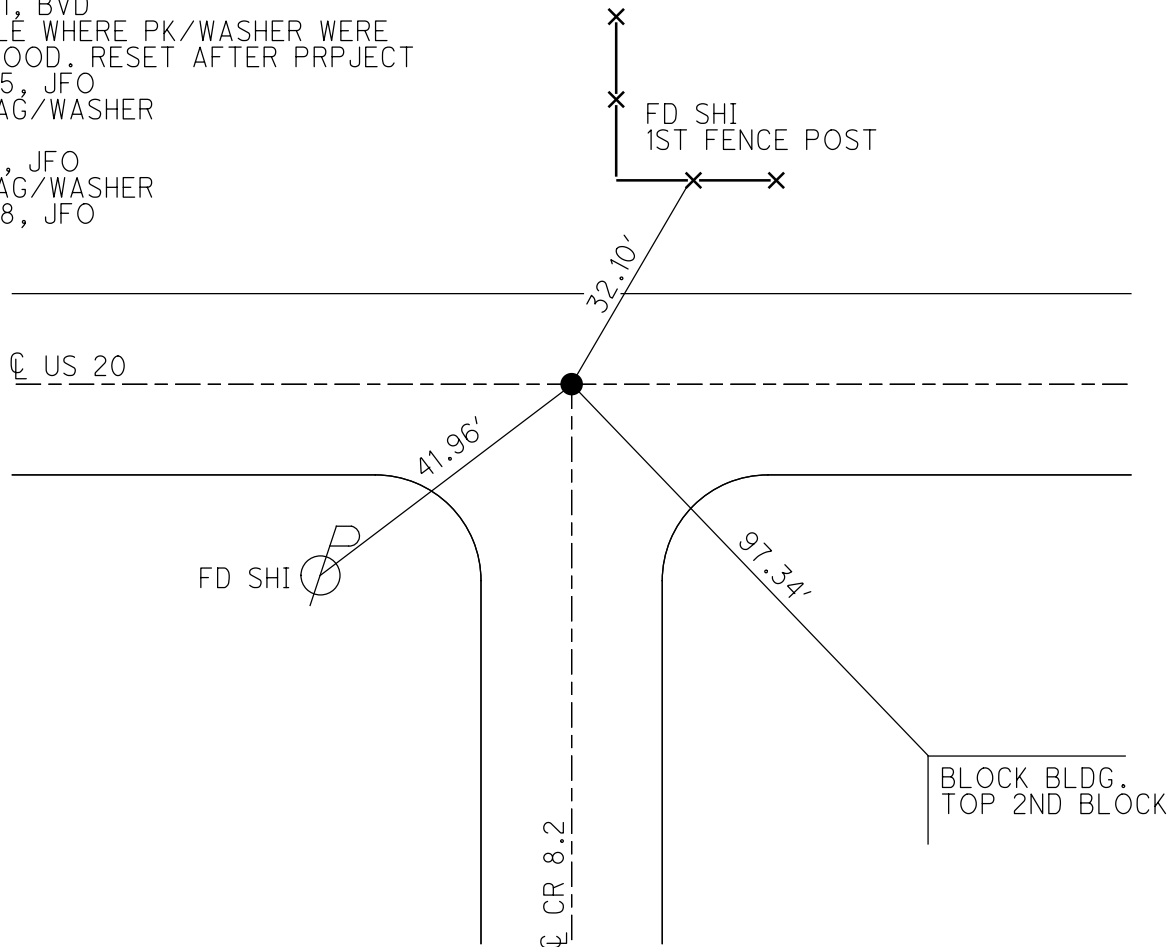


O.D.O.T. DISTRICT 2 SURVEY OFFICE (USE ONLY)

PERSONNEL	REFERENCE NO.	42	SHEET	2	OF	28
NOTES	RHOADES	DATE	4/11/17	ROUTE	US 20	
H.C.	O'DONNELL	WEATHER	CLOUDY	COUNTY	FULTON	
R.C.	HELDMAN	TEMP.	56°	TOWNSHIP	ROYALTON	
				SECTION	23	
				T	9	S
				R	3	E


TYPE MONUMENT _____ MAG NAIL _____
ON SURFACE - ~~BELOW~~ _____ ON _____
~~LEFT~~ - ℄ PAV'T - RIGHT _____ 1' _____
_____ TO _____ EDGE PAVEMENT
S.L.M. 1097+98.99

GRID: NORTHING: 733890.799 EASTING: 1554207.311

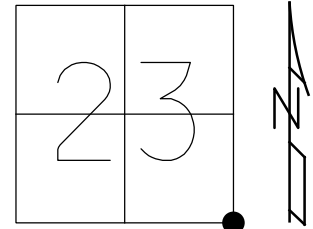

42 TO 42A = 2.67'

RECORD:
SE. COR. SEC. 23
SM. SPIKE SET
8-27-86
SET P.K./WASHER
6-21-01, BVD
FD MAG NAIL
REF42
9-24-15, JFO
SET MAG/WASHER
6-29-18, JFO

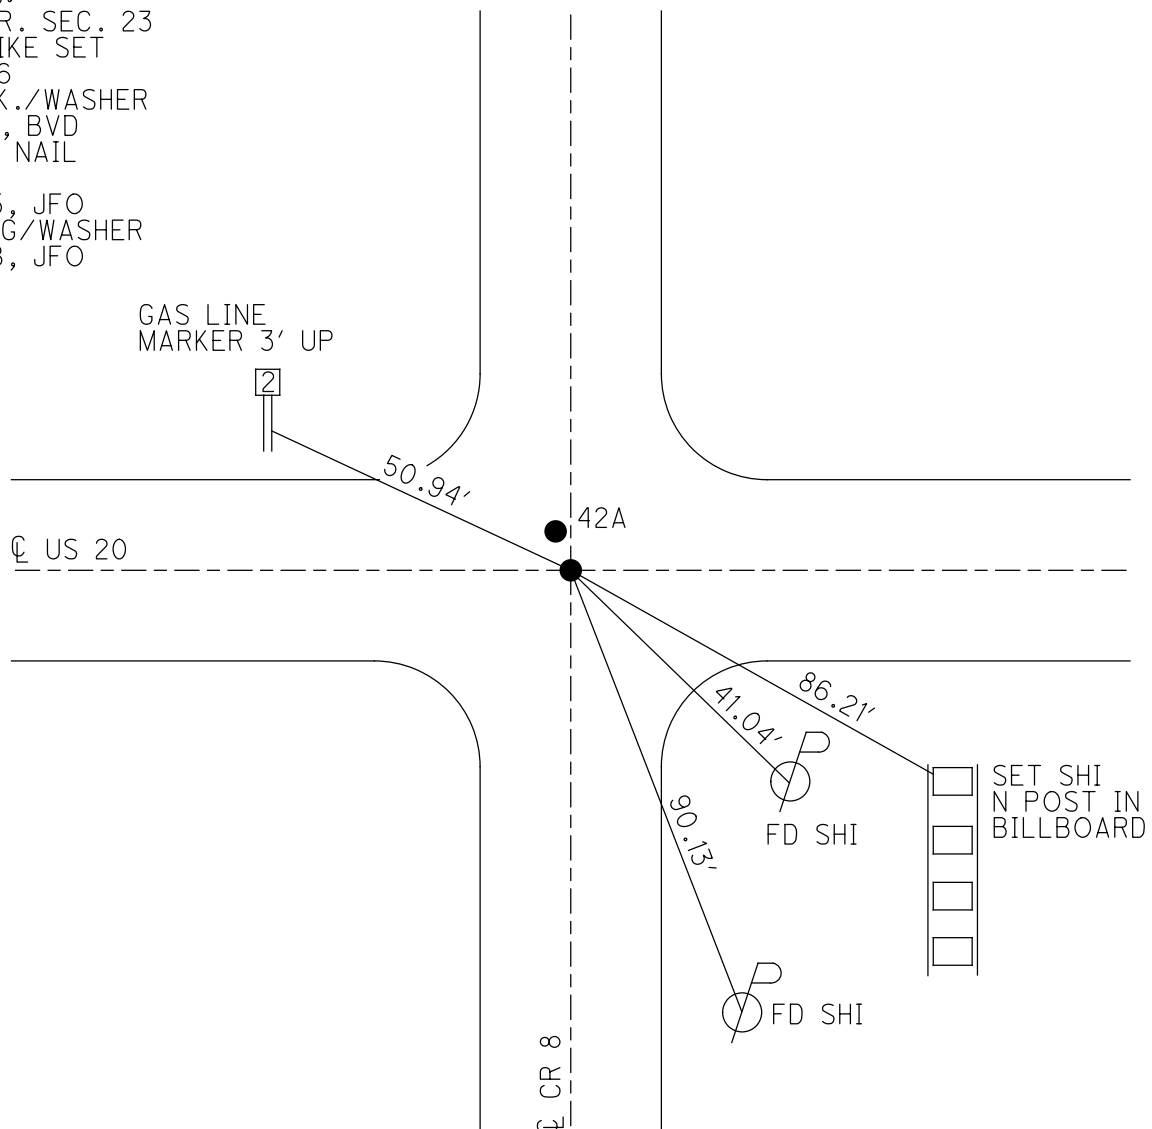

O.D.O.T. DISTRICT 2 SURVEY OFFICE (USE ONLY)

PERSONNEL

REFERENCE NO.

42 A

SHEET

3

OF

28

NOTES

RHOADES

DATE

4/11/17

ROUTE

US 20

H.C.

O'DONNELL

WEATHER

CLOUDY

COUNTY

FULTON

R.C.

HELDMAN

TEMP.

56°

TOWNSHIP

ROYALTON

SECTION

23

T 9 S

R 3 E

TYPE MONUMENT

P.K. SHANK

ON SURFACE - ~~BELOW~~

ON

LEFT - ℄ PAV'T - ~~RIGHT~~

1.7'


TO EDGE PAVEMENT

S.L.M.


1044+93.04


GRID: NORTHING: 733893.279

EASTING: 1554206.288

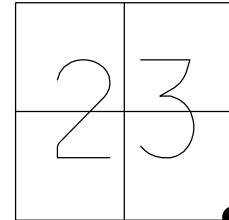

42 TO 42A = 2.67'

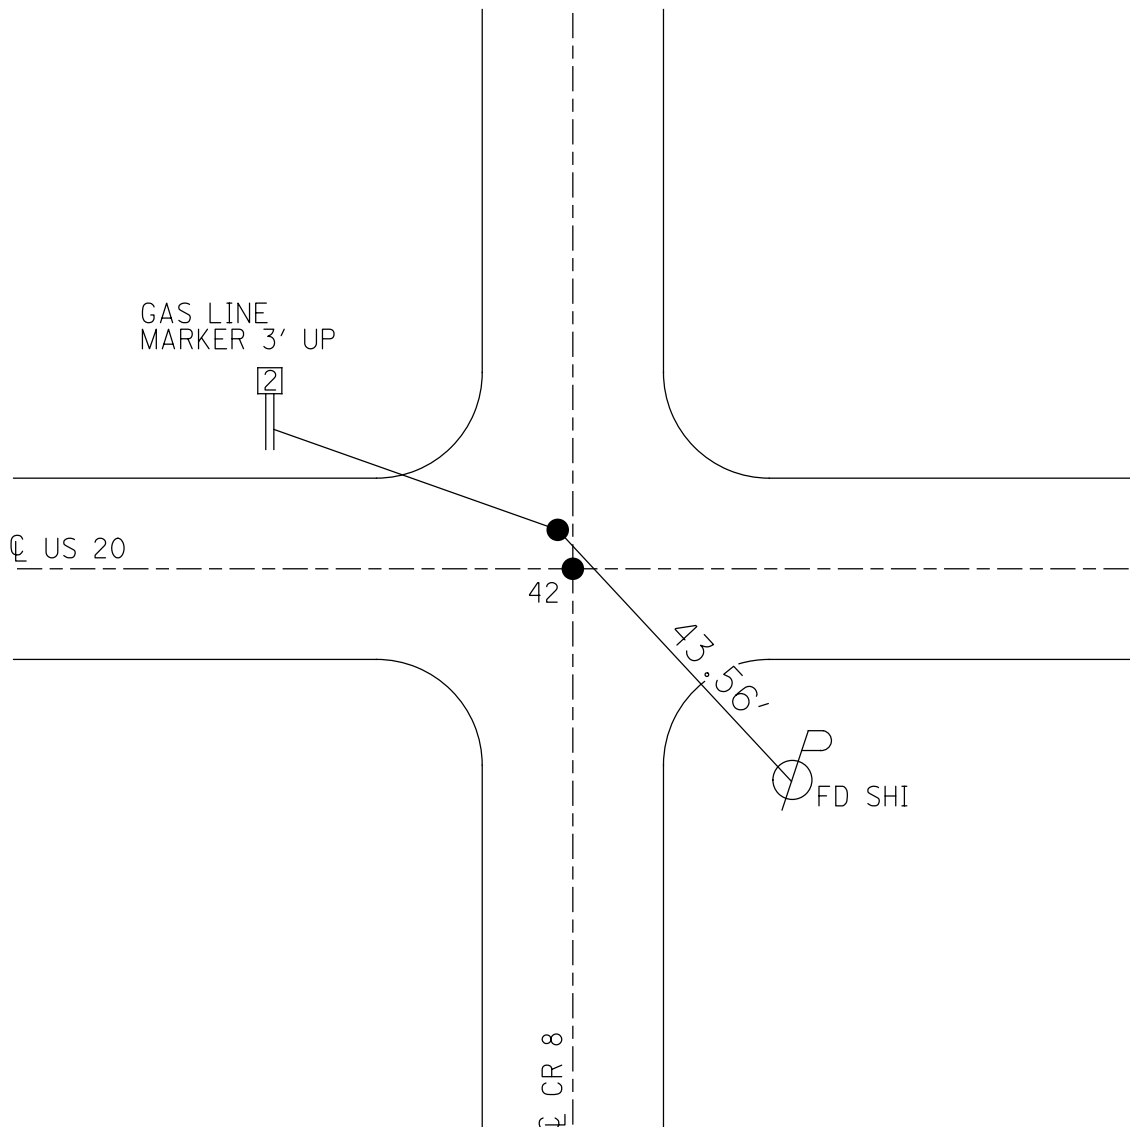

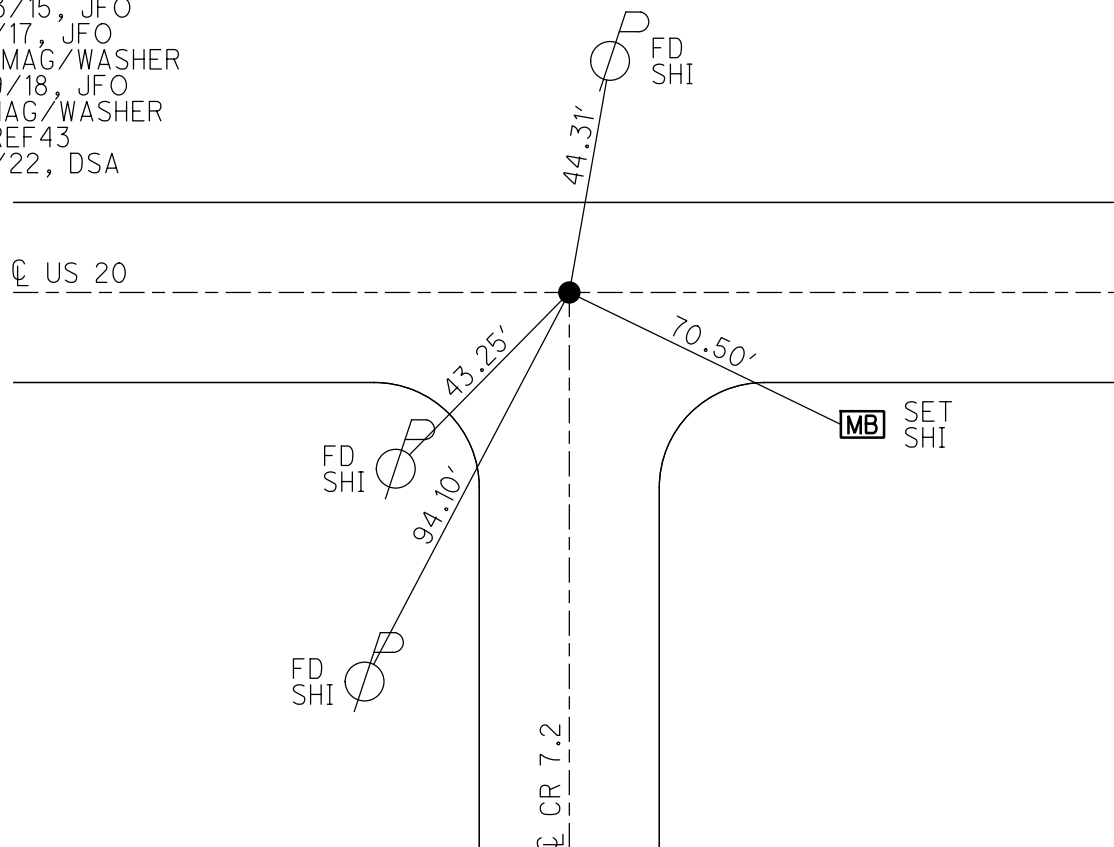

O.D.O.T. DISTRICT 2 SURVEY OFFICE (USE ONLY)

PERSONNEL

REFERENCE NO. 43 A

SHEET 5 OF 28

NOTES RHOADES

DATE 4/11/17

ROUTE US 20

H.C. O'DONNELL

WEATHER CLOUDY

COUNTY FULTON

R.C. HELDMAN

TEMP. 56°

TOWNSHIP ROYALTON

DWG BY NIESE PID NO PID R/W

SECTION 24

T 9 S R 3 E

TYPE MONUMENT P.K./WASHER

ON SURFACE - ~~BELOW~~ ON

OFFSET CL PAVEMENT ON LT : RT

- TO - EDGE PAVEMENT


STATION: 1150+79.30

HORIZ.DATUM: NAD83 2011

GEOID: NAVD88 2018

GRID: NORTHING: 733696.781

EASTING: 1559484.051

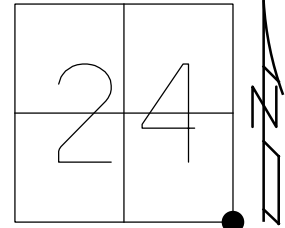

RECORD:

S.E. COR. SEC. 24

STA. 1156+62.43

1932 PLAN

SET P.K./WASHER

6/21/01, BVD

FD P.K./WASHER

REFA43

10/13/15, JFO

4/11/17, JFO


SET MAG/WASHER

6/26/18, JFO

FD MAG/WASHER

1/14/22, DSA

FD "+" IN FACE
PIER COLUMN OF
R.R. BRIDGE

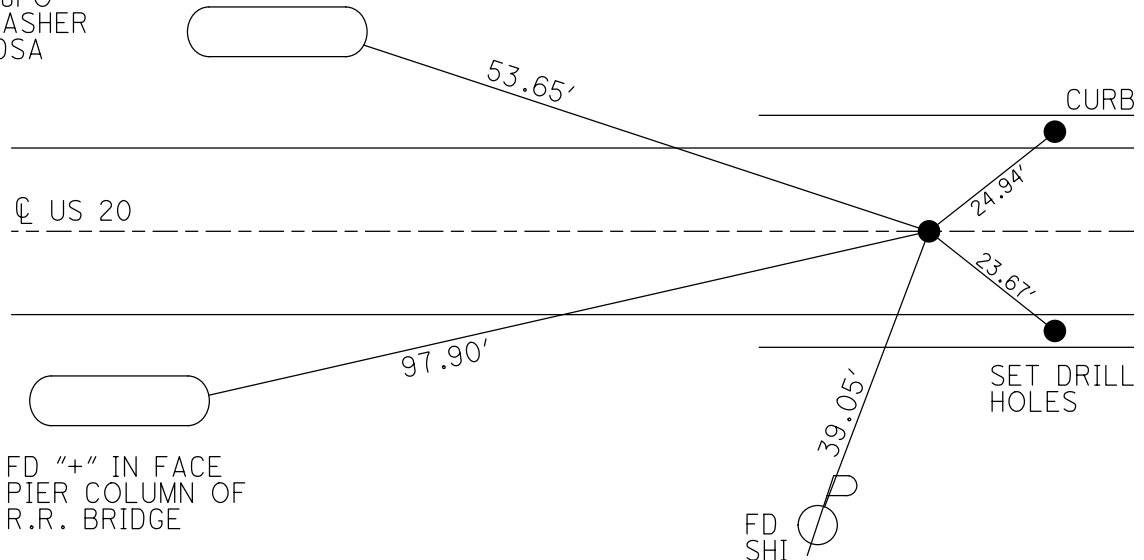

O.D.O.T. DISTRICT 2 SURVEY OFFICE (USE ONLY)

PERSONNEL

REFERENCE NO. 43 B

SHEET 6 OF 28

NOTES RHOADES

DATE 7/10/18

ROUTE US 20

H.C. O'DONNELL

WEATHER CLOUDY

COUNTY FULTON

R.C. RHOADES

TEMP. 87°

TOWNSHIP AMBOY

DWG BY NIESE

PID NO PID R/W

SECTION 19

T 9 S R 4 E

TYPE MONUMENT SET MAG/WASHER

ON SURFACE - ~~BELOW~~ ON

OFFSET Q PAVEMENT 2.5' N OF CURB ~~LT~~ : RT

- TO - EDGE PAVEMENT


STATION: 1153+49.22

HORZ.DATUM: NAD83 2011


GEOID: NAVD88 2018

GRID: NORTHING: 733686.168

EASTING: 1559753.763

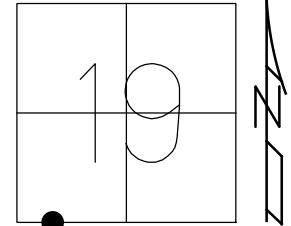

RECORD: P.I.
STA 1159+32.43
 $\Delta = 14^{\circ}25'$ LT
L=145
R= 1146.3
8/27/86, IRS
DNF
10/13/15
SHOT TIE XING
REFB43
11/4/15, JFO
SET MAG/WASHER
7/10/18, JFO
FD MAG/WASHER
RECREFB43
1/14/22, DSA

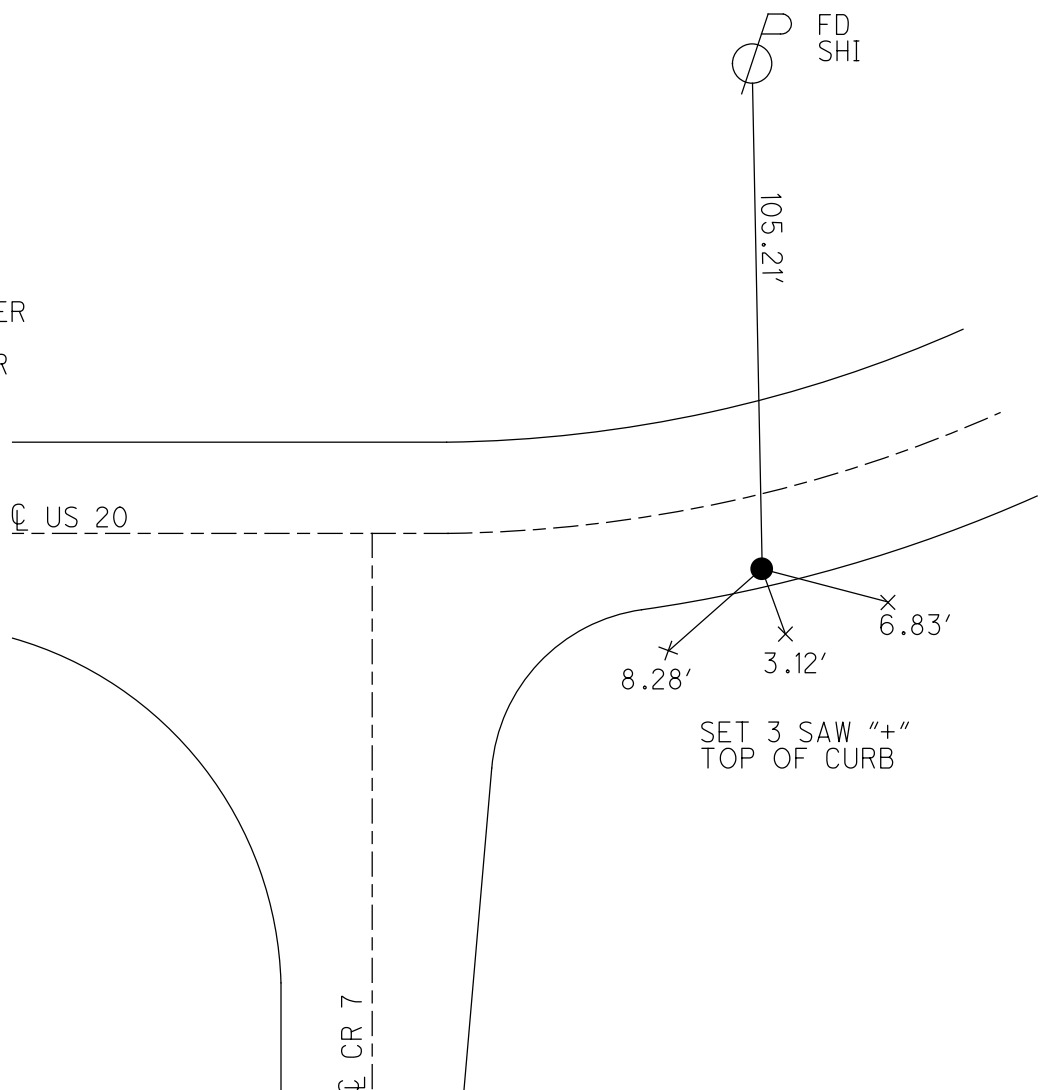

O.D.O.T. DISTRICT 2 SURVEY OFFICE (USE ONLY)

PERSONNEL

REFERENCE NO. 43 C

SHEET 7 OF 28

NOTES RHOADES

DATE 4/11/17

ROUTE US 20

H.C. O'DONNELL

WEATHER CLEAR

COUNTY FULTON

R.C. RHOADES

TEMP. 56°

TOWNSHIP AMBOY

SECTION 19

DWG BY NIESE PID NO PID R/W

T 9 S R 4 E

TYPE MONUMENT P.K. SHANK (HOLE)

ON SURFACE - ~~BELOW~~ ON

OFFSET Q PAVEMENT 1.7' TO N EP LT : RT

1.7' TO LT EDGE PAVEMENT


STATION: 1157+05.88

HORIZ.DATUM: NAD83 2011


GEOID: NAVD88 2018

GRID: NORTHING: 733761.661

EASTING: 1560102.346

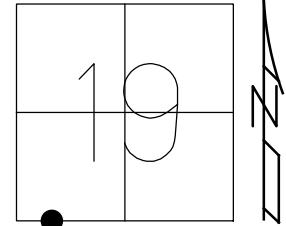

RECORD: P.I.
STA. 1162+87.62
 $\Delta = 12^\circ 27' 20''$
T = 125.09'
R = 1146.3
SET P.K./WASHER
6/21/01, BVD
D.N.F.
TIES X-ED TO
HOLE IN ROAD
REFC43
10/13/15, JFO
SET MAG/WASHER
4/11/17, JFO
FD MAG/WASHER
RECREFC43
1/14/22, DSA

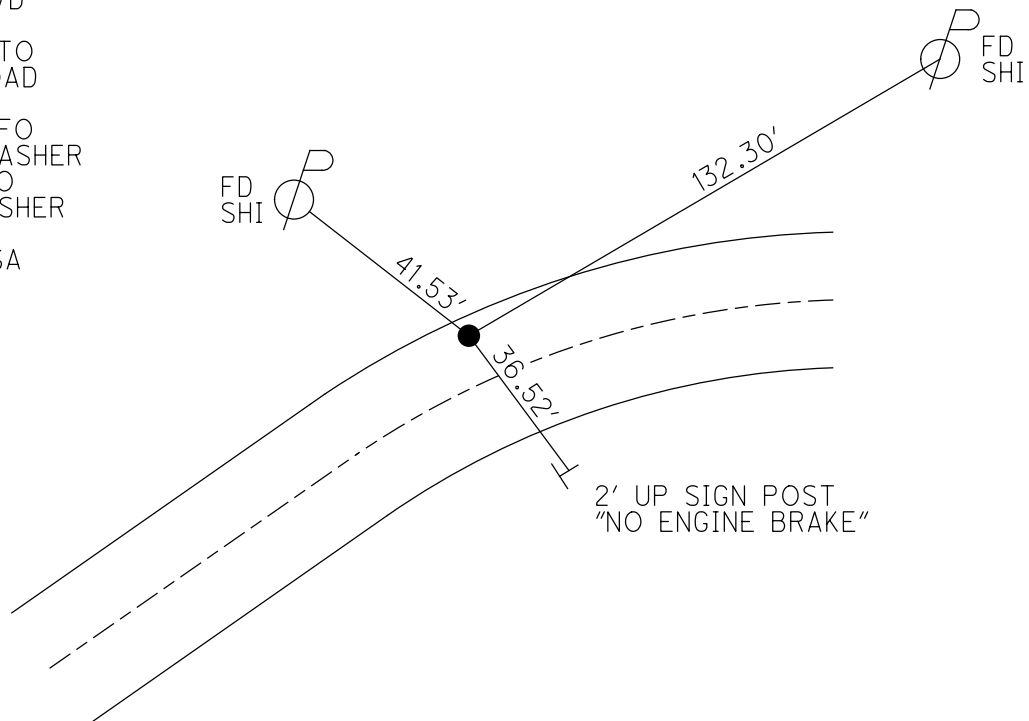


O.D.O.T. DISTRICT 2 SURVEY OFFICE (USE ONLY)


PERSONNEL	REFERENCE NO. <u>44</u>	SHEET <u>8</u> OF <u>28</u>
NOTES	DATE <u>4/11/17</u>	ROUTE <u>US 20</u>
H.C. <u>RHOADES</u>	WEATHER <u>CLOUDY</u>	COUNTY <u>FULTON</u>
R.C. <u>O'DONNELL</u>	TEMP. <u>56°</u>	TOWNSHIP <u>AMBOY</u>
<u>HELDMAN</u>		SECTION <u>19</u>
		T <u>9</u> S R <u>4</u> E

TYPE MONUMENT R.R. SPIKE
 ON SURFACE - BELOW 4"
~~LEFT~~ - Q PAV'T - ~~RIGHT~~ ON
TO EDGE PAVEMENT
 S.L.M. 1167+90.04

GRID: NORTHING: 733756.391 EASTING: 1561186.494

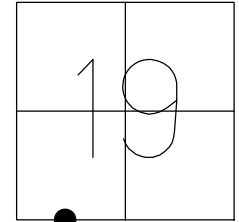

RECORD:
 SET SPIKE
 8-27-86
 SET P.K./WASHER
 6-22-01, BVD
 FD P.K. NAIL
 REF44
 10-13-15, JFO
 SET MAG/WASHER
 6-26-18, JFO

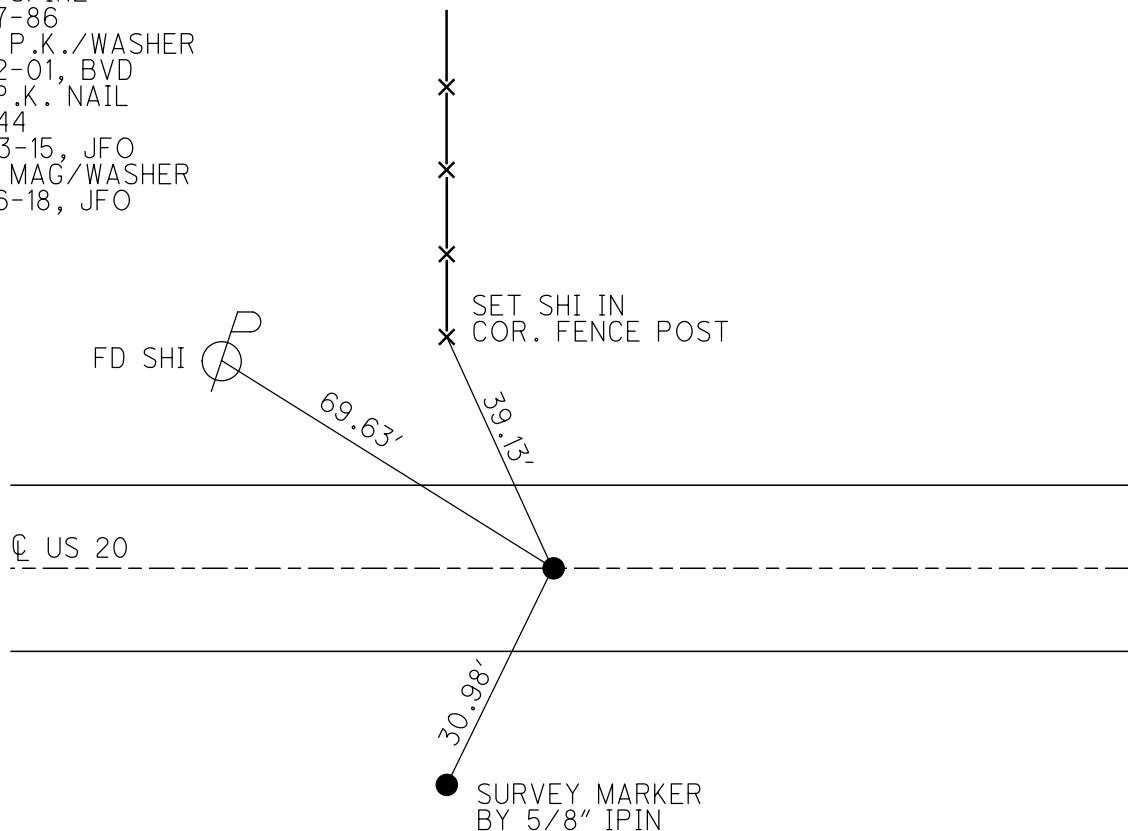


O.D.O.T. DISTRICT 2 SURVEY OFFICE (USE ONLY)

PERSONNEL	REFERENCE NO. <u>45</u>	SHEET <u>9</u> OF <u>28</u>
NOTES	DATE <u>4/11/17</u>	ROUTE <u>US 20</u>
H.C. <u>RHOADES</u>	WEATHER <u>CLOUDY</u>	COUNTY <u>FULTON</u>
R.C. <u>O'DONNELL</u>	TEMP. <u>56°</u>	TOWNSHIP <u>AMBOY</u>
		SECTION <u>19</u>
		T <u>9</u> S R <u>4</u> E


TYPE MONUMENT _____ P.K./WASHER _____
 ON SURFACE - ~~BELOW~~ _____ ON _____
~~LEFT~~ - Q PAV'T - ~~RIGHT~~ _____ ON _____
 _____ TO _____ EDGE PAVEMENT
 S.L.M. 1184+77.99

GRID: NORTHING: 733748.292 EASTING: 1562874.425

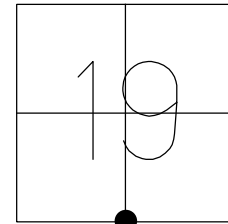

RECORD:
 S. 1/4 COR. SEC. 19
 8-27-86
 SET P.K./WASHER
 6-22-01, BVD
 FD P.K./WASHER
 REF45
 10-13-15, JFO
 SET MAG/WASHER
 6-26-18, JFO


SET SHI
 4x4" POST
 FEN

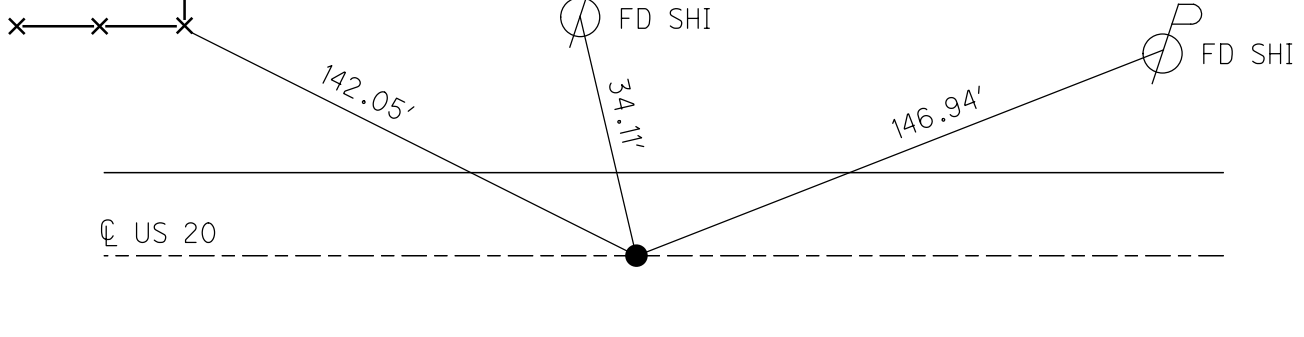


O.D.O.T. DISTRICT 2 SURVEY OFFICE (USE ONLY)

PERSONNEL	REFERENCE NO.	<u>45A</u>	SHEET	<u>10</u>	OF	<u>28</u>
NOTES	RHOADES	DATE	<u>4/11/17</u>	ROUTE	<u>US 20</u>	
H.C.	<u>O'DONNELL</u>	WEATHER	<u>CLOUDY</u>	COUNTY	<u>FULTON</u>	
R.C.	<u>HELDMAN</u>	TEMP.	<u>56°</u>	TOWNSHIP	<u>AMBOY</u>	
				SECTION	<u>19</u>	
				T <u>9</u> S	R <u>4</u> E	

TYPE MONUMENT _____ P.K./WASHER _____
ON SURFACE - ~~BELOW~~ _____ ON _____
LEFT - ℄ PAV'T - ~~RIGHT~~ _____ 0.5'
_____ TO _____ EDGE PAVEMENT
S.L.M. 1197+95.85
GRID: NORTHING: 733738.539 EASTING: 1564192.244

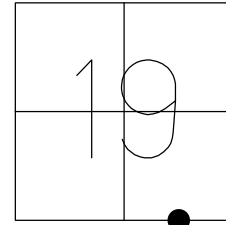


RECORD:
1/16 COR. SEC. 19
8-17-86
SET P.K./WASHER
6-22-01, BVD
FD P.K./WASHER
REFA45
10-13-15, JFO
SET MAG/WASHER
6-26-18, JFO

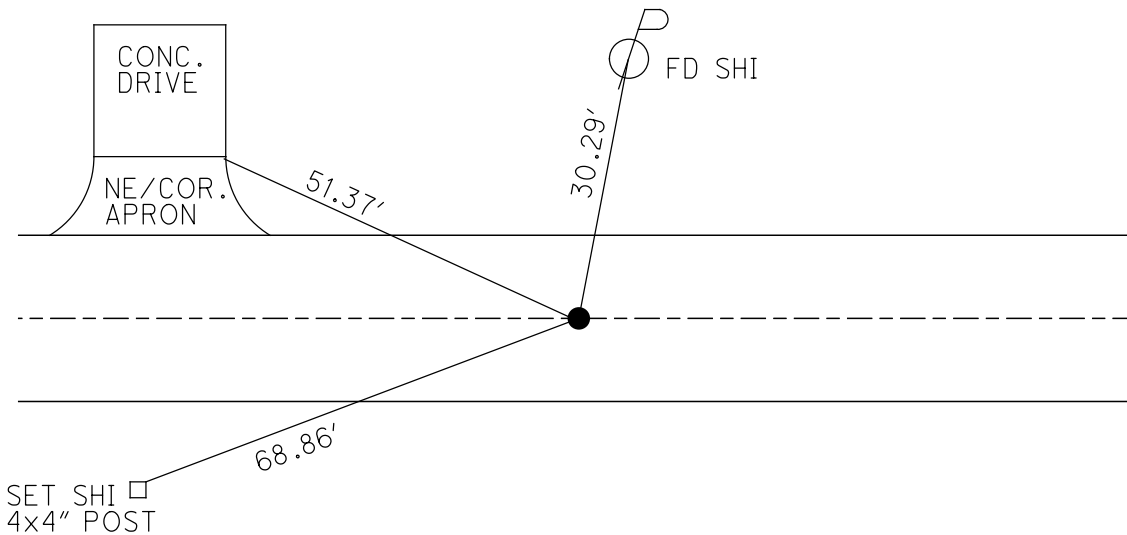


O.D.O.T. DISTRICT 2 SURVEY OFFICE (USE ONLY)

PERSONNEL	REFERENCE NO. <u>46</u>	SHEET <u>11</u> OF <u>28</u>
NOTES	DATE <u>8/28/00</u>	ROUTE <u>US 20</u>
H.C. <u>HOSS</u>	WEATHER <u>FAIR</u>	COUNTY <u>FULTON</u>
R.C. <u>CORDS</u>	TEMP. <u>82°</u>	TOWNSHIP <u>AMBOY</u>
<u>VAN DUSEN</u>		SECTION <u>19</u>
		T <u>9</u> S R <u>4</u> E

TYPE MONUMENT R.R. SPIKE
~~ON SURFACE~~ - BELOW 1.5"
~~LEFT - C~~ PAV'T - ~~RIGHT~~ ON
TO EDGE PAVEMENT
 S.L.M. 1211+13.54
 GRID: NORTHING: 733728.812 EASTING: 1565509.898

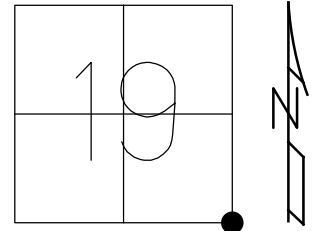

RECORD:
 S.E. COR. SEC. 19
 8-27-86
 SET P.K./WASHER
 6-22-01, BVD
 FD MONBAX 1' IPIN
 REF46
 10-14-15, JFO
 FD IPIN
 6-26-18, JFO

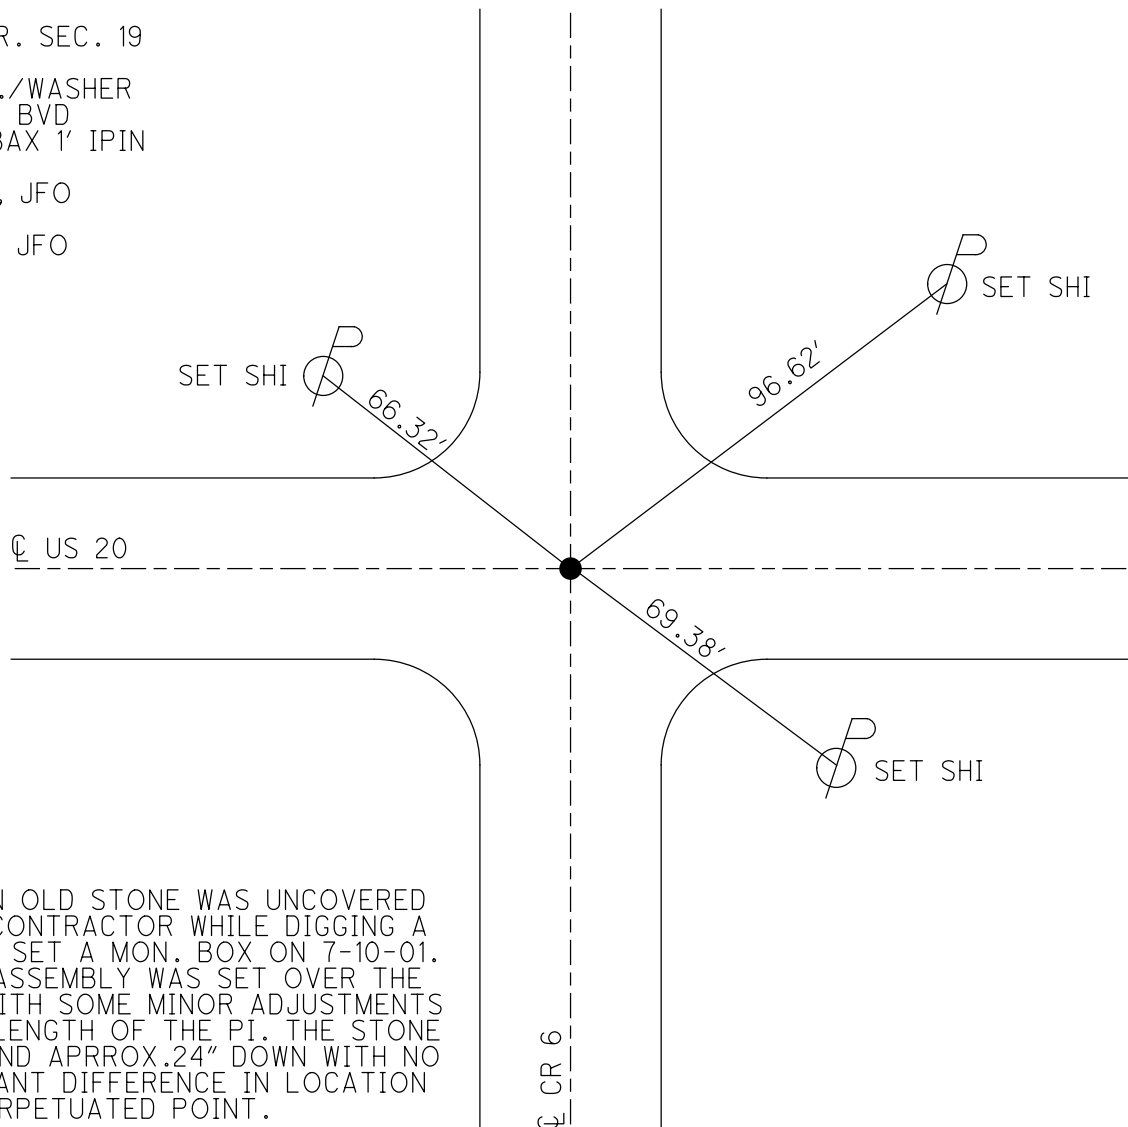

NOTE: AN OLD STONE WAS UNCOVERED
 BY THE CONTRACTOR WHILE DIGGING A
 HOLE TO SET A MON. BOX ON 7-10-01.
 A MON. ASSEMBLY WAS SET OVER THE
 STONE WITH SOME MINOR ADJUSTMENTS
 ON THE LENGTH OF THE PI. THE STONE
 WAS FOUND APPROX. 24" DOWN WITH NO
 SIGNIFICANT DIFFERENCE IN LOCATION
 FROM PERPETUATED POINT.

PERSONNEL

REFERENCE NO. 46A SHEET 12 OF 28

NOTES RHOADES

DATE 4/11/17

ROUTE US 20

H.C. O'DONNELL

WEATHER CLOUDYCOUNTY FULTON

R.C. HELDMAN

TEMP. 56°

TOWNSHIP AMBOY

SECTION 20

T_9S R_4E

TYPE MONUMENT _____ P.K./WASHER _____


ON SURFACE - ~~BELOW~~ _____ ON

~~LEFT~~ - C PAV'T - ~~RIGHT~~ ON

_____TO_____EDGE PAVEMENT

S.L.M. 1236+84.35

GRID: NORTHING: 733718.067 EASTING: 1568080.688

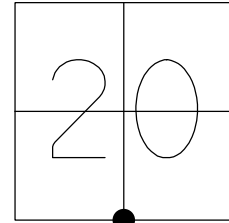

RECORD:

S 1/4 CORNER SEC 23

SET P.K./WASHER

6-21-01, BVD


FD P.K./WASHER

REF A46

10-14-15, JFO

SET MAG/WASHER

6-26-18, JFO

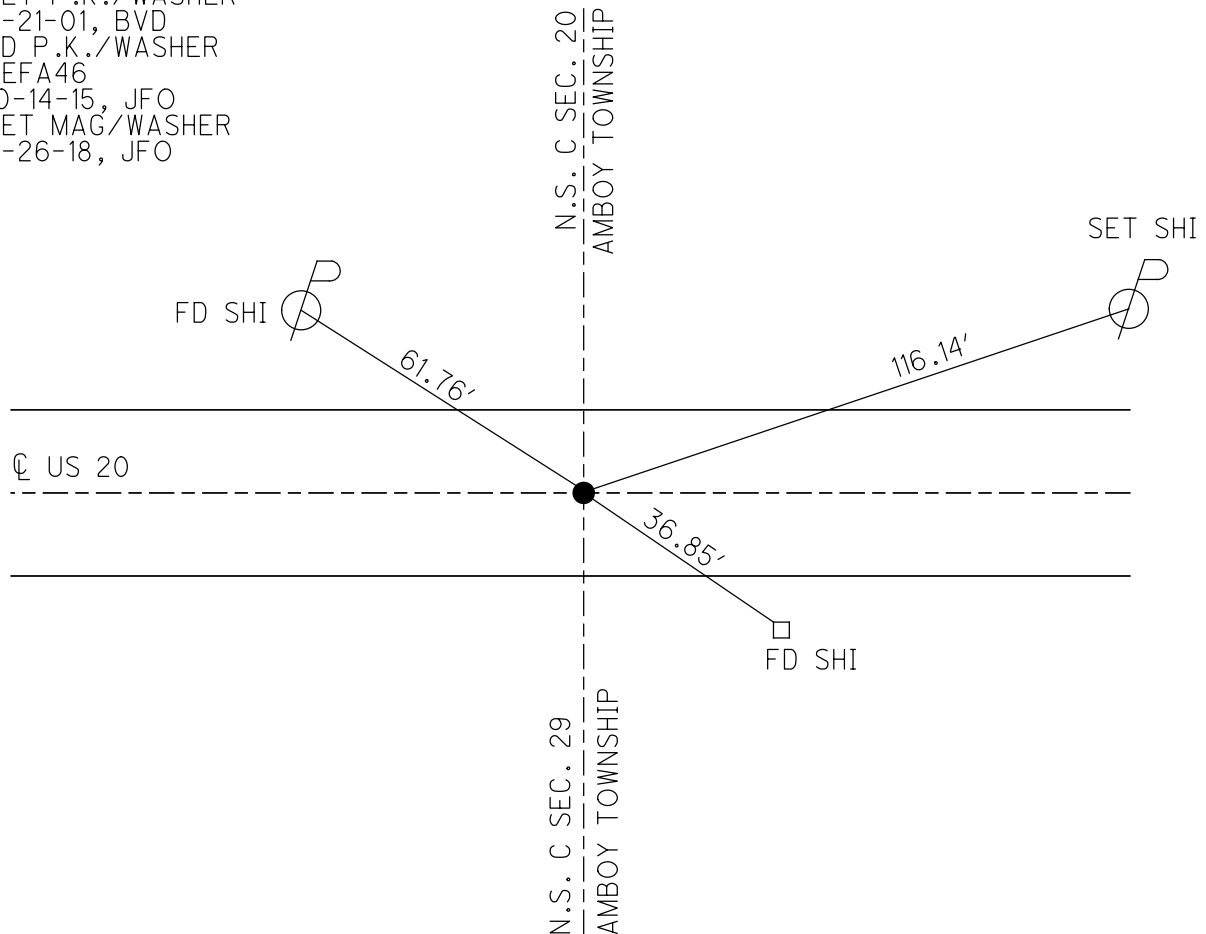

O.D.O.T. DISTRICT 2 SURVEY OFFICE (USE ONLY)

PERSONNEL	REFERENCE NO. <u>46B</u>	SHEET <u>13</u> OF <u>28</u>
NOTES	DATE <u>4/11/17</u>	ROUTE <u>US 20</u>
H.C. <u>RHOADES</u>	WEATHER <u>CLOUDY</u>	COUNTY <u>FULTON</u>
R.C. <u>O'DONNELL</u>	TEMP. <u>56°</u>	TOWNSHIP <u>AMBOY</u>
		SECTION <u>20</u>
		T <u>9</u> S R <u>4</u> E

TYPE MONUMENT _____ P.K./WASHER _____


ON SURFACE - ~~BELOW~~ _____ ON _____

~~LEFT~~ - Q PAV'T - ~~RIGHT~~ _____ ON _____


_____ TO _____ EDGE PAVEMENT

S.L.M. 1249+72.25

GRID: NORTHING: 733713.820 EASTING: 1569368.578

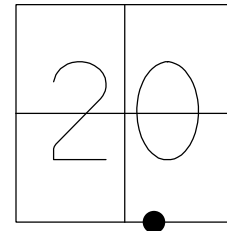


RECORD:
 1/4, 1/4 COR. SEC. 20
 SET P.K./WASHER,
 8-22-86
 SET P.K./WASHER
 6-22-01, BVD
 RE P.K./WASHER
 REFB46
 10-14-15, JFO
 SET MAG/WASHER
 6-25-18, JFO

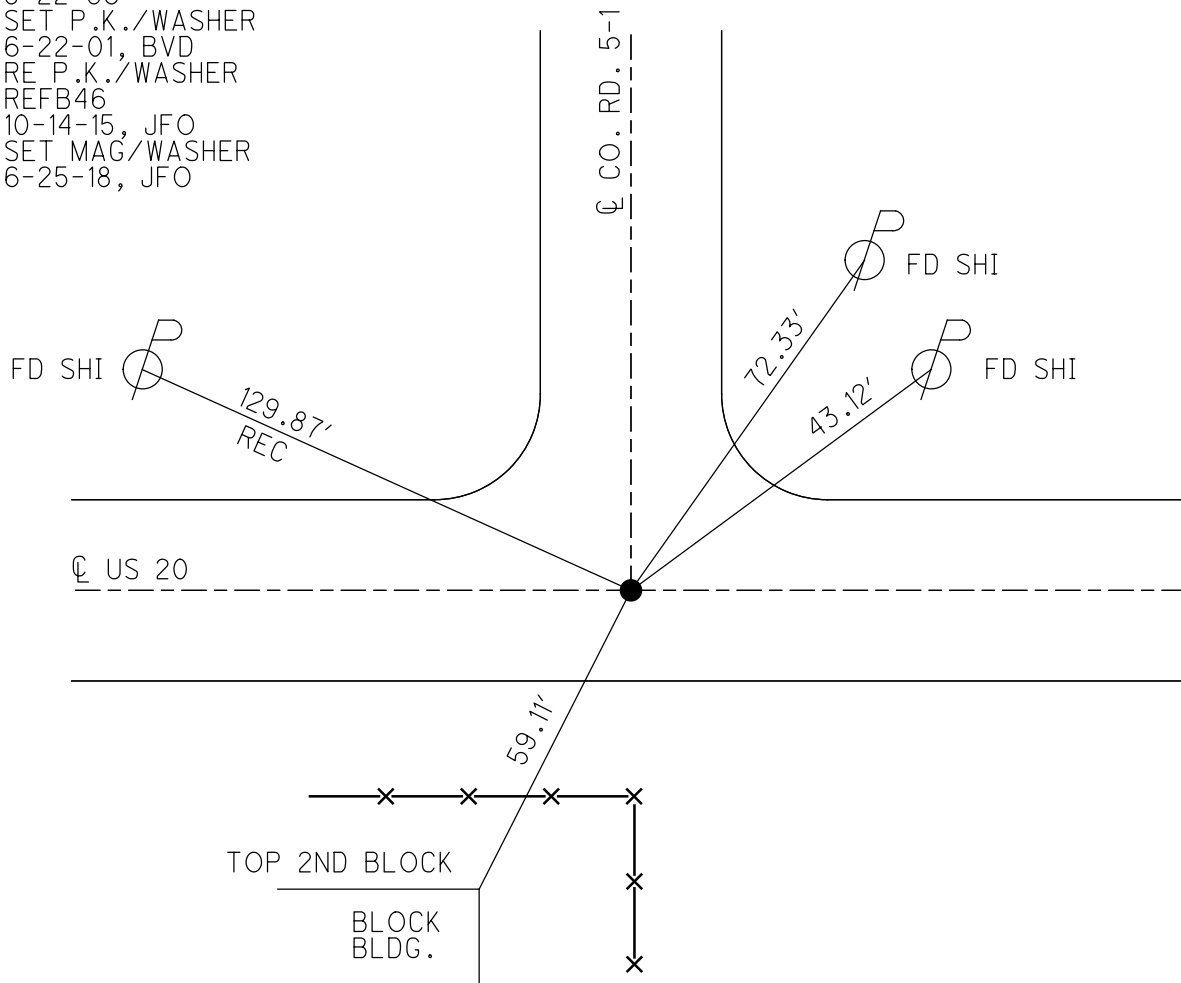


O.D.O.T. DISTRICT 2 SURVEY OFFICE (USE ONLY)

PERSONNEL	REFERENCE NO. <u>47</u>	SHEET <u>14</u> OF <u>28</u>
NOTES	DATE <u>4/11/17</u>	ROUTE <u>US 20</u>
H.C. <u>RHOADES</u>	WEATHER <u>CLOUDY</u>	COUNTY <u>FULTON</u>
R.C. <u>O'DONNELL</u>	TEMP. <u>56°</u>	TOWNSHIP <u>AMBOY</u>
		SECTION <u>20</u>
		T <u>9</u> S R <u>4</u> E

TYPE MONUMENT _____ P.K./WASHER _____
 ON SURFACE - ~~BELOW~~ _____ ON _____
~~LEFT~~ - C PAV'T - RIGHT _____ 1.3' _____
11.7' TO RT EDGE PAVEMENT _____
 S.L.M. _____ 1262+59.85 _____
 GRID: NORTHING: 733709.917 EASTING: 1570656.173

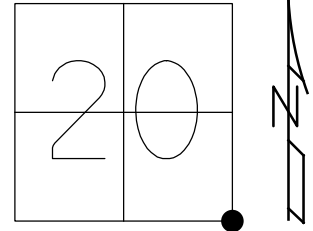

RECORD:
 SET P.K./WASHER
 6-22-01, BVD
 FD P.K./WASHER
 REF47
 10-14-15, JFO
 SET MAG/WASHER
 6-26-18, JFO

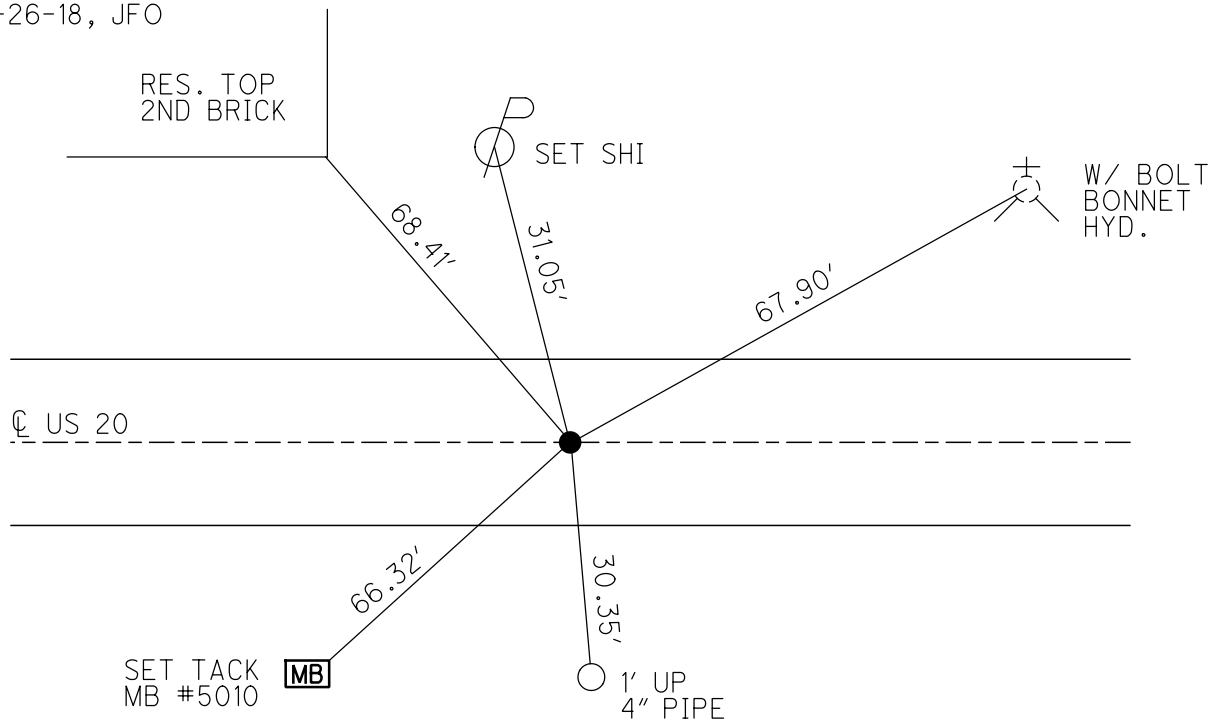

O.D.O.T. DISTRICT 2 SURVEY OFFICE (USE ONLY)

PERSONNEL

REFERENCE NO. 48

SHEET 15 OF 28

NOTES RHOADES

DATE 4/11/17

ROUTE US 20

H.C. O'DONNELL

WEATHER CLOUDY

COUNTY FULTON

R.C. HELDMAN

TEMP. 56°

TOWNSHIP AMBOY

SECTION 21

T 9 S R 4 E

TYPE MONUMENT P.K./WASHER


ON SURFACE - ~~BELOW~~ ON

LEFT - CL PAV'T - ~~RIGHT~~ 1'


TO EDGE PAVEMENT

S.L.M. 1276+13.90

GRID: NORTHING: 733726.623 EASTING: 1572010.117

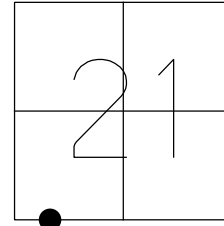

RECORD:
SET P.K./WASHER
6-22-01, BVD
FD P.K./WASHER
REF48
10-14-15, JFO
SET MAG/WASHER
6-26-18, JFO

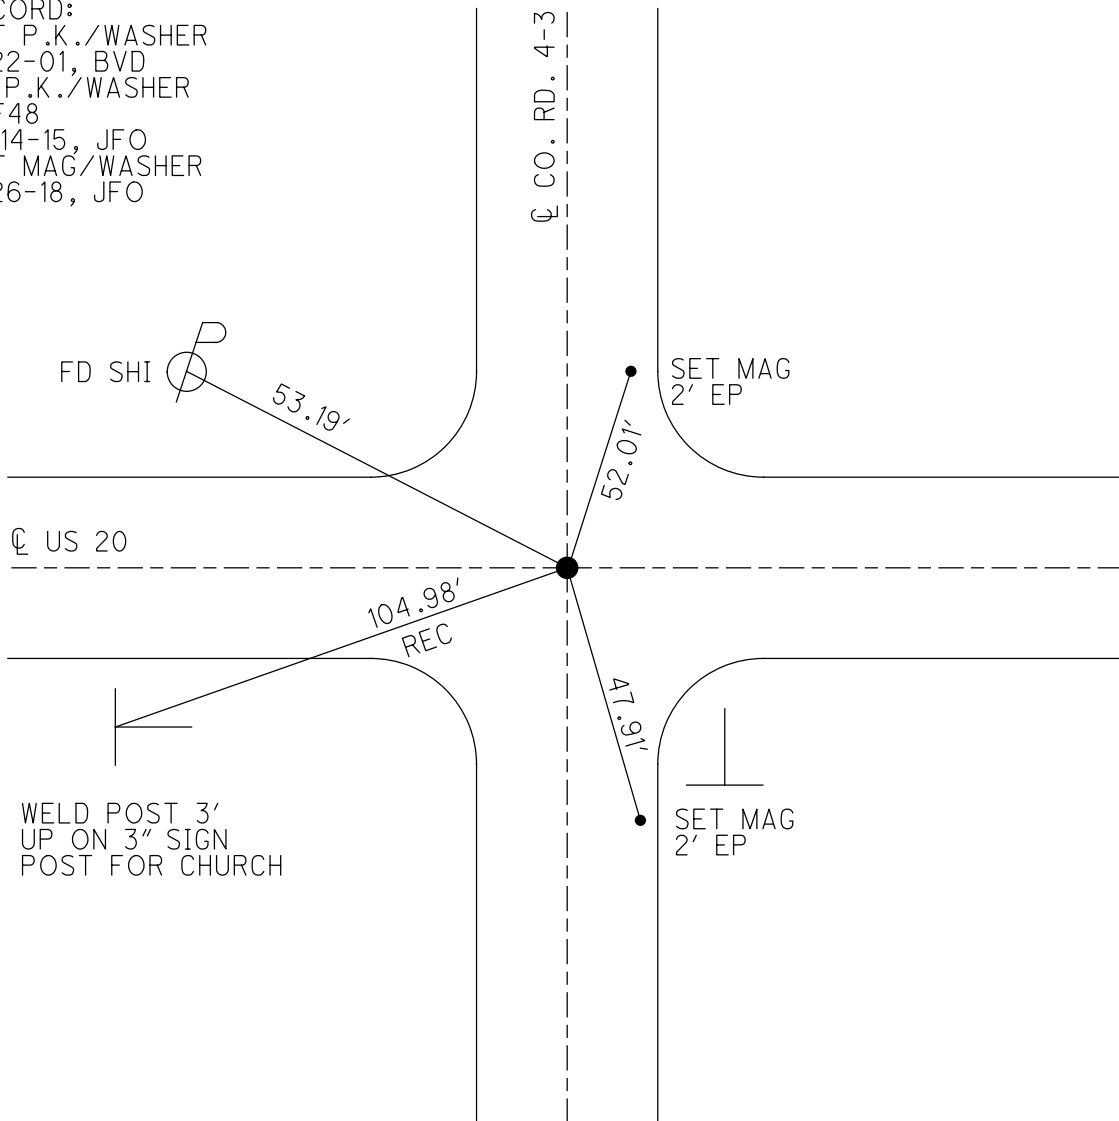


O.D.O.T. DISTRICT 2 SURVEY OFFICE (USE ONLY)


PERSONNEL _____ REFERENCE NO. 48A SHEET 16 OF 28
NOTES RHOADES DATE 4/11/17 ROUTE US 20
H.C. O'DONNELL WEATHER CLOUDY COUNTY FULTON
R.C. HELDMAN TEMP. 56° TOWNSHIP AMBOY
SECTION 21
T 9 S R 4 E

TYPE MONUMENT _____ MAG NAIL
ON SURFACE - ~~BELOW~~ _____ ON
~~LEFT~~ - ℄ PAV'T - RIGHT _____ 0.6'
_____ TO _____ EDGE PAVEMENT
S.L.M. _____ 1289+70.53

GRID: NORTHING: 733743.058 EASTING: 1573366.646

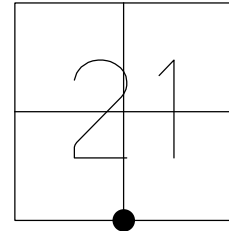

RECORD:
FD MAG NAIL
SET BY OTHERS
6-22-01, BVD
FD MAG NAIL
REFA48
10-14-15, JFO
SET MAG/WASHER
6-26-18, JFO

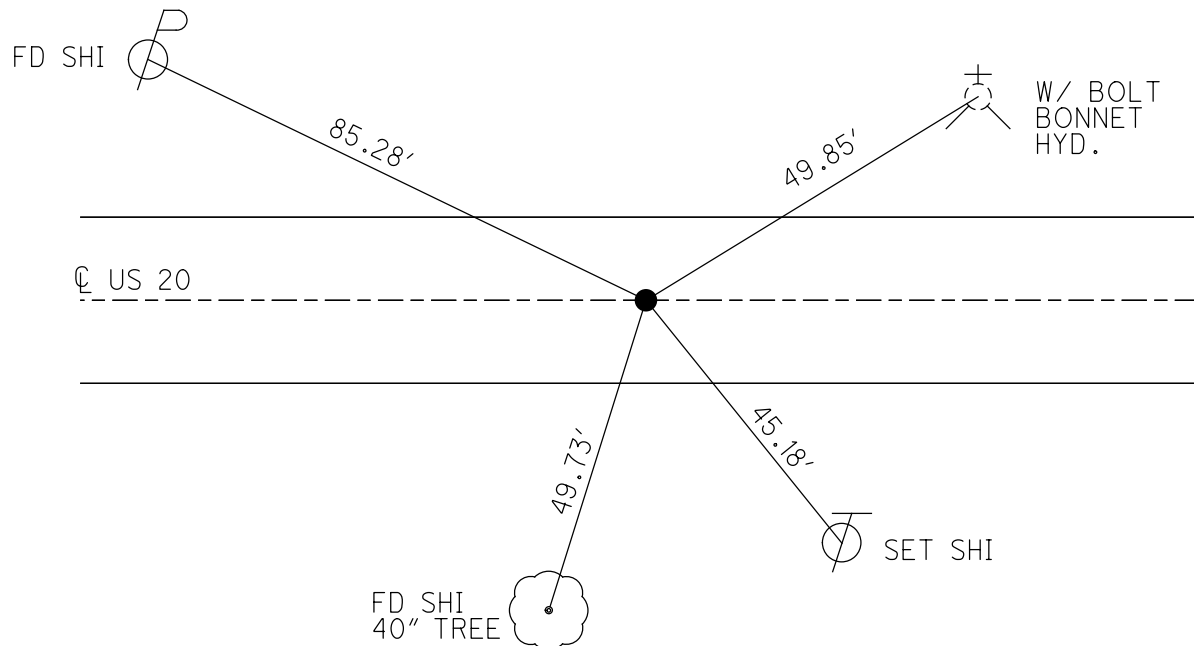

O.D.O.T. DISTRICT 2 SURVEY OFFICE (USE ONLY)

PERSONNEL

REFERENCE NO. 49

SHEET 17 OF 28

NOTES RHOADES

DATE 4/12/17

ROUTE US 20

H.C. O'DONNELL

WEATHER FAIR

COUNTY FULTON

R.C. HELDMAN

TEMP. 46°

TOWNSHIP AMBOY

SECTION 21

T_9 S R_4 E

TYPE MONUMENT _____ MAG NAIL _____


ON SURFACE - ~~BELOW~~ _____ ON

LEFT - C PAV'T - RIGHT 0.6'

11.7' TO LT EDGE PAVEMENT

S.L.M. 1302+76.54

GRID: NORTHING: 733782.222 EASTING: 1574672.074

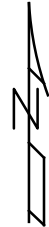

RECORD:

FD MAG NAIL

SET BY OTHERS

6-22-01, BVD


FD MAG NAIL

REF 49

9-15-15, JFO

SET MAG/WASHER

6-25-18, JFO

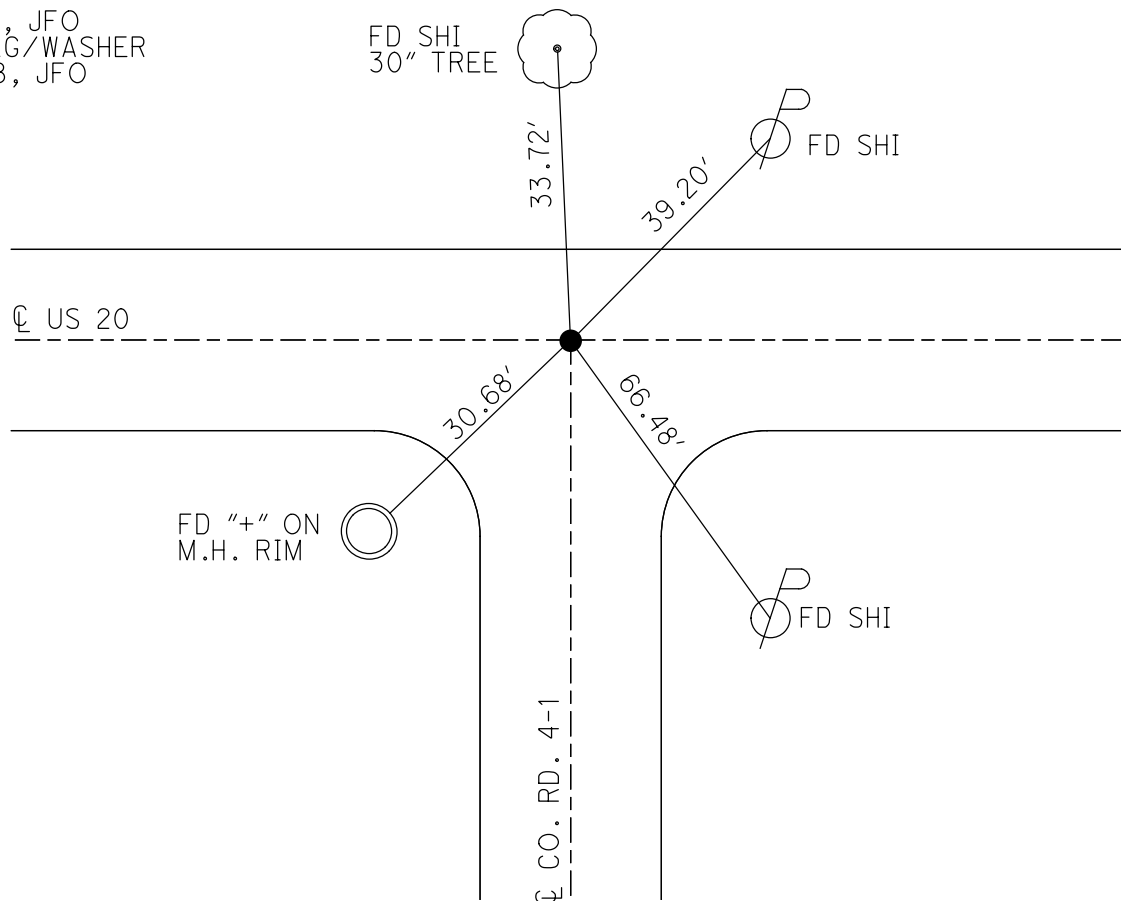


O.D.O.T. DISTRICT 2 SURVEY OFFICE (USE ONLY)

PERSONNEL _____ REFERENCE NO. 50 SHEET 18 OF 28
NOTES RHOADES _____ DATE 4/12/17 ROUTE US 20
H.C. O'DONNELL _____ WEATHER FAIR COUNTY FULTON
R.C. HELDMAN _____ TEMP. 46° TOWNSHIP AMBOY


SECTION 21
T 9 S R 4 E

TYPE MONUMENT _____ SET MAG/WASHER _____
ON SURFACE - ~~BELOW~~ _____ ON _____
LEFT - CL PAV'T - ~~RIGHT~~ _____ 2.6'
9.5' TO LT EDGE PAVEMENT
S.L.M. 1315+82.52

GRID: NORTHING: 733821.401 EASTING: 1575977.466

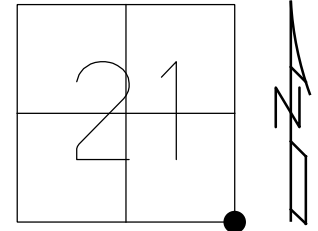


RECORD:
FD MAG NAIL
SET BY OTHERS
6-22-01, BVD
FD MAG NAIL
REF50
9-15-15, JFO
SET MAG/WASHER
6-25-18, JFO

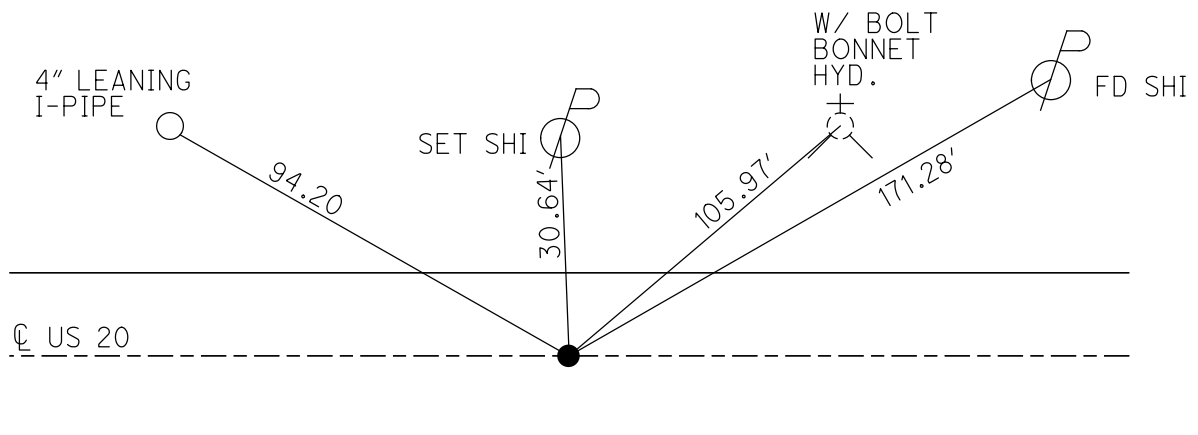


O.D.O.T. DISTRICT 2 SURVEY OFFICE (USE ONLY)

PERSONNEL	REFERENCE NO. <u>50A</u>	SHEET <u>19</u> OF <u>28</u>
NOTES	DATE <u>4/12/17</u>	ROUTE <u>US 20</u>
H.C. <u>RHOADES</u>	WEATHER <u>FAIR</u>	COUNTY <u>FULTON</u>
R.C. <u>O'DONNELL</u>	TEMP. <u>46°</u>	TOWNSHIP <u>AMBOY</u>
		SECTION <u>22</u>
		T <u>9</u> S R <u>4</u> E

TYPE MONUMENT _____ MAG NAIL _____
 ON SURFACE - ~~BELOW~~ _____ ON _____
 LEFT - CL PAV'T - ~~RIGHT~~ _____ 1'
 _____ 12' TO RT _____ EDGE PAVEMENT
 S.L.M. _____ 1342+55.63
 GRID: NORTHING: 733815.864 EASTING: 1578650.567

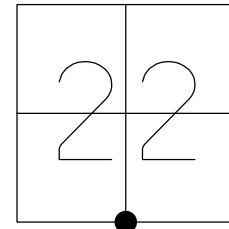

RECORD:
 FD MAG NAIL
 SET BY OTHER
 6-22-01, BVD
 FD MAG NAIL
 REFA50
 10-14-15, JFO
 SET MAG/WASHER
 6-25-18, JFO

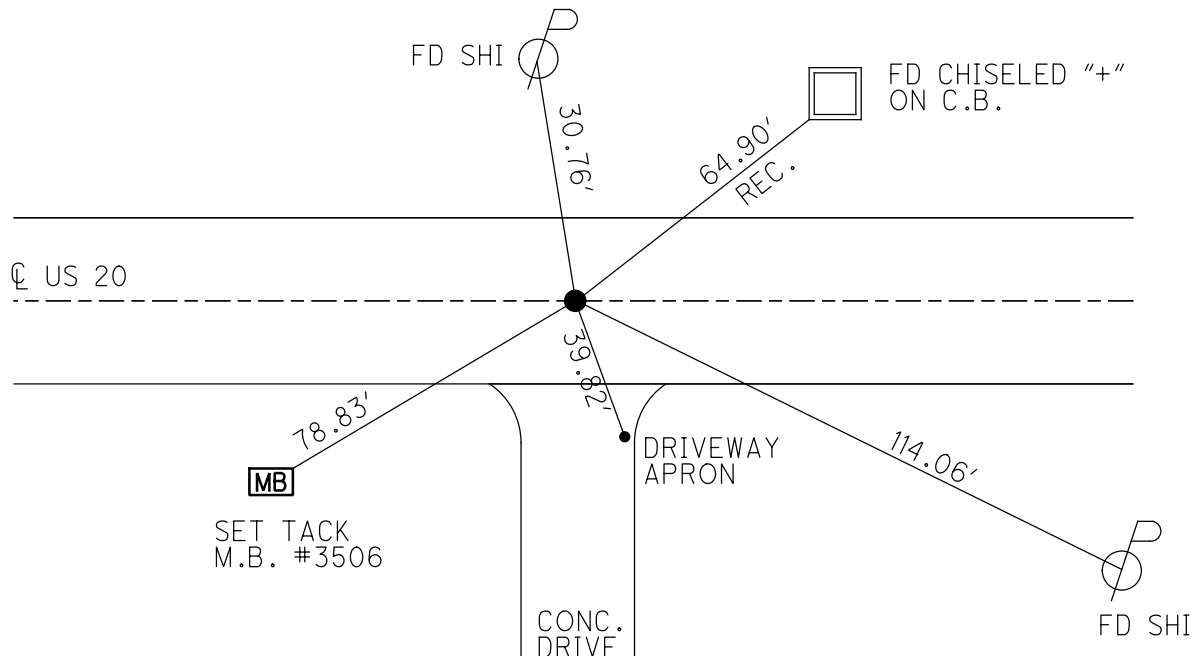


O.D.O.T. DISTRICT 2 SURVEY OFFICE (USE ONLY)

PERSONNEL	REFERENCE NO. <u>51</u>	SHEET <u>20</u> OF <u>28</u>
NOTES	DATE <u>4/12/17</u>	ROUTE <u>US 20</u>
H.C. <u>RHOADES</u>	WEATHER <u>CLOUDY</u>	COUNTY <u>FULTON</u>
R.C. <u>O'DONNELL</u>	TEMP. <u>46°</u>	TOWNSHIP <u>AMBOY</u>
		SECTION <u>22</u>
		T <u>9</u> S R <u>4</u> E


TYPE MONUMENT MAG NAIL
 ON SURFACE - ~~BELOW~~ ON
~~LEFT - C~~ PAV'T - ~~RIGHT~~ ON
12' TO RT EDGE PAVEMENT
 S.L.M. 1368+32.17

GRID: NORTHING: 733784.790 EASTING: 1581226.925

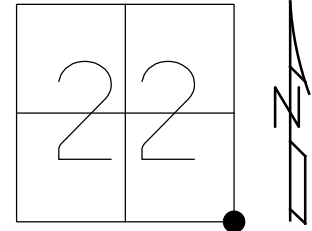

51 TO 51A = 179.95'

RECORD:
 FD P.K. NAIL -
 ASSUMPTION CORPLINE
 FD MAG NAIL
 SET BY OTHERS
 6-22-01, BVD
 FD MAG NAIL
 REF51
 10-14-17
 SET MAG/WASHER
 NEW REF51
 6-25-18, JFO

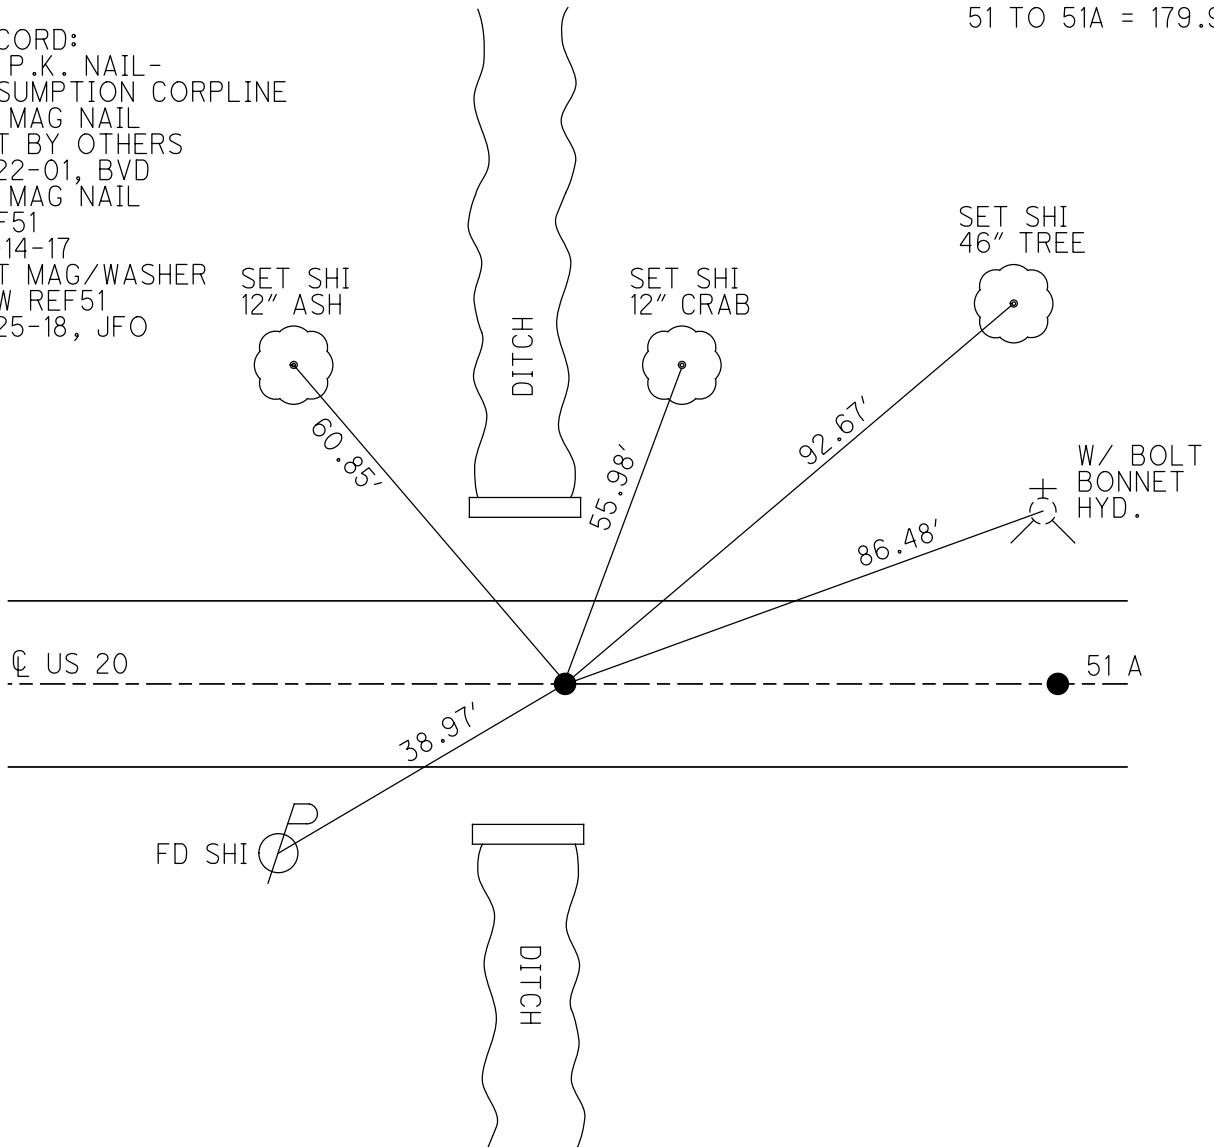

O.D.O.T. DISTRICT 2 SURVEY OFFICE (USE ONLY)

PERSONNEL

REFERENCE NO.

51A

SHEET

21

OF

28

NOTES

RHOADES

DATE

4/12/17

ROUTE

US 20

H.C.

O'DONNELL

WEATHER

CLOUDY

COUNTY

FULTON

R.C.

HELDMAN

TEMP.

46°

TOWNSHIP

AMBOY

SECTION

23

T 9 S R 4 E

TYPE MONUMENT

P.K./WASHER

ON SURFACE - ~~BELOW~~

ON

~~LEFT~~ - $\odot$ PAV'T - RIGHT

1'

10.3'



TO RT EDGE PAVEMENT

S.L.M.

1370+12.44

GRID: NORTHING: 733781.818

EASTING: 1581407.1633

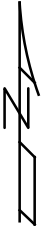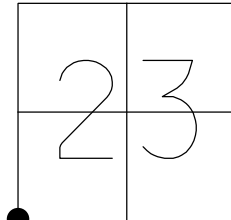

RECORD:

SET P.K./WASHER

6-22-01, BVD

FD P.K./WASHER


REFA51

10-14-15, JFO

SET MAG/WASHER

6-25-18, JFO

51 TO 51A = 179.95'

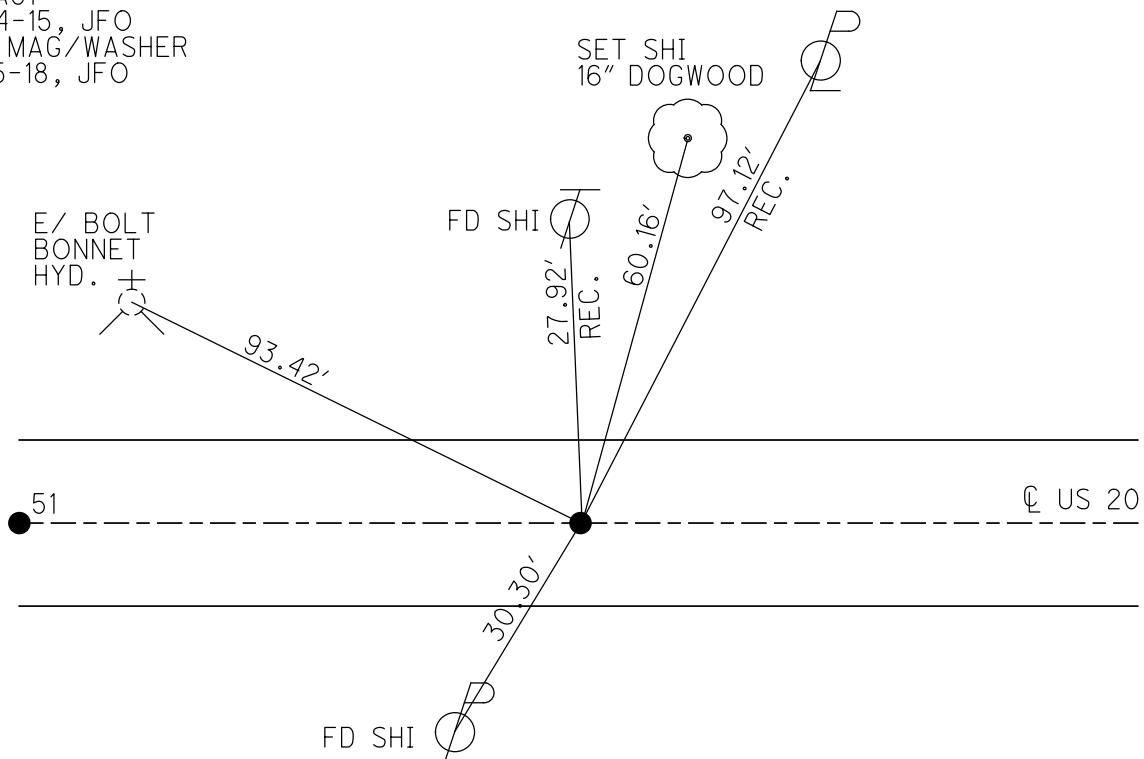

O.D.O.T. DISTRICT 2 SURVEY OFFICE (USE ONLY)

PERSONNEL

REFERENCE NO.

51B

SHEET

22

OF

28

NOTES

RHOADES

DATE

4/12/17

ROUTE

US 20

H.C.

O'DONNELL

WEATHER

PT. CLOUDY

COUNTY

FULTON

R.C.

RHOADES

TEMP.

46°

TOWNSHIP

AMBOY

SECTION

23

T 9 S

R 4 E

TYPE MONUMENT

P.K./WASHER

ON SURFACE - ~~BELOW~~

ON

~~LEFT~~ - $\odot$ PAV'T - RIGHT

7.8'



TO EDGE PAVEMENT

S.L.M.


1383+82.66

GRID: NORTHING: 733759.204

EASTING: 1582777.197

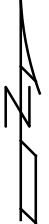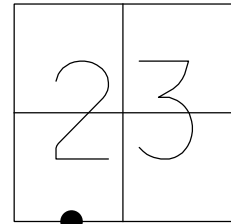

RECORD: SET P.K./WASHER
6-22-01, BVD
FD P.K./WASHER
REFB51
10-14-15, JFO
SET MAG/WASHER
6-25-18, JFO

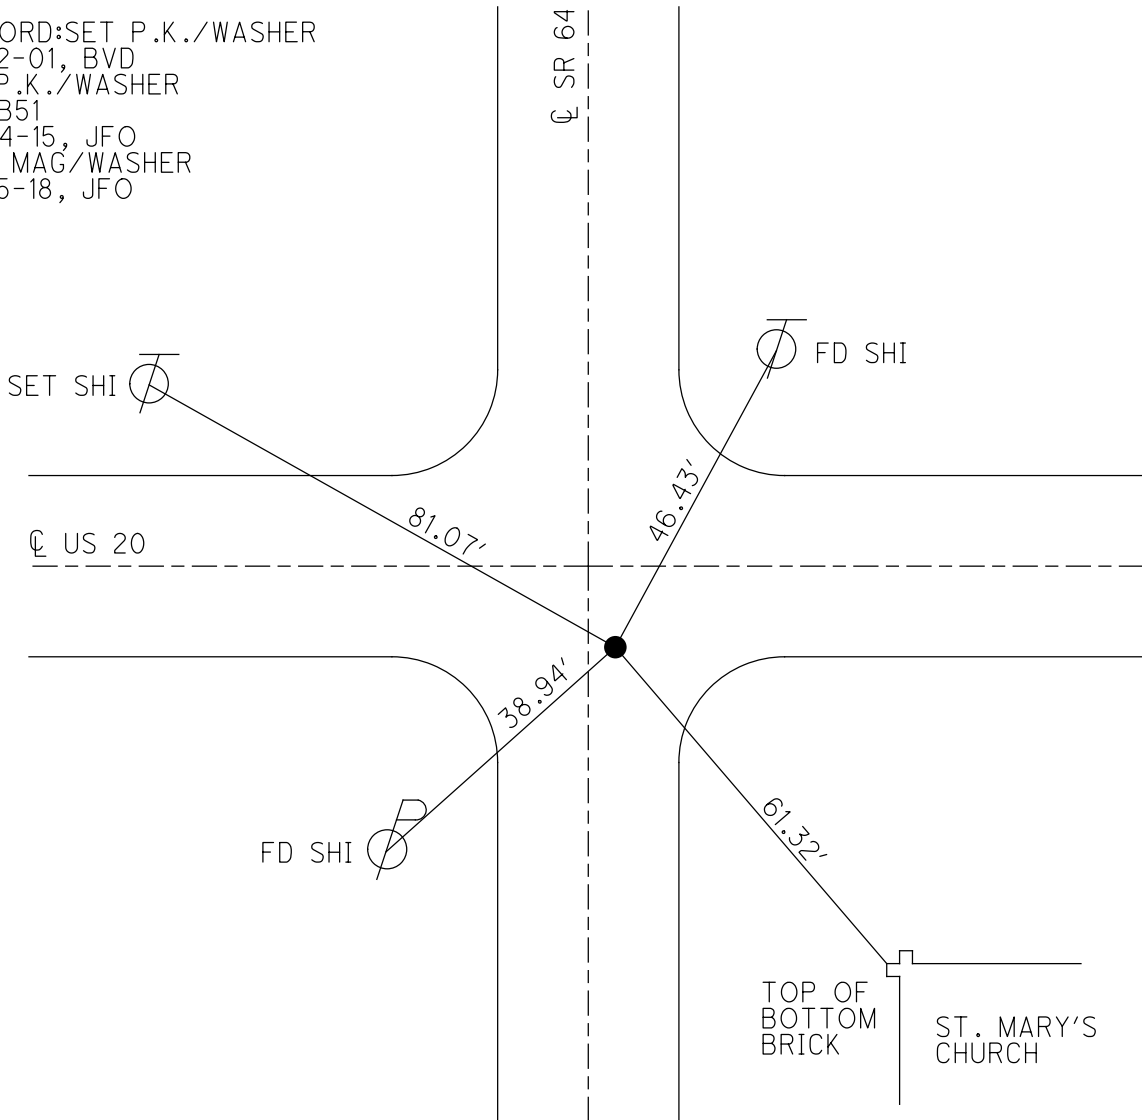


O.D.O.T. DISTRICT 2 SURVEY OFFICE (USE ONLY)


PERSONNEL	REFERENCE NO. <u>52</u>	SHEET <u>23</u> OF <u>28</u>
NOTES	DATE <u>4/12/17</u>	ROUTE <u>US 20</u>
H.C. <u>RHOADES</u>	WEATHER <u>PT. CLOUDY</u>	COUNTY <u>FULTON</u>
R.C. <u>O'DONNELL</u>	TEMP. <u>46°</u>	TOWNSHIP <u>AMBOY</u>
		SECTION <u>23</u>
		T <u>9</u> S R <u>4</u> E

TYPE MONUMENT _____ SET MAG NAIL _____
 ON SURFACE - ~~BELOW~~ _____ ON _____
~~LEFT - C~~ PAV'T - RIGHT _____ 3.7' _____
 8.0' TO RT _____ EDGE PAVEMENT _____
 S.L.M. _____ 1394+78.47 _____

GRID: NORTHING: 733740.984 EASTING: 1583872.857

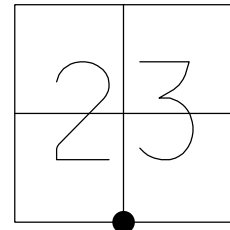

RECORD:
 SET P.K./WASHER
 6-22-01, BVD
 FD P.K./WASHER
 REF52
 10-14-15, JFO
 SET MAG/WASHER
 6-25-18, JFO

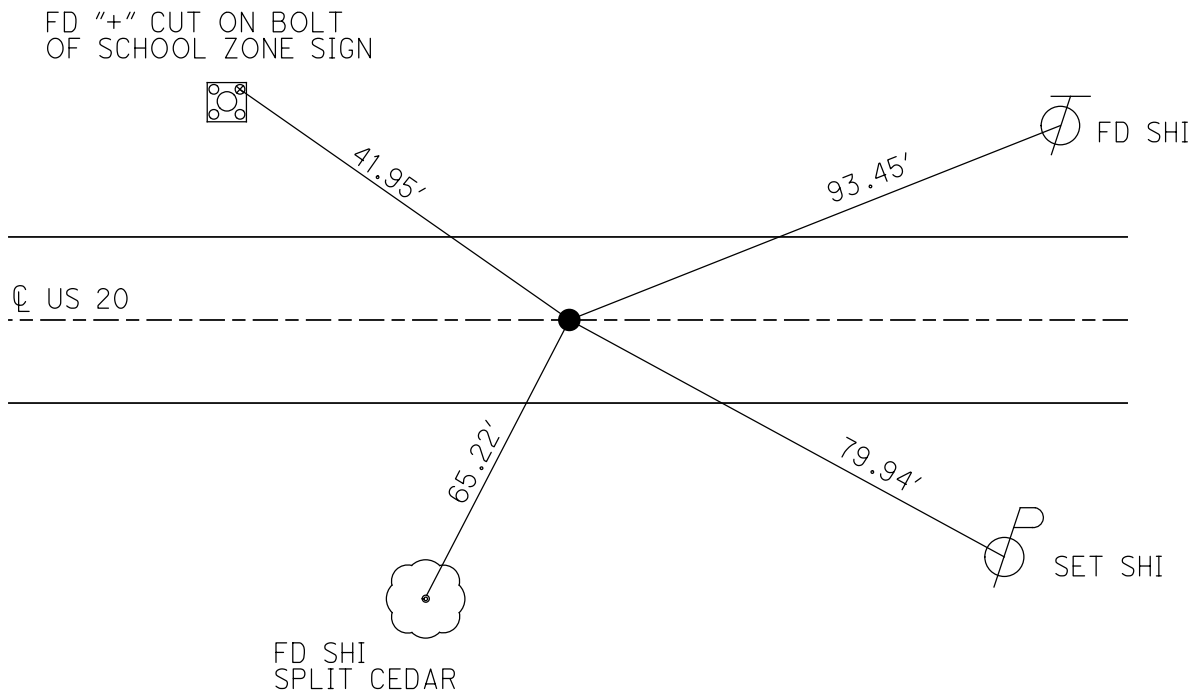

O.D.O.T. DISTRICT 2 SURVEY OFFICE (USE ONLY)

PERSONNEL

REFERENCE NO.

53

SHEET

24

OF

28

NOTES

RHOADES

DATE

4-12-17

ROUTE

US 20

H.C.

O'DONNELL

WEATHER

P.T. CLOUDY

COUNTY

FULTON

R.C.

HELDMAN

TEMP.

46°

TOWNSHIP

AMBOY

SECTION

23

T 9 S

R 4 E

TYPE MONUMENT

P.K./WASHER

ON SURFACE - ~~BELOW~~

ON

~~LEFT~~ - ℄ PAV'T - RIGHT

5.3'


TO EDGE PAVEMENT

S.L.M.

1402+97.51

GRID: NORTHING: 733666.693

EASTING: 1586490.841

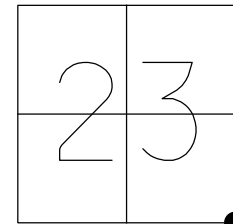

53 T 53A = 20.01'

RECORD:

SET P.K./WASHER

6-22-01, BVD


FD P.K./WASHER

REF53

10-14-15, JFO

SET MAG/WASHER

6-25-18, JFO

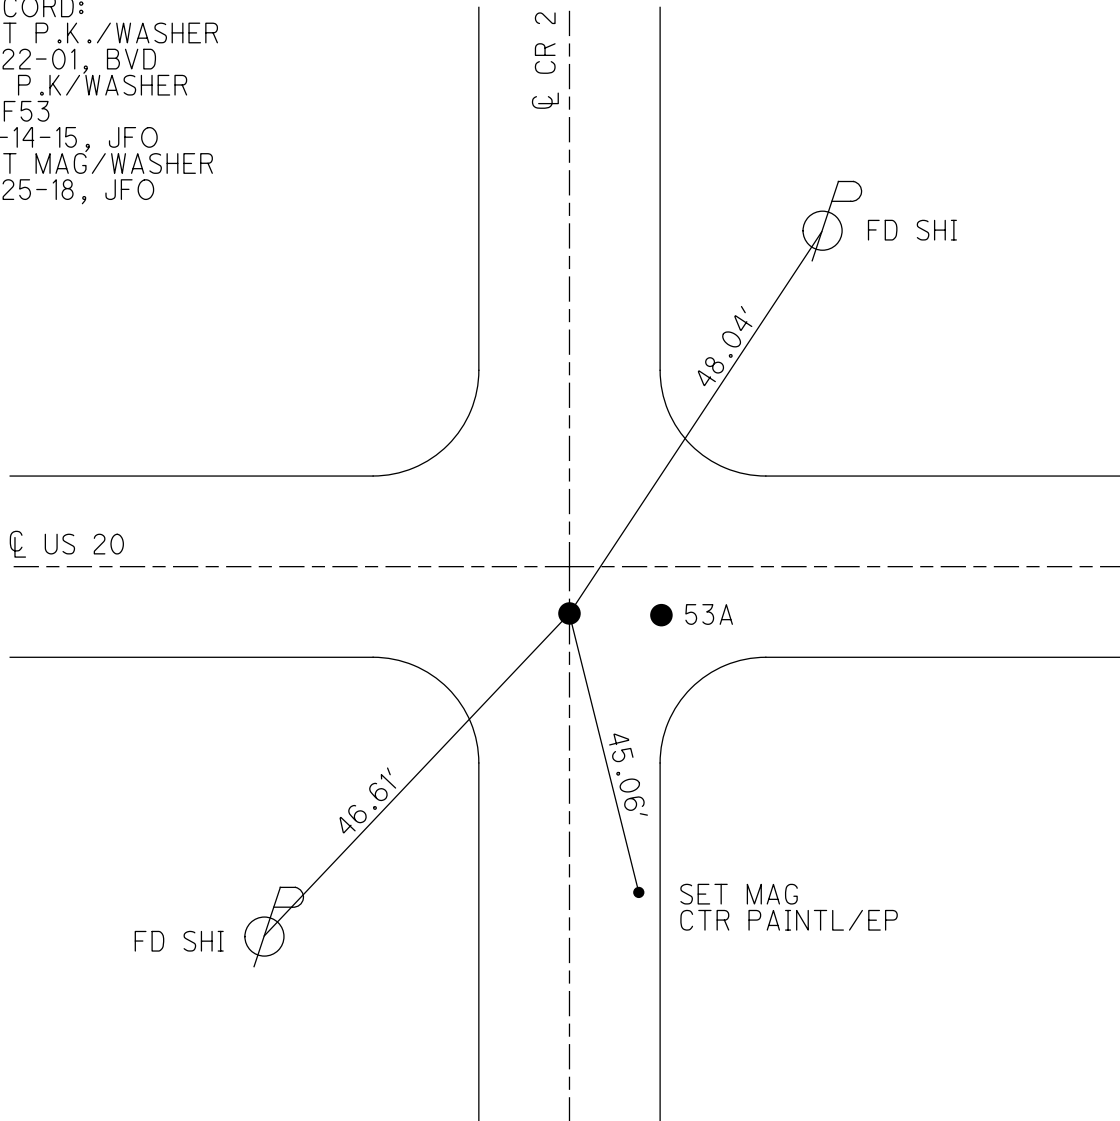

O.D.O.T. DISTRICT 2 SURVEY OFFICE (USE ONLY)

PERSONNEL

REFERENCE NO. 53A

SHEET 25 OF 28

NOTES RHOADES

DATE 4/12/17

ROUTE US 20

H.C. O'DONNELL

WEATHER PT. CLOUDY

COUNTY FULTON

R.C. HELDMAN

TEMP. 46°

TOWNSHIP AMBOY

SECTION 23

T 9 S R 4 E

TYPE MONUMENT P.K./WASHER

ON SURFACE - ~~BELOW~~ ON


~~LEFT~~ - ℄ PAV'T - RIGHT 5.3'

TO EDGE PAVEMENT

S.L.M. 1421+17.53


GRID: NORTHING: 733666.158

EASTING: 1586510.859

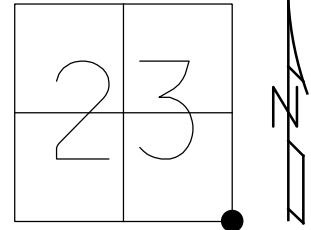

53 T 53A = 20.01'

RECORD:
SET P.K./WASHER
6-22-01, BVD
FD P.K/WASHER
REFA53
10-14-15, JFO
SET MAG/WASHER
6-25-18, JFO

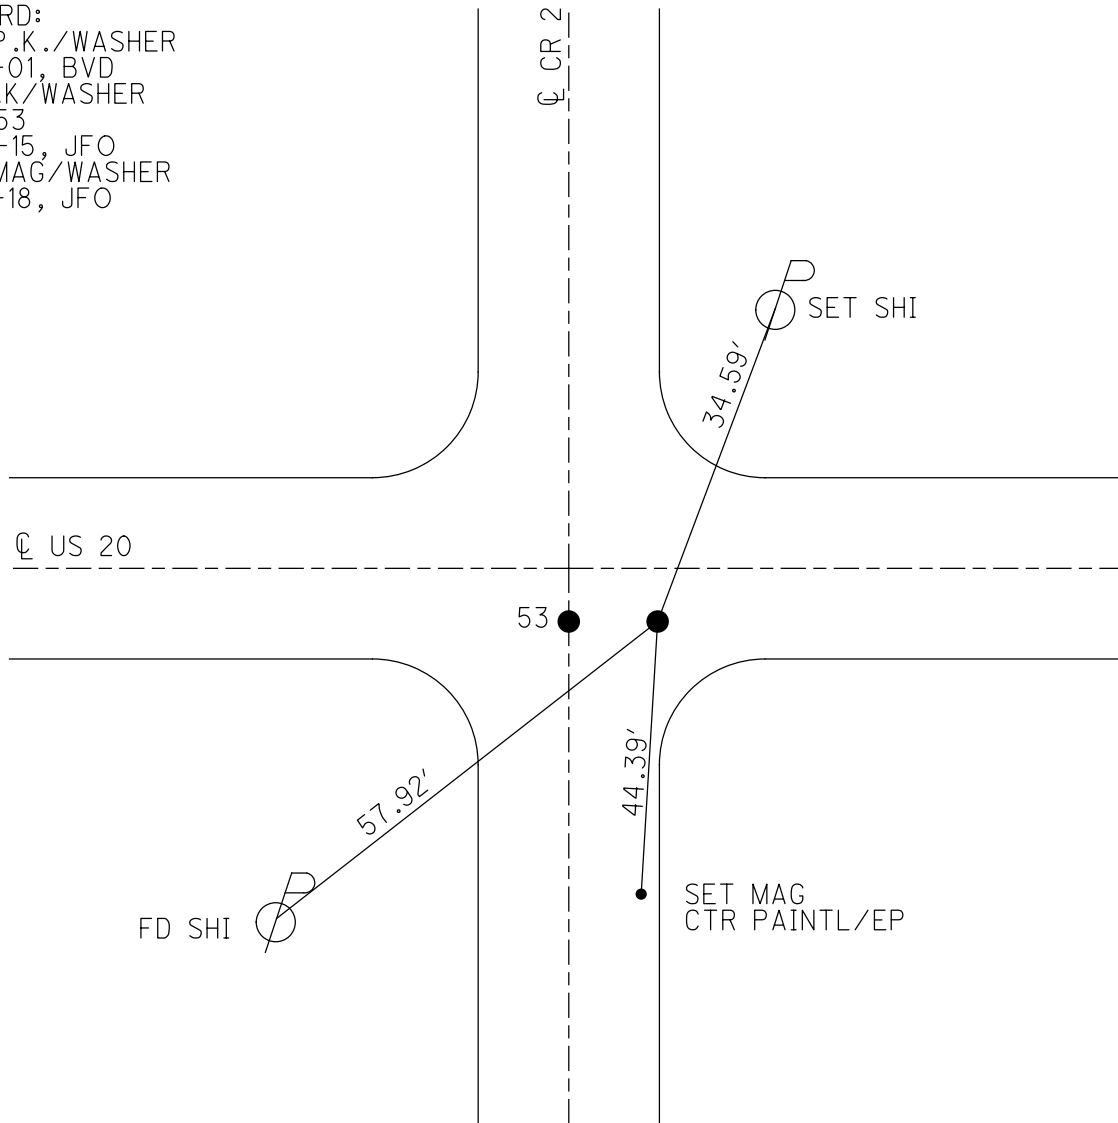

O.D.O.T. DISTRICT 2 SURVEY OFFICE (USE ONLY)

PERSONNEL

REFERENCE NO. 54

SHEET 26 OF 28

NOTES AUBLE

DATE 12/21/23

ROUTE SR 20

H.C. NIESE

WEATHER CLOUDY

COUNTY FULTON

R.C. ASTON

TEMP. 45°

TOWNSHIP AMBOY

SECTION 24

DWG BY RHOADES

PID PAVING TRAIN

T 9 N R 4 E

TYPE MONUMENT MAG/WASHER

ON SURFACE - ~~BELOW~~ ON

OFFSET Q PAVEMENT 3.7' LT : ~~RT~~

8.3' TO LT EDGE PAVEMENT


STATION: 1447+46.02

HORIZ.DATUM: NAD83 2011

GEOID: NAVD88 2018


GRID: NORTHING: 733611.172

EASTING: 1589139.530

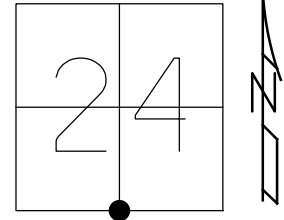

RECORD:
SET P.K./WASHER
6-22-01, BVD
FD P.K/WASHER
REF54
10-14-15, JFO
SET MAG/WASHER
6-25-18, JFO
FD MAG/WASHER
FUL20REF54
6/9/23, JAM
12/21/23, DSA


FULTON LPD:
N: 390848.518
E: 235463.606

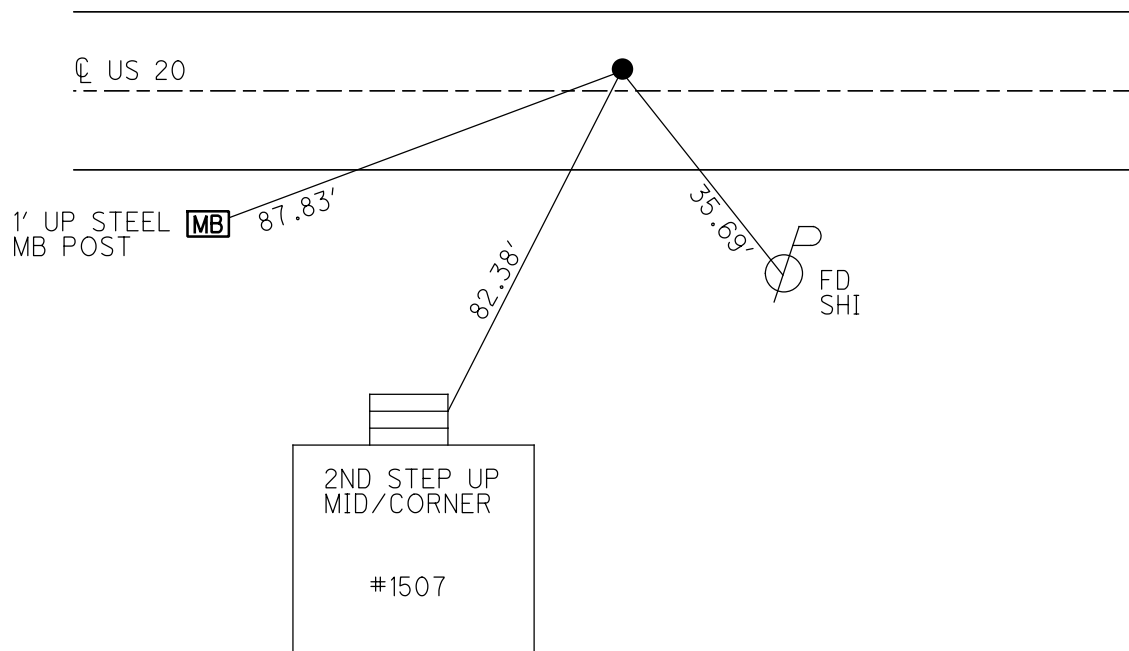

O.D.O.T. DISTRICT 2 SURVEY OFFICE (USE ONLY)


PERSONNEL _____ REFERENCE NO. 55 SHEET 27 OF 28
NOTES HUSS DATE 7/24/00 ROUTE US 20
H.C. CORDES WEATHER CLOUDY COUNTY FULTON
R.C. KARGER TEMP. 72° TOWNSHIP AMBOY
SECTION 24
T 9 S R 4 E

TYPE MONUMENT _____ P.K./WASHER _____
ON SURFACE - ~~BELOW~~ _____ ON _____
~~LEFT~~ - ℄ PAV'T - ~~RIGHT~~ _____ ON _____
_____ TO _____ EDGE PAVEMENT
S.L.M. 1473+91.53
GRID: NORTHING: - _____ EASTING: - _____

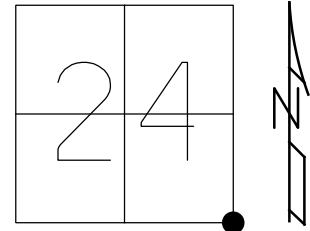

55 TO 55A = 57.51'

RECORD:
SET P.K./WASHER
REF51
10-21-15, JFO
FD MONBOX
4-12-17
1" IPIN FD BENT
TO THE NORTH
REF1
6-25-18, JFO

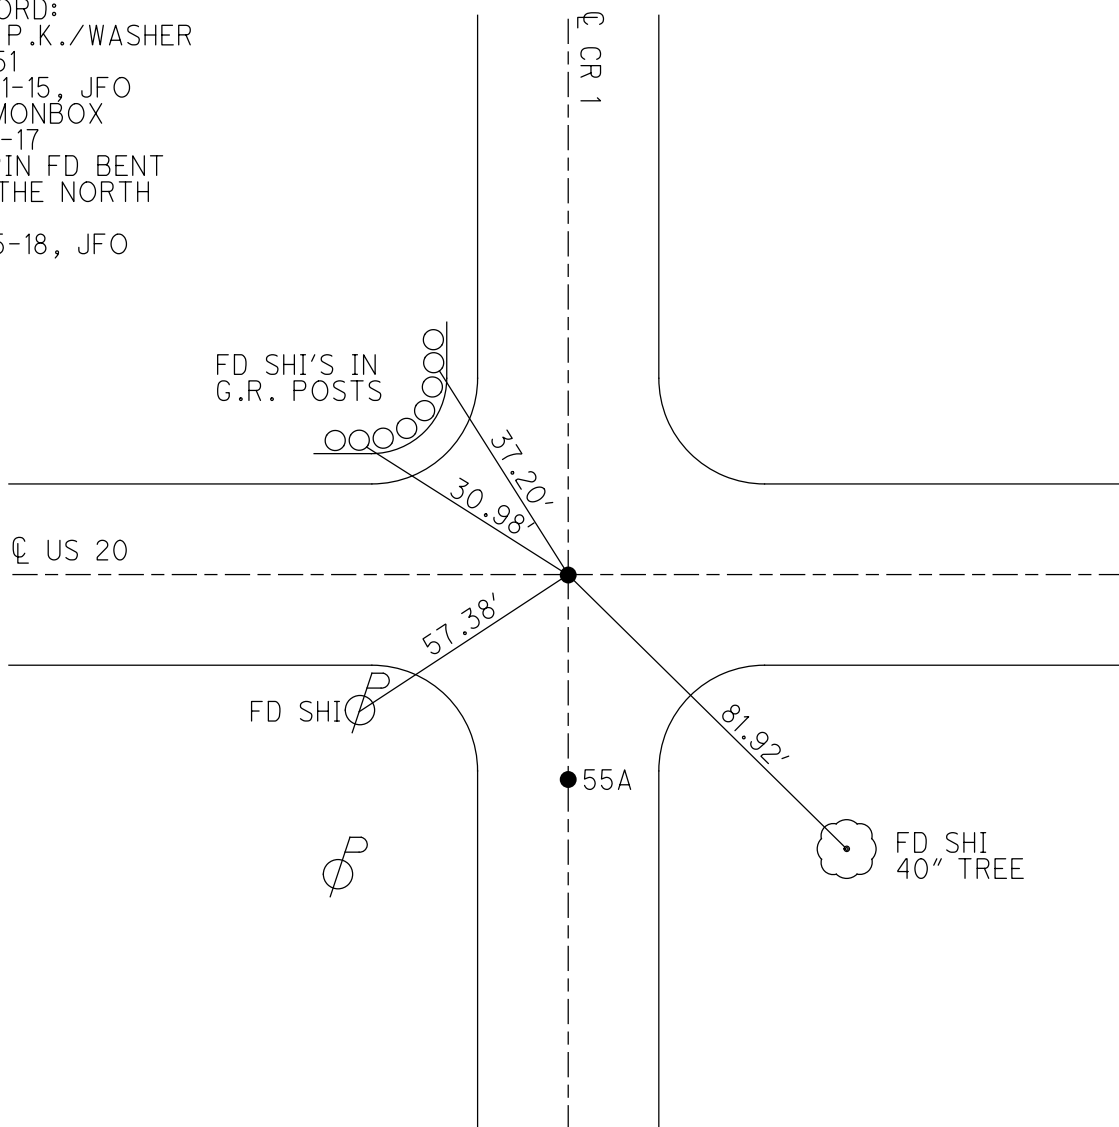


O.D.O.T. DISTRICT 2 SURVEY OFFICE (USE ONLY)

PERSONNEL	REFERENCE NO. <u>55A</u>	SHEET <u>28</u> OF <u>28</u>
NOTES	DATE <u>7/24/00</u>	ROUTE <u>US 20</u>
H.C. <u>CORDES</u>	WEATHER <u>CLOUDY</u>	COUNTY <u>FULTON</u>
R.C. <u>KARGER</u>	TEMP. <u>72°</u>	TOWNSHIP <u>AMBOY</u>
		SECTION <u>24</u>
		T <u>9</u> S R <u>4</u> E

TYPE MONUMENT P.K./WASHER
 ON SURFACE - ~~BELOW~~ ON
~~LEFT - C~~ PAV'T - ~~RIGHT~~ ON
TO EDGE PAVEMENT
 S.L.M. 1473+94.45

GRID: NORTHING: 733554.166 EASTING: 1591785.500

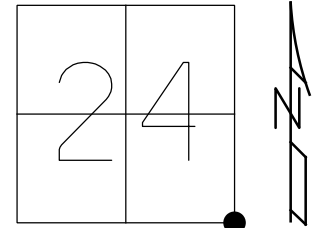

55 TO 55A = 57.51'

RECORD:
 SET P.K./WASHER
 6-22-01, BVD
 FD R.R. SPIKE 4' DOWN
 REFA1
 10-21-15, JFO
 MONBOX FD
 W/ 1" IPIN
 NEWREFA55
 4-12-17, JFO

