
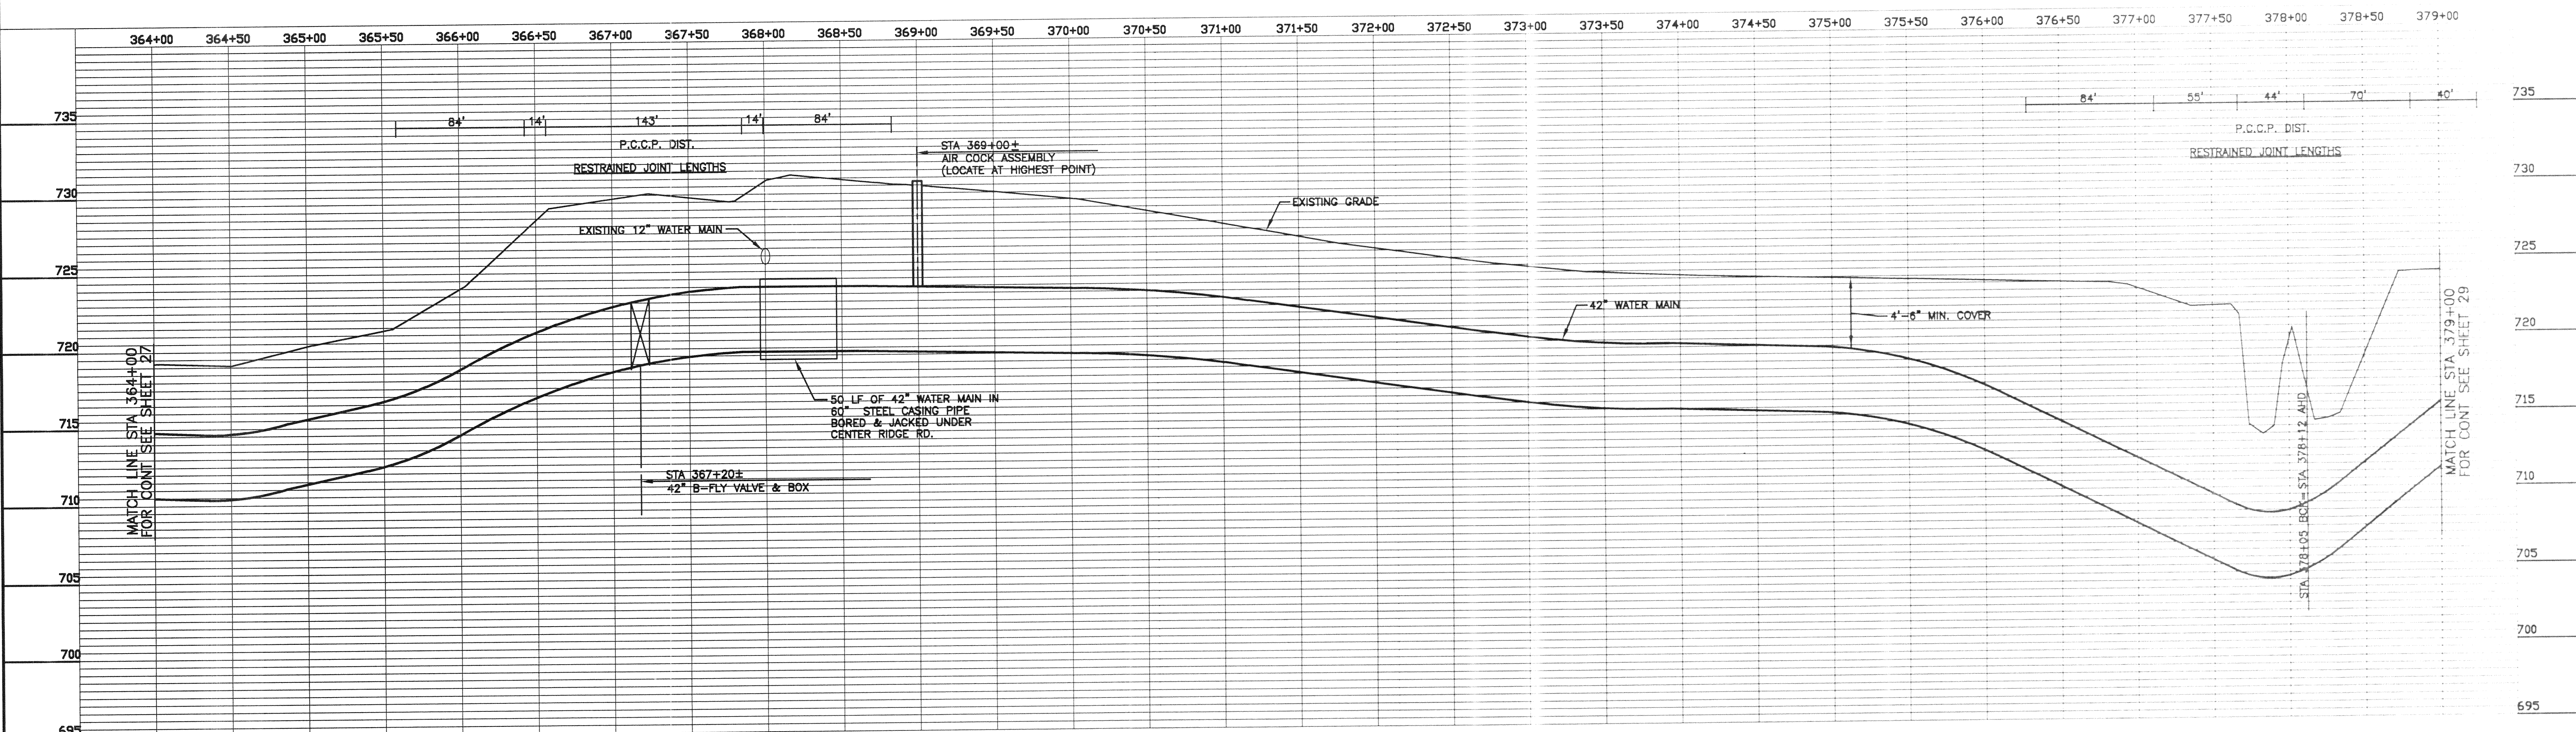


DATE: DECEMBER 1999

FILE NAME: 2789-28

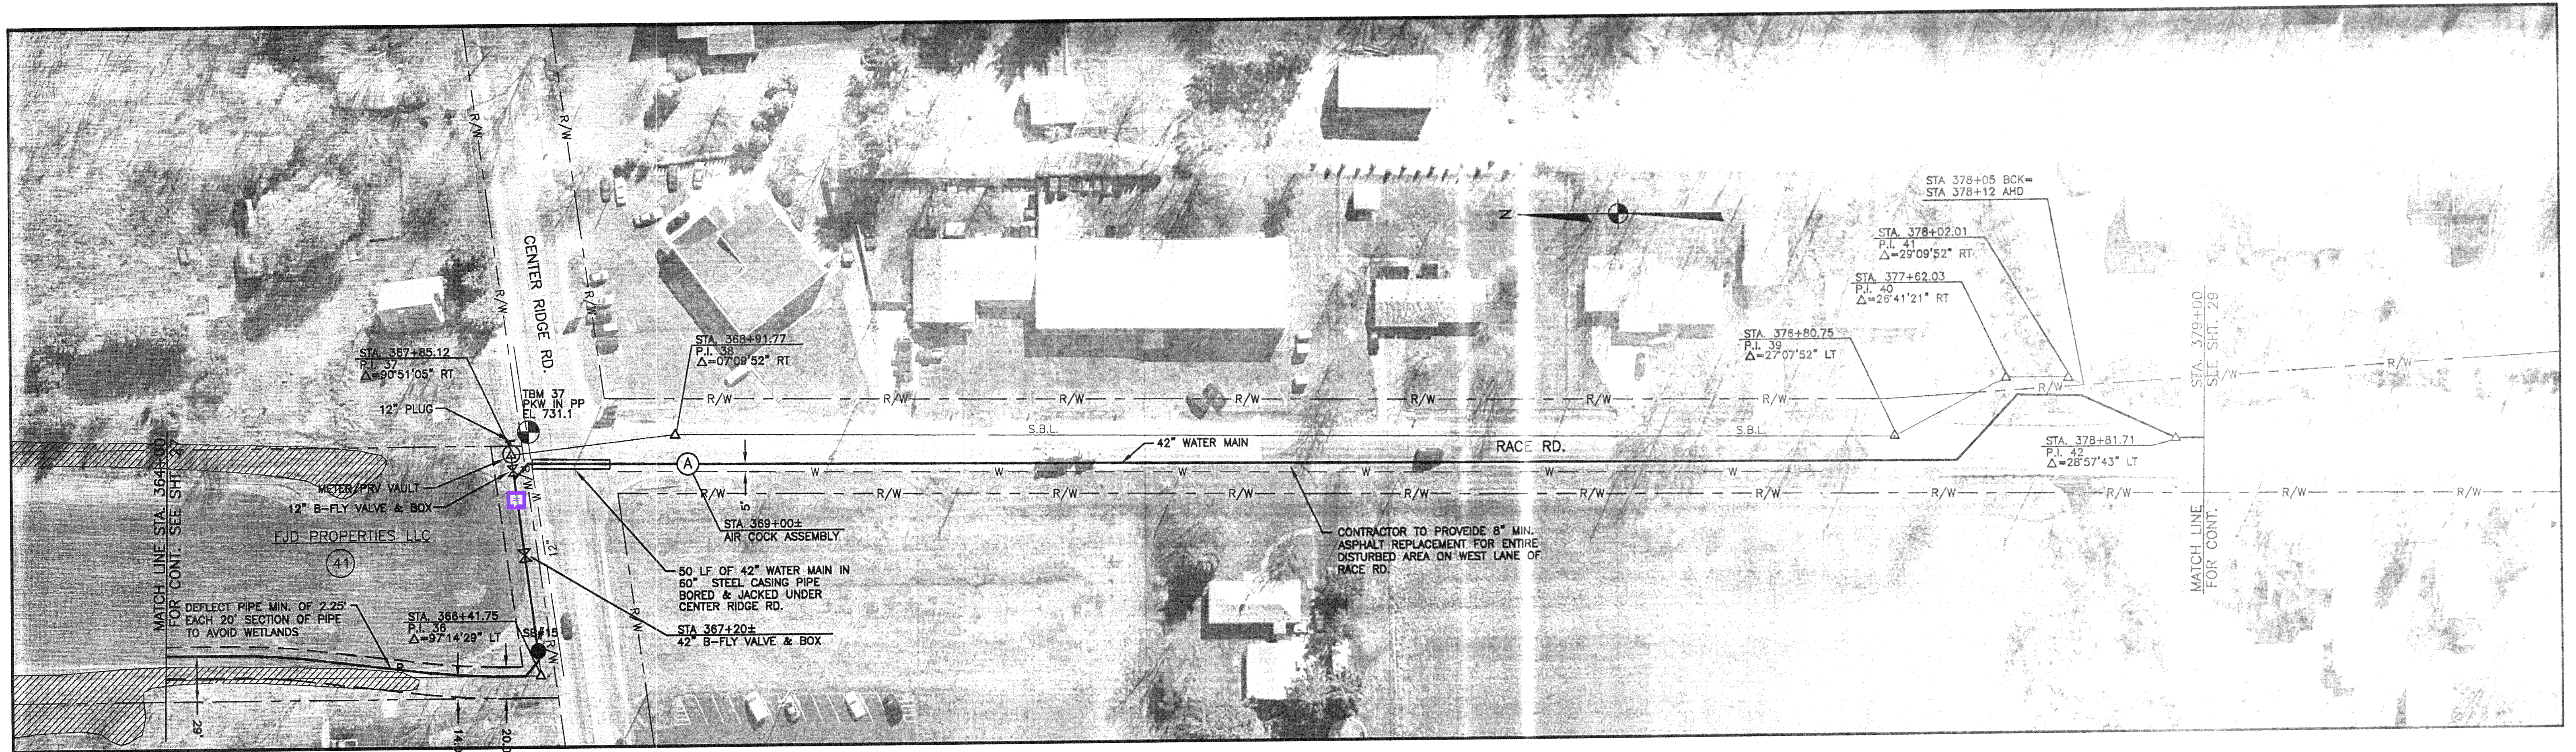

THIS RECORD DOCUMENT HAS BEEN PREPARED BASED ON INFORMATION PROVIDED BY THE CONSTRUCTION CONTRACTOR. GRW ENGINEERS, INC. HAS ATTEMPTED TO VERIFY THE ACCURACY AND/OR COMPLETENESS OF THIS INFORMATION BUT SHALL NOT BE RESPONSIBLE FOR ANY ERRORS OR OMISSIONS WHICH MAY BE INCORPORATED HEREIN AS A RESULT.


GRW
GRW Engineers, Inc.
Engineers, Architects, Planners
LEXINGTON, LOUISVILLE, NASHVILLE, INDIANAPOLIS

ENGINEER/ARCHITECT: GRW ENGINEERS

CONSTRUCTION COMPANY: EXCAVATION TECHNOLOGIES

DATE: AUGUST, 2001

REVISIONS			
NO.	DESCRIPTION	DATE	BY

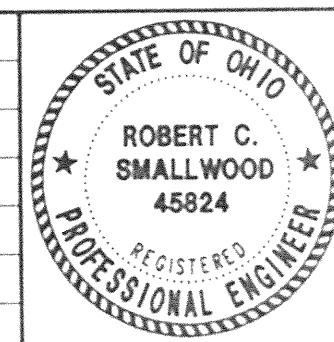

GRW PROJECT NO. 2788

LINE "A"
STA. 364+00 TO STA. 379+00
EASTERN TRANSMISSION LINE #2
AVON LAKE MUNICIPAL UTILITIES


GRW
GRW Engineers, Inc.
Engineers, Architects, Planners
LEXINGTON, LOUISVILLE, NASHVILLE, INDIANAPOLIS

DESIGNED	DATE
DRAWN	REVIEWED
CHECKED	APPROVED
IN CHARGE	DATE

28

DATE: DECEMBER 1999


FILE NAME: 2788-29

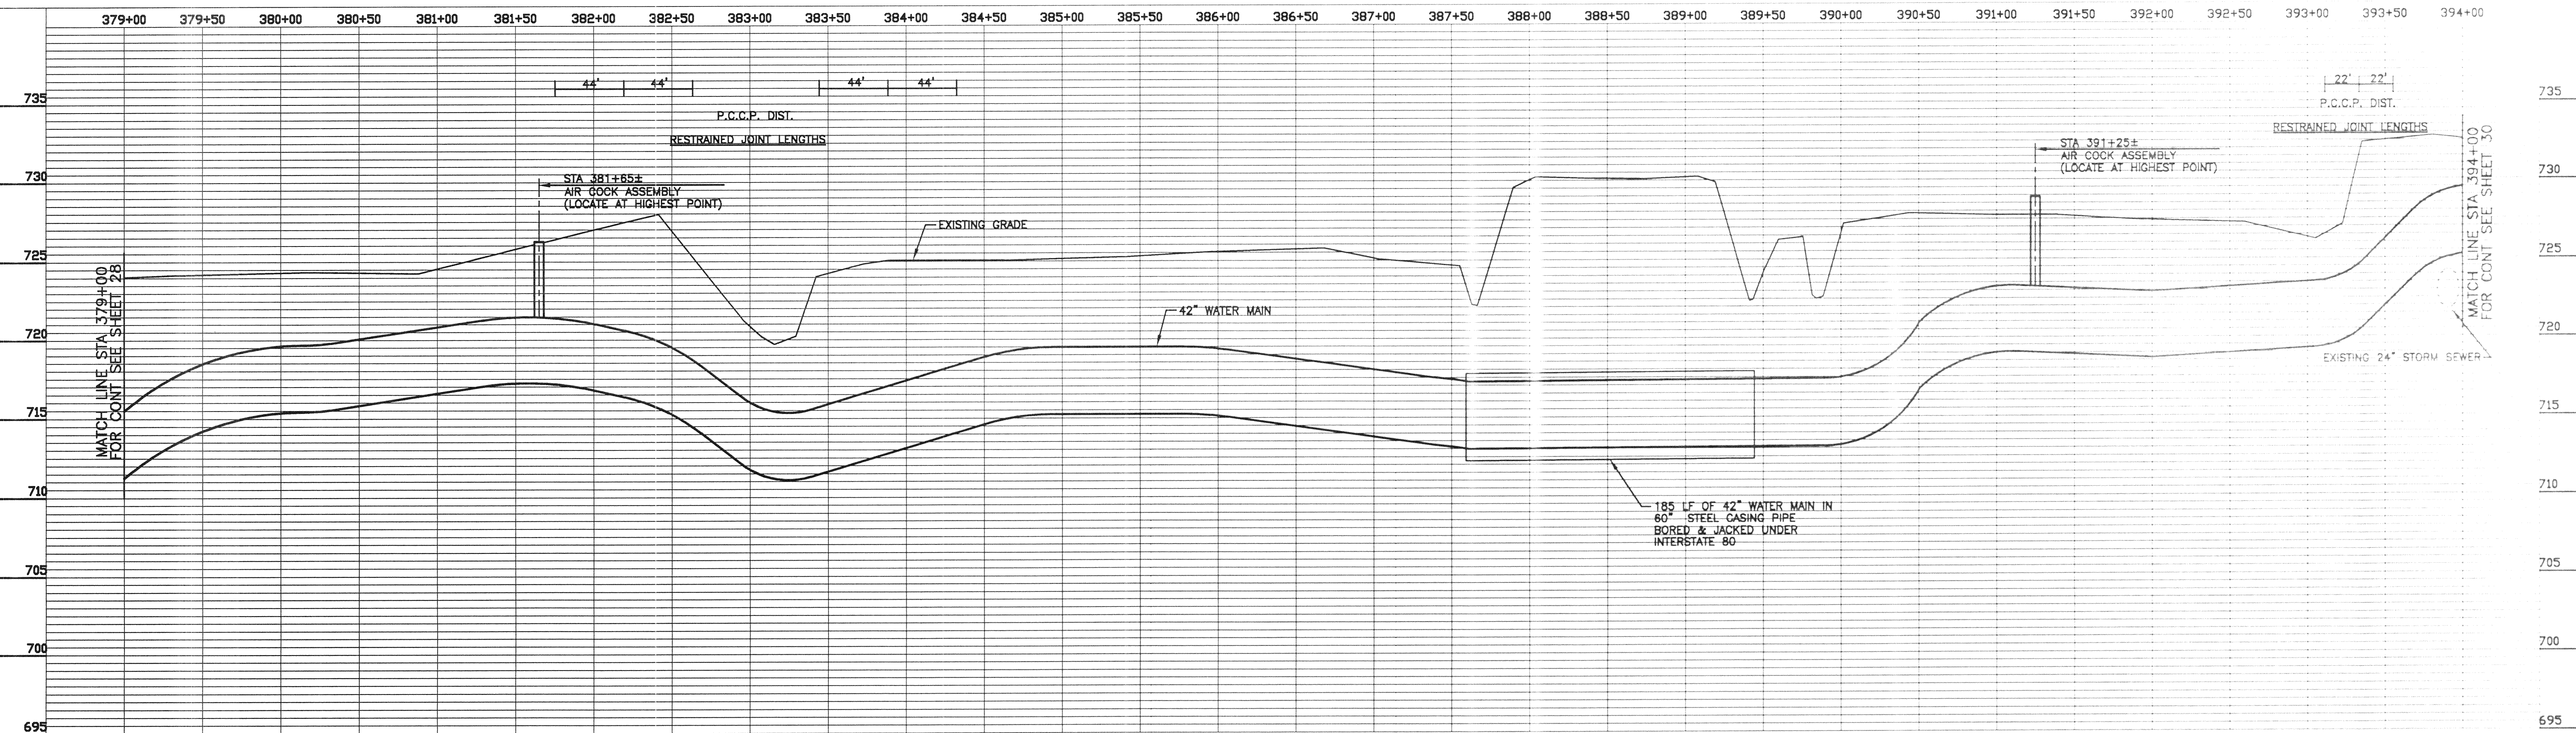

THIS RECORD DOCUMENT HAS BEEN PREPARED BASED ON INFORMATION PROVIDED BY THE CONSTRUCTION CONTRACTOR. GRW ENGINEERS, INC. HAS ATTEMPTED TO VERIFY THE ACCURACY AND/OR COMPLETENESS OF THIS INFORMATION BUT SHALL NOT BE RESPONSIBLE FOR ANY ERRORS OR OMISSIONS WHICH MAY BE INCORPORATED HEREIN AS A RESULT.

GRW Engineers, Inc.
Engineers, Architects, Planners
LEXINGTON, LOUISVILLE, NASHVILLE, INDIANAPOLIS
ENGINEER/ARCHITECT: GRW ENGINEERS
CONSTRUCTION COMPANY: EXCAVATION TECHNOLOGIES
DATE: AUGUST, 2001

REVISIONS			
NO.	DESCRIPTION	DATE	BY

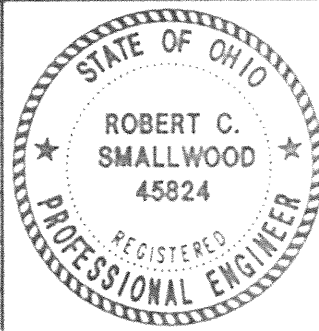



GRW PROJECT NO. 2788
LINE "A"
STA. 379+00 TO STA. 394+00
EASTERN TRANSMISSION LINE #2
AVON LAKE MUNICIPAL UTILITIES

GRW
Engineers, Architects, Planners
LEXINGTON LOUISVILLE NASHVILLE INDIANAPOLIS

DESIGNED	DATE
DRAWN	DATE
CHECKED	DATE
APPROVED	DATE

DATE: DECEMBER 1999

FILE NAME: 2788-30

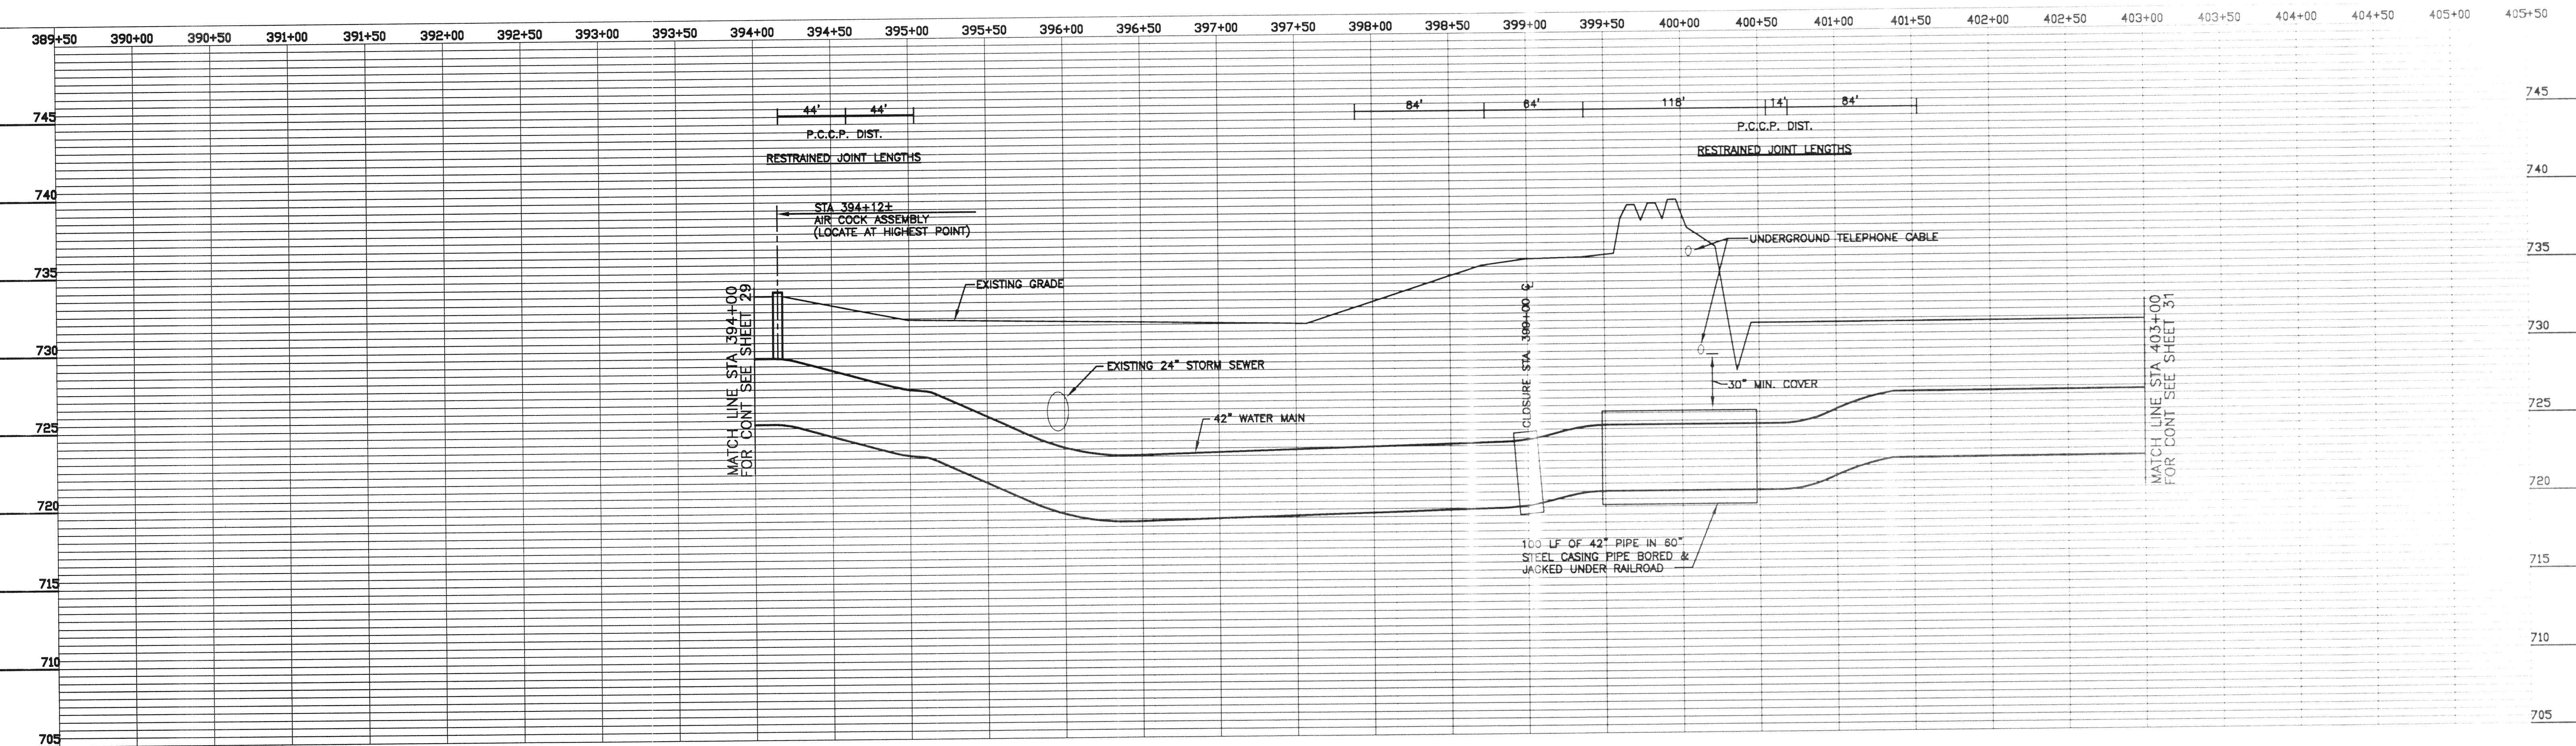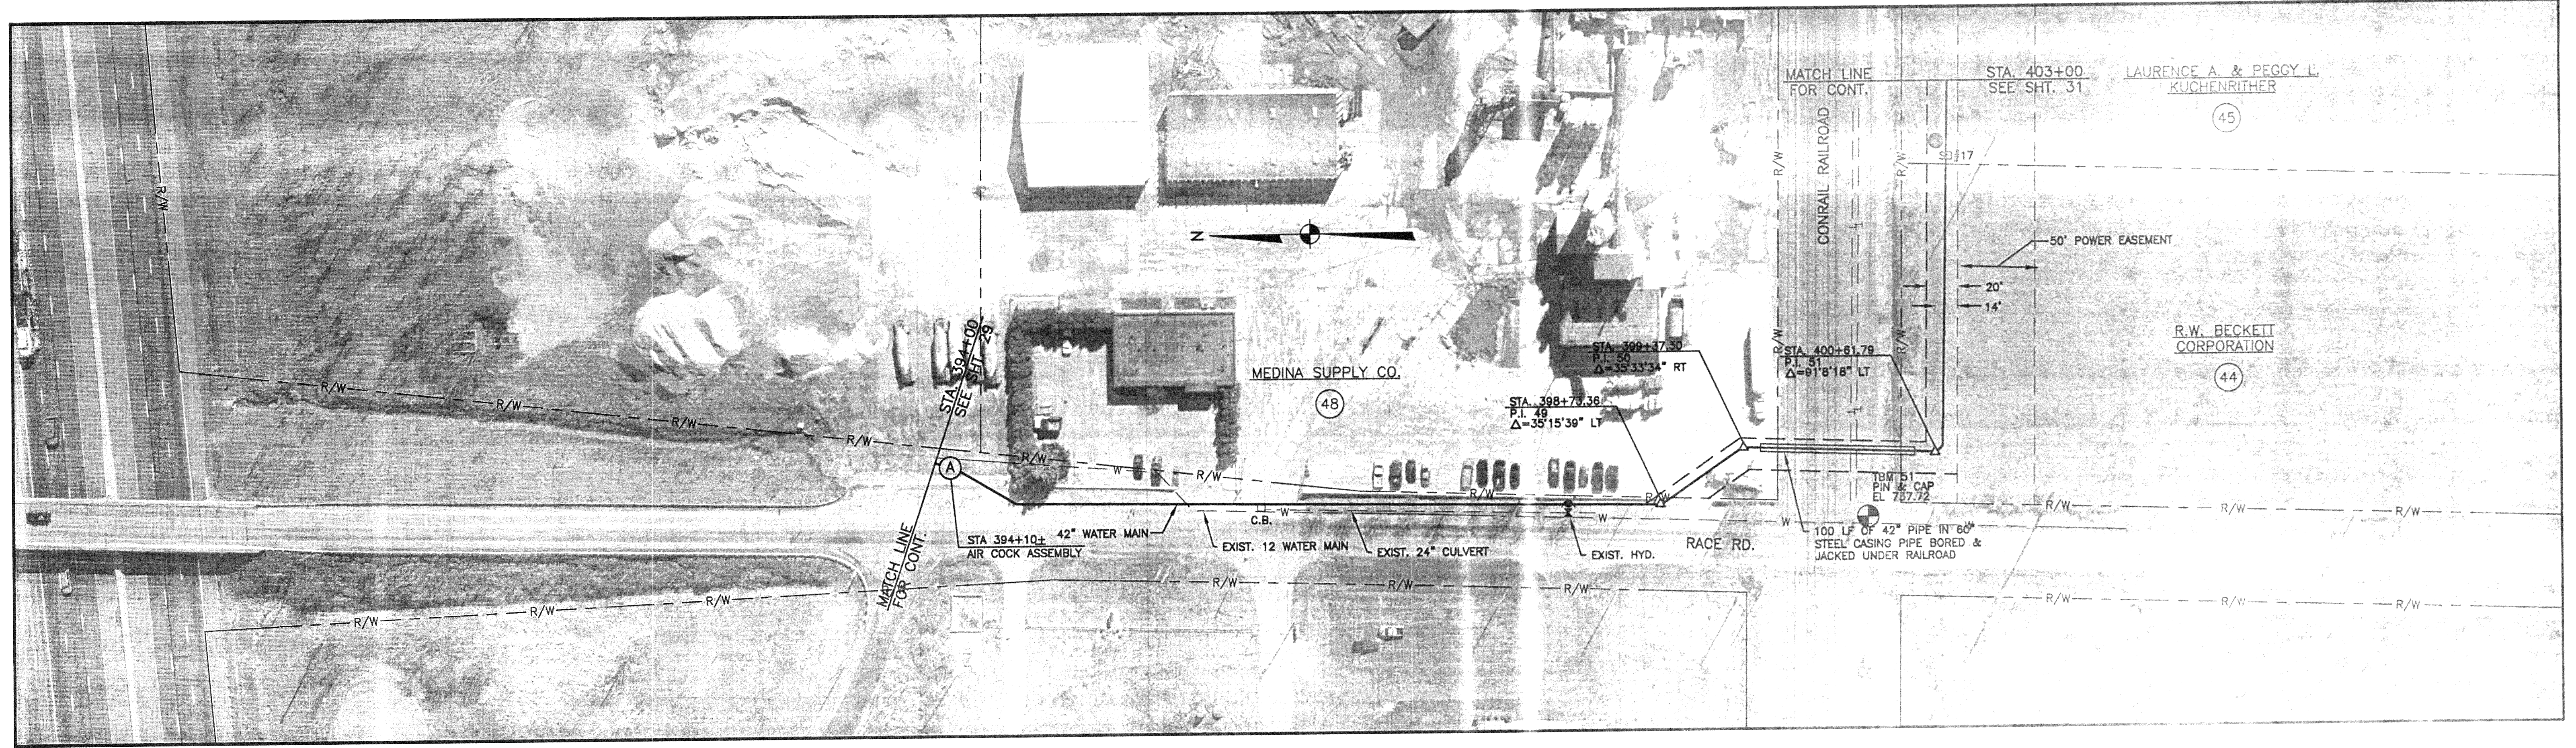

THIS RECORD DOCUMENT HAS BEEN PREPARED BASED ON INFORMATION PROVIDED BY THE CONSTRUCTION CONTRACTOR. GRW ENGINEERS, INC. HAS ATTEMPTED TO VERIFY THE ACCURACY AND/OR COMPLETENESS OF THIS INFORMATION BUT SHALL NOT BE RESPONSIBLE FOR ANY ERRORS OR OMISSIONS WHICH MAY BE INCORPORATED HEREIN AS A RESULT.


GRW Engineers, Inc.
Engineers, Architects, Planners
LEXINGTON, LOUISVILLE, NASHVILLE, INDIANAPOLIS

ENGINEER/ARCHITECT: GRW ENGINEERS

CONSTRUCTION COMPANY: EXCAVATION TECHNOLOGIES

DATE: AUGUST, 2001

REVISIONS		
NO.	DESCRIPTION	DATE BY

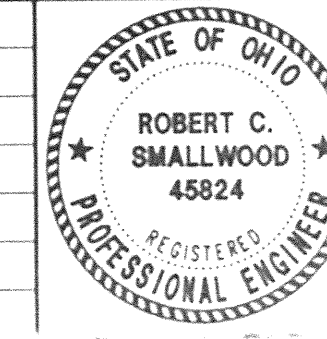

GRW PROJECT NO. 2788



LINE "A"
STA. 394+00 TO STA. 403+00
EASTERN TRANSMISSION LINE #2
AVON LAKE MUNICIPAL UTILITIES

GRW Engineers, Inc.
Engineers, Architects, Planners
LEXINGTON, LOUISVILLE, NASHVILLE, INDIANAPOLIS

DESIGNED: DLT	DATE: DECEMBER 1999
DRAWN: DLT	SCALE: 1" = 50'-0"
REVIEWED: ROS	CHECKED: DLT
APPROVED: ROS	30

FILE NAME: 2788- 31

DATE: DECEMBER 1999

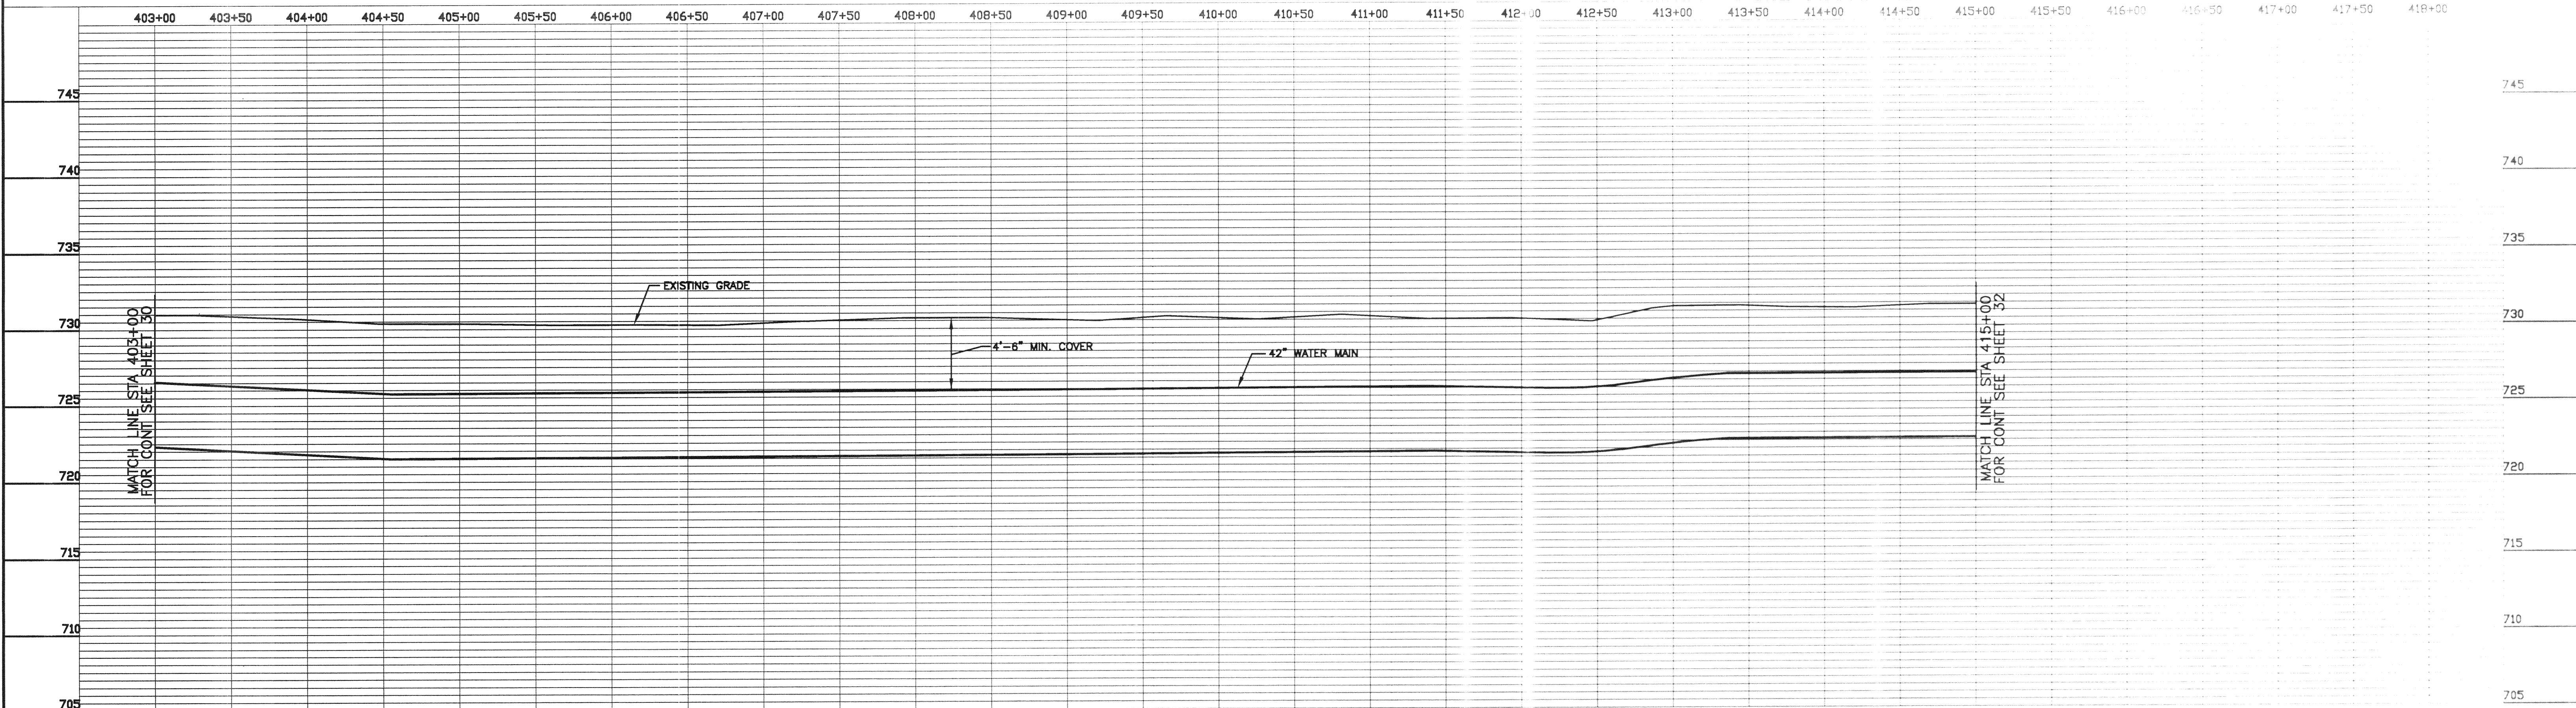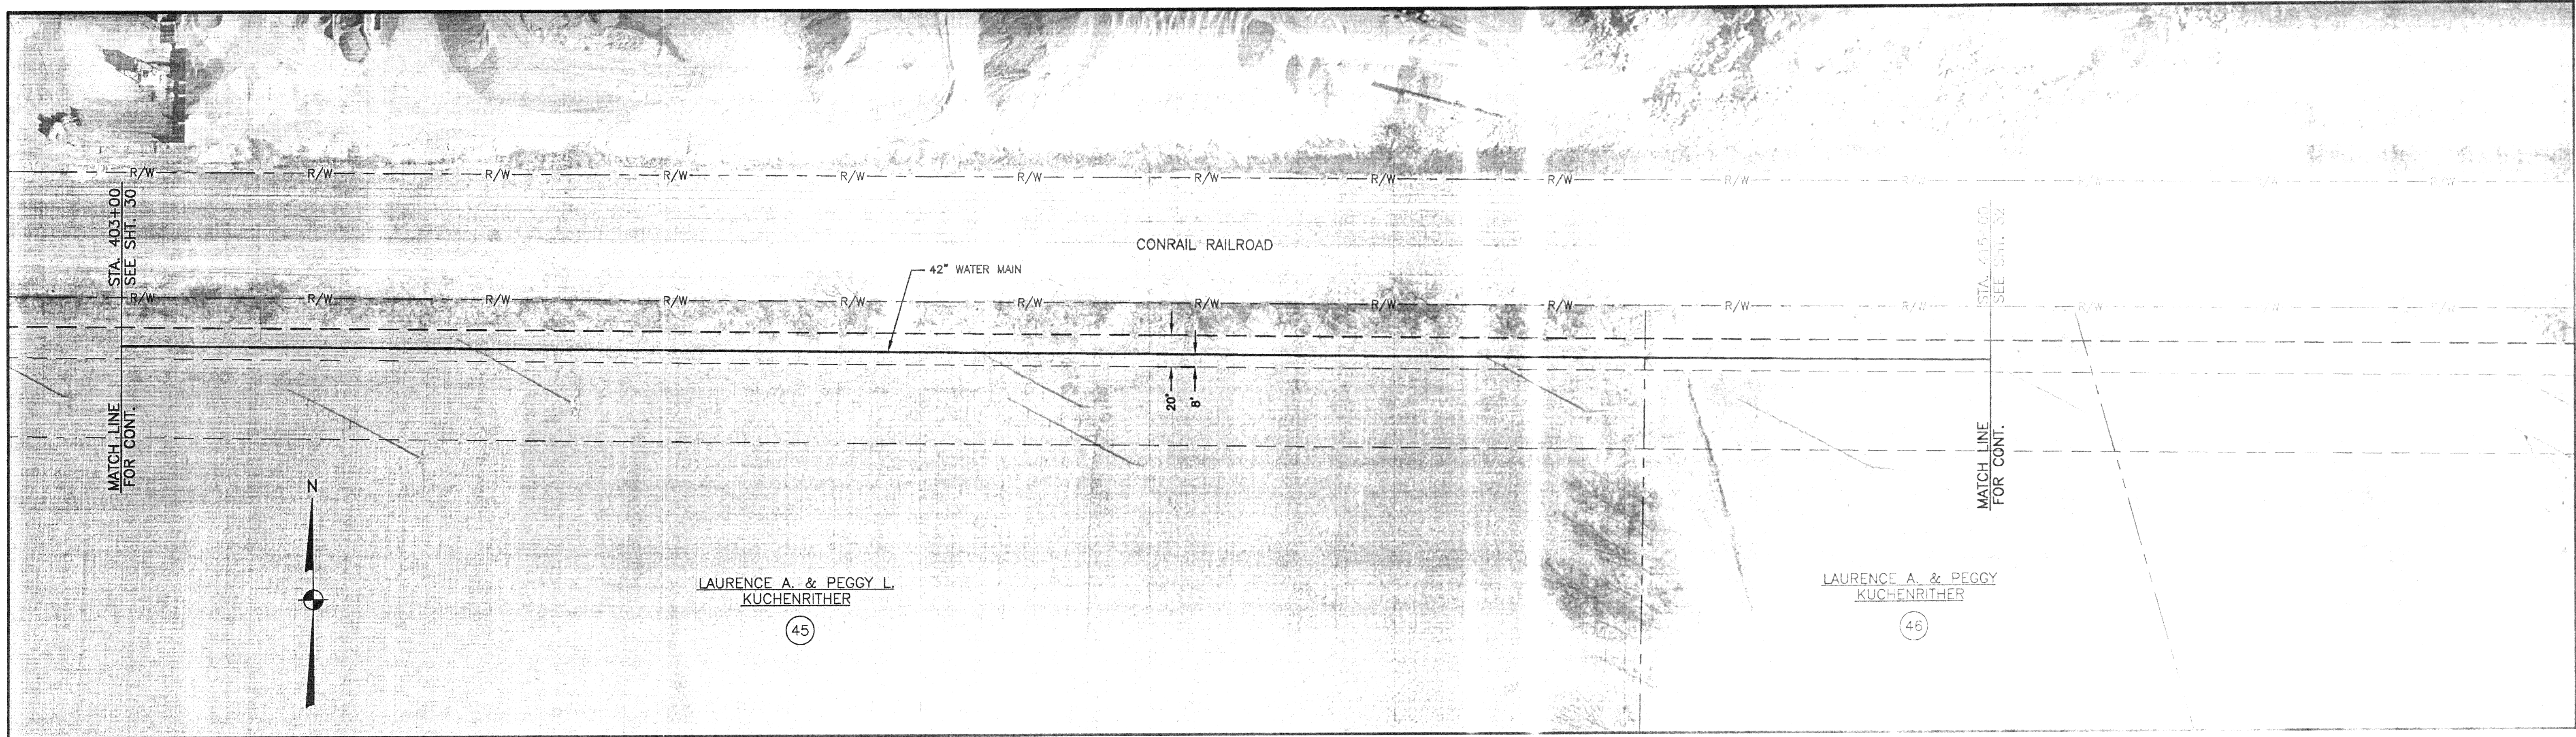

THIS RECORD DOCUMENT HAS BEEN PREPARED BASED ON INFORMATION PROVIDED BY THE CONSTRUCTION CONTRACTOR. GRW ENGINEERS, INC. HAS ATTEMPTED TO VERIFY THE ACCURACY AND/OR COMPLETENESS OF THIS INFORMATION BUT SHALL NOT BE RESPONSIBLE FOR ANY ERRORS OR OMISSIONS WHICH MAY BE INCORPORATED HEREIN AS A RESULT.


GRW Engineers, Inc.
Engineers, Architects, Planners
LEXINGTON, LOUISVILLE, NASHVILLE, INDIANAPOLIS

ENGINEER/ARCHITECT: GRW ENGINEERS

CONSTRUCTION COMPANY: EXCAVATION TECHNOLOGIES

DATE: AUGUST, 2001

REVISIONS			
NO.	DESCRIPTION	DATE	BY

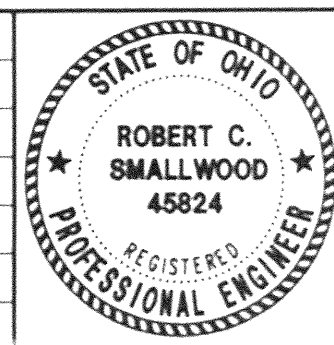

GRW PROJECT NO. 2788

LINE "A"
STA. 403+00 TO STA. 415+00
EASTERN TRANSMISSION LINE #2
AVON LAKE MUNICIPAL UTILITIES

DESIGNED DLT	DATE DECEMBER 1999
DRAWN DLT	SCALE 1" = 50'-0"
REVIEWED RCS	SHEET NO.
APPROVED RCS	31

GRW Engineers, Inc.
Engineers, Architects, Planners
LEXINGTON LOUISVILLE NASHVILLE INDIANAPOLIS