


# LOCATION SKETCH

Sketch the system which was installed in the space below. Designate the mains, as Mains "A", "B", etc. Indicate the size of the mains and laterals. Show distances from buildings or other known points. Show ditches, streams, or existing mains. Show roads which will help locate property.

NORTH

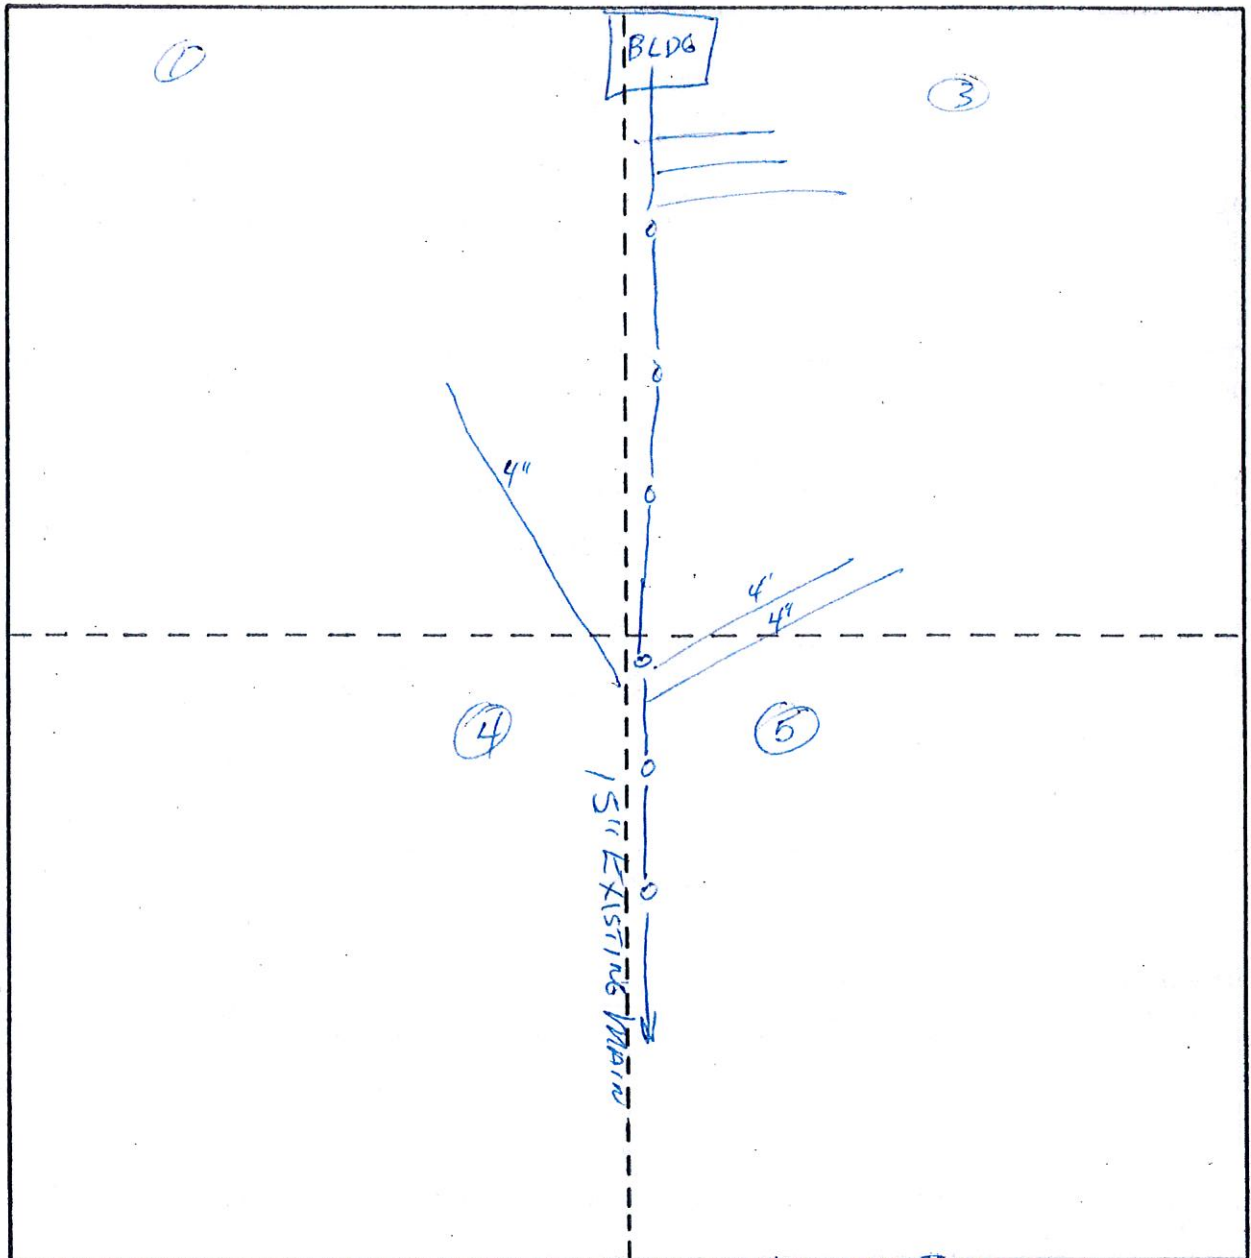

Entire block represents 40 acres  
Small blocks 10 acres

Not TO SCALE  
Scale 1 inch = 200 feet

Notes:

May-June 1975  
2250' 4" installed  
by Phil Cantelero  
for George Suleas