


FAIRFIELD COUNTY
WALNUT TOWNSHIP
SEC. 20 & 29, T. 16, R. 18

RETRIEV TECHNOLOGIES INCORPORATED
8090 LANCASTER-NEWARK RD
0490254300
INDUSTRIAL

COYOTE RUN II, LLC
1380 BALTIMORE-SOMERSET RD NE
0490254200
AGRICULTURAL

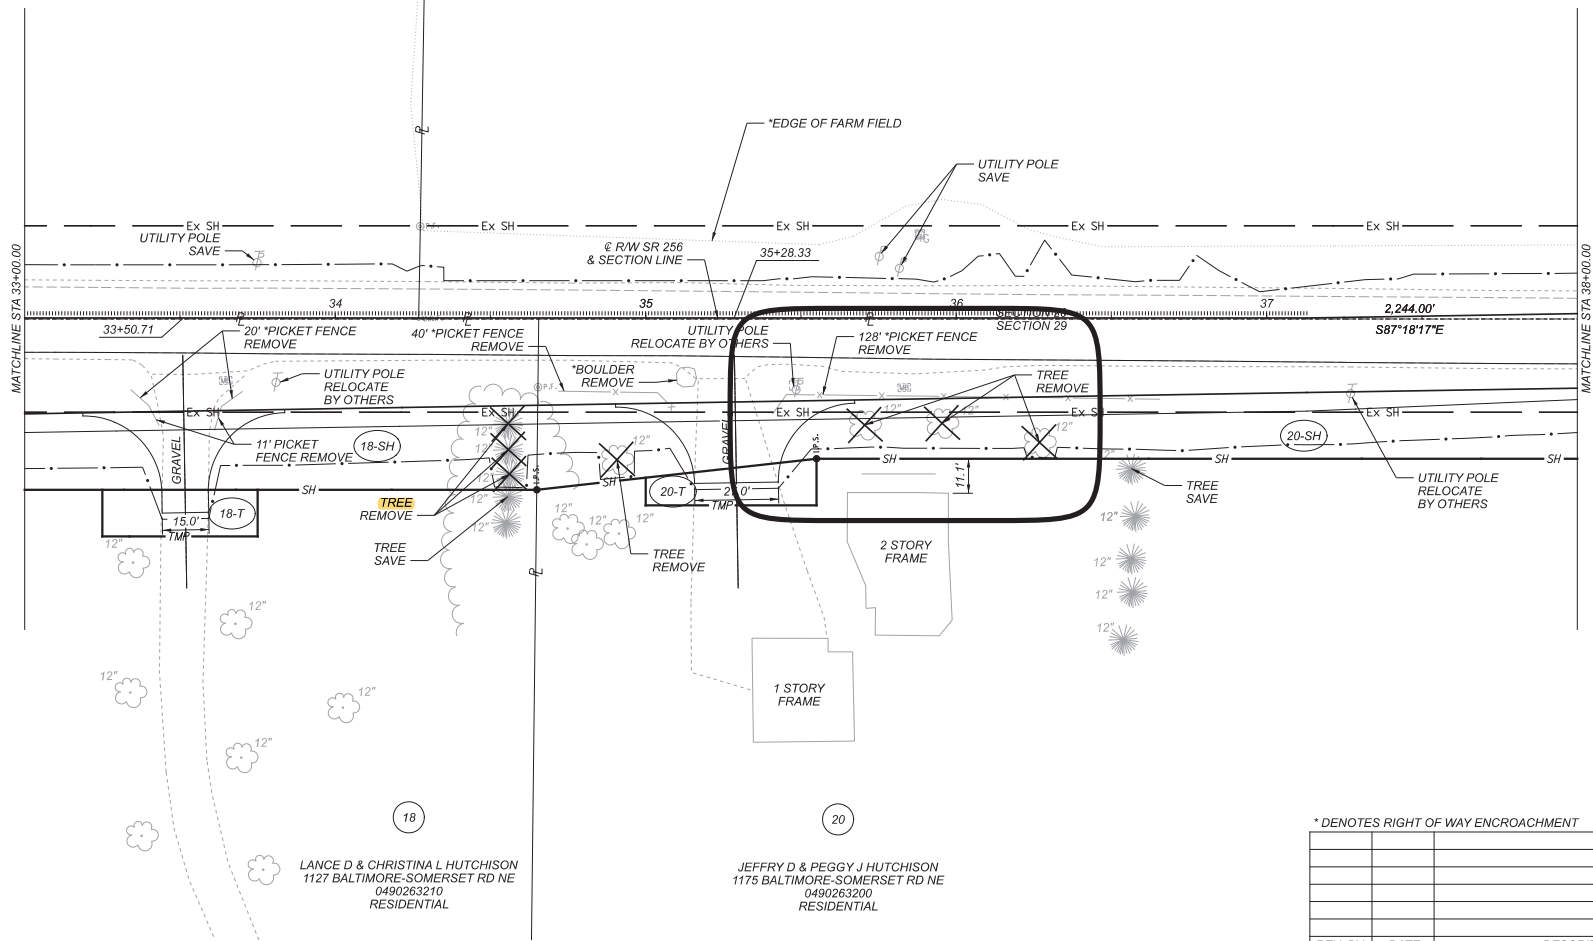

* DENOTES RIGHT OF WAY ENCROACHMENT

					ALM
					REVIEWER
					SJS 09/11/20
					PROJECT ID
					110412
					SHEET TOTAL
					34 37
REV. BY	DATE			DESCRIPTION	SHEET TOTAL
	DATE COMPLETED 09/11/20				P.O. 0

HORIZONTAL
SCALE IN FEET



0 20

RIGHT OF WAY TOPO SHEET
SR 256 STA. 33+00.00 TO STA. 38+00.00

DESIGN AGENCY
**Mead
& Hunt**
CLIENT



DESIGNER

ALM

REVIEWER	
1	2
3	4
5	6
99	100

SJS 09/11/20

PROJECT ID
110412

T10-712	
SUBSET	TOTAL
1	1
2	2
3	3
100	100

34	37
----	----

SHEET	TOTAL
-------	-------

FAI-37-06.10

MODEL: I0402_R1205 PAPER/SIZE: TX(11in.) DATE: 12/18/2020 TIME: 10:29:28 AM USER: j78qim
 pw:\trc-pw.bentley.com\trc-pw\Documents\5 - Projects\Ohio Department of Transportation\345242 - FA-37-06.01A - CAD_Des(ghv0402x400-Engineering)\RWSheets\I0402_R1205.dgn