
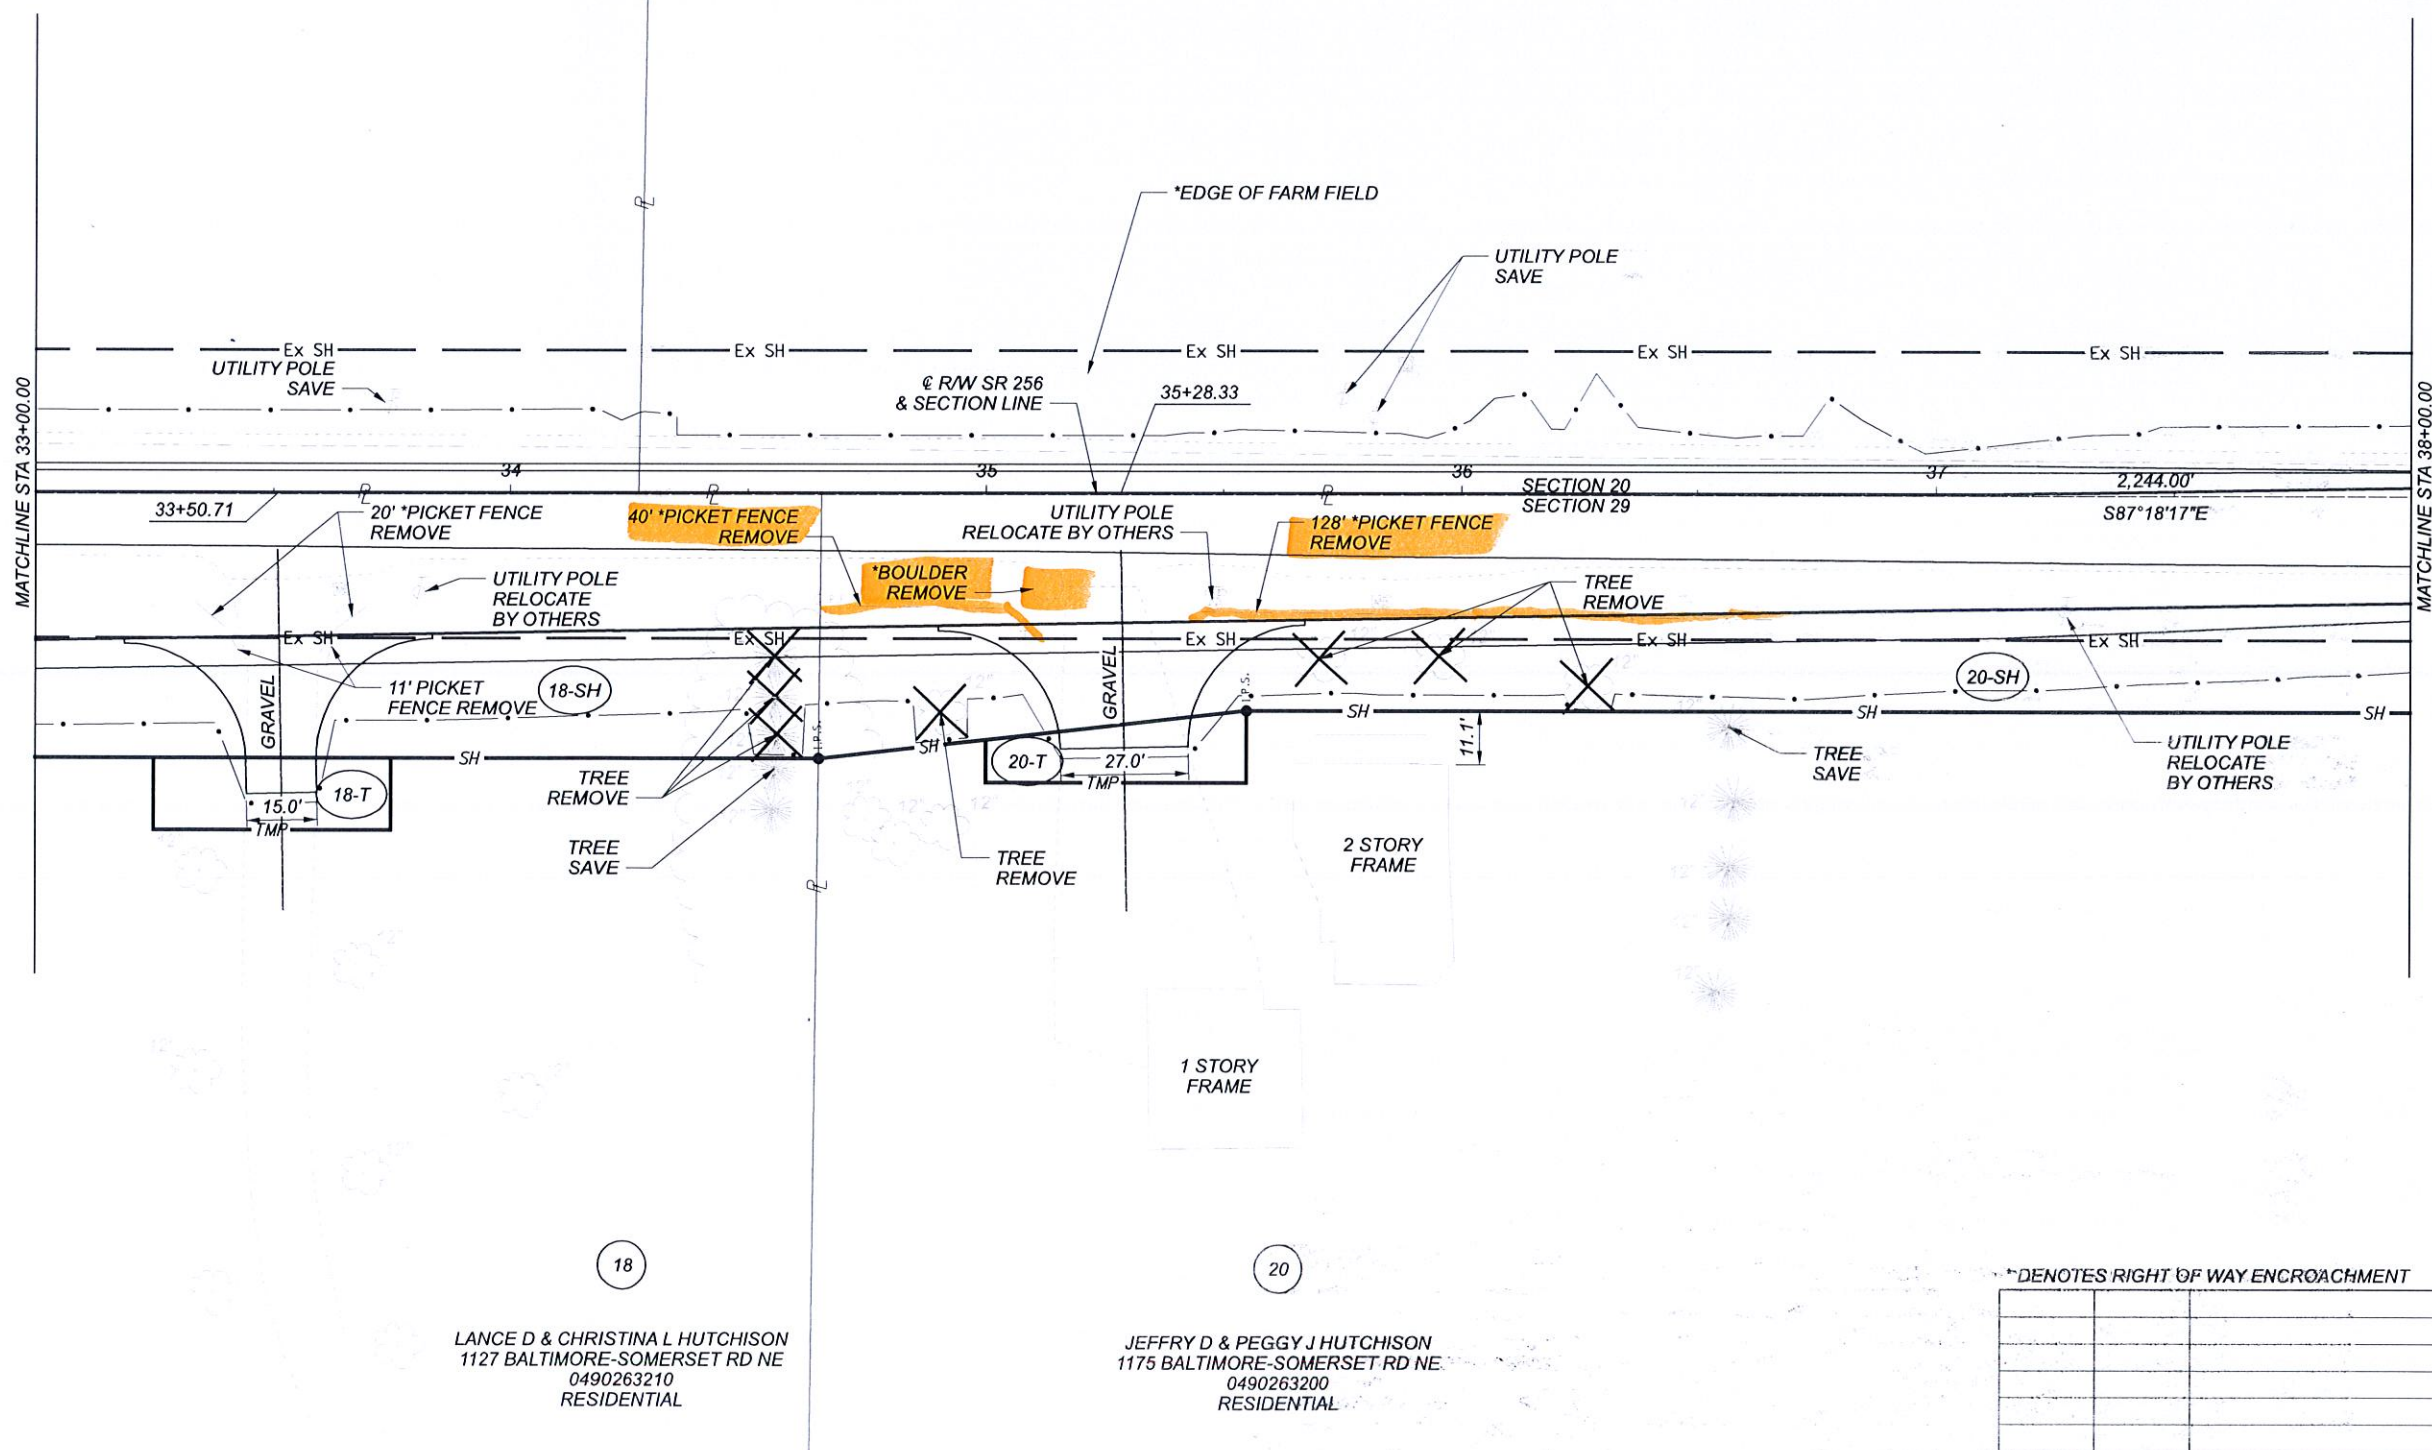


HORIZONTAL
SCALE IN FEET
0 10 20 40RIGHT OF WAY TOPO SHEET
SR 256 STA. 33+00.00 TO STA. 38+00.00

DESIGNER	ALM
REVIEWER	SJS
DATE	09/11/20
PROJECT ID	110412
SUBSET	34
TOTAL	37
SHEET	P.186
TOTAL	201

REV. BY DATE DESCRIPTION
DATE COMPLETED: 09/11/20

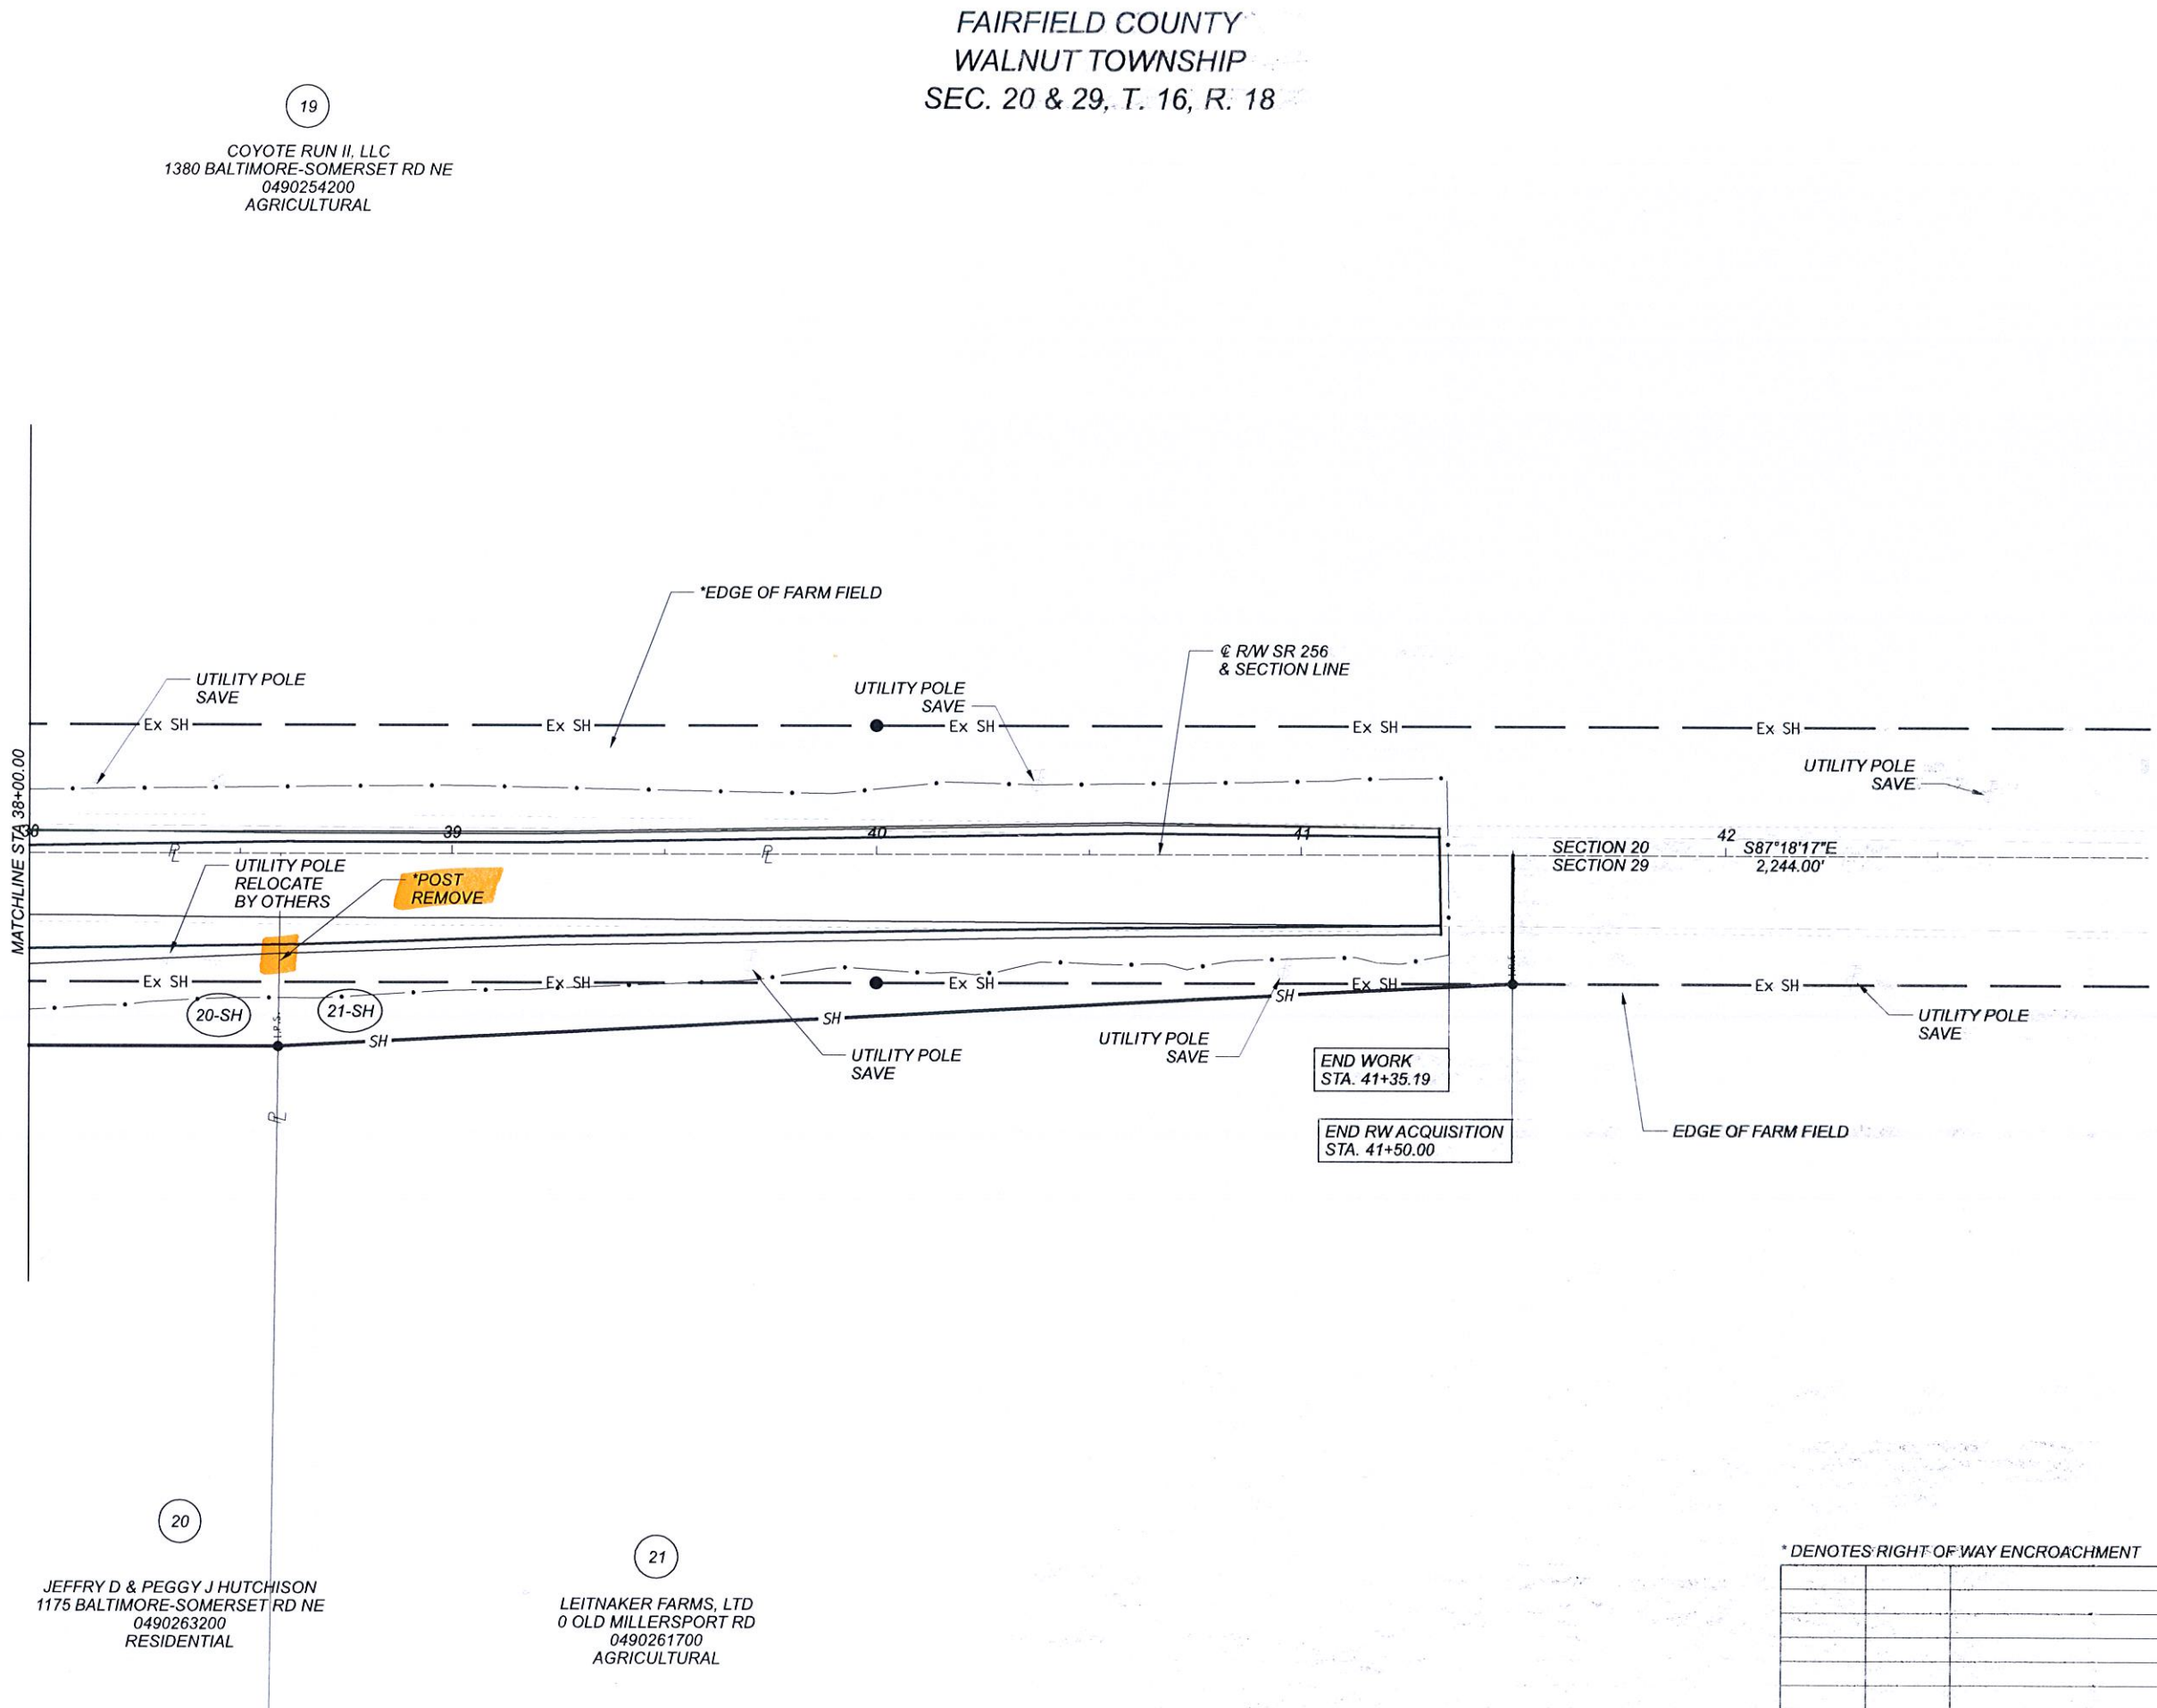

JEFFRY D & PEGGY J HUTCHISON
1175 BALTIMORE-SOMERSET RD NE
0490263200
RESIDENTIAL

LEITNAKER FARMS, LTD
0 OLD MILLERSPORT RD
0490261700
AGRICULTURAL

* DENOTES RIGHT OF WAY ENCROACHMENT

REV. BY	DATE	DESCRIPTION
DATE COMPLETED	09/11/20	

DESIGN AGENCY	Mead & Hunt
CLIENT	
DESIGNER	ALM
REVIEWER	SJS
DATE	09/11/20
PROJECT ID	110412
SUBSET	36
TOTAL	37
SHEET	P.188
TOTAL	201

RIGHT OF WAY TOPO SHEET
SR 256 STA. 38+00.00 TO STA. 43+00.00

