

STATE OF OHIO  
DEPARTMENT OF TRANSPORTATION

FEDERAL PROJECT NO.  
**E240711**

RAILROAD INVOLVEMENT  
**NONE**

# HAM CR 96 3.92-SIDEWALK


**PROJECT DESCRIPTION**

THE PROJECT INVOLVES THE CONSTRUCTION OF NEW SIDEWALKS ON BOTH SIDES OF SPRINGDALE ROAD FROM POOLE ROAD TO YELLOWWOOD DRIVE.

## COLERAIN TOWNSHIP SECTION 15, TOWN 2, RANGE 1 HAMILTON COUNTY


**EARTH DISTURBED AREAS**

PROJECT EARTH DISTURBED AREA:	1.20 ACRES
ESTIMATED CONTRACTOR E.D.A.:	0.10 ACRES
NOTICE OF INTENT E.D.A.:	1.30 ACRES

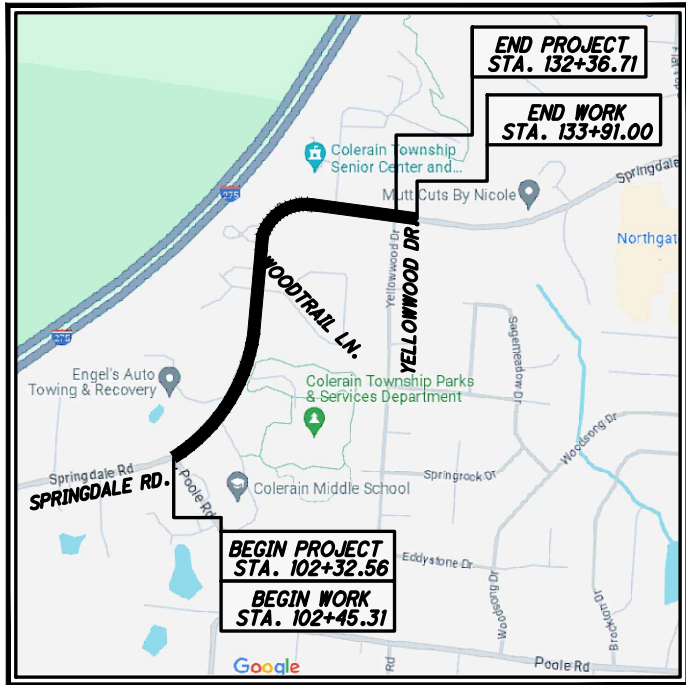

**LOCATION MAP**

LATITUDE: 39° 14' 40" N LONGITUDE: 84° 36' 46" W

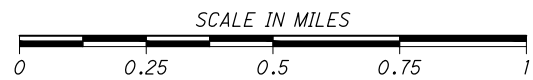

PORTION TO BE IMPROVED	—————
STATE & FEDERAL ROUTES	—————
OTHER ROADS	—————

**DESIGN DESIGNATION**

CURRENT ADT (2027)	8,800
DESIGN YEAR ADT (2047)	10,100
DESIGN HOURLY VOLUME (2047)	1,100
DIRECTIONAL DISTRIBUTION	53%
TRUCKS (24 HOUR B&C)	1%
DESIGN SPEED	40 MPH
LEGAL SPEED	35 MPH

DESIGN FUNCTIONAL CLASSIFICATION:  
05 MAJOR COLLECTOR (URBAN)

NHS PROJECT ----- NO  
**DESIGN EXCEPTIONS: NONE REQUIRED**

**ADA DESIGN WAIVERS: NONE REQUIRED**

**UNDERGROUND UTILITIES**  
Contact Two Working Days Before You Dig

OHIO 811, 8-1-1, or 1-800-362-2764 (Non-members must be called directly)

PLAN PREPARED BY:

440 E. HOEWISHER ROAD • SIDNEY, OHIO 45365 • 937.497.0200  
8956 GLENDALE MILFORD ROAD, SUITE 1 • LOVELAND, OHIO 45140 • 513.239.8554  
www.CHOICEONEENGINEERING.com

**INDEX OF SHEETS:**

TITLE SHEET	1
SCHEMATIC PLAN	2
TYPICAL SECTIONS	3
GENERAL NOTES	4-6
MAINTENANCE OF TRAFFIC NOTES	7
GENERAL SUMMARY	8-9
SUBSUMMARY	10-13
PROJECT SITE PLAN	14-15
PLAN AND PROFILE - SPRINGDALE ROAD	16-22
CROSS SECTIONS - SPRINGDALE ROAD	23-42
DRIVE DETAILS (PROFILES)	43
CURB RAMP DETAILS	44-45
TRAFFIC CONTROL PLAN	46-49
TRAFFIC SIGNAL NOTES	50-51
TRAFFIC SIGNAL PLAN	52-53
GREATER CINCINNATI WATERWORKS PLANS	1-4 (GCWWI-)

REVIEW COMPLETE	
PM	2023 SPECIFICATIONS
BRIDGES	THE STANDARD SPECIFICATIONS OF THE STATE OF OHIO, DEPARTMENT OF TRANSPORTATION, INCLUDING SUPPLEMENTAL SPECIFICATIONS LISTED IN THE PLANS AND CHANGES LISTED IN THE PROPOSAL SHALL GOVERN THIS IMPROVEMENT.
CONSTRUCT	I HEREBY APPROVE THESE PLANS AND DECLARE THAT THE MAKING OF THIS IMPROVEMENT WILL NOT REQUIRE THE CLOSING TO TRAFFIC OF THE HIGHWAY AND THAT PROVISIONS FOR THE MAINTENANCE AND SAFETY OF TRAFFIC WILL BE SET FORTH ON THE PLANS AND ESTIMATES.
DRAINAGE	Tami Brehm, P.E. 09/02/2025
ENVIRON	L. Keith Smith, P.E. 07/30/2025
GEOTECH	Casey Carriere, P.E. 7/29/2025
ITS	
MOT(4)	Alex Genbauffe, P.E. 10/01/2025
PAVEMENT	
ROADWAY	Katherine S. DeStefano, P.E. 07/25/2025
R/W	
SURVEY	
TRAFFIC	Teri C. Scanlon, P.E. 09/03/2025
UTILITIES	Lucas W. Braun, P.E. 08/28/2025
OTHER	Katherine S. DeStefano, P.E. 07/25/2025
OTHER	

All associated SCD/SS dates should be filled in at this point.

comments were made on the BMP calcs

STAGE 3 SUBMITTAL - JULY 23, 2023

That's now at Stage 3.

DATES TO BE ADDED PRIOR TO FINAL TRACINGS SUBMITTAL

ENGINEERS SEAL

FOR ENTIRE PLAN EXCEPT TRAFFIC SIGNAL PLAN

SIGNED: \_\_\_\_\_  
DATE: \_\_\_\_\_

ENGINEERS SEAL

FOR TRAFFIC SIGNAL PLAN

SIGNED: \_\_\_\_\_  
DATE: \_\_\_\_\_

OHIO DEPARTMENT OF TRANSPORTATION STANDARD CONSTRUCTION DRAWINGS				SUPPLEMENTAL SPECIFICATIONS	SPECIAL PROVISIONS
BP-4.1	XX/XX/XX	TC-41.20	XX/XX/XX	800	XX/XX/XX
BP-5.1	XX/XX/XX	TC-41.30	XX/XX/XX	832	XX/XX/XX
BP-7.1	XX/XX/XX	TC-42.20	XX/XX/XX		
		TC-52.10	XX/XX/XX	878	
DM-1.1	XX/XX/XX	TC-52.20	XX/XX/XX		
		TC-74.10	XX/XX/XX		
		TC-83.20	XX/XX/XX		
DM-4.3		TC-87.10	XX/XX/XX		
DM-4.4					
		MT-95.61	XX/XX/XX		
		MT-97.10	XX/XX/XX		
		MT-101.90	XX/XX/XX		
		MT-105.10	XX/XX/XX		
		MT-110.10	XX/XX/XX		

Douglas A. Gruver, P.E.  
District 08 Deputy Director

Pamela Boratyn  
Director, Department of Transportation

HAM CR 96 3.92-SIDEWALK

Z:\project\Hamilton\ColerainTownship\HAM-COL-2301SpringdaleRoadSidewalkPhase2\120866\_1\_GT001.dwg 17-Jul-25 1:44 PM

TITLE SHEET

DESIGN AGENCY

CHOICE ONE ENGINEERING



DESIGNER  
IJW

REVIEWER  
BAW 7-23-2025


PROJECT ID  
120861

SHEET TOTAL  
P:1 53

COLERAIN TOWNSHIP

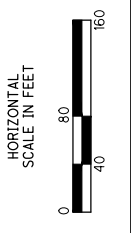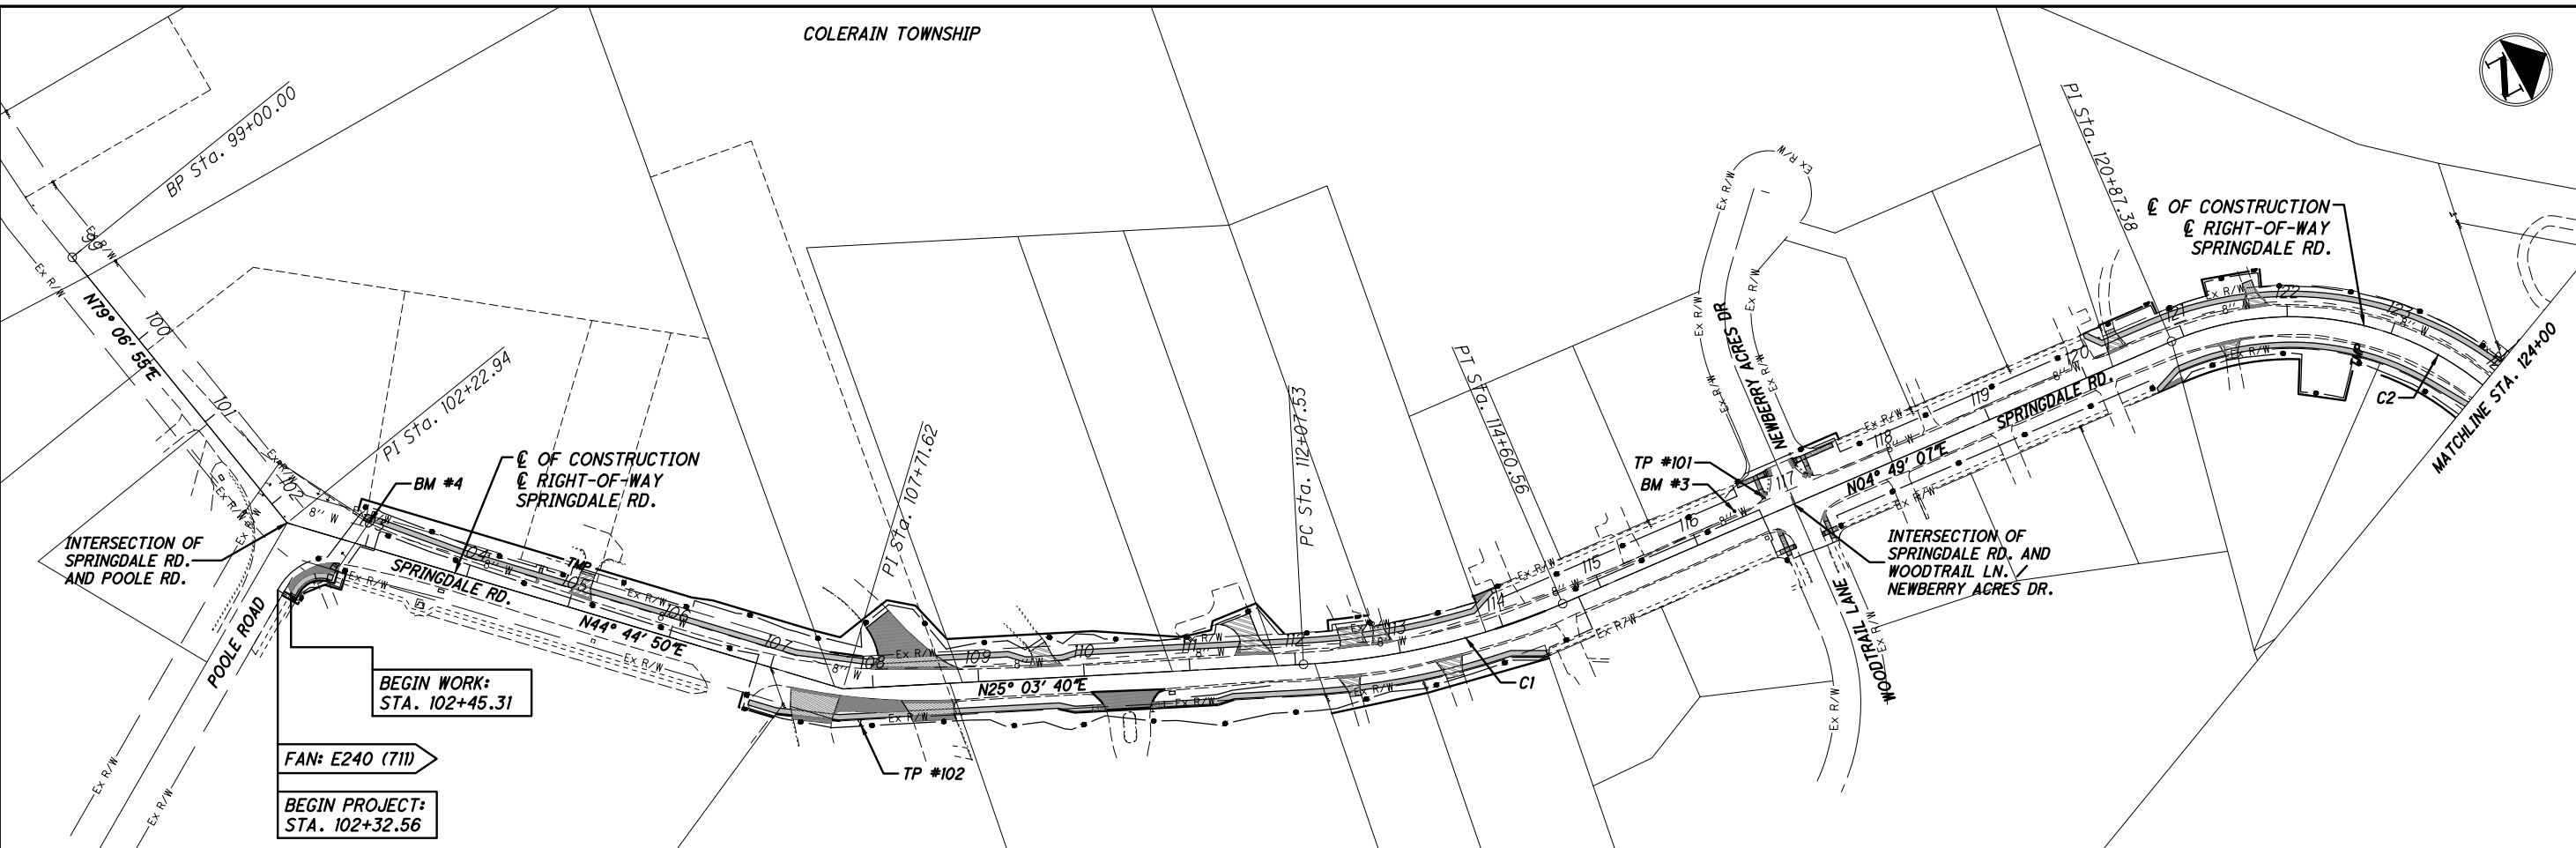

SCHEMATIC PLAN

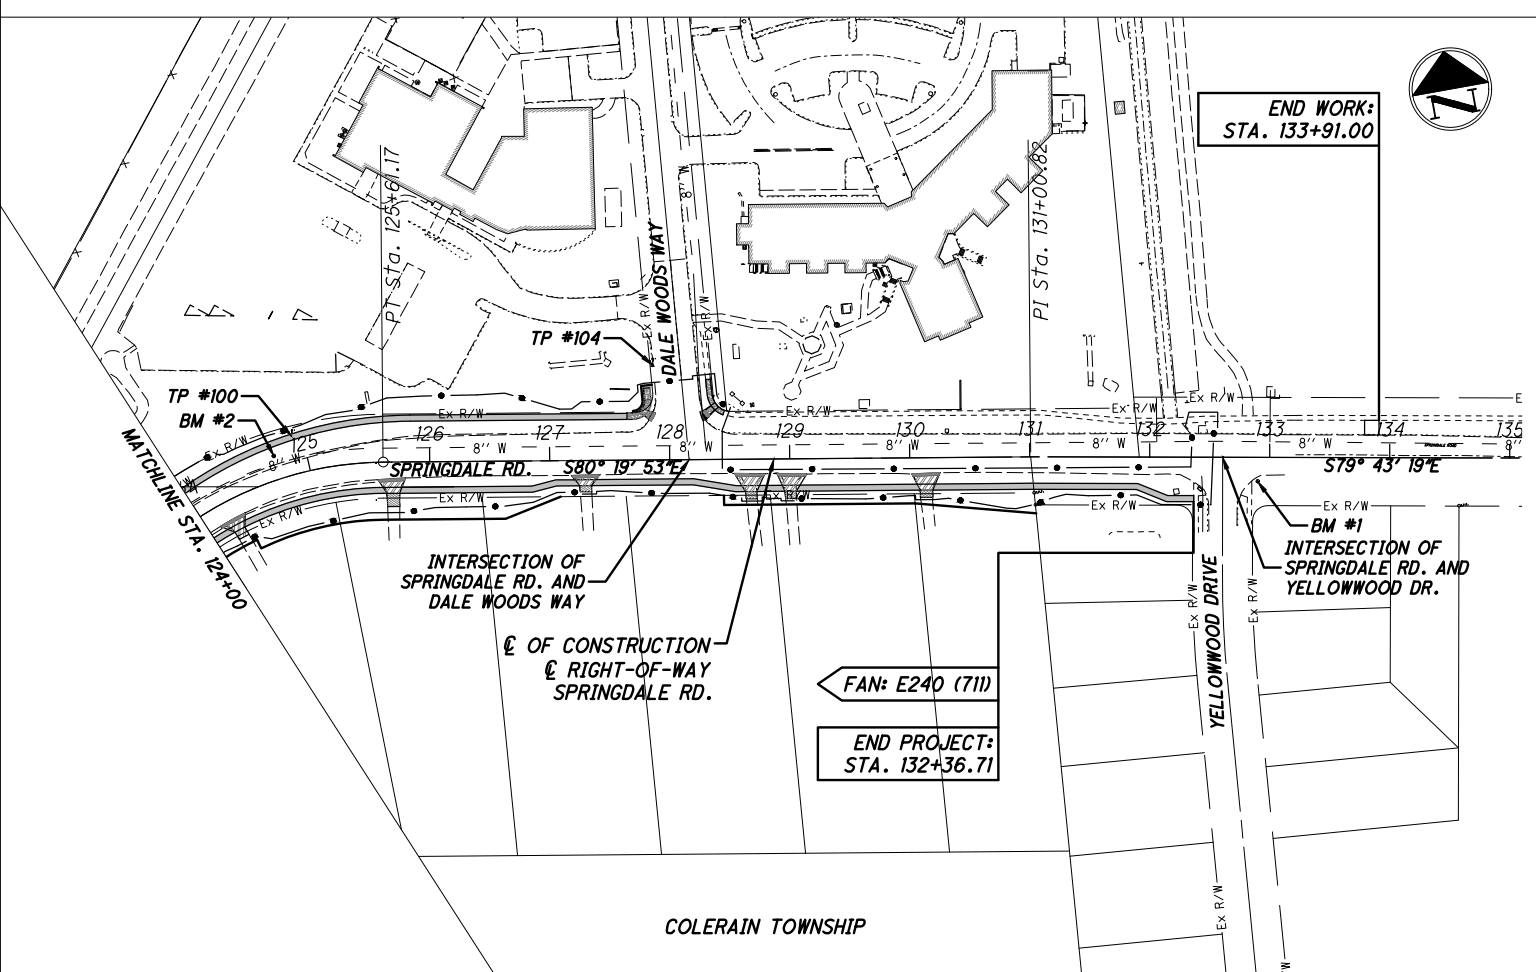

NAD 83(2011) GRID

HORIZONTAL CONTROL:

TRAVERSE POINT #100  
 N=460511.3860  
 E=1370406.1840  
 STA. 124+91.83, 31.37' LT

TRAVERSE POINT #101  
 N=459809.6750  
 E=1370093.1020  
 STA. 116+75.48, 16.68' LT

TRAVERSE POINT #102  
 N=458954.8540  
 E=1369879.4070  
 STA. 107+86.34, 34.26' RT

TRAVERSE POINT #104  
 N=460516.9210  
 E=1370712.8060  
 STA. 127+86.32, 79.05' LT

VERTICAL CONTROL:

BENCHMARK #1 ELEV: 860.01 PT.#: 35000  
 MAG NAIL IN POWER POLE AT THE SE CORNER OF SPRINGDALE RD. & YELLOWWOOD DR. @ STA. 132+90 RT.

BENCHMARK #2 ELEV: 890.58 PT.#: 35001  
 BOLT AT TIP ARROW TOP FLANGE OF FIRE HYDRANT IN FRONT OF 4300 SPRINGDALE RD. @ STA. 124+75 LT.


BENCHMARK #3 ELEV: 896.80 PT.#: 36002  
 BOLT AT TIP ARROW TOP FLANGE OF FIRE HYDRANT AT THE SW CORNER OF SPRINGDALE RD. AND NEWBERRY ACRES. @ STA. 116+44 LT.

BENCHMARK #4 ELEV: 916.62 PT.#: 36003  
 MAG NAIL IN THE POWER POLE AT THE NE CORNER OF SPRINGDALE RD. & POOLE RD. @ STA. 102+98 LT.

Really??

NOTE: THERE ARE NO EXISTING LANDSCAPED AREAS WITHIN THE WORK LIMIT

CURVE TABLE					
CURVE	RADIUS	LENGTH	DELTA	CH DIST	CH BEARING
C1	716.20'	253.03'	20°14'33"	251.72'	N14°56'23"E
C2	286.20'	473.79'	94°51'00"	421.51'	N52°14'37"E

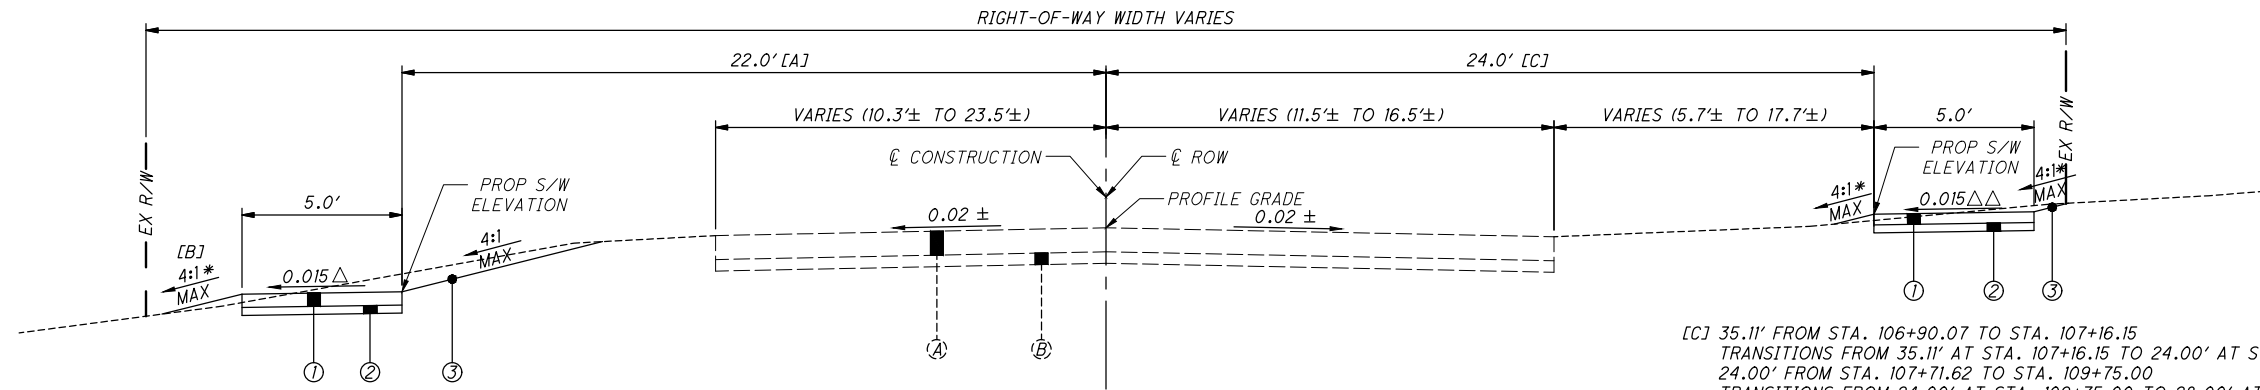

TYPICAL SECTION - SPRINGDALE ROAD

STA. 102+96.96 TO 114+29.86  
STA. 120+13.31 TO 132+36.68

\* SLOPE VARIES SEE CROSS-SECTIONS FOR MORE DETAILS

[C] 35.11' FROM STA. 106+90.07 TO STA. 107+16.15  
 TRANSITIONS FROM 35.11' AT STA. 107+16.15 TO 24.00' AT STA. 107+71.62  
 24.00' FROM STA. 107+71.62 TO STA. 109+75.00  
 TRANSITIONS FROM 24.00' AT STA. 109+75.00 TO 28.00' AT STA. 109+90.00  
 28.00' FROM STA. 109+90.00 TO STA. 111+24.44  
 TRANSITIONS FROM 28.00' AT STA. 111+24.44 TO 24.00' AT STA. 111+39.44  
 24.00' AT STA. 111+39.44 TO STA. 114+00.00  
 TRANSITIONS FROM 24.00' AT STA. 114+00.00 TO 35.10' AT STA. 114+29.86

TRANSITIONS FROM 35.16' AT STA. 120+57.49 TO 24.00' AT STA. 120+85.15  
 24.00' FROM STA. 120+85.15 TO STA. 123+56.91  
 TRANSITIONS FROM 24.00' AT STA. 123+56.91 TO 21' AT STA. 124+00.00  
 21.00' FROM STA. 124+00.00 TO STA. 126+85.06  
 TRANSITIONS FROM 21.00' AT STA. 126+85.06 TO 16.00' AT STA. 127+05.00  
 16.00' FROM STA. 127+05.00 TO STA. 128+20.00  
 TRANSITIONS FROM 16.00' AT STA. 128+20.00 TO 22.00' AT STA. 128+55.00  
 22.00' FROM STA. 128+55.00 TO STA. 131+90.00  
 TRANSITIONS FROM 22.00' AT STA. 131+90.00 TO 32.00' AT STA. 132+15.00  
 32.00' FROM STA. 132+15.00 TO STA. 132+36.68

[A] TRANSITIONS FROM 24.44' AT STA. 102+96.96 TO 18.00' AT STA. 104+00.00  
 18' FROM STA. 104+00.00 TO STA. 107+19.90  
 TRANSITIONS FROM 18.00' FROM STA. 107+19.90 TO STA. 22.00' AT STA. 107+95.50  
 22.00' FROM STA. 107+95.50 TO STA. 109+28.52  
 TRANSITIONS FROM 22.00' AT STA. 109+28.52 TO 16.00' AT STA. 109+45.00  
 16.00' FROM STA. 109+45.00 TO STA. 109+80.00  
 TRANSITIONS FROM 16.00' AT STA. 109+80.00 TO 20.00' AT STA. 109+95.00  
 20.00' FROM STA. 109+95.00 TO STA. 113+78.00  
 TRANSITIONS FROM 20.00' AT STA. 113+78.00 TO 32.67' AT STA. 114+00.81

TRANSITIONS FROM 35.12' AT STA. 120+13.31 TO 22.00' AT STA. 120+25.17  
 22.00' FROM STA. 120+25.17 TO STA. 120+75.70  
 TRANSITIONS FROM 22.00' AT STA. 120+75.70 TO 34.00' AT STA. 125+83.88  
 34.00' FROM STA. 125+83.88 TO STA. 127+64.76

[B] 3:1 MAX SLOPE FROM STA. 106+10.00 TO STA. 111+25.00

△ SIDEWALK CROSS SLOPE VARIES AS DETAILED BELOW

SIDEWALK SLOPES @ 0.015 AWAY FROM ROADWAY BETWEEN:

102+96.96 TO 112+75.00

SIDEWALK SLOPES @ 0.015 TOWARD ROADWAY BETWEEN:

112+75.00 TO 114+00.81  
120+13.31 TO 127+64.76

NOTE:  
WHERE SIDEWALK CROSS SLOPE TRANSITIONS, TRANSITION LENGTH SHALL BE AT A RATE OF 5' FOR EVERY 1% OF GRADE CHANGE.

LEGEND (ALL TYPICAL SHEETS)

- Ⓐ - EXISTING ASPHALT CONCRETE
- Ⓑ - EXISTING AGGREGATE BASE MATERIAL
- ① - ITEM 608 - 5" CONCRETE WALK
- ② - ITEM 411 - 3" STABILIZED CRUSHED AGGREGATE
- ③ - ITEM 659 - SEEDING AND MULCHING, CLASS 1

ABBREVIATION LEGEND (ALL PLAN SHEETS)

- (ATG) - ADJUST TO GRADE DO
- (DND) - DO NOT DISTURB
- (RTG) - RECONSTRUCT TO GRADE
- (R&R) - REMOVE AND REPLACE
- (TBR) - TO BE REMOVED
- (TBR/LBO) - TO BE RELOCATED BY OTHERS

SYMBOLS LEGEND (ALL PLAN SHEETS)

- CATCHBASIN (ATG)
- ⊕ WATER SERVICE VALVE (ATG)
- ✕ TREE REMOVAL
- CONST. LIMITS

HATCH LEGEND FOR PLANS

ITEM 253 PAVEMENT REPAIR, AS PER PLAN

- ITEM 441 - 1.5" ASPHALT CONCRETE SURFACE COURSE, TYPE 1, (449), PG64-22
- ITEM 407 - NON-TRACKING TACK COAT (APPLIED @ 0.060 GAL/SY)
- ITEM 441 - 1.5" ASPHALT CONCRETE INTERMEDIATE COURSE, TYPE 1 (449)
- ITEM 407 - NON-TRACKING TACK COAT (APPLIED @ 0.060 GAL/SY)
- ITEM 301 - 9" ASPHALT CONCRETE BASE, PG64-22 (449) (2 EQUAL LIFTS) (PROVIDE 0.06 GAL/SY TACK COAT APPLICATION BETWEEN LIFTS)
- ITEM 304 - 6" AGGREGATE BASE
- ITEM 204 - SUBGRADE COMPACTION

RESIDENTIAL ASPHALT DRIVEWAYS

- ITEM 441 - 1.25" ASPHALT CONCRETE SURFACE COURSE, TYPE 1, (449), PG64-22 (DRIVEWAYS)
- ITEM 407 - NON-TRACKING TACK COAT (0.06 GAL/SY)
- ITEM 441 - 2.75" ASPHALT CONCRETE INTERMEDIATE COURSE, TYPE 1, (449) (DRIVEWAYS)
- ITEM 304 - 8" AGGREGATE BASE

COMMERCIAL ASPHALT DRIVEWAYS

- ITEM 441 - 1.25" ASPHALT CONCRETE SURFACE COURSE, TYPE 1, (449), PG64-22 (DRIVEWAYS)
- ITEM 407 - NON-TRACKING TACK COAT (0.06 GAL/SY)
- ITEM 441 - 2.75" ASPHALT CONCRETE INTERMEDIATE COURSE, TYPE 1, (449) (DRIVEWAYS)
- ITEM 407 - NON-TRACKING TACK COAT (0.06 GAL/SY)
- ITEM 301 - 4" ASPHALT CONCRETE BASE, PG64-22 (499)
- ITEM 304 - 6" AGGREGATE BASE

RESIDENTIAL CONCRETE DRIVEWAYS

- ITEM 452 - 7" NON-REINFORCED CONCRETE PAVEMENT, CLASS QC 1P
- ITEM 411 - 3" STABILIZED CRUSHED AGGREGATE

COMMERCIAL CONCRETE DRIVEWAYS

- ITEM 452 - 8" NON-REINFORCED CONCRETE PAVEMENT, CLASS QC 1P
- ITEM 411 - 3" STABILIZED CRUSHED AGGREGATE

WALK REMOVED OR PAVEMENT REMOVED AND RE-SEEDED

- ITEM 202 - PAVEMENT/WALK REMOVED
- ITEM 659 - SEEDING AND MULCHING, CLASS 1
- ITEM 653 - TOPSOIL FURNISHED AND PLACED, 12"

CURB RAMP

- ITEM 608 - CURB RAMP
- ITEM 411 - 3" STABILIZED CRUSHED AGGREGATE

SIDEWALK

- ITEM 608 - 5" CONCRETE WALK
- ITEM 411 - 3" STABILIZED CRUSHED AGGREGATE

Add Item 204 subgrade compaction for sidewalks.

△△ SIDEWALK CROSS SLOPE VARIES AS DETAILED BELOW


SIDEWALK SLOPES @ 0.015 AWAY FROM ROADWAY BETWEEN:

106+90.07 TO 108+80.00  
122+80.00 TO 131+30.00


SIDEWALK SLOPES @ 0.015 TOWARD ROADWAY BETWEEN:

108+80.00 TO 114+29.86  
120+57.49 TO 122+80.00  
131+30.00 TO 132+36.68

NOTE:  
WHERE SIDEWALK CROSS SLOPE TRANSITIONS, TRANSITION LENGTH SHALL BE AT A RATE OF 5' FOR EVERY 1% OF GRADE CHANGE.

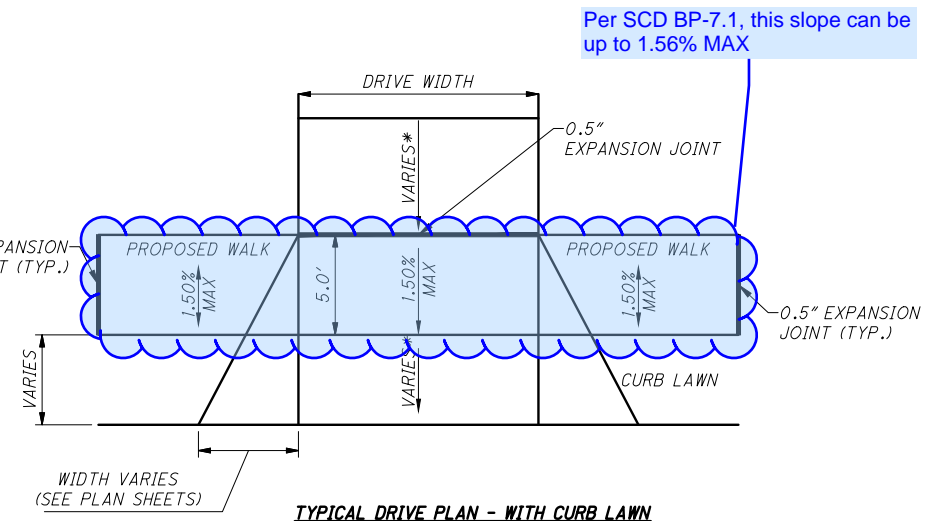

Per SCD BP-7.1, this slope can be up to 1.56% MAX

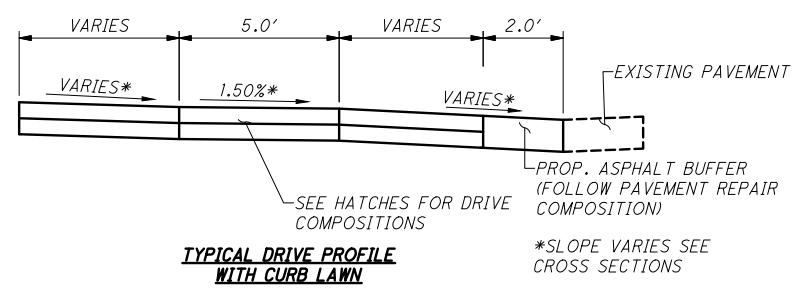

HAM CR 96 3.92-SIDEWALK

Z:\project\Hamilton\Colerain\Township\HAM-COL-2301SpringdaleRoadSidewalkPhase2\120861\_GN002.dwg 17-Jul-25 1:45 PM

**UTILITIES**

LISTED BELOW ARE ALL UTILITIES LOCATED WITHIN THE PROJECT CONSTRUCTION LIMITS TOGETHER WITH THEIR RESPECTIVE OWNERS:

**WATER**  
GREATER CINCINNATI WATER WORKS  
4747 SPRING GROVE AVE.  
CINCINNATI, OH 45232  
ATTN: EARL BRATFISH  
(513) 591-6533  
ATTN: DANIEL LOUIS  
(513) 352-3723

**COMMUNICATION**  
MCI  
5400 DUFF ROAD  
CINCINNATI, OH 45129  
ATTN: STEPHEN HOWELL  
(614) 816-0361

**SANITARY SEWER**  
MSD  
1600 GEST ST.  
CINCINNATI, OH 45204  
ATTN: ROB FRANKLIN  
(513) 557-7188

**STREETS, STORM SEWER, & TRAFFIC SIGNALS**  
HAMILTON CO. ENGINEER  
223 W. GALBRAITH ROAD  
CINCINNATI, OH 45215  
ATTN: DAN JONES (STORM & STREETS)  
(513) 946-8432  
ATTN: TOM SPILLE (TRAFFIC SIGNALS)  
(513) 946-8412

**GAS**  
DUKE ENERGY  
139 E. FOURTH ST.  
P.O. BOX 960, RM 460A  
CINCINNATI, OH 45202  
ANDY MCNICHOLS  
(513) 384-4731  
ATTN: MARK BRANSCUM  
(513) 287-2517

**COMMUNICATION**  
CHARTER  
10920 KENWOOD ROAD  
CINCINNATI, OH 45242  
ATTN: TODD VANVRAKEN  
(513) 386-5958

**PIPELINE**  
BP PIPELINES (NORTH AMERICA) INC.  
30 S. WACKER DRIVE  
SUITE 900  
CHICAGO, IL 60606  
ATTN: KEITH BOYLE  
(312) 809-4708

**COMMUNICATION**  
ALTAFIBER  
221 E. FOURTH ST.  
BUILDING 121-900  
CINCINNATI, OH 45202  
ATTN: BRECK COWAN  
(513) 565-7187

ODOT DISTRICT 8  
505 S. STATE ROUTE 741  
ATTN: TOM MAZZA  
(513) 933-6591

**ELECTRIC**  
DUKE ENERGY  
2010 DANA AVENUE  
ROOM EF 324  
CINCINNATI, OH 45207  
ATTN: MIKE CROSSLAND  
(513) 882-2994

OHIO UTILITIES  
PROTECTION SERVICE 2  
WORKING DAYS BEFORE YOU  
DIG CALL TOLL FREE  
800-362-2764

THE LOCATION OF THE UNDERGROUND UTILITIES SHOWN ON THE PLANS ARE AS OBTAINED FROM THE OWNERS AS REQUIRED BY SECTION 153.64 O.R.C.

EXISTING UTILITIES ARE SHOWN IN THEIR APPROXIMATE LOCATION ACCORDING TO THE BEST AVAILABLE DATA. THE CONTRACTOR WILL BE RESPONSIBLE FOR LOCATING THEM IN THE FIELD PRIOR TO CONSTRUCTION AND WILL BE RESPONSIBLE FOR ANY DAMAGE DONE TO THEM. CONTRACTOR TO CONTACT OHIO UTILITIES PROTECTION SERVICE AT 1-800-362-2764 AT LEAST 48 HOURS PRIOR TO CONSTRUCTION. NON-MEMBERS MUST BE CALLED DIRECTLY.

**WORK LIMITS**

THE WORK LIMITS SHOWN ON THESE PLANS ARE FOR PHYSICAL CONSTRUCTION ONLY. PROVIDE THE INSTALLATION AND OPERATION OF ALL WORK ZONE TRAFFIC CONTROL AND WORK ZONE TRAFFIC CONTROL DEVICES REQUIRED BY THESE PLANS WHETHER INSIDE OR OUTSIDE THESE WORK LIMITS.

**CONSTRUCTION NOISE**

IN ORDER TO MINIMIZE ANY ADVERSE CONSTRUCTION NOISE IMPACTS, ANY POWER-OPERATED CONSTRUCTION-TYPE DEVICES SHALL NOT BE OPERATED BETWEEN THE HOURS SPECIFIED IN THE LOCAL NOISE ORDINANCES. IF THERE IS NO NOISE ORDINANCE IN PLACE, POWER-OPERATED CONSTRUCTION-TYPE DEVICES SHALL NOT BE OPERATED BETWEEN THE HOURS TO 7:00 PM TO 7:00 AM.

**MUD AND DEBRIS**

THE TRACKING OR SPILLING OF MUD, DIRT OF DEBRIS UPON PUBLIC STREETS IS PROHIBITED AND ANY SUCH OCCURRENCE SHALL BE CLEANED UP IMMEDIATELY BY THE CONTRACTOR.

**SUBCONTRACTOR SUPERVISION**

THE CONTRACTOR IS REQUIRED TO HAVE A PROJECT SUPERVISOR ON-SITE TO SUPERVISE THE SUBCONTRACTOR FOR QUALITY CONTROL PURPOSES AND TO PROVIDE ANY NECESSARY ASSISTANCE TO THE SUBCONTRACTOR TO ENSURE QUALITY WORK.

COST OF THIS ITEM SHALL BE INCLUDED IN THE COST OF RELATED PAY ITEMS OF THIS PROJECT.

**CONTROL OF SPILLS**

BEST CONSTRUCTION PRACTICES ARE TO BE IMPLEMENTED TO MINIMIZE WATER QUALITY IMPACTS. IDLE EQUIPMENT, PETROCHEMICALS, AND TOXIC/HAZARDOUS MATERIALS SHALL NOT BE STORED NEAR DRAINAGE WAYS, DITCHES, OR STREAMS. REFUELING SHALL NOT BE UNDERTAKEN NEAR DRAINAGE WAYS, DITCHES, OR STREAMS. A SPILL CONTAINMENT KIT IS TO BE MAINTAINED ONSITE THROUGHOUT CONSTRUCTION ACTIVITIES. SPILLS OF FUELS, OILS, CHEMICALS, OR OTHER MATERIALS WHICH COULD POSE A THREAT TO GROUNDWATER SHALL BE CLEANED UP IMMEDIATELY. IF THE SPILL IS A REPORTABLE AMOUNT, THE LOCAL FIRE DEPARTMENT IS TO BE CONTACTED.

**NON-RUBBER TIRE VEHICLES**

NO NON-RUBBER TIRE VEHICLES SHALL BE MOVED ON TOWNSHIP OR COUNTY STREETS. EXCEPTIONS MAY BE GRANTED BY THE TOWNSHIP WHERE SHORT DISTANCES AND SPECIAL CIRCUMSTANCES ARE INVOLVED. GRANTING OF EXCEPTIONS MUST BE IN WRITING AND ANY RESULTING DAMAGE MUST BE REPAIRED TO THE SATISFACTION OF THE ENGINEER. THE CONTRACTOR SHALL USE EXTREME CARE WHEN OPERATING NON-RUBBER TIRE VEHICLES ON STREETS OR DRIVEWAYS TO AVOID MARKING OR DAMAGING THE PAVEMENT. PROTECTION OF THE PAVEMENT FROM DAMAGE RESULTING FROM THE TRACTS OF NON-RUBBER TIRE VEHICLES UTILIZED IN TRENCH EXCAVATION SHALL BE REQUIRED. A WOOD PLANK SYSTEM, USED TIRES, RUBBER MATS, OR OTHER MEANS AS APPROVED BY THE ENGINEER SHALL BE USED TO PROTECT THE PAVEMENT. THE COST OF THIS WORK SHALL BE INCLUDED IN THE UNIT PRICE BID FOR THE VARIOUS ITEMS OF THE CONTRACT.

**PROTECTION OF RIGHT-OF-WAY LANDSCAPING**

IN ADDITION TO ODOT SPECIFICATION 107.10, PRIOR TO BEGINNING WORK, THE CONTRACTOR, THE PROJECT ENGINEER, AND A REPRESENTATIVE OF THE TOWNSHIP OF COLERAIN WILL REVIEW AND RECORD ALL LANDSCAPING ITEMS WITHIN THE RIGHT-OF-WAY (BOTH WITHIN AND OUTSIDE THE CONSTRUCTION LIMITS). A RECORD OF THIS REVIEW WILL BE KEPT IN THE PROJECT ENGINEER'S FILES. PRIOR TO FINAL ACCEPTANCE, A FINAL REVIEW OF LANDSCAPING ITEMS WILL BE MADE.

CONSTRUCT ALL ACTIVITIES, EQUIPMENT STORAGE, AND STAGING TO WITHIN THE CONSTRUCTION LIMITS. THE CONSTRUCTION LIMITS ARE IDENTIFIED IN THE PLANS.

SUBMIT A WRITTEN REQUEST TO THE ENGINEER TO USE ANY AREA OUTSIDE THESE LIMITS. THE DOCUMENT SUBMITTED MUST CLEARLY IDENTIFY THE AREA AND EXPLAIN THE PROPOSED USE AND RESTORATION OF THE AREA. USE OF THESE AREAS FOR DISPOSAL OF WASTE MATERIAL AND CONSTRUCTION DEBRIS, EXCAVATION OF BORROW MATERIAL AND PLACEMENT OF PORTABLE PLANTS IS PROHIBITED. THE REQUEST MUST BE APPROVED, IN WRITING, BEFORE THE CONTRACTOR HAS PERMISSION TO USE THE AREA.

ANY ITEMS DAMAGED BEYOND THE CONSTRUCTION LIMITS, AS DEFINED ABOVE, WILL BE REPLACED IN KIND OR AS APPROVED BY THE PROJECT ENGINEER.

Just state that the project will comply with all local noise ordinances.

**SURVEY PARAMETERS**

PRIMARY PROJECT CONTROL MONUMENTS GOVERN ALL POSITIONING ON ODOT PROJECTS. SEE SHEET 2 OF THE PLANS FOR A TABLE CONTAINING PROJECT CONTROL INFORMATION.

USE THE FOLLOWING PROJECT CONTROL, VERTICAL POSITIONING, AND HORIZONTAL POSITIONING PARAMETERS FOR ALL SURVEYING:

PROJECT CONTROL

POSITIONING METHOD: ODOT VRS  
MONUMENT TYPE: IRON PIN

VERTICAL POSITIONING

ORTHOMETRIC HEIGHT DATUM: NAVD88  
GEOID: GEOID 18

HORIZONTAL POSITIONING

REFERENCE NAME: NAD83 (CORS2011 ADJUSTMENT)  
ELLIPSOID: GRS 80  
MAP PROJECTION: LAMBERT CONFORMAL CONIC  
COORDINATE SYSTEM: OHIO STATE PLANE SOUTH  
COMBINED SCALE FACTOR: 1.0000983555907  
ORIGIN OF COORDINATE SYSTEM: 460511.3860, 1370406.1840

USE THE POSITIONING METHODS AND MONUMENT TYPE USED IN THE ORIGINAL SURVEY TO RESTORE ALL MONUMENTS RELATED TO PRIMARY PROJECT CONTROL THAT ARE DAMAGED OR DESTROYED BY CONSTRUCTION ACTIVITIES. RESTORE DAMAGED OR DESTROYED MONUMENTS IN ACCORDANCE WITH CMS 623.

UNITS ARE U.S. SURVEY FEET.

HORIZONTAL CONTROL

Point #	Northing	Easting	Elevation	Type
100	460511.3860	1370406.1840	888.88	IRON PIN
101	459809.6750	1370093.1020	895.18	MAG NAIL
102	458954.8540	1369879.4070	911.50	IRON PIN
104	460516.9210	1370712.8060	876.04	CUT CROSS

VERTICAL CONTROL

Point #	Northing	Easting	Elevation	Type
BM #1	460332.7560	1371192.1240	860.01	MAG NAIL IN POLE
BM #2	460497.9110	1370388.8120	890.58	FH BOLT TIP ARROW
BM #3	459778.6090	1370091.1560	896.80	FH BOLT TIP ARROW
BM #4	458636.0300	1369491.7540	916.62	MAG NAIL IN POLE

**SEEDING AND MULCHING**

THE FOLLOWING QUANTITIES ARE PROVIDED TO PROMOTE GROWTH AND CARE OF PERMANENT SEEDED AREAS:

ITEM 659 - TOPSOIL	305 CU. YD.
ITEM 659 - SEEDING AND MULCHING, CLASS 1	2,750 SQ. YD.
ITEM 659 - REPAIR SEEDING AND MULCHING	137 SQ. YD.
ITEM 659 - INTER-SEEDING	137 SQ. YD.
ITEM 659 - COMMERCIAL FERTILIZER	0.37 TON
ITEM 659 - LIME	0.56 ACRE
ITEM 659 - WATER	15.22 M. GAL

SEEDING AND MULCHING SHALL BE APPLIED TO ALL AREAS OF EXPOSED SOIL BETWEEN THE RIGHT-OF-WAY LINES, AND WITHIN THE CONSTRUCTION LIMITS FOR AREAS OUTSIDE THE RIGHT-OF-WAY LINES COVERED BY WORK AGREEMENT OR SLOPE EASEMENT. QUANTITY CALCULATIONS FOR SEEDING AND MULCHING ARE BASED ON THESE LIMITS.

**CLEARING AND GRUBBING**

REMOVE ALL BRUSH, TREES AND STUMPS SPECIFICALLY MARKED FOR REMOVAL WITHIN THE CONSTRUCTION LIMITS UNDER THE LUMP SUM BID FOR ITEM 201, CLEARING AND GRUBBING. THE FOLLOWING IS AN APPROXIMATE ESTIMATE OF THE NUMBER OF TREES AND STUMPS LARGER THAN 8" TO BE REMOVED.

SIZES	NO. TREES	NO. STUMPS	TOTAL
8"	1	0	1
10"	1	0	1
12"	1	0	1
14"	2	0	2
16"	1	0	1
18"	5	0	5
48"	1	0	1

**CROSSINGS AND CONNECTIONS TO EXISTING PIPES AND UTILITIES**

WHERE PLANS PROVIDE FOR A PROPOSED CONDUIT TO BE CONNECTED TO, OR CROSS OVER OR UNDER AN EXISTING SEWER OR UNDERGROUND UTILITY, THE CONTRACTOR SHALL LOCATE THE EXISTING PIPES OR UTILITIES BOTH AS TO LINE AND GRADE BEFORE STARTING TO LAY THE PROPOSED CONDUIT.

IF IT IS DETERMINED THAT THE ELEVATION OF THE EXISTING CONDUIT, OR EXISTING APPURTENANCE TO BE CONNECTED, DIFFERS FROM THE PLAN ELEVATION, OR RESULTS IN A CHANGE IN THE PLAN CONDUIT SLOPE, THE ENGINEER SHALL BE NOTIFIED BEFORE STARTING CONSTRUCTION OF ANY PORTION OF THE PROPOSED CONDUIT WHICH WILL BE AFFECTED BY THE VARIANCE IN THE EXISTING ELEVATIONS.

IF IT IS DETERMINED THAT THE PROPOSED CONDUIT WILL INTERSECT ANY EXISTING SEWER OR UNDERGROUND UTILITY IF CONSTRUCTED AS SHOWN ON THE PLAN, THE ENGINEER SHALL BE NOTIFIED BEFORE STARTING CONSTRUCTION OF ANY PORTION OF THE PROPOSED CONDUIT WHICH WOULD BE AFFECTED BY THE INTERFERENCE WITH AN EXISTING FACILITY.

PAYMENT FOR ALL THE OPERATIONS DESCRIBED ABOVE SHALL BE INCLUDED IN THE CONTRACT PRICE FOR THE PERTINENT 611 CONDUIT ITEM.

**REVIEW OF DRAINAGE FACILITIES**

BEFORE ANY WORK IS STARTED ON THE PROJECT AND AGAIN BEFORE FINAL ACCEPTANCE BY THE STATE, REPRESENTATIVES OF THE STATE AND THE CONTRACTOR, ALONG WITH LOCAL REPRESENTATIVES, SHALL MAKE AN INSPECTION OF ALL EXISTING SEWERS WHICH ARE TO REMAIN IN SERVICE AND WHICH MAY BE AFFECTED BY THE WORK. THE CONDITION OF THE EXISTING CONDUITS AND THEIR APPURTENANCE SHALL BE DETERMINED FROM FIELD OBSERVATIONS. RECORDS OF THE INSPECTION SHALL BE KEPT IN WRITING BY THE STATE.

ALL NEW CONDUITS, INLETS, CATCH BASINS, AND MANHOLES CONSTRUCTED AS A PART OF THE PROJECT SHALL BE FREE OF ALL FOREIGN MATTER AND IN A CLEAN CONDITION BEFORE THE PROJECT WILL BE ACCEPTED BY THE STATE.

ALL EXISTING SEWERS INSPECTED INITIALLY BY THE ABOVE MENTIONED PARTIES SHALL BE MAINTAINED AND LEFT IN A CONDITION REASONABLY COMPARABLE TO THAT DETERMINED BY THE ORIGINAL INSPECTION. ANY CHANGE IN THE CONDITION RESULTING FROM THE CONTRACTOR'S OPERATIONS SHALL BE CORRECTED BY THE CONTRACTOR TO THE SATISFACTION OF THE ENGINEER.

PAYMENT FOR ALL OPERATIONS DESCRIBED ABOVE SHALL BE INCLUDED IN THE CONTRACT PRICE FOR THE PERTINENT 611 CONDUIT ITEMS.

GENERAL NOTES

DESIGN AGENCY



CHOICE ONE ENGINEERING

DESIGNER

IJW

REVIEWER

BAW 7-23-2025

PROJECT ID

120861

SHEET

P.4

TOTAL

53

**CLEAN WATER CONNECTIONS**

ROOF DRAINS, FOUNDATION DRAINS, AND ALL OTHER CLEAN WATER CONNECTIONS TO THE SANITARY SYSTEM ARE PROHIBITED.

**FUTURE MAINTENANCE OF PROPOSED ITEMS:**

ALL PROPOSED DRAINAGE STRUCTURES AND CONVEYANCES SHOWN ON THESE PLANS ARE NOT ACCEPTED BY THE BOARD OF COUNTY COMMISSIONERS OF HAMILTON COUNTY, AND THE COUNTY OF HAMILTON IS NOT RESPONSIBLE TO MAINTAIN, REPAIR OR REPLACE ANY PROPOSED DRAINAGE STRUCTURES AND CONVEYANCES SHOWN ON THESE PLANS. EXCEPT HEREIN MODIFIED WHEN THE DRAINAGE STRUCTURES AND CONVEYANCES CROSS UNDERNEATH COUNTY ROADWAY.

ALL PROPOSED SIDEWALK AND CURB RAMPS SHOWN ON THESE PLANS ARE NOT ACCEPTED BY THE BOARD OF COUNTY COMMISSIONERS OF HAMILTON COUNTY, AND THE COUNTY OF HAMILTON IS NOT RESPONSIBLE TO MAINTAIN, REPAIR OR REPLACE ANY PROPOSED SIDEWALK SHOWN ON THESE PLANS.

ALL PROPOSED CURB AND CURB INLETS SHOWN ON THESE PLANS ARE NOT ACCEPTED BY THE BOARD OF COUNTY COMMISSIONERS OF HAMILTON COUNTY, AND THE COUNTY OF HAMILTON IS NOT RESPONSIBLE TO MAINTAIN, REPAIR OR REPLACE ANY PROPOSED DRAINAGE STRUCTURES AND CONVEYANCES SHOWN ON THESE PLANS.

**ITEM 253 - PAVEMENT REPAIR, AS PER PLAN**

THIS ITEM OF WORK WILL SHALL CONSIST OF THE REMOVAL OF THE EXISTING ASPHALT AND AGGREGATE AND THE INSTALLATION OF THE NEW AGGREGATE AND ASPHALT PAVEMENT. THE NEW PAVEMENT AND AGGREGATE SHALL FOLLOW THE DETAIL AND PAVEMENT COMPOSITION FOUND ON SHEET 3 OF THESE PLANS. ANY PAVEMENT MARKINGS THAT ARE DISTURBED DURING THIS REPLACEMENT SHALL BE REPLACED IN-KIND WITH ITEM 642 PAINT AND INCIDENTAL TO ITEM 253, PAVEMENT REPAIR, AS PER PLAN.

PAYMENT FOR ITEM 253, PAVEMENT REPAIR, AS PER PLAN FOR ALL OPERATIONS DESCRIBED ABOVE SHALL BE AT THE CONTRACT CUBIC YARD BID PRICE.

**ITEM 630 SIGNING, MISC.: SOLAR-POWERED RECTANGULAR RAPID FLASHING BEACON (RRFB) SIGN ASSEMBLY**

THIS THIS WORK SHALL CONSIST OF FURNISHING AND INSTALLING A SOLAR POWERED RECTANGULAR RAPID FLASHING BEACON (RRFB) SIGN ASSEMBLY. THE FLASHING UNIT SHALL BE SOLAR POWERED, PEDESTRIAN ACTIVATED, AND 2-SIDED WITH TWO LED ARRAY BASED YELLOW INDICATIONS ON EACH SIDE. MULTIPLE UNITS SHALL BE WIRELESSLY CONTROLLED AND SYNCHRONIZED. THE UNIT SHALL BE COMPLIANT WITH THE MOST CURRENT OHIO MANUAL OF UNIFORM TRAFFIC CONTROL DEVICES (OMUTCD) AND FHWA INTERIM APPROVAL FOR RRFBs (1A-21).

**GENERAL REQUIREMENTS -**

EACH RRFB SHALL CONSIST OF TWO RAPIDLY FLASHED RECTANGULAR-SHAPED YELLOW INDICATIONS HAVING LED ARRAY BASED LIGHT SOURCE.

EACH RRFB SHALL BE A COMPLETE ASSEMBLY, CONSISTING OF BUT NOT LIMITED TO, SIGNAGE, SIGN MOUNTING HARDWARE, INDICATIONS AND ELECTRICAL COMPONENTS (WIRING, SOLID-STATE CIRCUIT BOARDS, ETC.).

EACH RRFB SHALL CONTAIN A PEDESTRIAN INDICATION LIGHT VISIBLE BY THE PEDESTRIAN IN THE DIRECTION OF TRAVEL.

**ITEM 630 SIGNING, MISC.: RECTANGULAR RAPID FLASHING BEACON (RRFB) SIGN ASSEMBLY (CONT'D)**

This language should go into a maintenance agreement between County and Township. It is not of the contractors concern to build the project

EACH RRFB SHALL UTILIZE SOLAR POWER.

EACH RRFB SHALL BE ACTIVATED BY ADA COMPLIANT PUSHBUTTONS.

THE RRFB SHALL BE NORMALLY DARK, SHALL INITIATE OPERATION ONLY UPON PEDESTRIAN ACTUATION, AND SHALL CEASE OPERATION AFTER A PREDETERMINED TIME LIMIT (BASED ON OMUTCD PROCEDURES).

EACH REMOTE RRFB SHALL BE WIRELESSLY ACTIVATED.

ALL RRFB LIGHT INDICATIONS SHALL BE WIRELESSLY SYNCHRONIZED (ALL LIGHTS WILL TURN ON WITHIN 120 MSEC AND REMAIN SYNCHRONIZED THROUGHOUT THE DURATION OF THE FLASHING CYCLE).

THE UNIT SHALL BE CAPABLE OF RUNNING 14 DAYS WITHOUT SUNLIGHT.

MATERIALS -  
FURNISH A COMPLETE ASSEMBLY, CONSISTING OF BUT NOT LIMITED TO, SIGNAGE, SIGN MOUNTING HARDWARE, INDICATIONS, AND ELECTRICAL COMPONENTS (WIRING, SOLID-STATE CIRCUIT BOARDS, ETC.). THE RRFB ASSEMBLY INCLUDES THE FOLLOWING ITEMS:

- 1. RRFB INDICATIONS
  - a. EACH RRFB INDICATION LENS SHALL BE A MINIMUM SIZE OF APPROXIMATELY 5" WIDE X 2" HIGH.
  - b. THE RRFB INDICATIONS SHALL BE ALIGNED HORIZONTALLY, WITH THE LONGER DIMENSION OF THE INDICATION HORIZONTAL. THERE SHALL BE TWO INDICATIONS ON THE FRONT AND TWO INDICATIONS ON THE BACK.
  - c. EACH RRFB SHALL BE SUPPLIED WITH ALL REQUIRED HARDWARE TO INSTALL ASSEMBLY. ALL EXPOSED HARDWARE SHALL BE ANTI-VANDAL.
  - d. EACH RRFB SHALL BE LOCATED BETWEEN THE BOTTOM OF THE CROSSING WARNING SIGN AND THE TOP OF THE SUPPLEMENTAL DOWNWARD DIAGONAL ARROW PLAQUE.
  - e. THE LIGHT INTENSITY OF THE YELLOW INDICATIONS SHALL MEET THE MINIMUM CLASS 1 SPECIFICATIONS OF SOCIETY OF AUTOMOTIVE ENGINEERS (SAE) STANDARD J595 (DIRECTIONAL FLASHING OPTICAL WARNING DEVICES FOR AUTHORIZED EMERGENCY, MAINTENANCE, AND SERVICE VEHICLES) DATED JANUARY, 2005.
  - f. TO MINIMIZE EXCESSIVE GLARE DURING NIGHTTIME CONDITIONS, AN AUTOMATIC SIGNAL DIMMING DEVICE SHALL BE USED TO REDUCE THE BRILLIANCE OF THE RRFB INDICATIONS.
  - g. AN LED PEDESTRIAN CONFIRMATION LIGHT DIRECTED AT AND VISIBLE TO PEDESTRIANS IN THE CROSSWALK SHALL BE INSTALLED INTEGRAL TO THE RRFB OR PUSHBUTTON TO GIVE CONFIRMATION THAT THE RRFB IS IN OPERATION.
  - h. THE PEDESTRIAN CONFIRMATION LIGHT SHALL HAVE A MINIMUM AREA OF 0.5 SQUARE INCHES AND BE CONSPICUOUS TO PEDESTRIANS AT ALL DISTANCES FROM THE BEGINNING OF THE CONTROLLED CROSSWALK TO A POINT 10 FEET FROM THE END OF THE CONTROLLED CROSSWALK DURING BOTH DAY AND NIGHT.

**ITEM 630 SIGNING, MISC.: RECTANGULAR RAPID FLASHING BEACON (RRFB) SIGN ASSEMBLY (CONT'D)**

- 2. SIGNS
  - a. ALL SIGN ASSEMBLIES SHALL USE ANTI-VANDAL FASTENERS TO MOUNT COMPONENTS TO SIGN AND SIGN TO FIXTURE.
  - b. PEDESTRIAN PUSHBUTTONS SIGNS SHALL BE PROVIDED AND INCLUDE THE LEGEND "PUSH BUTTON TO TURN ON WARNING LIGHTS, WAIT FOR GAP IN TRAFFIC". SIGNS SHOULD BE MOUNTED ADJACENT TO OR INTEGRAL WITH EACH PEDESTRIAN PUSHBUTTON.
  - c. TWO SETS OF SIGNS SHALL BE REQUIRED PER UNIT FOR VIEW FROM EACH APPROACH.
  - d. ASSURE SIGN MEETS THE REQUIREMENTS OF C&MS 630.

- 3. CONTROL CIRCUIT
  - a. THE CONTROL CIRCUIT SHALL HAVE THE CAPABILITY OF INDEPENDENTLY FLASHING UP TO TWO INDEPENDENT OUTPUTS. THE LED LIGHT OUTPUTS AND FLASH PATTERN SHALL BE COMPLETELY PROGRAMMABLE.
  - b. THE CONTROL CIRCUIT SHALL BE SEALED WATERTIGHT TO ELIMINATE DIRT CONTAMINATION AND ALLOW FOR SAFE HANDLING IN ALL WEATHER CONDITIONS.
  - c. THE LEDS SHALL BE SEALED AGAINST DUST AND MOISTURE INTRUSION AS PER THE REQUIREMENTS OF NEMA STANDARD 250-1991 FOR TYPE 4 ENCLOSURE AND TO PROTECT ALL INTERNAL LED AND ELECTRICAL COMPONENTS.

- 4. BATTERY AND SOLAR PANELS
  - a. BATTERY UNIT SHALL BE A 12VDC, 35 AHR MINIMUM, SEALED GEL OR AGM LEAD ACID BATTERY. BATTERIES SHALL HAVE A WRITTEN TWO YEAR FULL REPLACEMENT WARRANTY.
  - b. THE SOLAR PANEL SHALL PROVIDE A MINIMUM OF 40 WATTS PEAK TOTAL OUTPUT.
  - c. THE SOLAR PANEL SHALL BE MOUNTED TO AN ALUMINUM PLATE AND BRACKET AT AN ANGLE OF 45 DEGREES- 60 DEGREES TO PROVIDE MAXIMUM OUTPUT.
  - d. ALL FASTENERS USED SHALL BE ANTI-VANDAL.

- 5. WIRELESS RADIO
  - a. RADIO CONTROL SHALL OPERATE ON A 900 MHZ FREQUENCY HOPPING SPREAD SPECTRUM NETWORK, WI-FI OR APPROVED EQUAL.
  - b. RADIO SHALL INTEGRATE COMMUNICATION OF RRFB CONTROL CIRCUIT TO ACTIVATE SIGN FROM PUSHBUTTON INPUT.
  - c. THE RADIO SHALL BE SYNCHRONIZED SO ALL OF THE REMOTE RRFB LIGHT INDICATIONS WILL TURN ON WITHIN 120 MSEC OF EACH OTHER AND REMAIN SYNCHRONIZED THROUGH-OUT THE DURATION OF THE FLASHING CYCLE.

- 6. PUSHBUTTON
  - a. THE PUSHBUTTON SHALL BE CAPABLE OF CONTINUOUS OPERATION OVER A TEMPERATURE RANGE OF -30 DEGREES F TO +165 DEGREES F.
  - b. PUSHBUTTON SHALL BE ADA COMPLIANT.

7. PEDESTAL SHAFT AND BASE - MOUNT ON A STANDARD 4.5-INCH OD ALUMINUM PEDESTAL POLE WITH BREAKAWAY BASE. A 14 FOOT POLE SHALL BE PROVIDED AND FIELD ADJUSTED AND CAPPED TO MAINTAIN THE PROPER SIGN MOUNTING HEIGHTS, UNLESS SPECIFIED OTHERWISE IN THE PLANS. POLE AND BASE MANUFACTURER SHALL BE LISTED ON ODOT'S QUALIFIED PRODUCTS LIST.

**CONSTRUCTION -**

THE RRFB SHALL BE ASSEMBLED AND CONSTRUCTED BY THE CONTRACTOR AS SHOWN AND SPECIFIED ON THE PLANS.

**WARRANTY -**

WARRANTY SHALL BE TWO YEARS FROM THE DATE OF FINAL ACCEPTANCE.

**ITEM 630 SIGNING, MISC.: RECTANGULAR RAPID FLASHING BEACON (RRFB) SIGN ASSEMBLY (CONT'D)**

**MEASUREMENT -**

THE DEPARTMENT WILL MEASURE THE ITEM COMPLETE IN PLACE, INCLUDING ALL MATERIALS, TESTING, LABOR AND SOFTWARE FOR A FULLY FUNCTIONAL UNIT.

**PAYMENT -**

PAYMENT WILL BE AT THE CONTRACT UNIT PRICE PER EACH FOR ITEM 630 "SIGNING MISC.: SOLAR POWERED RECTANGULAR RAPID FLASHING BEACON (RRFB) SIGN ASSEMBLY".

**ITEM SPECIAL - MAILBOX AND SUPPORT SYSTEM, SINGLE**

FOR MAILBOXES CALLED OUT TO BE REMOVED AND REPLACED THE CONTRACTOR SHALL REMOVE EXISTING MAILBOXES AND SUPPORTS, AND FURNISH AND INSTALL NEW MAILBOXES AND SUPPORTS. ALL MAILBOXES AND SUPPORTS SHALL BE PLACED IN THEIR EXISTING LOCATION ADJACENT TO THE ROADWAY.

THIS WORK SHALL CONSIST OF FURNISHING AND ERECTING MAILBOX SUPPORTS, ANY ASSOCIATED MOUNTING HARDWARE NECESSARY FOR THE APPROVED MAILBOX TYPE, AND ATTACHING A TOWNSHIP APPROVED MAILBOX AT LOCATIONS SPECIFIED IN THE PLAN, OR OTHERWISE ESTABLISHED BY THE ENGINEER.

MAILBOXES SHALL BE BLACK, DOUBLE SIDED MAILBOXES AND THE MAILBOX MAKE/MODEL SHALL BE APPROVED BY THE TOWNSHIP PRIOR TO THE CONTRACTOR ORDERING MATERIALS.

WOOD POSTS SHALL BE NOMINAL 4 INCHES BY 4 INCHES SQUARE OR 4.5 INCHES DIAMETER ROUND, AND CONFORM TO 710.14.

STEEL POSTS SHAL BE NOMINAL PIPE SIZE 2 INCHES I.D., AND CONFORM TO AASHTO M 181.

ALL HARDWARE INCLUDING BUT NOT LIMITED TO PLATES, SCREWS, BOLTS, AND ETC. SHALL BE COMMERCIAL-GRADE GALVANIZED STEEL.

POSTS SHALL BE SET PER THE FIRST PARAGRAPH OF 606.03, AND SHALL IN NO INSTANCE BE ENCASED IN CONCRETE.


SUPPORT HARDWARE SHALL ACCOMMODATE EITHER A SINGLE OR A DOUBLE MAILBOX INSTALLATION, AND NO MORE THAN TWO BOXES MAY BE MOUNTED ON A SINGLE POST.

THE MAILBOX SHALL BE SECURELY AND NEATLY ATTACHED BY THE CONTRACTOR TO THE NEW SUPPORT. THE CONTRACTOR SHALL FURNISH ALL NECESSARY ATTACHMENT HARDWARE (NUTS, BOLTS, PLATES, SPACERS, AND WASHERS) AS NECESSARY TO ACCOMMODATE THE COMPLETE INSTALLATION.

THE CONTRACTOR SHALL BE RESPONSIBLE FOR COORDINATING WITH THE LOCAL POST MASTER REGARDING THE TIMING OF THE MOVEMENT OF ANY MAILBOX TO A NEW LOCATION.

PAYMENT UNDER THIS ITEM SHALL BE LIMITED TO FINAL PERMANENT INSTALLATIONS, TEMPORARY INSTALLATIONS AND THE REMOVAL OF THE EXISTING MAILBOX AND SUPPORT SHALL BE INCIDENTAL TO ITEM SPECIAL MAILBOX SUPPORT SYSTEM, (SINGLE). HOWEVER, THE SAME MATERIAL AND SIZE LIMITATIONS AS FOR PERMANENT INSTALLATIONS SHALL APPLY.

MAILBOX SUPPORTS, COMPLETE IN PLACE, WILL BE PAID FOR AT THE CONTRACT UNIT PRICE PER EACH, FOR ITEM SPECIAL MAILBOX SUPPORT SYSTEM, (SINGLE).

DESIGN AGENCY

CHOICE ONE ENGINEERING
DESIGNER
IJW
REVIEWER
BAW 7-23-2025
PROJECT ID
120861
SHEET TOTAL
P.5 53

**ITEM SPECIAL - PIPE CLEANOUT, 24" AND UNDER**

THIS WORK CONSISTS OF REMOVING SEDIMENT AND DEBRIS FROM THE EXISTING DRAINAGE CONDUITS SPECIFIED IN THE PLANS. DISPOSE OF ALL MATERIAL PER 105.16 AND 105.17. CLEAN OUT TO THE APPROVAL OF THE ENGINEER.

CLEANOUT THE PIPE IS PAID FOR AT THE UNIT PRICE PER LINEAR FOOT FOR ITEM SPECIAL, PIPE CLEANOUT. THIS PRICE INCLUDES THE COST FOR MATERIAL, EQUIPMENT, LABOR, AND ALL INCIDENTALS REQUIRED TO COMPLETE THE CLEANOUT.

**ITEM SPECIAL - CONSULTANT FOR CONCRETE QUALITY CONTROL INCLUDING TESTING AND INSPECTION**

ALL CONCRETE SHALL BE TESTED. ALL TESTING, INSPECTION AND QUALITY CONTROL FOR CONCRETE, NOT INCLUDED UNDER QC/QA PAY ITEMS, SHALL BE THE RESPONSIBILITY OF THE CONTRACTOR. THE CONTRACTOR SHALL PROVIDE A CONCRETE TESTING CONSULTANT WITH PREVIOUS EXPERIENCE AND FAMILIARITY IN ODOT PROCEDURES, CONCRETE TESTING REQUIREMENTS AND CONCRETE TESTING DOCUMENTATION. AT LEAST 30 DAYS PRIOR TO CONCRETE PLACEMENT, SUBMIT TO THE ENGINEER FOR APPROVAL, THE PROPOSED CONCRETE TESTING CONSULTANT ALONG WITH THE RESUMES OF THE PROPOSED TESTING PERSONNEL.

TESTING CONCRETE FOR STRUCTURES AND PORTLAND CEMENT CONCRETE PAVEMENT SHALL BE PERFORMED AS OUTLINED IN CMS SPECIFICATIONS 455 RESPECTIVELY.

THROUGH THE CONTRACTOR, THE CONSULTANT SHALL BE RESPONSIBLE FOR ENSURING THAT ALL CONCRETE PLACED IS IN ACCORDANCE WITH THE SPECIFICATIONS. SUCH WORK SHALL BE IN ACCORDANCE WITH THE APPLICABLE CONSTRUCTION AND MATERIAL SPECIFICATIONS AND THE ODOT CONSTRUCTION INSPECTION MANUAL OF PROCEDURES FOR CONCRETE. THE CONCRETE CONSULTANT SHALL PROVIDE THE NECESSARY TRAINED TECHNICIAN(S), ALL EQUIPMENT, AND SHALL FURNISH THE PROJECT ENGINEER WITH TWO (2) COPIES OF ALL TEST RESULTS WITHIN 24 HOURS AFTER COMPLETION OF CONCRETE PLACEMENT.

THE TECHNICIAN SHALL BE ACI LEVEL 1 CERTIFIED AND WILL BE REQUIRED TO DEMONSTRATE HIS/HER COMPETENCE AND EXPERIENCE LEVELS TO THE ENGINEER PRIOR TO BEGINNING WORK. THE ENGINEER WILL ORDER THE CONTRACTOR TO REPLACE ANY TECHNICIAN THAT IS NOT VERSED IN THE REQUIRED TESTING PROCEDURE.

THE TECHNICIAN SHALL VERBALLY NOTIFY THE ODOT PROJECT ENGINEER OF ANY FAILING TEST AND SHALL SUBMIT FOLLOW-UP WRITTEN NOTIFICATION TO THE PROJECT ENGINEER OF REMEDIAL ACTION(S) TAKEN. TESTS SHALL BE TAKEN AS SPECIFIED WITHIN THE CONSTRUCTION AND MATERIAL SPECIFICATIONS, CONCRETE MANUAL OR APPROPRIATE SUPPLEMENTAL SPECIFICATION AS LISTED IN THE PROPOSAL GOVERNING THE PROJECT. IT SHALL BE THE SOLE RESPONSIBILITY OF THE CONTRACTOR TO MAKE IMMEDIATE CORRECTIONS OR ADJUSTMENTS TO THE CONCRETE MIX VIA DIRECT COMMUNICATION WITH THE CONCRETE SUPPLIER'S PLANT PERSONNEL TO MAINTAIN UNINTERRUPTED COMPLIANCE WITH THE SPECIFICATIONS UPON NOTIFICATION OF CONCRETE MIX NON-COMPLIANCE BY THE CONSULTANT TECHNICIAN. THE PROJECT ENGINEER MAY REQUIRE MORE FREQUENT TESTING AS CONDITIONS WARRANT.

UPON COMPLETION OF DAILY CONCRETE PLACEMENT(S), THE CONCRETE CONSULTANT SHALL PROVIDE THE PROJECT ENGINEER WITH DAILY TEST REPORTS, TE-45'S, INSPECTORS DAILY REPORT AND SUPPORTING DOCUMENTATION FOR EACH ITEM OF CONCRETE WORK PERFORMED SEPARATED BY MIX DESIGN. SUBSEQUENTLY, UPON COMPLETION OF AN ENTIRE CONCRETE SPECIFICATION ITEM, THE CONCRETE CONSULTANT SHALL ALSO PROVIDE THE PROJECT ENGINEER WITH TWO (2) COPIES OF AN ADDITIONAL INSPECTION REPORT BY A REGISTERED PROFESSIONAL ENGINEER, STATE OF OHIO, WHICH CONTAINS THE TESTING-RESULTS SUMMARY FOR EACH ITEM BY CONTRACT REFERENCE NUMBER AND THE CONSULTANT'S CONCLUSIONS RELATIVE TO SPECIFICATION COMPLIANCE FOR ALL CONCRETE-TESTING WORK.

**ITEM SPECIAL - CONSULTANT FOR CONCRETE QUALITY CONTROL INCLUDING TESTING AND INSPECTION (CONTINUED)**

THE ODOT PROJECT ENGINEER RESERVES THE RIGHT TO MAKE UNANNOUNCED QUALITY-CONTROL TESTS TO VERIFY PROCEDURES USED AND RESULTS BEING OBTAINED BY THE CONTRACTOR.

THE CONCRETE TECHNICIAN SHALL WORK UNDER THE DIRECTION OF A REGISTERED PROFESSIONAL ENGINEER, STATE OF OHIO, WHO WILL MONITOR THE CONCRETE TEST RESULTS. THE FINAL INSPECTION REPORTS FOR EACH COMPLETED ITEM SHALL BE SIGNED BY A REGISTERED PROFESSIONAL ENGINEER, STATE OF OHIO, CERTIFYING THAT ALL CONCRETE TESTS PROVIDED BY THE CONTRACTOR MET APPLICABLE CONTRACT REQUIREMENTS. A FINAL REPORT ISSUED BY THE CONSULTING FIRM SHALL CONTAIN A CERTIFIED STATEMENT OF COMPLIANCE WITH ODOT SPECIFICATIONS AND ANY OTHER CONCLUSIONS REGARDING THE CONCRETE MATERIALS INCORPORATED INTO THE PROJECT. SUCH STATEMENT SHALL BE SIGNED BY A REGISTERED PROFESSIONAL ENGINEER, STATE OF OHIO. AND, THE CONCRETE CONSULTANT SHALL BE REQUIRED TO ATTEND MONTHLY PROGRESS MEETINGS AS REQUIRED BY THE PROJECT ENGINEER.

ADDITIONALLY, THE CONTRACTOR SHALL BE REQUIRED TO KEEP A POSTED LIST OF BEAM AND CYLINDER IDENTIFICATION NUMBERS FOR THE PURPOSE OF IDENTIFYING THE CORRESPONDING PLACEMENT LOCATION AND CONCRETE SPECIFICATION ITEM.

PAYMENT SHALL BE BID AS LUMP SUM FOR ITEM SPECIAL MISC.: CONSULTANT FOR CONCRETE QUALITY CONTROL INCLUDING TESTING AND INSPECTION. THE ITEM WILL BE PAID FOR AS FOLLOWS:

- UPON APPROVAL OF CONSULTANT . . . . . 20%
- PROGRESSIVE EQUIVALENT PAYMENTS . . . . . 50%
- UPON SUBMISSION OF FINAL REPORT . . . . . 30%.

THE TECHNICIAN SHALL HAVE THE FULL EFFECT AND AUTHORITY OF AN ODOT PROJECT INSPECTOR IN DETERMINING ACCEPTABILITY OF MATERIAL AND CONCRETE PLACEMENT PRACTICES.

Add the following plan notes and adjust as applicable to this project. Carry over to gensum as necessary

**ROUNDING**

THE ROUNDING AT SLOPE BREAKPOINTS SHOWN ON THE TYPICAL SECTIONS APPLIES TO ALL CROSS-SECTIONS, EVEN THOUGH OTHERWISE SHOWN.

**ITEM 204 - PROOF ROLLING**

THE FOLLOWING QUANTITY IS PROVIDED IN THE GENERAL SUMMARY TO ADDRESS LOCATIONS REQUIRING PROOF ROLLING. SEE PLAN SHEET NO. P.15 FOR ADDITIONAL INFORMATION.

ITEM 204 - PROOF ROLLING 2.0 HOUR.

**ITEM 204 - SUBGRADE COMPACTION AND PROOF ROLLING**

CONSTRUCT THE SUBGRADE AS FOLLOWS AND IN THE FOLLOWING SEQUENCE:

1. SHAPE THE SUBGRADE TO WITHIN 0.2 FEET OF THE PLAN SUBGRADE ELEVATION.
2. EXCAVATE AND REPLACE UNSUITABLE SUBGRADE BEFORE PROOF THE EXCAVATION LIMITS ARE SHOWN AND LABELED ON THE CROSS SECTIONS AS UNSUITABLE SUBGRADE. UNSUITABLE SUBGRADE INCLUDES UNSUITABLE SOIL (A-4B, A-2-5, A-5, A-7-5, AND SOIL WITH A LIQUID LIMIT GREATER THAN 65) AND ANY COAL, SHALE, OR ROCK WHICH NEEDS TO BE REMOVED ACCORDING TO SECTION OF THE CONSTRUCTION AND MATERIAL SPECIFICATIONS (C&MS).  
  
IF THERE IS UNSUITABLE SUBGRADE IN A SHALLOW FILL LOCATION, EXCAVATE AND REPLACE THE UNSUITABLE SUBGRADE BEFORE CONSTRUCTING THE SHALLOW FILL AND SHAPING THE SUBGRADE.
3. COMPACT THE SUBGRADE ACCORDING TO C&MS 204.03.
4. APPROXIMATE LIMITS FOR EXCAVATION OF UNSTABLE SUBGRADE ARE SHOWN AND LABELED ON THE CROSS SECTIONS AS UNSTABLE THE ENGINEER WILL IDENTIFY THE ACTUAL LIMITS OF EXCAVATION FOR UNSTABLE SUBGRADE BASED ON THE PROOF ROLLING RESULTS AND VISUAL OBSERVATIONS.  
  
PROOF ROLL THE COMPACTED SUBGRADE ACCORDING TO C&MS 204.06.
5. EXCAVATE UNSTABLE SUBGRADE AS DIRECTED BY THE ENGINEER AND STABILIZE BY REPLACING WITH THE SPECIFIED MATERIALS ACCORDING TO C&MS 204.07. EXCAVATIONS WILL EXTEND 18 INCHES BEYOND THE EDGE OF THE SURFACE OF THE PAVEMENT, PAVED SHOULDERS, OR PAVED MEDIANS.
6. PROOF ROLL THE STABILIZED AREAS ACCORDING TO C&MS 204.06 TO VERIFY STABILITY.
7. FINE GRADE THE SUBGRADE TO THE SPECIFIED GRADE.

THE QUANTITIES FOR EXCAVATING THE UNSUITABLE SUBGRADE AND UNSTABLE SUBGRADE ARE BOTH PAID UNDER ITEM 204, EXCAVATION OF SUBGRADE.

**ITEM 202 - CURB REMOVED, AS PER PLAN**

SAW CUT THE EXISTING CURB FOR THE LIMITS SHOWN ON THE PLANS SUCH THAT THE CURB IS FLUSH WITH THE ADJACENT SURFACES.

**POST CONSTRUCTION STORM WATER TREATMENT**

THIS PLAN UTILIZES STRUCTURAL BEST MANAGEMENT PRACTICES (BMP'S) FOR POST CONSTRUCTION STORM WATER TREATMENT.

**VEGETATED FILTER STRIP**

THIS PLAN UTILIZES VEGETATED FILTER STRIP(S) FOR POST CONSTRUCTION STORM WATER TREATMENT. THE VEGETATED FILTER STRIPS ARE CURRENTLY IN PLACE AND FUNCTIONAL SO CONTRACTOR DOESN'T NEED TO PERFORM ANY WORK ON EXISTING VEGETATED FILTER STRIPS.

**PERMANENT PAVEMENT MARKINGS**

THE CONTRACTOR SHALL REFERENCE ALL PAVEMENT MARKINGS INCLUDING AUXILIARY PAVEMENT MARKINGS BEFORE THE START OF THE RESURFACING OPERATION. THIS WILL BE NECESSARY TO ASSURE THE CORRECT PLACEMENT OF MARKINGS IN ORIGINAL LOCATIONS (EXCEPT WHERE NOTED). FOR CENTER LINE MARKINGS, THE CONTRACTOR SHALL INSTALL THE PASSING/NO PASSING ZONE MARKINGS ACCORDING TO THE CURRENT CENTER LINE LOGS AVAILABLE AT <http://www.dot.state.oh.us/Divisions/Operations/Traffic/miscellaneous/Pages/CenterlinePassingandNoPassingZoneLogs.aspx>

ALL CROSSWALK MARKINGS WITHIN THE PAVING LIMITS ARE TO BE UPDATED TO HIGH VISIBILITY CROSSWALK MARKINGS (LONGITUDINAL BARS) AS PER SCD TC-74.20. TYPICAL WIDTH OF THE CROSSWALK MARKINGS ARE TO BE 8".

PAYMENT FOR THIS OPERATION SHALL BE INCLUDED WITH EACH RESPECTIVE PAY ITEM.

**CONTINGENCY QUANTITIES**

THE CONTRACTOR SHALL NOT ORDER MATERIALS OR PERFORM WORK LISTED IN THE GENERAL SUMMARY FOR ITEMS DESIGNATED BY PLAN NOTE TO BE USED "AS DIRECTED BY THE ENGINEER UNLESS AUTHORIZED BY THE ENGINEER". THE ACTUAL WORK LOCATIONS AND QUANTITIES USED AT THE ENGINEER'S DIRECTION SHALL BE MADE A MATTER OF RECORD BY INCORPORATION INTO THE FINAL CHANGE ORDER GOVERNING COMPLETION OF THE PROJECT.


**ITEM 611 - CATCH BASIN ADJUSTED TO GRADE**

THIS WORK SHALL CONSIST OF ADJUSTING CATCH BASINS TO GRADE PRIOR TO THE APPLICATION OF THE SURFACE COURSE AS DIRECTED BY THE ENGINEER. THE FOLLOWING QUANTITY HAS BEEN CARRIED TO THE GENERAL SUMMARY:  
ITEM 611 - CATCH BASIN ADJUSTED TO GRADE .....19 EACH

**ITEM 623 - CONSTRUCTION LAYOUT STAKES, AS PER PLAN**

PRIOR TO THE START OF ROADWAY OPERATION, THE CONTRACTOR SHALL REFERENCE THE LENGTH OF THE PROJECT ON BOTH SIDES OF THE ROADWAY, IN A MANNER SATISFACTORY TO THE ENGINEER. THE PAVEMENT SHALL BE REFERENCED IN 500 FEET INCREMENTS, OR IN INCREMENTS ACCEPTABLE TO THE ENGINEER, IN A SEMIPERMANENT CONDITION.

DESIGN AGENCY



CHOICE ONE ENGINEERING

DESIGNER  
IJW

REVIEWER  
BAW 7-23-2025

PROJECT ID  
120861

SHEET TOTAL  
P.6 | 53

**ITEM 614 - MAINTAINING TRAFFIC**

A MINIMUM OF ONE LANE OF TRAFFIC IN EACH DIRECTION SHALL BE MAINTAINED AT ALL TIMES BY USE OF THE EXISTING PAVEMENT AND THE COMPLETED PAVEMENT, UNLESS OTHERWISE APPROVED BY THE ENGINEER IN WHICH IN THAT CASE AT LEAST ONE LANE SHALL BE MAINTAINED WITH FLAGGING OPERATIONS. AREAS WHERE CURB IS TO BE REPLACED SHALL BE HANDLED ACCORDING TO THE OVERNIGHT TRENCH CLOSING NOTE IN THESE PLANS.

IN THE EVENT OF A LANE CLOSURE TRAFFIC SHALL BE MAINTAINED VIA FLAGGING IN ACCORDANCE WITH ODOT'S SCD MT-95.61 AND 97.10. LANE CLOSURES SHALL BE RESTRICTED TO WORKING HOURS OF 7:00 AM TO 7:00 PM.

LENGTH AND DURATION OF LANE CLOSURES AND RESTRICTIONS SHALL BE AT THE APPROVAL OF THE ENGINEER. IT IS THE INTENT TO MINIMIZE THE IMPACT TO THE TRAVELING PUBLIC. LANE CLOSURES OR RESTRICTIONS OVER SEGMENTS OF THE PROJECT IN WHICH NO WORK IS ANTICIPATED WITHIN A REASONABLE TIME FRAME, AS DETERMINED BY THE ENGINEER, SHALL NOT BE PERMITTED. THE LEVEL OF UTILIZATION OF MAINTENANCE OF TRAFFIC DEVICES SHALL BE COMMENSURATE WITH THE WORK IN PROGRESS.

ACCESS TO AND FROM ALL LOCAL RESIDENTIAL AND BUSINESS DRIVES WITHIN THE LIMITS OF THIS PROJECT SHALL BE MAINTAINED AT ALL TIMES (24 HOURS A DAY) BY USING THE EXISTING PAVEMENT, TEMPORARY PAVEMENT, AND THE PROPOSED PAVEMENT UNLESS OTHERWISE DIRECTED BY THE ENGINEER. IT IS THE CONTRACTOR'S RESPONSIBILITY TO SEQUENCE THE WORK TO HELP MINIMIZE THE NEED FOR TEMPORARY AGGREGATE PAVEMENT. TEMPORARY AGGREGATE PAVEMENT CAN BE ASPHALT GRINDINGS OR OTHER AGGREGATE APPROVED BY THE ENGINEER. THE COST OF INSTALLATION, MATERIAL, AND REMOVAL OF THE TEMPORARY AGGREGATE PAVEMENT IS TO BE PART OF THE ITEM 614 MAINTAINING TRAFFIC LUMP SUM.

THE CONTRACTOR WILL BE REQUIRED TO PROVIDE, ERECT, MAINTAIN (IN PROPER POSITION, CLEAN AND LEGIBLE, AND IN GOOD WORKING CONDITION, AND SUBSEQUENTLY REMOVE ALL LIGHTS, SIGNS, CONES, BARRICADES, EXISTING PAVEMENT MARKINGS, AND ANY OTHER TRAFFIC CONTROL DEVICES NECESSARY FOR THE MAINTENANCE OF TRAFFIC.

THE CONTRACTOR SHALL ADJUST THE LOCATION AND/OR SPACING OF ALL TRAFFIC CONTROL CHANNELING DEVICES AS DICTATED BY THE PROGRESS OF THE REQUIRED WORK TO ALLOW CONSTRUCTION ACCESS TO WORK AREAS WHILE MAINTAINING SAFE AND EFFECTIVE TRAFFIC CONTROL DURING ALL CONSTRUCTION OPERATIONS. THE ORIGINAL LOCATION, PLACEMENT, SPACING AND SUBSEQUENT RELOCATION OR REMOVAL OF ALL TRAFFIC CONTROL DEVICES SHALL BE SUBJECT TO THE ENGINEER'S APPROVAL.

IT IS INTENDED THAT THE TRAFFIC NOT BE SUBJECTED TO ANY LANE CLOSURES UNLESS ACTIVE WORK IS BEING PERFORMED IN OR IMMEDIATELY ADJACENT TO THE CLOSED LANE. THE ROADWAY SHALL NOT BE RESTRICTED TO ANY LANE CLOSURE DURING PERIODS OF INTERMITTENT OR IRREGULAR WORK, NOR CLOSED SOLELY FOR THE CONVENIENCE OF THE CONTRACTOR. THE ENGINEER SHALL MAKE THE FINAL DETERMINATION AS TO WHAT CONSTITUTES ACTIVE WORK AND WHETHER OR NOT THE LANE CLOSURE IS JUSTIFIED.

IF, IN THE OPINION OF THE ENGINEER, THE LANE CLOSURE IS NOT JUSTIFIED, THEY MAY ORDER ALL OR PART OF THE LANE CLOSURE REOPENED TO TRAFFIC (UNTIL SUCH TIME THIS CONDITION IS CORRECTED.)

THE CONTRACTOR SHALL FURNISH AND INSTALL ADVANCE WARNING "ROAD WORK AHEAD" (W20-1) SIGNS AND "END ROAD WORK" (G20-2) SIGNS, ON ALL PUBLIC ROADS ENTERING OR EXITING THE PROJECT LIMITS, AS WELL AS OTHER NECESSARY MAINTENANCE OF TRAFFIC SIGNS.

ALL WORK AND TRAFFIC CONTROL DEVICES SHALL BE IN ACCORDANCE WITH C&MS 614 AND OTHER APPLICABLE PORTIONS OF THE SPECIFICATIONS, AS WELL AS THE OHIO MANUAL OF UNIFORM TRAFFIC CONTROL DEVICES. PAYMENT FOR ALL LABOR, EQUIPMENT AND MATERIALS SHALL BE INCLUDED IN THE LUMP SUM CONTRACT PRICE FOR ITEM 614, MAINTAINING TRAFFIC, UNLESS SEPARATELY ITEMIZED IN THE PLAN.

**ITEM 614, LAW ENFORCEMENT OFFICER WITH PATROL CAR FOR ASSISTANCE, AS PER PLAN**

USE OF LAW ENFORCEMENT OFFICERS (LEOS) BY CONTRACTORS OTHER THAN THE USER SPECIFIED BELOW WILL NOT BE PERMITTED AT PROJECT COST. LEOS SHOULD NOT BE USED WHERE THE OMTCD INTENDS THAT FLAGGERS BE USED.

IN ADDITION TO THE REQUIREMENTS OF C&MS 614 AND THE OMTCD, A UNIFORMED LEO WITH AN OFFICIAL PATROL CAR (CAR WITH TOP-MOUNTED EMERGENCY FLASHING LIGHTS AND COMPLETE MARKINGS OF THE APPROPRIATE LAW ENFORCEMENT AGENCY) SHALL BE PROVIDED FOR THE FOLLOWING TRAFFIC CONTROL TASKS:

- DURING A TRAFFIC SIGNAL INSTALLATION WHEN IMPACTING THE NORMAL FUNCTION OF THE SIGNAL OR THE FLOW OF TRAFFIC, OR WHEN TRAFFIC NEEDS TO BE DIRECTED THROUGH AN ENERGIZED TRAFFIC SIGNAL CONTRARY TO THE SIGNAL DISPLAY (E.G., DIRECTING MOTORISTS THROUGH A RED LIGHT).

IN GENERAL, LEOS SHOULD MANUALLY CONTROL TRAFFIC MOVEMENTS THROUGH SIGNALIZED INTERSECTIONS IN WORK ZONES.

LEOS SHOULD NOT FORGO THEIR TRAFFIC CONTROL RESPONSIBILITIES TO APPREHEND MOTORISTS FOR ROUTINE TRAFFIC VIOLATIONS. HOWEVER, IF A MOTORIST'S ACTIONS ARE CONSIDERED TO BE RECKLESS, THEN PURSUIT OF THE MOTORIST IS APPROPRIATE.

THE LEOS WORK AT THE DIRECTION OF THE CONTRACTOR. THE CONTRACTOR IS RESPONSIBLE FOR SECURING THE SERVICES OF THE LEOS WITH THE APPROPRIATE AGENCIES AND COMMUNICATING THE INTENTIONS OF THE PLANS WITH RESPECT TO DUTIES OF THE LEOS. THE TOWNSHIP SHALL HAVE FINAL CONTROL OVER THE LEOS' DUTIES AND PLACEMENT, AND WILL RESOLVE ANY ISSUES THAT MAY ARISE BETWEEN THE TWO PARTIES.

ENSURE PROVIDED LEOS HAVE BEEN TRAINED APPROPRIATE TO THE JOB DECISIONS THEY ARE REQUIRED TO MAKE WHILE ON THE PROJECT, IN ACCORDANCE WITH C&MS 614.03.

THE LEO SHALL REPORT IN TO THE CONTRACTOR PRIOR TO THE START OF THE SHIFT, IN ORDER TO RECEIVE INSTRUCTIONS REGARDING SPECIFIC WORK ASSIGNMENTS DURING HIS/HER SHIFT. THE LEO IS EXPECTED TO STAY AT THE PROJECT SITE FOR THE ENTIRE DURATION OF HIS/HER SHIFT. THE LEO SHALL REPORT TO THE CONTRACTOR AT THE END OF HIS/HER SHIFT. SHOULD IT BE NECESSARY TO LEAVE THE PROJECT SITE, THE LEO SHALL NOTIFY THE TOWNSHIP. THE CONTRACTOR SHALL PROVIDE THE LEO WITH A TWO-WAY COMMUNICATION DEVICE WHICH SHALL BE RETURNED TO THE CONTRACTOR AT THE END OF HIS/HER SHIFT.

LEOS (WITH PATROL CAR) REQUIRED BY THE TRAFFIC MAINTENANCE TASKS ABOVE SHALL BE PAID FOR ON A UNIT PRICE (HOURLY) BASIS UNDER ITEM 614, LAW ENFORCEMENT OFFICER (WITH PATROL CAR) FOR ASSISTANCE. THE FOLLOWING ESTIMATED CONTINGENT QUANTITIES HAVE BEEN INCLUDED IN THE ESTIMATE.

ITEM 614, LAW ENFORCEMENT OFFICER WITH 8 HOURS PATROL CAR FOR ASSISTANCE, AS PER PLAN

THE HOURS PAID SHALL INCLUDE ANY MINIMUM SHOW-UP TIME REQUIRED BY THE LAW ENFORCEMENT AGENCY INVOLVED.

ANY ADDITIONAL COSTS (ADMINISTRATIVE OR OTHERWISE) INCURRED BY THE CONTRACTOR TO OBTAIN THE SERVICES OF A LEO ARE INCLUDED WITH THE BID UNIT PRICE FOR ITEM 614, LAW ENFORCEMENT OFFICER WITH PATROL CAR FOR ASSISTANCE, AS PER PLAN.

**OVERNIGHT TRENCH CLOSING**

THE BASE WIDENING SHALL BE COMPLETED TO A DEPTH OF NO MORE THAN 3 INCHES BELOW THE EXISTING PAVEMENT BY THE END OF EACH WORK DAY, UNLESS THE BASE WIDENING IS SEPARATED FROM TRAFFIC BY DRUMS OR PORTABLE CONCRETE BARRIER AS SHOWN IN THE PLANS. NO UNPROTECTED TRENCH SHALL BE LEFT OPEN OVERNIGHT. IN CASE WORK MUST BE SUSPENDED BECAUSE OF INCLEMENT WEATHER OR OTHER REASONS, THE TRENCH FOR THE UNCOMPLETED BASE WIDENING SHALL BE BACKFILLED AT THE DIRECTION OF THE ENGINEER.

**NOTIFICATION OF TRAFFIC RESTRICTIONS**

THROUGHOUT THE DURATION OF THE PROJECT, THE CONTRACTOR SHALL NOTIFY THE PROJECT ENGINEER IN WRITING OF ALL TRAFFIC RESTRICTIONS AND UPCOMING MAINTENANCE OF TRAFFIC CHANGES. THE CONTRACTOR SHALL ENSURE THE WRITTEN NOTIFICATION IS SUBMITTED IN A TIMELY MANNER TO ALLOW THE PROJECT ENGINEER TO MEET THE REQUIRED TIME FRAMES SET FORTH IN THE TABLE BELOW TO INFORM THE SPECIAL HAULING PERMITS SECTION (HAULING.PERMITS@DOT.OHIO.GOV) AND THE DISTRICT PUBLIC INFORMATION OFFICER (PIO). THIS NOTIFICATION SHALL BE RECEIVED BY THE PROJECT ENGINEER PRIOR TO THE PHYSICAL SETUP OF ANY APPLICABLE SIGNS OR MESSAGE BOARDS.

INFORMATION SHOULD INCLUDE, BUT IS NOT LIMITED TO, ALL CONSTRUCTION ACTIVITIES THAT IMPACT OR INTERFERE WITH TRAFFIC AND SHALL LIST THE SPECIFIC LOCATION, TYPE OF WORK, ROAD STATUS, DATE AND TIME OF RESTRICTION, DURATION OF RESTRICTION, NUMBER OF LANES MAINTAINED, NUMBER OF LANES CLOSED, MINIMUM VERTICAL CLEARANCE, MINIMUM WIDTH OF DRIVABLE PAVEMENT, DETOUR ROUTES, IF APPLICABLE, AND ANY OTHER INFORMATION REQUESTED BY THE PROJECT ENGINEER.

**NOTIFICATION TIME TABLE**

ITEM	DURATION OF CLOSURE	NOTICE DUE TO PERMITS
RAMP & ROAD CLOSURES	>= 2 WEEKS >12 HOURS & < 2 WEEKS < 12 HOURS	21 CALENDAR DAYS PRIOR 14 CALENDAR DAYS PRIOR 4 BUSINESS DAYS PRIOR

LANE CLOSURE & RESTRICT.	>= 2 WEEKS < 2 WEEKS	14 CALENDAR DAYS PRIOR 5 BUSINESS DAYS PRIOR
--------------------------	-------------------------	---

START OF CONST. & TRAFFIC PATTERN CHANGES	N/A	14 CALENDAR DAYS PRIOR
---	-----	------------------------

ANY UNFORESEEN CONDITIONS NOT SPECIFIED IN THE PLANS REQUIRING TRAFFIC RESTRICTIONS SHALL ALSO BE REPORTED TO THE PROJECT ENGINEER USING THE NOTIFICATION TIME TABLE.

Add the following plan notes and adjust as applicable to this project. Carry over to gensum as necessary

**ITEM 608 - CURB RAMP, AS PER PLAN**

IN AREAS OF INTERSECTION WHERE CURB IS REPLACED, WHEEL CHAIR RAMPS SHALL BE CONSTRUCTED TO MEET ADA REQUIREMENTS IN ACCORDANCE WITH ODOT STANDARD DRAWING BP-7.1 AND AS DIRECTED BY THE ENGINEER.

THE INTENT OF THIS ITEM IS TO INSTALL ADA CURB RAMPS WHERE INDICATED IN THIS SET OF PLANS. THE CONTRACTOR SHALL BE RESPONSIBLE FOR REMOVING THE EXISTING WALK AND/OR CURB AND GUTTER IN A MANNER THAT DOES NOT DAMAGE OTHER AREAS MEANT TO REMAIN IN PLACE (SEE CURRENT STANDARD DRAWING BP-7.1). AS THESE INSTALLATIONS ARE BEING MADE TO FIT EXISTING CONDITIONS, VARIATIONS FROM STANDARD MAY OCCUR. ANY DEVIATIONS FROM DETAIL IN THESE PLANS MUST FIRST BE APPROVED BY THE ENGINEER. RESTORATION TO EXISTING PAVEMENT AREAS IN FRONT OF THE PROPOSED CURB RAMPS SHALL BE INCLUDED IN THIS ITEM OF WORK. RESTORATION SHALL BE MADE UP TO AND INCLUDE THE SURFACE COURSE. ALL WORK, LABOR, MATERIAL, EQUIPMENT, AND INCIDENTALS NECESSARY TO COMPLETE THIS WORK SHALL BE INCLUDED IN THE UNIT PRICE BID PER SQUARE FOOT FOR ITEM 608, CURB RAMP, AS PER PLAN.

**PAVEMENT REPAIR**


PAVEMENT REPAIR SHALL CONSIST OF PAVEMENT REMOVED AND REPLACED TO CORRECT COUNTER SLOPE AND/OR CROSS SLOPE AT PROPOSED CURB RAMP BASES, AND/OR FOR EASE OF CONSTRUCTION.

IN ADDITION TO THE REQUIREMENT OF ODOT C&MS SECTION 253, THE CONTRACTOR SHALL REMOVE AN ADDITIONAL WIDTH OF PAVEMENT MEASURED 2 FEET FROM THE FACE OF THE CURB/GUTTER TO BE REMOVED. REFER TO THE TYPICAL SECTION BELOW FOR PAVEMENT BUILD-UP OF THE REPLACEMENT MATERIAL.

ESTIMATED QUANTITIES ARE INCLUDED IN THE SUBSUMMARY ON SHEET P.09  
THE 6" AGGREGATE BASE SHALL BE INSTALLED UNDER THE CURB AND SHALL EXTEND WIDTHWISE APPROXIMATELY 10" PAST THE BACK OF CURB.

ALL OF THESE ITEMS, INCLUDING THE PAVEMENT REMOVAL, ARE INCLUDED IN THE SQ FT ITEM, CURB RAMP, AS PER PLAN.

**TYPICAL SECTION: PAVEMENT REPAIR, AS PER PLAN**

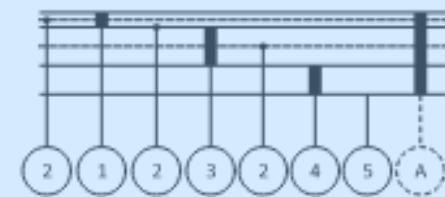

- A ITEM 202 - PAVEMENT REMOVED
- 1 ITEM 441 - 3" ASPHALT CONCRETE SURFACE COURSE, TYPE 1, (449), PG64-22 (2 LIFTS)
- 2 ITEM 407 - NON-TRACKING TACK COAT
- 3 ITEM 301 - 8" ASPHALT CONCRETE BASE, PG64-22 (2 LIFTS)
- 4 ITEM 304 - 6" AGGREGATE BASE
- 5 ITEM 204 - SUBGRADE COMPACTION

EXISTING PAVEMENT BUILD-UPS WERE NOT FOUND. THE EXISTING PAVEMENT IS EXPECTED TO BE BITUMINOUS CONCRETE OVER PENETRATION MACADAM. REGARDLESS OF MATERIAL FOUND, BACKFILL AS SHOWN IN TYPICAL SECTION ABOVE.


MAINTANCE OF TRAFFIC NOTES

DESIGN AGENCY  
CHOICE ONE ENGINEERING  
DESIGNER  
I JW  
REVIEWER  
PAW 7-23-2025  
PROJECT ID  
120861  
SHEET TOTAL  
P:7 53

SHEET NUMBER												PART.	ITEM	ITEM	GRAND	UNIT	DESCRIPTION	SEE SHEET NO.
4	10	11	13	14	42							01/MPO	EXT	TOTAL				
												LS	201	11000	LS		ROADWAY	4
		867										867	202	23000	867	SY	PAVEMENT REMOVED (ASPHALT)	
		257										257	202	23000	257	SY	PAVEMENT REMOVED (CONCRETE)	
	1,540											1,540	202	30000	1,540	SF	WALK REMOVED	
	21	42										63	202	32000	63	FT	CURB REMOVED	
	15											15	202	32500	15	FT	CURB AND GUTTER REMOVED	
				134								134	202	35100	134	FT	PIPE REMOVED, 24" DIAMETER AND UNDER	
				20								20	SPECIAL	20270110	20	FT	PIPE CLEANOUT, 24" AND UNDER	6
		1										1	202	98100	1	EACH	REMOVAL MISC.: WOOD POST REMOVED	
						552						552	203	10000	552	CY	EXCAVATION	
						358						358	203	20000	358	CY	EMBANKMENT	
	16,970											16,970	608	12000	16,970	SF	5" CONCRETE WALK	
	1,407											1,407	608	52000	1,407	SF	CURB RAMP	
	15	34										49	609	98000	49	FT	CURB, MISC.: BARRIER CURB REPLACED (IN-KIND)	
	18											18	609	98000	18	FT	CURB, MISC.: CURB AND GUTTER REPLACED (IN-KIND)	
	18	30										48	653	10000	48	CY	TOPSOIL FURNISHED AND PLACED	
		26										26	SPECIAL	69098000	26	EACH	MAILBOX SUPPORT SYSTEM, SINGLE	5
												LS	SPECIAL	69098400	LS		CONSULTANT FOR CONCRETE QUALITY CONTROL INCLUDING TESTING AND INSPECTION	6
																	EROSION CONTROL	
305				33								338	659	00300	338	CY	TOPSOIL	
2,750												2,750	659	00500	2,750	SY	SEEDING AND MULCHING, CLASS 1	
137												137	659	14000	137	SY	REPAIR SEEDING AND MULCHING	
137												137	659	15000	137	SY	INTER-SEEDING	
0.37												0.37	659	20000	0.37	TON	COMMERCIAL FERTILIZER	
0.56												0.56	659	31000	0.56	ACRE	LIME	
15.22												15.22	659	35000	15.22	MGAL	WATER	
				294								294	670	00500	294	SY	SLOPE EROSION PROTECTION	
												LS	832	15000	LS		STORM WATER POLLUTION PREVENTION PLAN	
												LS	832	15002	LS		STORM WATER POLLUTION PREVENTION INSPECTIONS	
												LS	832	15010	LS		STORM WATER POLLUTION PREVENTION INSPECTION SOFTWARE	
												12,000	832	30000	12,000	EACH	EROSION CONTROL	
																	DRAINAGE	
			157									157	611	04900	157	FT	12" CONDUIT, TYPE D	
			1									1	611	98630	1	EACH	CATCH BASIN ADJUSTED TO GRADE	
																	PAVEMENT	
	5	62										67	253	02001	67	CY	PAVEMENT REPAIR, AS PER PLAN	5
		34										34	301	56000	34	CY	ASPHALT CONCRETE BASE, PG64-22, (449)	
		65										65	304	20000	65	CY	AGGREGATE BASE	
		41										41	407	20000	41	GAL	NON-TRACKING TACK COAT, APPLIED AT 0.06 GAL./S.Y.	
	171	59										230	411	10000	230	CY	STABILIZED CRUSHED AGGREGATE	
		13										13	441	70500	13	CY	ASPHALT CONCRETE SURFACE COURSE, TYPE 1, (449), (DRIVEWAYS)	
		28										28	441	70600	28	CY	ASPHALT CONCRETE INTERMEDIATE COURSE, TYPE 1, (449), (DRIVEWAYS)	
		473										473	452	11010	473	SY	7" NON-REINFORCED CONCRETE PAVEMENT, CLASS QC 1P	
		232										232	452	12010	232	SY	8" NON-REINFORCED CONCRETE PAVEMENT, CLASS QC 1P	

Revise gensum and estimate as dictated by changes made in the plan set.

GENERAL SUMMARY

DESIGN AGENCY  
  
 CHOQUE ONE ENGINEERING  
 DESIGNER  
 IJW  
 REVIEWER  
 BAW 7-23-2025  
 PROJECT ID  
 120861  
 SHEET TOTAL  
 P.8 53





REF NO.	SHEET NO.	STATION TO STATION		SIDE	MEASURED AREA (S.F.)	202	202	202	253	411	608	608	609	609	653							
						CURB REMOVED FT	CURB AND GUTTER REMOVED FT	WALK REMOVED SF	PAVEMENT REPAIR, AS PER PLAN CY	STABILIZED CRUSHED AGGREGATE CY	5" CONCRETE WALK SF	CURB RAMP SF	CURB, MISC.: BARRIER CURB REPLACED (IN-KIND) FT	CURB, MISC.: CURB AND GUTTER REPLACED (IN-KIND) FT	TOPSOIL FURNISHED AND PLACED CY							
SW1	16	102+40.64	TO	102+81.55	RT	314		617		2.91	253	61			12.65							
SW2	16-17	102+91.32	TO	105+01.91	LT	1065		37		9.86	976	89			0.43							
SW3	17	105+15.61	TO	108+06.21	LT	1395				12.92	1395											
SW4	17	106+90.07	TO	107+32.49	RT	208			108	1.93	208											
SW5	17	107+69.58	TO	108+34.95	RT	366				3.39	366											
SW6	17	108+60.90	TO	109+52.15	LT	441				4.08	441											
SW7	17-18	108+74.99	TO	110+18.65	RT	714				6.61	658	56										
SW8	17-18	109+70.79	TO	111+48.94	LT	877				8.12	877											
SW9	18	110+61.35	TO	112+47.32	RT	928				8.59	868	60										
SW10	18	111+68.26	TO	112+44.60	LT	363				3.36	363											
SW11	18	112+57.60	TO	113+36.79	RT	403				3.73	403											
SW12	18	112+66.14	TO	112+77.99	LT	50				0.46	50											
SW13	18	112+88.29	TO	114+04.87	LT	567			81	5.25	567				1.30							
SW14	18	113+52.58	TO	114+29.98	RT	406				3.76	406											
SW15	19	116+56.15	TO	116+86.63	LT	204		137		1.89		204										
SW16	19	116+68.94	TO	116+84.45	RT	159		78		1.47		159										
SW17	19	117+14.65	TO	117+54.14	LT	227		161		2.10		227										
SW18	19	117+12.38	TO	117+27.60	RT	142		80		1.31		142										
SW19	20	120+13.31	TO	120+33.54	LT	123		20		1.14	123				0.08							
SW20	20	120+42.39	TO	121+64.48	LT	632				5.85	632											
SW21	20	120+57.49	TO	121+34.16	RT	365		101		3.38	365				2.64							
SW22	20	121+46.78	TO	124+19.24	RT	1224				11.33	1224											
SW23	20-21	121+73.00	TO	127+84.70	LT	3345				30.97	3124	221										
SW24	20-21	124+29.37	TO	125+64.38	RT	605				5.60	605											
SW25	21	125+74.75	TO	127+25.00	RT	739				6.84	739											
SW26	21	127+34.62	TO	128+62.95	RT	627				5.81	627											
SW27	21	128+28.03	TO	128+45.90	LT	188			120	1.74		188										
SW28	21	128+72.30	TO	128+95.80	RT	106				0.98	106											
SW29	21-22	129+05.29	TO	130+08.70	RT	503				4.66	503											
SW30	22	130+19.00	TO	132+36.68	RT	1091				10.10	1091											
C1	19	116+85.95	TO	116+89.25	LT	16			7	0.87				7								
C2	19	117+11.94	TO	117+15.59	LT	18			8	1.02				8								
C3	19	117+18.31	TO	117+22.14	LT	14	6			0.79				3								
C4	21	127+82.92	TO	127+86.55	LT	14	7			0.80			7									
C5	21	128+27.58	TO	128+30.66	LT	16	8			0.87			8									
TOTALS CARRIED TO GENERAL SUMMARY							21	15	1540	5	171	16970	1407	15	18	18						

SUBSUMMARY - ROADWAY

REF NO.	SHEET NO.	STATION	SIDE	MEASURED AREA (S.F.)	202		653	SPECIAL
					PAVEMENT REMOVED (ASPHALT)	REMOVAL MISC.: WOOD POST REMOVED	TOPSOIL FURNISHED AND PLACED	MAILBOX SUPPORT SYSTEM, SINGLE
					SY	EACH	CY	EACH
R1	16	104+68.33	LT					1
R2	17	107+69.77 TO 108+32.04	RT	853.4	94.82		29.75	
R3	17	108+29.08	RT					1
R4	17	108+30.82	RT					1
R5	17	109+74.13	LT					1
R6	18	111+37.50	LT					1
R7	18	112+30.74	RT					1
R8	18	112+40.16	LT					1
R9	18	113+03.44	LT					1
R10	18	113+27.92	RT					1
R11	18	113+98.59	LT					1
R12	18	114+42.03	RT					1
R13	19	115+25.16	LT					1
R14	19	118+13.15	RT					1
R15	19	118+58.94	LT					1
R16	19	119+19.29	RT					1
R17	19	119+85.89	LT					1
R18	20	120+26.80	LT					1
R19	20	120+31.49	RT					1
R20	20	121+59.24	RT			1		1
R21	20	124+40.41	RT					1
R22	21	125+86.00	RT					1
R23	21	127+42.55	RT					1
R24	21	128+81.76	RT					1
R25	21	128+87.20	RT					1
R26	22	130+31.20	RT					1
R27	22	131+85.40	RT					1
TOTALS CARRIED TO GENERAL SUMMARY					95	1	30	26

REF NO.	SHEET NO.	STATION	SIDE	DRIVE TYPE	DRIVE WIDTH (AT BACK OF APRON)	DRIVE WIDTH (AT MEET EXISTING POINT)	DRIVE AREA (MEASURED S.F.)	202		202	202	253	301	304	407	411	441	441	452	452	609
								PAVEMENT REMOVED (CONCRETE)	PAVEMENT REMOVED (ASPHALT)	CURB REMOVED	PAVEMENT REPAIR, AS PER PLAN	ASPHALT CONCRETE BASE, PG64-22, (449)	AGGREGATE BASE	NON-TRACKING TACK COAT, APPLIED AT 0.06 GAL/S. Y.	STABILIZED CRUSHED AGGREGATE	ASPHALT CONCRETE SURFACE COURSE, TYPE 1, (449), (DRIVEWAYS)	ASPHALT CONCRETE INTERMEDIATE COURSE, TYPE 1, (449), (DRIVEWAYS)	7" NON-REINFORCED CONCRETE PAVEMENT, CLASS QC 1P	8" NON-REINFORCED CONCRETE PAVEMENT, CLASS QC 1P	CURB, MISC.: BARRIER CURB REPLACED (IN-KIND)	
								SY	SY	FT	CY	CY	CY	GAL	CY	CY	CY	SY	SY	FT	
DR1	17	105+08.80	LT	RES.	13.5	22.7	377	2.89	32.93		2.38				3.08			37.00			
DR2	17	107+44.90	RT	COMM.	36.3	46.9	1181		121.23	10	5.18	1.83	2.74	1.97	8.70	0.57	1.26		104.40		
DR3	17	108+42.00	LT	COMM.	26.2	86.7	2281		234.80	29	8.82	18.43	27.65	19.91	5.83	5.76	12.67		69.92	29	
DR4	17	108+52.70	RT	COMM.	40.4	54.4	818.5		80.17	3	5.55	2.48	3.72	2.68	4.79	0.78	1.71		57.50	5	
DR5	17	109+66.40	LT	RES.	16.6	30.9	418.4	33.26	3.21		3.28				3.33			39.91			
DR6	18	110+40.00	RT	COMM.	42.7	69.2	899.1		99.90			11.10	16.65	11.99		3.47	7.63				
DR7	18	111+57.90	LT	RES.	29.3	36.2	857.8	84.53			3.88				7.30			87.54			
DR8	18	112+52.50	RT	RES.	10.6	22.2	300.8		26.50		2.38		1.32	0.36	1.89	0.21	0.45	22.72			
DR9	18	112+54.70	LT	RES.	21.8	26.4	460.3	43.26			2.88				3.78			45.38			
DR10	18	112+83.00	LT	RES.	9.9	19.9	236.8	20.39			2.13				1.84			22.06			
DR11	18	113+45.00	RT	RES.	16.4	26.5	396.1	35.20			2.87				3.19			38.28			
DR12	20	120+38.00	LT	RES.	8.9	18.8	251.9		24.10		2.01		1.31	0.35	1.51	0.20	0.45	18.07			
DR13	20	121+40.30	RT	RES.	11.4	21.7	251.6	18.20			2.31				1.94			23.33			
DR14	20	121+68.40	LT	RES.	9.4	25.4	346		31.92		2.69		2.62	0.71	1.77	0.41	0.90	21.29			
DR15	20	124+24.70	RT	RES.	9.0	23.6	234.1	18.38			2.47				1.76			21.08			
DR16	21	125+69.70	RT	RES.	10.1	23.0	313.2		29.01		2.43		2.77	0.75	1.46	0.43	0.95	17.48			
DR17	21	127+30.50	RT	RES.	9.5	23.5	193.8		16.18		2.44		1.18	0.32	0.95	0.18	0.41	11.34			
DR18	21	128+68.20	RT	RES.	9.2	25.2	313.3		22.32		2.69		1.37	0.37	1.94	0.21	0.47	23.28			
DR19	21	129+01.10	RT	RES.	9.2	24.6	304		21.83		2.62		1.39	0.37	1.86	0.22	0.48	22.31			
DR20	22	130+13.90	RT	RES.	10.3	23.5	298.4		27.66		2.51		1.53	0.41	1.77	0.24	0.52	21.29			
TOTALS CARRIED TO GENERAL SUMMARY								257	772	42	62	34	65	41	59	13	28	473	232	34	

SUBSUMMARY - ROADWAY & DRIVES

DESIGN AGENCY



CHOICE ONE ENGINEERING

DESIGNER

IJW

REVIEWER

BAW 7-23-2025

PROJECT ID

120861

SHEET TOTAL

P.11 53

REF NO.	SHEET NO.	LOCATION	STATION	SIDE	CODE	SIZE (INCHES)	625	630	630	630	630	630	630	630
							EACH	FT	EACH	SF	EACH	EACH	EACH	EACH
S1	46	SPRINGDALE RD	103+88.00	LT	M4-5						1			
					M1-1					1			1	
					M6-3					1				
S2	46	SPRINGDALE RD	104+15.00	LT	M4-5	24"X12"				2				
					M1-1	30"X24"		15		5				
					M6-3	21"X15"				2.19				
S3	47	SPRINGDALE RD	110+63.00	RT	R1-1	30"X30"		13	1	6.25				
S4	47	SPRINGDALE RD	110+65.85	RT	R1-1						1			
S5	48	SPRINGDALE RD	127+76.00	LT	CUSTOM						1			
S6	48	SPRINGDALE RD	127+81.00	LT	R9-3	12"X18"		12			1.5			
					D3-1						1			
					R1-1					1			1	
					R7-1					1				
					CUSTOM					1				
S7	48	SPRINGDALE RD	127+86.00	LT	R1-1	30"X30"		14	1	6.25				
S8	48	SPRINGDALE RD	127+87.00	RT	R9-3	12"X18"		12		1.5				
S9	48	SPRINGDALE RD	128+27.00	RT	R9-3	12"X18"		12		1.5				
S10	48	SPRINGDALE RD	128+39.00	LT	R9-3	12"X18"		12		1.5				
S11	49	SPRINGDALE RD	131+35.00	RT	W11-2	30"X30"					6.25			
					W16-9P	24"X12"		15		2				
S12	49	SPRINGDALE RD	132+17.00	RT	W11-2						1			
					W16-7PL					1			1	
S13	49	SPRINGDALE RD	132+36.00	RT			1							1
S14	49	SPRINGDALE RD	132+48.00	LT			1							1
S15	49	SPRINGDALE RD	132+33.00	LT	W11-2						1			
					W16-7PL		12			1			1	
					CUSTOM						1			
S16	49	SPRINGDALE RD	133+85.00	LT	W11-2	30"X30"				6.25				
					W16-9P	24"X12"		15		2				
TOTALS CARRIED TO GENERAL SUMMARY							2	132	2	45	12	2	5	2

This is generally paid as pedestal foundation, Item 632

625  
LIGHT POLE FOUNDATION,  
24" X 6' DEEP

12"X18"

18x18

1.5

6.25


12"X18"

12"X18"

1.5

REF NO.	SHEET NO.	STATION	642	642	642	642	642	642
			STOP LINE, TYPE 1	CROSSWALK LINE, 12", TYPE 1	CROSSWALK LINE, 24", TYPE 1	LANE ARROW, TYPE 1	REMOVAL OF PAVEMENT MARKING	REMOVAL OF PAVEMENT MARKING
			FT	FT	FT	EACH	FT	EACH
TW1	46	102+86.00			80			
TW2	47	116+76.00			60			
TW3	47	117+22.00			70			
XW1	48	128+06.00		82			61	
SL1	48	128+01.00	22					
LA1	48	127+95.38				1		1
LA2	48	128+06.42				1		1
TOTALS CARRIED TO GENERAL SUMMARY			22	82	210	2	61	2

SUBSUMMARY - SIGNING & PAVEMENT MARKINGS

DESIGN AGENCY  
  
 CHOICE ONE ENGINEERING  
 DESIGNER  
 IJW  
 REVIEWER  
 BAW 7-23-2025  
 PROJECT ID  
 120861  
 SHEET TOTAL  
 P.12 53

REF NO.	SHEET NO.	STATION TO STATION		SIDE	202	SPECIAL	509	611	611	638	638	638	638	638	638	638	638	638	SPECIAL		
					PIPE REMOVED, 24" UNDER	PIPE CLEANOUT, 24" UNDER	CONCRETE REINFORCEMENT, MISC.: REINFORCING STEEL (PER GCWW PLANS)	12" CONDUIT, TYPE D	CATCH BASIN ADJUSTED TO GRADE	WATER WORK, MISC.: REMOVING FIRE HYDRANT (PER GCWW PLANS)	WATER WORK, MISC.: REMOVING EXISTING VALVE BOX (PER GCWW PLANS)	WATER WORK, MISC.: FURNISHING AND INSTALLING FIRE HYDRANT (PER GCWW PLANS)	WATER WORK, MISC.: FURNISHING AND INSTALLING FIRE HYDRANT EXTENSION, 6" LONG (PER GCWW PLANS)	WATER WORK, MISC.: FURNISHING AND INSTALLING VALVE BOX COMPLETE (PER GCWW PLANS)	WATER WORK, MISC.: FURNISHING AND INSTALLING CURB AND ROADWAY BOX (PER GCWW PLANS)	WATER WORK, MISC.: RESETTING EXISTING CURB AND ROADWAY BOX (PER GCWW PLANS)	WATER WORK, MISC.: RESETTING EXISTING VALVE BOXES COMPLETE (PER GCWW PLANS)	WATER WORK, MISC.: FURNISHING AND LAYING 6" DUCTILE IRON PIPE AND FITTINGS (PER GCWW PLANS)	WATER WORK, MISC.: FURNISHING AND LAYING 8" DUCTILE IRON PIPE AND FITTINGS (PER GCWW PLANS)	CONCRETE, CLASS "C" (PER GCWW PLANS)	
					FT	FT	LB	FT	EACH	EACH	EACH	EACH	EACH	EACH	EACH	EACH	EACH	FT	FT	CY	
D1	17-18	109+99.31	TO	111+00.00	RT	88			101												
D2	18	114+47.65	TO	114+67.07	RT		20														
D3	20	121+25.87	TO	121+56.00	RT	24			28												
D4	20	121+58.03	TO	121+84.53	LT	22			28												
D5	21	127+69.62			LT				1												
WW1	16	104+32.39			LT		30			1	1	1	1	1				8	15	1	
WW2	17	107+57.72			RT										1						
WW3	17	108+81.56			LT										1			1			
WW4	17	109+72.58			LT																
WW5	18	110+81.57			LT													1			
WW6	18	112+00.00			LT																
WW7	18	113+21.38			LT																
WW8	20	124+03.29			RT																
WW9	21	125+31.86			LT																
WW10	21	125+89.49			RT																
WW11	21	127+09.16			RT																
WW12	21	128+21.32			RT																
TOTALS CARRIED TO GENERAL SUMMARY						134	20	30	157	1	1	1	1	1	1	9	1	1	8	15	1

SHEET NO.	LOCATION	SIDE	632	632	632	632	633		
			ACCESSIBLE PEDESTRIAN PUSHBUTTON, AS PER PLAN (GENERIC) (ALTERNATE#1)	ACCESSIBLE PEDESTRIAN PUSHBUTTON, AS PER PLAN (POLARA) (ALTERNATE#2)	COVERING OF PEDESTRIAN SIGNAL HEAD	REMOVAL OF MISCELLANEOUS TRAFFIC SIGNAL ITEM, PEDESTRIAN PUSHBUTTON	CONTROLLER ITEM, MISC.: REPROGRAM CABINET		
			EACH	EACH	EACH	EACH	EACH		
52	Ex. SP-3 (102+97.53, 23.62' LT)	LT	1	1	1	1			
52	Ex. SP-4 (102+79.61, 33.08' RT)	RT	1	1	1	1	1		
TOTALS CARRIED TO GENERAL SUMMARY			2	2	2	2	1		

SUBSUMMARY - DRAINAGE, WATERWORKS, & TRAFFIC SIGNAL

DESIGN AGENCY  
  
 CHOICE ONE ENGINEERING  
 DESIGNER  
 IJW  
 REVIEWER  
 BAW 7-23-2025  
 PROJECT ID  
 120861  
 SHEET TOTAL  
 P.13 | 53



PROJECT DATA:

PROJECT AREA = 1.20 ACRES  
 PROJECT EARTH DISTURBED AREA = 1.20 ACRES  
 ESTIMATED CONTRACTOR EARTH DISTURBED AREA = 0.1 ACRES  
 NOTICE OF INTENT EARTH DISTURBED AREA = 1.30 ACRES  
 IMPERVIOUS AREA FOR PRE-CONSTRUCTION SITE = 0.00 ACRES  
 IMPERVIOUS AREA FOR POST-CONSTRUCTION SITE = 0.91 ACRES  
 RUNOFF COEFFICIENT FOR PRE-CONSTRUCTION SITE = 0.5  
 RUNOFF COEFFICIENT FOR POST-CONSTRUCTION SITE = 0.5  
 POST CONSTRUCTION BMP: VEGETATED FILTER STRIP  
 MAINTAINED BY: COLERAIN TOWNSHIP  
 IMMEDIATE RECEIVING WATERS: HAMILTON COUNTY STORM SEWER  
 SUBSEQUENT RECEIVING WATERS: GREAT MIAMI RIVER

QUANTITY NOTE:

QUANTITIES CARRIED TO THE GENERAL SUMMARY

ITEM 659 TOPSOIL..... 33.00 C.Y.  
 ITEM 670 SLOPE EROSION PROTECTION..... 294.00 S.Y.

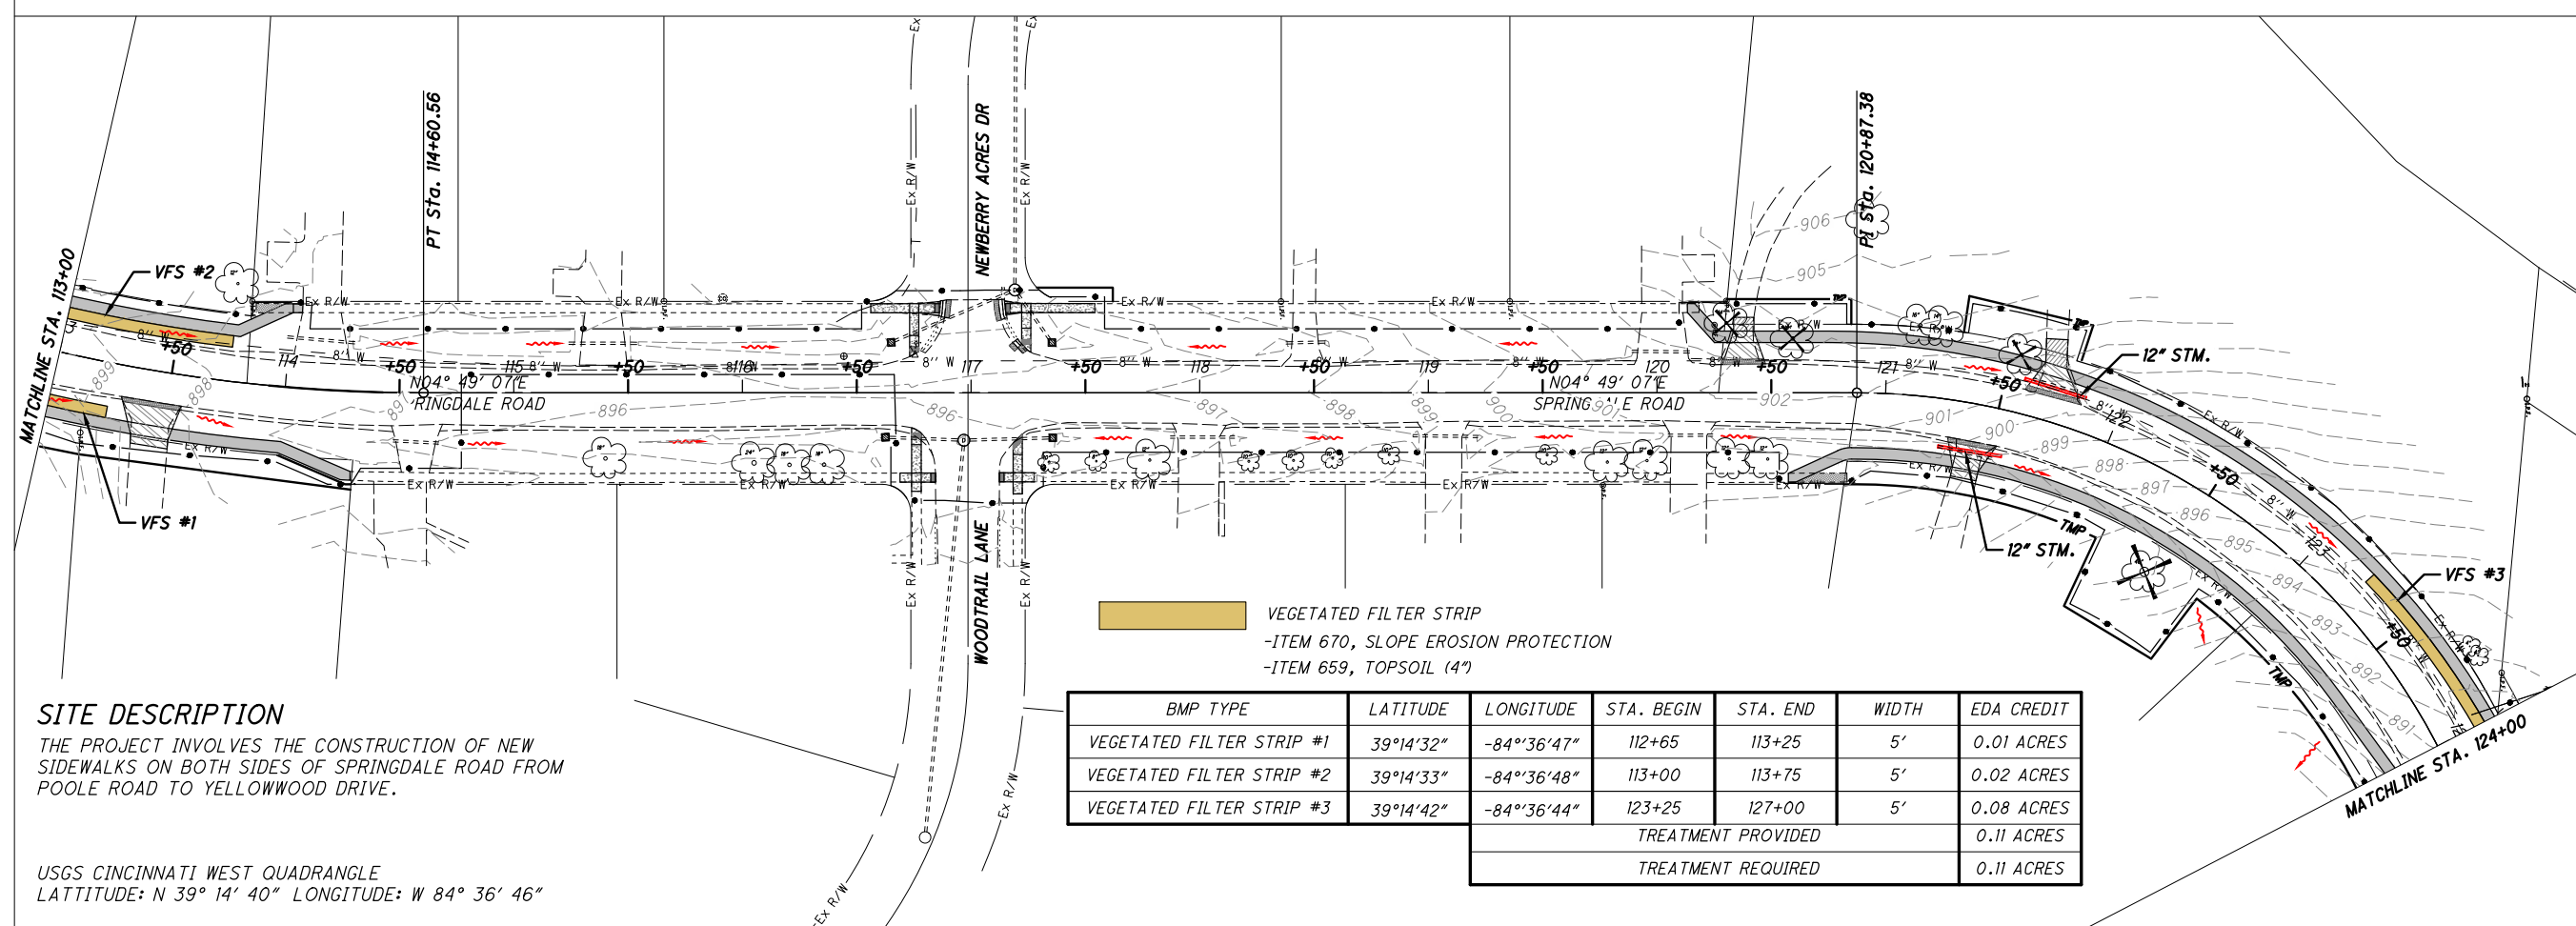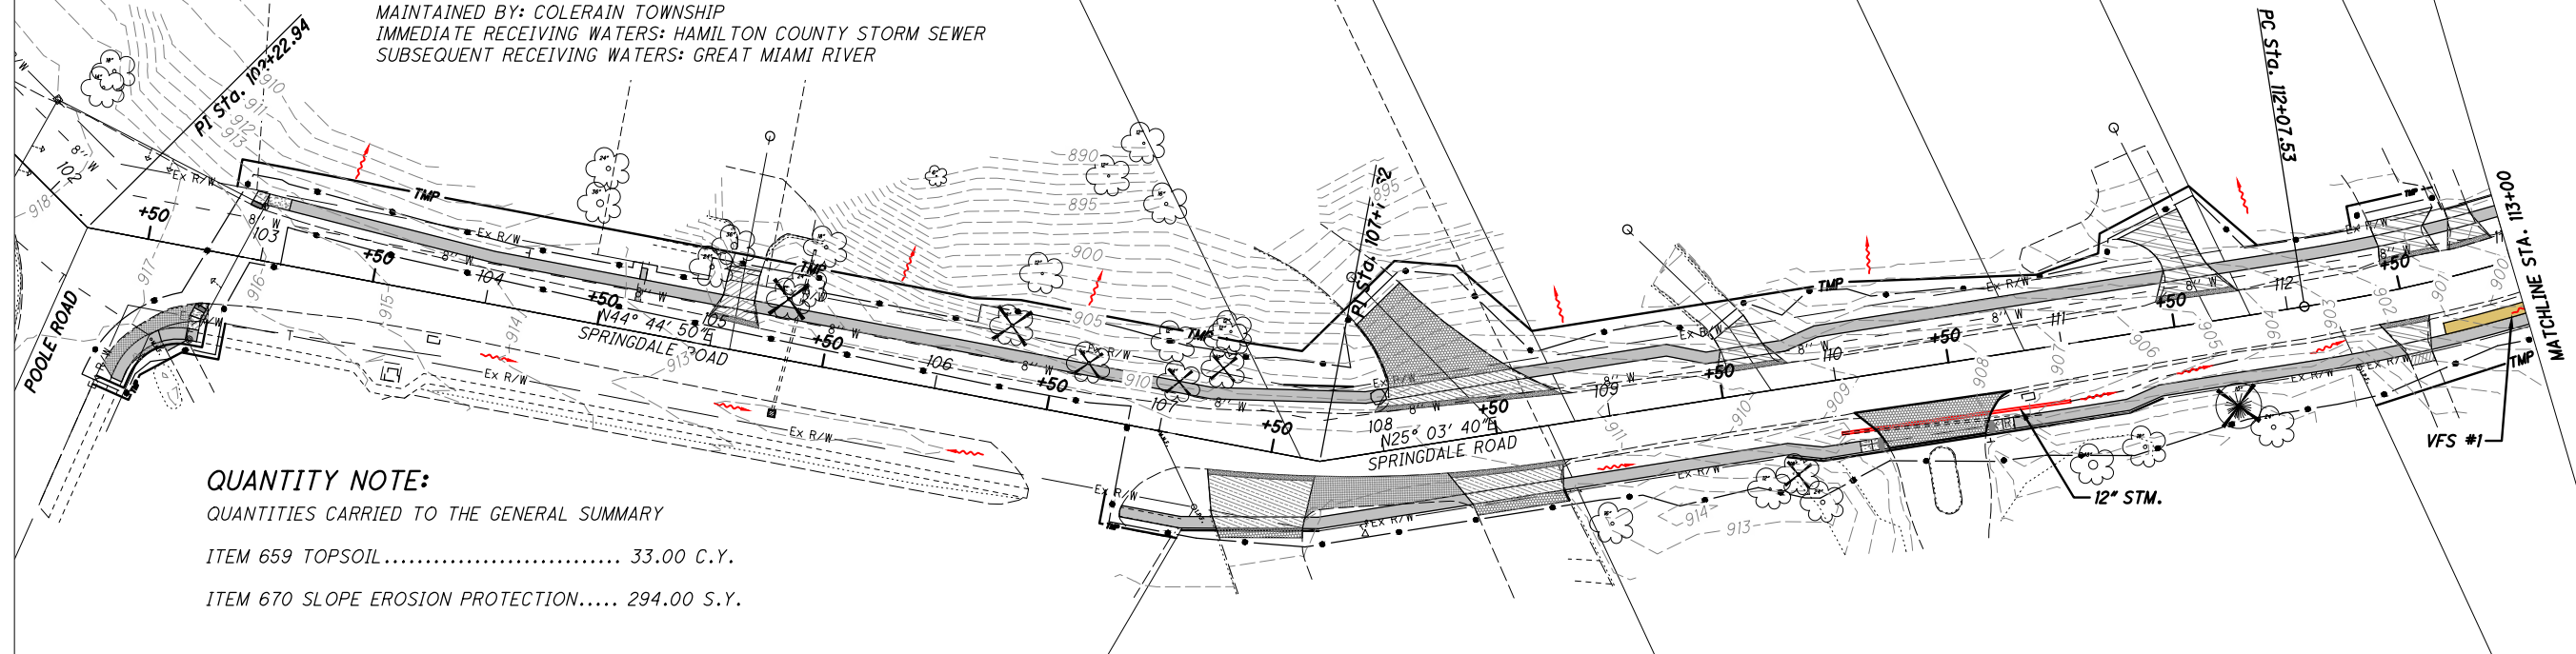


SITE DESCRIPTION

THE PROJECT INVOLVES THE CONSTRUCTION OF NEW SIDEWALKS ON BOTH SIDES OF SPRINGDALE ROAD FROM POOLE ROAD TO YELLOWWOOD DRIVE.


USGS CINCINNATI WEST QUADRANGLE  
 LATITUDE: N 39° 14' 40" LONGITUDE: W 84° 36' 46"



VEGETATED FILTER STRIP  
 -ITEM 670, SLOPE EROSION PROTECTION  
 -ITEM 659, TOPSOIL (4")

BMP TYPE	LATITUDE	LONGITUDE	STA. BEGIN	STA. END	WIDTH	EDA CREDIT
VEGETATED FILTER STRIP #1	39°14'32"	-84°36'47"	112+65	113+25	5'	0.01 ACRES
VEGETATED FILTER STRIP #2	39°14'33"	-84°36'48"	113+00	113+75	5'	0.02 ACRES
VEGETATED FILTER STRIP #3	39°14'42"	-84°36'44"	123+25	127+00	5'	0.08 ACRES
TREATMENT PROVIDED						0.11 ACRES
TREATMENT REQUIRED						0.11 ACRES

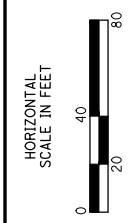


PROJECT SITE PLAN  
 STA. 102+00 to STA. 124+00

DESIGN AGENCY  
  
 CHOICE ONE ENGINEERING  
 DESIGNER  
 IJW  
 REVIEWER  
 BAW 7-23-2025  
 PROJECT ID  
 120861  
 SHEET TOTAL  
 P.14 53

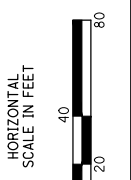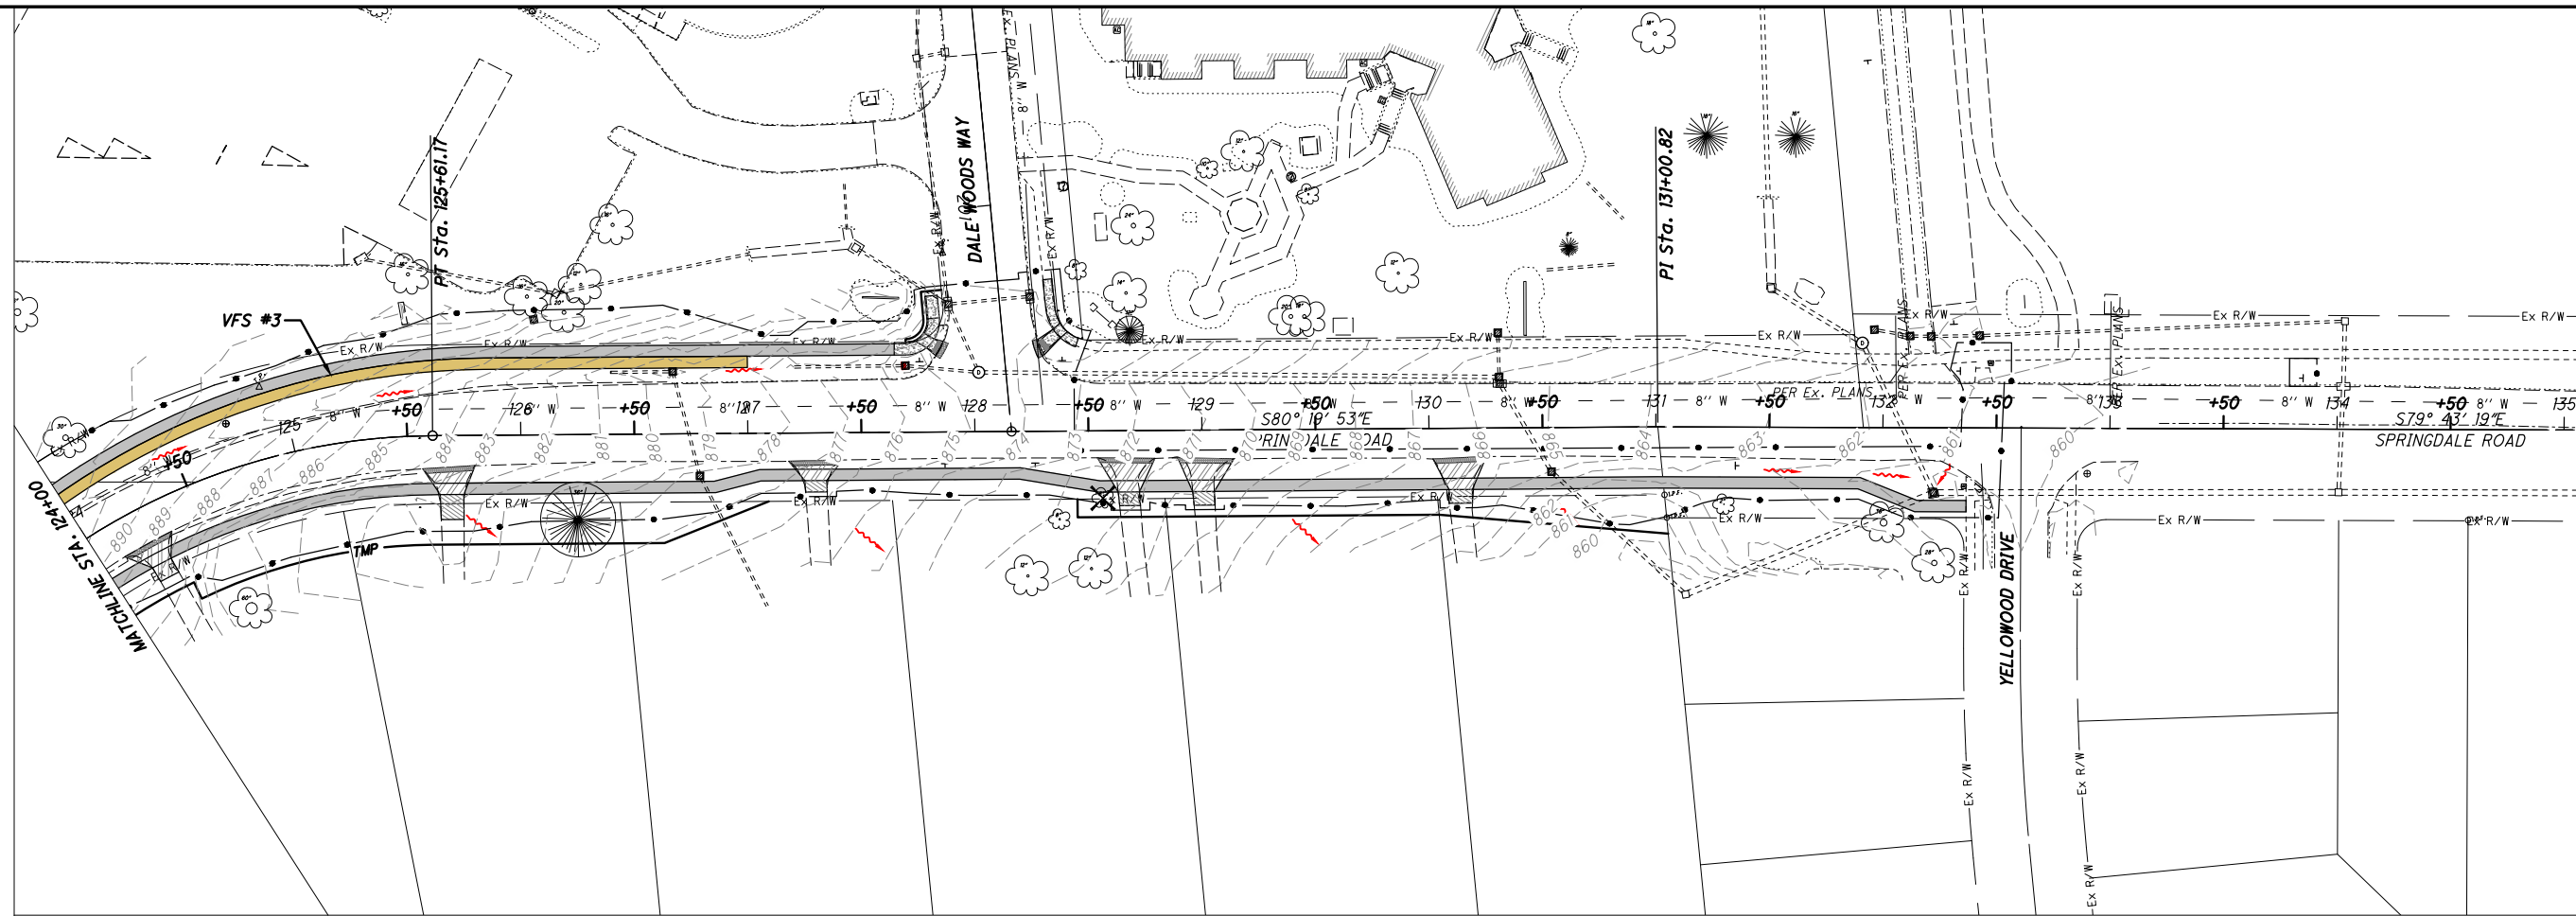

**PROJECT SITE PLAN**  
STA. 124+00 to STA. 135+00

 VEGETATED FILTER STRIP  
-ITEM 670, SLOPE EROSION PROTECTION  
-ITEM 659, TOPSOIL (4")

BMP TYPE	LATITUDE	LONGITUDE	STA. BEGIN	STA. END	WIDTH	EDA CREDIT
VEGETATED FILTER STRIP #1	39°14'32"	-84°36'47"	112+65	113+25	5'	0.01 ACRES
VEGETATED FILTER STRIP #2	39°14'33"	-84°36'48"	113+00	113+75	5'	0.02 ACRES
VEGETATED FILTER STRIP #3	39°14'42"	-84°36'44"	123+25	127+00	5'	0.08 ACRES
TREATMENT PROVIDED						0.11 ACRES
TREATMENT REQUIRED						0.11 ACRES

**SITE DESCRIPTION**

THE PROJECT INVOLVES THE CONSTRUCTION OF NEW SIDEWALKS ON BOTH SIDES OF SPRINGDALE ROAD FROM POOLE ROAD TO YELLOWWOOD DRIVE.

USGS CINCINNATI WEST QUADRANGLE  
LATITUDE: N 39° 14' 40" LONGITUDE: W 84° 36' 46"

DESIGN AGENCY



CHOICE ONE ENGINEERING

DESIGNER  
IJW

REVIEWER  
BAW 7-23-2025

PROJECT ID  
120861

SHEET TOTAL  
P.15 53

**HATCH LEGEND (ALL PLAN SHEETS)**

[Hatched Box]	FULL DEPTH PAVEMENT REPAIR
[Hatched Box]	RESIDENTIAL ASPHALT DRIVE
[Hatched Box]	COMMERCIAL ASPHALT DRIVE
[Hatched Box]	RESIDENTIAL CONCRETE DRIVE
[Hatched Box]	COMMERCIAL CONCRETE DRIVE
[Hatched Box]	REMOVED AND RE-SEED
[Hatched Box]	CURB RAMP
[Hatched Box]	SIDEWALK

**ABBREVIATION LEGEND (ALL PLAN SHEETS)**

(ATG)	- ADJUST TO GRADE
(DND)	- NO NOT DISTURB
(R&R)	- REMOVE AND REPLACE
(TBR)	- TO BE REMOVED
(TBRLBO)	- TO BE RELOCATED BY OTHERS

**SYMBOLS LEGEND (ALL PLAN SHEETS)**

[Red Square]	CATCHBASIN (ATG)
[Blue Circle]	WATER SERVICE VALVE (ATG)
[X]	TREE REMOVAL
[Dashed Line]	CONST. LIMITS

**NOTE:** ALL EXISTING MAILBOXES TO BE REMOVED AND REPLACED FOLLOWING AS PER PLAN NOTE ON SHEET 5

add the gold hatching for the



Where is this being relocated to?  
Is the anchor staying within the R/W?

This proposed grass area will become damaged and rutted by turning vehicles. Consider installing curb around the radius. Would have to add some pavement repair quantity as well.


BENCHMARK #4 ELEV. 916.62  
MAG NAIL IN THE POWER POLE AT THE NE CORNER OF SPRINGDALE RD. & POOLE RD. @ STA. 102+98 LT.

BEGIN PROJECT:  
STA. 102+32.56  
  
FAN: E240 (711)



BEGIN WORK:  
STA. 102+45.31

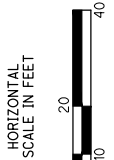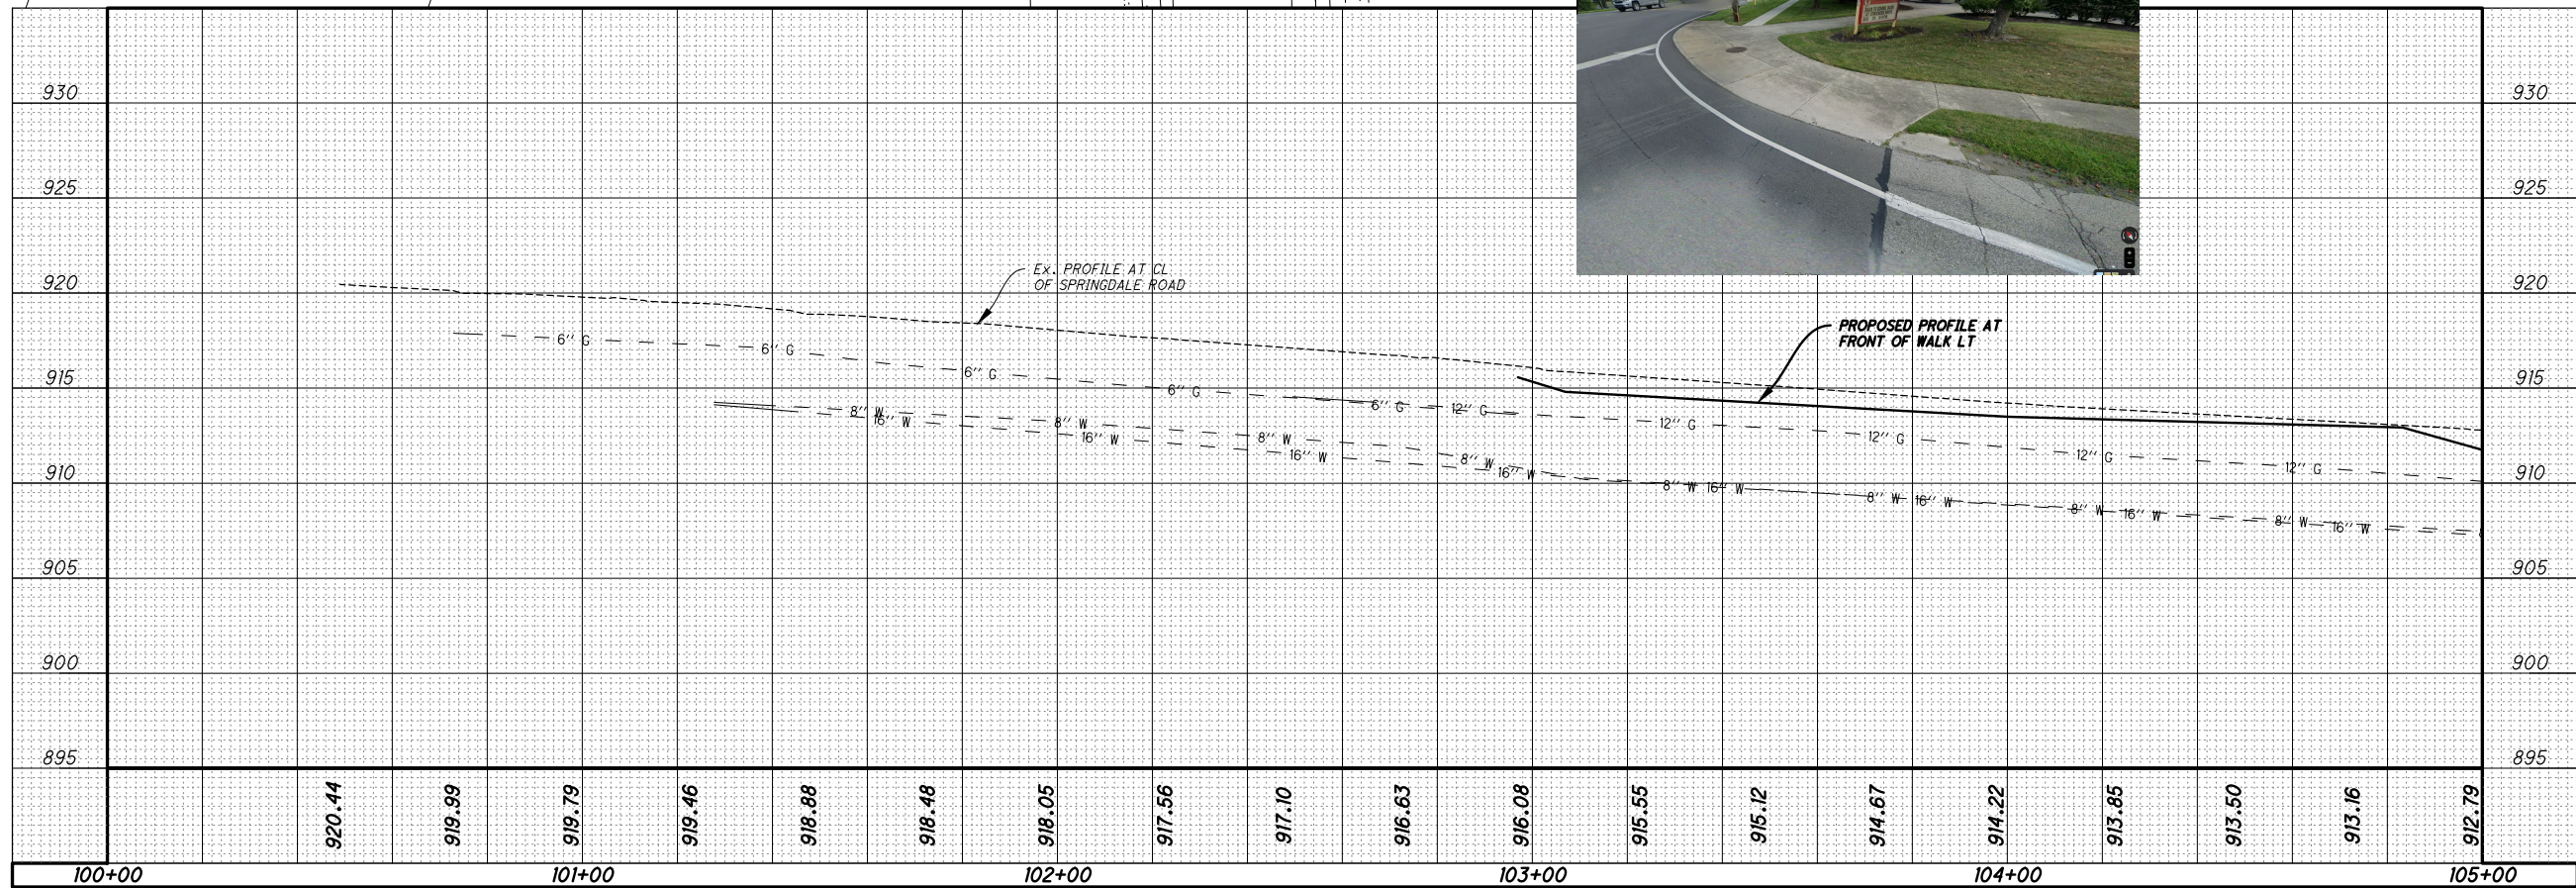

**PLAN AND PROFILE - SPRINGDALE ROAD**  
STA. 100+00 to STA. 105+00

DESIGN AGENCY  
  
CHOICE ONE ENGINEERING  
DESIGNER  
IJW  
REVIEWER  
BAW 7-23-2025  
PROJECT ID  
120861  
SHEET TOTAL  
P.16 53



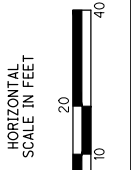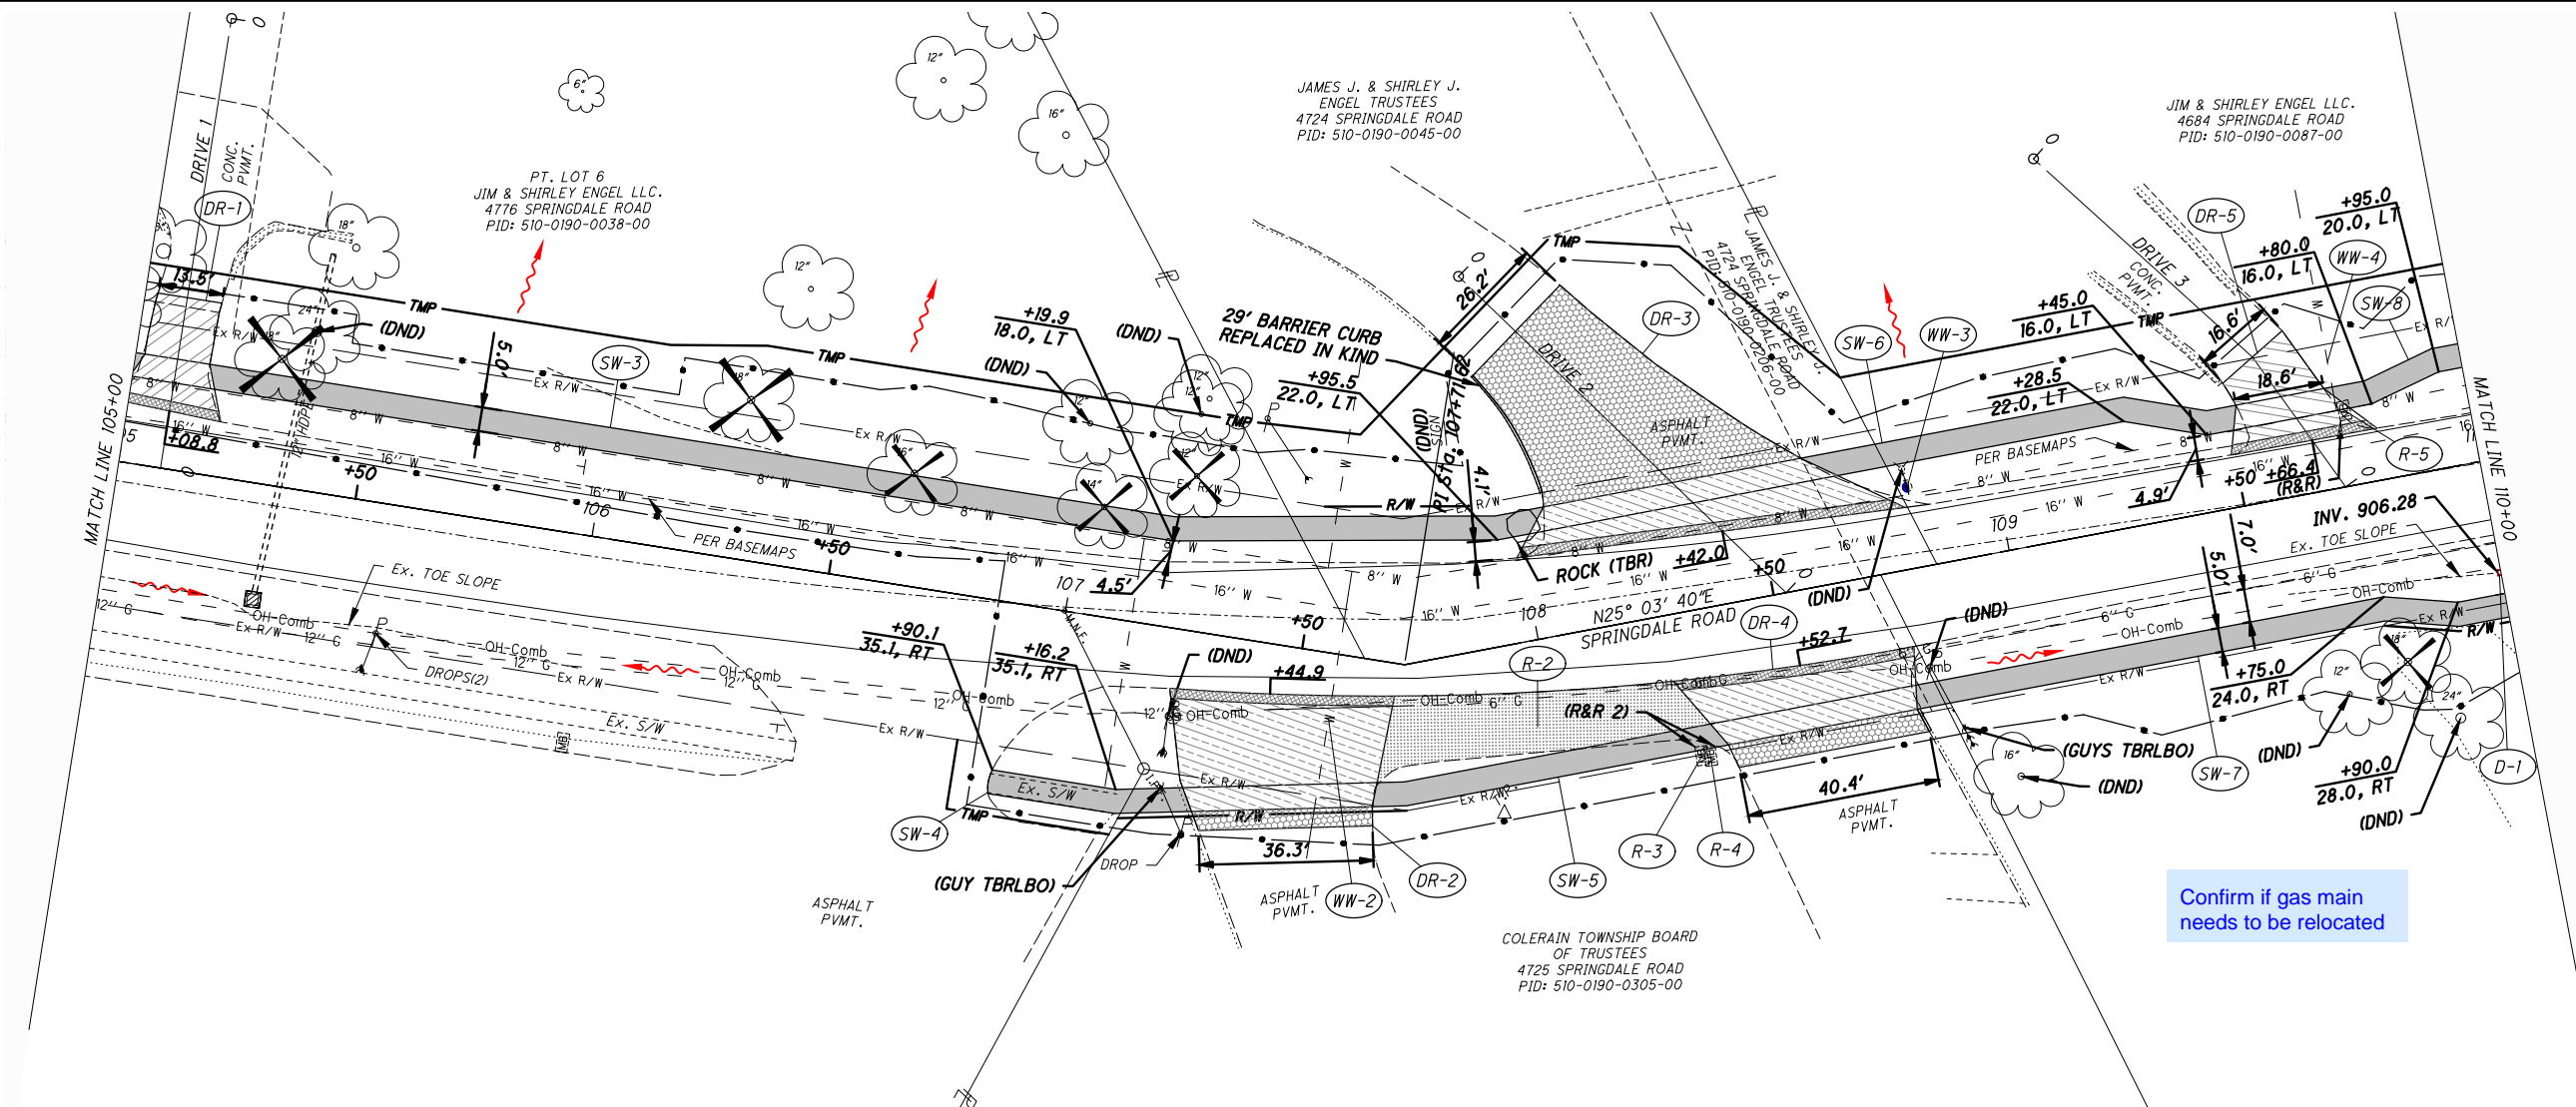


**PLAN AND PROFILE - SPRINGDALE ROAD**  
STA. 105+00 to STA. 110+00



DESIGN AGENCY



DESIGNER	IJW
REVIEWER	BAW 7-23-2025
PROJECT ID	120861
SHEET TOTAL	P.17 53

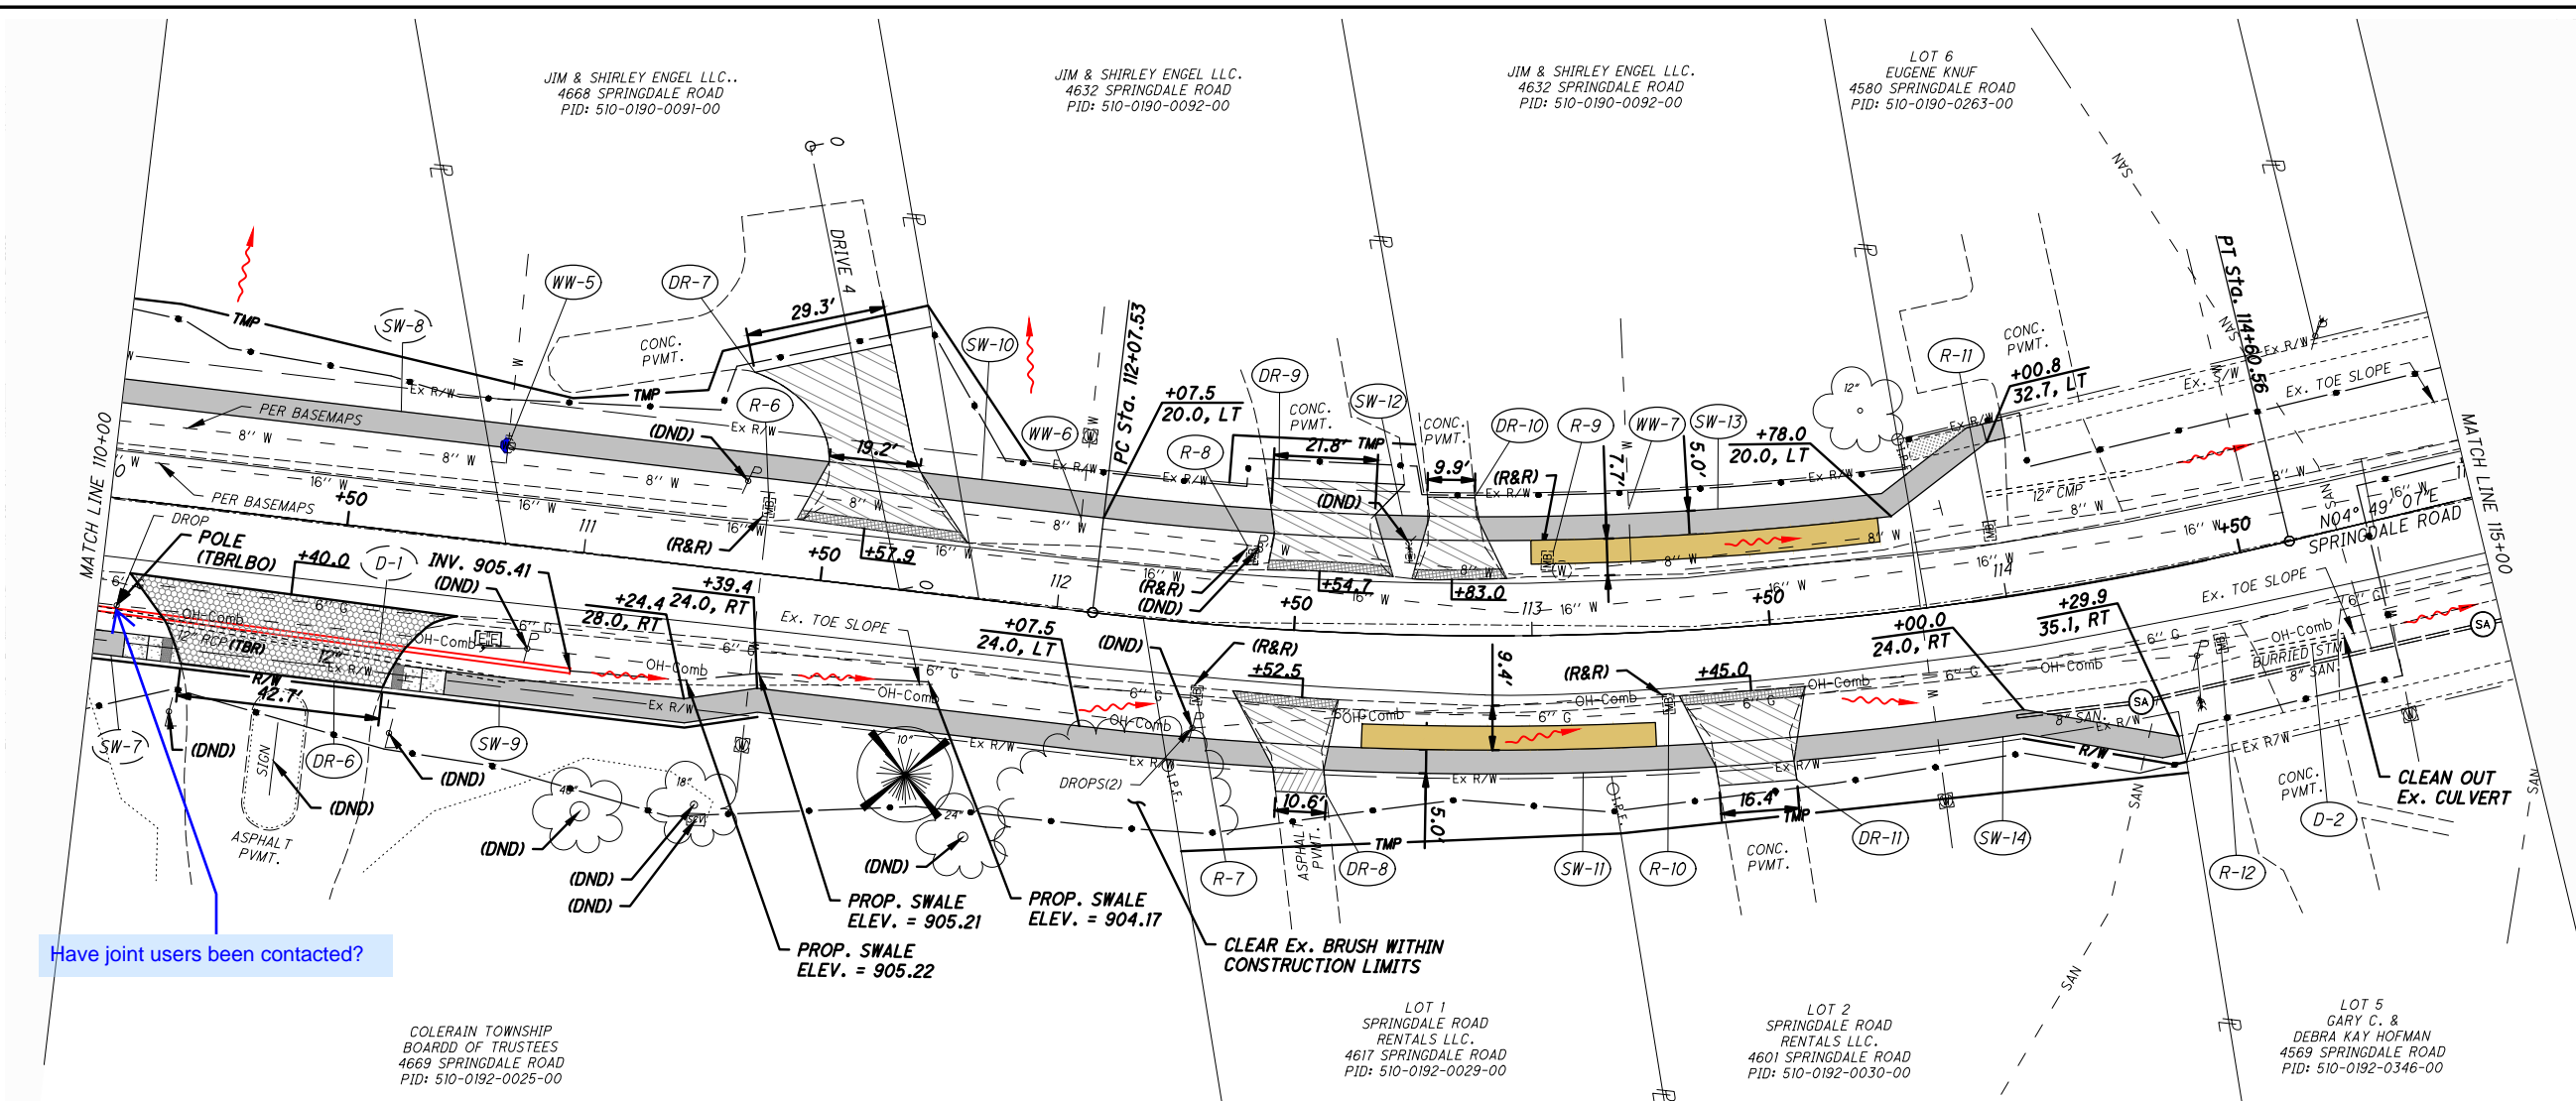




Have joint users been contacted?

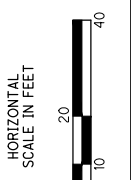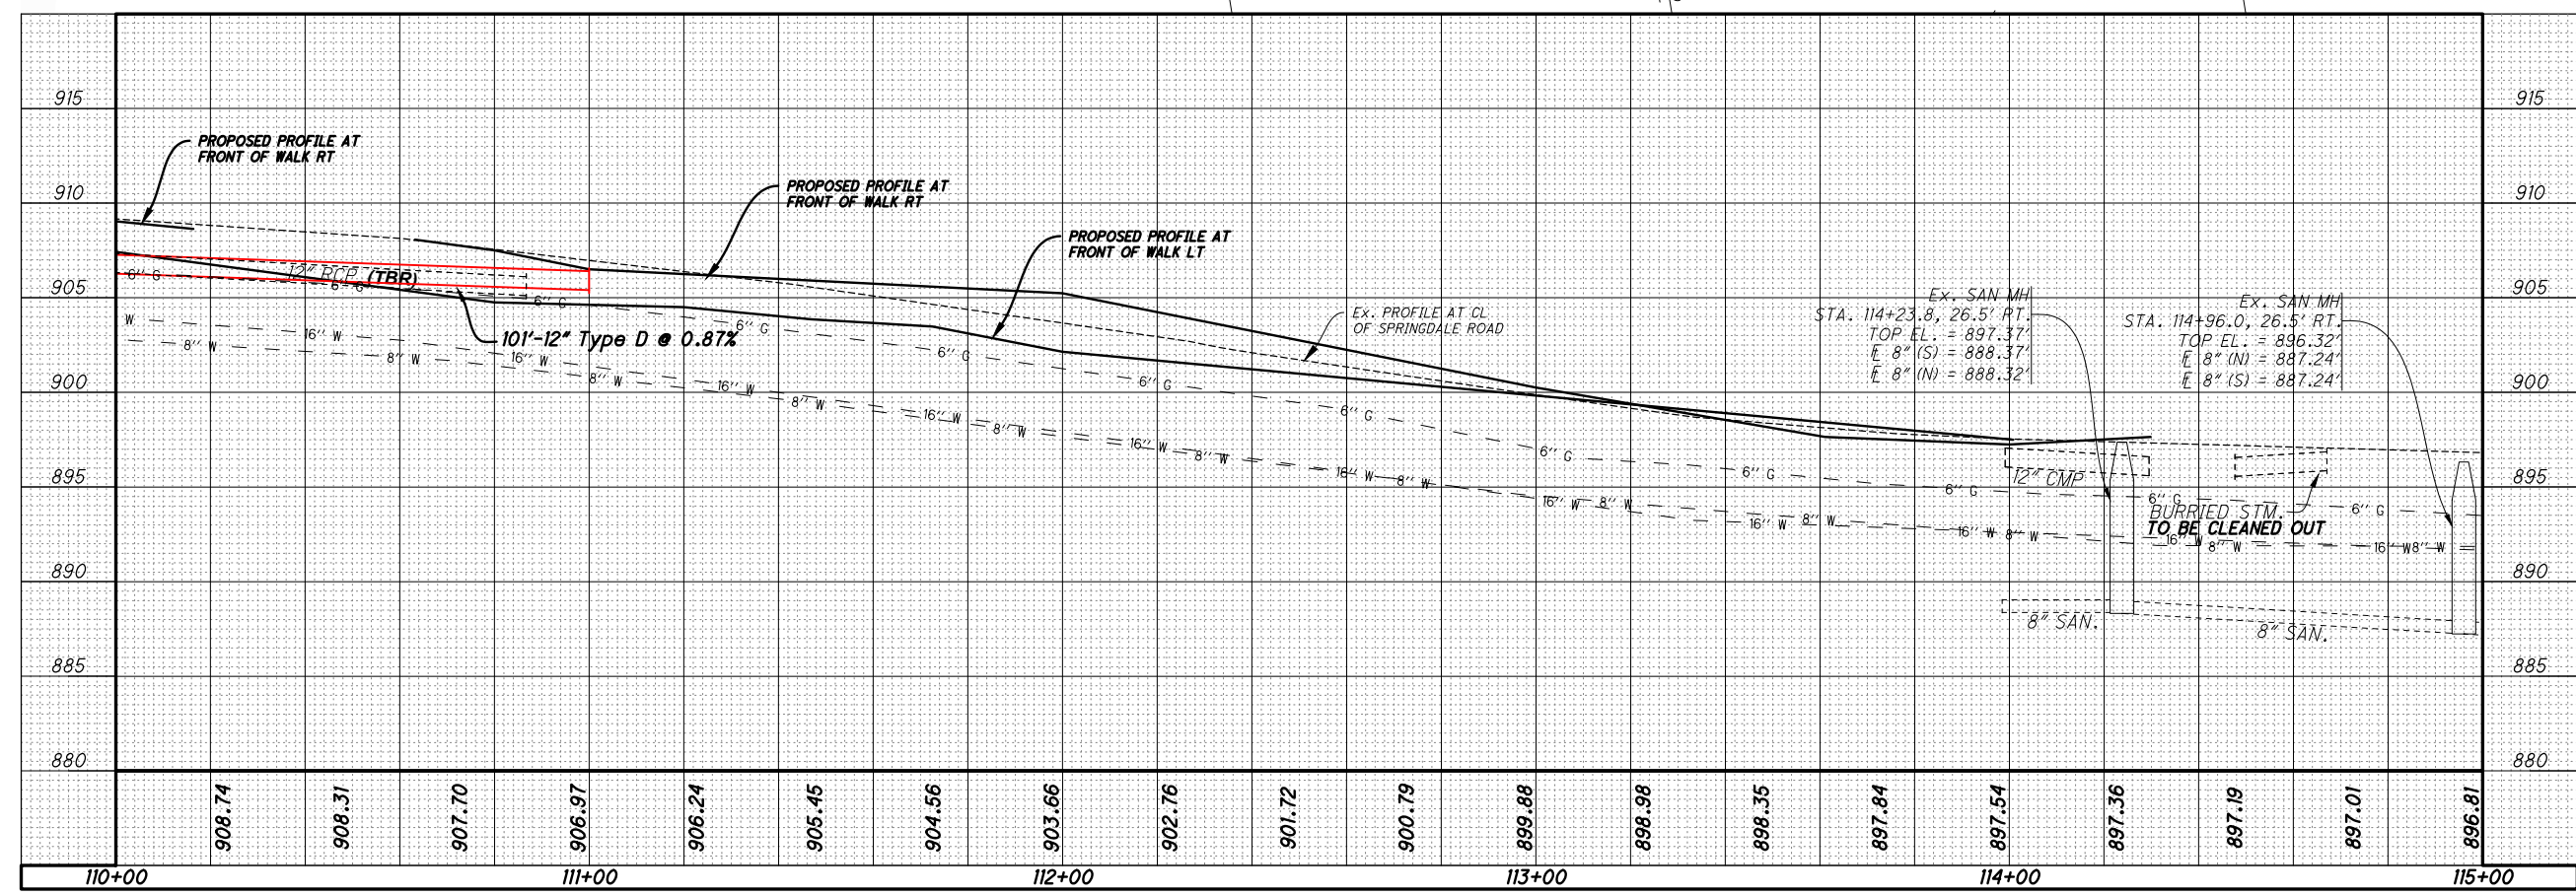

**PLAN AND PROFILE - SPRINGDALE ROAD**  
 STA. 110+00 to STA. 115+00

DESIGN AGENCY  
  
 CHOICE ONE ENGINEERING  
 DESIGNER  
 IJW  
 REVIEWER  
 BAW 7-23-2025  
 PROJECT ID  
 120861  
 SHEET TOTAL  
 P.18 53

BENCHMARK #3 ELEV. 896.80  
BOLT AT TIP ARROW TOP FLANGE  
OF FIRE HYDRANT AT THE SW  
CORNER OF SPRINGDALE RD. AND  
NEWBERRY ACRES. @ STA. 116+44  
LT.

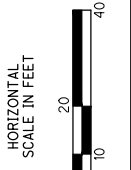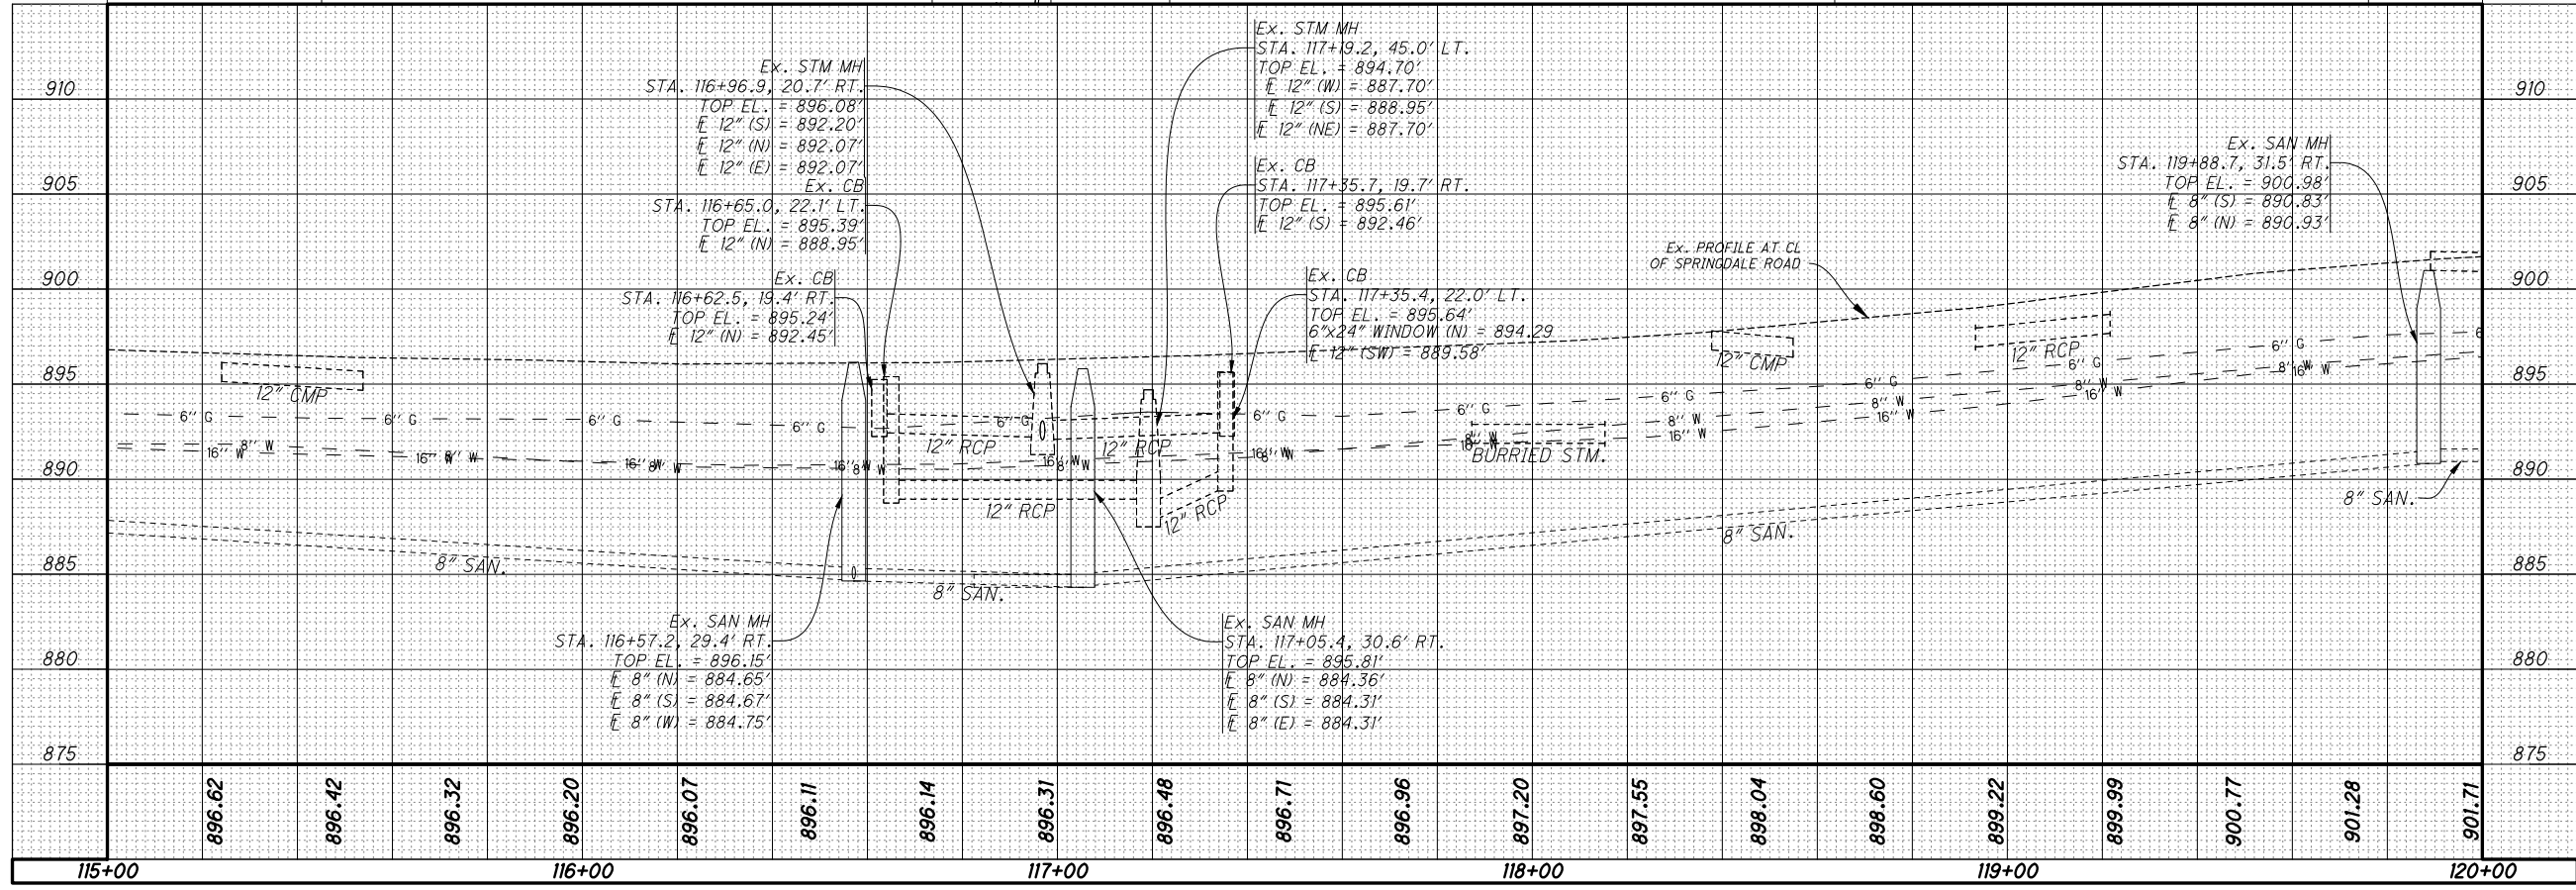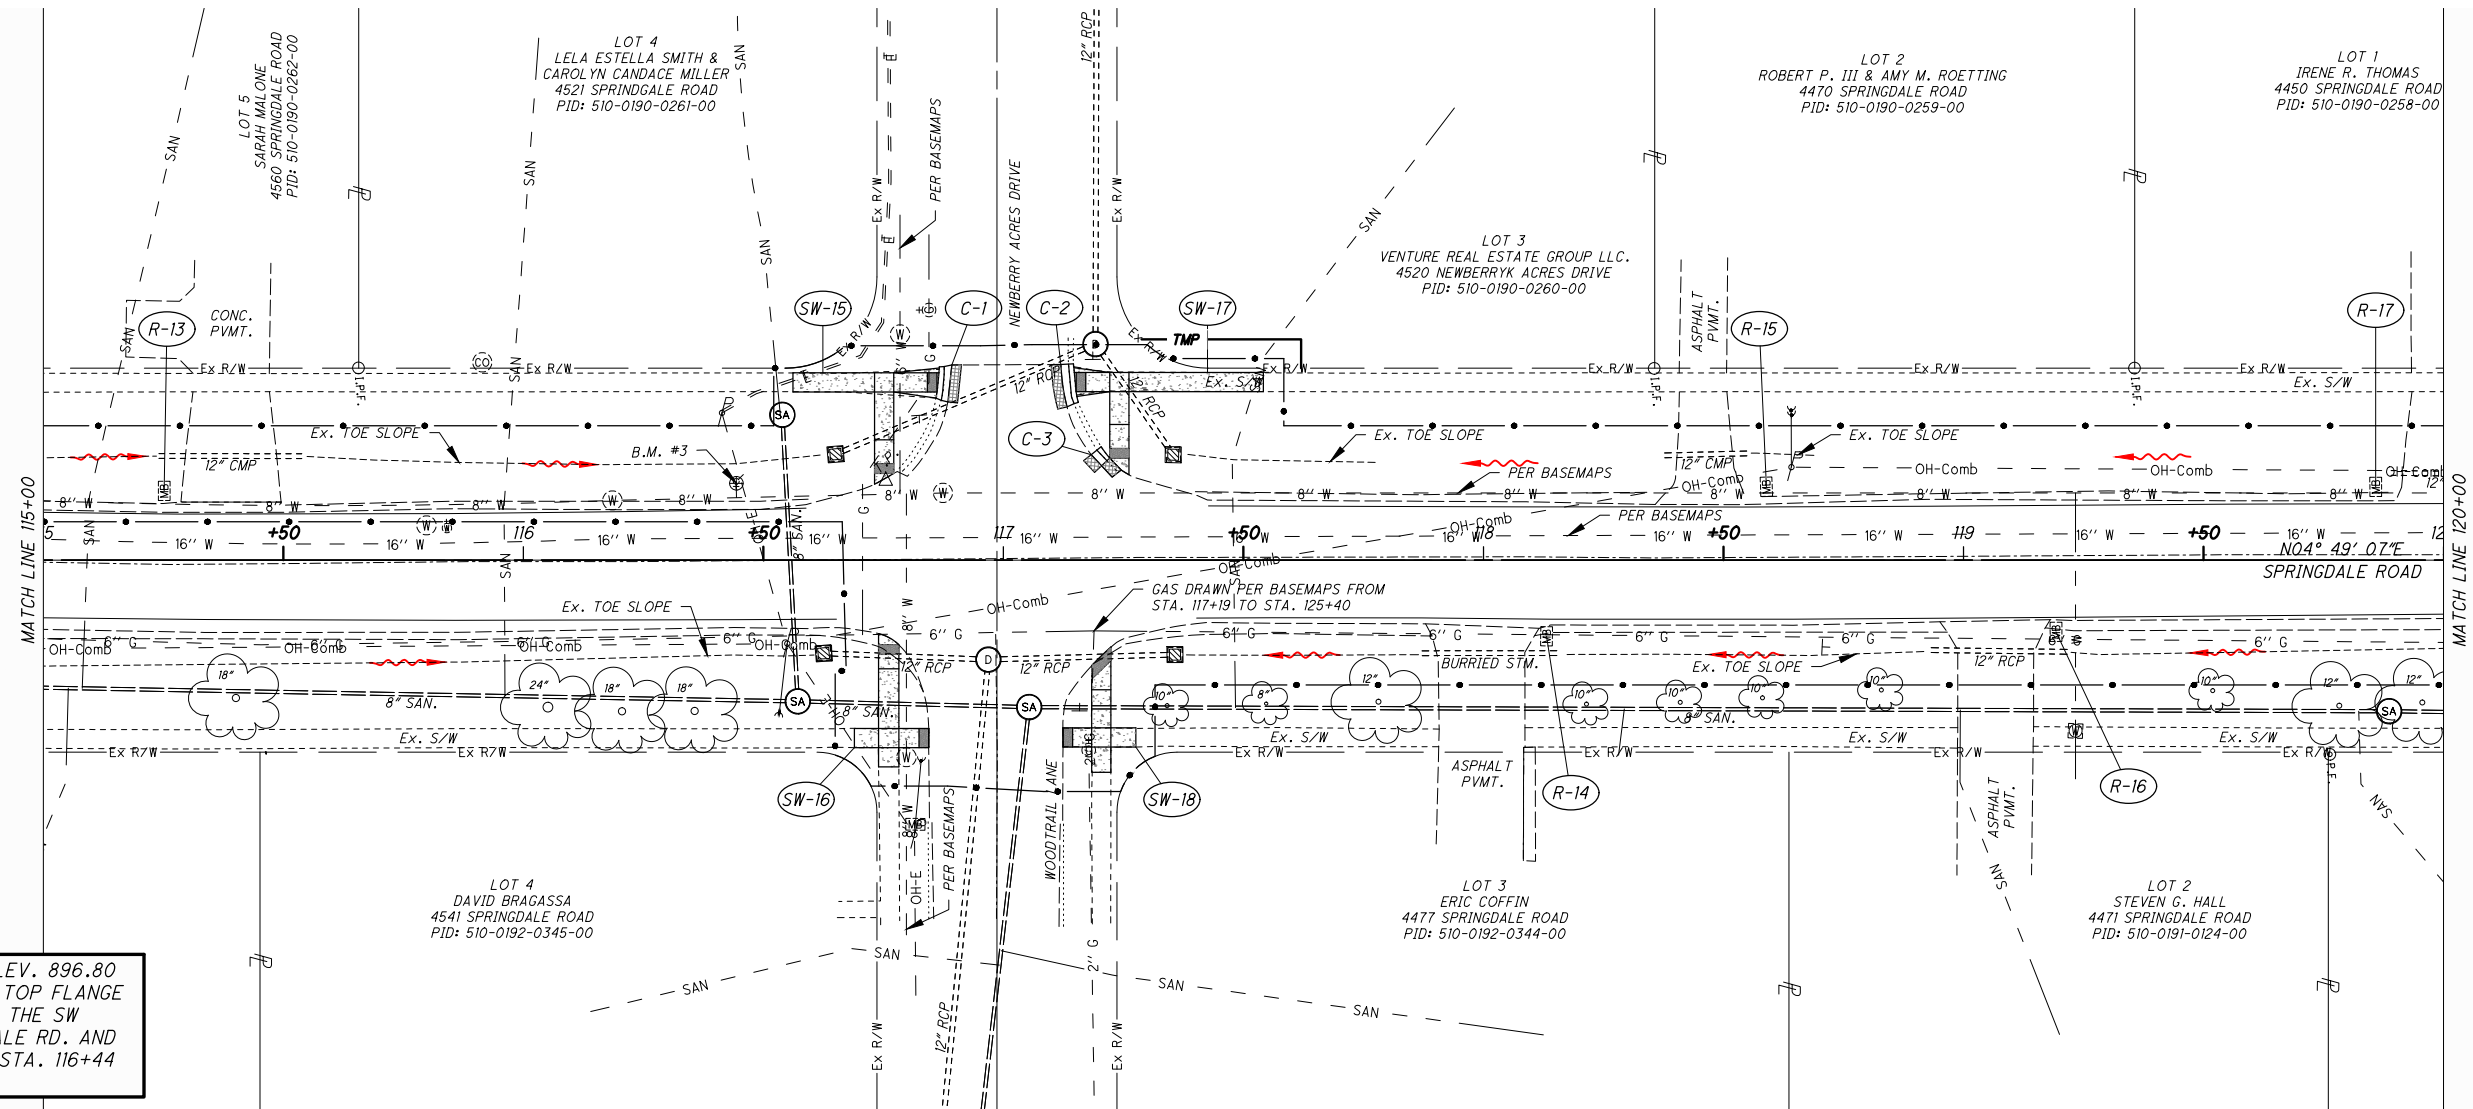

**PLAN AND PROFILE - SPRINGDALE ROAD**  
STA. 115+00 to STA. 120+00

DESIGN AGENCY



CHOICE ONE ENGINEERING

DESIGNER

IJW

REVIEWER

BAW 7-23-2025



PROJECT ID

120861

SHEET TOTAL

P.19 53

BENCHMARK #2 ELEV. 890.58  
BOLT AT TIP ARROW TOP FLANGE  
OF FIRE HYDRANT IN FRONT OF  
4300 SPRINGDALE RD. @ STA.  
124+75 LT.

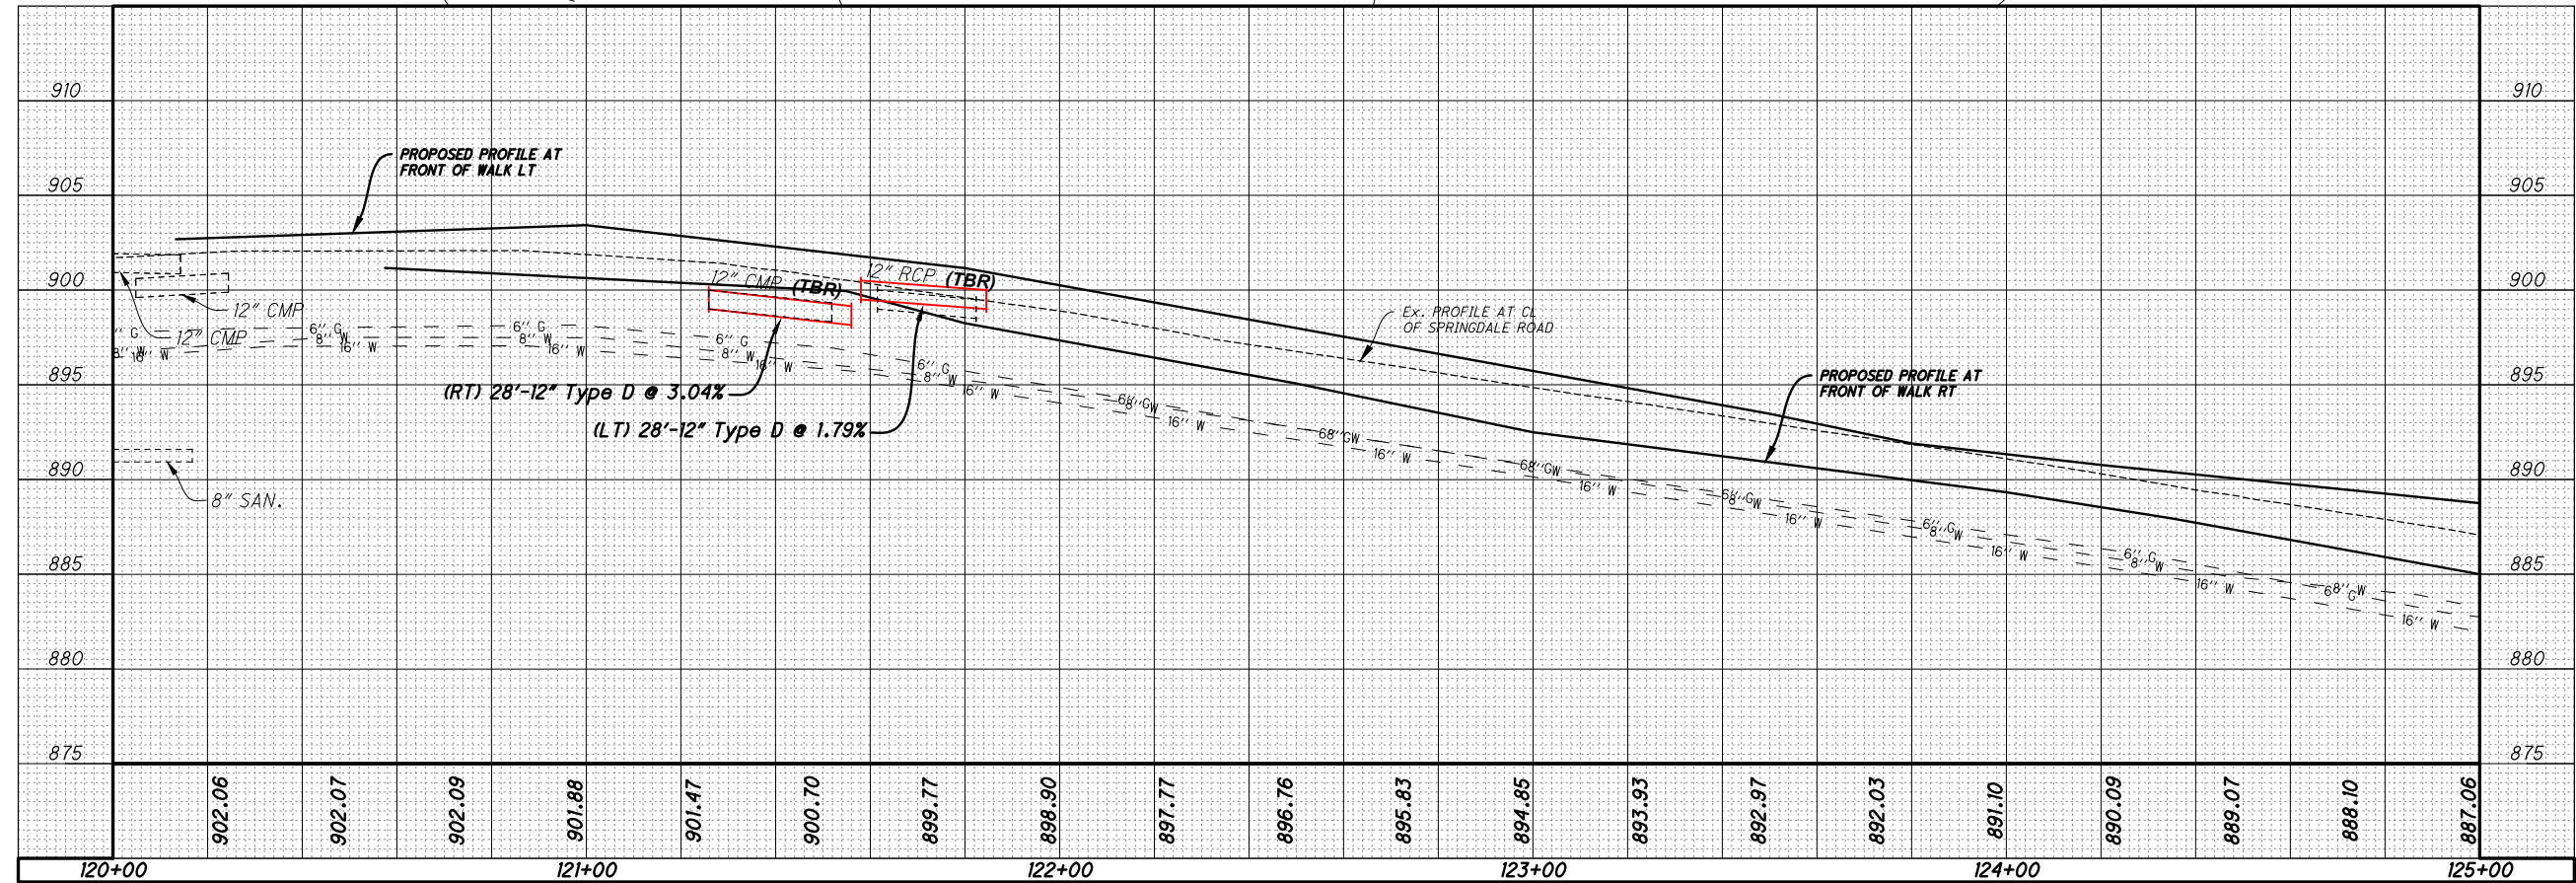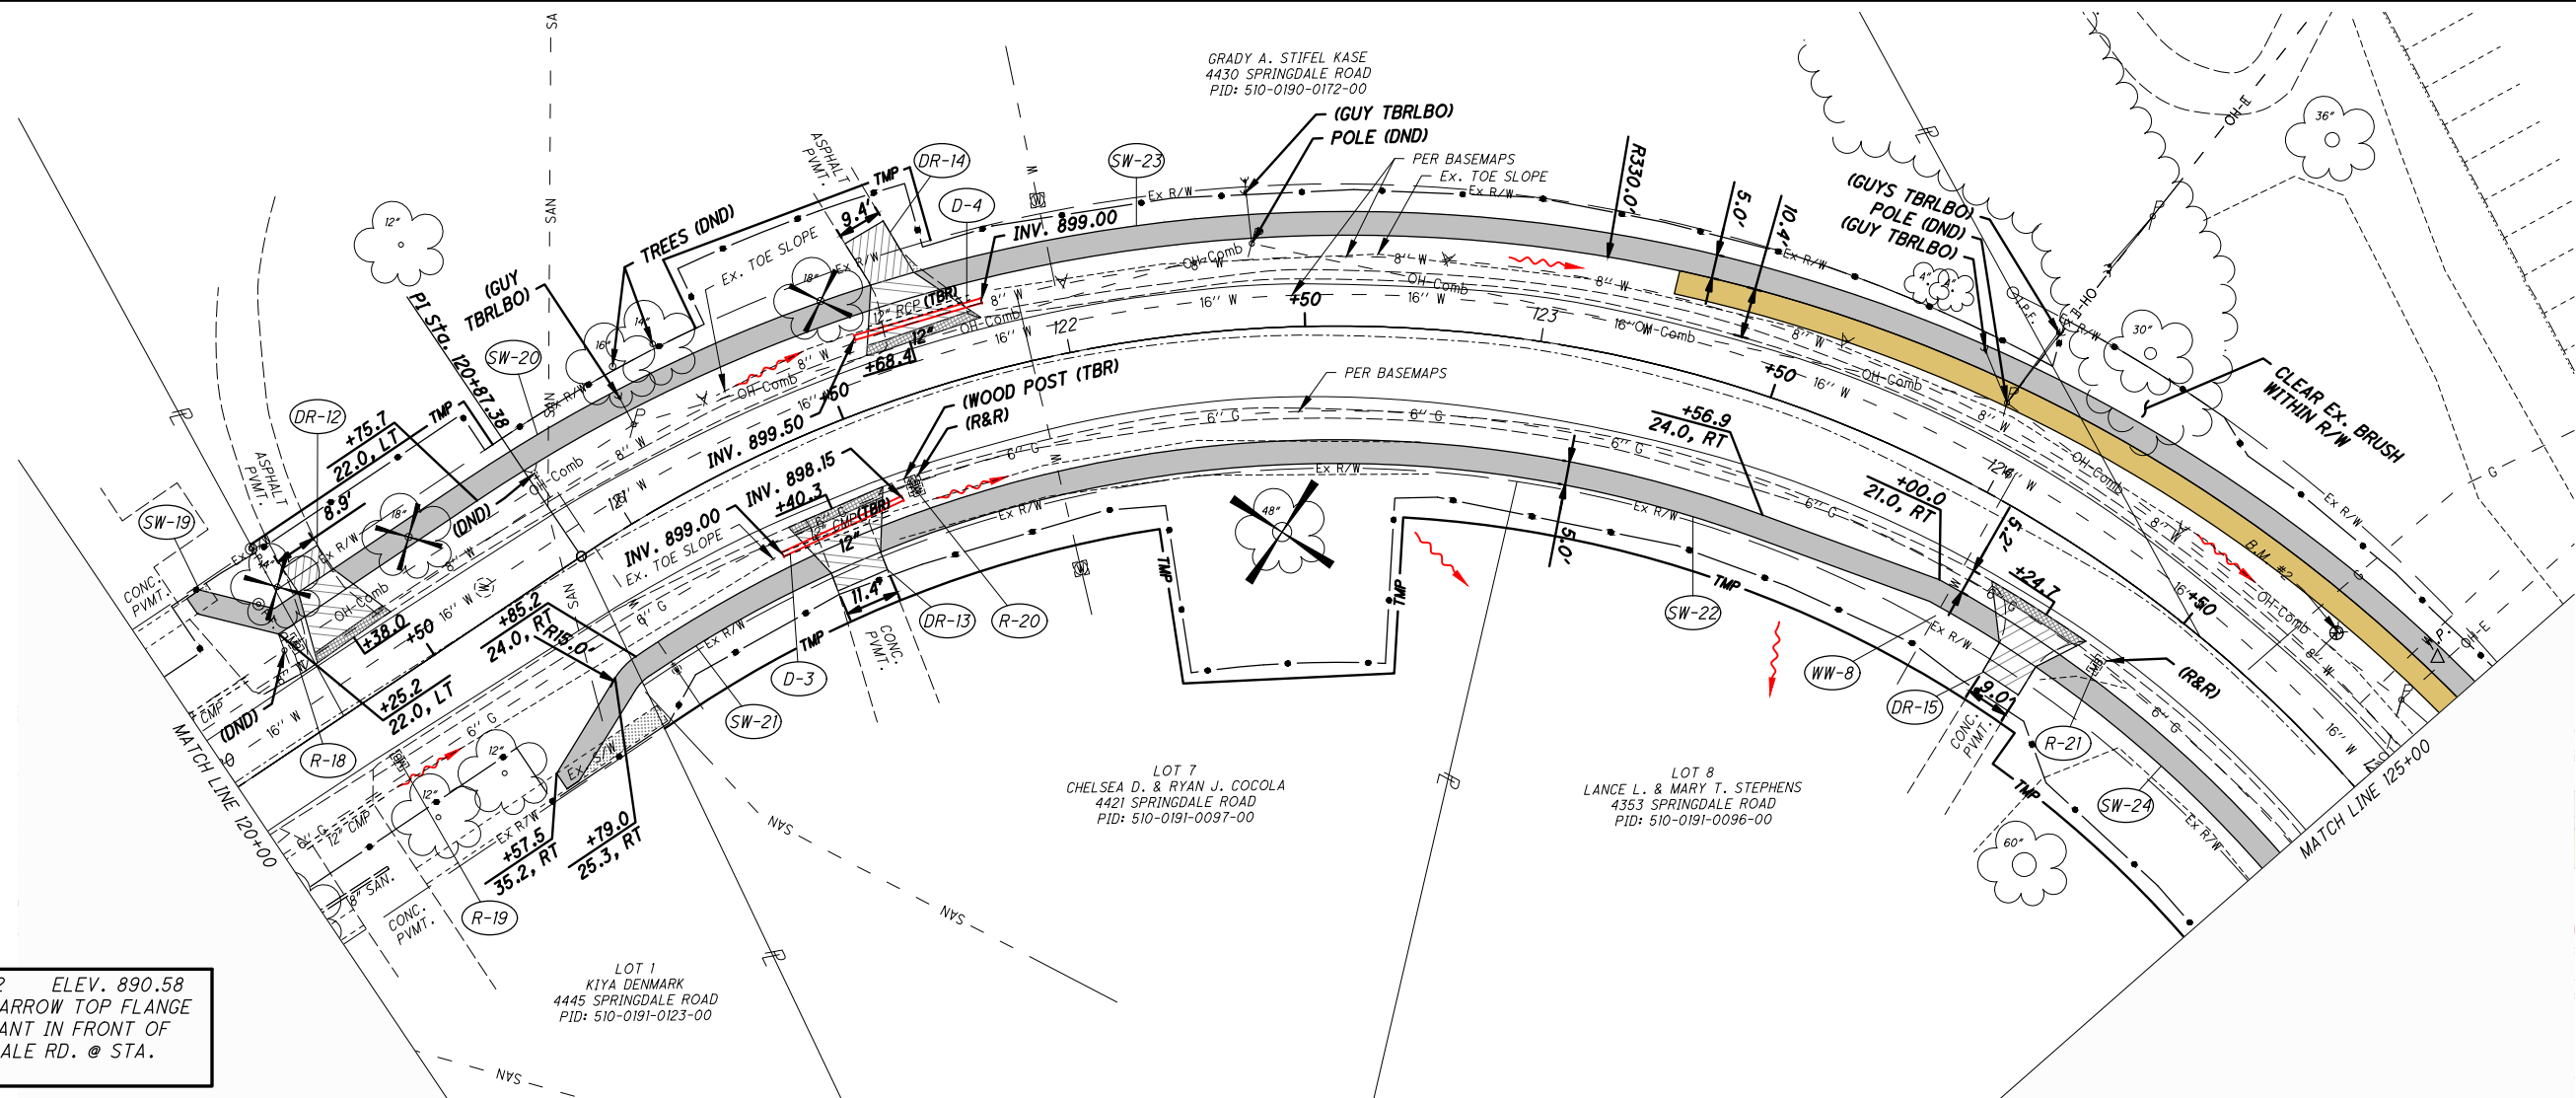

**PLAN AND PROFILE - SPRINGDALE ROAD**  
STA. 120+00 to STA. 125+00

DESIGN AGENCY



CHOICE ONE ENGINEERING

DESIGNER

IJW

REVIEWER




BAW 7-23-2025

PROJECT ID

120861

SHEET TOTAL

P.20 53

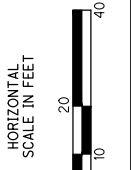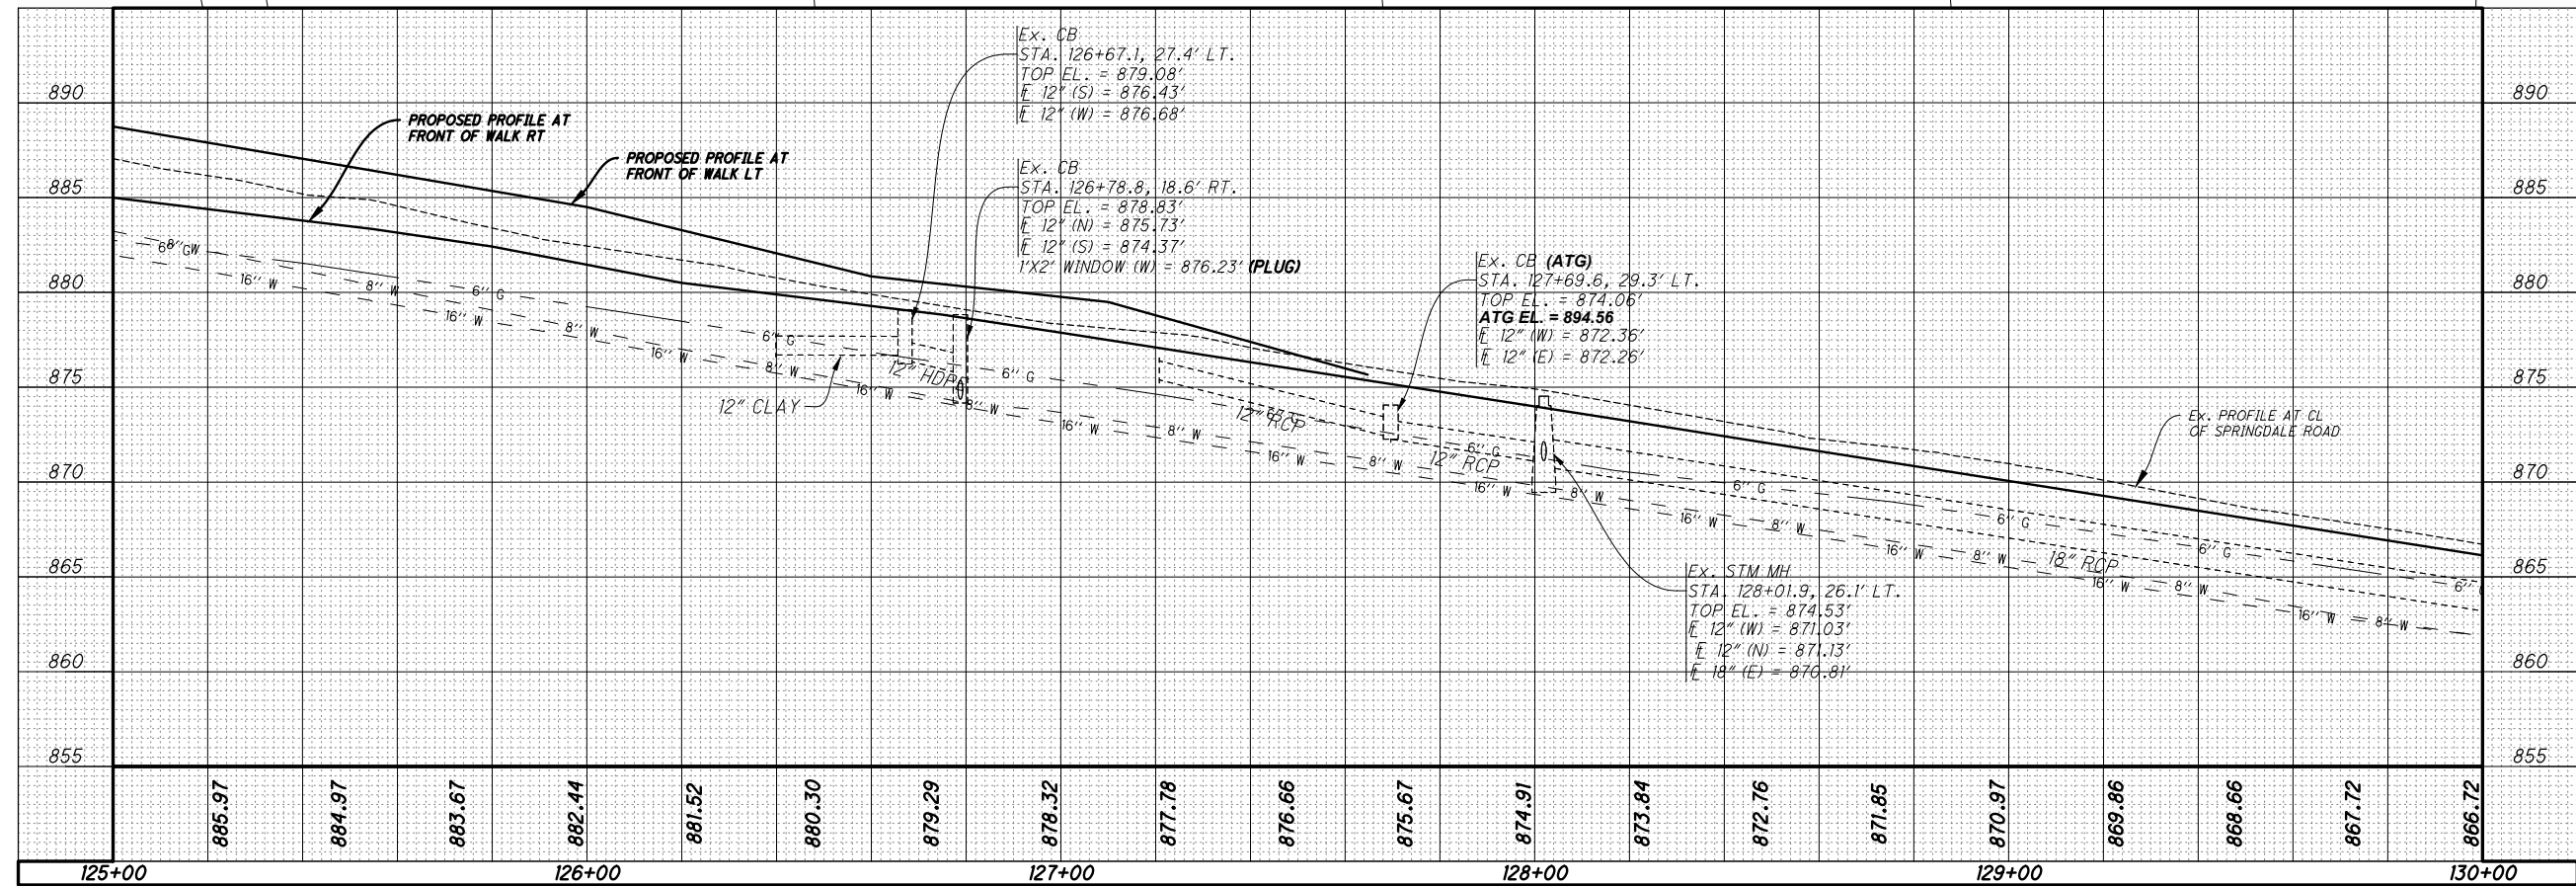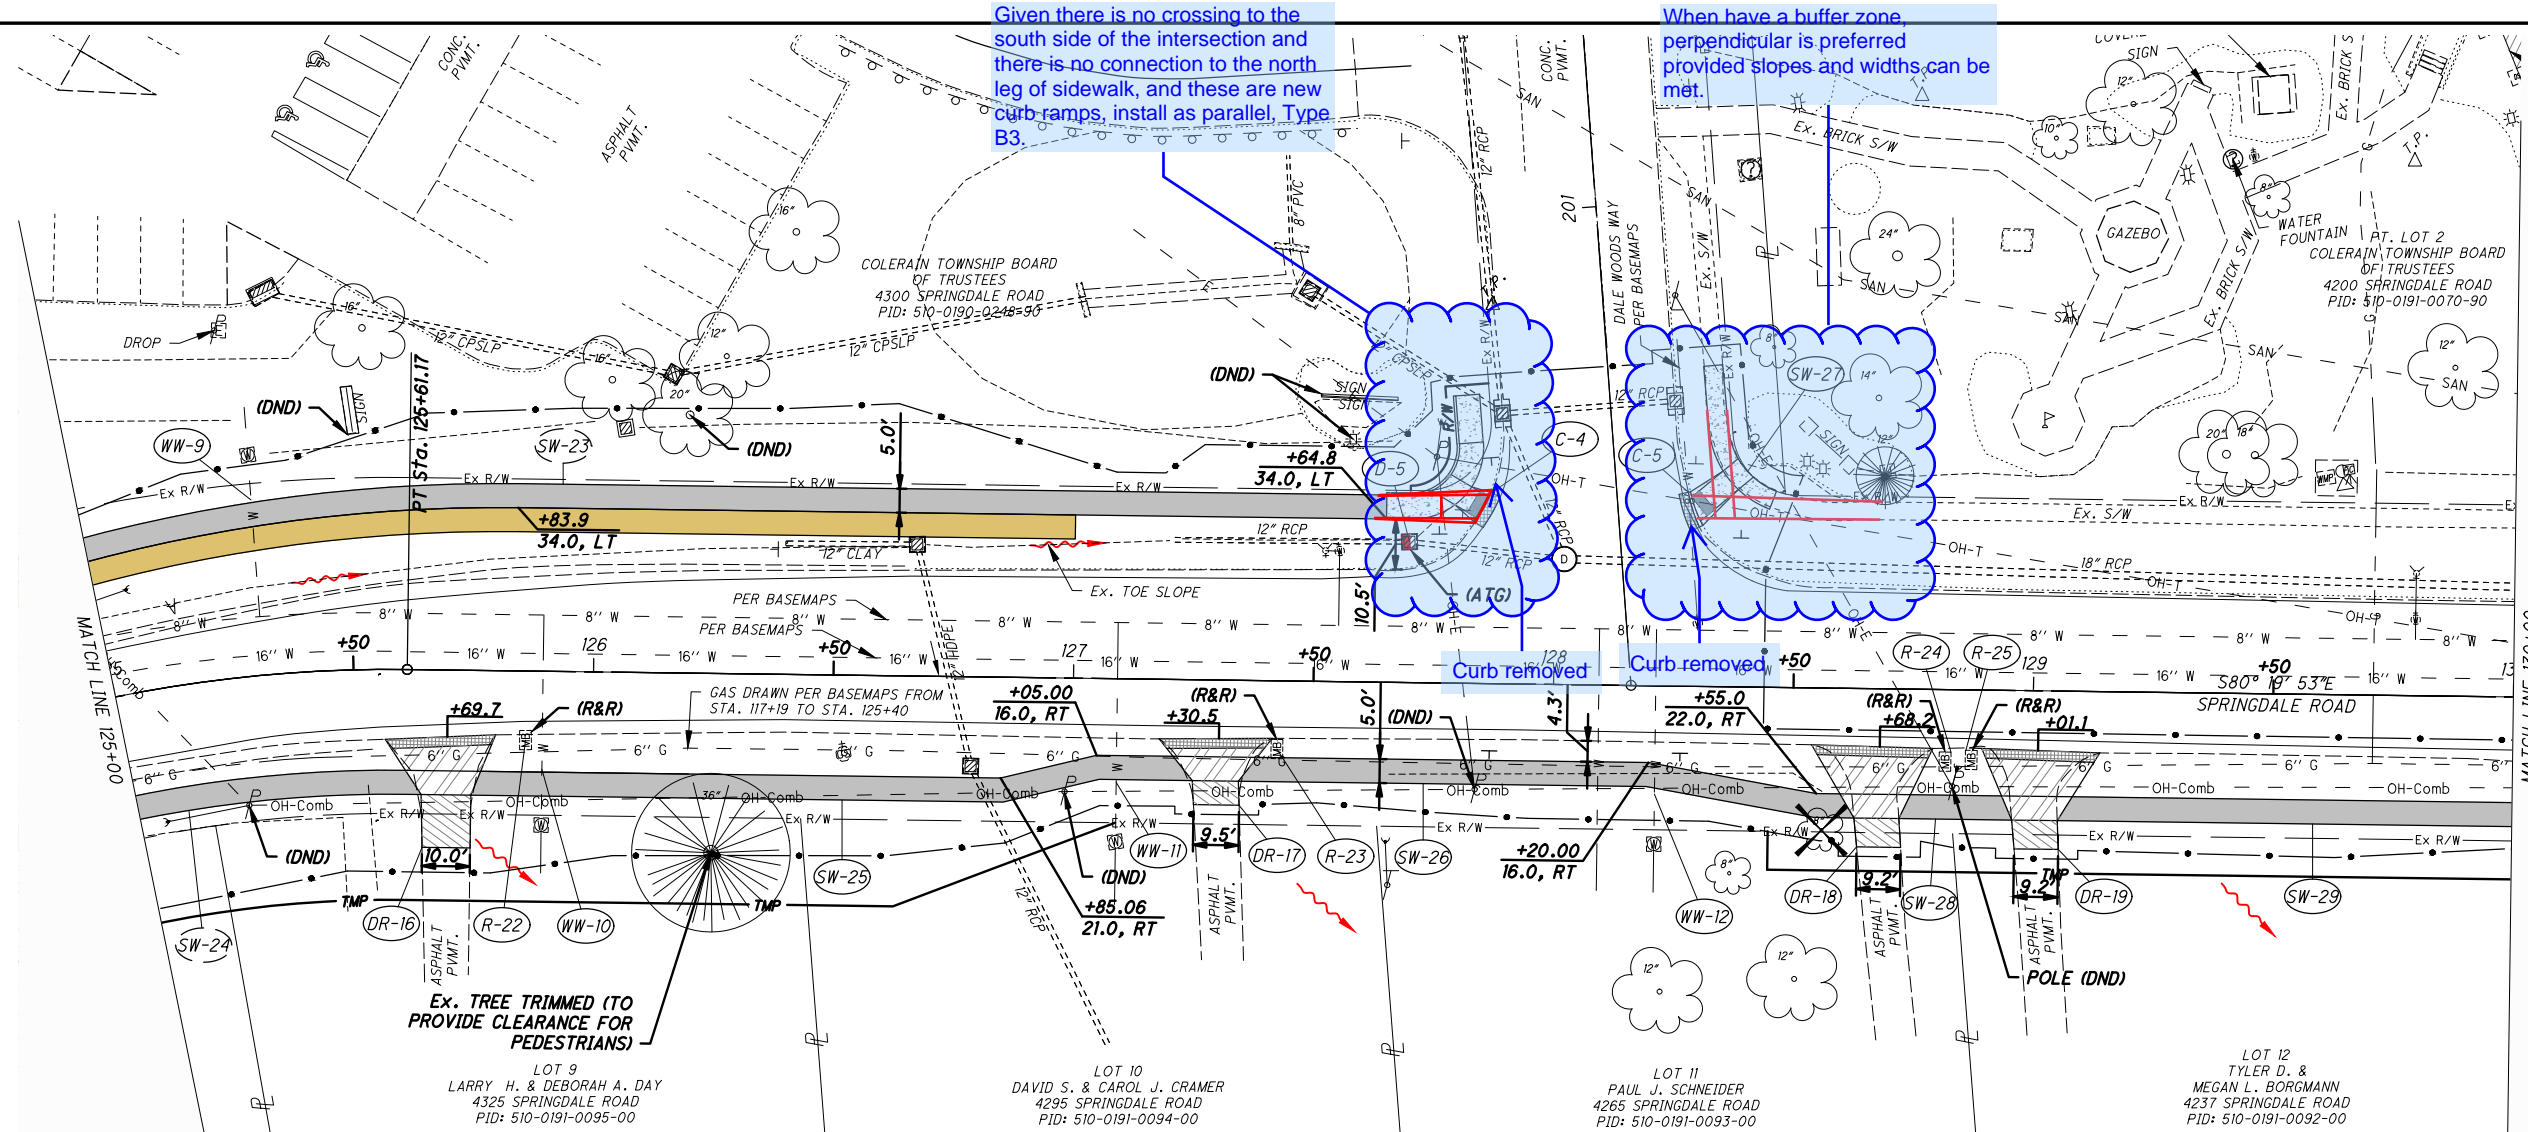


PLAN AND PROFILE - SPRINGDALE ROAD  
STA. 125+00 to STA. 130+00

DESIGN AGENCY



DESIGNER  
I JW  
REVIEWER  
BAW 7-23-2025  
PROJECT ID  
120861  
SHEET TOTAL  
P.21 53

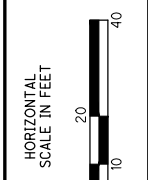


**PLAN AND PROFILE - SPRINGDALE ROAD**  
 STA. 130+00 to STA. 135+00

DESIGN AGENCY	
DESIGNER	IJW
REVIEWER	BAW 7-23-2025
PROJECT ID	120861
SHEET	P.22
TOTAL	53


COLERAIN TOWNSHIP BOARD OF TRUSTEES  
 4180 SPRINGDALE ROAD  
 PID: 510-0191-0071-90

END WORK: STA. 133+91.00

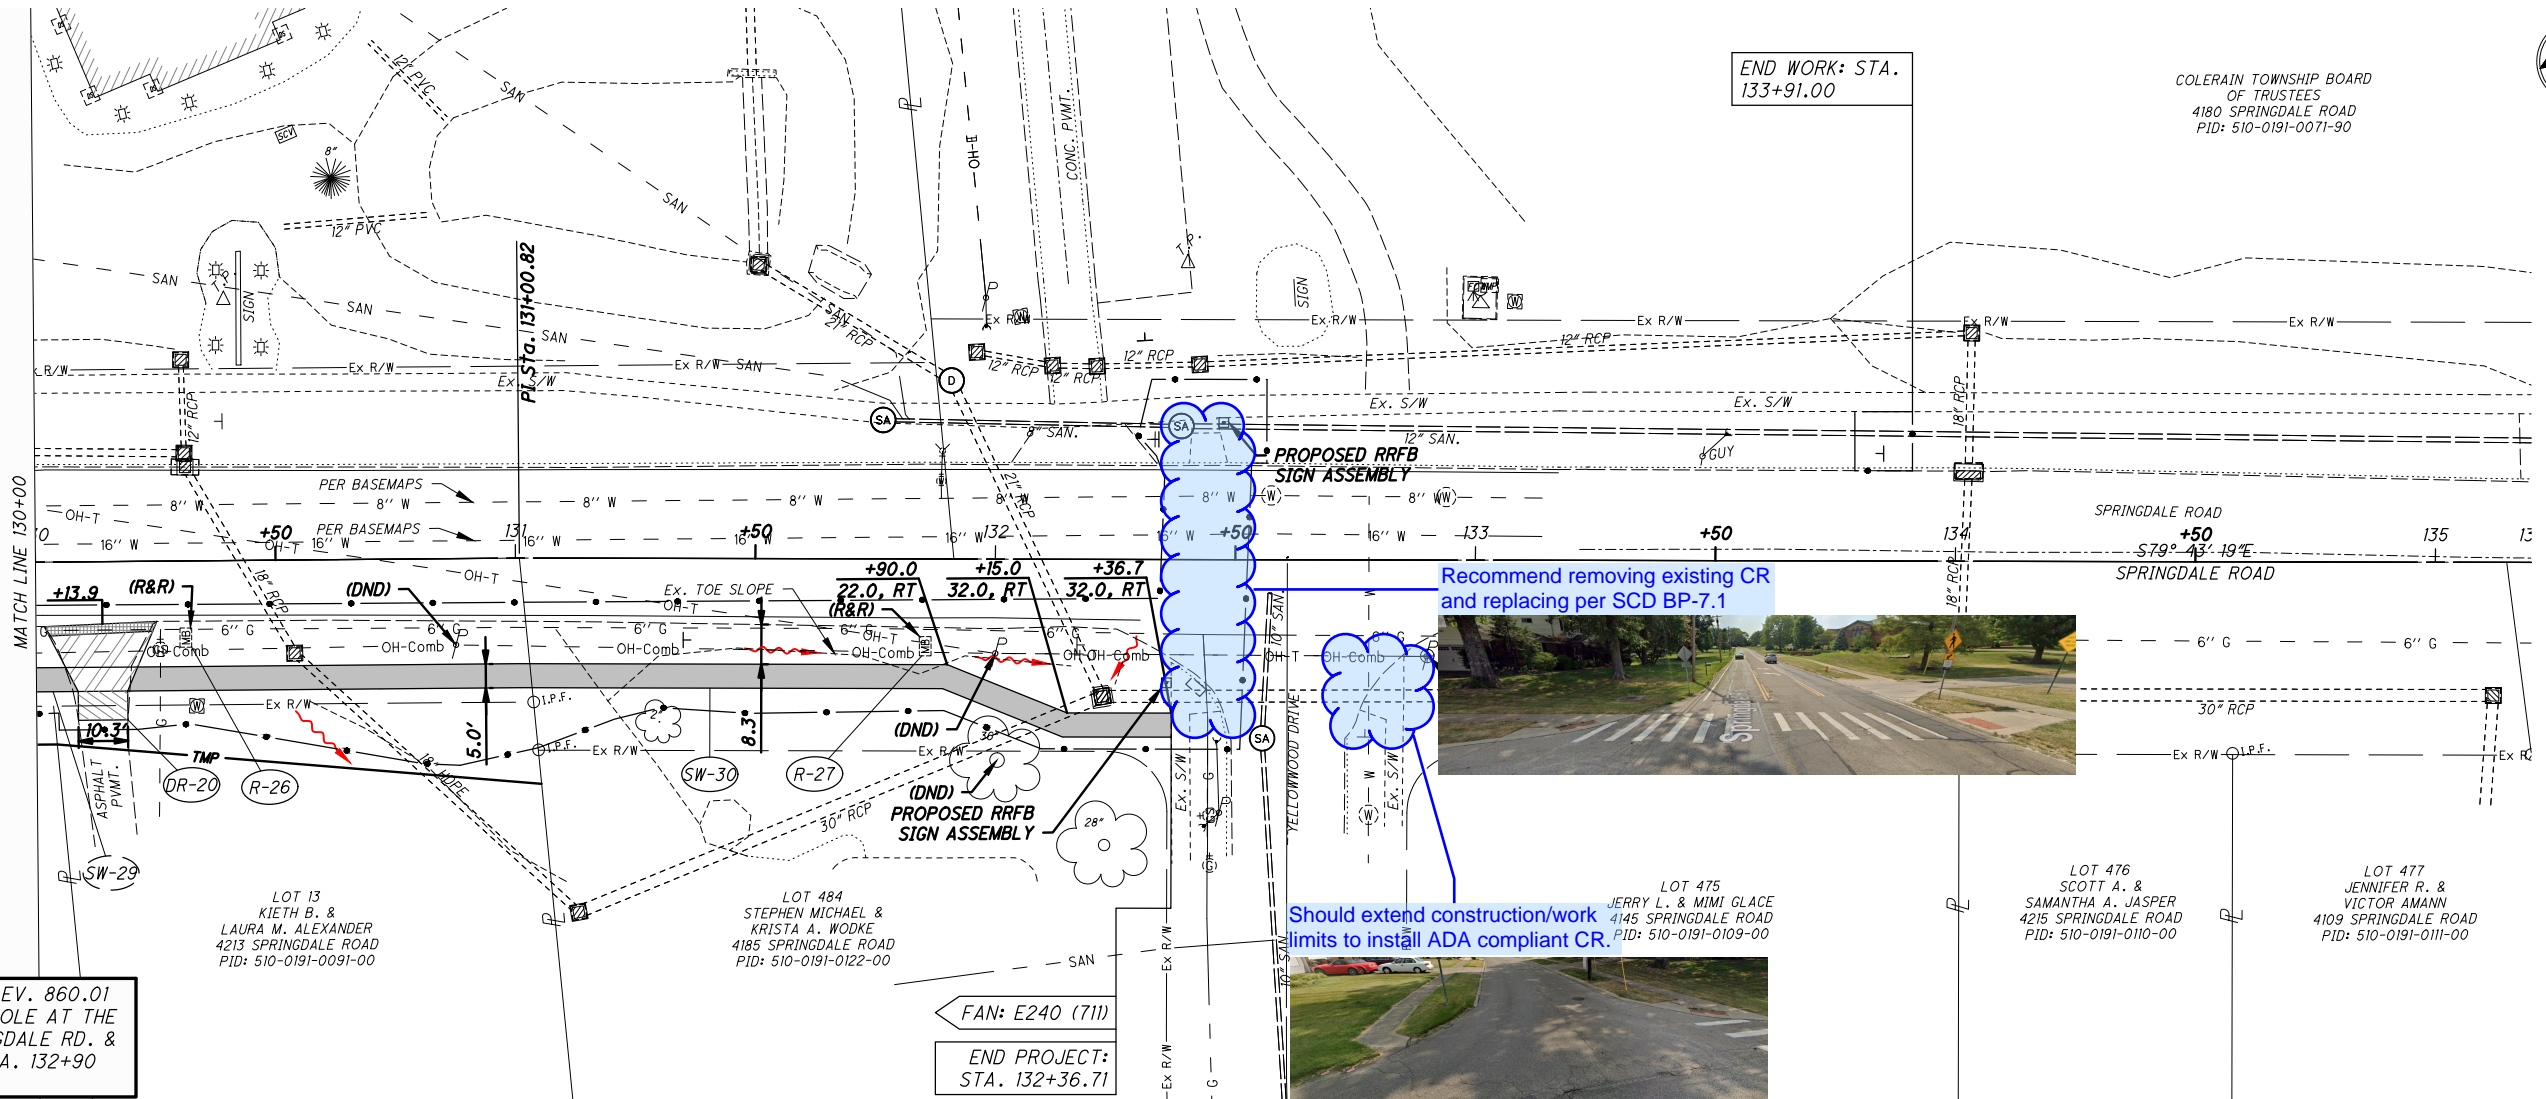

BENCHMARK #1 ELEV. 860.01  
 MAG NAIL IN POWER POLE AT THE SE CORNER OF SPRINGDALE RD. & YELLOWWOOD DR. @ STA. 132+90 RT.


END PROJECT: STA. 132+36.71

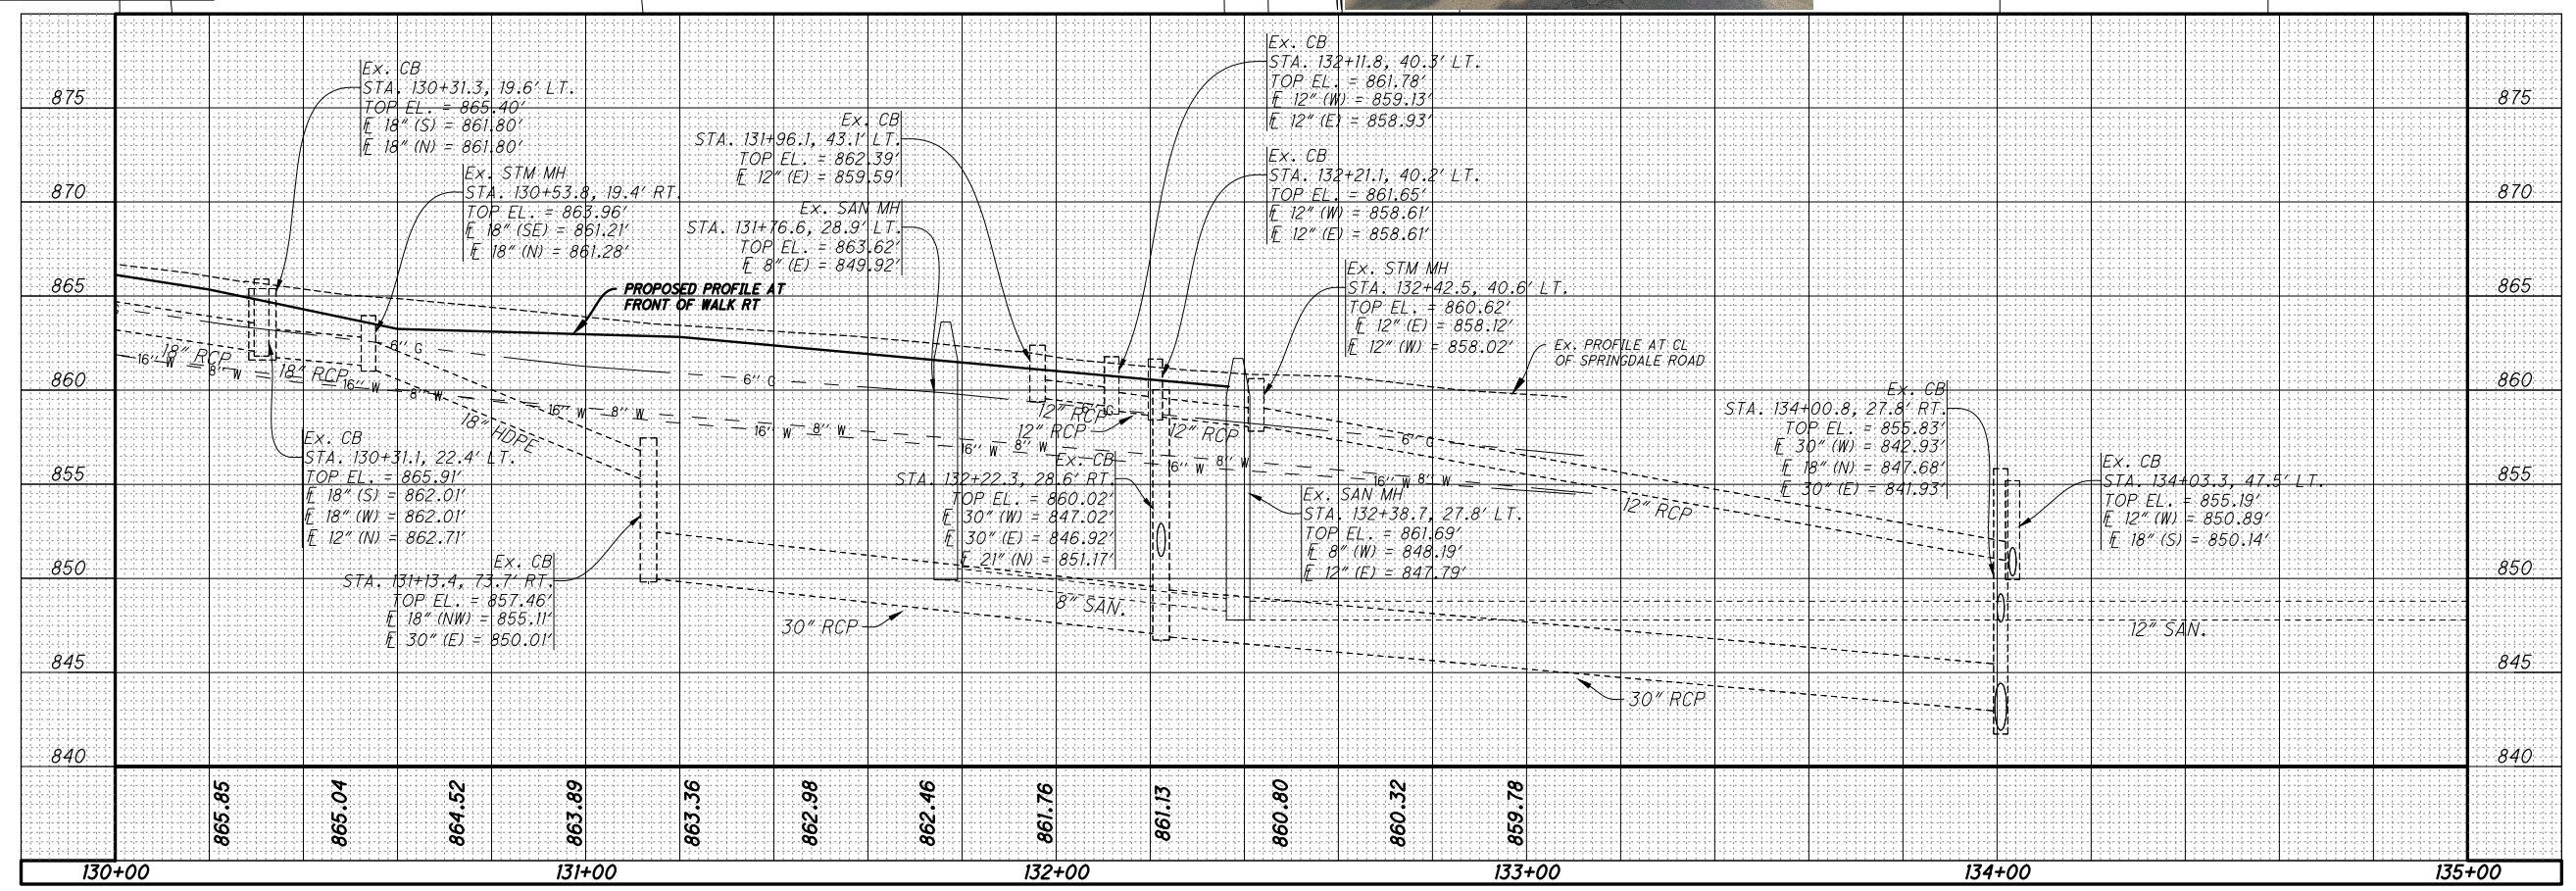

130+00	865.85	865.04	864.52	863.89	863.36	862.98	862.46	861.76	861.13	860.80	860.32	859.78	134+00	135+00
--------	--------	--------	--------	--------	--------	--------	--------	--------	--------	--------	--------	--------	--------	--------

SEEDING  
END SO.  
WIDTH YDS.

SEEDING AND MULCHING AREAS MEASURED IN AUTOCAD - QUANTITY SHOWN IN GENERAL NOTES

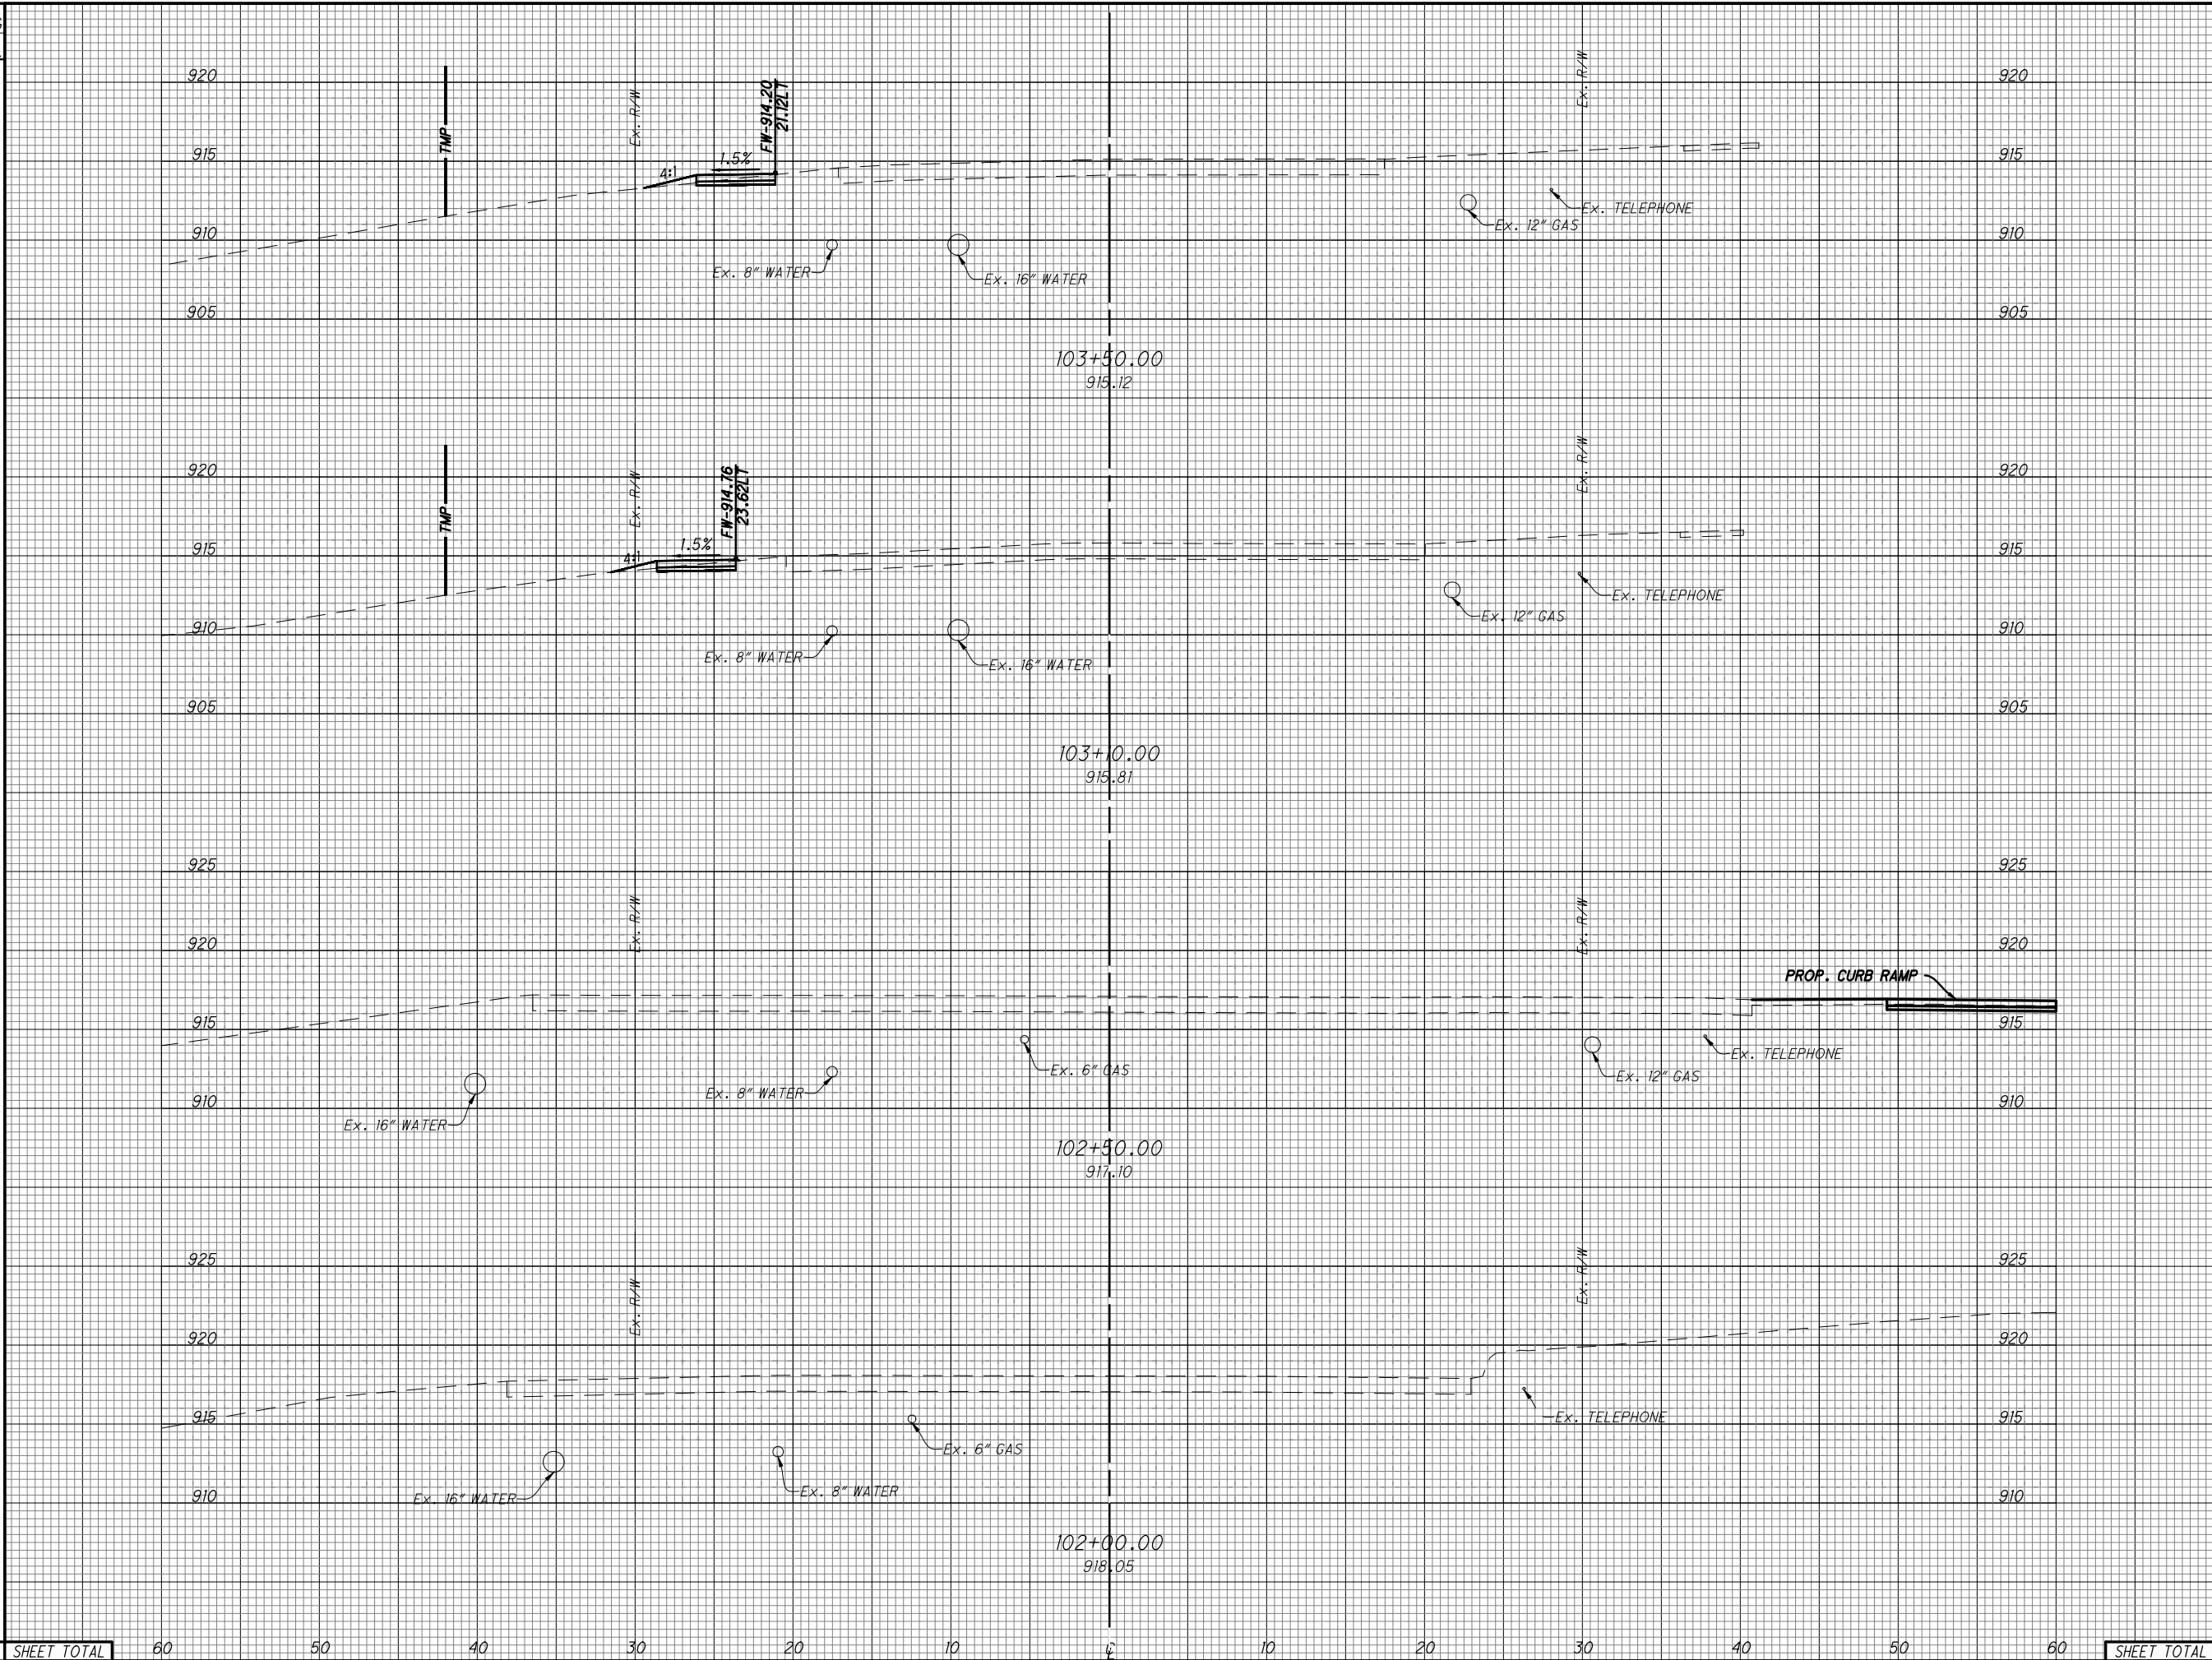

STATION	END AREA		VOLUME	
	CUT	FILL	CUT	FILL
103+50.00 919.12	1.2	0.8	1.8	1.1
103+10.00 915.81	1.2	0.7	1.3	0.8
102+50.00 917.10	0	0	0	0
102+00.00 918.05	0	0	0	0
<b>SHEET TOTAL</b>	<b>2.4</b>	<b>1.5</b>	<b>3.1</b>	<b>1.9</b>

CROSS SECTIONS - SPRINGDALE ROAD  
STA. 102+00 TO STA. 103+50

DESIGN AGENCY



CHOICE ONE ENGINEERING

DESIGNER

IJW

REVIEWER

BAW 7-23-2025

PROJECT ID


120861

SHEET TOTAL

P.23 53

SEEDING  
END SO.  
WIDTH YDS.


SEEDING AND MULCHING AREAS MEASURED IN AUTOCAD - QUANTITY SHOWN IN GENERAL NOTES

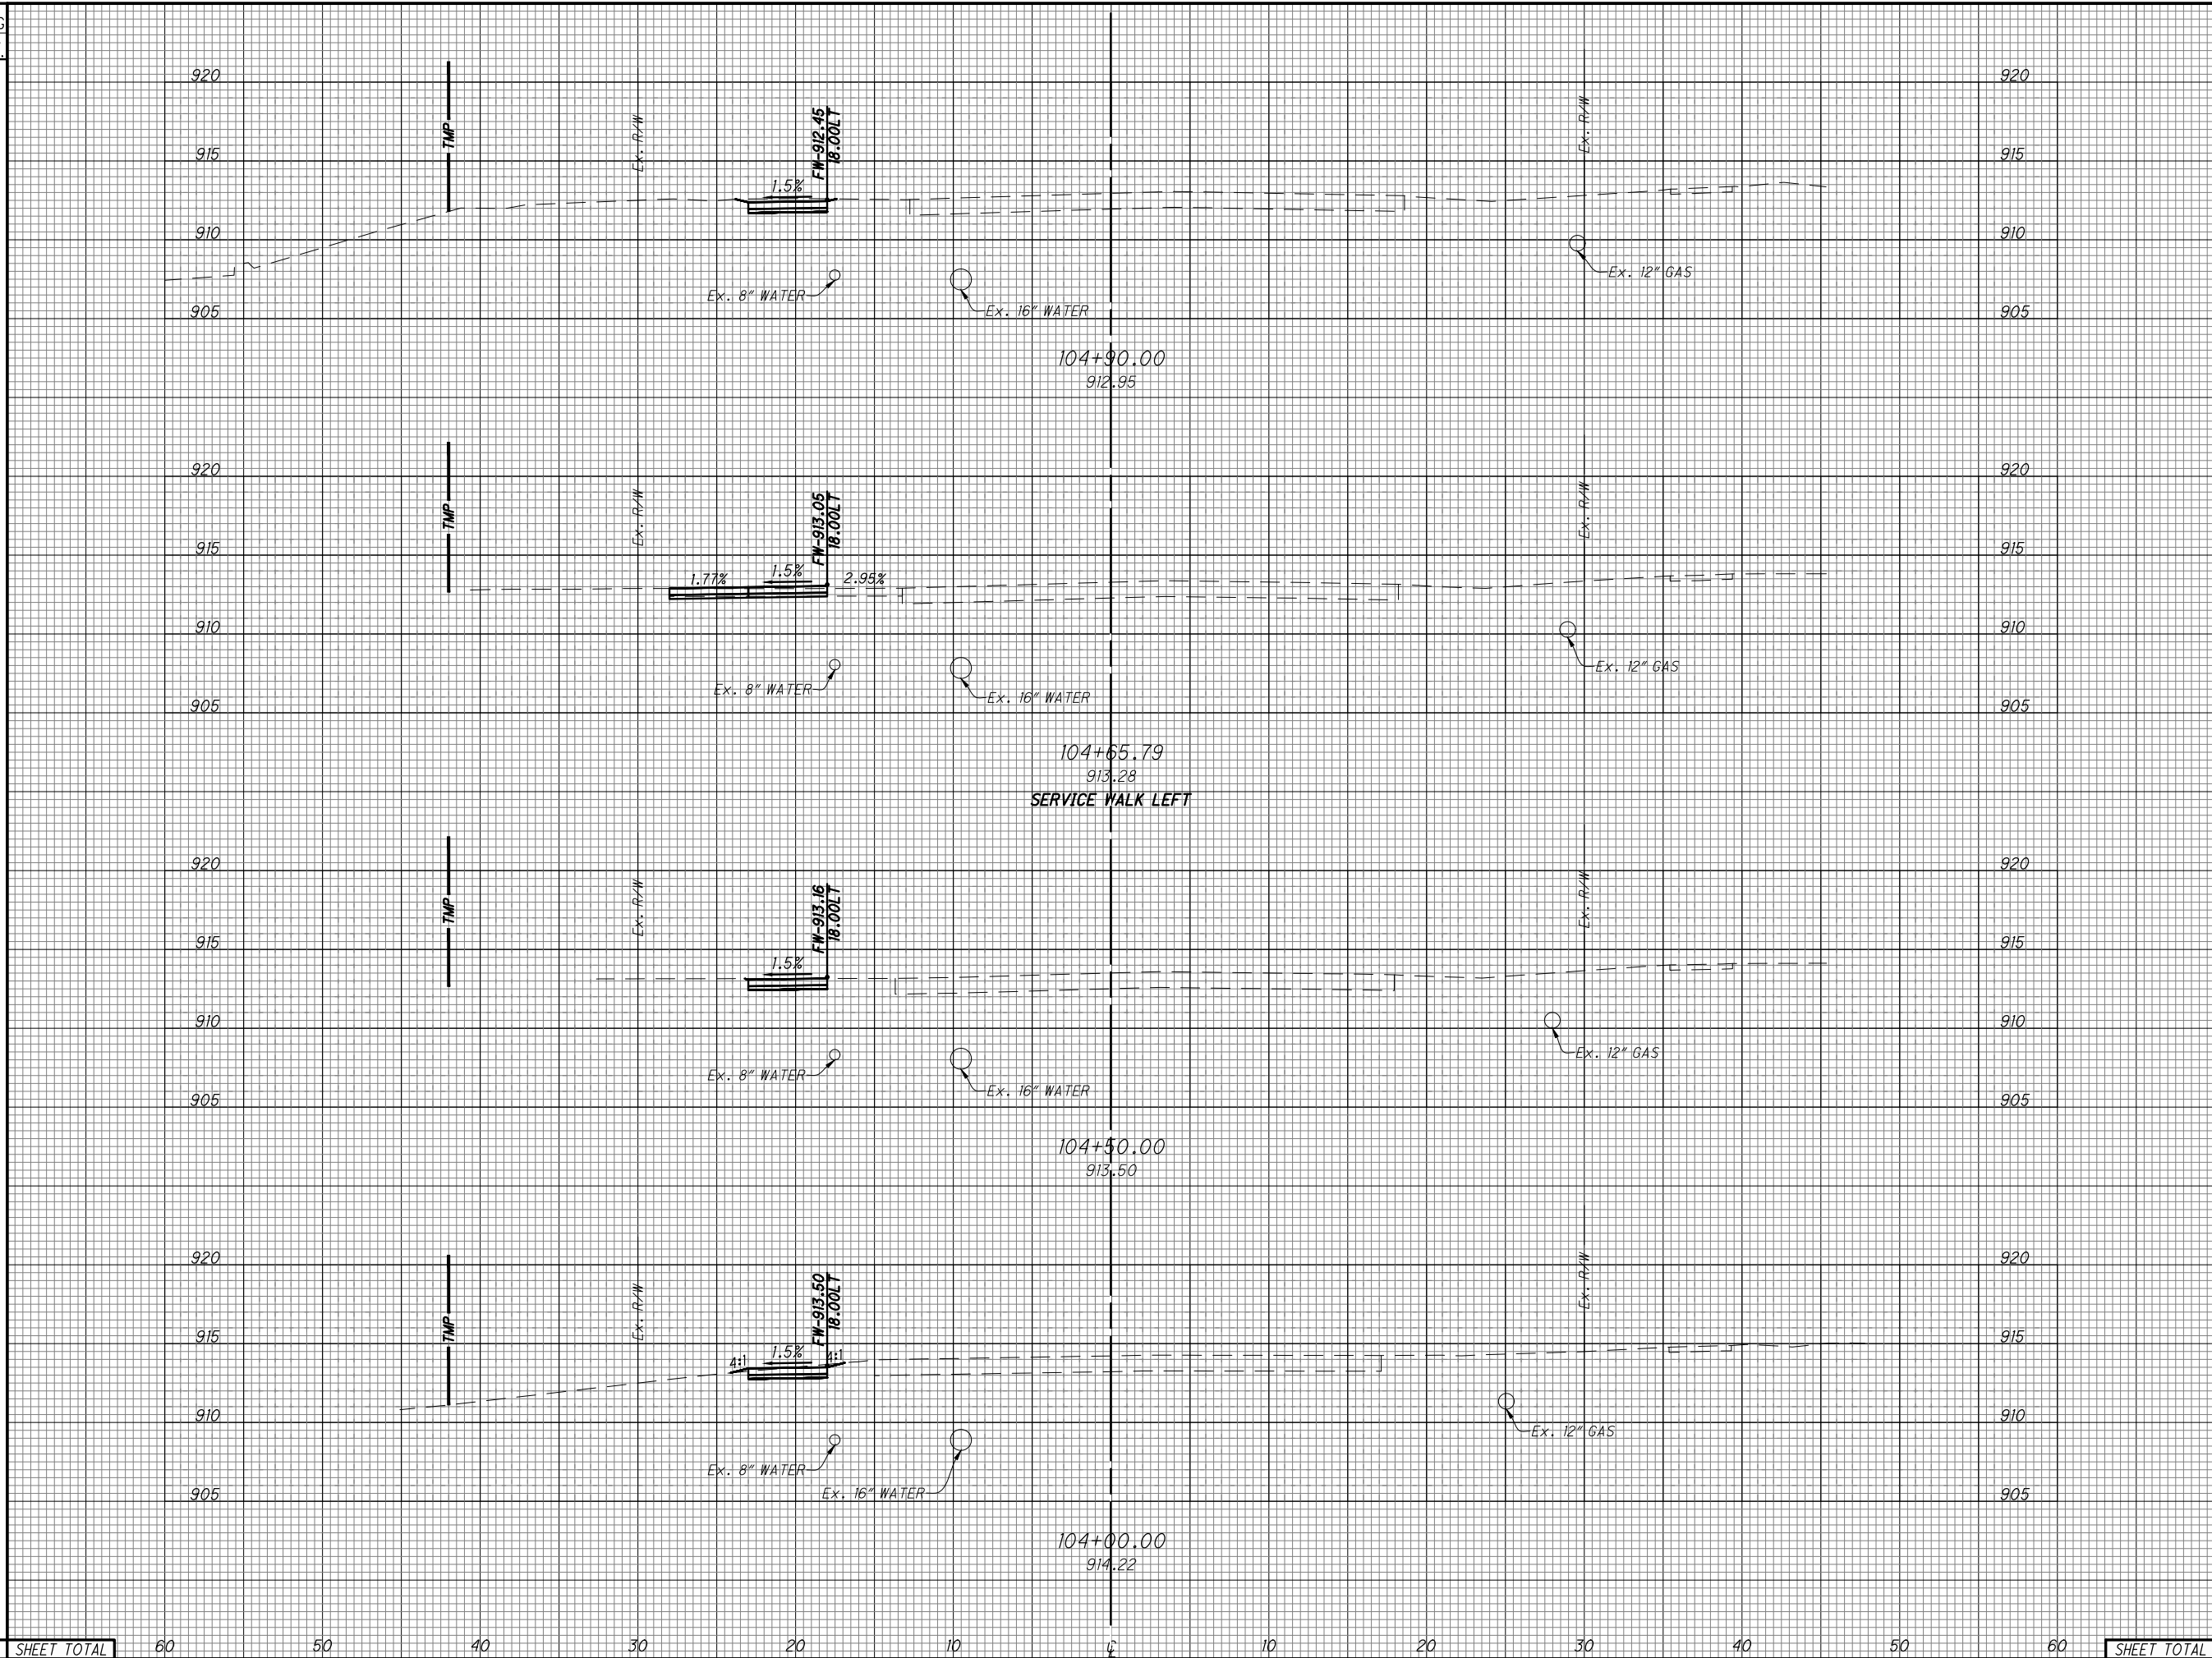

END AREA	VOLUME	
	CUT	FILL
1.4	0	0
1.0	0.2	0
0.8	0.4	0
0.6	0.1	0
1.3	0	0
2.5	0.1	0
1.4	0.1	0
2.4	0.1	0
<b>4.9</b>	<b>0.5</b>	<b>6.5</b>

SHEET TOTAL 60 50 40 30 20 10 0 10 20 30 40 50 60 SHEET TOTAL 4.9 0.5 6.5 0.5

CROSS SECTIONS - SPRINGDALE ROAD  
STA. 104+00 TO STA. 104+90

DESIGN AGENCY  
  
 CHOICE ONE ENGINEERING  
 DESIGNER  
 IJW  
 REVIEWER  
 BAW 7-23-2025  
 PROJECT ID  
 120861  
 SHEET TOTAL  
 P.24 53



SEEDING  
END SO.  
WIDTH YDS.

SEEDING AND MULCHING AREAS MEASURED IN AUTOCAD - QUANTITY SHOWN IN GENERAL NOTES



SEE DRIVE DETAILS SHEET FOR DRIVE PROFILE

General Comment: When cross referencing, identify sheet number.

END AREA		VOLUME	
CUT	FILL	CUT	FILL
1.4	0.4	2.5	0.5
1.3	0.1	1.3	0
2.7	0	4.5	0
7.6	0	3.1	0
<b>13.0</b>	<b>0.5</b>	<b>11.4</b>	<b>0.5</b>

CROSS SECTIONS - SPRINGDALE ROAD  
STA. 105+08.80 TO STA. 106+00

DESIGN AGENCY



CHOICE ONE ENGINEERING

DESIGNER

IJW

REVIEWER

BAW 7-23-2025

PROJECT ID

120861


SHEET TOTAL

P.25 53

SEEDING  
END SO.  
WIDTH YDS.


SEEDING AND MULCHING AREAS MEASURED IN AUTOCAD - QUANTITY SHOWN IN GENERAL NOTES

A 4:1 slope seems feasible and is recommended to be installed where possible.

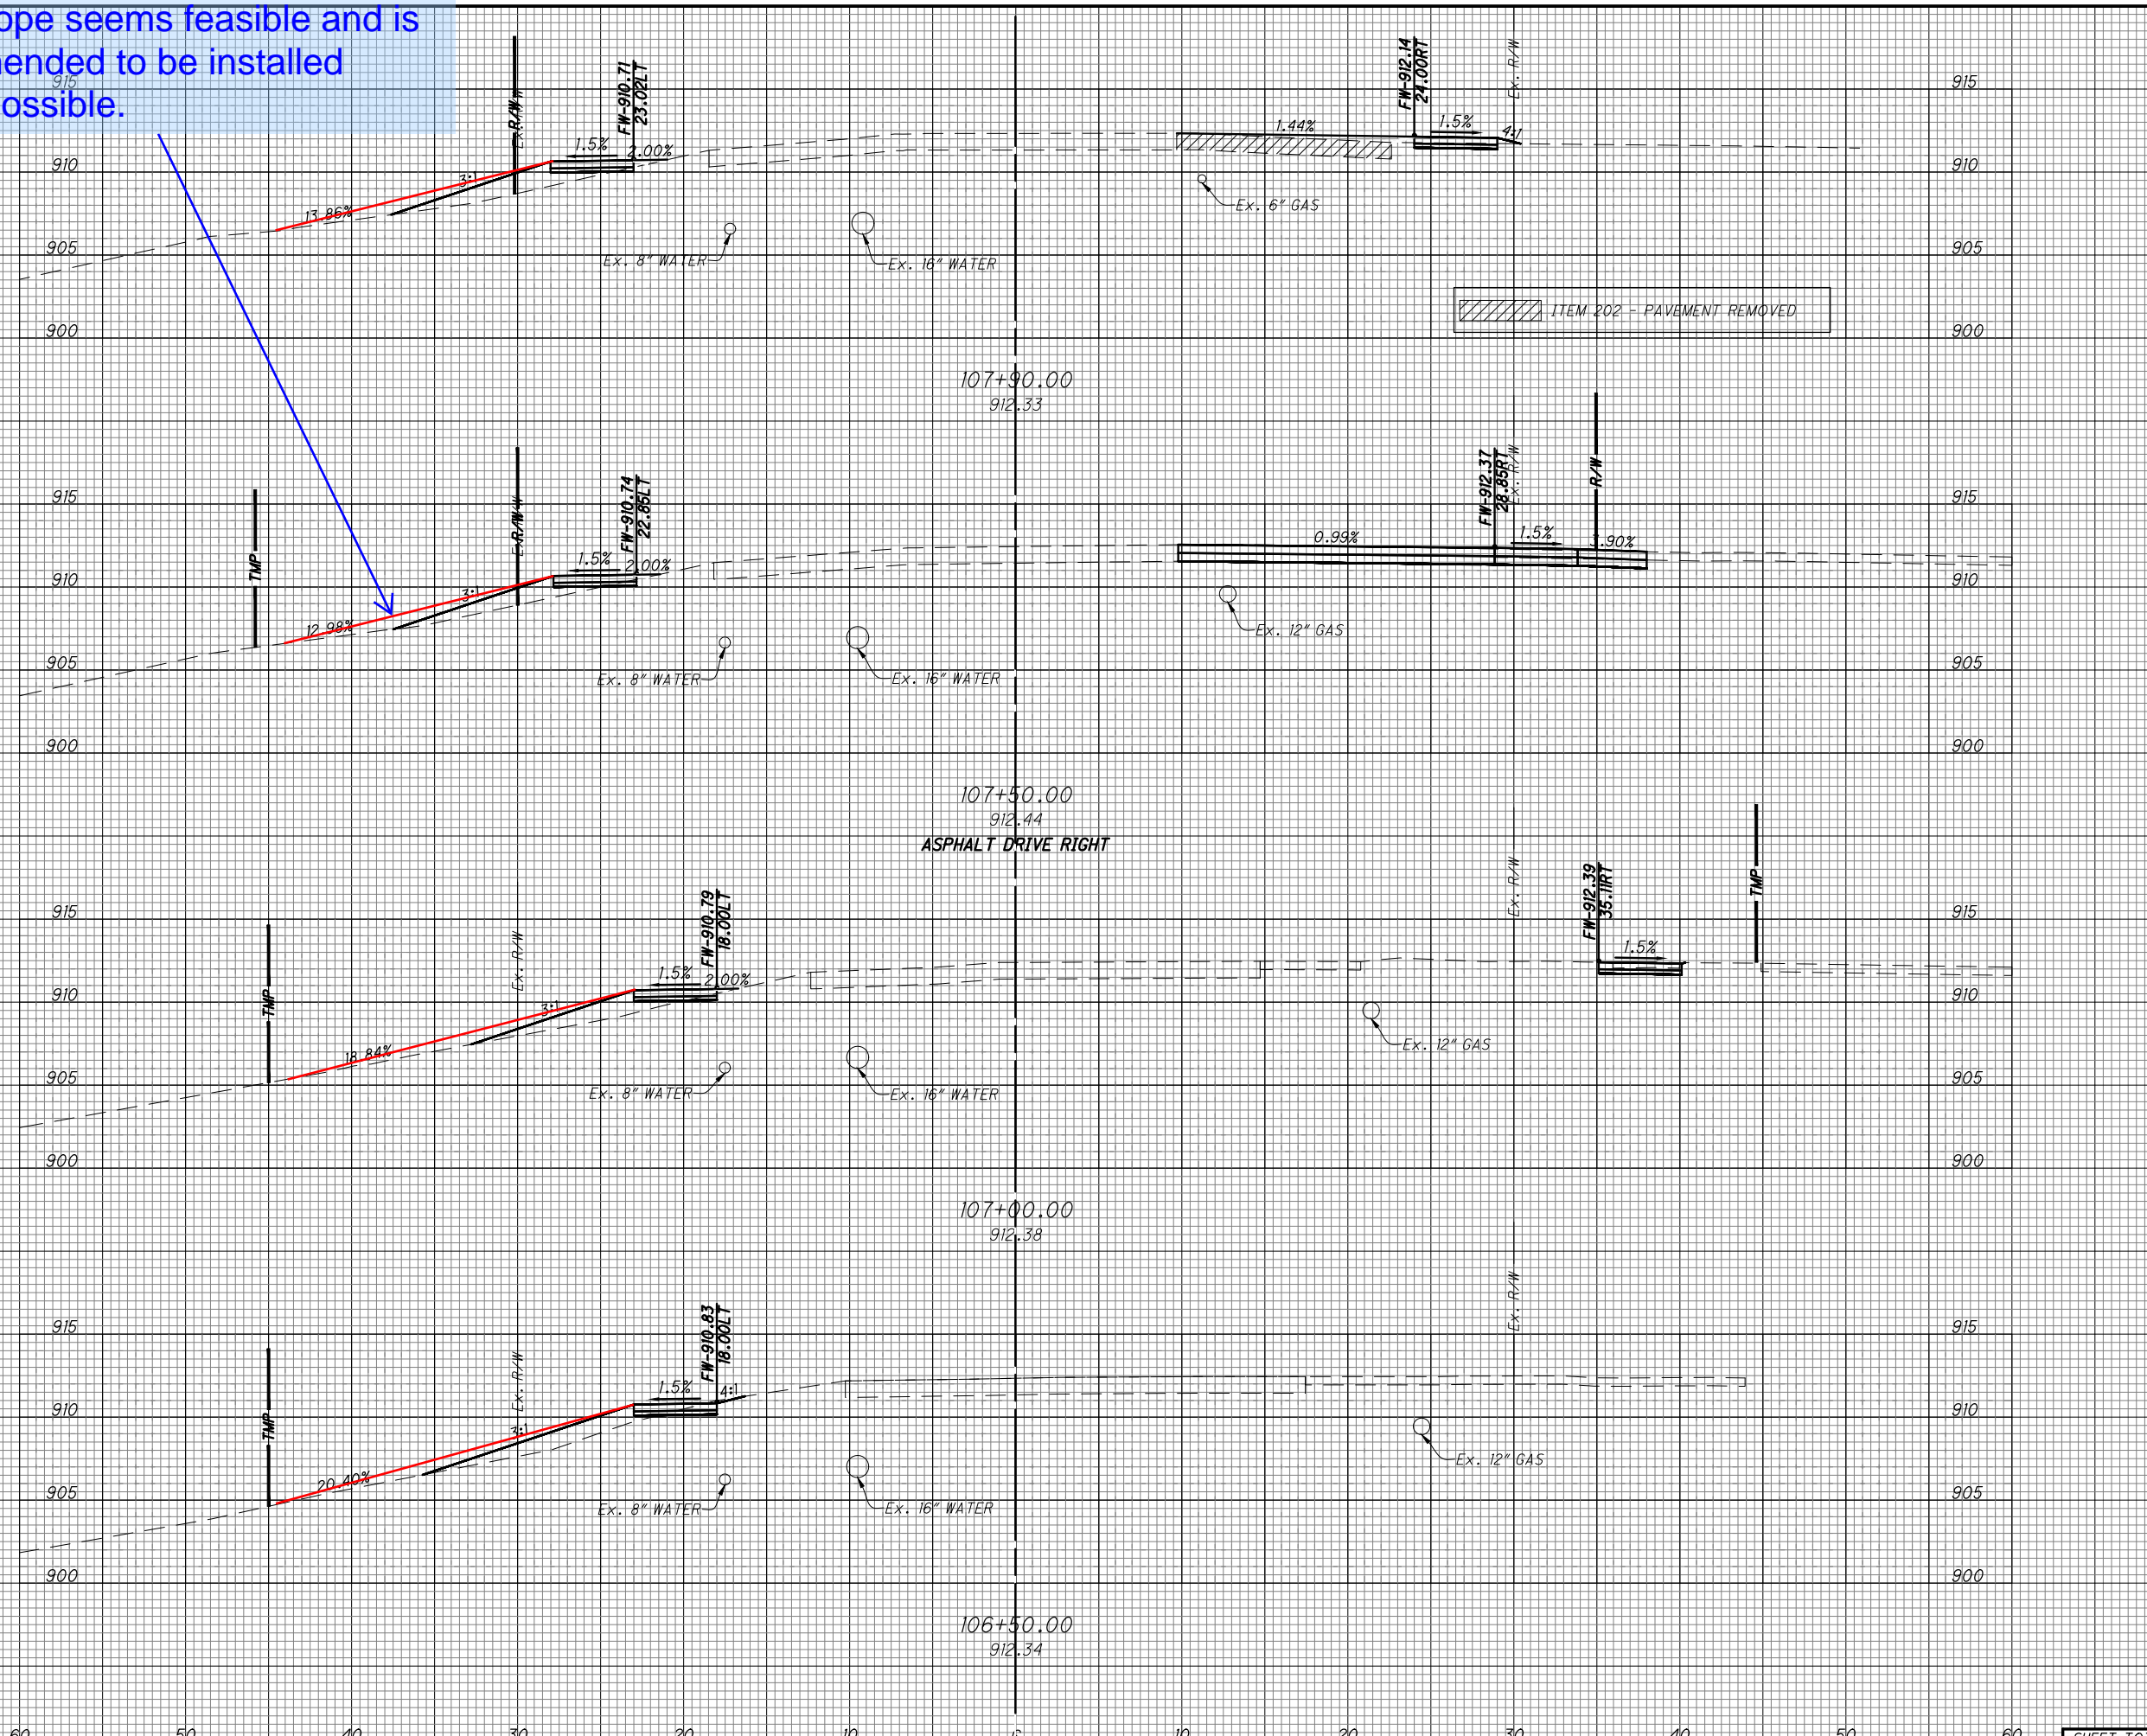


END AREA	VOLUME	
	CUT	FILL
1.4	24.1	
14.8	23.9	
18.6	8.2	
18.7	15.3	
1.6	8.3	
2.3	16.7	
0.9	9.7	
2.1	9.4	
<b>22.5</b>	<b>50.3</b>	<b>37.9</b>

CROSS SECTIONS - SPRINGDALE ROAD  
STA. 106+50 TO STA. 107+90

DESIGN AGENCY  
  
 CHOICE ONE ENGINEERING  
 DESIGNER  
 IJW  
 REVIEWER  
 BAW 7-23-2025  
 PROJECT ID  
 120861  
 SHEET TOTAL  
 P.26 53


SEEDING  
END SO.  
WIDTH YDS.

SEEDING AND MULCHING AREAS MEASURED IN AUTOCAD - QUANTITY SHOWN IN GENERAL NOTES

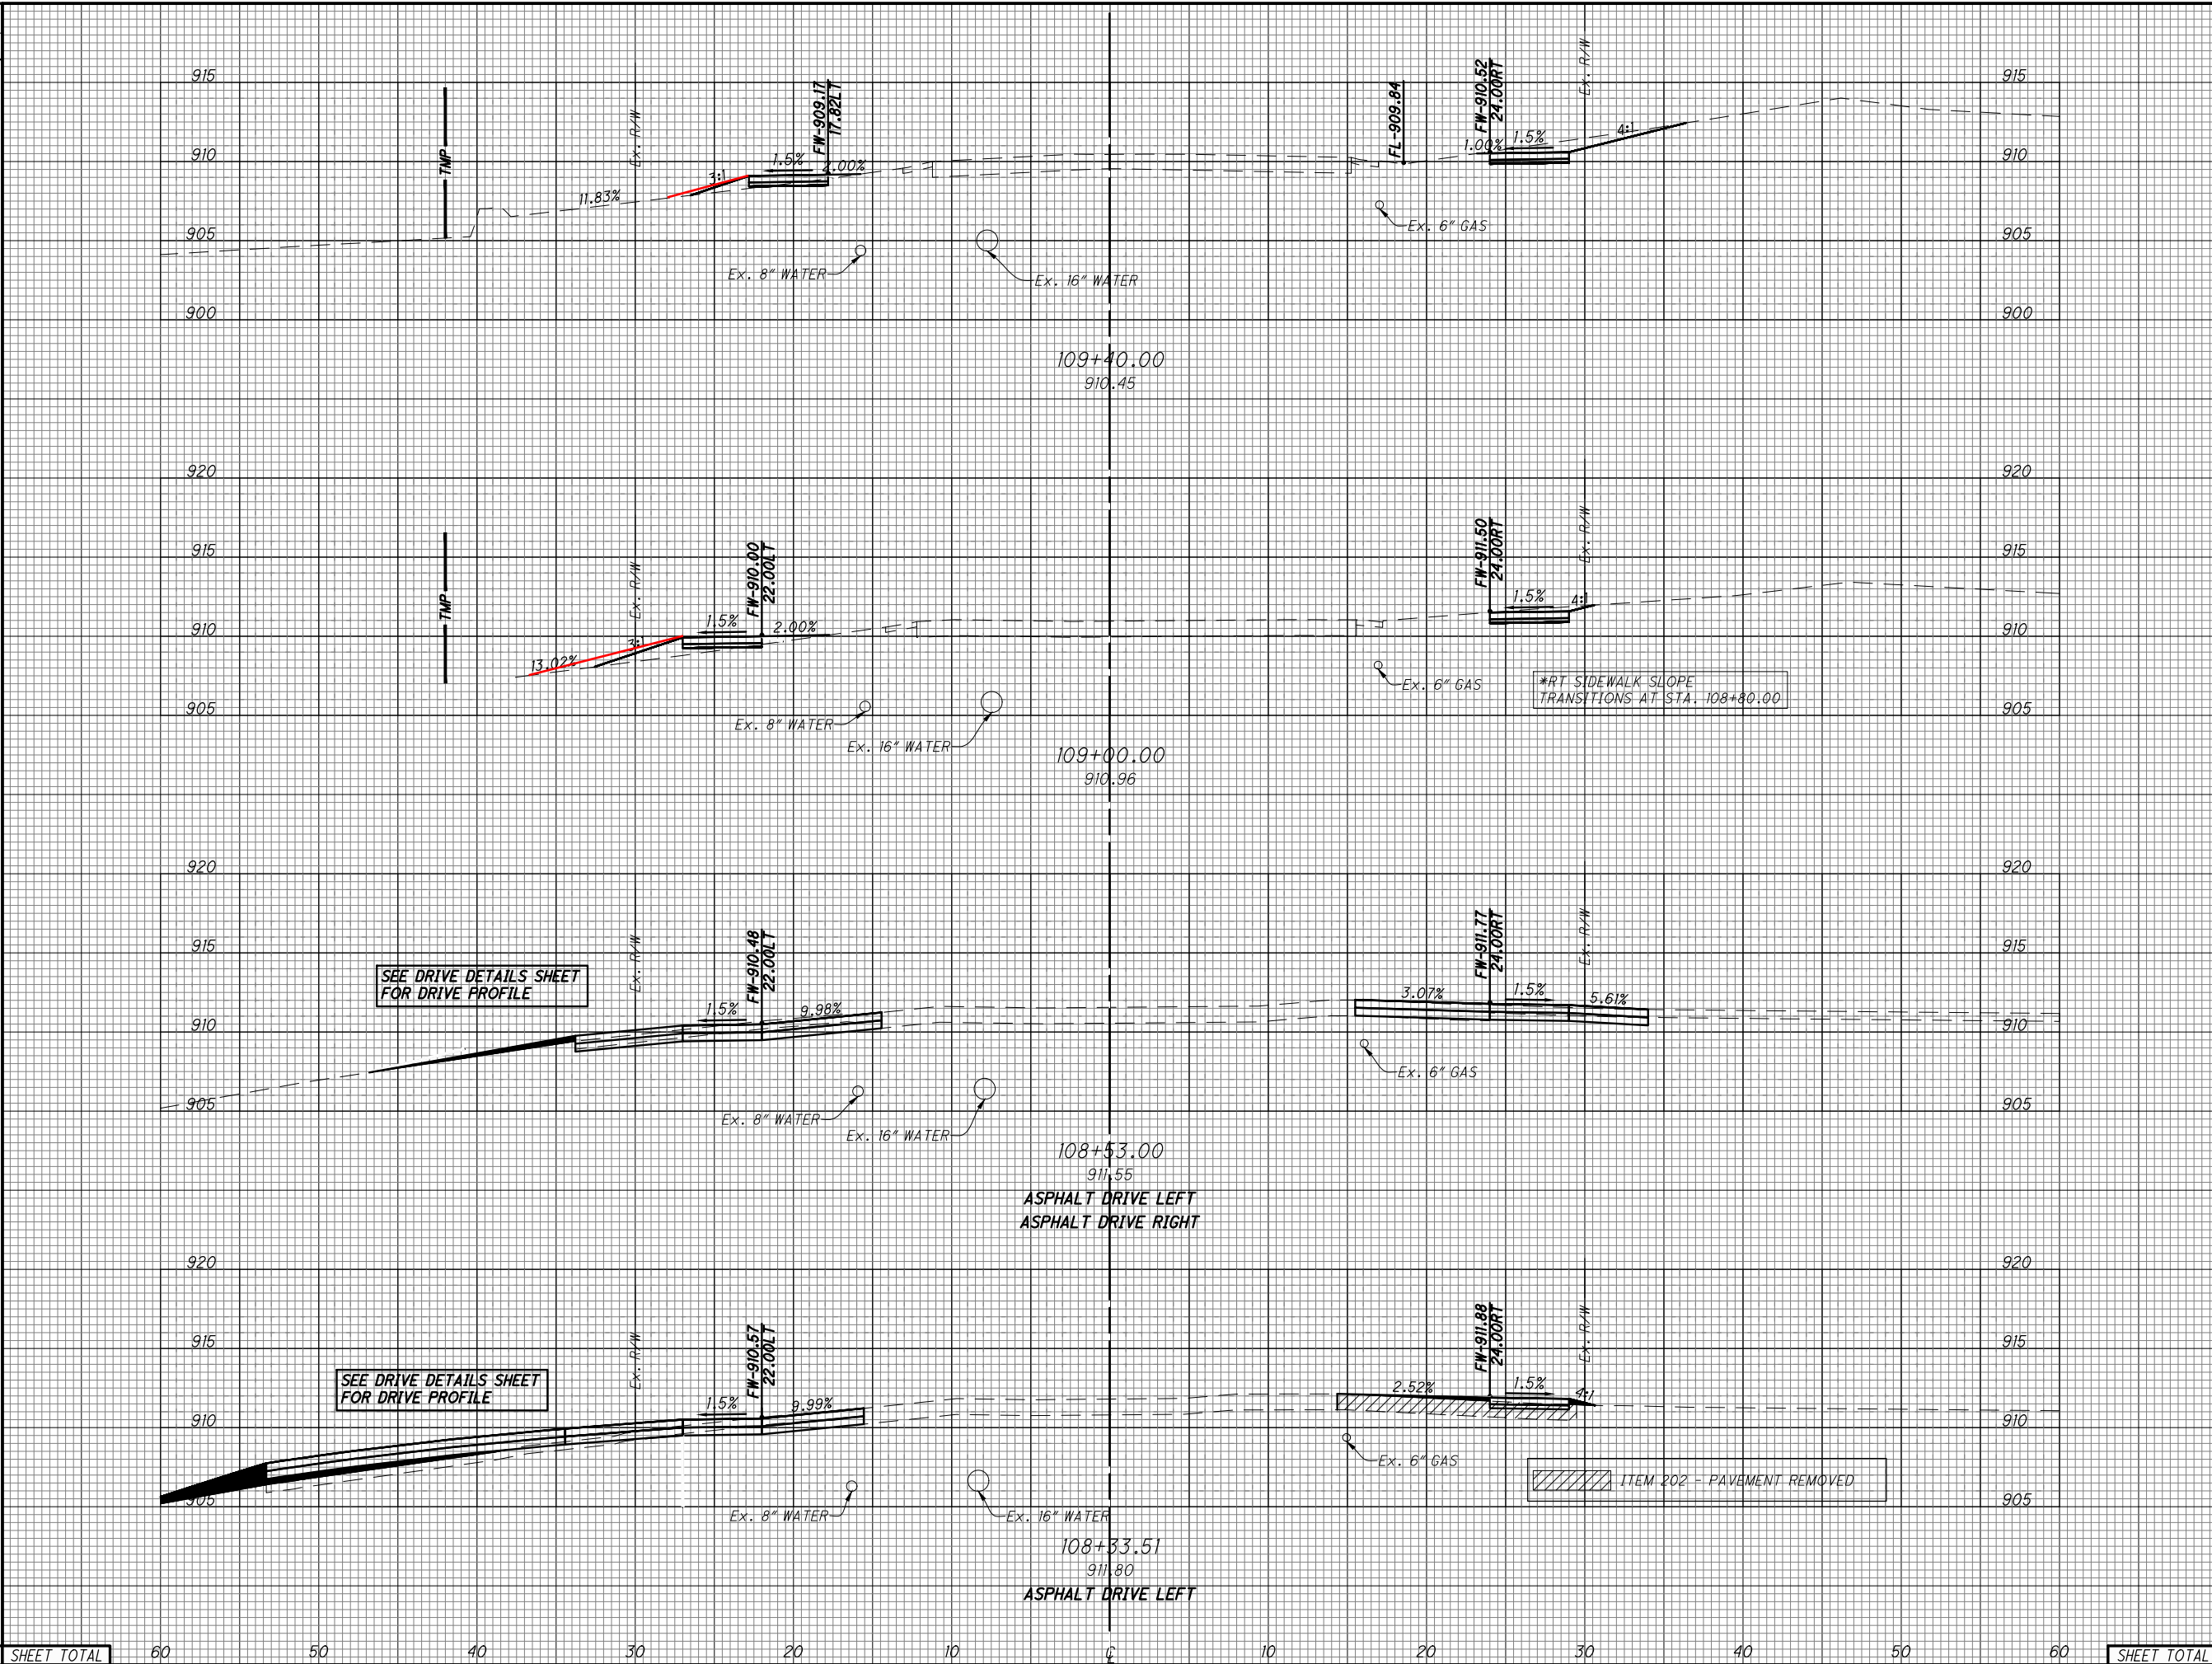

END AREA	VOLUME	
	CUT	FILL
4.7	1.8	
4.7	5.0	
1.6	5.0	
21.1	6.4	
22.6	2.3	
11.0	11.9	
7.8	30.7	
7.4	44.1	
<b>36.7</b>	<b>39.8</b>	<b>67.4</b>


**CROSS SECTIONS - SPRINGDALE ROAD  
STA. 108+33.51 TO STA. 109+40**

DESIGN AGENCY  
  
 CHOICE ONE ENGINEERING  
 DESIGNER  
 IJW  
 REVIEWER  
 BAW 7-23-2025  
 PROJECT ID  
 120861  
 SHEET TOTAL  
 P.27 53

SHEET TOTAL 60 50 40 30 20 10 0 10 20 30 40 50 60 SHEET TOTAL 36.7 39.8 67.4

SEEDING	SO.
END WIDTH	YDS.


SEEDING AND MULCHING AREAS MEASURED IN AUTOCAD - QUANTITY SHOWN IN GENERAL NOTES

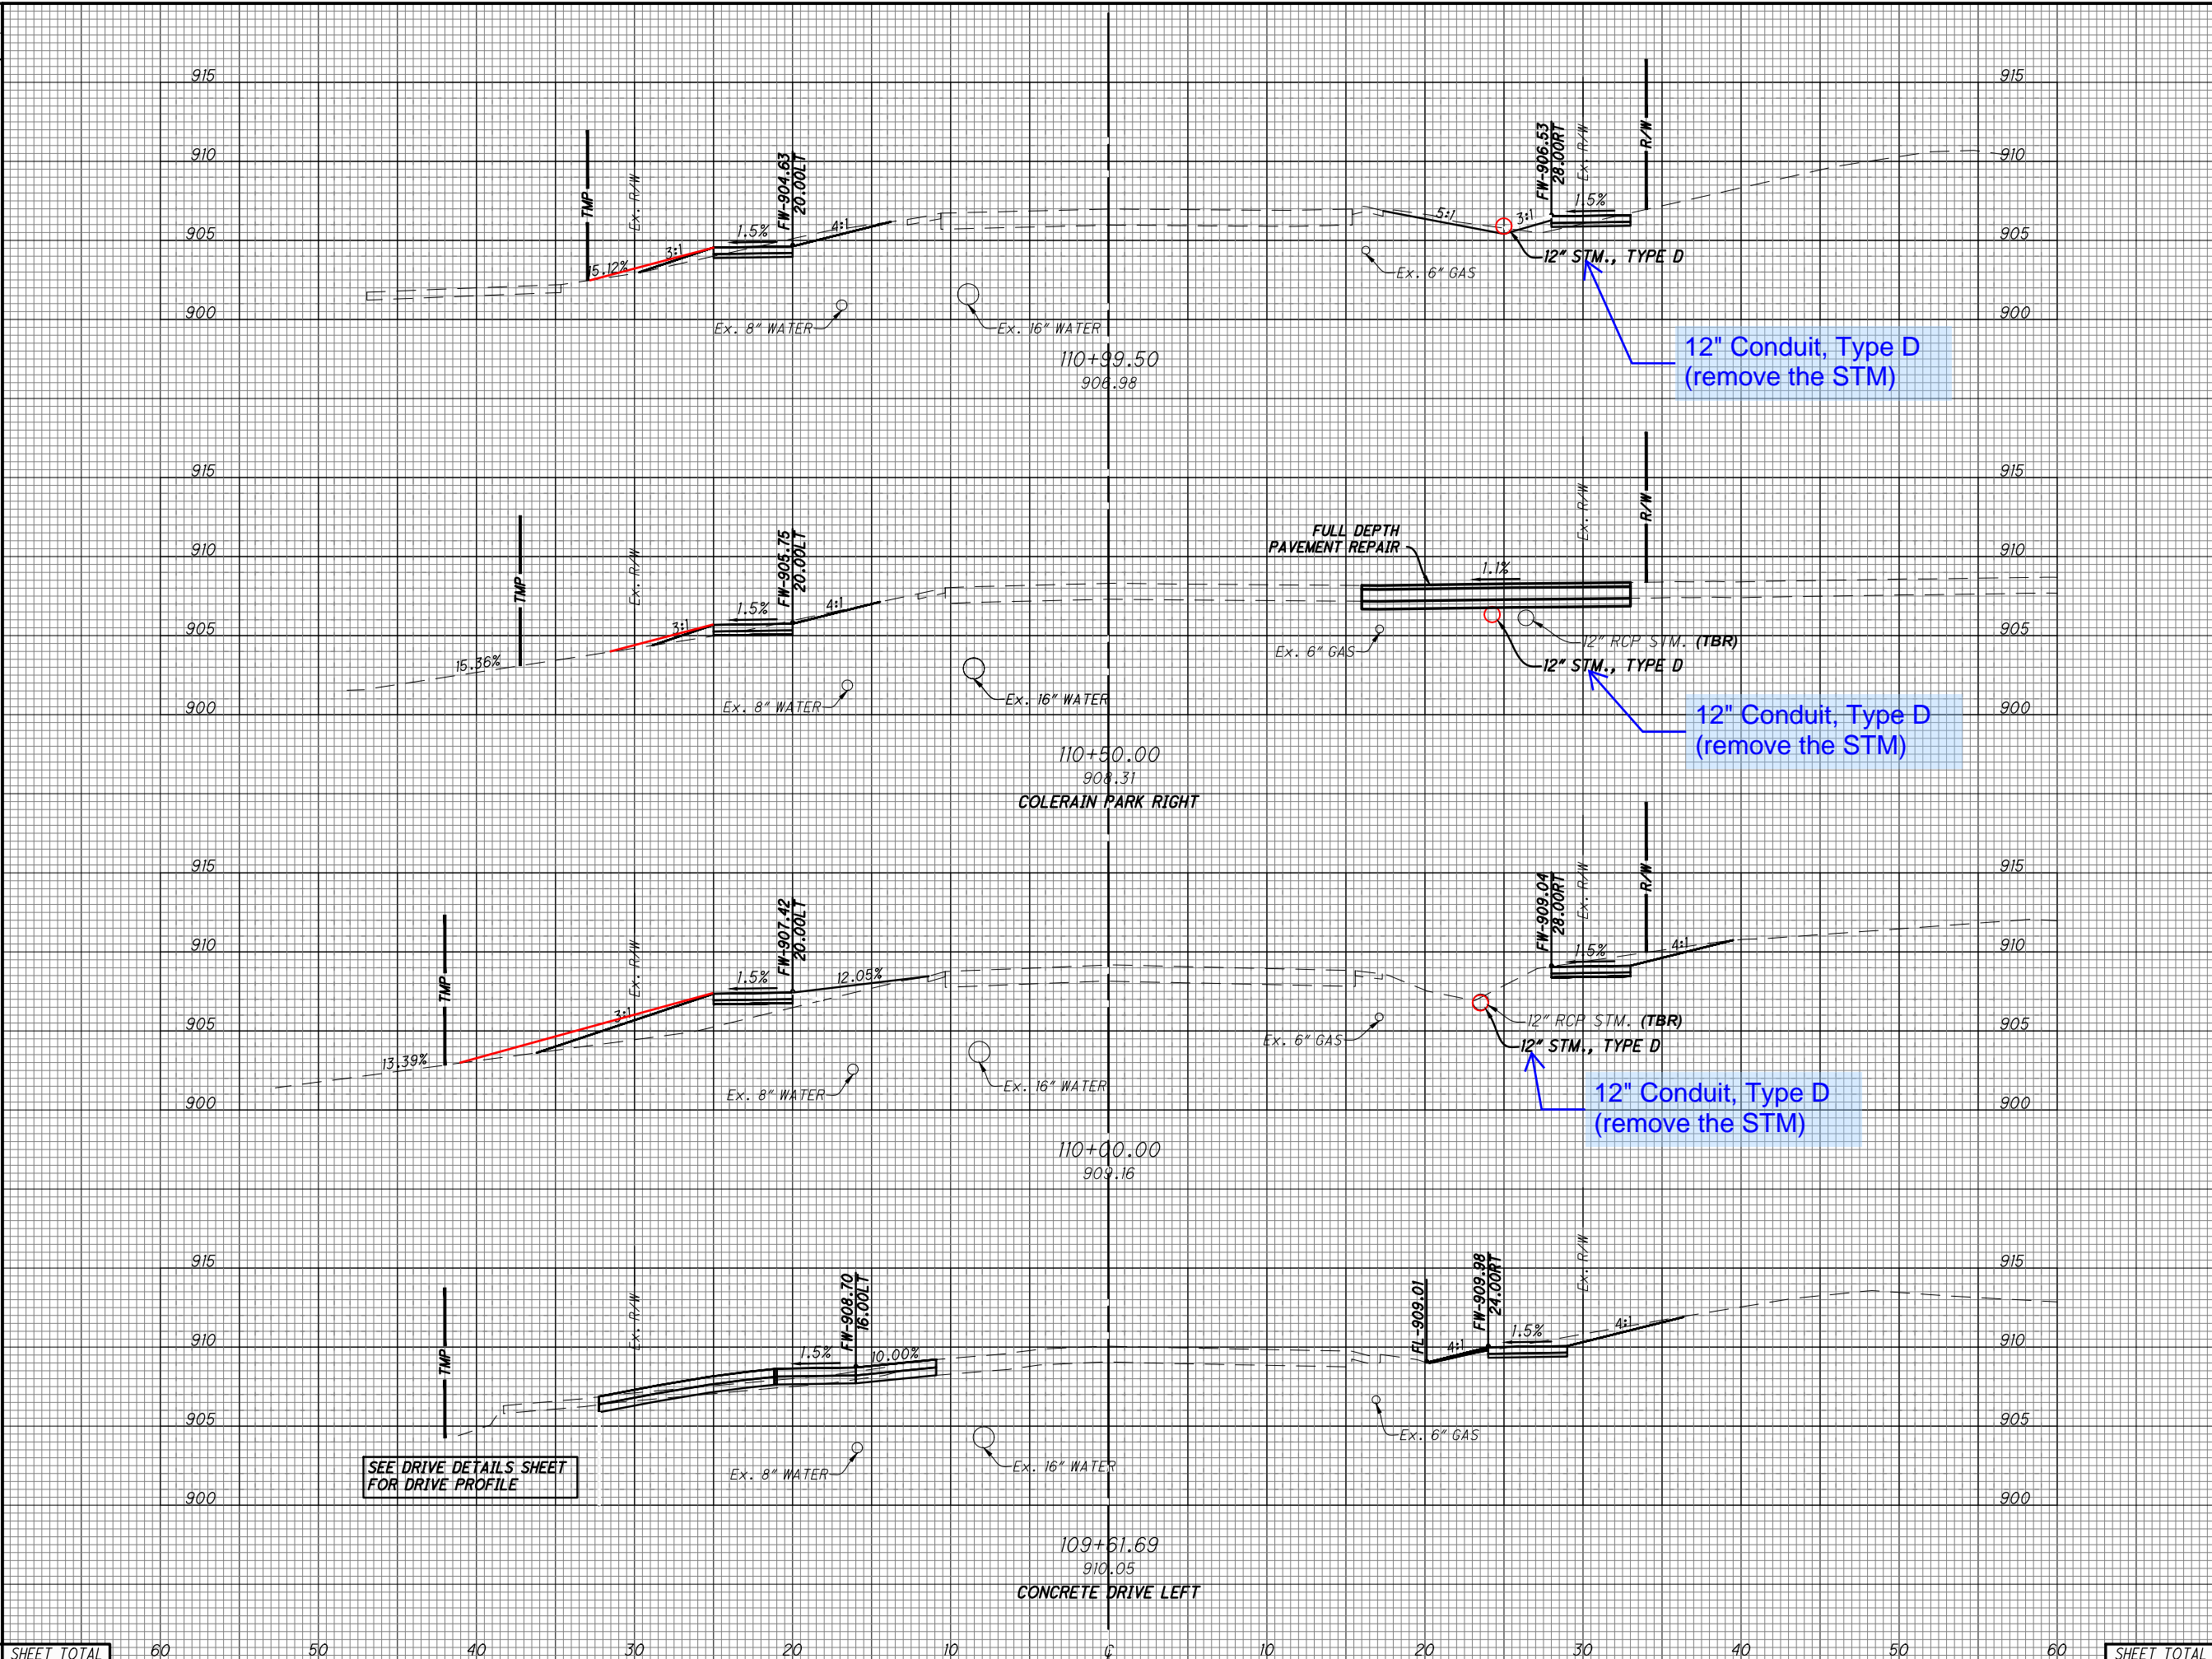

END AREA	VOLUME	
	CUT	FILL
5.9	2.4	
25.1	1.3	
21.5	1.4	
23.1	20.9	
3.5	21.2	
9.5	15.5	
9.9	0.6	
5.9	1.0	
<b>40.8</b>	<b>25.6</b>	<b>63.6</b>


SHEET TOTAL	60	50	40	30	20	10	0	10	20	30	40	50	60	SHEET TOTAL	40.8	25.6	63.6	38.3
-------------	----	----	----	----	----	----	---	----	----	----	----	----	----	-------------	------	------	------	------

CROSS SECTIONS - SPRINGDALE ROAD  
STA. 109+61.69 TO STA. 110+99.50

DESIGN AGENCY  
  
 CHOICE ONE ENGINEERING  
 DESIGNER  
 IJW  
 REVIEWER  
 BAW 7-23-2025  
 PROJECT ID  
 120861  
 SHEET TOTAL  
 P.28 53

SEEDING  
END SO.  
WIDTH YDS.

SEEDING AND MULCHING AREAS MEASURED IN AUTOCAD - QUANTITY SHOWN IN GENERAL NOTES

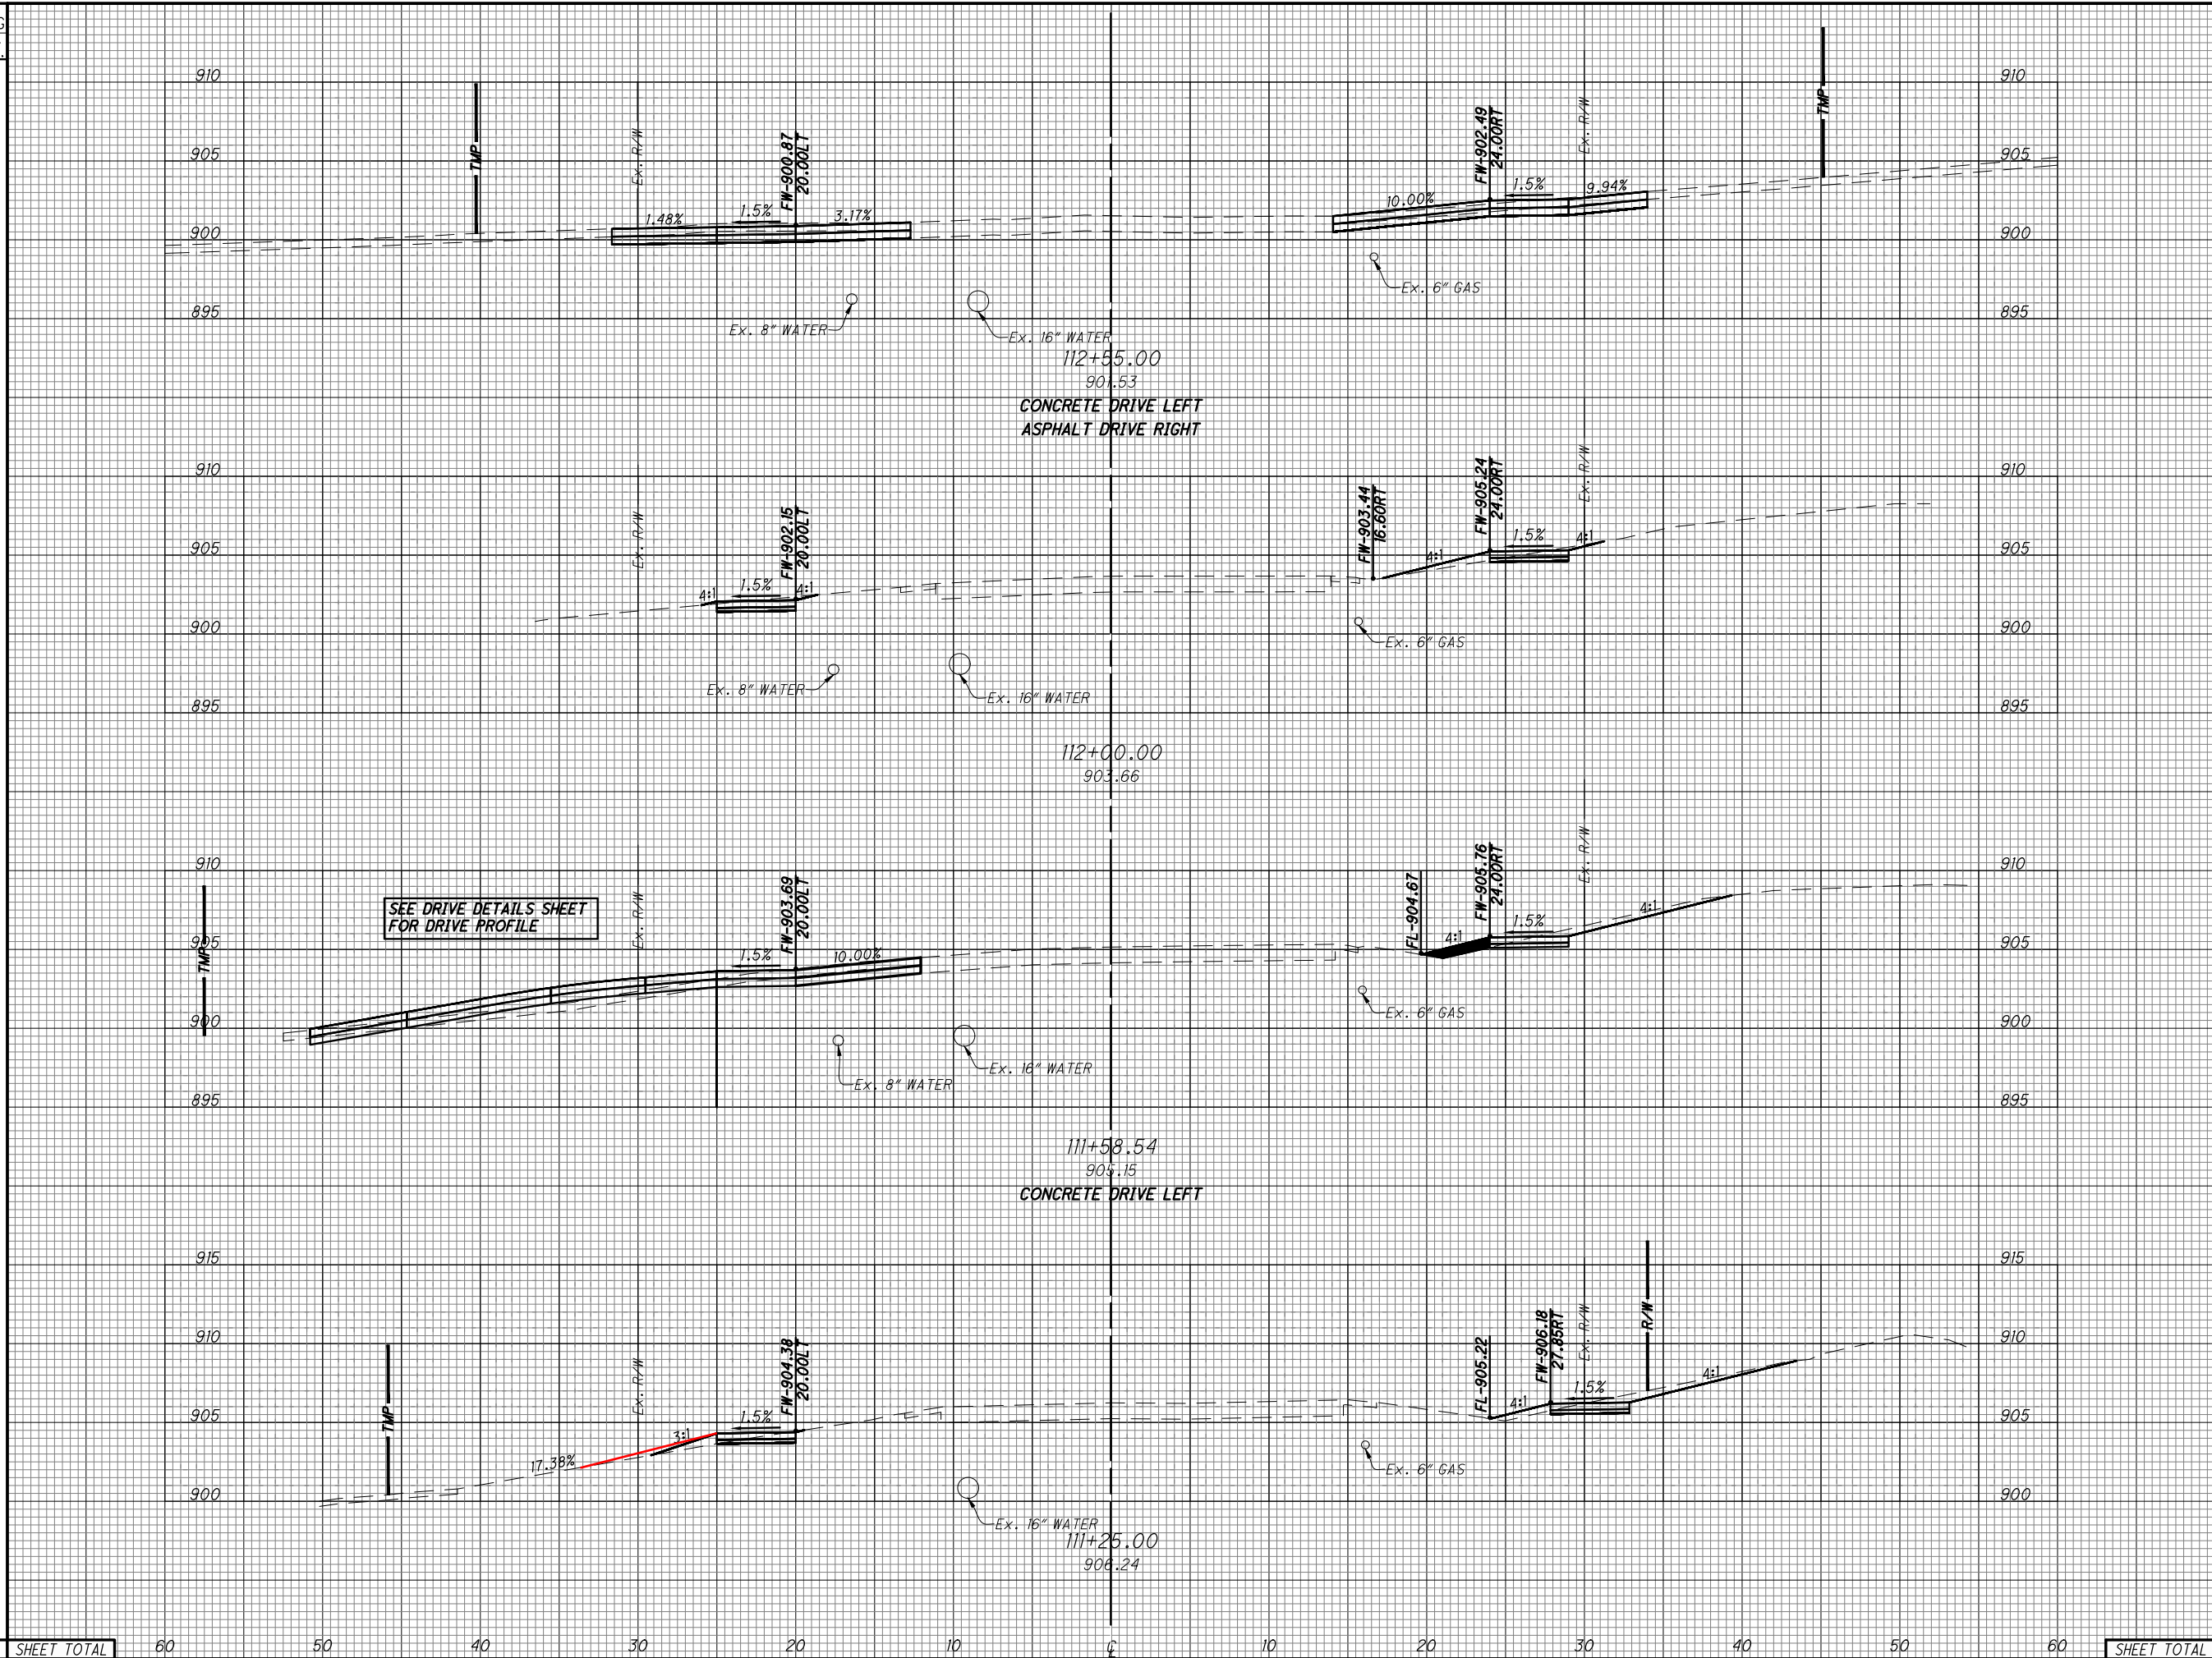

END AREA	VOLUME	
	CUT	FILL
27.1	0	0
30.6	1.9	0
2.9	1.9	0
14.1	5.8	0
15.4	0	0
12.7	5.3	0
5.1	2.8	0
5.2	2.5	0
<b>SHEET TOTAL</b>	<b>50.5</b>	<b>10.4</b>

SHEET TOTAL


SHEET TOTAL

CROSS SECTIONS - SPRINGDALE ROAD  
STA. 111+25 TO STA. 112+55

DESIGN AGENCY  
CHOICE ONE ENGINEERING  
DESIGNER  
I JW  
REVIEWER  
BAW 7-23-2025  
PROJECT ID  
120861  
SHEET TOTAL  
P.29 53

SEEDING  
END SO.  
WIDTH YDS.

SEEDING AND MULCHING AREAS MEASURED IN AUTOCAD - QUANTITY SHOWN IN GENERAL NOTES

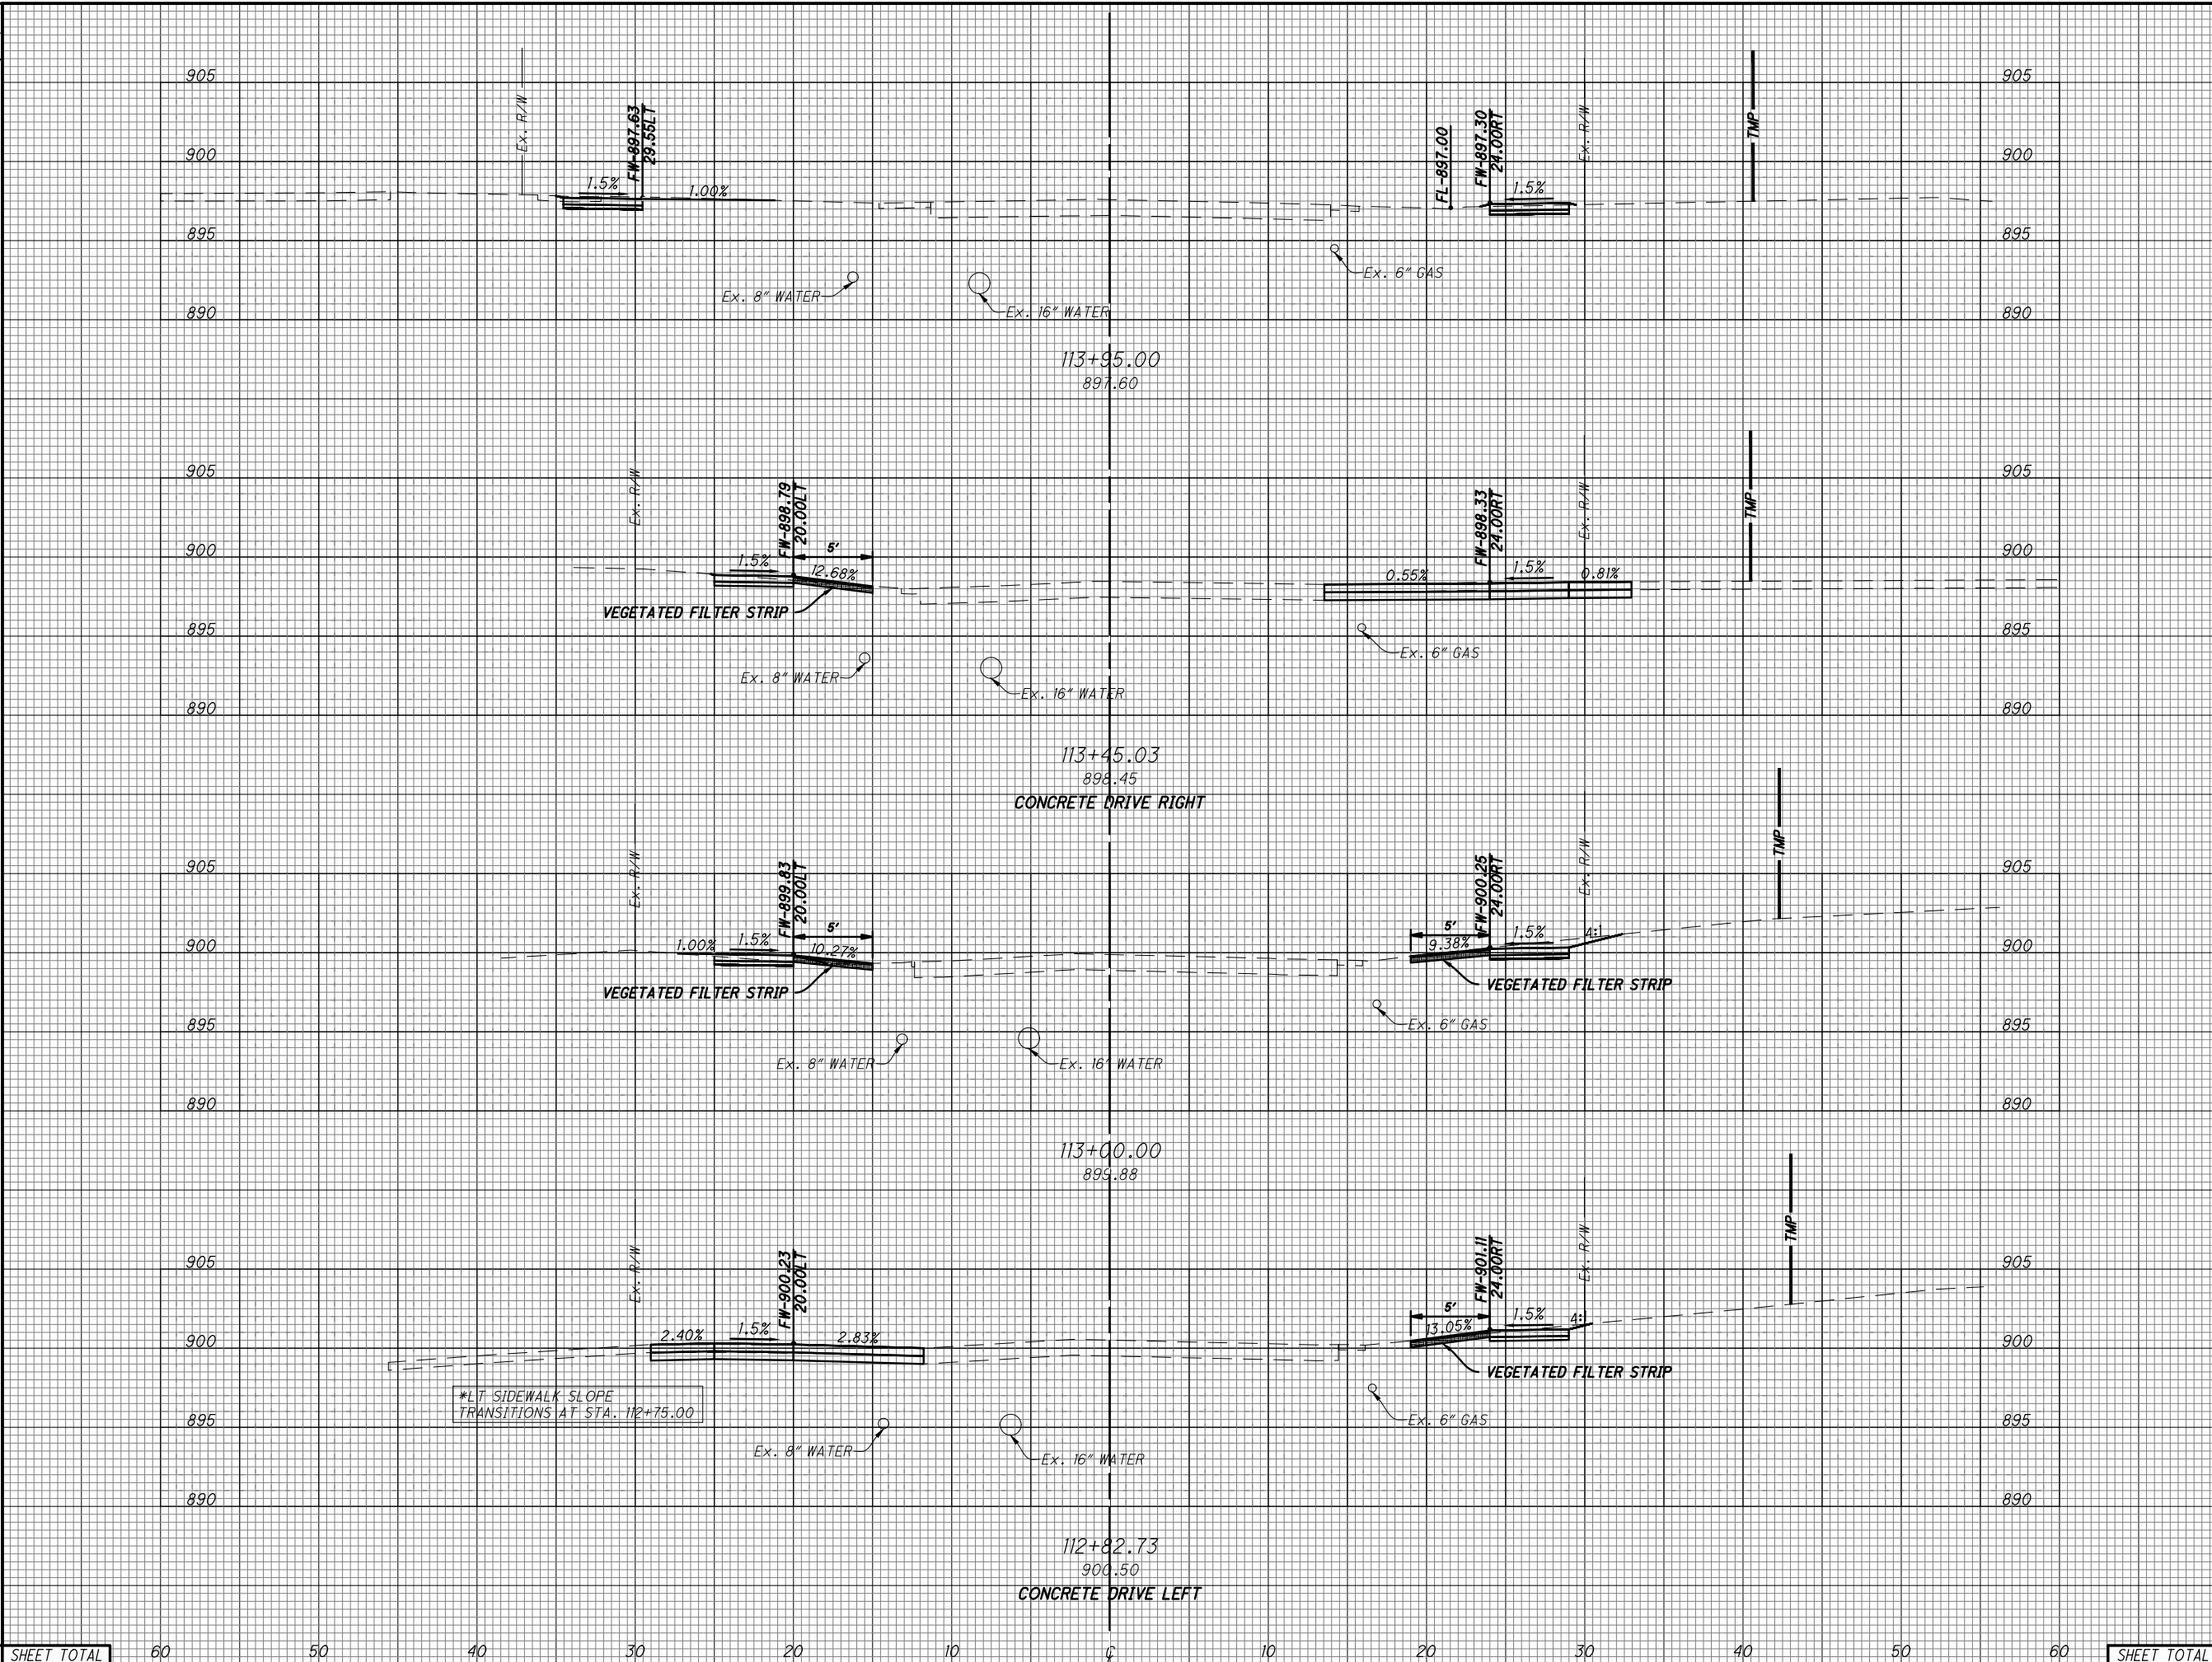

END AREA	VOLUME	
	CUT	FILL
3.0	0	
17.9	0	
16.3	0	
18.9	0	
6.4	0	
6.5	0	
13.9	0	
21.1	0	
<b>42.6</b>	<b>0</b>	<b>64.4</b>


CROSS SECTIONS - SPRINGDALE ROAD  
STA. 112+82.73 TO STA. 113+95

DESIGN AGENCY  
CHOICE ONE ENGINEERING  
DESIGNER  
IJJW  
REVIEWER  
BAW 7-23-2025  
PROJECT ID  
120861  
SHEET TOTAL  
P.30 53

SHEET TOTAL 60 50 40 30 20 10 0 10 20 30 40 50 60 SHEET TOTAL 42.6 0 64.4 0

SEEDING  
END SO.  
WIDTH YDS.

SEEDING AND MULCHING AREAS MEASURED IN AUTOCAD - QUANTITY SHOWN IN GENERAL NOTES

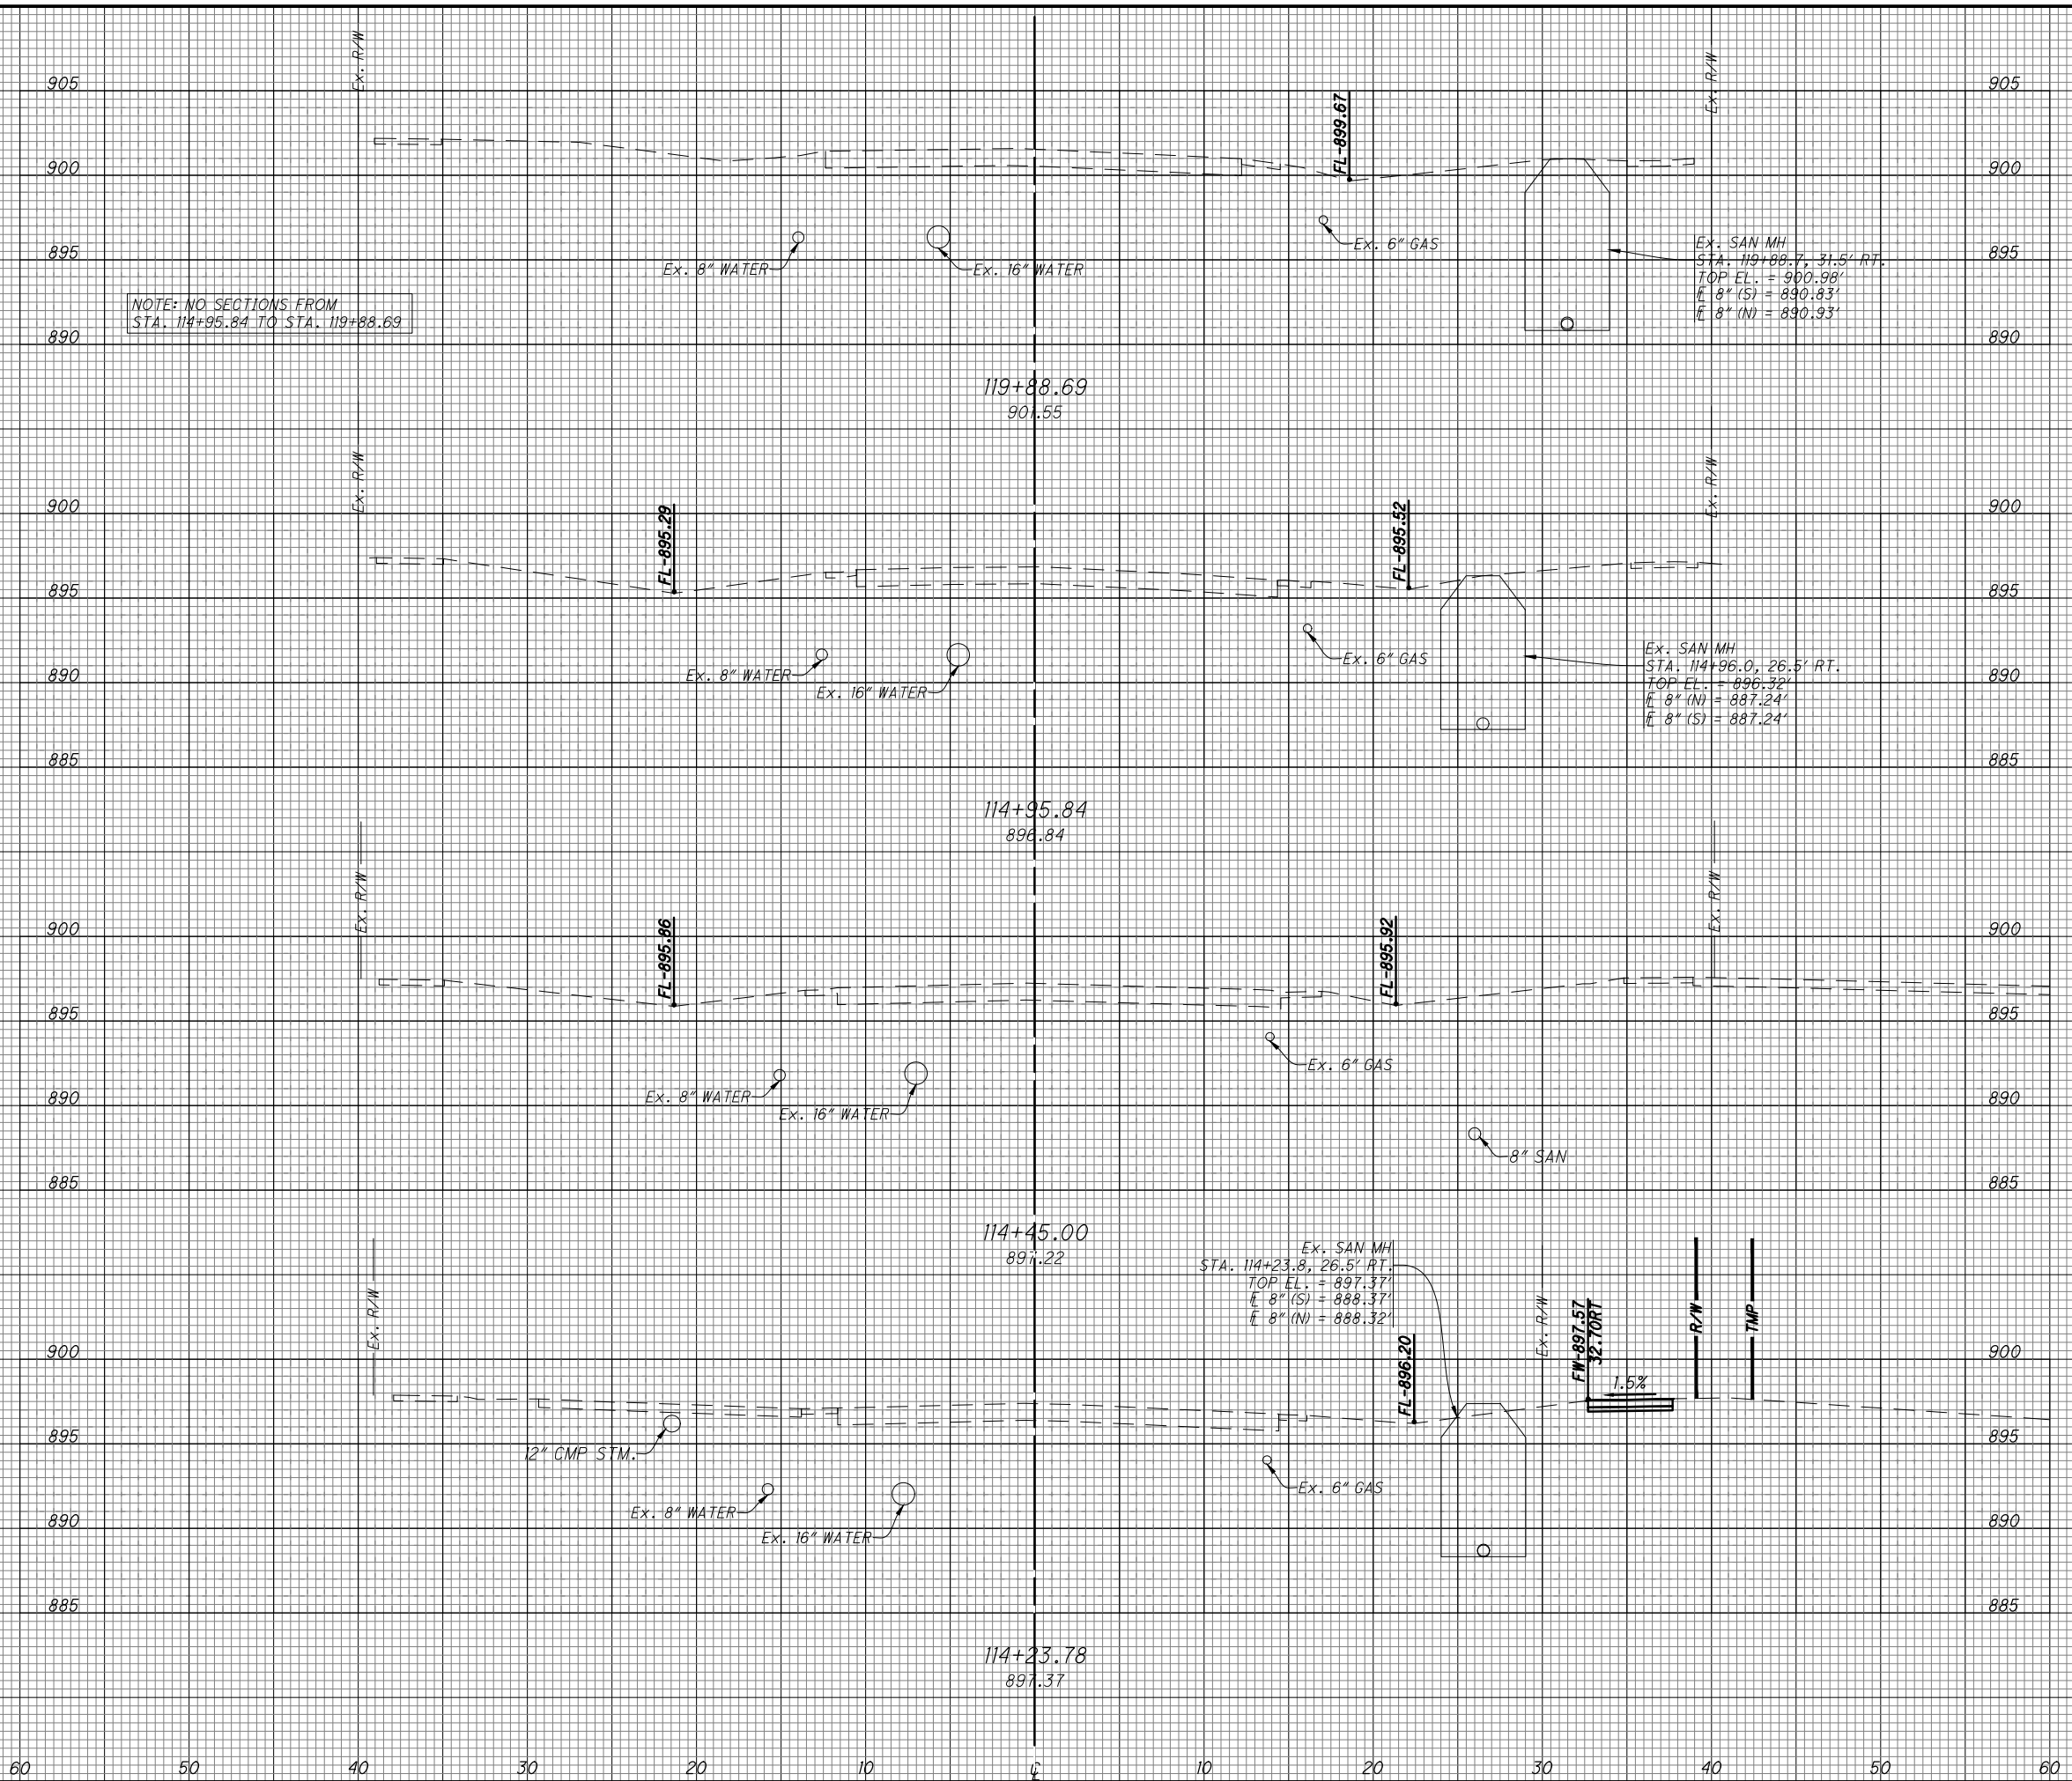


NOTE: NO SECTIONS FROM  
STA. 114+95.84 TO STA. 119+88.69

END AREA	VOLUME	
	CUT	FILL
0	0	0
0	0	0
0.5	0	0
1.3	0	0
2.3	0	0
<b>1.3</b>	<b>0</b>	<b>2.8</b>


SHEET TOTAL 60 50 40 30 20 10 0 10 20 30 40 50 60 SHEET TOTAL

CROSS SECTIONS - SPRINGDALE ROAD  
STA. 114+23.78 TO STA. 119+88.69

DESIGN AGENCY  
  
 CHOICE ONE ENGINEERING  
 DESIGNER  
 IJW  
 REVIEWER  
 BAW 7-23-2025  
 PROJECT ID  
 120861  
 SHEET TOTAL  
 P.31 53

SEEDING  
END SO.  
WIDTH YDS.

SEEDING AND MULCHING AREAS MEASURED IN AUTOCAD - QUANTITY SHOWN IN GENERAL NOTES

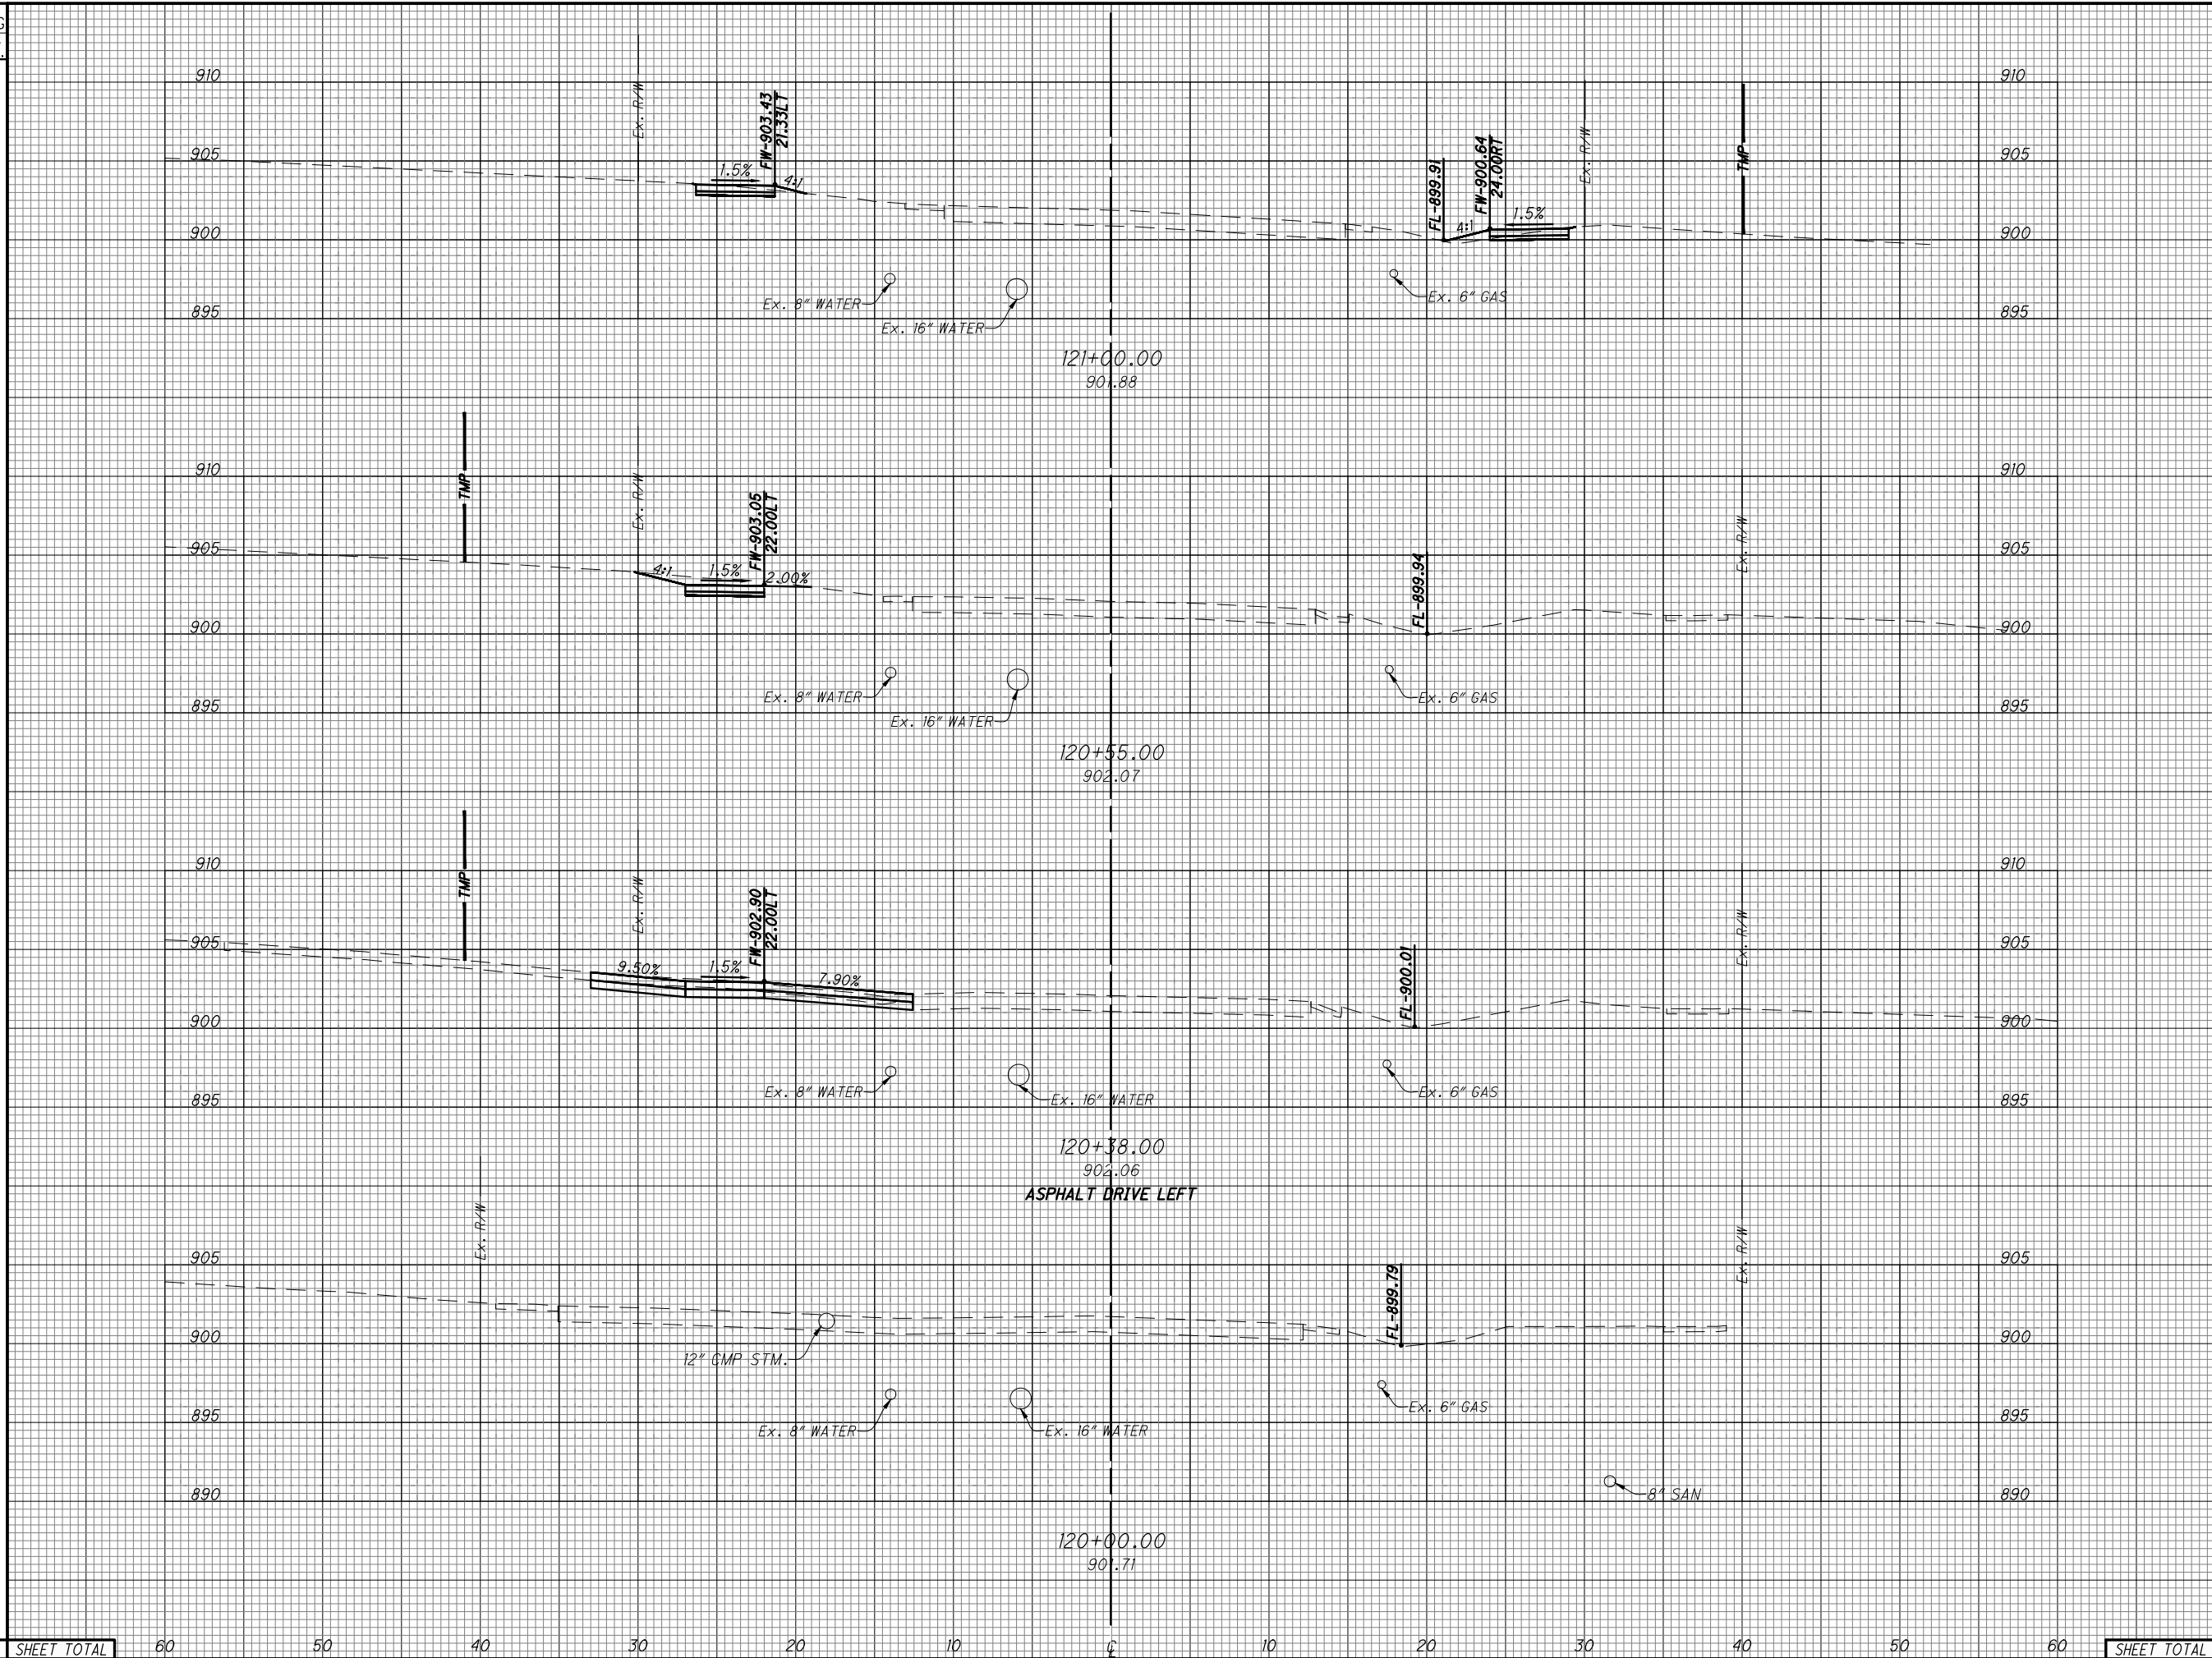

END AREA	VOLUME	
	CUT	FILL
2.4	1.4	
4.2	1.2	
2.6	0	
4.9	0	
12.9	0	
9.1	0	
0	0	
0	0	
15.9	1.4	18.2
1.2		1.2

SHEET TOTAL

60 50 40 30 20 10 0 10 20 30 40 50 60

SHEET TOTAL

CROSS SECTIONS - SPRINGDALE ROAD  
STA. 120+00 TO STA. 121+00

DESIGN AGENCY



CHOICE ONE ENGINEERING

DESIGNER

IJW

REVIEWER

BAW 7-23-2025

PROJECT ID

120861


SHEET TOTAL

P.32 53



SEEDING  
END SO.  
WIDTH YDS.

SEEDING AND MULCHING AREAS MEASURED IN AUTOCAD - QUANTITY SHOWN IN GENERAL NOTES

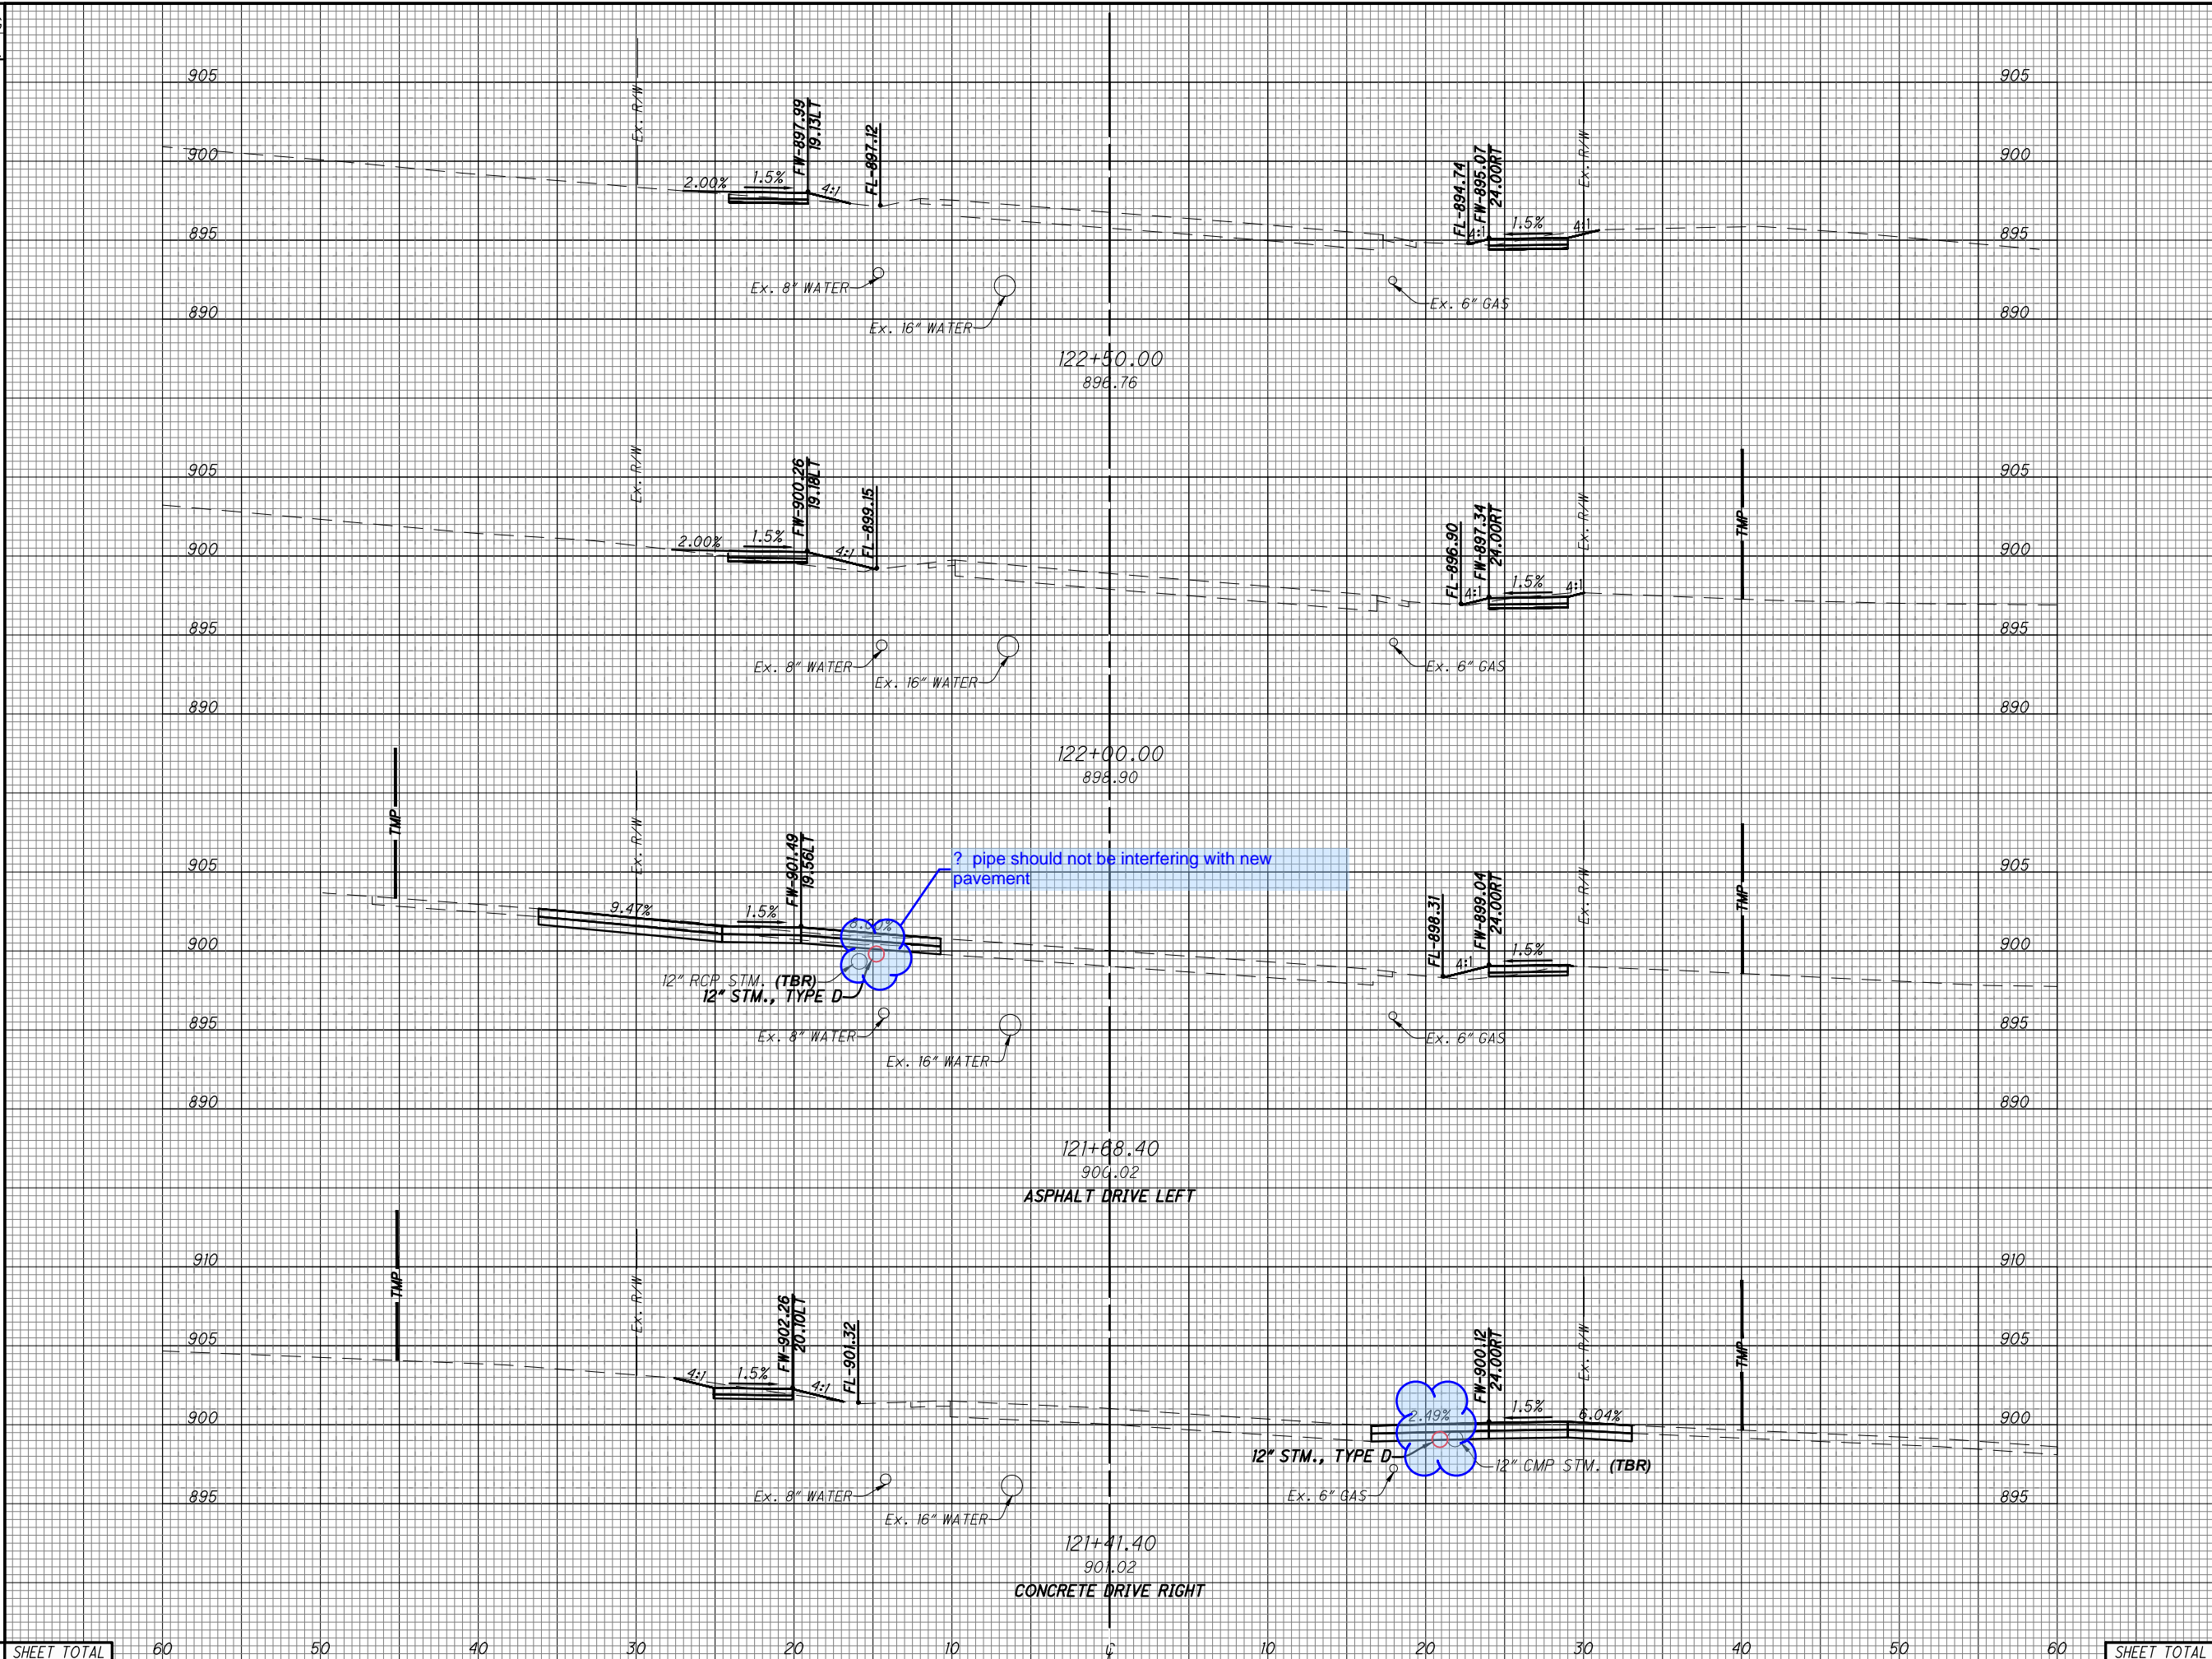

END AREA	VOLUME	
	CUT	FILL
2.8	1.1	
4.4	3.1	
1.9	3.3	
10.5	2.6	
16.0	1.2	
14.3	0.9	
12.6	0.6	
11.5	1.5	
<b>33.3</b>	<b>6.2</b>	<b>40.7</b>


? pipe should not be interfering with new pavement

**CROSS SECTIONS - SPRINGDALE ROAD  
STA. 121+41.40 TO STA. 122+50**

DESIGN AGENCY  
CHOICE ONE ENGINEERING  
DESIGNER  
IJW  
REVIEWER  
BAW 7-23-2025  
PROJECT ID  
120861  
SHEET TOTAL  
P.33 53


SEEDING  
END SO.  
WIDTH YDS.

SEEDING AND MULCHING AREAS MEASURED IN AUTOCAD - QUANTITY SHOWN IN GENERAL NOTES

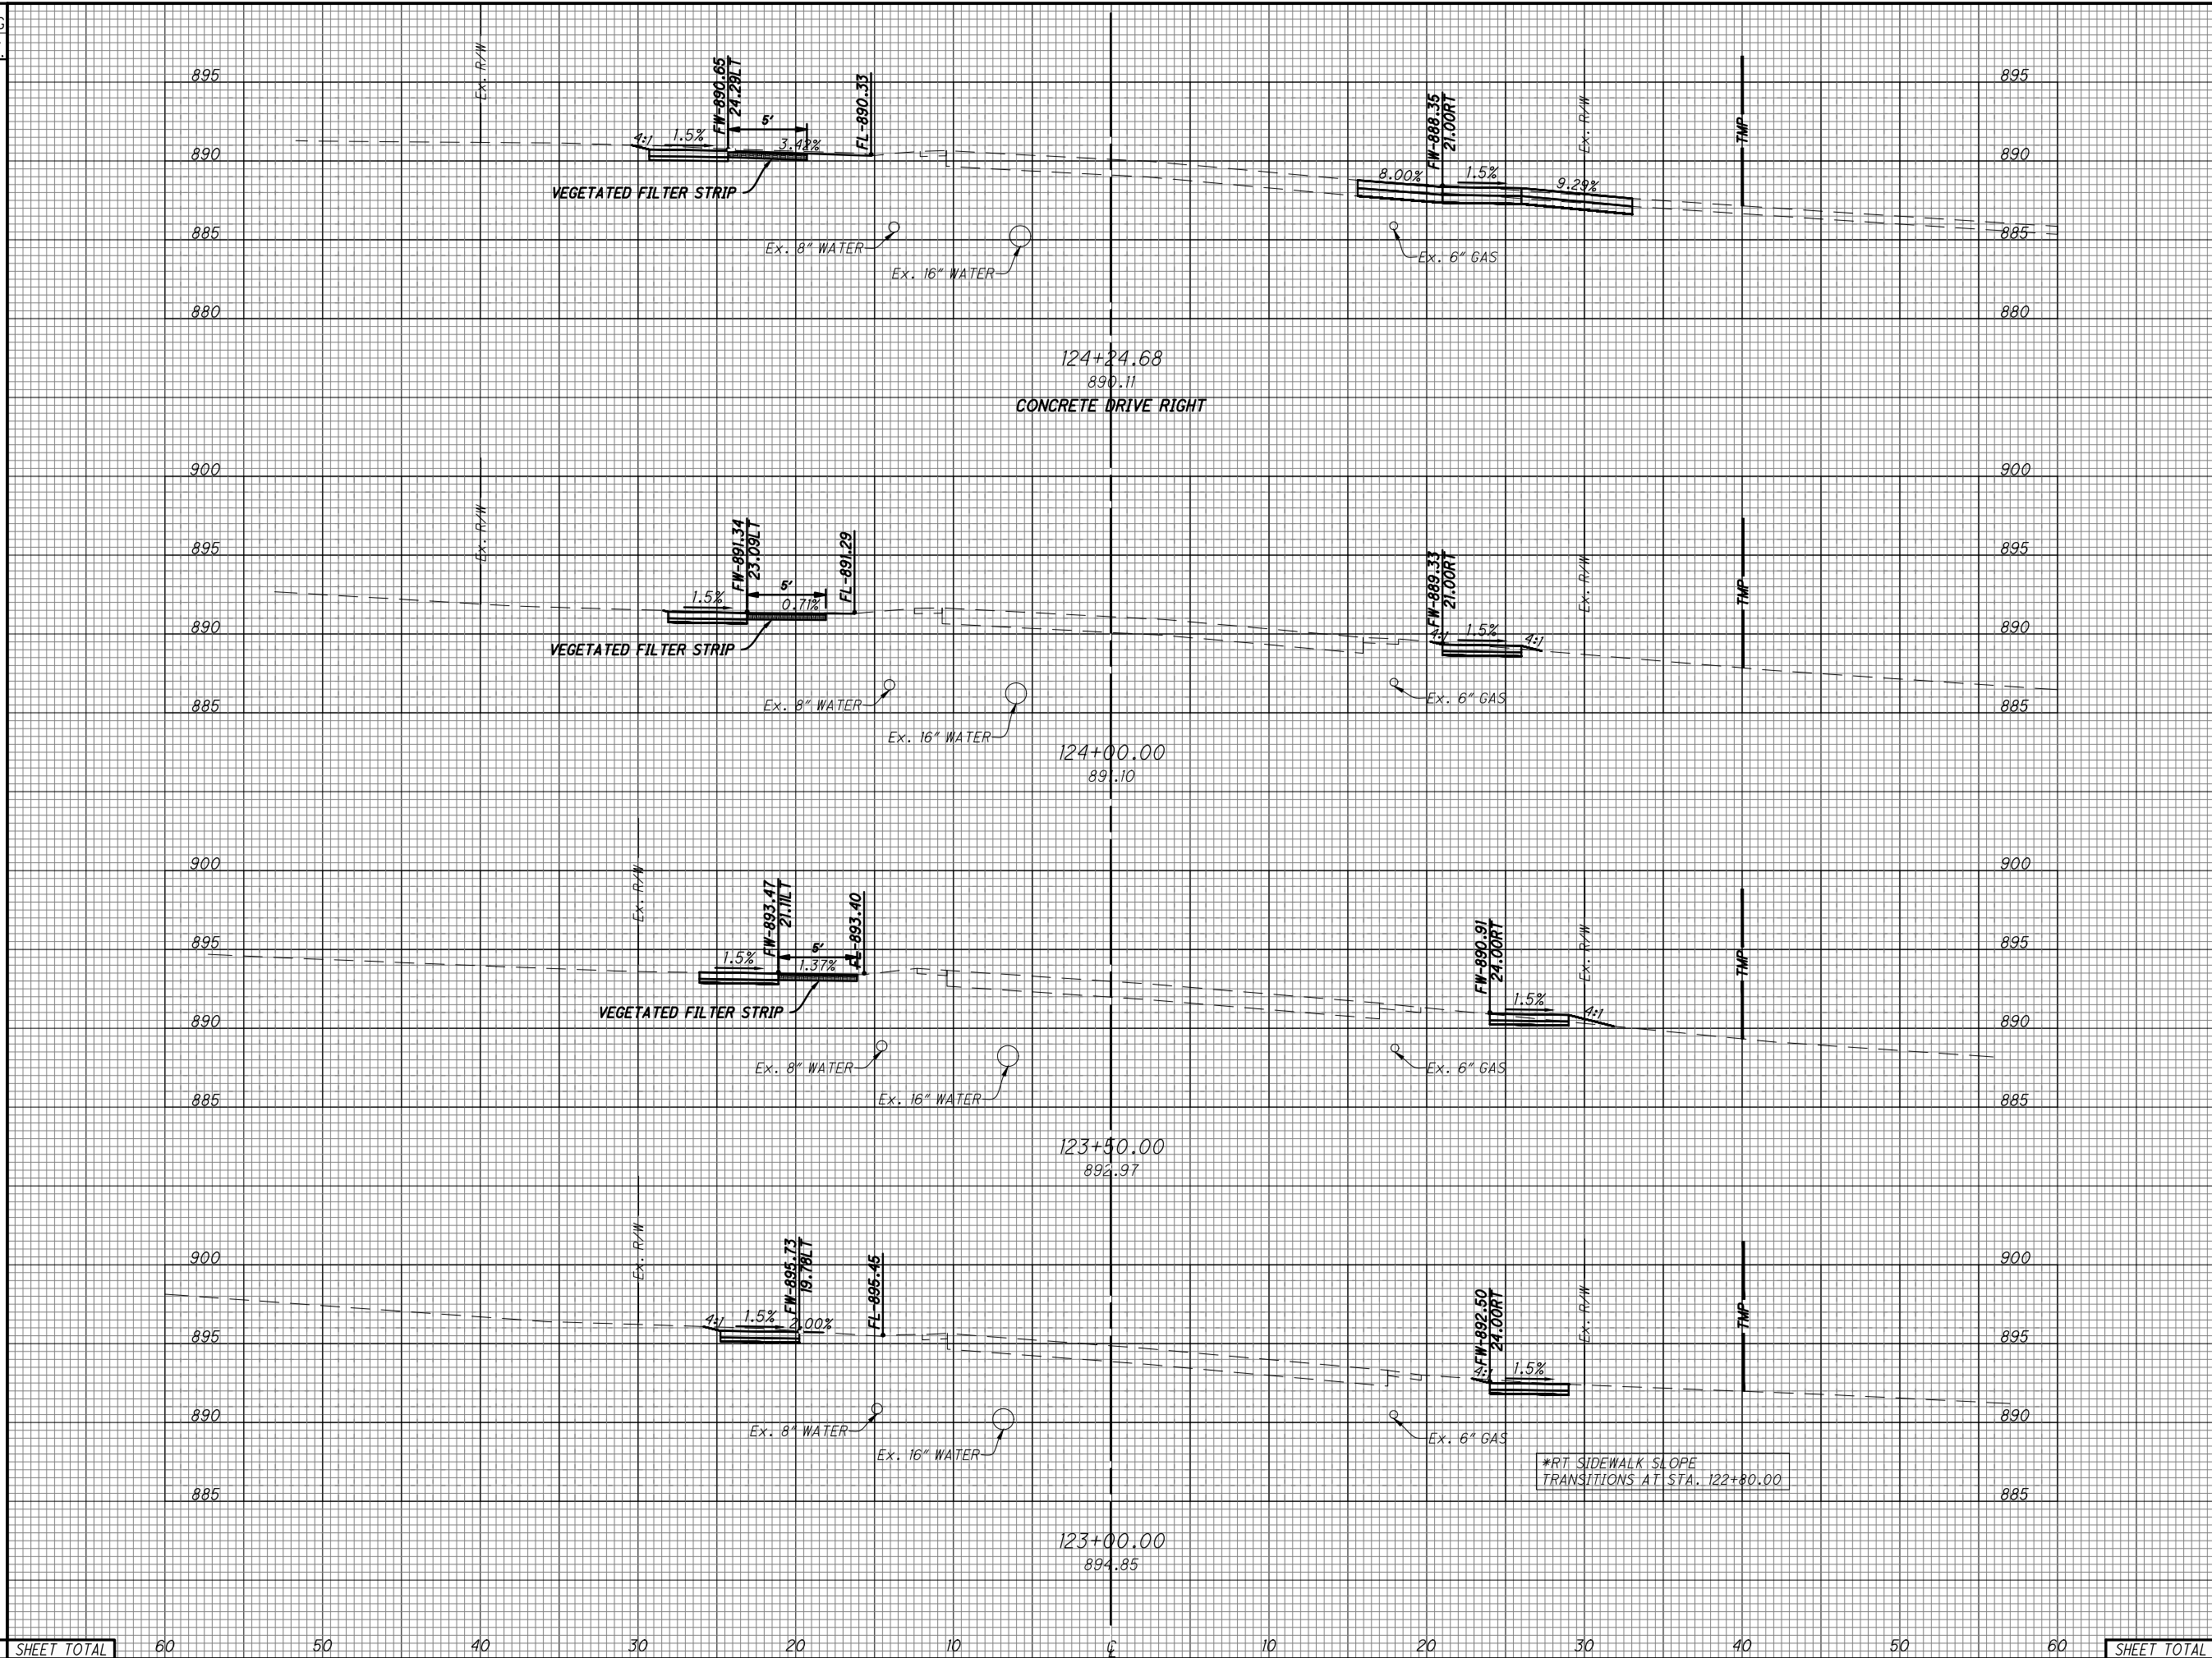

STATION	END AREA		VOLUME	
	CUT	FILL	CUT	FILL
124+24.68	15.9	0	9.4	0
124+00.00	4.7	0.1	8.5	0.6
123+50.00	4.5	0.6	6.7	0.6
123+00.00	2.7	0	5.1	1.0
<b>SHEET TOTAL</b>	<b>27.8</b>	<b>.7</b>	<b>29.7</b>	<b>2.2</b>


**CROSS SECTIONS - SPRINGDALE ROAD  
STA. 123+00 TO STA. 124+24.68**

DESIGN AGENCY  
  
 CHOICE ONE ENGINEERING  
 DESIGNER  
 IJW  
 REVIEWER  
 BAW 7-23-2025  
 PROJECT ID  
 120861  
 SHEET TOTAL  
 P.34 53

SHEET TOTAL 60 50 40 30 20 10 0 10 20 30 40 50 60 SHEET TOTAL 27.8 .7 29.7 2.2


SEEDING  
END SO.  
WIDTH YDS.

SEEDING AND MULCHING AREAS MEASURED IN AUTOCAD - QUANTITY SHOWN IN GENERAL NOTES

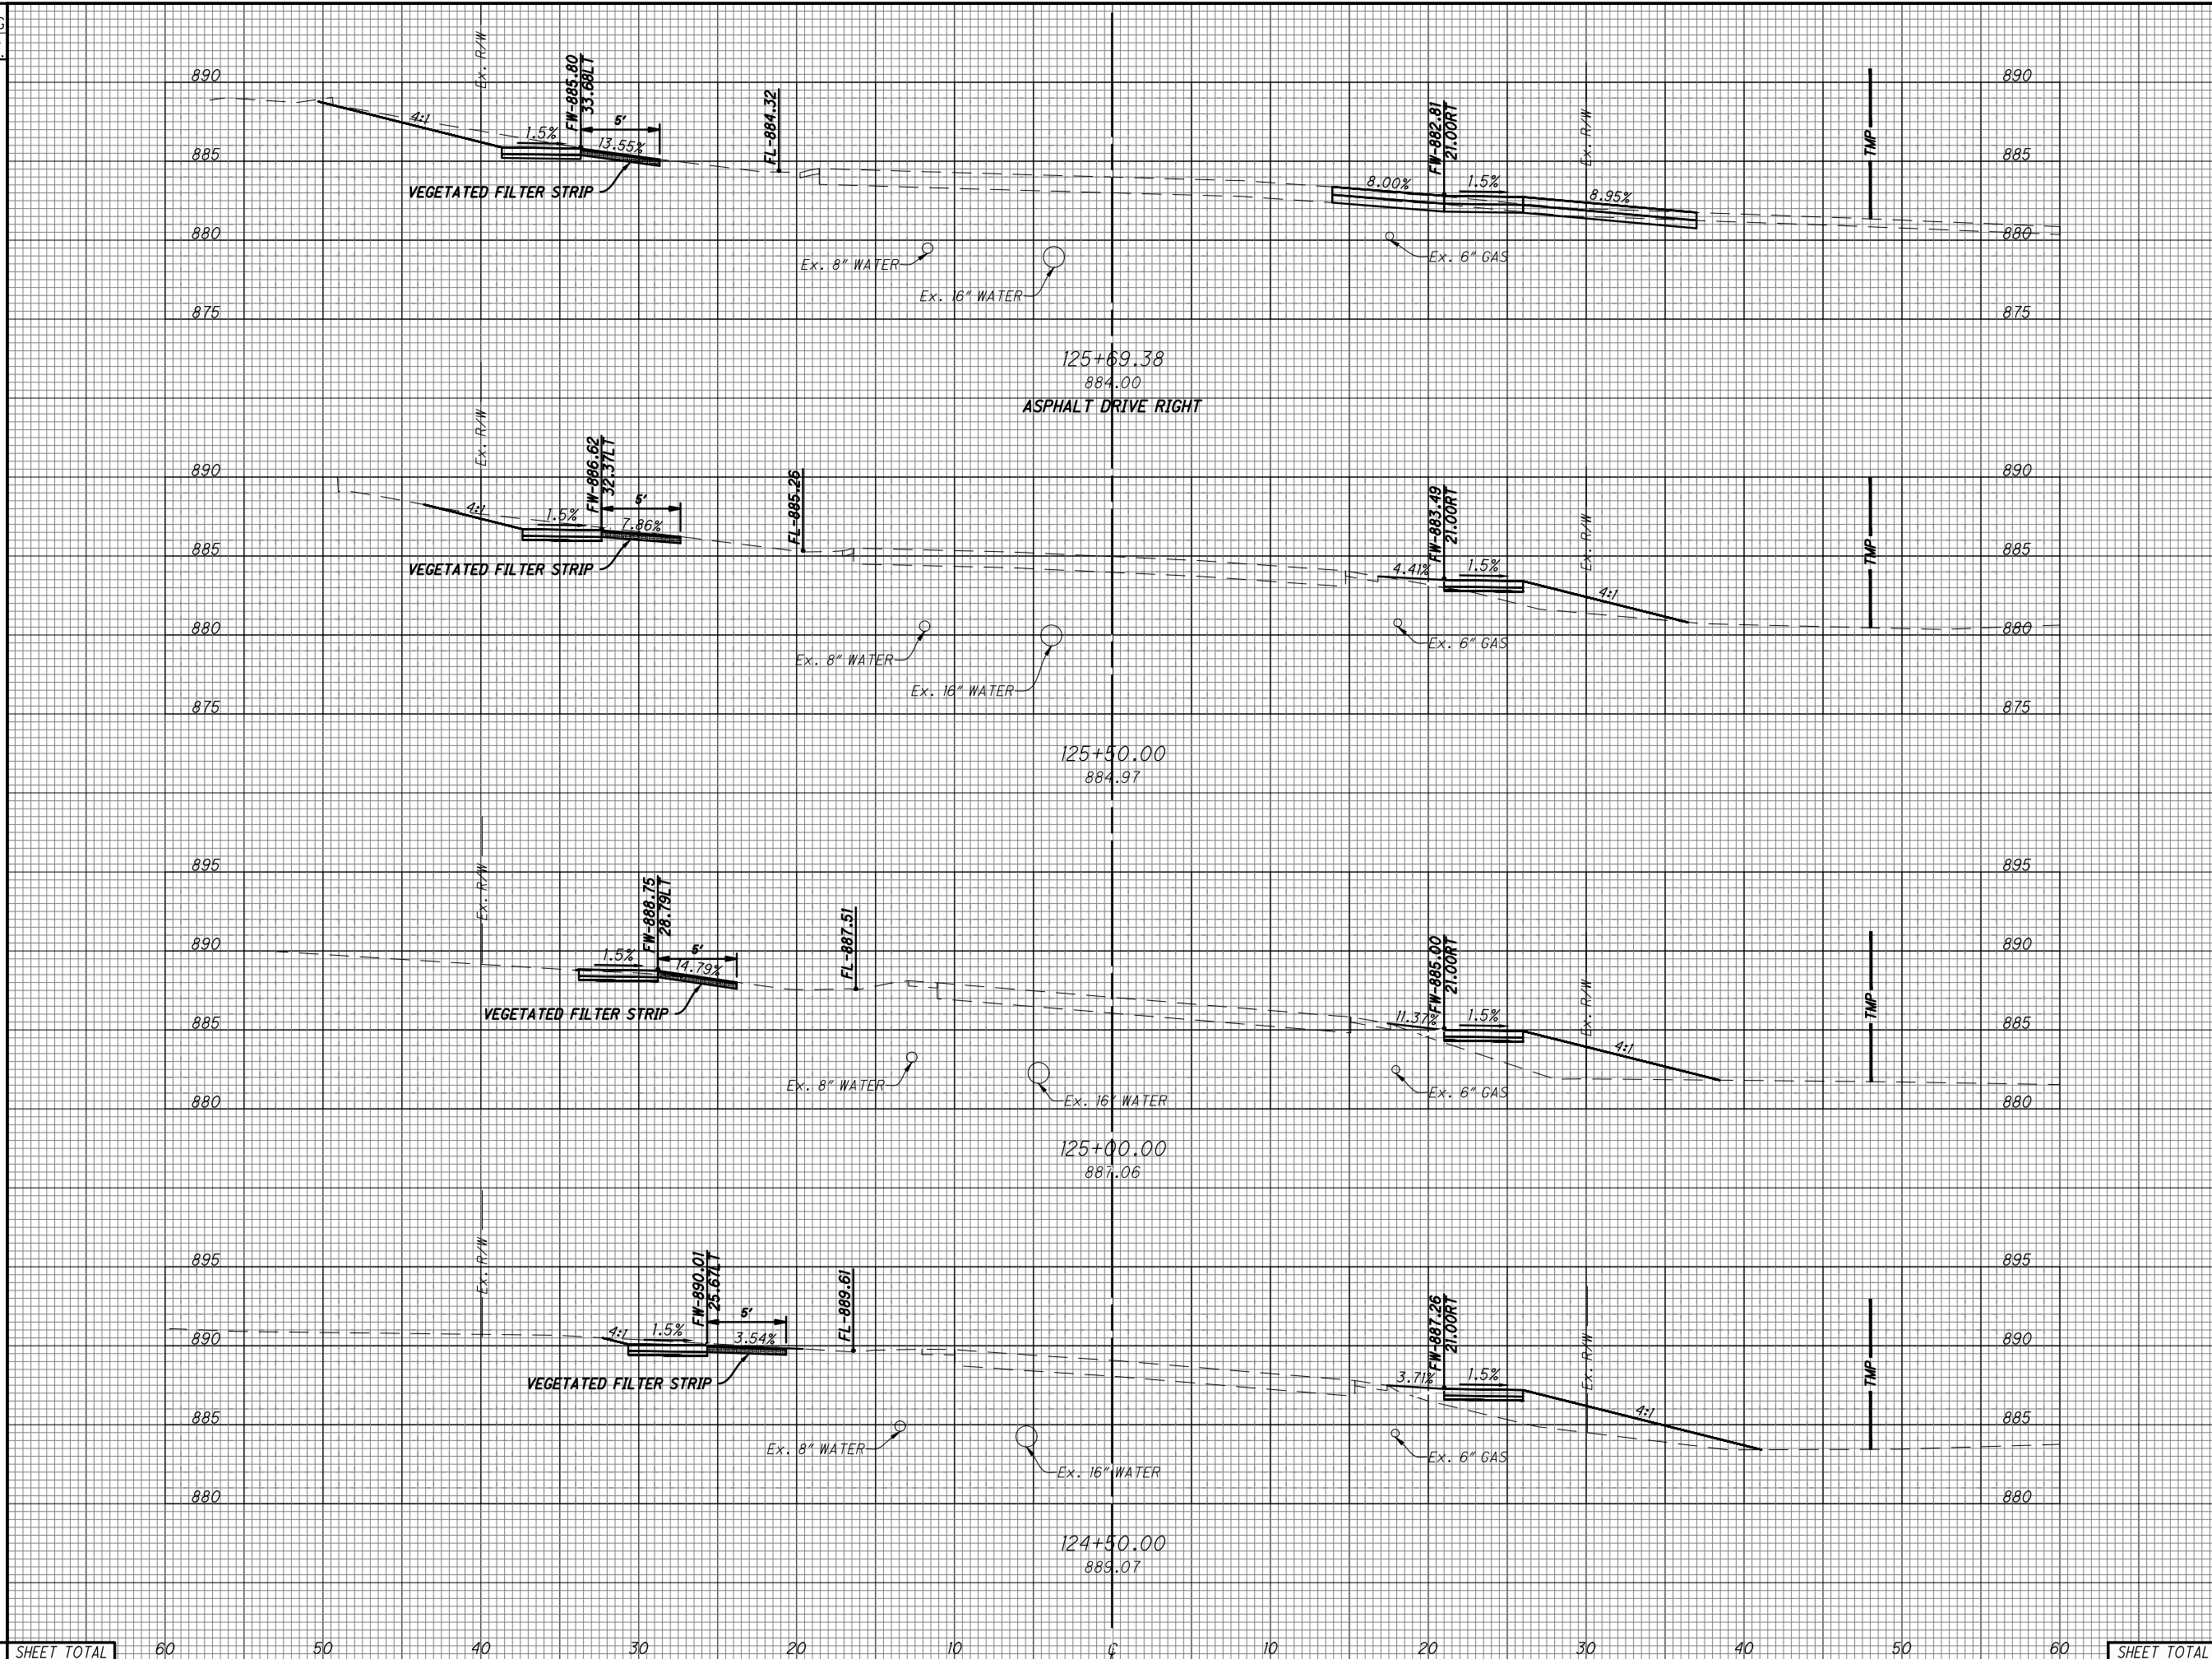


END AREA	VOLUME	
	CUT	FILL
18.7	0	
8.8	4.0	
5.7	11.2	
7.9	33.3	
2.8	24.8	
6.3	46.0	
4.0	24.9	
9.3	11.7	
<b>31.2</b>	<b>60.9</b>	<b>34.3</b>

**CROSS SECTIONS - SPRINGDALE ROAD**  
STA. 124+50 TO STA. 125+69.38

DESIGN AGENCY  
  
 CHOICE ONE ENGINEERING  
 DESIGNER  
 IJW  
 REVIEWER  
 BAW 7-23-2025  
 PROJECT ID  
 120861  
 SHEET TOTAL  
 P.35 53


SEEDING  
END SO.  
WIDTH YDS.

SEEDING AND MULCHING AREAS MEASURED IN AUTOCAD - QUANTITY SHOWN IN GENERAL NOTES

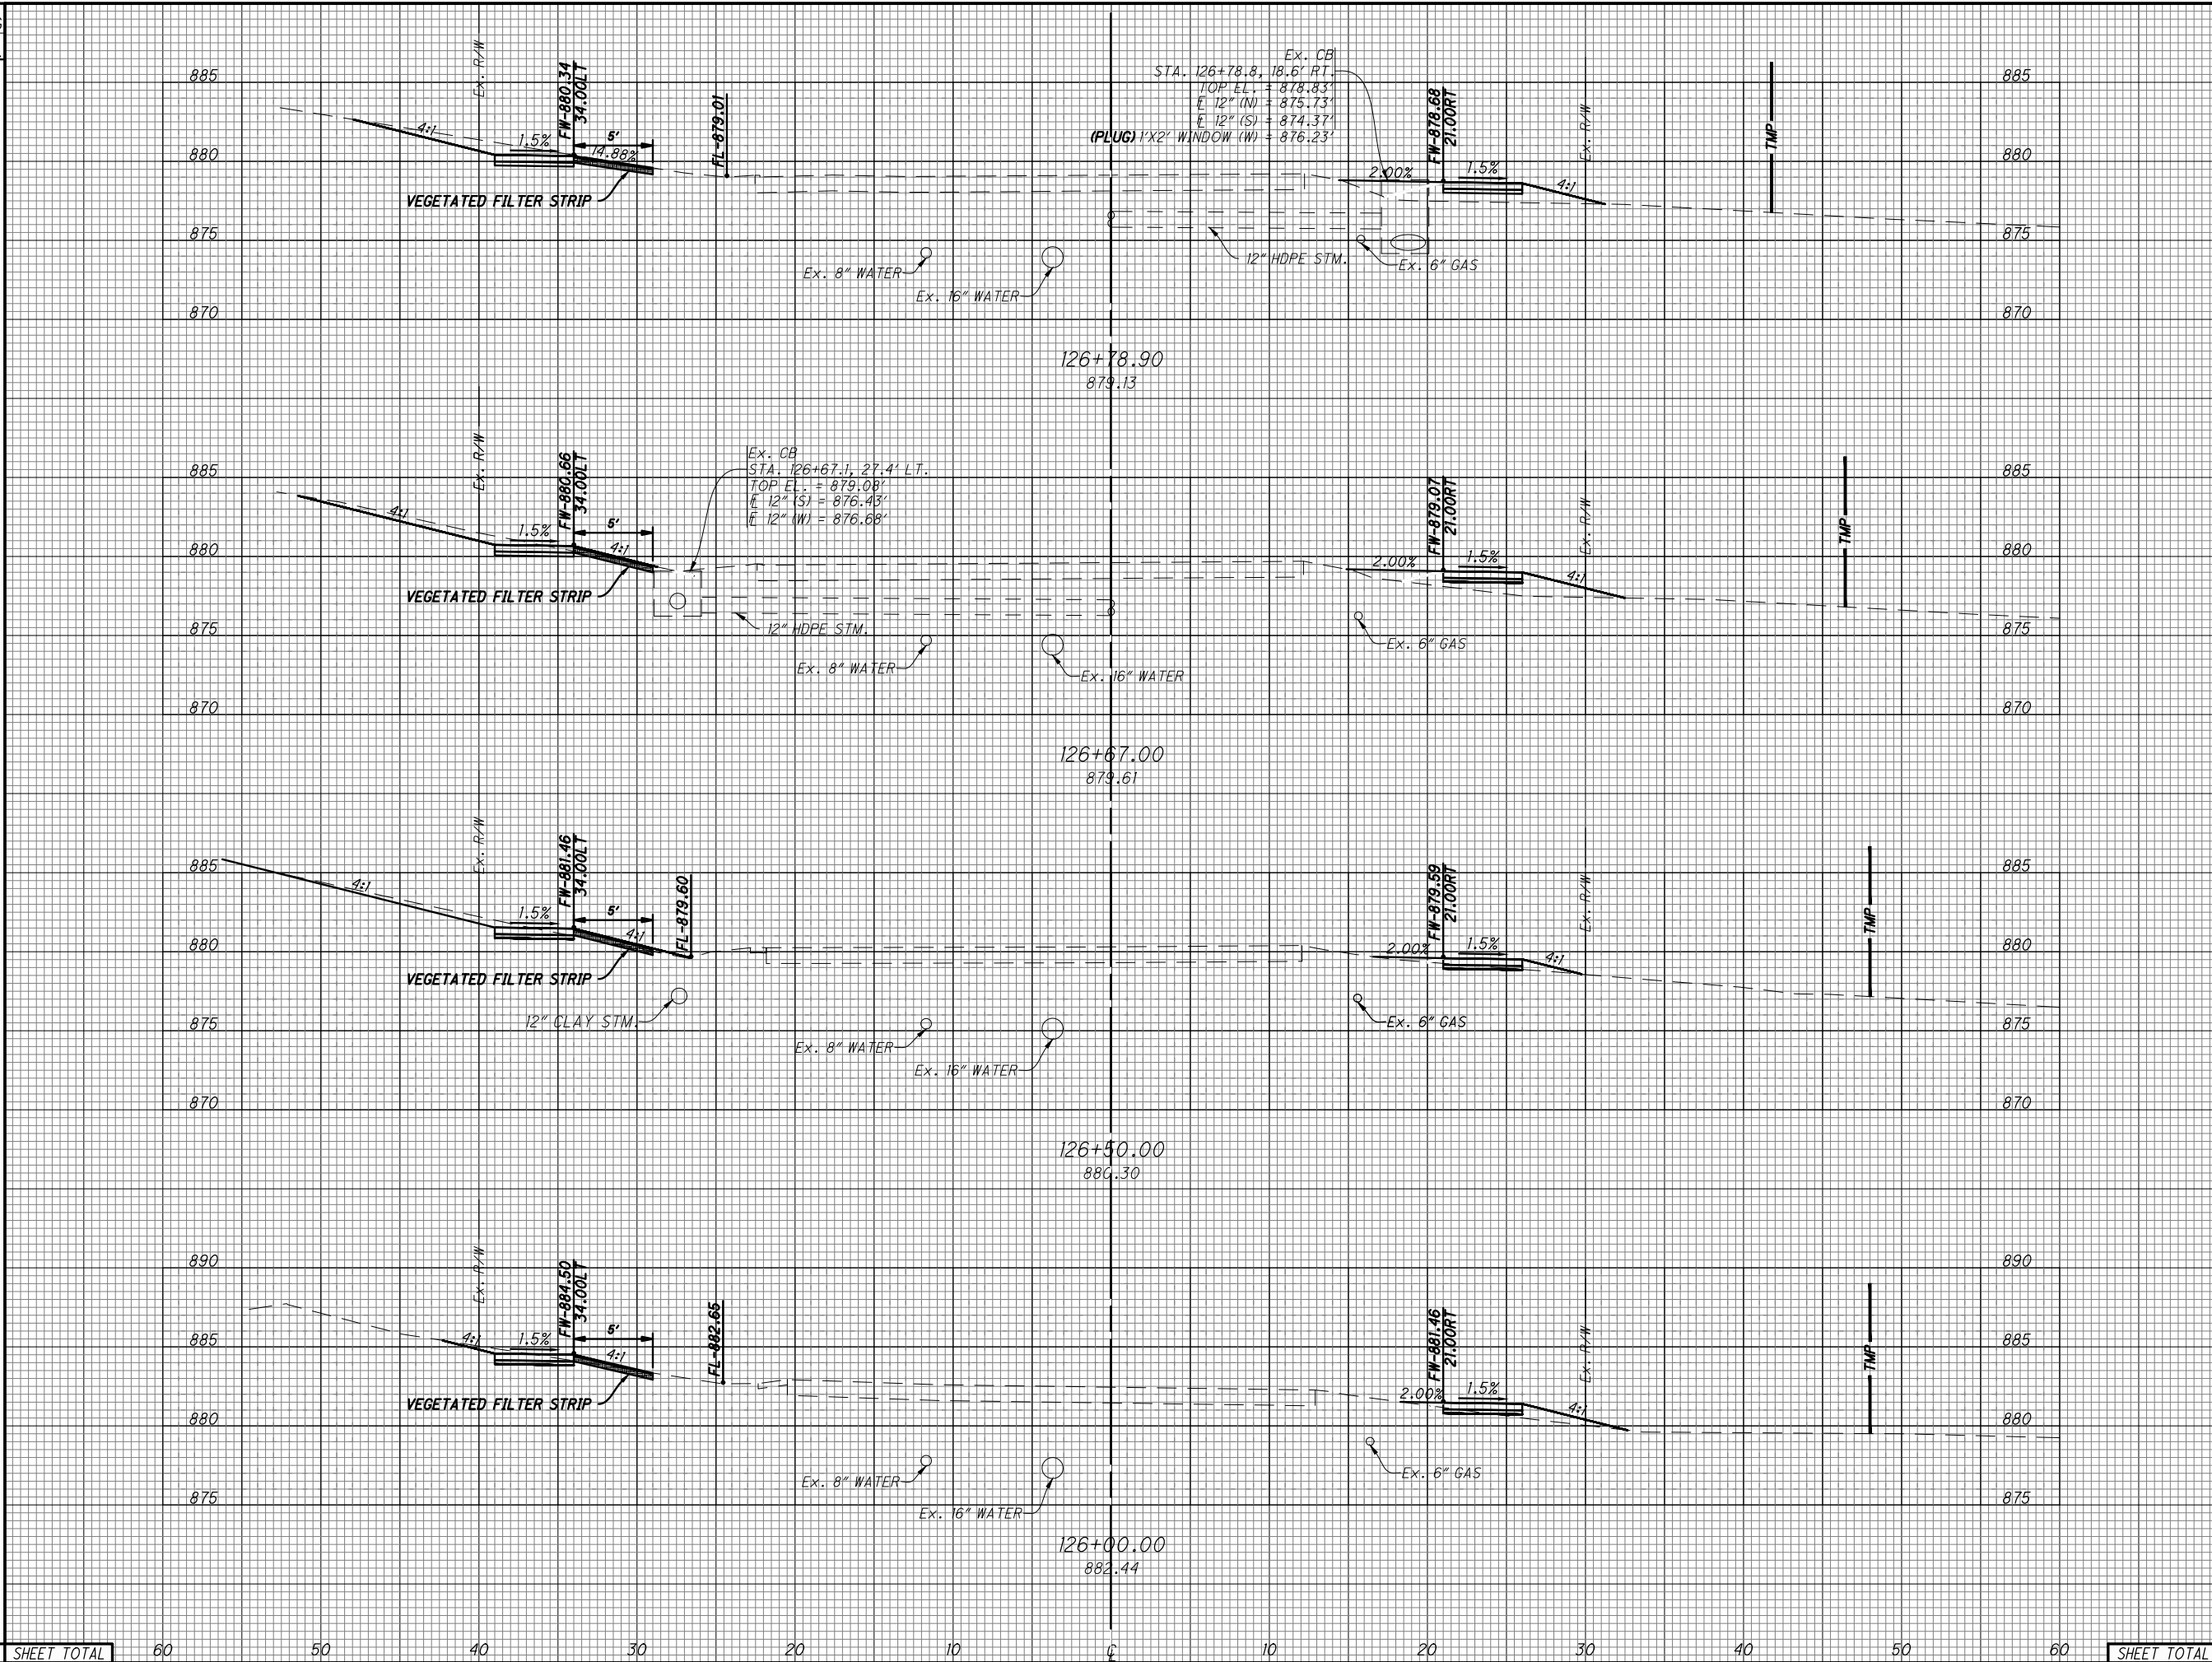


END AREA	VOLUME	
	CUT	FILL
7.1	11.5	
3.1	3.3	
6.8	11.4	
4.0	4.2	
5.9	1.9	
8.6	5.0	
3.4	3.5	
12.5	2.0	
<b>23.2</b>	<b>28.3</b>	<b>28.2</b>
<b>14.5</b>		

**CROSS SECTIONS - SPRINGDALE ROAD**  
**STA. 126+00 TO STA. 126+78.90**

DESIGN AGENCY  
  
 CHOICE ONE ENGINEERING  
 DESIGNER  
 IJW  
 REVIEWER  
 BAW 7-23-2025  
 PROJECT ID  
 120861  
 SHEET TOTAL  
 P.36 53

SEEDING  
END SO.  
WIDTH VDS.

SEEDING AND MULCHING AREAS MEASURED IN AUTOCAD - QUANTITY SHOWN IN GENERAL NOTES

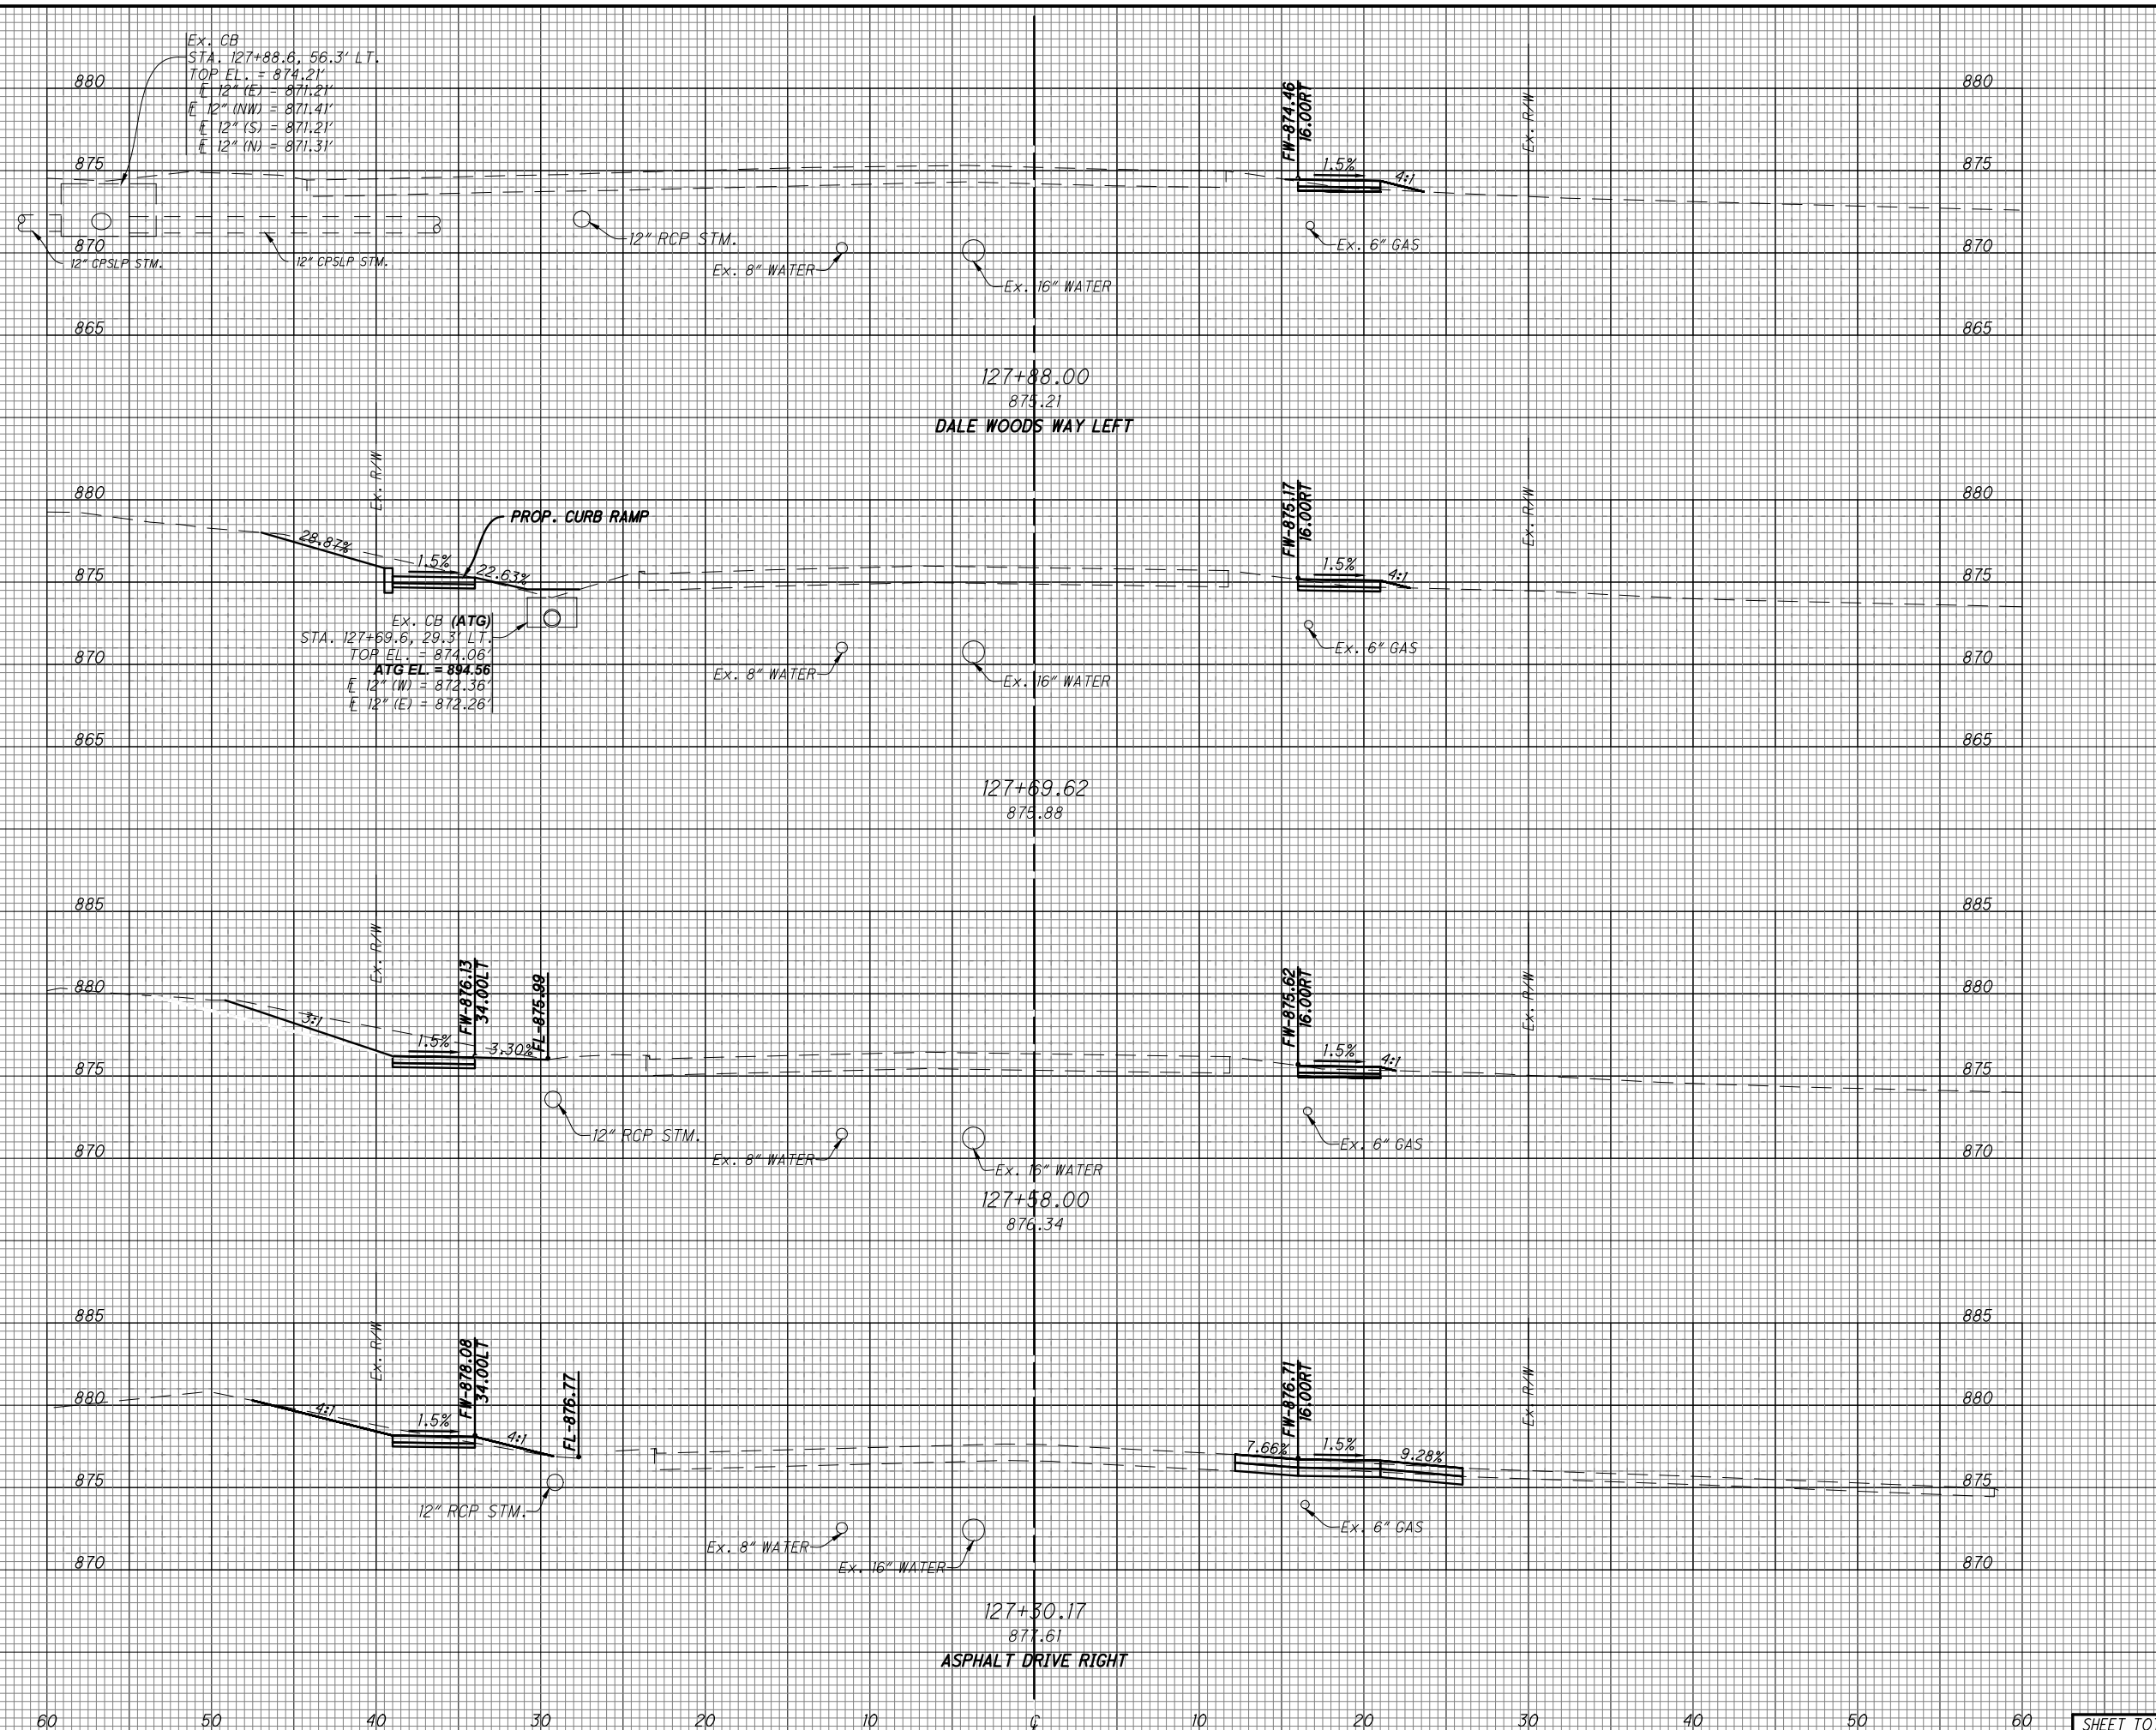


END AREA	VOLUME	
	CUT	FILL
1.1	0.7	
2.9	0.7	
7.3	1.4	
4.3	0.3	
12.5	0	
12.4	0.5	
11.5	1.0	
17.7	11.9	
<b>32.4</b>	<b>3.1</b>	<b>13.4</b>

SHEET TOTAL

60 50 40 30 20 10 0 10 20 30 40 50 60


SHEET TOTAL

CROSS SECTIONS - SPRINGDALE ROAD  
STA. 127+30.17 TO STA. 127+88

DESIGN AGENCY  
  
 CHOICE ONE ENGINEERING  
 DESIGNER  
 IJW  
 REVIEWER  
 BAW 7-23-2025  
 PROJECT ID  
 120861  
 SHEET TOTAL  
 P.37 53


SEEDING  
END SO.  
WIDTH YDS.

SEEDING AND MULCHING AREAS MEASURED IN AUTOCAD - QUANTITY SHOWN IN GENERAL NOTES

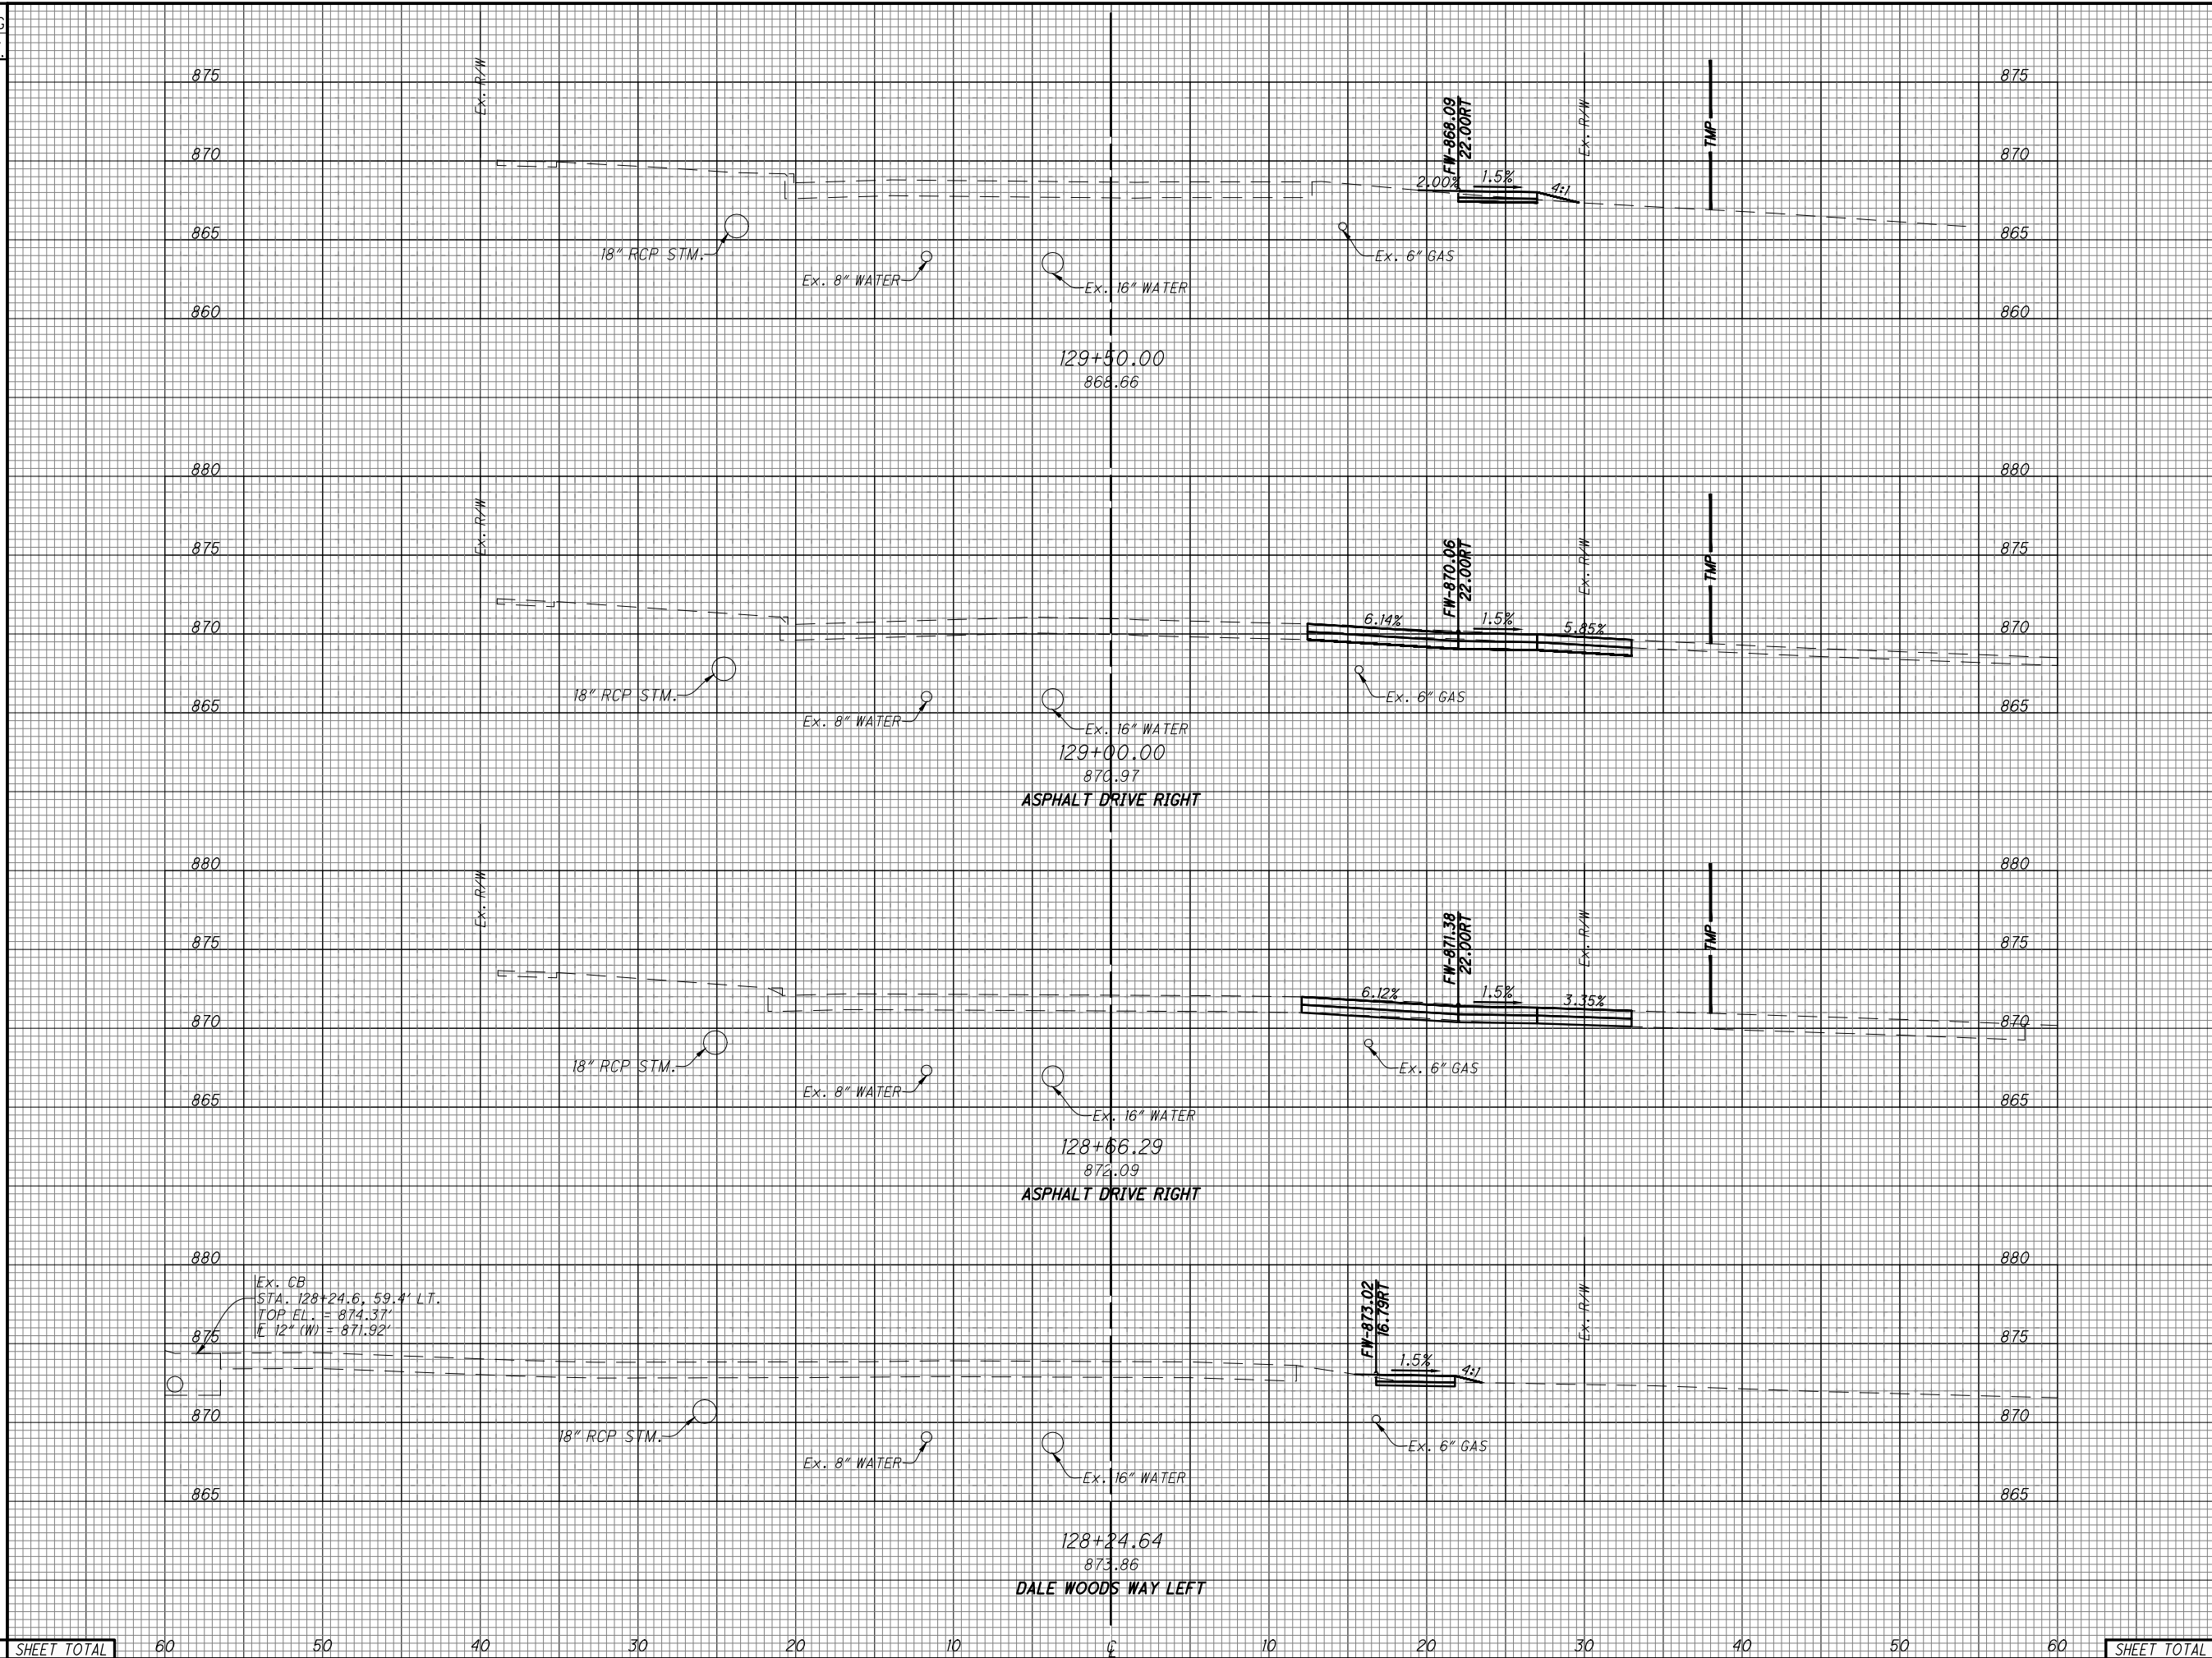


STATION	END AREA		VOLUME	
	CUT	FILL	CUT	FILL
128+24.64	1.6	0.7		
128+66.29	12.6	0.3		
129+00.00	18.4	0		
129+50.00	14.5	0		
<b>SHEET TOTAL</b>	<b>32.0</b>	<b>1.2</b>	<b>47.1</b>	<b>1.0</b>

CROSS SECTIONS - SPRINGDALE ROAD  
STA. 128+24.64 TO STA. 129+50

DESIGN AGENCY  
  
 CHOICE ONE ENGINEERING  
 DESIGNER  
 IJW  
 REVIEWER  
 BAW 7-23-2025  
 PROJECT ID  
 120861  
 SHEET TOTAL  
 P.38 53

SEEDING  
END SO.  
WIDTH YDS.

SEEDING AND MULCHING AREAS MEASURED IN AUTOCAD - QUANTITY SHOWN IN GENERAL NOTES

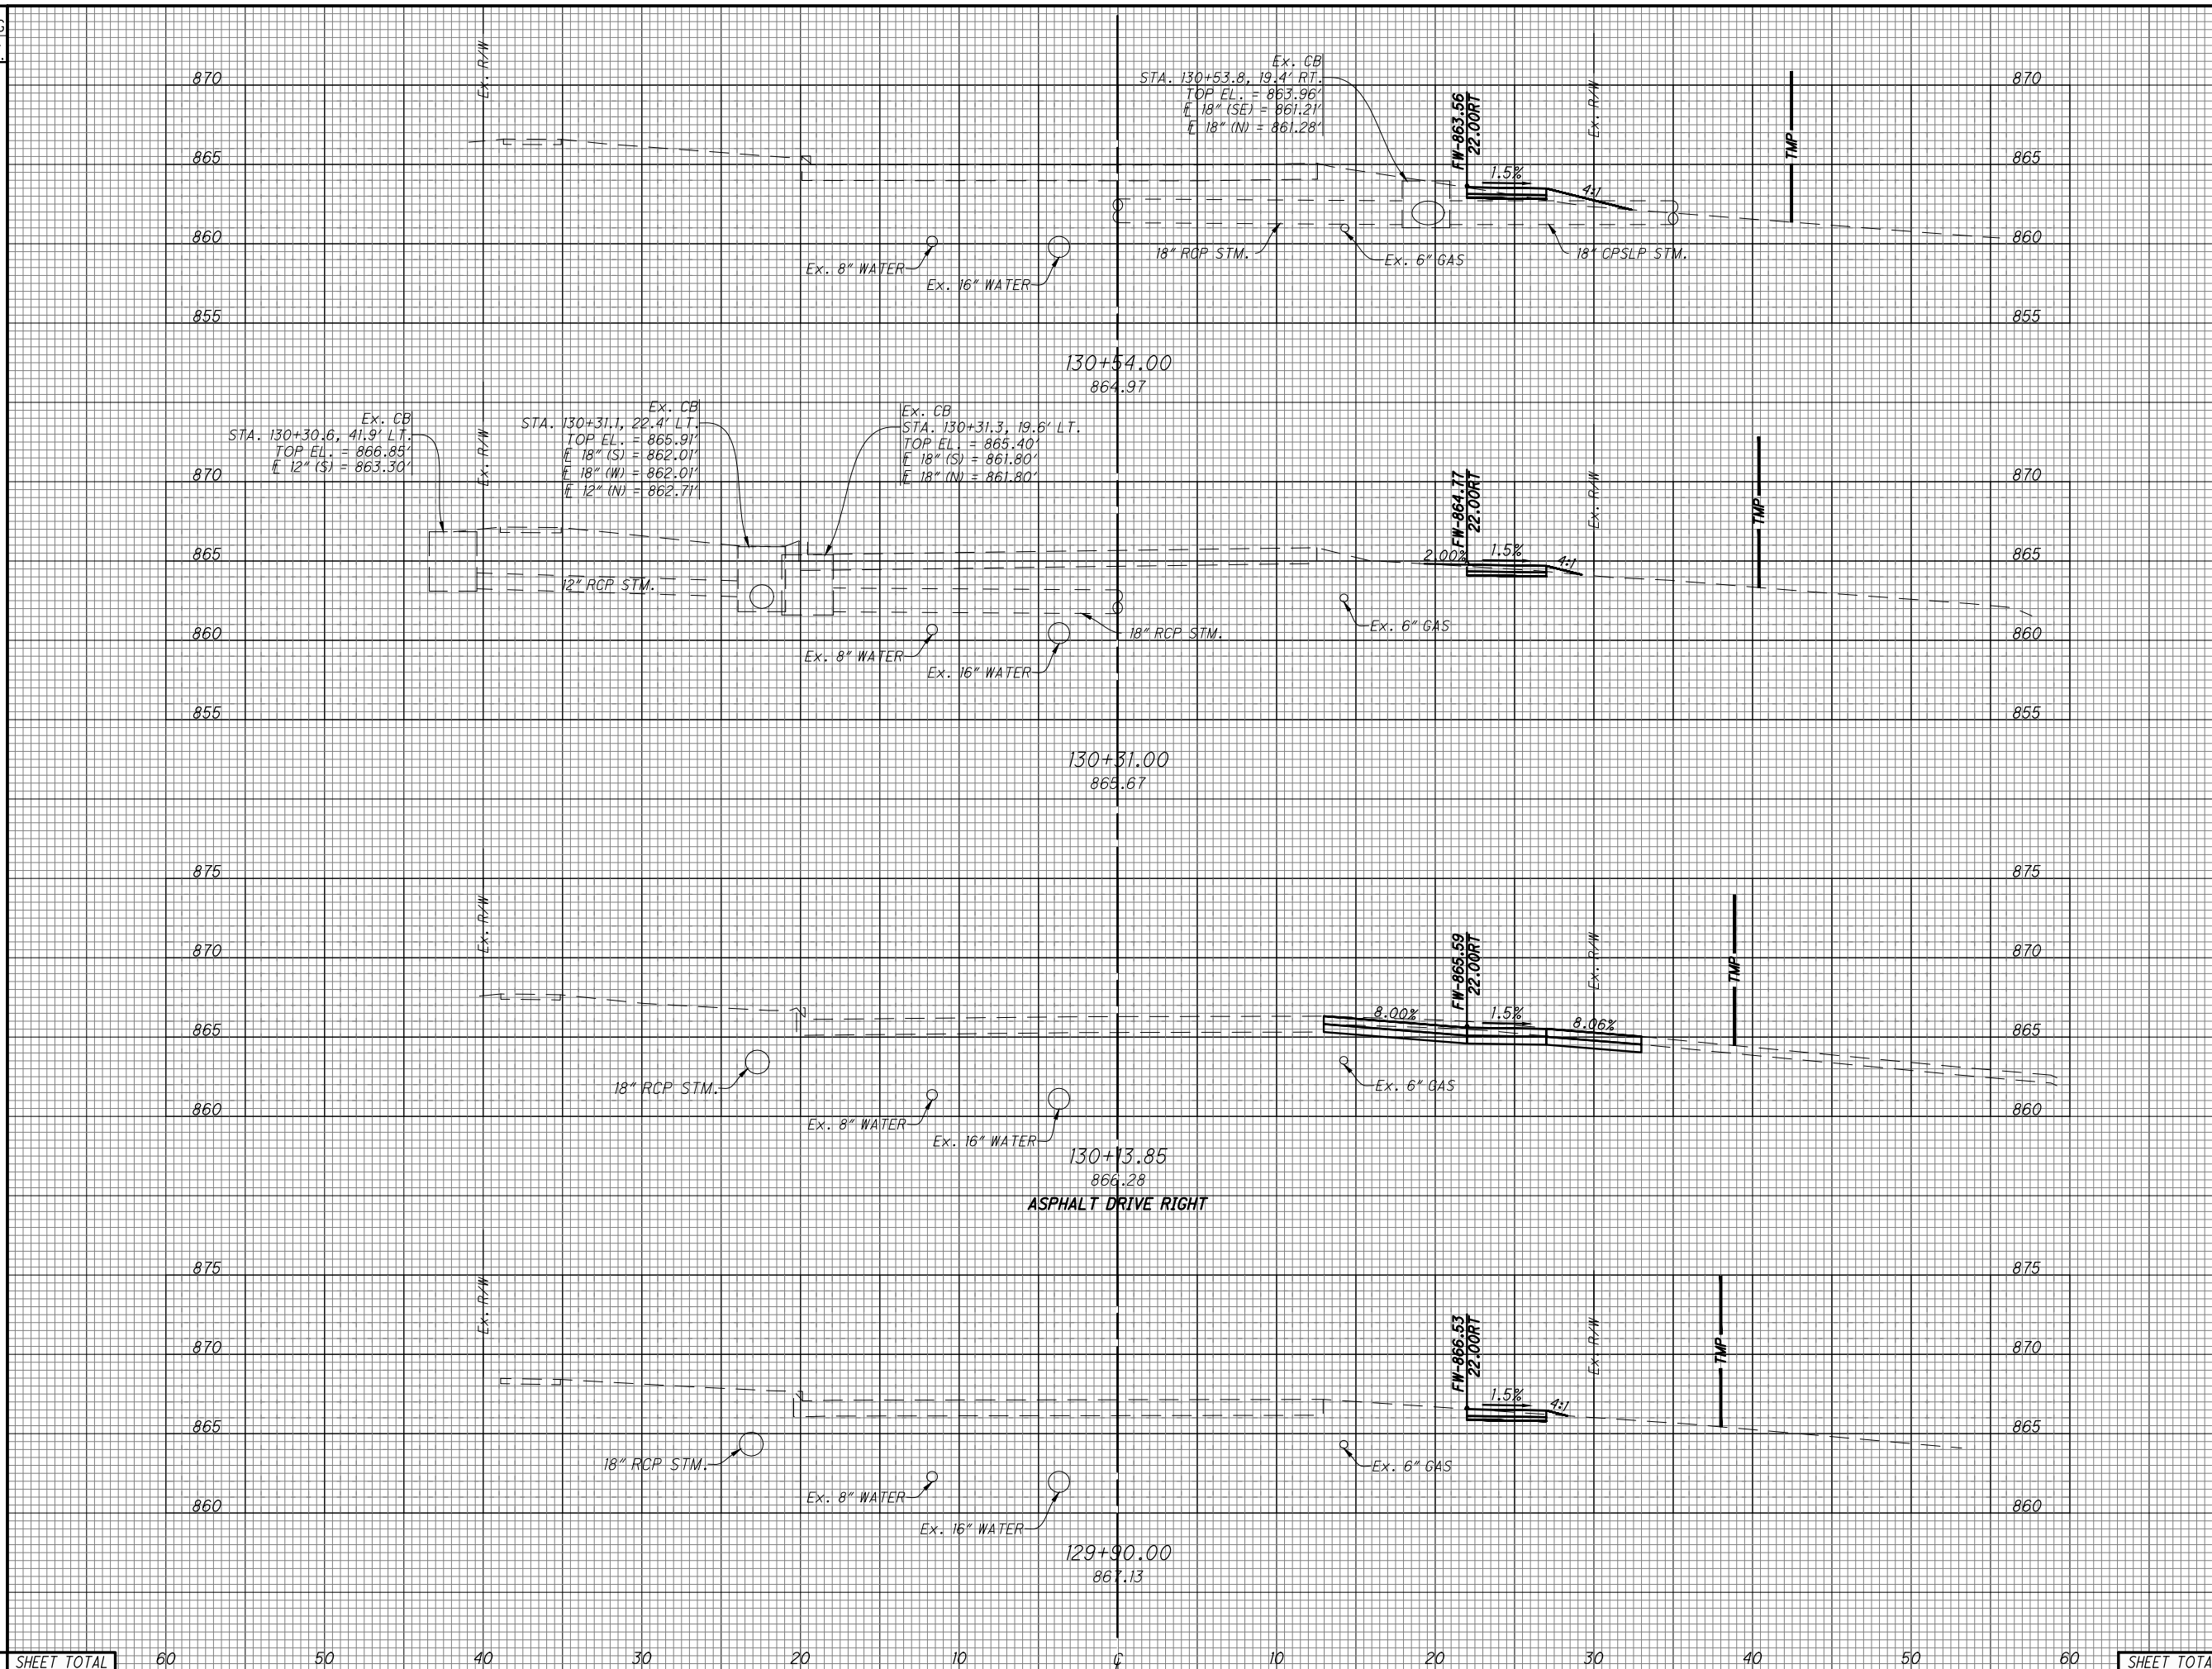


END AREA	VOLUME	
	CUT	FILL
0.9	2.3	
0.9	0.2	
1.3	0.5	
5.7	0.2	
16.6	0	
7.9	0.1	
1.3	0.2	
1.9	0.7	
<b>SHEET TOTAL</b>	<b>20.1</b>	<b>3</b>
	<b>16.4</b>	<b>1.2</b>

CROSS SECTIONS - SPRINGDALE ROAD  
STA. 129+90 TO STA. 130+54

DESIGN AGENCY  
CHOICE ONE ENGINEERING  
DESIGNER  
IJJW  
REVIEWER  
BAW 7-23-2025  
PROJECT ID  
120861  
SHEET TOTAL  
P.39 53


SEEDING  
END SO.  
WIDTH YDS.

SEEDING AND MULCHING AREAS MEASURED IN AUTOCAD - QUANTITY SHOWN IN GENERAL NOTES

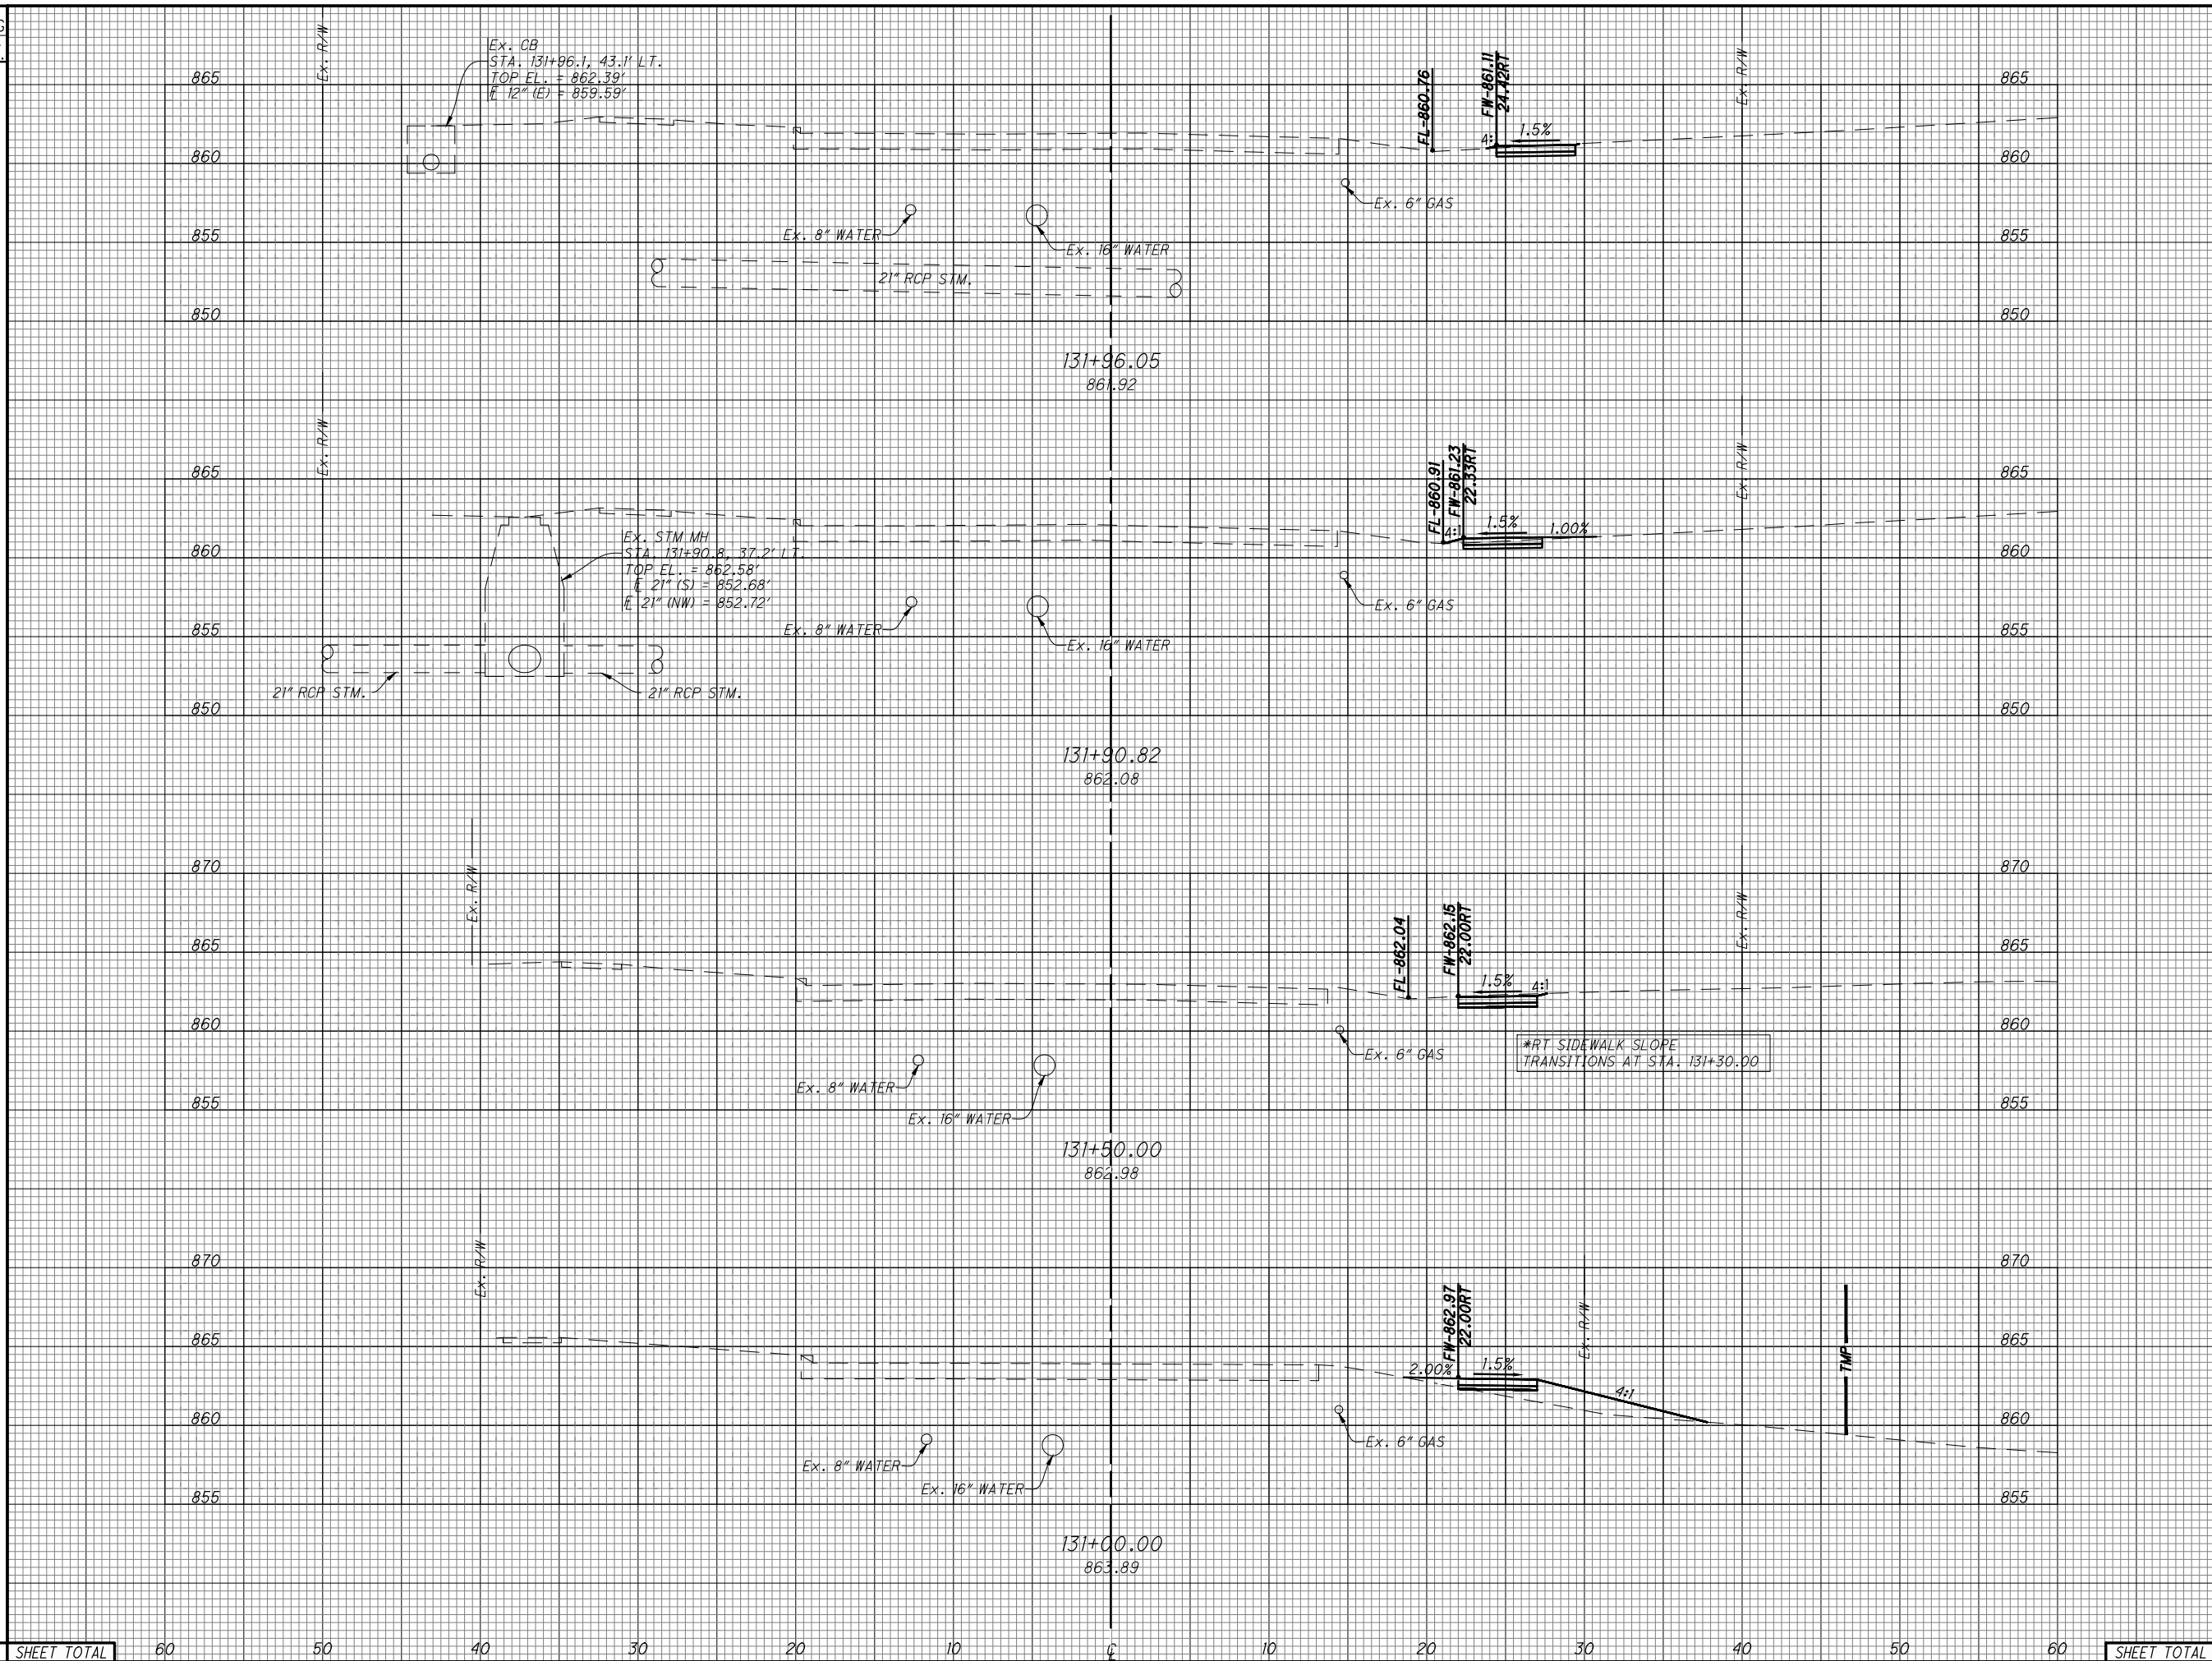

STATION	END AREA		VOLUME	
	CUT	FILL	CUT	FILL
131+96.05	1.3	0	0.3	0
131+90.82	1.3	0.4	2.0	0.3
131+50.00	1.3	0	1.2	10.8
131+00.00	0	11.7	0.8	11.9
<b>SHEET TOTAL</b>	<b>20.1</b>	<b>3</b>	<b>16.4</b>	<b>1.2</b>

**CROSS SECTIONS - SPRINGDALE ROAD  
STA. 131+00 TO STA. 131+96.05**

DESIGN AGENCY  
  
 CHOICE ONE ENGINEERING  
 DESIGNER  
 IJW  
 REVIEWER  
 BAW 7-23-2025  
 PROJECT ID  
 120861  
 SHEET TOTAL  
 P.40 53



SEEDING  
END SO.  
WIDTH YDS.


SEEDING AND MULCHING AREAS MEASURED IN AUTOCAD - QUANTITY SHOWN IN GENERAL NOTES




END AREA	VOLUME	
	CUT	FILL
0	0	0
0.4	0.5	0
1.3	1.7	0
0.5	0.3	0
1.3	0	0
0.8	0	0
<b>20.1</b>	<b>3</b>	<b>16.4</b>

SHEET TOTAL 60 50 40 30 20 10 0 10 20 30 40 50 60 SHEET TOTAL 20.1 3 16.4 1.2


CROSS SECTIONS - SPRINGDALE ROAD  
STA. 132+11.81 TO STA. 132+38.69

DESIGN AGENCY  
  
 CHOICE ONE ENGINEERING  
 DESIGNER  
 IJW  
 REVIEWER  
 BAW 7-23-2025  
 PROJECT ID  
 120861  
 SHEET TOTAL  
 P.41 53




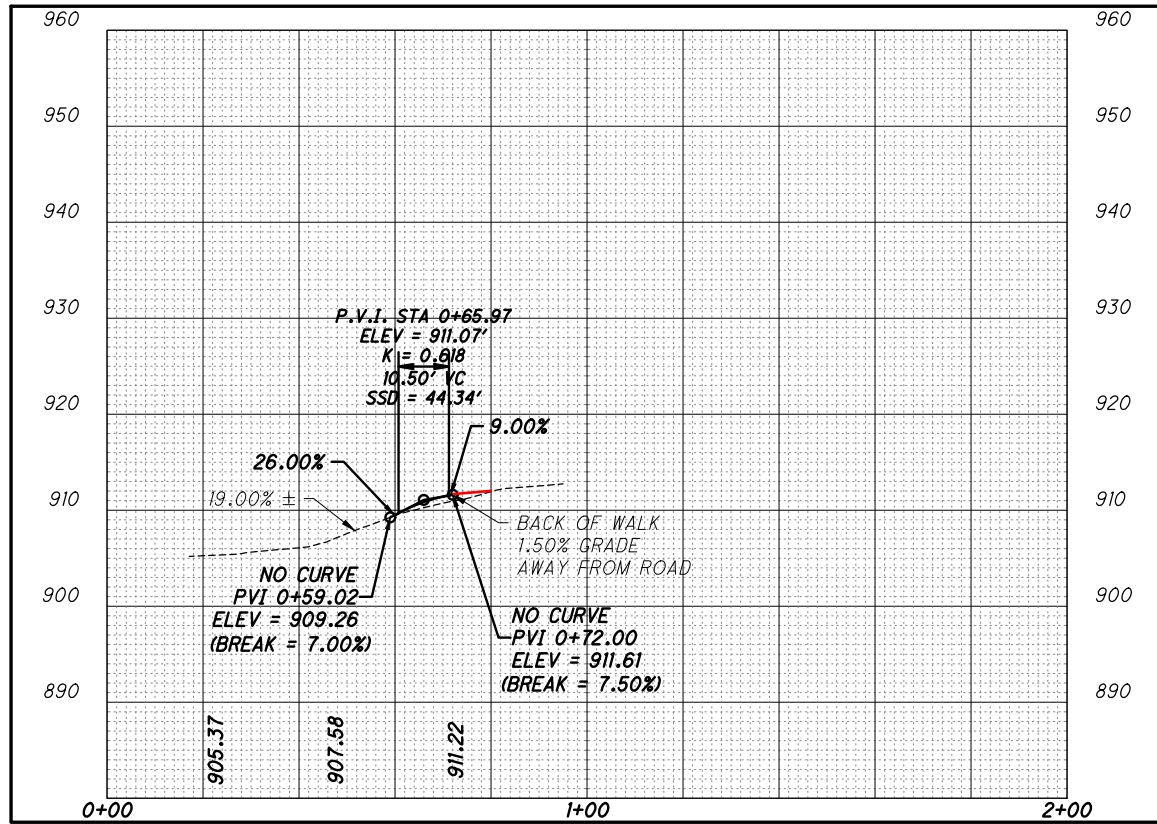


DRIVE #1  
STA. 105+08.80, LT

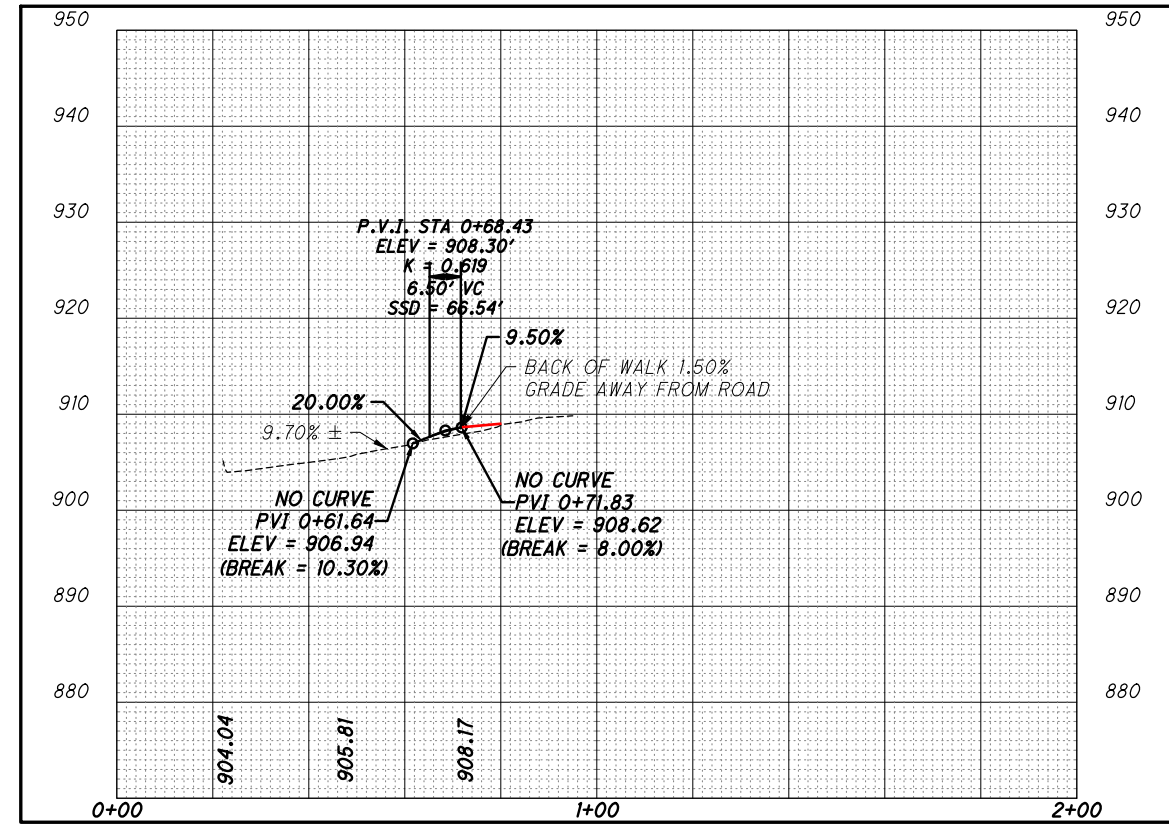


DRIVE #3  
STA. 109+71.48, LT

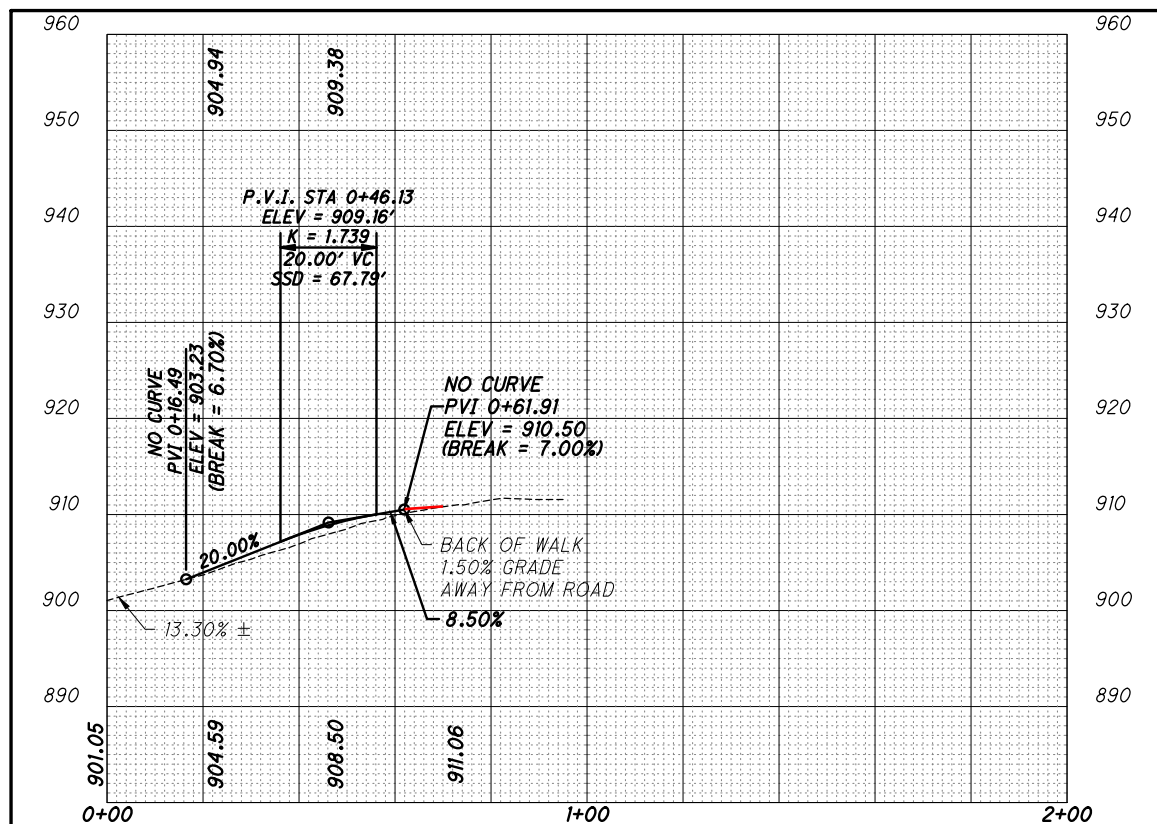

DRIVE #2  
STA. 108+52.64, LT

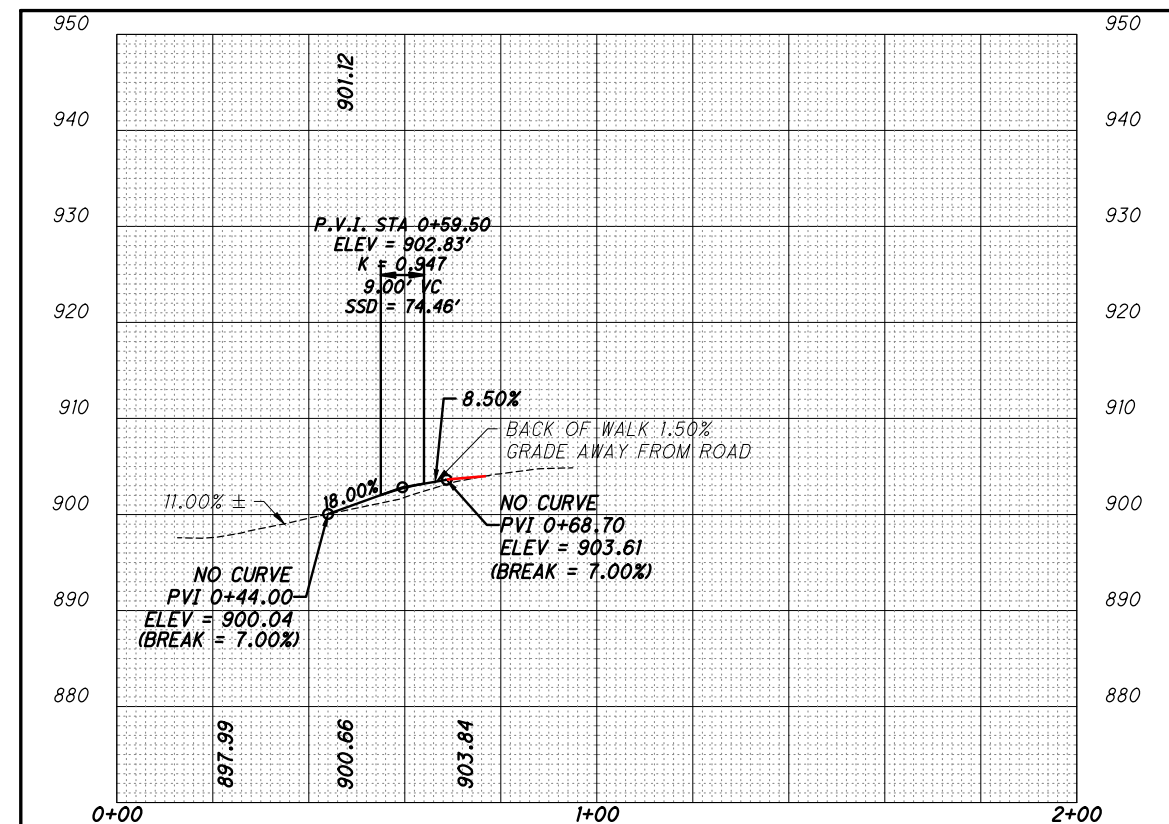

DRIVE #4  
STA. 111+66.69, LT

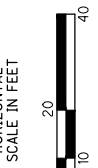

DRIVE DETAILS (PROFILES)

DESIGN AGENCY



CHOICE ONE ENGINEERING

DESIGNER

IJW

REVIEWER


BAW 7-23-2025

PROJECT ID


120861

SHEET TOTAL


P.43 53

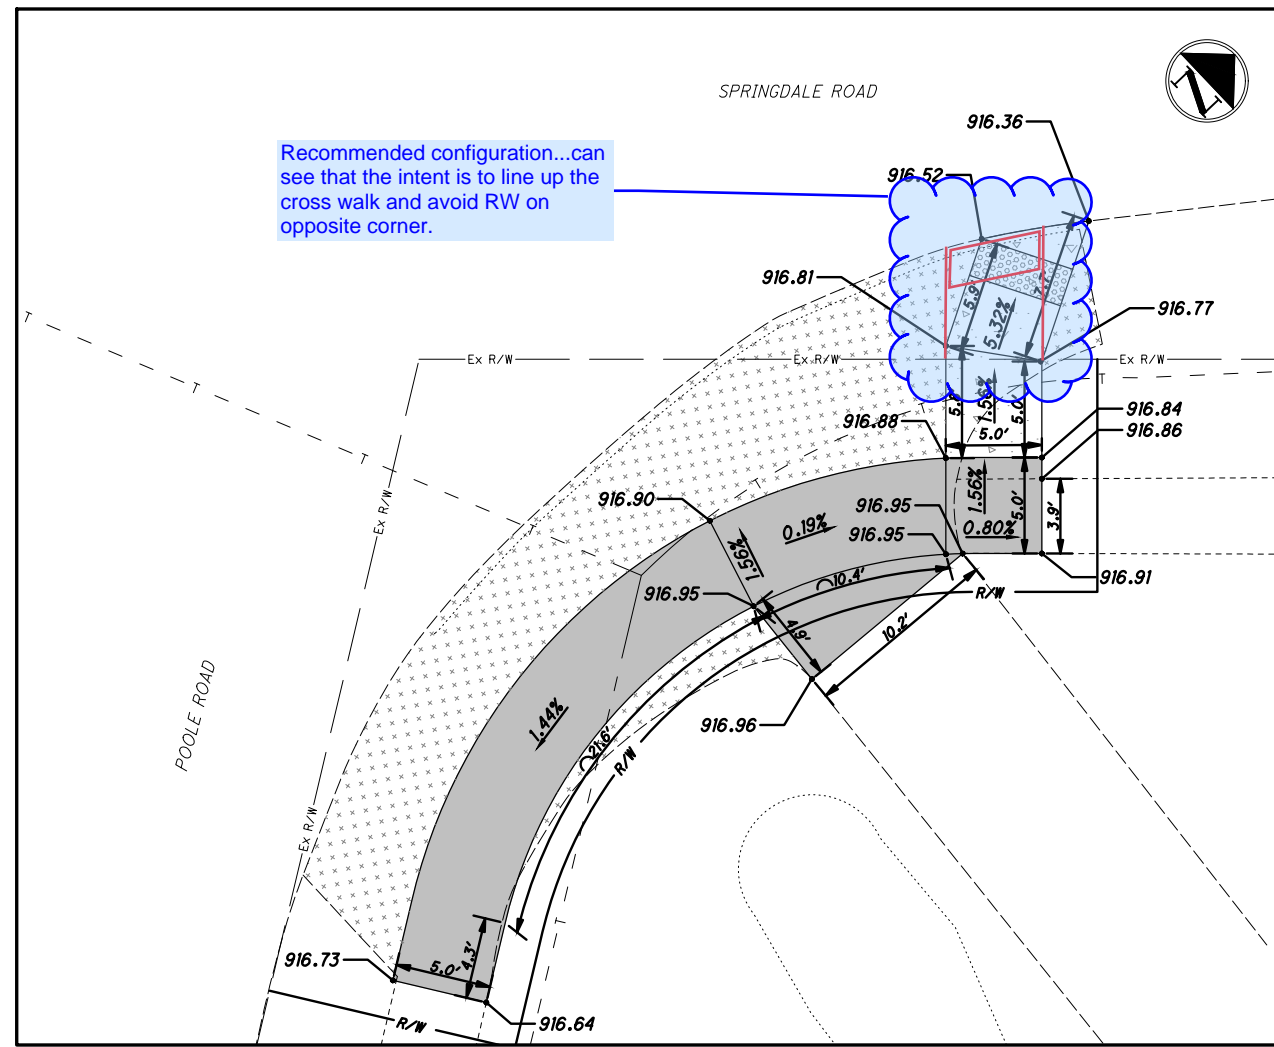


CURB RAMP #1  
SE CORNER OF SPRINGDALE RD. AND POOLE RD.

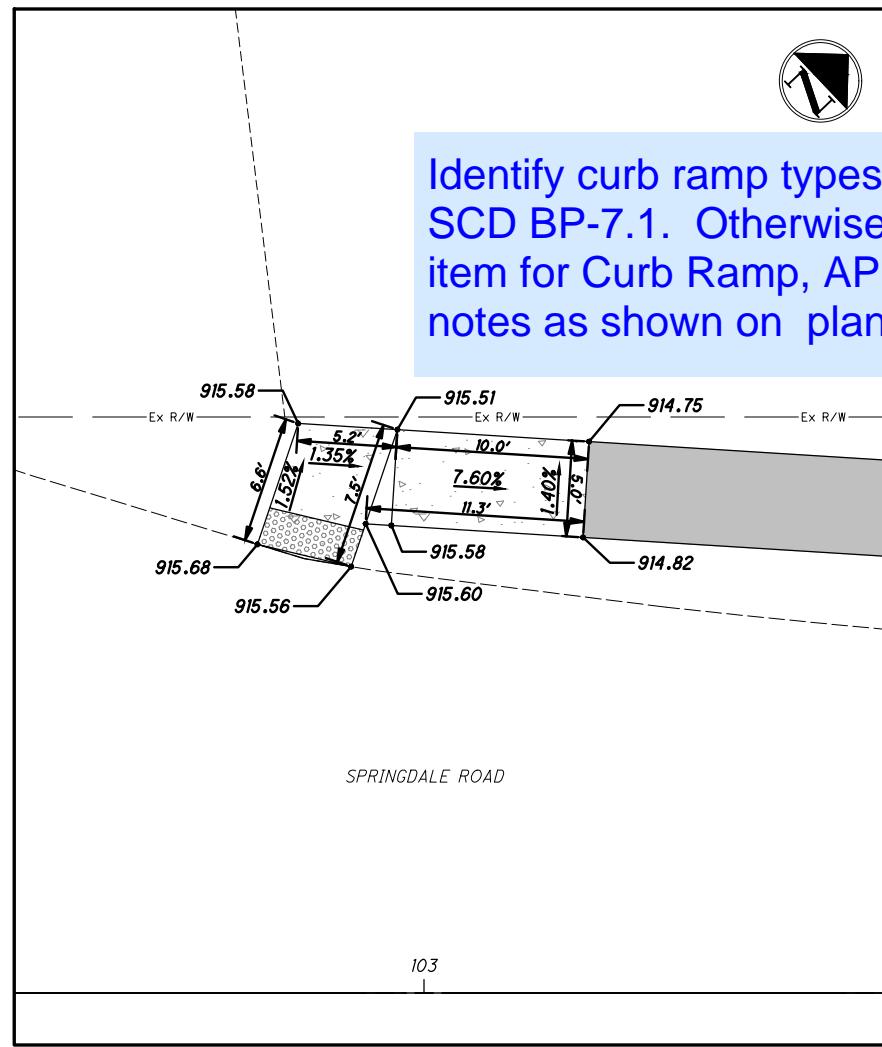


CURB RAMP #2  
NE CORNER OF SPRINGDALE RD. AND POOLE RD.

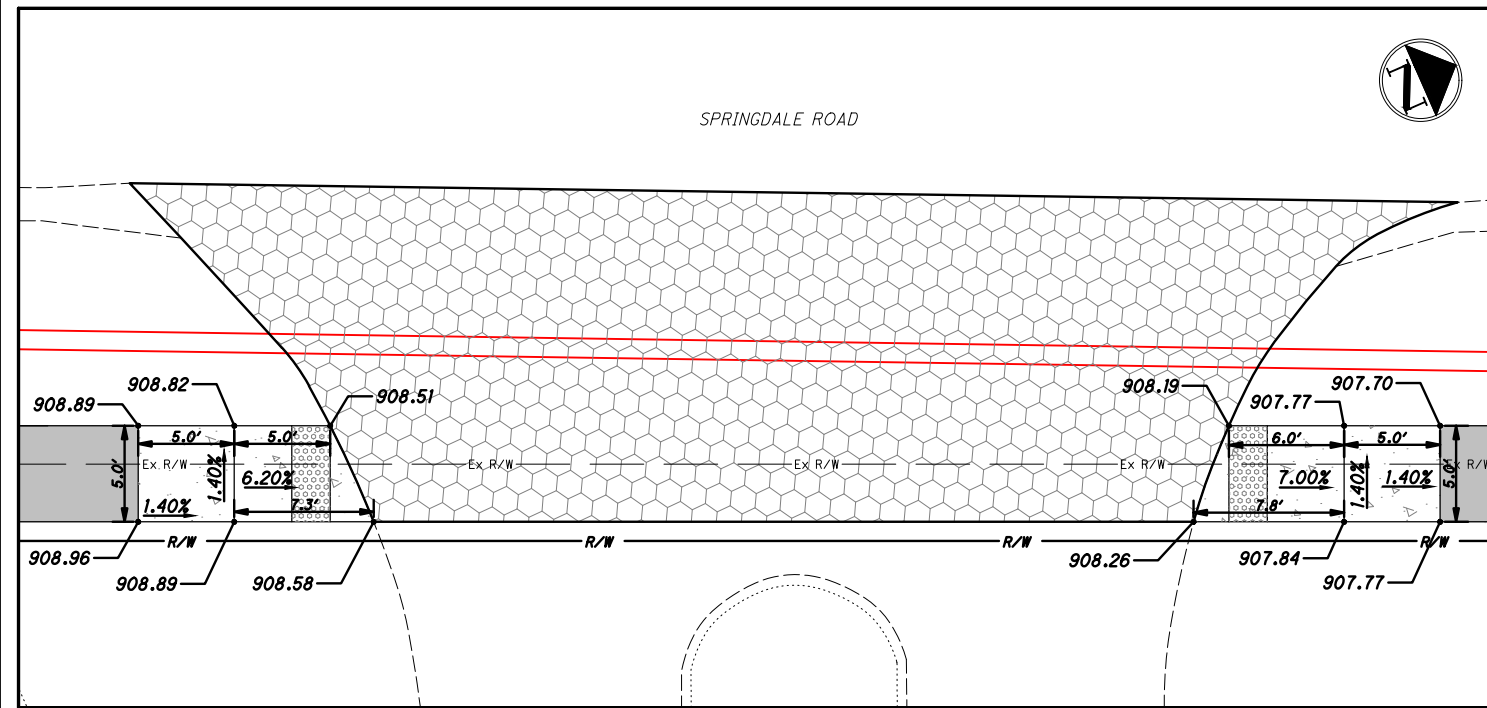

CURB RAMP #3 & #4  
COLERAIN PARK ENTRANCE


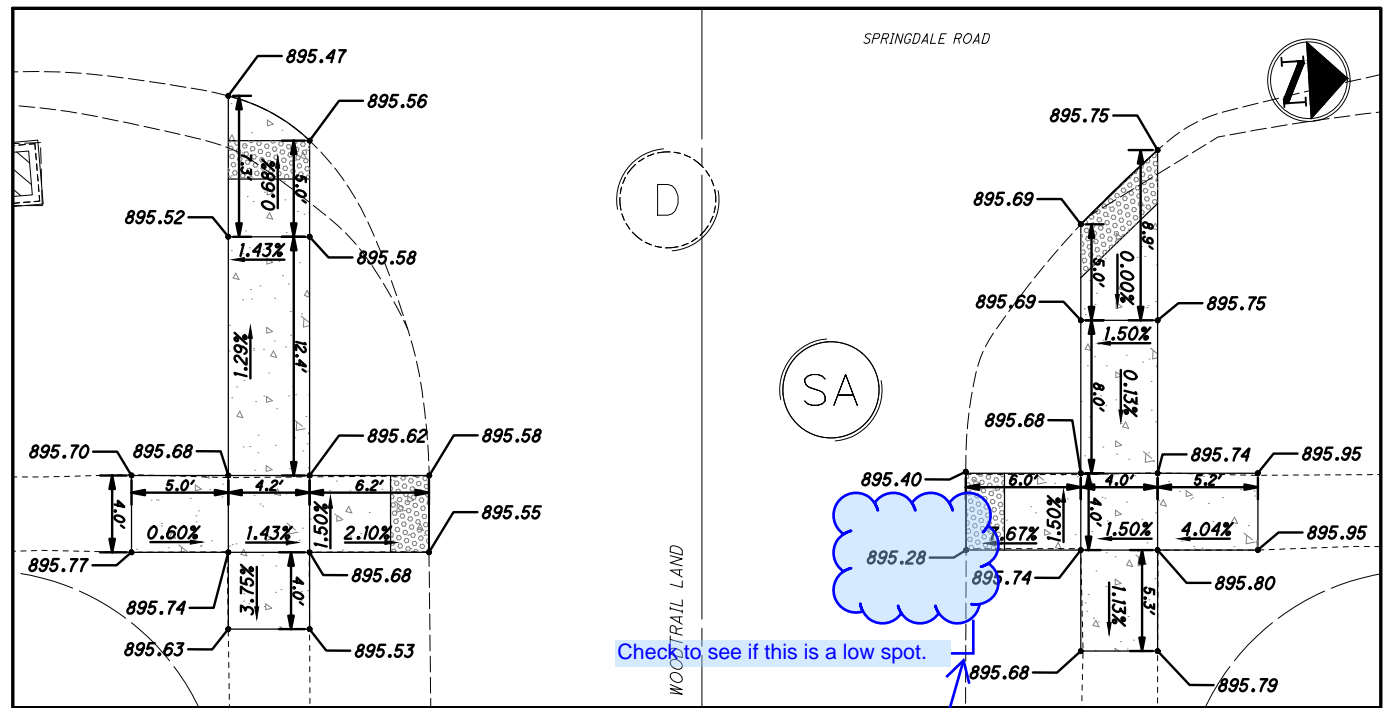


CURB RAMP #5 & #6  
EAST SIDE OF SPRINGDALE RD. AT WOODTRAIL LN.

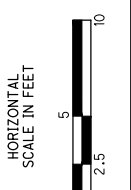

CURB RAMP DETAILS





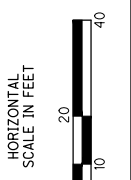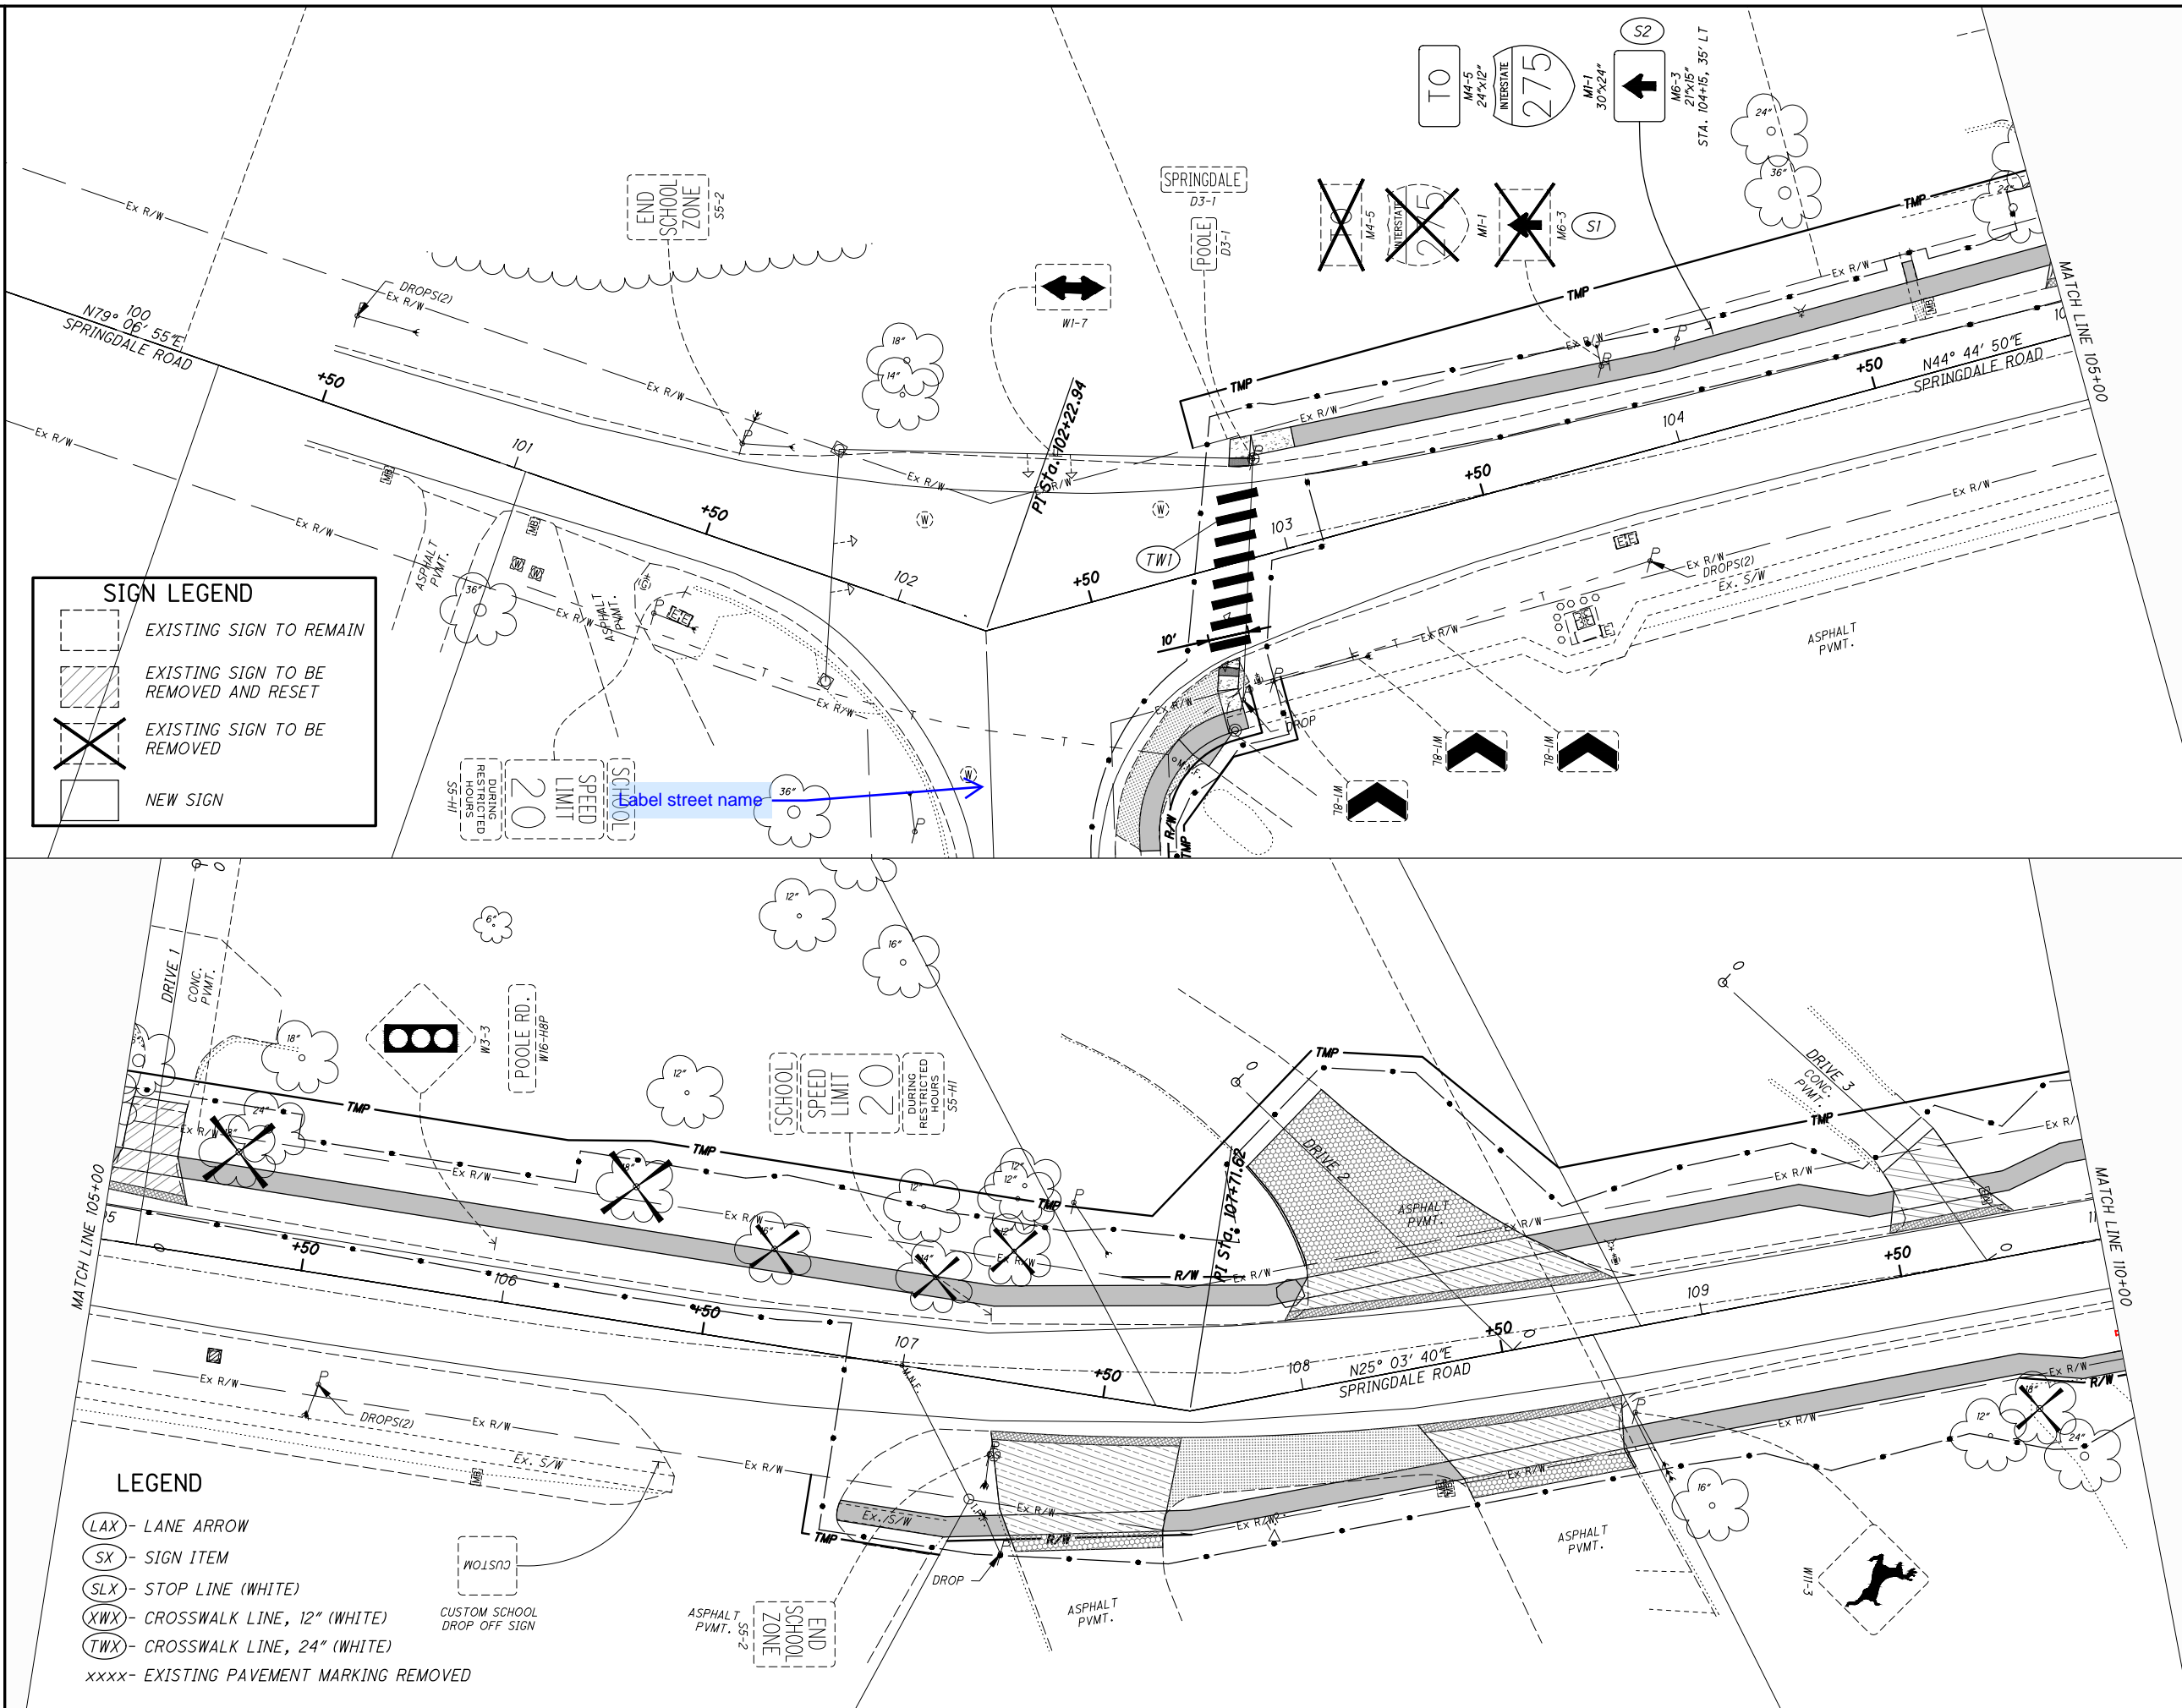

**TRAFFIC CONTROL PLAN - SPRINGDALE ROAD**  
 STA. 100+00 to STA. 110+00



DESIGN AGENCY	
CHOICE ONE ENGINEERING	
DESIGNER	
IJW	
REVIEWER	
BAW 7-23-2025	
PROJECT ID	
120861	
SHEET	TOTAL
P.46	53

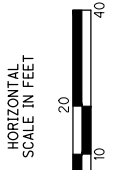
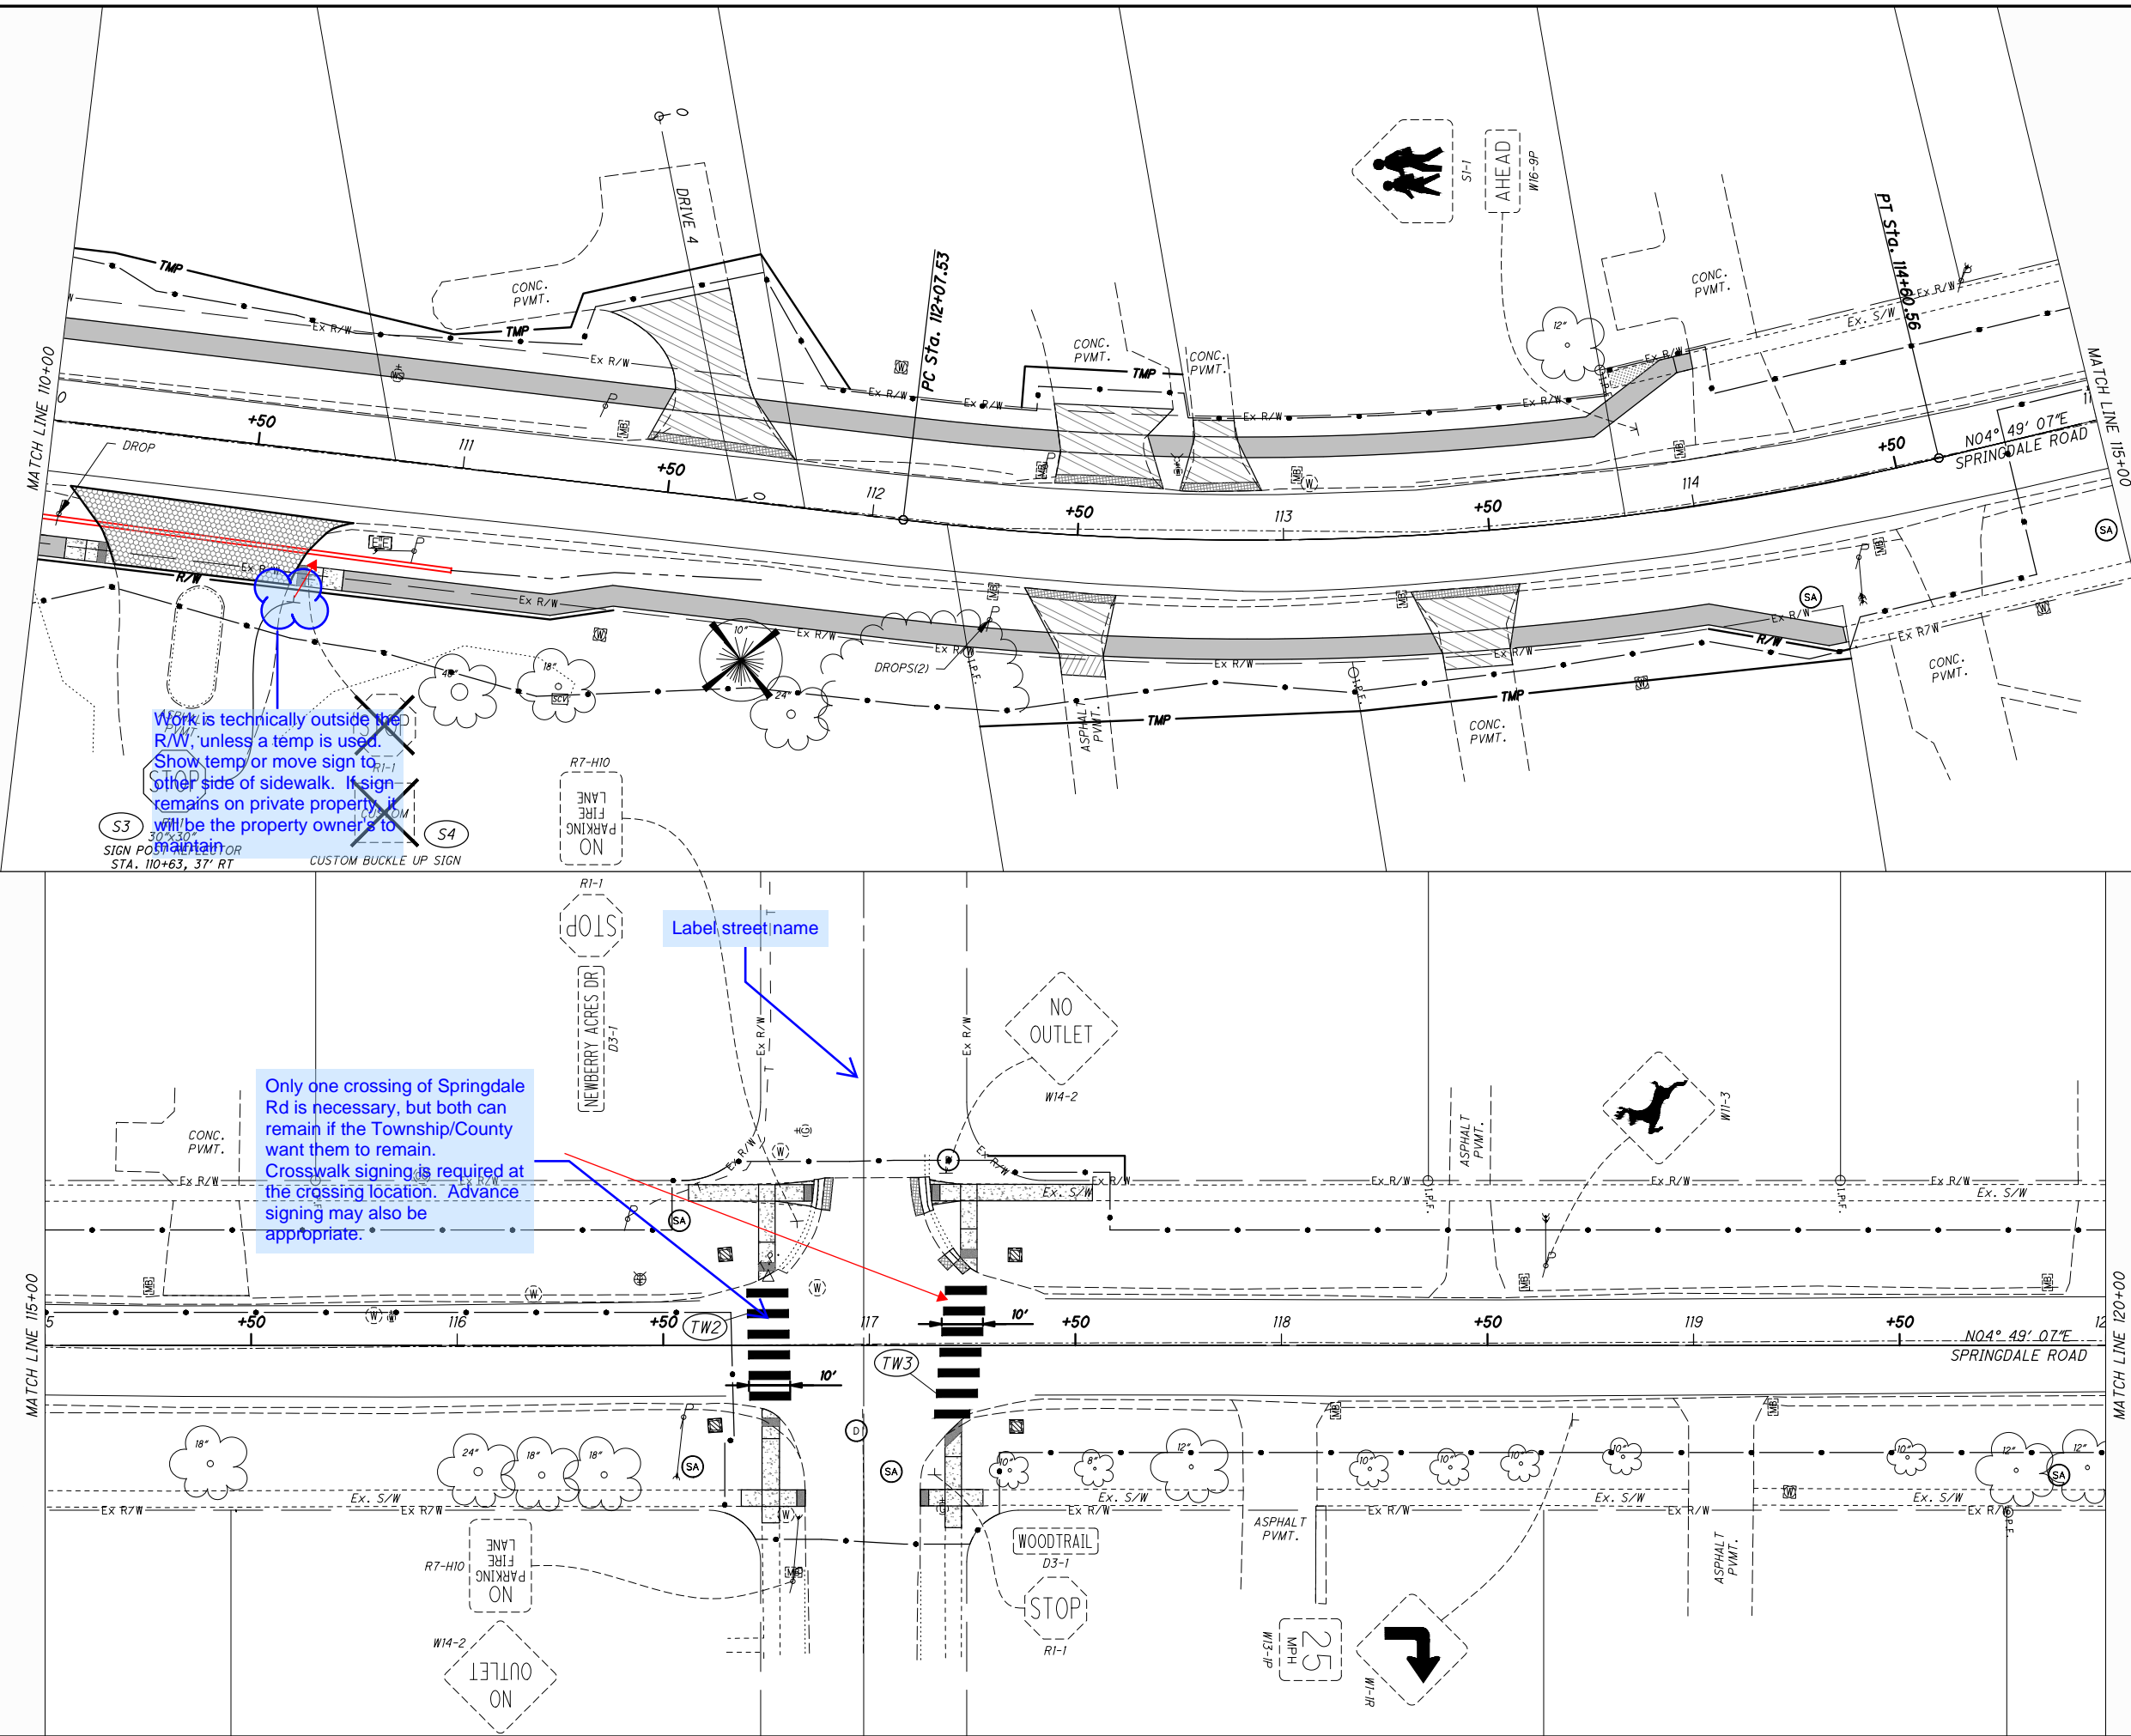


**TRAFFIC CONTROL PLAN - SPRINGDALE ROAD**  
STA. 110+00 to STA. 120+00

DESIGN AGENCY




DESIGNER	IJW
REVIEWER	BAW 7-23-2025
PROJECT ID	120861
SHEET TOTAL	P.47 53

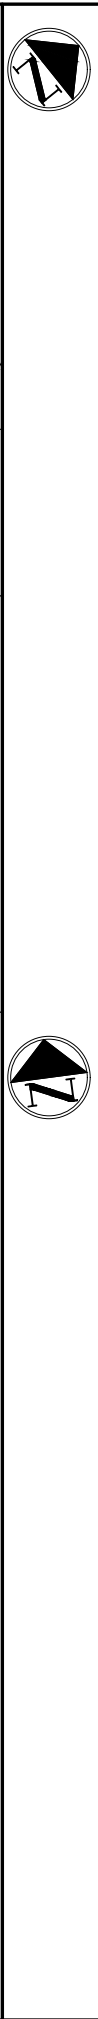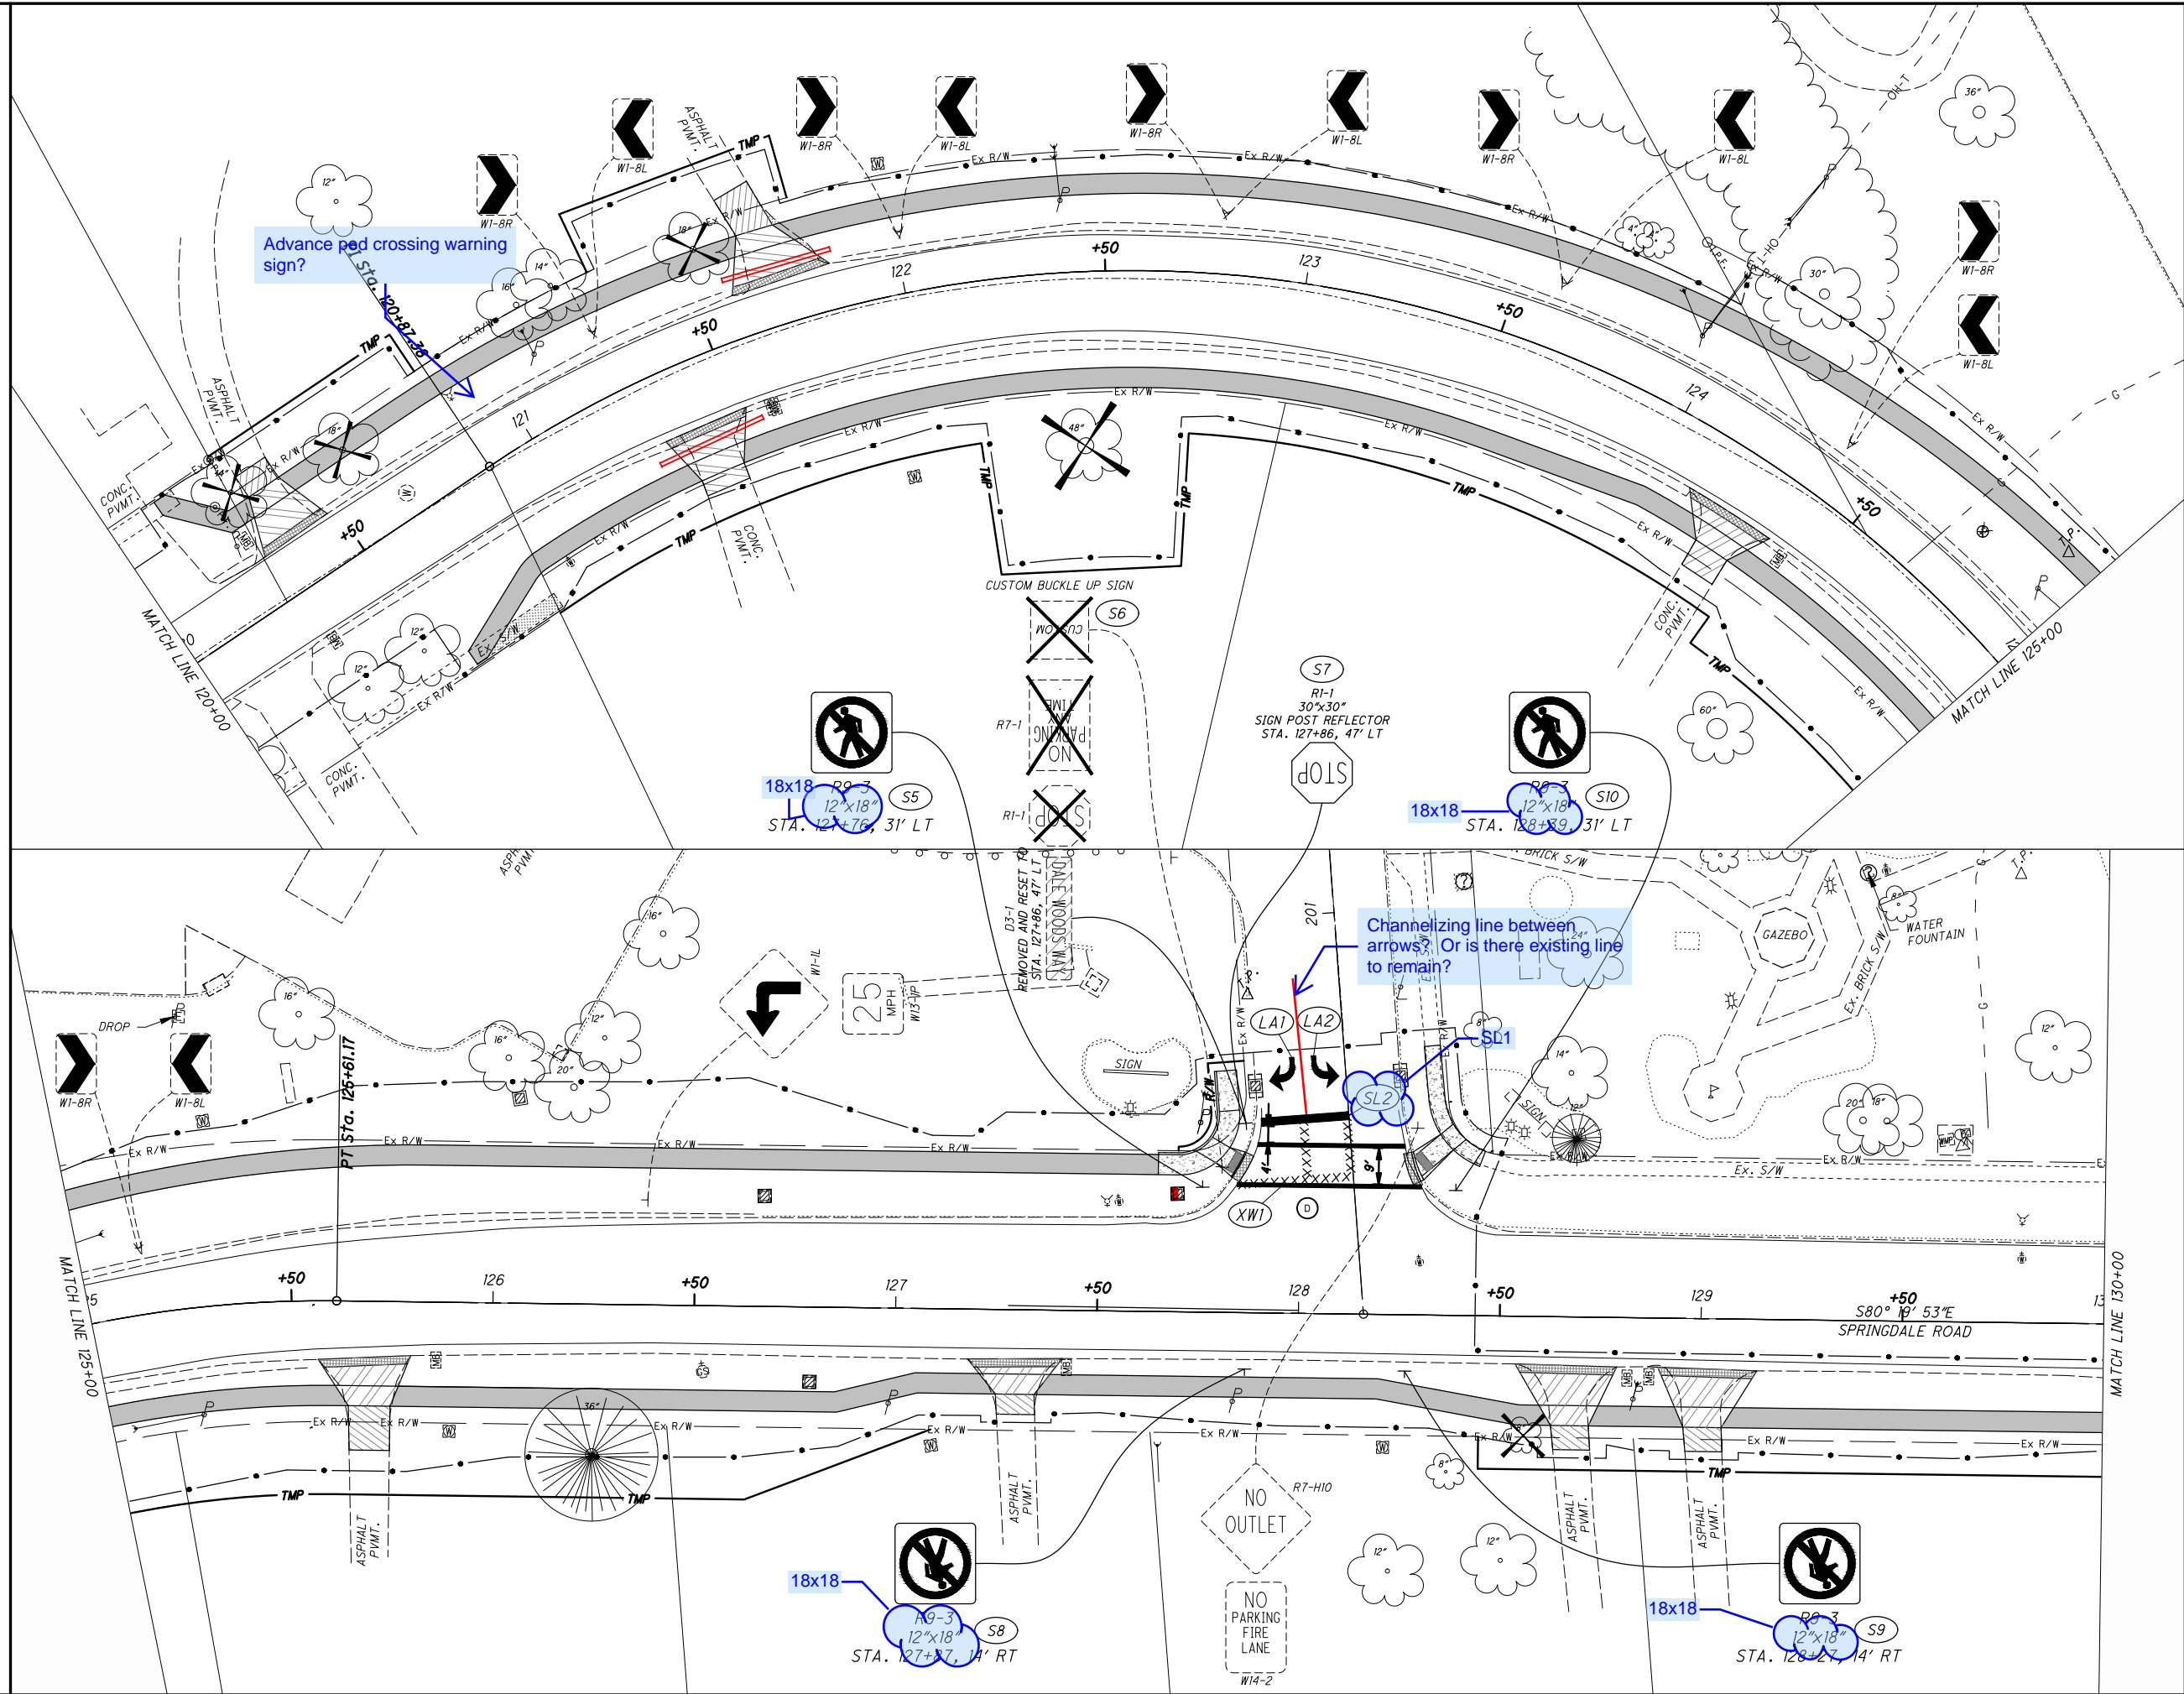

**TRAFFIC CONTROL PLAN - SPRINGDALE ROAD**  
 STA. 120+00 to STA. 130+00

DESIGN AGENCY	
CHOICE ONE ENGINEERING	
DESIGNER	
IJW	
REVIEWER	
BAW 7-23-2025	
PROJECT ID	
120861	
SHEET	TOTAL
P.48	53







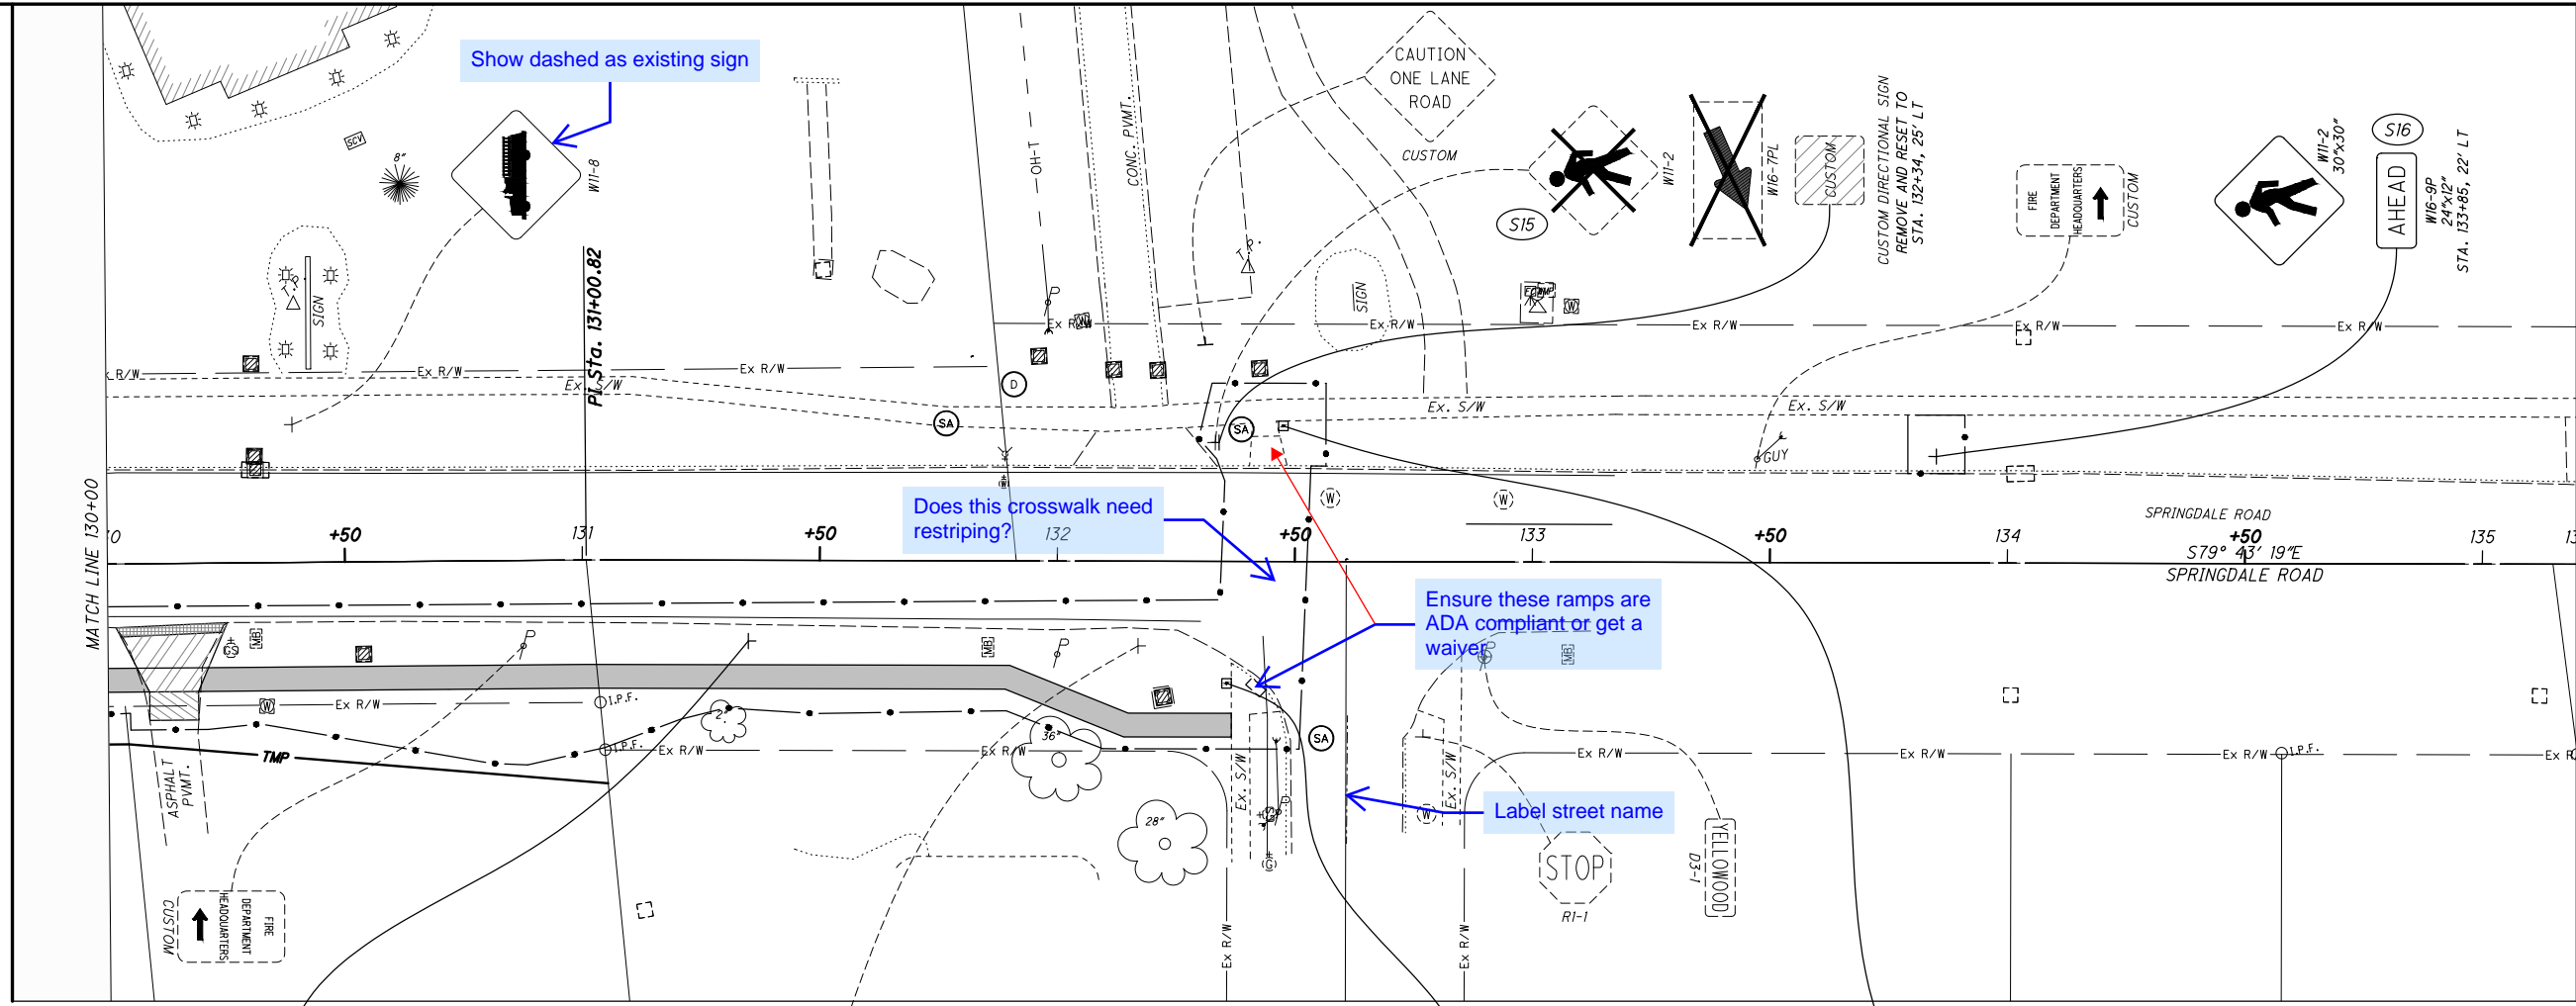


Show dashed as existing sign

Does this crosswalk need restriping?

Ensure these ramps are ADA compliant or get a waiver

Label street name

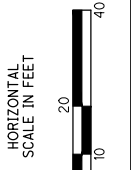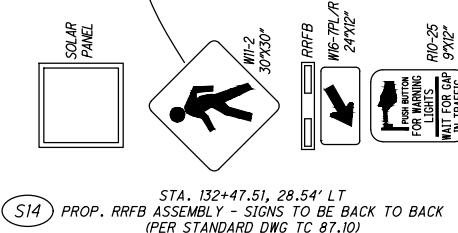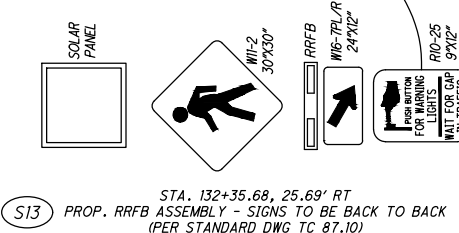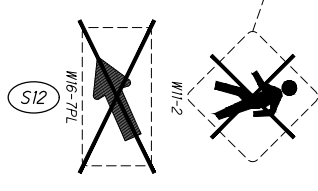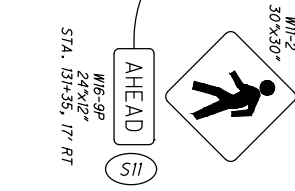

**TRAFFIC CONTROL PLAN - SPRINGDALE ROAD**  
 STA. 130+00 to STA. 135+00

DESIGN AGENCY	
CHOICE ONE ENGINEERING	
DESIGNER	IJW
REVIEWER	IJW
PROJECT ID	BAW 7-23-2025
	120861
SHEET	TOTAL
P.49	53

# ODOT STANDARD CONSTRUCTION DRAWINGS

DRAWINGS IN THESE PLANS SHALL BE CONSIDERED AS REFERENCE TO ITEMS 625, 632, 633, 725, 730, 732 AND 733 RESPECTIVELY.

ALL MATERIALS MUST BE IN COMPLIANCE WITH CONTRACT SPECIFICATIONS UNLESS OTHERWISE APPROVED BY ODOT, TOWNSHIP, AND THE COUNTY. ALL WORK AND MATERIALS NOT SPECIFICALLY REFERENCED IN THE CONTRACT SHALL MEET OR EXCEED THE REQUIREMENTS OF:

OHIO DEPARTMENT OF TRANSPORTATION, CONSTRUCTION AND MATERIAL SPECIFICATIONS (2023)

THE LATEST EDITION OF THE OHIO MANUAL OF UNIFORM TRAFFIC CONTROL DEVICES (2012)

## WORK INSPECTION

THE CONTRACTOR SHALL PROVIDE ODOT AND HAMILTON COUNTY WITH 72 HOUR NOTICE OF ANY SIGNAL WORK TO BE PERFORMED AT THE INTERSECTION SO THAT INSPECTION SERVICES CAN BE SUPPLIED.

## GROUNDING AND BONDING

THE REQUIREMENTS OF THE CONSTRUCTION AND MATERIAL SPECIFICATIONS (CMS) AND THE TC SERIES OF STANDARD CONSTRUCTION DRAWINGS ARE MODIFIED AS FOLLOWS:

1. ALL METALLIC PARTS CONTAINING ELECTRICAL CONDUCTORS SHALL BE PERMANENTLY JOINED TO FORM AN EFFECTIVE GROUND FAULT CURRENT PATH BACK TO THE GROUNDED CONDUCTOR IN THE POWER SERVICE DISCONNECT SWITCH.

A. PROVIDE AN EQUIPMENT GROUNDING CONDUCTOR IN METALLIC CONDUITS (725.04) IN ADDITION TO THE CONDUCTORS SPECIFIED AND BOND THE CONDUIT TO THIS GROUNDING CONDUCTOR.

B. WHEN AN EQUIPMENT GROUNDING CONDUCTOR IS REQUIRED IN PLASTIC CONDUIT (725.05), THE INSTALLATION SHALL INCLUDE A SEPARATE EQUIPMENT GROUNDING CONDUCTOR IN ADDITION TO THE CONDUCTORS SPECIFIED.

C. METALLIC CONDUIT CARRYING THE LOOP WIRES FROM IN THE PAVEMENT TO THE PULL BOX SPLICE LOCATION WILL ONLY BE BONDED AT THE PULL BOX END, AND WILL NOT CONTAIN AN EQUIPMENT GROUNDING CONDUCTOR.

D. IF MULTIPLE CONDUIT RUNS BEGIN AND END AT THE SAME POINTS, ONLY ONE EQUIPMENT GROUNDING CONDUCTOR IS REQUIRED.

E. IF AN EQUIPMENT GROUNDING CONDUCTOR IS NEEDED IN CONDUIT BETWEEN SIGNALIZED INTERSECTIONS FOR UNDERGROUND INTERCONNECT CABLE, THE GROUNDING SYSTEM FOR EACH SIGNALIZED INTERSECTION WILL BE SEPARATED ABOUT MIDWAY BETWEEN THE INTERSECTIONS.

F. THE MESSENGER WIRE AT SIGNALIZED INTERSECTIONS WILL BE USED AS THE CONDUCTIVE PATH FROM CORNER TO CORNER IF CONDUIT IS NOT PROVIDED UNDER THE ROADWAY. WHEN CONDUIT CONNECTS THE CORNERS OF AN INTERSECTION, AN EQUIPMENT GROUNDING CONDUCTOR SHALL BE USED IN THE CONDUIT.

### 2. CONDUITS.

A. THE 725.04 CONDUIT SHALL HAVE GROUNDING BUSHINGS INSTALLED AT ALL TERMINATION POINTS. THE BUSHING MATERIAL SHALL BE COMPATIBLE WITH GALVANIZED STEEL CONDUIT AND THE GROUNDING LUG MATERIAL SHALL BE COMPATIBLE FOR USE WITH COPPER WIRE. THREADED OR COMPRESSION TYPE BUSHINGS MAY BE USED.

B. THE 725.05 CONDUIT SHALL HAVE THE INSIDE AND OUTSIDE DIAMETERS OF THE CONDUIT DEBURRED AT ALL TERMINATION POINTS.

C. BOTH ENDS OF METALLIC CONDUIT SHALL BE BONDED TO THE EQUIPMENT GROUNDING CONDUCTOR.

D. METALLIC CONDUIT MAY BE BONDED TO METALLIC BOXES THROUGH THE USE OF CONDUIT FITTINGS UL APPROVED FOR THIS TYPE OF CONNECTION, WITH THE BOX BONDED TO THE EQUIPMENT GROUNDING CONDUCTOR.

### 3. WIRE FOR GROUNDING AND BONDING.

A. USE INSULATED, COPPER WIRE FOR THE EQUIPMENT GROUNDING CONDUCTOR. BONDING JUMPERS IN BOXES AND ENCLOSURES MAY BE BARE OR INSULATED COPPER WIRE. WIRE SIZE SHALL BE AS FOLLOWS:

a. USE 4 AWG BETWEEN THE POWER SERVICE AND SUPPORTS, POLES, PEDESTALS, CONTROLLER OR FLASHER CABINETS.

## GROUNDING AND BONDING (CONTINUED)

b. USE A MINIMUM 8 AWG BETWEEN LOOP DETECTOR PULL BOXES AND THE FIRST CONDUIT THAT REQUIRES A LARGER SIZE AS SPECIFIED IN 3.A.I ABOVE.

c. USE A MINIMUM 8 AWG BETWEEN THE "PREPARE TO STOP WHEN FLASHING" INSTALLATION (INCLUDING SUPPORT) AND THE FIRST CONDUIT THAT REQUIRES A LARGER SIZE AS SPECIFIED IN 3.A.I ABOVE.

d. THE INSULATION SHALL BE GREEN OR GREEN WITH YELLOW STRIPE(S). FOR 4 AWG OR LARGER, INSULATION MAY ALSO BE BLACK WITH GREEN TAPE/LABELS INSTALLED AT ALL ACCESS POINTS.

e. IN A HIGHWAY LIGHTING SYSTEM, THE EQUIPMENT GROUNDING CONDUCTOR SHALL BE THE SAME WIRE SIZE AS THE DUCT CABLE OR DISTRIBUTION CABLE CIRCUIT CONDUCTORS, WITH THE MINIMUM CONDUCTOR SIZE OF 4 AWG. BONDING JUMPERS WILL BE MINIMUM SIZE 4 AWG.

### 4. GROUND ROD.

A. A 3/4 INCH SCHEDULE 40 PVC CONDUIT WILL BE USED IN FOUNDATIONS AND CONCRETE WALLS FOR THE GROUNDING CONDUCTOR (GROUND WIRE) RACEWAY TO THE GROUND ROD. SHOULD METALLIC CONDUIT BE USED, BOTH ENDS OF THE CONDUIT SHALL BE BONDED TO THE GROUNDING CONDUCTOR.

B. THE TYPICAL GROUNDING CONDUCTOR (GROUND WIRE) SHALL BE 4 AWG INSULATED, COPPER.

5. THE GREEN CONDUCTOR IN SIGNAL CABLES (CONDUCTOR #4) SHALL NOT BE USED TO SUPPLY POWER TO A SIGNAL INDICATION. IT WILL BE CONNECTED TO THE SIGNAL BODY AS AN EQUIPMENT GROUND IN ALUMINUM HEADS AND IT WILL BE UNUSED IN PLASTIC HEADS. UNUSED CONDUCTORS SHALL BE GROUNDED IN THE CABINET. TYPICAL USE OF CONDUCTORS IS AS FOLLOWS:

COND. NO.	COLOR	VEHICLE SIGNAL	PED. SIGNAL
1	BLACK	GREEN BALL	#1 WALK
2	WHITE	AC NEUTRAL	AC NEUTRAL
3	RED	RED BALL	#1 DW/FDW
4	GREEN	EQUIP. GROUND	EQUIP. GROUND
5	ORANGE	YELLOW BALL	#2 DW/FDW
6	BLUE	GREEN ARROW	#2 WALK
7	WH/BL STRIPE	YELLOW ARROW	NOT USED

### 6. POWER SERVICE AND DISCONNECT SWITCH.

A. AT THE POWER SERVICE LOCATION, THE GROUNDING CONDUCTOR (GROUND WIRE) FROM THE DISCONNECT SWITCH NEUTRAL (AC-) BAR TO THE GROUND ROD SHALL BE A CONTINUOUS, UNSPLICED CONDUCTOR. IF SPLICED, IT SHALL BE AN EXOTHERMIC WELD BUTT SPLICE.

B. THE SERVICE NEUTRAL (AC-) SHALL ONLY BE CONNECTED TO GROUND AT THE PRIMARY POWER SERVICE DISCONNECT SWITCH.

a. NEMA CONTROLLER CABINETS: IF A POWER SERVICE DISCONNECT SWITCH IS LOCATED BEFORE THE CONTROLLER CABINET, THE NEUTRAL (AC-) AND THE GROUNDING BARS IN THE CONTROLLER CABINET SHALL NOT BE CONNECTED TOGETHER AS SHOWN IN NEMA TS-2, FIGURE 5-4.

b. IF SECONDARY DISCONNECT SWITCHES ARE CONNECTED AFTER THE PRIMARY DISCONNECT SWITCH, THE NEUTRAL (AC-) SHALL ONLY BE GROUNDED AT THE PRIMARY SWITCH. EQUIPMENT GROUNDING CONDUCTORS SHALL BE BROUGHT TO THE PRIMARY SWITCH, BUT SHALL BE GROUNDED AT BOTH SECONDARY AND PRIMARY SWITCHES.

7. PAYMENT - ALL MATERIALS AND WORK REQUIRED TO COMPLETE THE EFFECTIVE GROUND FAULT CURRENT PATH SYSTEM ARE INCIDENTAL TO THE CONDUCTORS INSTALLED BY CONTRACT.

## MAINTENANCE OF TRAFFIC SIGNAL

THE CONTRACTOR SHALL BE RESPONSIBLE FOR MAINTAINING TRAFFIC SIGNAL INSTALLATIONS WITHIN THE PROJECT UNDER THE FOLLOWING CONDITIONS:

1. EXISTING SIGNAL INSTALLATIONS WHICH THE PLANS REQUIRE THE CONTRACTOR TO ADJUST, MODIFY, ADD ONTO OR REMOVE, OR WHICH THE CONTRACTOR ACTUALLY ADJUSTS, MODIFIES OR OTHERWISE DISTURBS. THE CONTRACTOR SHALL BE RESPONSIBLE FOR THE ENTIRE INSTALLATION (AT AN INTERSECTION) FROM THE TIME HIS OPERATIONS FIRST DISTURB THE INSTALLATION UNTIL THE INSTALLATION HAS BEEN SUBSEQUENTLY REMOVED OR MODIFIED AND THE WORK IS ACCEPTED.

2. NEW OR REUSED SIGNAL INSTALLATIONS OR DEVICES, INSTALLED BY THE CONTRACTOR. THE CONTRACTOR SHALL BE RESPONSIBLE FOR MAINTENANCE OF THESE FROM THE TIME OF INSTALLATION UNTIL THE WORK IS ACCEPTED.

3. THE CONTRACTOR IS RESPONSIBLE FOR MAINTAINING THE EXISTING TRAFFIC SIGNAL DURING CONSTRUCTION. ANY TEMPORARY ADJUSTMENTS, TEMPORARY POLES, ETC. THAT MAY BE NEEDED SHALL BE INCIDENTAL TO ITEM 614 MAINTAINING TRAFFIC. THE ITEMS DESCRIBED ABOVE AND ALL NECESSARY WORK/MATERIALS ASSOCIATED WITH THE TEMPORARY SIGNAL SUPPORTS REQUIRED TO MAINTAIN A FULLY OPERATIONAL SIGNALIZED INTERSECTION SHALL BE INCIDENTAL TO ITEM 614, MAINTAINING TRAFFIC AND HAS BEEN INCLUDED IN THE LUMP SUM BID PRICE.

THE CONTRACTOR SHALL CORRECT AS QUICKLY AS POSSIBLE ALL OUTAGES OR MALFUNCTIONS. HE SHALL PROVIDE THE MAINTAINING AGENCY AND ODOT SUCH ADDRESSES AND PHONE NUMBERS WHERE HIS MAINTENANCE FORCES CAN BE CONTACTED. THE CONTRACTOR SHALL PROVIDE ONE OR MORE PERSONS TO RECEIVE ALL CALLS AND DISPATCH THE NECESSARY MAINTENANCE FORCES TO CORRECT OUTAGES. SUCH A PERSON OR PERSONS MAY BE USED TO PERFORM OTHER DUTIES AS LONG AS PROMPT ATTENTION IS GIVEN TO THESE CALLS AND A PERSON IS READILY AVAILABLE CONTINUOUSLY 24 HOURS A DAY, 7 DAYS A WEEK. ALL LAMP OUTAGES, CABLE OUTAGES, ELECTRICAL FAILURES, EQUIPMENT MALFUNCTIONS AND MISALIGNED SIGNAL HEADS SHALL BE CORRECTED TO THE SATISFACTION OF THE TOWNSHIP AND ODOT WITH THE SIGNAL BACK TO SERVICE WITHIN TWO HOURS AFTER THE CONTRACTOR HAS BEEN NOTIFIED OF THE OUTAGE.

IN THE EVENT NEW SIGNALS ARE DAMAGED PRIOR TO ACCEPTANCE, ALL DAMAGED EQUIPMENT EXCEPT POLES AND CONTROL EQUIPMENT SHALL BE REPLACED BY THE CONTRACTOR TO THE SATISFACTION OF THE COUNTY AND ODOT WITH THE SIGNAL BACK IN SERVICE WITHIN 8 HOURS AFTER THE CONTRACTOR'S NOTIFICATION OF THE OUTAGE. THE CONTRACTOR SHALL ARRANGE FOR FULL TRAFFIC CONTROL UNTIL THE SIGNAL IS BACK IN OPERATION.

NONE OF THE ABOVE SHALL BE CONSTRUED AS COLLECTIVE OR CONSECUTIVE OUTAGE TIME PERIODS AT ANY ONE LOCATION. THAT IS, WHERE MORE THAN ONE OUTAGE OCCURS AT ANY ONE LOCATION THEN THE ALLOTTED TIME LIMIT SHALL BE FOR THE WORST SINGLE OUTAGE.

WHERE OUTAGES ARE THE DIRECT RESULT OF A VEHICLE ACCIDENT THE RESPONSE OF THE CONTRACTOR SHALL BE AS OUTLINED ABOVE. THE CONTRACTOR SHALL BE RESPONSIBLE FOR COLLECTION OF ANY COMPENSATION FOR THIS WORK FROM THOSE PARTIES RESPONSIBLE FOR THE DAMAGE.

WHERE THE CONTRACTOR HAS FAILED TO, OR CANNOT RESPOND TO, AN OUTAGE OR SIGNAL EQUIPMENT MALFUNCTION, AT THESE LOCATIONS WITHIN HIS RESPONSIBILITY, WITHIN PERIODS AS SPECIFIED ABOVE, THE COUNTY AND ODOT MAY INVOKE THE PROVISIONS OF SECTION 105.15 AND ANY SUBSEQUENT BILLINGS TO ODOT, OR THE COUNTY POLICE SERVICES AND MAINTENANCE SERVICES BY ODOT FORCES SHALL BE DEDUCTED FROM MONIES DUE OR TO BECOME DUE THE CONTRACTOR IN ACCORDANCE WITH PROVISIONS OF SECTION 105.15.

THE CONTRACTOR SHALL PROVIDE THE MAINTENANCE SERVICE ENTIRELY WITH HIS FORCES OR HE MAY CHOOSE TO ENTER INTO A COOPERATIVE UNDERSTANDING WITH THE LOCAL MAINTAINING AGENCY TO PROVIDE THE MAINTENANCE. THE CONTRACTOR SHALL INFORM THE COUNTY, IN WRITING, OF THE MAINTENANCE METHOD SELECTED.

THE CONTRACTOR SHALL BE RESPONSIBLE FOR ANY DAMAGE TO ANY TRAFFIC SIGNAL COMPONENTS REQUIRED TO BE HANDLED DURING THE RELOCATION OF POLES AND REVISIONS TO THE SIGNAL SYSTEM. WHEN A TRAFFIC SIGNAL MUST BE TAKEN OUT OF SERVICE BY THE CONTRACTOR, DUE TO CONSTRUCTION PROCEDURES, THIS OUTAGE SHALL NOT EXCEED 4 HOURS AND SHALL NOT INCLUDE THE HOURS OF 7 TO 9 AM AND 4 TO 6 PM, ANY SIGNALIZED INTERSECTION, WHERE THE SIGNAL IS OUT OF SERVICE DUE TO CONSTRUCTION PROCEDURES, OR DUE TO AN OUTAGE OR MALFUNCTION OF EQUIPMENT AS DESCRIBED ABOVE, SHALL BE PROTECTED, BY THE CONTRACTOR, BY THE INSTALLATION OF TEMPORARY "STOP" SIGNS.

## MAINTENANCE OF TRAFFIC SIGNAL (CONT.)

THE CONTRACTOR SHALL MAINTAIN COMPLETE RECORDS OF MALFUNCTIONS INCLUDING:

1. TIME OF NOTIFICATION OF MALFUNCTION;
2. TIME OF WORK CREWS ARRIVAL TO CORRECT THE MALFUNCTION;
3. ACTIONS TAKEN TO CORRECT THE MALFUNCTION, INCLUDING A LIST OF PARTS REPAIRED OR REPLACED;
4. A DIAGNOSIS OF REASON FOR THE MALFUNCTION AND PROBABILITY OF REOCCURRENCE;
5. TIME OF COMPLETION OF THE REPAIR AND SYSTEM RESTORED TO FULL SERVICE.

A COPY OF THESE RECORDS SHALL BE PROVIDED TO THE COUNTY WITHIN THREE (3) WORKING DAYS FOLLOWING COMPLETION OF EACH REPAIR.

ALL COSTS RESULTING FROM THE ABOVE REQUIREMENTS SHALL BE CONSIDERED TO BE INCLUDED IN THE LUMP SUM PRICE BID FOR ITEM 614, MAINTAINING TRAFFIC.

## ITEM 632 ACCESSIBLE PEDESTRIAN PUSHBUTTON, AS PER PLAN (GENERIC) (ALTERNATE #1)

IN ADDITION TO THE REQUIREMENTS OF ODOT SPECIFICATIONS 632, 732, SCD TC-83.10, ODOTCD, AND PROWAG, THE FOLLOWING REQUIREMENTS SHALL APPLY:

1. THE PUSHBUTTON ASSEMBLY SHALL BE YELLOW.
2. THE PUSHBUTTON SHALL SOUND A PERCUSSIVE TONE/SPEECH MESSAGE WHEN ACTUATED. SOME EXAMPLES OF THE SPEECH MESSAGES ARE LISTED BELOW. THE CONTRACTOR SHALL HAVE ODOT, TOWNSHIP, AND COUNTY APPROVE THE MESSAGES AND DECIBELS (DB) LEVELS OF EACH BUTTON.
  - "WAIT, TO CROSS SPRINGDALE AT POOLE."
  - "SPRINGDALE. WALK SIGN IS ON TO CROSS SPRINGDALE."
3. THE CONTRACTOR SHALL PROVIDE ANY MISCELLANEOUS WIRE/ELECTRICAL EQUIPMENT, CONNECTIONS, MATERIAL, CONDUIT RISERS, WEATHERHEAD, ETC. TO MAKE A FULLY OPERATIONAL ACCESSIBLE PEDESTRIAN PUSHBUTTON THAT IS COMPATIBLE WITH THE EXISTING CABINET. THIS WORK SHALL BE INCIDENTAL TO ITEM 632 ACCESSIBLE PEDESTRIAN PUSHBUTTON.

PAYMENT FOR ITEM 632 ACCESSIBLE PEDESTRIAN PUSHBUTTON, AS PER PLAN (GENERIC) (ALTERNATE #1), FOR ALL OPERATIONS DESCRIBED ABOVE SHALL BE AT THE CONTRACT BID PRICE PER EACH AND SHALL INCLUDE ALL LABOR, MATERIAL AND EQUIPMENT REQUIRED TO COMPLETE THIS ITEM OF WORK.



ITEM 632 ACCESSIBLE PEDESTRIAN PUSHBUTTON, AS PER PLAN (POLARA) (ALTERNATE#2)

IN ADDITION TO THE REQUIREMENTS OF ODOT SPECIFICATIONS 632, 732, SCD TC-83.10, ODOTCD, AND PROWAG, THE FOLLOWING REQUIREMENTS SHALL APPLY:

1. THE PUSHBUTTON ASSEMBLY SHALL BE YELLOW AND MANUFACTURED BY POLARA.
2. THE PUSHBUTTON SHALL SOUND A PERCUSSIVE TONE/SPEECH MESSAGE WHEN ACTUATED. SOME EXAMPLES OF THE SPEECH MESSAGES ARE LISTED BELOW. THE CONTRACTOR SHALL HAVE ODOT, TOWNSHIP, AND COUNTY APPROVE THE MESSAGES AND DECIBELS (DB) LEVELS OF EACH BUTTON.
  - "WAIT, TO CROSS SPRINGDALE AT POOLE."
  - "SPRINGDALE. WALK SIGN IS ON TO CROSS SPRINGDALE."
3. THE CONTRACTOR SHALL PROVIDE ANY MISCELLANEOUS WIRE/ELECTRICAL EQUIPEMENT, CONNECTIONS, MATERIAL, CONDUIT RISERS, WEATHERHEAD, ETC. TO MAKE A FULLY OPERATIONAL ACCESSIBLE PEDESTRIAN PUSHBUTTON THAT IS COMPATIBLE WITH THE EXISTING CABINET. THIS WORK SHALL BE INCIDENTAL TO ITEM 632 ACCESSIBLE PEDESTRIAN PUSHBUTTON.

PAYMENT FOR ITEM 632 ACCESSIBLE PEDESTRIAN PUSHBUTTON, AS PER PLAN (POLARA) (ALTERNATE#2), FOR ALL OPERATIONS DESCRIBED ABOVE SHALL BE AT THE CONTRACT BID PRICE PER EACH AND SHALL INCLUDE ALL LABOR, MATERIAL AND EQUIPMENT REQUIRED TO COMPLETE THIS ITEM OF WORK.

ITEM 633 CONTROLLER ITEM, MISC.: REPROGRAM CONTROLLER CABINET

IN ADDITION TO THE REQUIREMENTS OF ODOT CMS 633 AND 733, THE CONTROLLER CABINET SHALL BE REWIRED AND REPROGRAMMED TO ACCOMMODATE THE NEW SIGNAL UPGRADES.

THE CONTRACTOR IS RESPONSIBLE FOR REPROGRAMMING, ETC. TO GET THE SIGNAL RUNNING.

Reprogramming per these plans

PAYMENT FOR ITEM 633 CONTROLLER ITEM, MISC.: REPROGRAM CONTROLLER CABINET, FOR ALL OPERATIONS DESCRIBED ABOVE SHALL BE AT THE CONTRACT BID PRICE PER EACH AND SHALL INCLUDE ALL LABOR, MATERIAL AND EQUIPMENT REQUIRED TO COMPLETE THIS ITEM OF WORK.

DESIGN AGENCY




CHOICE ONE ENGINEERING

DESIGNER  
BMW

REVIEWER  
AJH 7-23-2025

PROJECT ID  
120861


SHEET TOTAL  
P.51 | 53

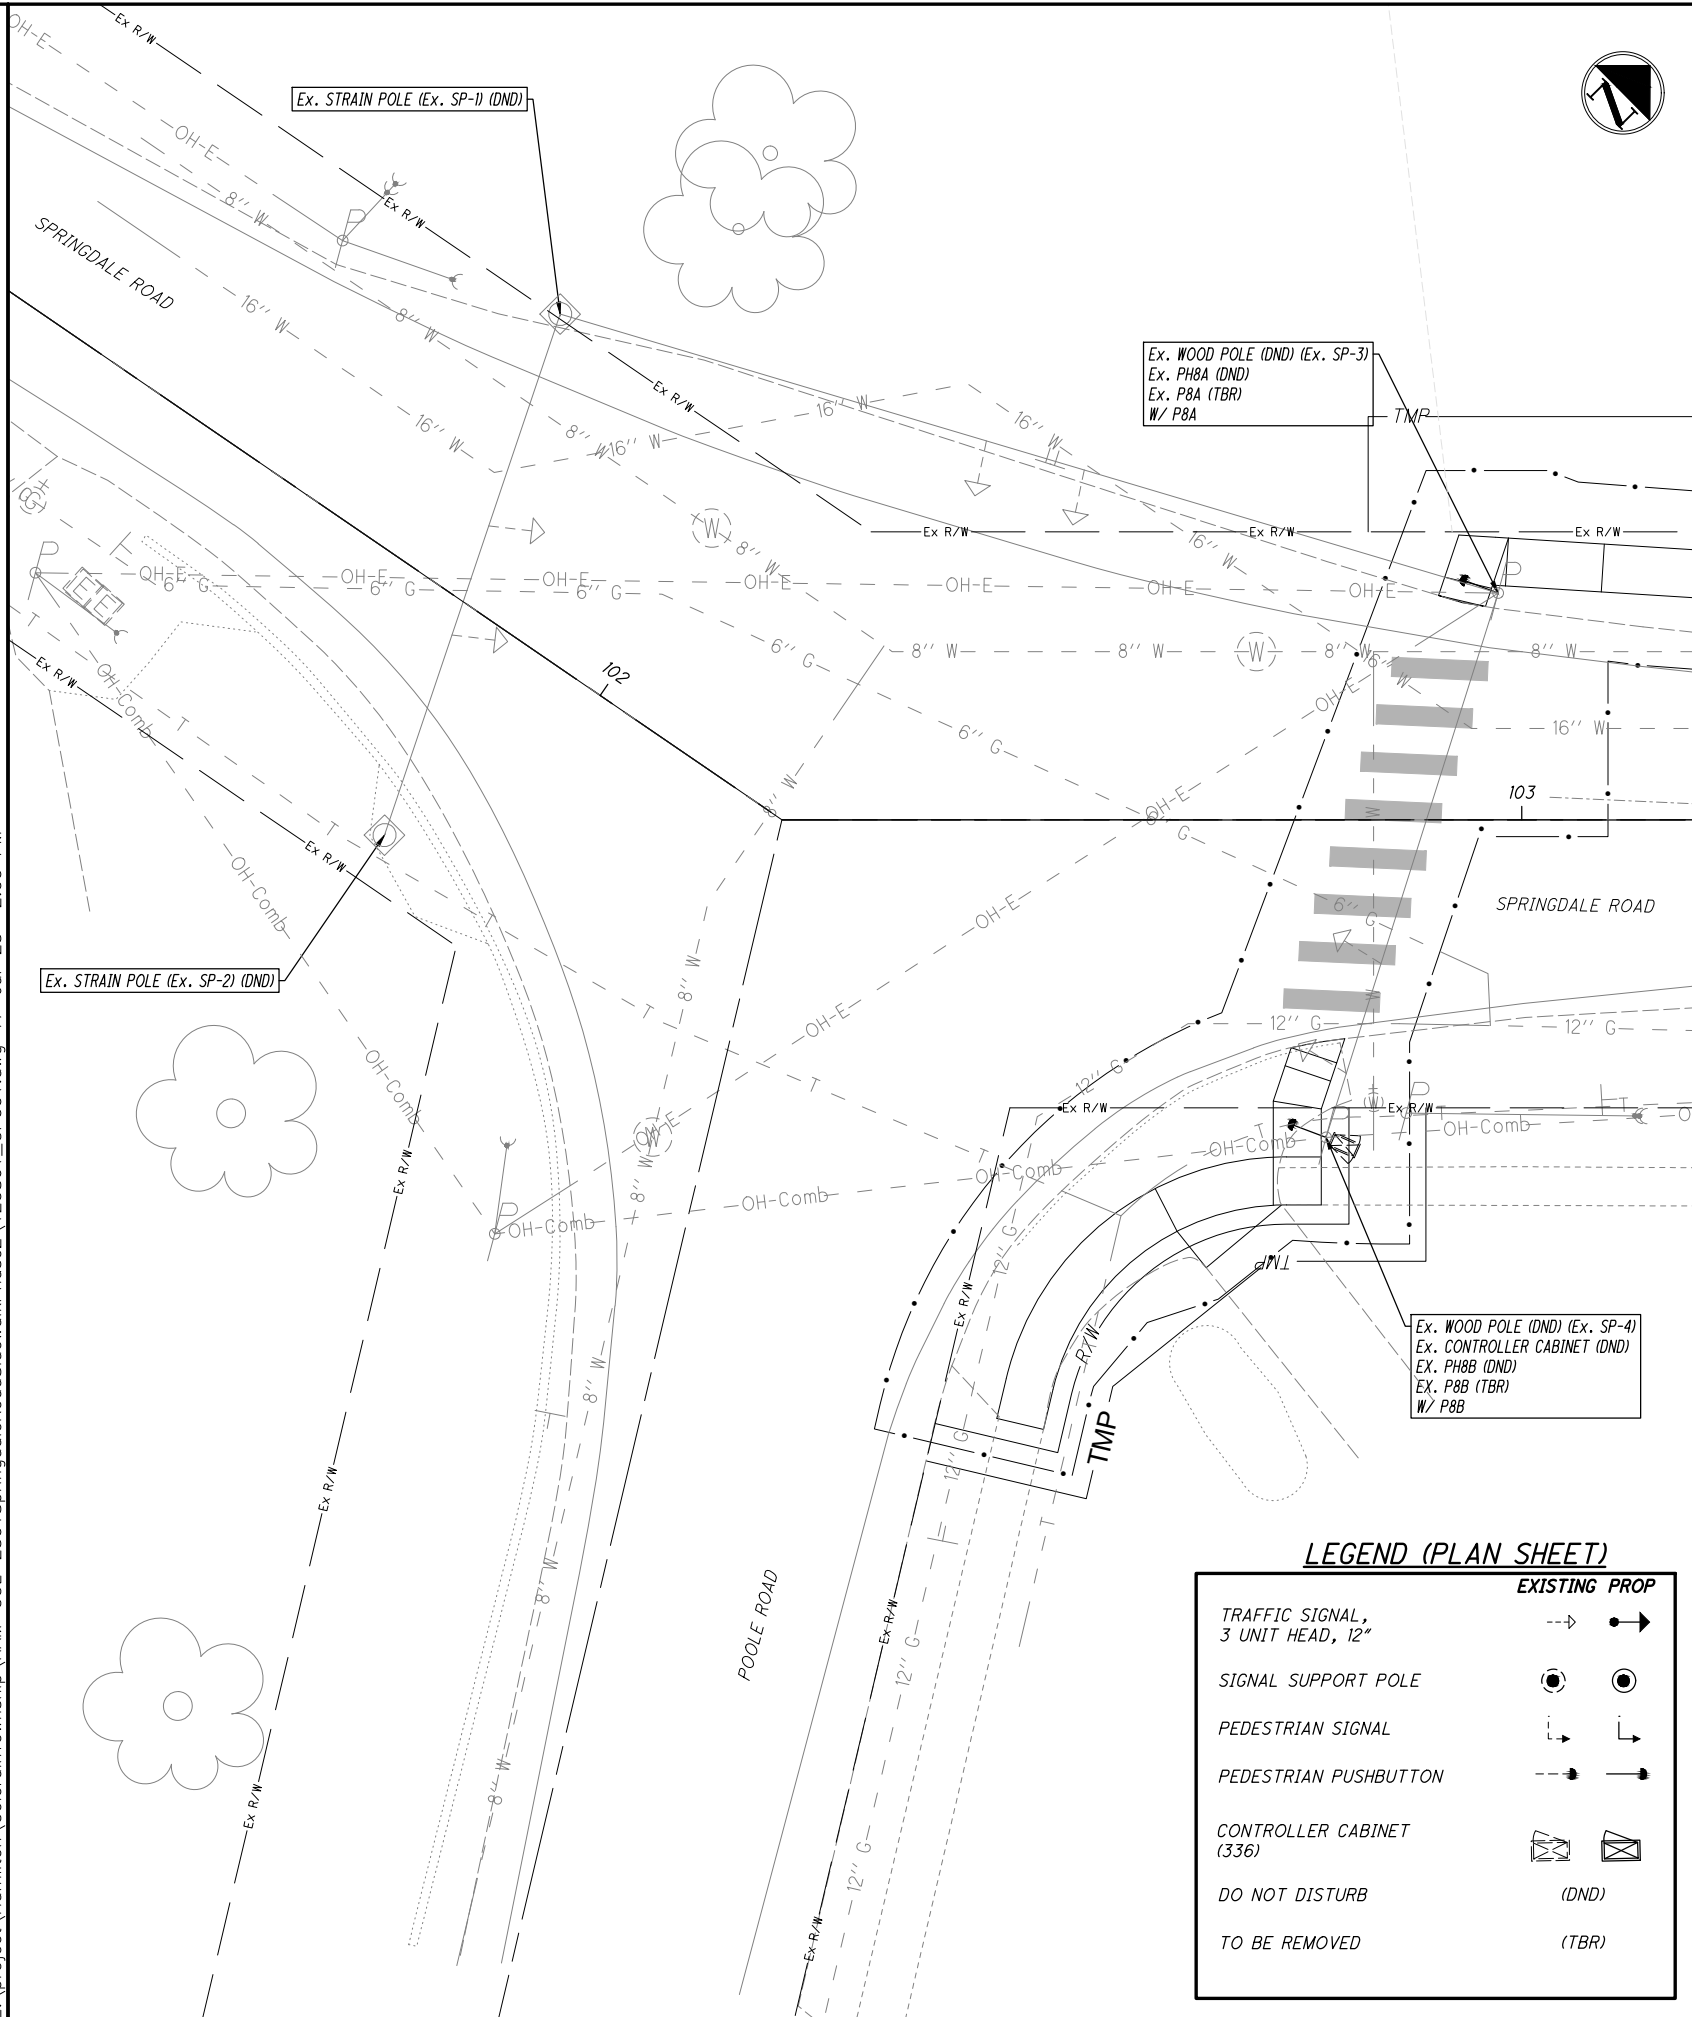

**LEGEND (PLAN SHEET)**


	EXISTING	PROP
TRAFFIC SIGNAL, 3 UNIT HEAD, 12"		
SIGNAL SUPPORT POLE		
PEDESTRIAN SIGNAL		
PEDESTRIAN PUSHBUTTON		
CONTROLLER CABINET (336)		
DO NOT DISTURB	(DND)	
TO BE REMOVED	(TBR)	

**EXISTING PEDESTRIAN SIGNAL HEADS**

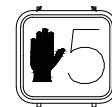


PEDESTRIAN HEADS (LED, COUNTDOWN, TYPE D2)  
Ex. PH8A, Ex. PH8B

**PEDESTRIAN SIGNS**

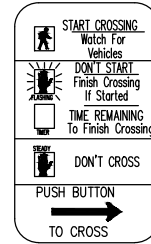

1 - LEFT ARROWS  
1 - RIGHT ARROWS

**PEDESTRIAN/STRAIN POLE ORIENTATION DETAIL**

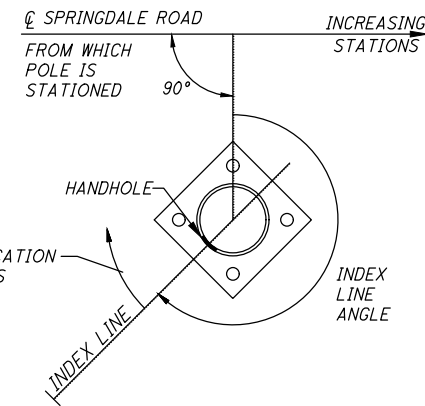


**PLAN DETAILS FOR EXISTING POLES**

EX. STRAIN POLE NO.	EX. WOOD POLE NO.	INDEX LINE ANGLE (DEG.)	ANGLES (DEG.) FROM INDEX LINE			
			PEDESTRIAN PUSHBUTTONS	PEDESTRIAN SIGNALS	CONTROLLER CABINET	
Ex. SP-1	-	0	-	-	-	-
Ex. SP-2	-	0	-	-	-	-
-	Ex. SP-3	0	110	EXISTING	-	-
-	Ex. SP-4	0	290	EXISTING	EXISTING	-


\*CONTRACTOR SHALL UTILIZE THE EXISTING WIRING AND PROVIDE ALL MISCELLANEOUS WIRING/EQUIPMENT TO COMPLETE A FULLY OPERATIONAL AUDIBLE PEDESTRIAN SIGNAL.

**LEGEND (WIRING DIAGRAM)**

	SIGNAL CABLE, 5 CONDUCTOR, NO. 14 AWG
	2 CONDUCTOR, NO. 14 AWG (LEAD-IN CABLE)
	SIGNAL SUPPORT POLE NO. .1
	EX. PEDESTRIAN PUSHBUTTON
	EX. PEDESTRIAN SIGNAL HEAD
	PEDESTRIAN PUSH BUTTON

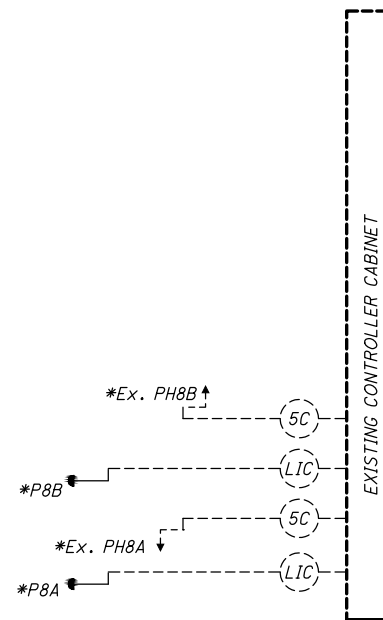

**WIRING DIAGRAM**

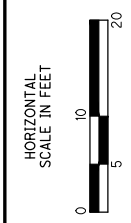

TRAFFIC SIGNAL PLAN



# GENERAL PROVISIONS

The Contractor is advised that there are several changes to the most recent edition of the City of Cincinnati Supplement dated January 1, 2023. These General Provisions include these changes. The Supplement and a Summary of Changes can be purchased or downloaded from the City's website:  
<http://www.cincinnati-oh.gov/dote/assets/File/2023%20CITY%20SUPPLEMENT-FINAL.pdf>

Water main items are to be constructed in accordance with the provisions of the State of Ohio, Department of Transportation, Construction and Material Specifications, dated January 1, 2023, and modified by the City of Cincinnati Supplement to said State of Ohio Specifications, effective January 1, 2023, and any supplements or changes thereto. Copies of the State specifications are on file at the Office of Contract Sales of the State of Ohio, Department of Transportation, 25 South Front Street, Columbus, Ohio, and at the offices of the City Engineer of Cincinnati, Ohio. Submittal of a bid for this project implies that the Contractor has taken all provisions of the Supplement into account.

The Greater Cincinnati Water Works (GCWW) understands that differing site conditions results in extra work/change orders to the project. Change orders on GCWW contracts will be done in strict accordance with Item 109.05 C of the State of Ohio Department of Transportation Construction and Material Specifications dated January 1, 2023 or most recent edition and as modified in this City of Cincinnati Supplement. GCWW limits the mark up on wages and fringe benefits as described in 109.05 C. 2. "Labor" to 30%. It is expressly understood that regardless of the nature of the claim, or change in scope of work, the Contractor is not entitled to compensation for loss of anticipated profit or production.

As defined in the City of Cincinnati Supplement, sections 107.07 and 107.071, the Contractor is required to submit, at the time of the pre-construction meeting, a Site Safety Plan. Furthermore, the Contractor shall have an authorized and competent safety representative assigned to the project site.

The Contractor is advised that he has certain responsibilities under Section 153.64 of The Ohio Revised Code. For all underground utilities, contact the Ohio Utilities Protection Service at 1-800-362-2764 (toll free) 48 hours in advance of work. The Contractor is advised that all utility information has been shown on the contract plans from information provided by the owner of each utility in compliance with Sec. 153.64 of the Ohio Revised Code. In cases where utility information is incorrect and it results in a change in the contract plans the Contractor shall first notify the owner of the utility to determine the necessary course of action. The Contractor shall submit any subsequent claims as a result of downtime or additional work to the owner of the conflicting utility. The GCWW will not accept claims for any utility other than those as a result of incorrect water main and related appurtenance information.

The Contractor must locate or "pat hole" all utilities within the alignment of the proposed main a minimum of 50 feet ahead of pipe laying. Test holes must be dug, or trench excavated, a minimum of 50 feet (15.2 m) in advance of pipe laying, to assure proper clearance between the water main and any utility crossing, or underground structure. All utilities and structures shall be suitably braced and supported. The Contractor shall understand that any obstructions encountered in the installation of the main, due to the failure of having 50 feet (15.2m) of trench excavated ahead of laying operations, may require removal and relaying of the pipe at the contractors expense. The GCWW will not accept a claim for different utility conditions encountered when test holes are not performed as required.

Item 1120, "Exploratory Excavation", shall not include excavations within the limits of the proposed trench as defined in 1101.04 and 1101.05. Test holes are required on all utilities within 50 feet of the last laid pipe. Test holes within the alignment of the proposed trench are included in the Contractor's unit bid for Item 1101. Locations to be explored will vary from areas within the roadway to areas outside of the roadway.

It is the nature of construction that unmarked utilities or utilities not shown on the plans may be encountered within the excavation for the proposed work. the contractor is responsible to identify and remove any abandoned utilities encountered in the excavation. unless otherwise noted on the plans, no extra payment will be made for up to 10" diameter, width or depth utilities, to the contractor for the identification and removal of the abandon utility. All costs shall be included in the contractor's unit price bid for the appropriate item 1101, "Laying ductile iron pipe and fittings".

Street pavement or sidewalk should not be disturbed for a distance of more than 200 Feet (61.0 m) ahead of the last laid pipe. Backfill shall be completed within 50 feet (15.2 m) of the last laid pipe. Temporary or permanent surface restoration must be installed within a distance of 200 feet (61.0 m) of the laid pipe, including those areas where main installations occur within a closed lane or closed street condition. Roadway plates may be used as a temporary measure for a period not to exceed 24 hours without the approval of the GCWW.

Any undermined pavement of more than 6 inches horizontal must be removed prior to starting trench backfill. If undermining of pavement occurs more than 1 foot, then pavement must be shored to protect traffic, or arrangements made for additional lane closures must be made. If problems continue to occur regarding trenching integrity, sheeting and bracing can be required by the City Engineer or the City Engineer's representative, at the contractor's expense. If any tunneling is necessary, adequate information shown in both plan and profile and tunneling procedures must be submitted to the City Engineer's Office prior to commencement of work.

The GCWW has made every effort to depict the pipe sewers and lateral information on the plans. The Contractor is advised that sewer laterals are shown in plan view only. The Contractor shall determine the elevation of the sewer laterals in advance of laying the water main at these crossings. If the sewer laterals require changing in order to avoid conflict with the water main, or if the Contractor encounters a pipe sewer or lateral in the excavation that was not shown on the plans and requires a change of grade or alignment due to the installation of the water main, the Contractor shall furnish all necessary labor, material, tools, and equipment required to change the grade or alignment of pipe sewers and laterals of various sizes, allowing installation of water mains and appurtenances as shown on the plans, or as directed by the GCWW Inspector. This work shall include all necessary excavation, backfill, and restoration. The Contractor will be compensated under Item 1123, "Changing Pipe Sewers 8 Inch and Under". When crossing sanitary and combination sewers, a vertical clearance of 18" must be maintained.

**Notice of Confidentiality – Public Infrastructure Record**

This Document is a Public Infrastructure Record of the City of Cincinnati and its Greater Cincinnati Water Works, and is not subject to the public disclosure requirements of the public records laws of the State of Ohio and federal government. This Document is being provided on the basis of your reported need, and shall be considered confidential. By accepting this Document, you agree that it will not be shared or otherwise disclosed to anyone other than persons who have a direct need to know for the sole purpose of carrying out the project for which this Document was obtained. Anyone receiving this Document is bound by the same confidentiality requirements and must take precautions to protect against its dissemination.

The failure to observe the confidentiality requirements of this Notice shall serve as the basis for the City of Cincinnati to immediately seek legal recourse, including the recovery of actual damages resulting from unauthorized access or disclosure of the Document.



The Contractor is advised that due to the alignment of the proposed water main, it may be necessary to install a temporary valve box over an existing chambered valve that must remain in service during the water main installation as directed by the GCWW Inspector. The chamber shall be abandoned, a valve box (furnished by the contractor) placed over the valve, and upon project completion, the valve box must be removed. The contractor will not receive additional compensation for this work, but should include the cost of this work in his unit bid price for Item 1101, "Furnishing & Laying Ductile Iron Pipe and Fittings".

It is the Contractor's responsibility to provide adequate water supply for domestic and fire fighting purposes. In order to accomplish the water main connections with a minimum amount of inconvenience to the consumers, it may be necessary to do the work at other than normal working hours or as may be scheduled by the GCWW.

The Contractor is advised that the operating pressure of the existing water main within the limits of the subject project is approximately **44-76 P.S.I.**

In order to minimize the inconvenience of the consumers, the number of shutdowns required to do the proposed water main work shall be limited. Only one shutdown, limited to 8 hours, will be allowed during a 24 hour period.

All water service branches have a minimum cover of 3.0 feet.

The Contractor is advised that it shall be necessary to install temporary Plug/caps on the existing and proposed water mains in order to maintain service during testing and water main and branch connections. These temporary Plug shall be furnished by the contractor. He is responsible for their proper installation. The cost for this work shall be included in the Contractor's unit bid price for the appropriate Item 1101, "Furnishing & Laying Ductile Iron Pipe and Fittings".

The Contractor is required to excavate and expose the existing utilities and existing water mains along the line of the proposed water main and all proposed connection points to verify location, diameter, line and grade. Also, if the removal of the bulkhead or plug is required all excavation and temporary/permanent restoration shall be compensated under the Contractor's unit bid price for Item 1101, "Furnishing & Laying Ductile Iron Pipe and Fittings".

The Contractor is advised that all C.J. Plug are to be restrained with a Field Lok Gasket and all M.J. caps are to be restrained using a M.J.R.G.. This includes temporary Plug and caps for testing purposes. When a temporary plug is used, the contractor is permitted to remove the plug by cutting the section of pipe containing the plug and using a solid sleeve at that point to complete the tie-in. In the event that a cap is used, the contractor shall remove the M.J.R.G. and cap before completing the tie-in.

The Contractor is advised that on any fire hydrant required to be relocated with this project, all bolt assemblies shall be replaced. The cost for this work shall be included in the unit bid price for Item 1113 "Relocating Existing Fire Hydrants". No part of any fire hydrant setting shall be installed closer than five feet to any driveway, inlet, utility pole or guy wire anchor.

Item 1111, "Water Works Valve Chambers", shall also cover the furnishing and installing of Precast Reinforced Concrete Chambers in accordance with O.D.O.T. Specification 706.13. All pertinent provisions of this item and GCWW Standard Drawing No. 104-1A shall apply. Precast chambers shall be used in all locations where space permits and as directed by the GCWW.

Air cocks may be necessary for the proper operation of the water system. The Air Release Assembly, which may not be shown on the drawing, will be furnished and installed by the Contractor per the detail on these plans, if required by the GCWW.

It shall be the Contractor's responsibility to arrange for the removal and replacement of any poles and guys necessary for the installation of the proposed water mains, and any cost connected thereto shall be at his expense.

All pipe and specials shall be in accordance with City of Cincinnati Specification 40-110-16.

All procured water main and appurtenance materials, other than those furnished through the GCWW must be properly certified; certified for GCWW Inspection: or already inspected by the GCWW. Pipe, fittings, valves and fire hydrants must be GCWW inspected and stamped materials.

The Contractor should be advised that all Fittings (Bends, Offset Bends, Tees, Crosses, Sleeves, Caps and Plug) supplied for this job may be either ANSI/AWWA C-110 Full-body Ductile Iron, Cement Lined Fittings or ANSI/AWWA C-153 Compact Ductile Iron, Fusion Bonded Epoxy Coated Fittings in accordance with City of Cincinnati, Department of Purchasing, Standard Specification No. 40-110-12 for Pipe and Fittings Water, Ductile Iron 3" to 60". All fittings are subject to inspection and approval by appropriate GCWW inspection personnel. Minor pinholes and abrasions to epoxy coated valves and fittings are to be repaired using 3M Hot Melt Patch Compounds (H.M.P.C.) in the stick form. Repair procedures shall be in accordance with the General Application Steps identified for the H.M.P.C. All repairs to epoxy coated fittings are subject to inspection and approval by appropriate GCWW inspection personnel.

All rejected material, including pipe and fittings, shall be removed from the project site immediately.

The Contractor must maintain access to sidewalks at all times. Storage of any materials within the public Right of Way, including sidewalks, is not permitted unless approved by GCWW, the Project Engineer, or as indicated on the approved plans.

All copper tubing shall be type "K" of a standard nominal size: 3/4", 1", 1-1/2" and 2". All fittings will have copper flare type connections and shall be in accordance with City of Cincinnati Specification No. 40-113-05.

The contractor shall furnish the necessary certifications for branch material.

All proposed water mains will be hydrostatically tested for leakage in accordance with 1101.054, "Hydrostatic Test for Leakage", of the appropriate Item 1101, "Furnishing & Laying Ductile Iron Pipe and Fittings".

The Contractor will be responsible for filling, flushing, and pressure testing new water mains, 20" or smaller. the contractor will provide all labor, material and equipment (including the necessary pumps to apply the pressure test). The Water Works will provide the necessary meter and gauge. All costs for this work shall be included in the contractor's unit bid price for Item 1101, "Furnishing & Laying Ductile Iron Pipe and Fittings". Once the filling and pressure testing are completed, the Contractor will be responsible for flushing the proposed water main and the GCWW will be responsible for bacteria sampling. The GCWW will be responsible for filling, pressure testing and flushing new water mains greater than 20".

The Contractor is responsible for all pipe sewers disturbed in the completion of this project. In the event it becomes necessary to repair or replace existing pipe sewers, the Contractor must notify Sewer Maintenance, (513)244-1369, before proceeding with the work.

The Contractor is advised that his unit bid prices for the appropriate Item 1101, "Furnish & Install Pipe and Fittings", includes final restoration of all disturbed surfaces. The GCWW will not make full compensation under Item 1101 until final restoration is complete.

"All valve and air release box assemblies shall be domestically manufactured.

All box assemblies for 12-inch and smaller gate valves and 1-inch air releases shall be either Tyler Union Series 6850, EJ Series 8500, or Bingham & Taylor Series 4905, or GCWW approved equal. Box assemblies for these applications require a frost plug and "BOXLOK."

All box assemblies for 16-inch and above butterfly or gate valves and 2-inch air releases shall be EJ Series 460, or GCWW approved equal. Box assemblies for these applications require a frost plug.

All costs associated with adherence to these requirements shall be included in the Contractor's unit bid price for Item 1116 - Furnishing and Installing Valve Box Complete.

\*\*\*Note: Contractor shall verify the size and material of each service branch at the property line prior to installing branch. Cost for this work to be included in Item 1126-"Furnishing and Installing Copper Service Pipe w/ Aqua Shield".

The materials listed are only suggested for use during the water main and branch relocation work as proposed on the drawings. The contractor shall furnish additional material where needed. No allowance will be made for unused material nor will any extra payment be made for additional specials required to complete the water main work. Before ordering material the contractor is responsible for making his own field measurements and for field verifying the O.D. of existing water mains where sleeves and pipe couplings are involved.

Note 1:  
Valves furnished by the contractor shall be; American Resilient Wedge Gate Valve Series 2500, U.S. Pipe Metroseal Gate Valve, Kennedy Valve Ken Seal II Resilient Gate Valve, Clow F-6100 Series Resilient Wedge Gate Valve, Mueller 2360 Resilient Wedge Gate Valve.

Note 2:  
Low-Lead Brass Material Requirements:  
All components in contact with water shall be fabricated from Sebiloy II or Federalloy I-836 alloys or a material approved by the Engineer. All components that do not come in contact with water shall comply with the requirements of ASTM B 62 Copper Alloy Number. Coated or washed metals are not acceptable if their lead levels exceed .25% by weight prior to the coating or washing process. All service fittings and materials shall be certified as suitable for contact with drinking water by an accredited certification organization in accordance with ANSI/NSF Standard 61, Drinking Water Systems Components - Health Effects. All service fittings shall either be stamped or embossed with the letter "NL", to indicate "No-Lead", or marked to indicate that the product is manufactured from the low-lead alloys.

Note 3:  
Special Note on Service Pipe in Corrosive Soils:  
Service tubing is to be soft K Copper manufactured to the requirements of ASTM B88. Service tubing coating shall have NOVA Polyethylene LLDPE extrusion resin PP-0118-F coating to meet minimum of .026 mil thickness containing UV inhibitors. Service tubing shall have identification & traceability on both copper & plastic continuously line-marked with tube contents, ASTM specification, size, & descending footage. Unique lot number printed on both copper & plastic allowing product to be traced back to origin and time of manufacturing. Service tubing shall be Aqua Shield as manufactured by KAMCO Products Inc. or approved equal.

Note 4:  
Mechanical Joint Restrain Gland (MJRG):  
All mechanical joint restraint glands furnished by the contractor shall be any of the following:  
EBAA--Megalug  
TYLER/UNION--Tufgrip  
STAR--Stargrip  
FORD--Uni-Flange Series 1400

All products shall be domestically manufactured.

# SUGGESTED BILL OF MATERIALS

## FURNISHED BY CONTRACTOR

QTY	UNIT	DESCRIPTION
1	EACH	6" DUCTILE IRON PIPE, C.J., TH. CL. 55, 20' LENGTH
1	EACH	8" DUCTILE IRON PIPE, C.J., TH. CL. 55, 20' LENGTH
2	EACH	16" WIDE POLYETHYLENE TUBE, 16" WIDE X 20' LONG, 4 MIL CROSS LAMINATE
2	EACH	20" WIDE POLYETHYLENE TUBE, 20" WIDE X 20' LONG, 4 MIL CROSS LAMINATE
1	EACH	1 1/2" WIDE POLYETHYLENE TAPE WITH ADHESIVE (100' ROLL)
2	EACH	8" SOLID SLEEVE, D.P.
1	EACH	8" X 6" TEE, 2 M.J. X F.LG.
NOTE 1	1	6" VALVE, FLG, X M.J.
1	EACH	6" FLANGE TYTE RUBBER GASKET
1	EACH	VALVE BOX COMPLETE, IRON
1	EACH	VALVE BOX FROST PLUG
1	EACH	VALVE BOX BOXLOK (VALVE BOX ALIGNMENT DEVICE)
1	EACH	6" FH EXTENSION (6"LONG)
NOTE 4	2	6" MECHANICAL JOINT RESTRAIN GLAND (M.J.R.G.)
NOTE 4	4	8" MECHANICAL JOINT RESTRAIN GLAND (M.J.R.G.)

## SERVICE BRANCH MATERIALS

### FURNISHED BY CONTRACTOR

QTY	UNIT	DESCRIPTION
7	EACH	CURB BOX
2	EACH	ROADWAY BOX

## FURNISHED BY COLERAIN TOWNSHIP

QTY	UNIT	DESCRIPTION
1	EACH	6" FIRE HYDRANT

INDEX	
GENERAL PROVISIONS	.....1
SUGGESTED BILL OF MATERIALS	.....1
PLAN	.....2-4
RESTORATION DETAILS	.....3

**SPRINGDALE RD. SIDEWALK**


APPROVED: \_\_\_\_\_ DS-0989 / MF-17068

*Matthew S. Smith* 05/29/25  
GCWW SUPERVISING ENGINEER - DESIGN DATE

OEPA CERTIFICATION EXEMPT  
 NON - EXEMPT

OhioEPA Ohio Environmental Protection Agency "Self-Certification" letter required prior to the start of construction.


*Matthew S. Smith* 05/29/25  
OEPA REVIEW DATE

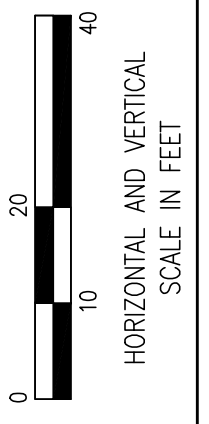

CALCULATED	MRO	CHECKED	EGG
------------	-----	---------	-----

REVISIONS	

GREATER CINCINNATI  
**WATER WORKS**  
 ENGINEERING DIVISION / DESIGN SECTION  
 3845 EASTERN AVENUE CINCINNATI, OHIO 45226

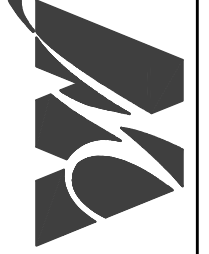


**SUGGESTED BILL OF MATERIAL**  
**G.C.W.W. SPECIAL PROVISIONS**

DS-0989  
 MF-17068

1
4


SPRINGDALE RD. SIDEWALK

# SPRINGDALE ROAD

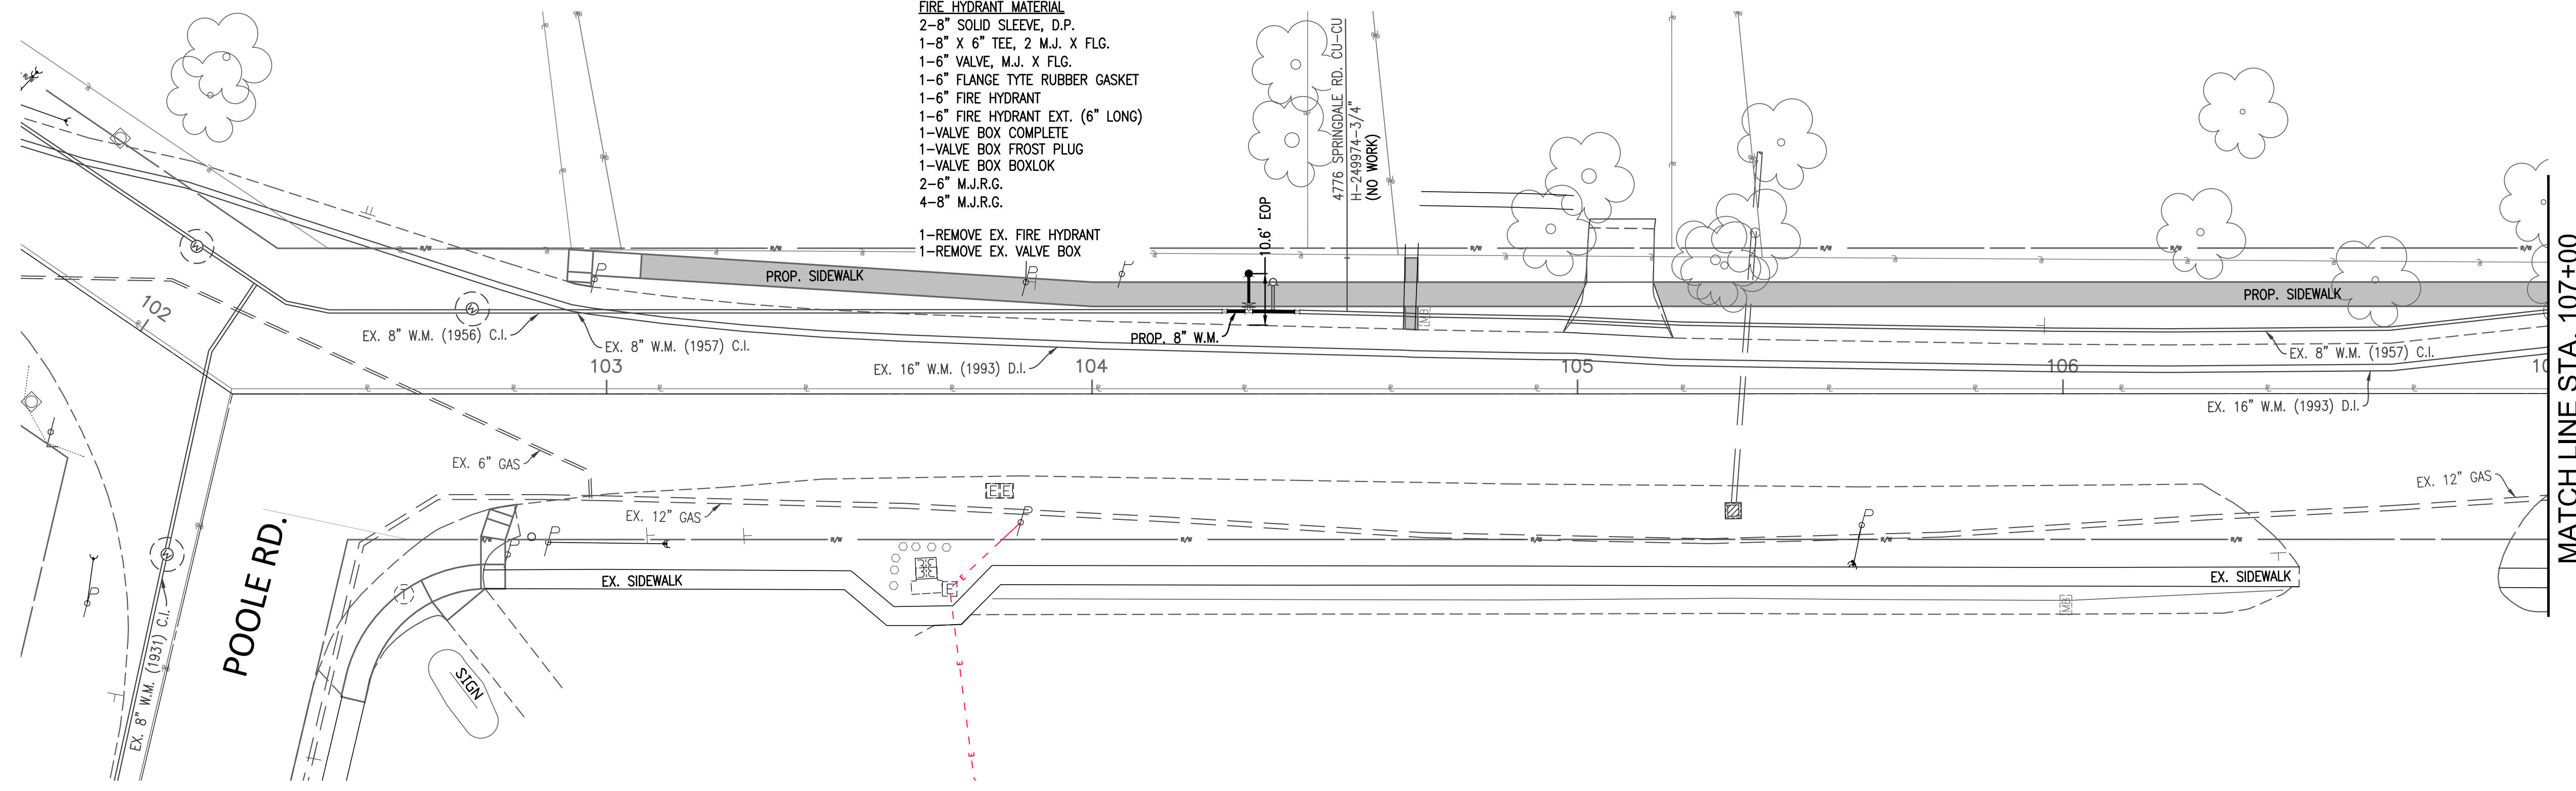



- FIRE HYDRANT MATERIAL**
- 2-8" SOLID SLEEVE, D.P.
  - 1-8" X 6" TEE, 2 M.J. X FLG.
  - 1-6" VALVE, M.J. X FLG.
  - 1-6" FLANGE TYTE RUBBER GASKET
  - 1-6" FIRE HYDRANT
  - 1-6" FIRE HYDRANT EXT. (6" LONG)
  - 1-VALVE BOX COMPLETE
  - 1-VALVE BOX FROST PLUG
  - 1-VALVE BOX BOXLOK
  - 2-6" M.J.R.G.
  - 4-8" M.J.R.G.

- 1-REMOVE EX. FIRE HYDRANT
- 1-REMOVE EX. VALVE BOX

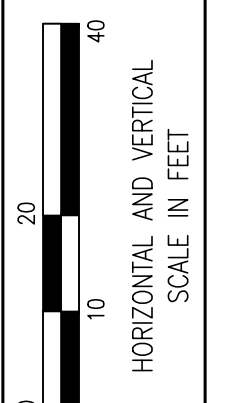

REVISIONS	CALCULATED
MRD	
CHECKED	
EGG	

GREATER CINCINNATI  
**WATER WORKS**  
 ENGINEERING DIVISION / DESIGN SECTION  
 3845 EASTERN AVENUE, CINCINNATI, OHIO 45226

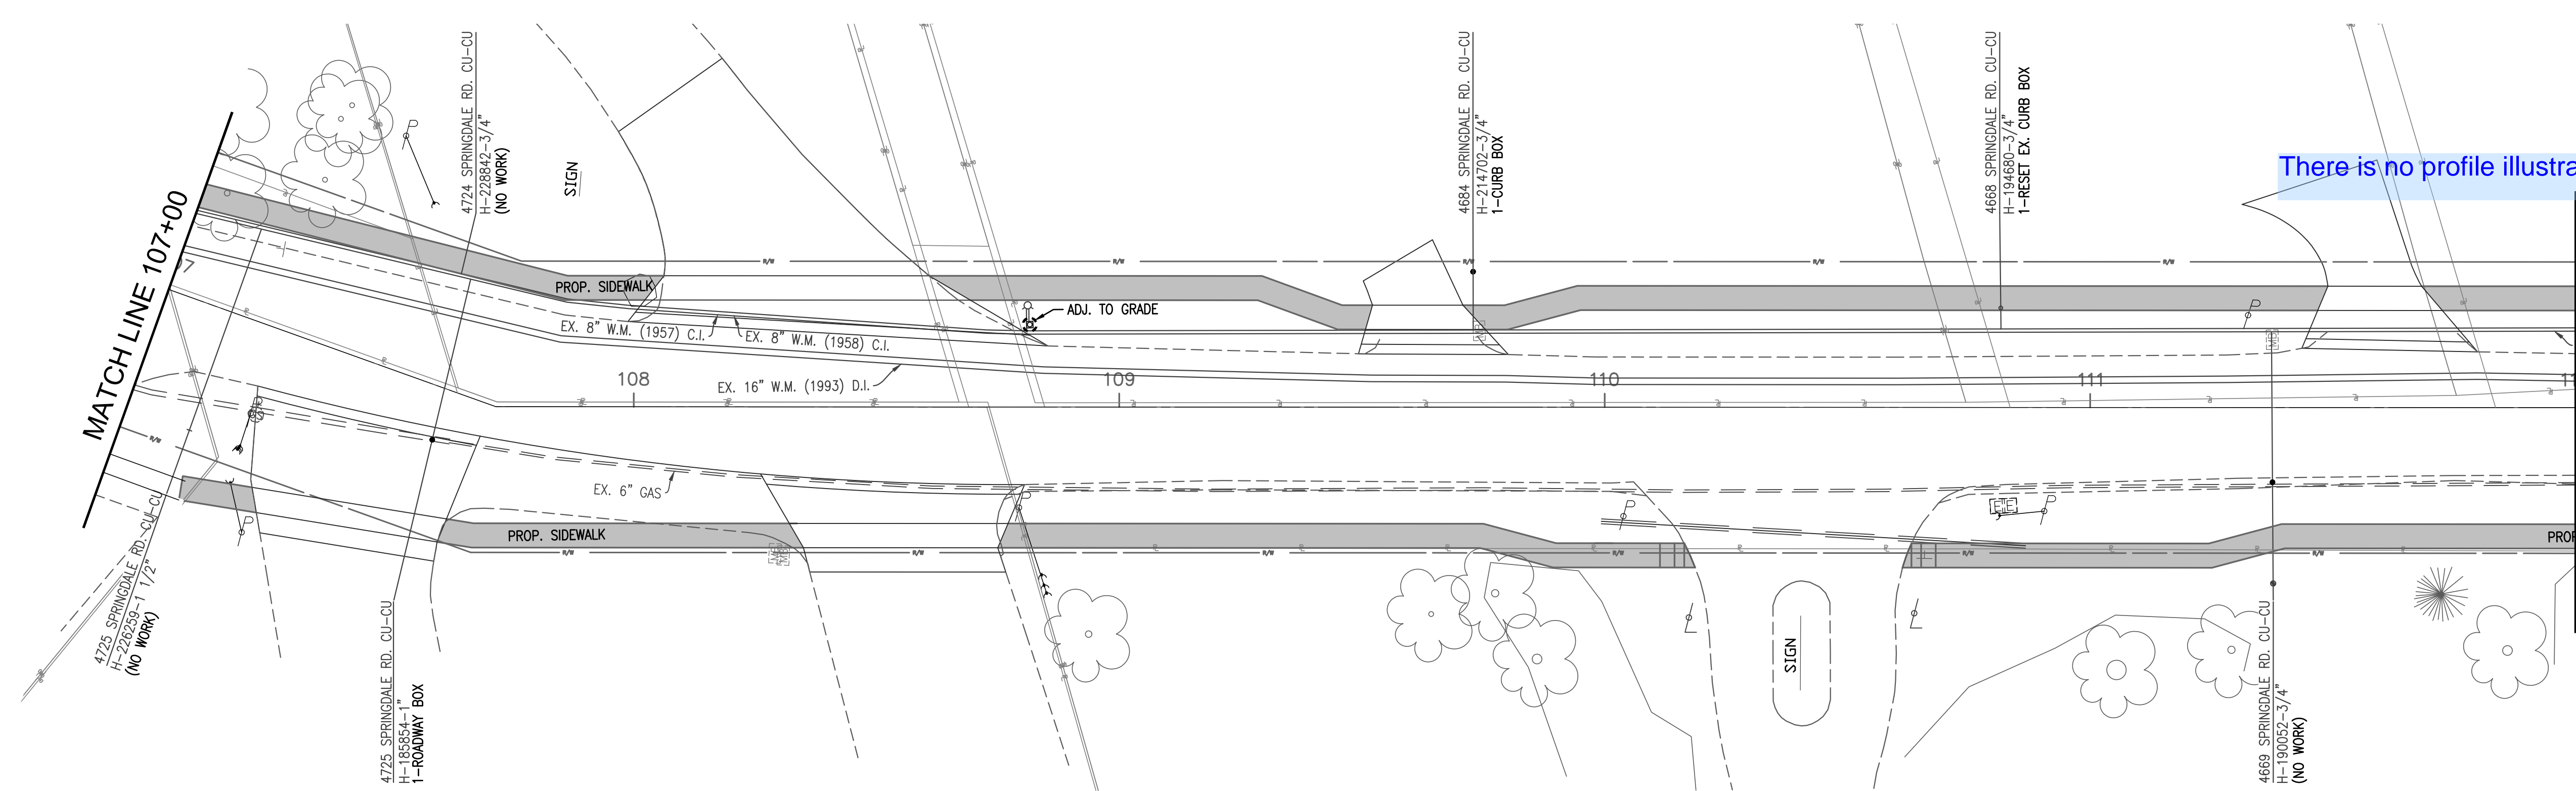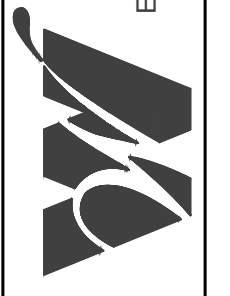

There is no profile illustrated.

## SPRINGDALE ROAD PLAN AND PROFILE

DS-0989  
 MF-17068

2  
 4


SPRINGDALE RD. SIDEWALK

**NOTICE OF CONFIDENTIALITY - PUBLIC INFRASTRUCTURE RECORD**


THIS DOCUMENT IS A PUBLIC INFRASTRUCTURE RECORD OF THE CITY OF CINCINNATI AND ITS GREATER CINCINNATI WATER WORKS, AND IS NOT SUBJECT TO THE PUBLIC DISCLOSURE REQUIREMENTS OF THE PUBLIC RECORDS LAWS OF THE STATE OF OHIO AND FEDERAL GOVERNMENT. THIS DOCUMENT IS BEING PROVIDED ON THE BASIS OF YOUR REPORTED NEED, AND SHALL BE CONSIDERED CONFIDENTIAL. BY ACCEPTING THIS DOCUMENT, YOU AGREE THAT IT WILL NOT BE SHARED OR OTHERWISE DISCLOSED TO ANYONE OTHER THAN PERSONS WHO HAVE A DIRECT NEED TO KNOW FOR THE SOLE PURPOSE OF CARRYING OUT THE PROJECT FOR WHICH THIS DOCUMENT WAS OBTAINED. ANYONE RECEIVING THIS DOCUMENT IS BOUND BY THE SAME CONFIDENTIALITY REQUIREMENTS AND MUST TAKE PRECAUTIONS TO PROTECT AGAINST ITS DISSEMINATION.

THE FAILURE TO OBSERVE THE CONFIDENTIALITY REQUIREMENTS OF THIS NOTICE SHALL SERVE AS THE BASIS FOR THE CITY OF CINCINNATI TO IMMEDIATELY SEEK LEGAL RECOURSE, INCLUDING THE RECOVERY OF ACTUAL DAMAGES RESULTING FROM UNAUTHORIZED ACCESS OR DISCLOSURE OF THE DOCUMENT.

# SPRINGDALE ROAD

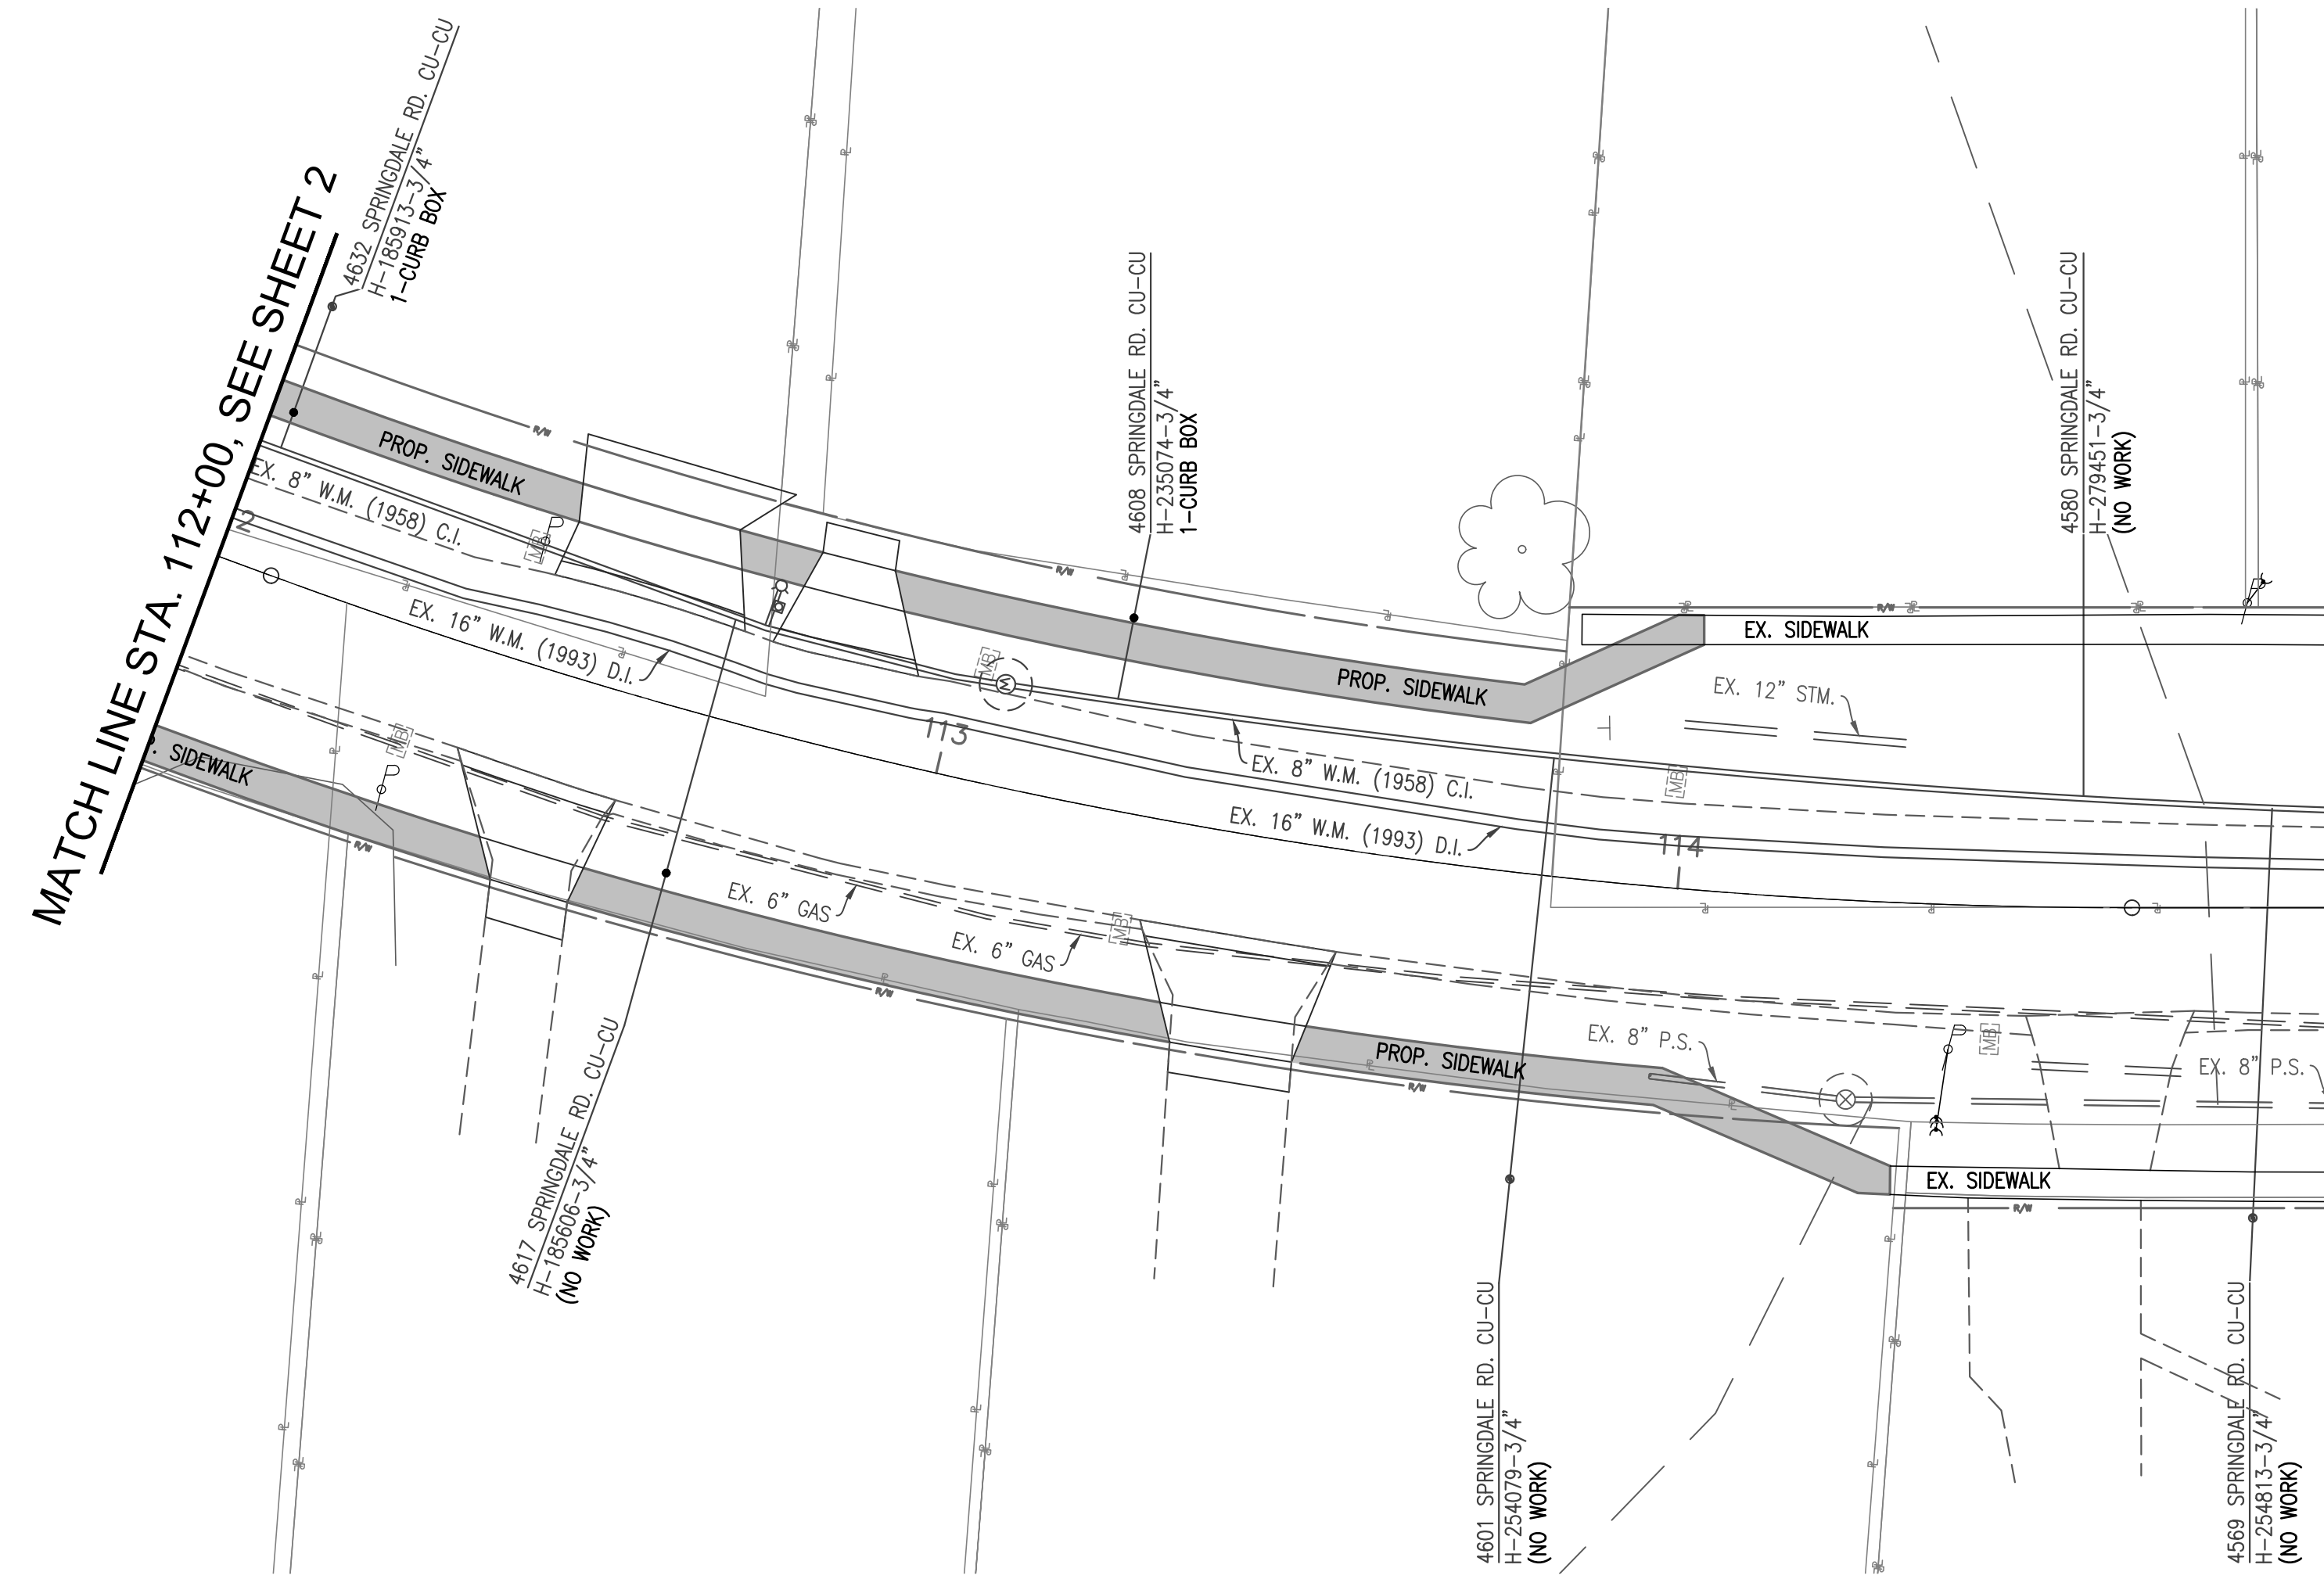

**STANDARD WATER MAIN TRENCH INSTALLATION DETAIL  
(TEMPORARY RESTORATION)**

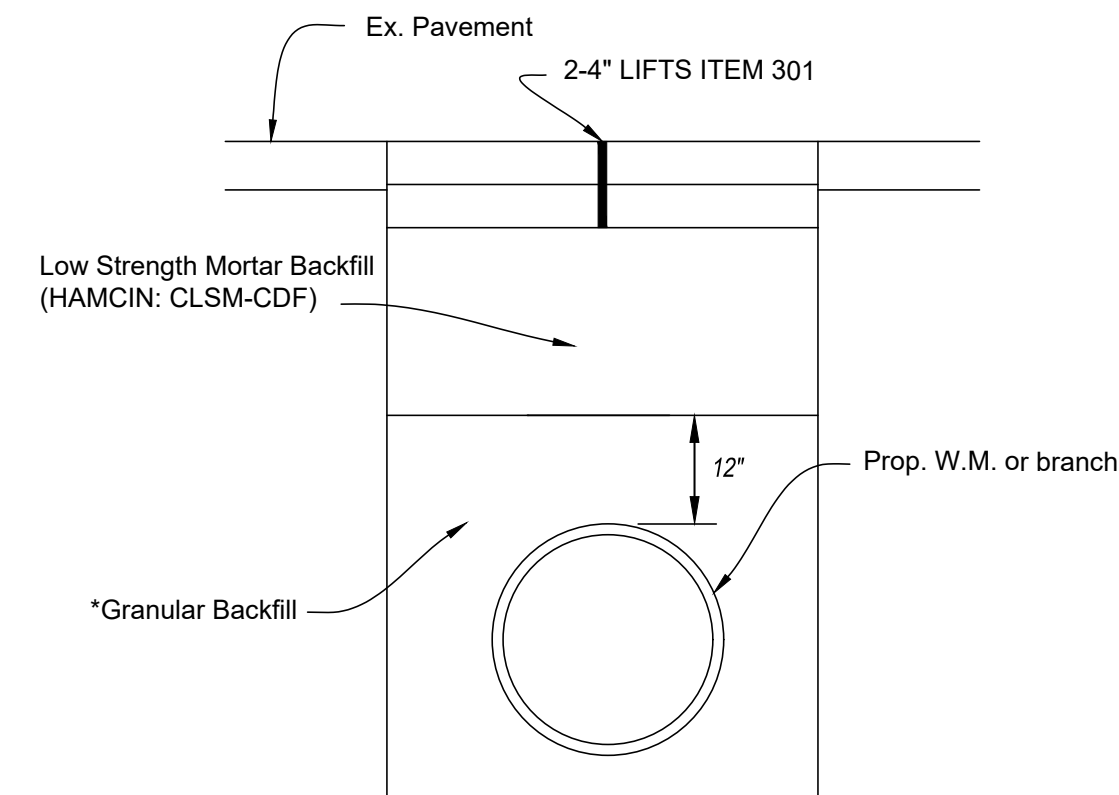

\*\*PERMANENT RESTORATION SHALL BE DONE IN ACCORDANCE WITH THE CONTRACT SPECIFICATIONS AND/OR PROJECT PLAN TYPICAL SECTIONS.

IN AREAS WHERE THE PAVEMENT, BASE AND/OR SUB-BASE IS TO BE REPLACED AS PART OF THE ROADWAY CONTRACT, THE COST FOR PERMANENT PAVEMENT RESTORATION SHALL BE INCLUDED UNDER THE APPROPRIATE PAVEMENT BID ITEMS. COST FOR TEMPORARY PAVEMENT RESTORATION IN THESE AREAS SHALL BE INCLUDED IN THE CONTRACTOR'S APPROPRIATE UNIT BID PRICE FOR ITEM 1101 OR ITEM 1126.

UNLESS OTHERWISE NOTED ON THE PLANS, AREAS WHERE THE EXISTING PAVEMENT, BASE AND/OR SUB-BASE ARE NOT TO BE DISTURBED, THE COST FOR TEMPORARY AND PERMANENT PAVEMENT RESTORATION SHALL BE INCLUDED IN THE CONTRACTOR'S APPROPRIATE UNIT BID PRICE FOR ITEM 1101 OR ITEM 1126.

\*BACKFILL OF THE WATER MAIN AND BRANCH TRENCH SHALL BE DONE IN ACCORDANCE WITH G.C.W.W. SPECIFICATIONS. ALL WATER MAINS AND BRANCHES INSTALLED OUTSIDE OF THE PAVEMENT AREA SHALL UTILIZE GRANULAR BACKFILL IN LIEU OF THE CONTROL DENSITY FILL. ALL COSTS FOR BACKFILL SHALL BE INCLUDED UNDER ITEM 1101 OR ITEM 1126.


CONTROLLED DENSITY FILL MUST MEET BOTH HAMCIN: CLSM-CDF PERFORMANCE SPECIFICATION AND O.D.O.T. SPECIFICATION. ALL FLOWABLE FILL PRODUCTS SHALL MEET THE REQUIREMENTS OF THE CURRENT HAMCIN CLSM-CDF BACKFILL SPECIFICATION (DATED MARCH 2015). COPIES OF THE HAMCIN CLSM-CDF BACKFILL SPECIFICATION ARE MADE AVAILABLE AT THE GCWW ENGINEERING OFFICES AT 4747 SPRING GROVE AVENUE, CINCINNATI DEPARTMENT OF TRANSPORTATION & ENGINEERING AT 801 PLUM STREET, OR THEIR WEBSITE: [HTTP://WWW.CINCINNATI-OH.GOV/OTTE/MANUALS-PERMITS-SUPPLEMENTS/](http://www.cincinnati-oh.gov/otte/manuals-permits-supplements/). ALSO, THE CONTRACTOR SHALL SUBMIT, PRIOR TO THE START OF CONSTRUCTION, THE NECESSARY DOCUMENTATION FOR REVIEW AND APPROVAL BY THE GCWW.

PLEASE NOTE THAT THE G.C.W.W. REQUIREMENT IS IN ADDITION TO HAMCIN SPECIFICATIONS FOR FLOWABLE FILL PRODUCTS. A COPY OF THE G.C.W.W. REQUIREMENT IS AVAILABLE AT THE G.C.W.W. ENGINEERING OFFICE LOCATED AT 4747 SPRING GROVE AVENUE. CONTACT THE SUPERVISOR OF INSPECTION AT 591-7870.

PRIOR TO THE START OF CONSTRUCTION, THE CONTRACTOR SHALL SUBMIT THE NECESSARY CONTROLLED DENSITY FILL COMPLIANCE DOCUMENTATION FOR REVIEW AND APPROVAL BY THE G.C.W.W.


GCWW NOTE:  
ALL FIELD LAYOUT OF WATER MAIN PIPE AND SPECIALS SHALL BE THE RESPONSIBILITY OF THE CONTRACTOR AND SHALL BE PERFORMED BY A LICENSED SURVEYOR.

There is no profile illustrated.

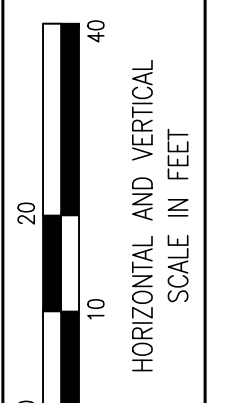

CALCULATED	MRD
REVISIONS	CHECKED
	EGG

GREATER CINCINNATI  
**WATER WORKS**  
ENGINEERING DIVISION / DESIGN SECTION  
3845 EASTERN AVENUE, CINCINNATI, OHIO 45226

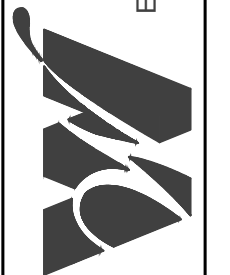

**SPRINGDALE ROAD  
PLAN AND PROFILE**

DS-0989  
MF-17068


3  
4

SPRINGDALE RD. SIDEWALK


**NOTICE OF CONFIDENTIALITY - PUBLIC INFRASTRUCTURE RECORD**  
THIS DOCUMENT IS A PUBLIC INFRASTRUCTURE RECORD OF THE CITY OF CINCINNATI AND ITS GREATER CINCINNATI WATER WORKS, AND IS NOT SUBJECT TO THE PUBLIC DISCLOSURE REQUIREMENTS OF THE PUBLIC RECORDS LAWS OF THE STATE OF OHIO AND FEDERAL GOVERNMENT. THIS DOCUMENT IS BEING PROVIDED ON THE BASIS OF YOUR REPORTED NEED, AND SHALL BE CONSIDERED CONFIDENTIAL. BY ACCEPTING THIS DOCUMENT, YOU AGREE THAT IT WILL NOT BE SHARED OR OTHERWISE DISCLOSED TO ANYONE OTHER THAN PERSONS WHO HAVE A DIRECT NEED TO KNOW FOR THE SOLE PURPOSE OF CARRYING OUT THE PROJECT FOR WHICH THIS DOCUMENT WAS OBTAINED. ANYONE RECEIVING THIS DOCUMENT IS BOUND BY THE SAME CONFIDENTIALITY REQUIREMENTS AND MUST TAKE PRECAUTIONS TO PROTECT AGAINST ITS DISSEMINATION.  
  
THE FAILURE TO OBSERVE THE CONFIDENTIALITY REQUIREMENTS OF THIS NOTICE SHALL SERVE AS THE BASIS FOR THE CITY OF CINCINNATI TO IMMEDIATELY SEEK LEGAL RECOURSE, INCLUDING THE RECOVERY OF ACTUAL DAMAGES RESULTING FROM UNAUTHORIZED ACCESS OR DISCLOSURE OF THE DOCUMENT.



# SPRINGDALE ROAD

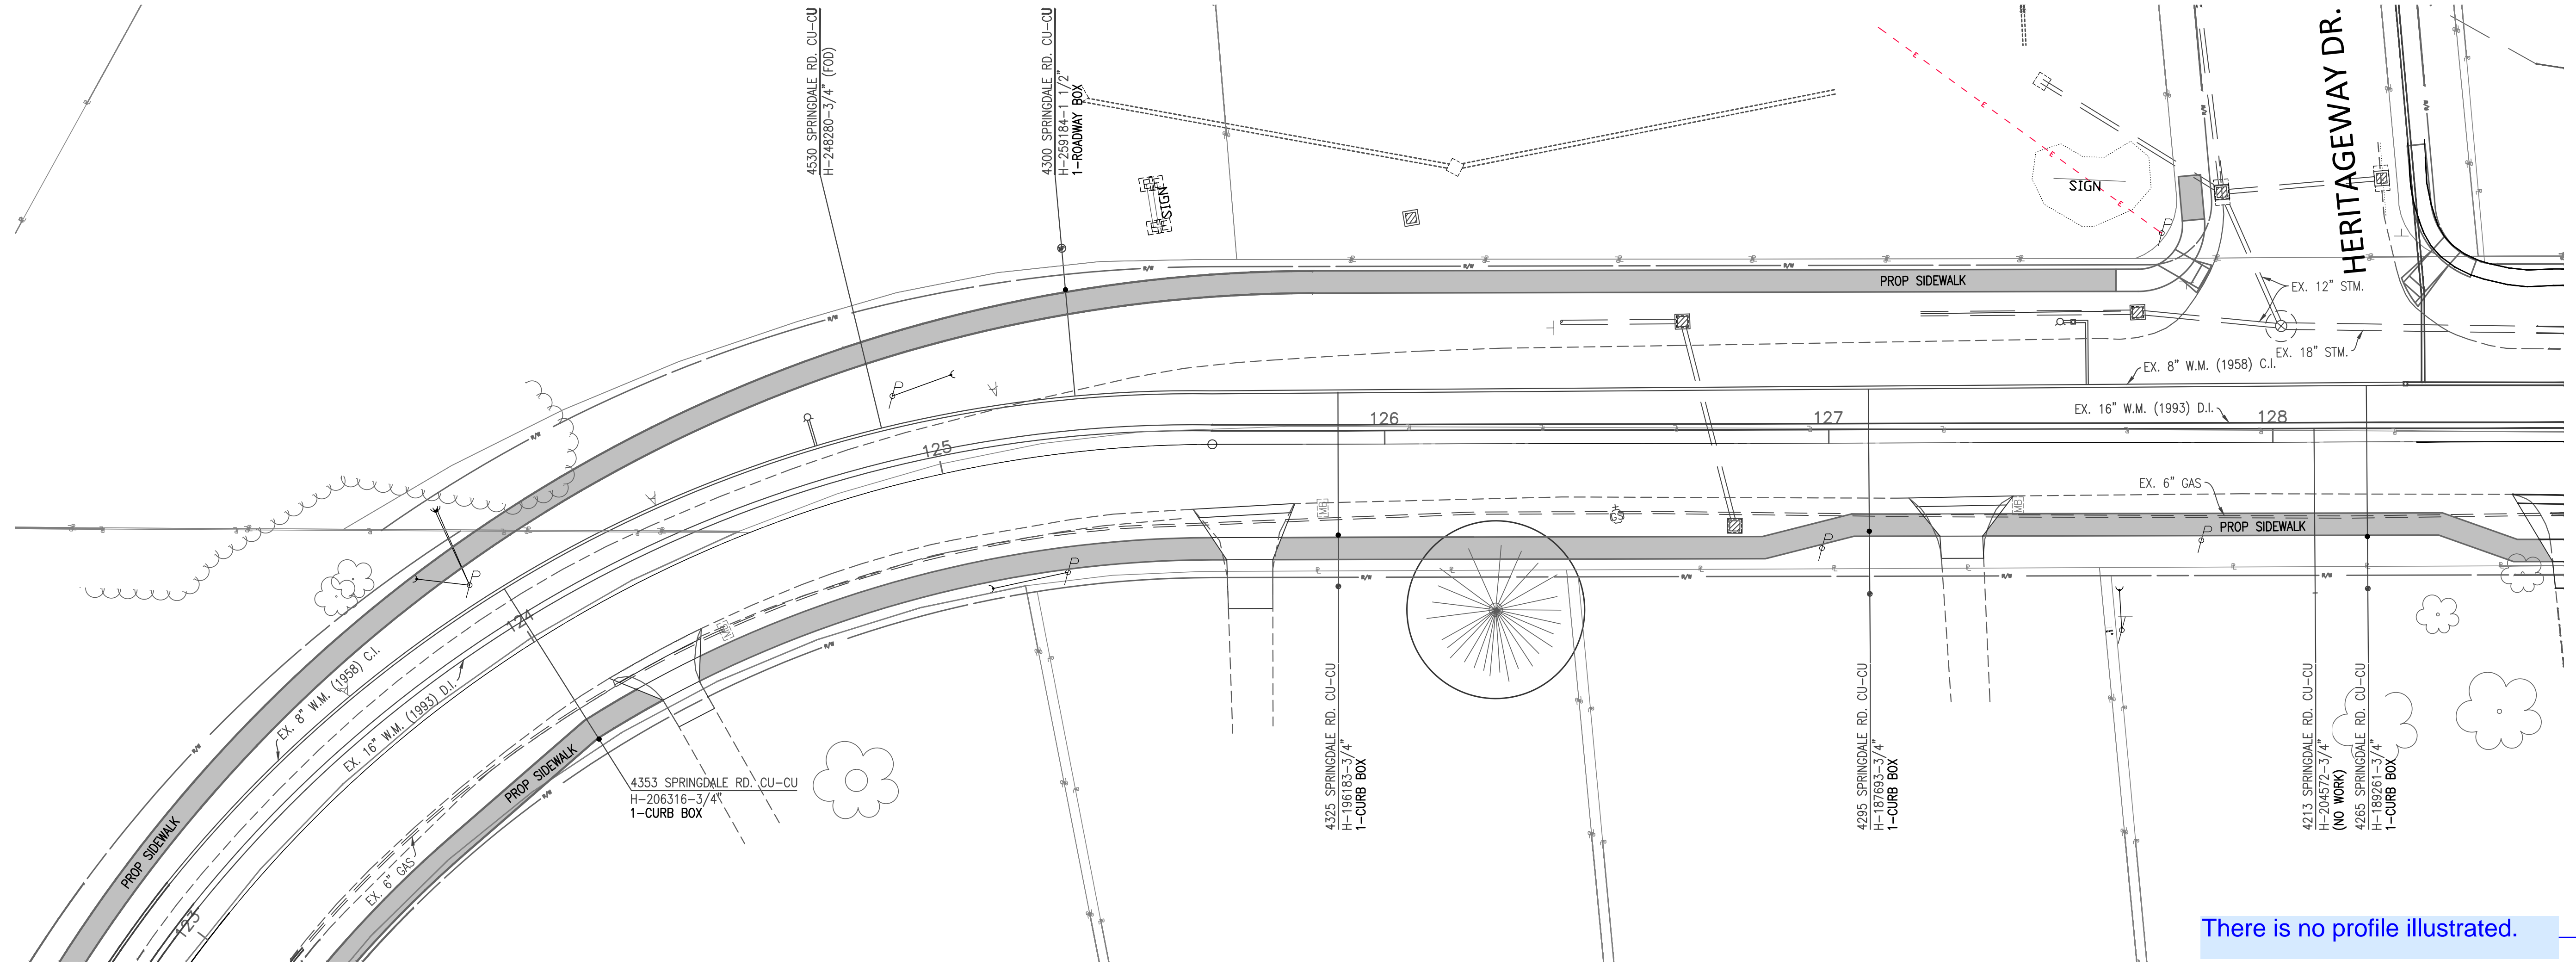

There is no profile illustrated.

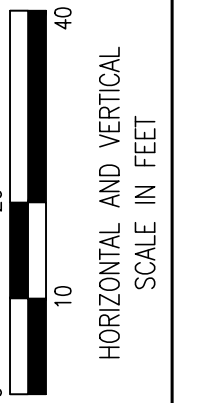

CALCULATED	MRD
REVISIONS	CHECKED
	EGG


GREATER CINCINNATI  
**WATER WORKS**  
 ENGINEERING DIVISION / DESIGN SECTION  
 3845 EASTERN AVENUE, CINCINNATI, OHIO 45226



## SPRINGDALE ROAD PLAN AND PROFILE

DS-0989  
 MF-17068

4  
 4

**NOTICE OF CONFIDENTIALITY - PUBLIC INFRASTRUCTURE RECORD**  
 THIS DOCUMENT IS A PUBLIC INFRASTRUCTURE RECORD OF THE CITY OF CINCINNATI AND ITS GREATER CINCINNATI WATER WORKS, AND IS NOT SUBJECT TO THE PUBLIC DISCLOSURE REQUIREMENTS OF THE PUBLIC RECORDS LAWS OF THE STATE OF OHIO AND FEDERAL GOVERNMENT. THIS DOCUMENT IS BEING PROVIDED ON THE BASIS OF YOUR REPORTED NEED, AND SHALL BE CONSIDERED CONFIDENTIAL. BY ACCEPTING THIS DOCUMENT, YOU AGREE THAT IT WILL NOT BE SHARED OR OTHERWISE DISCLOSED TO ANYONE OTHER THAN PERSONS WHO HAVE A DIRECT NEED TO KNOW FOR THE SOLE PURPOSE OF CARRYING OUT THE PROJECT FOR WHICH THIS DOCUMENT WAS OBTAINED. ANYONE RECEIVING THIS DOCUMENT IS BOUND BY THE SAME CONFIDENTIALITY REQUIREMENTS AND MUST TAKE PRECAUTIONS TO PROTECT AGAINST ITS DISSEMINATION.  
 THE FAILURE TO OBSERVE THE CONFIDENTIALITY REQUIREMENTS OF THIS NOTICE SHALL SERVE AS THE BASIS FOR THE CITY OF CINCINNATI TO IMMEDIATELY SEEK LEGAL RECOURSE, INCLUDING THE RECOVERY OF ACTUAL DAMAGES RESULTING FROM UNAUTHORIZED ACCESS OR DISCLOSURE OF THE DOCUMENT.