

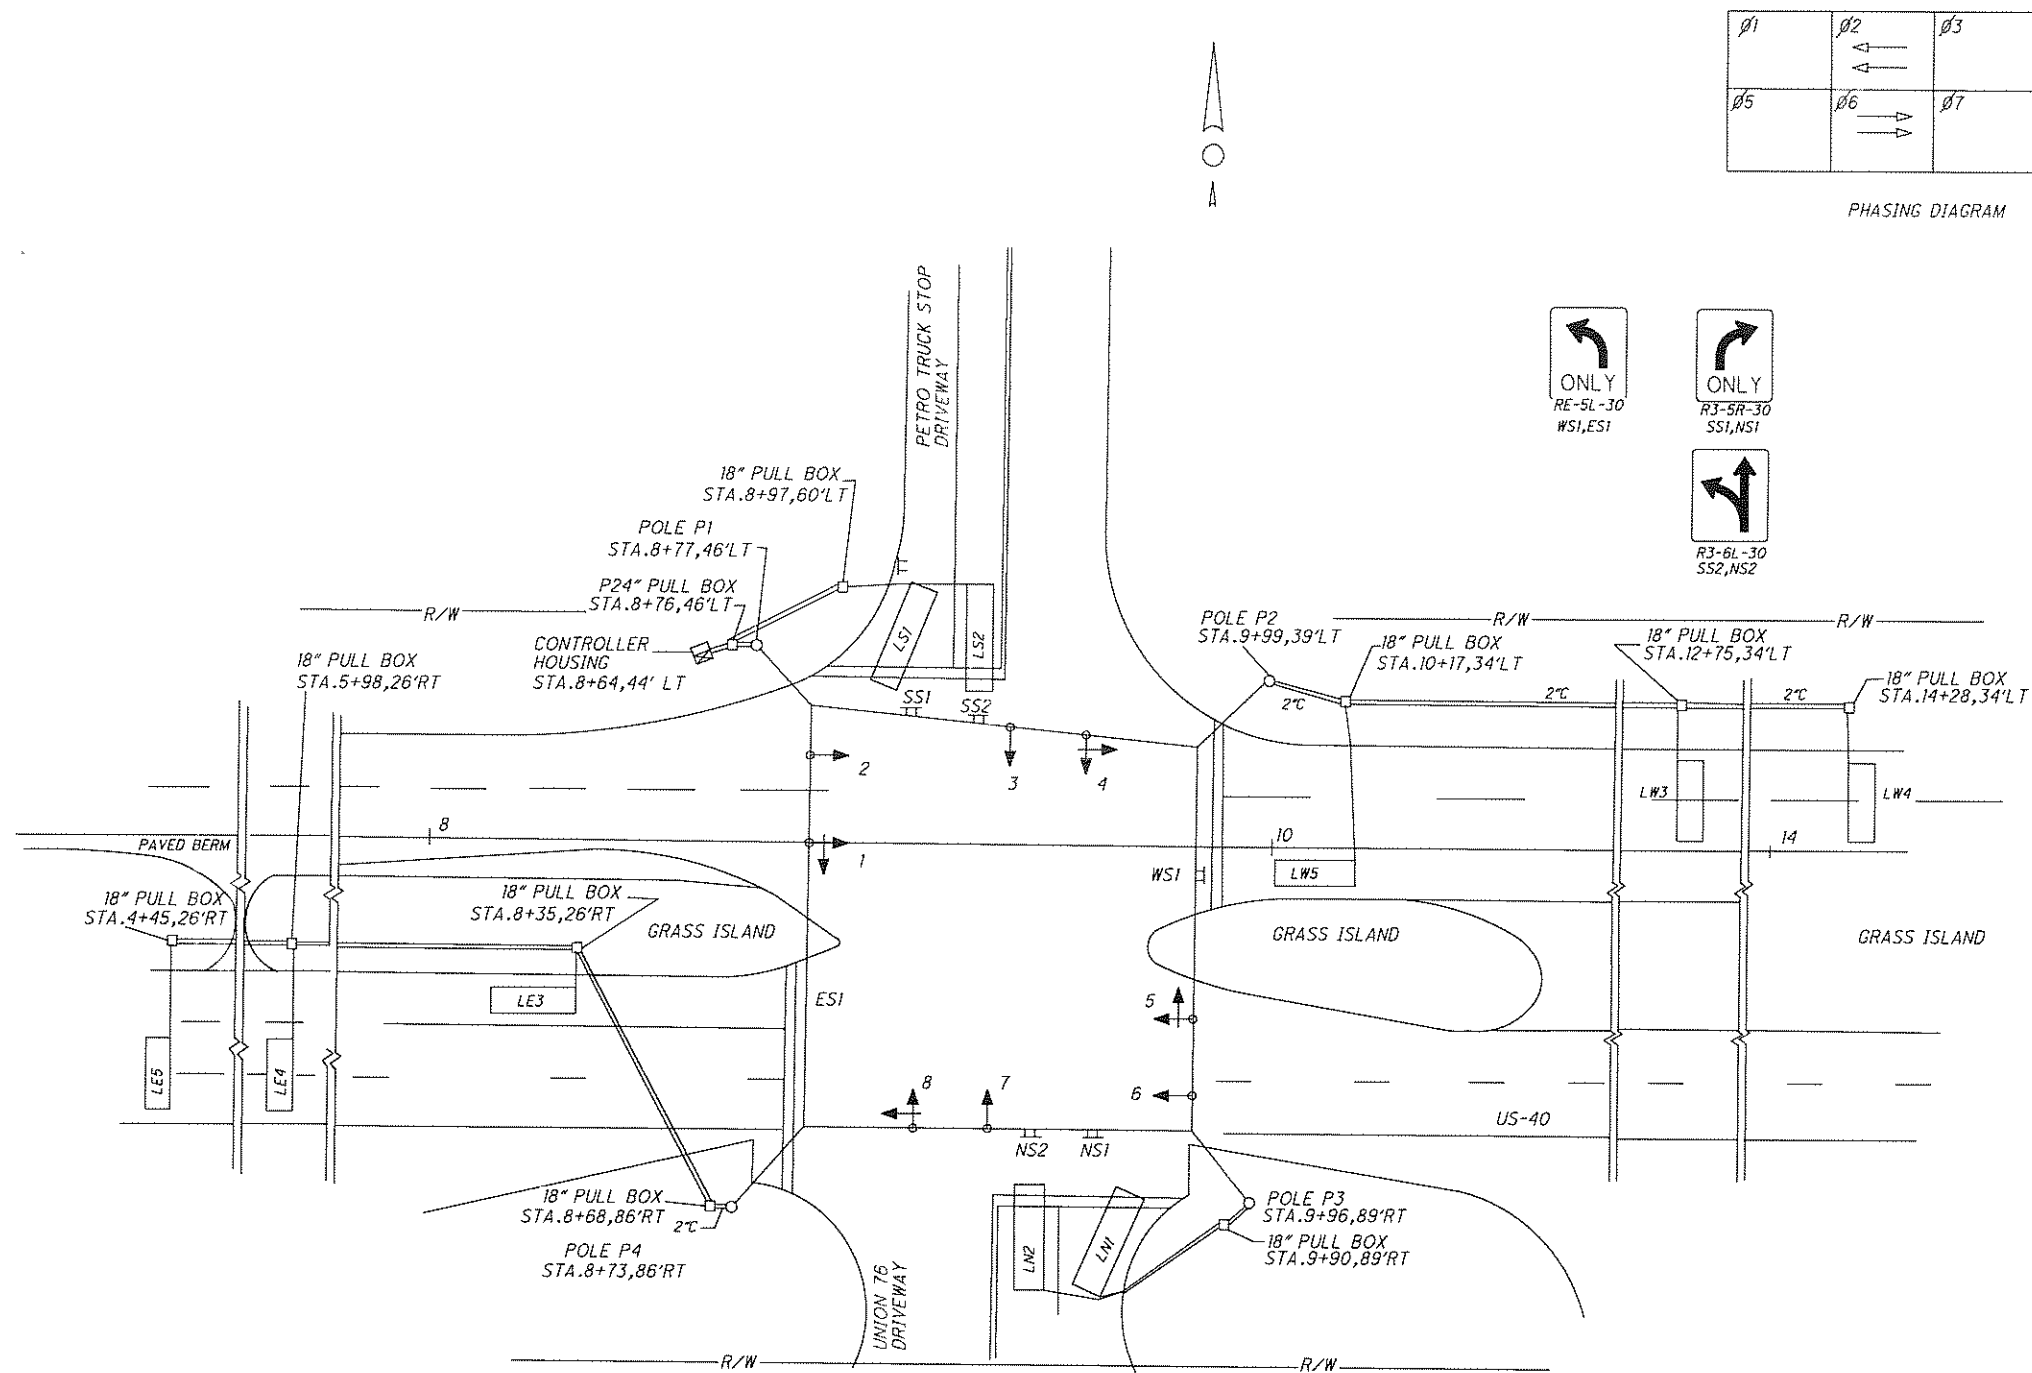
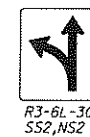


PHASING DIAGRAM

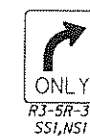

SIGNAL INDICATIONS

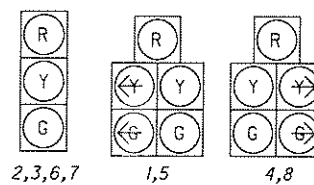

FLASHER OPERATION
RED TO US-40
RED TO PETRO
SIGNAL NO. PRE 40-0.42
OSIS NO. 781
INSTALLATION DATE 5-18-90
FILE NO. 3285

DATE	REVISIONS	OHIO DEPARTMENT OF TRANSPORTATION				
1-31-08	REPLACED CONTROLLER W/170 & 332 CABINET	US-40 & PETRO TRUCK STOP				
10-26-09	SHUT OF US-40 EAST & WEST LEFT TURN ARROWS					
		DISTRICT 8 COUNTY PREBLE 1=30'				
		APPROVED R.YANKOVICH DATE 2-15-91				
		ENGINEER OF TRAFFIC				
		DESIGNED	DRAWN	REVISED	CHECKED	REVIEWED

DESIGNED

REVIEWED

OFFICE OF
TRAFFIC
ENGINEERING

US-40 & PETRO TRUCK STOP
PREBLE COUNTY