


○

○

○

○

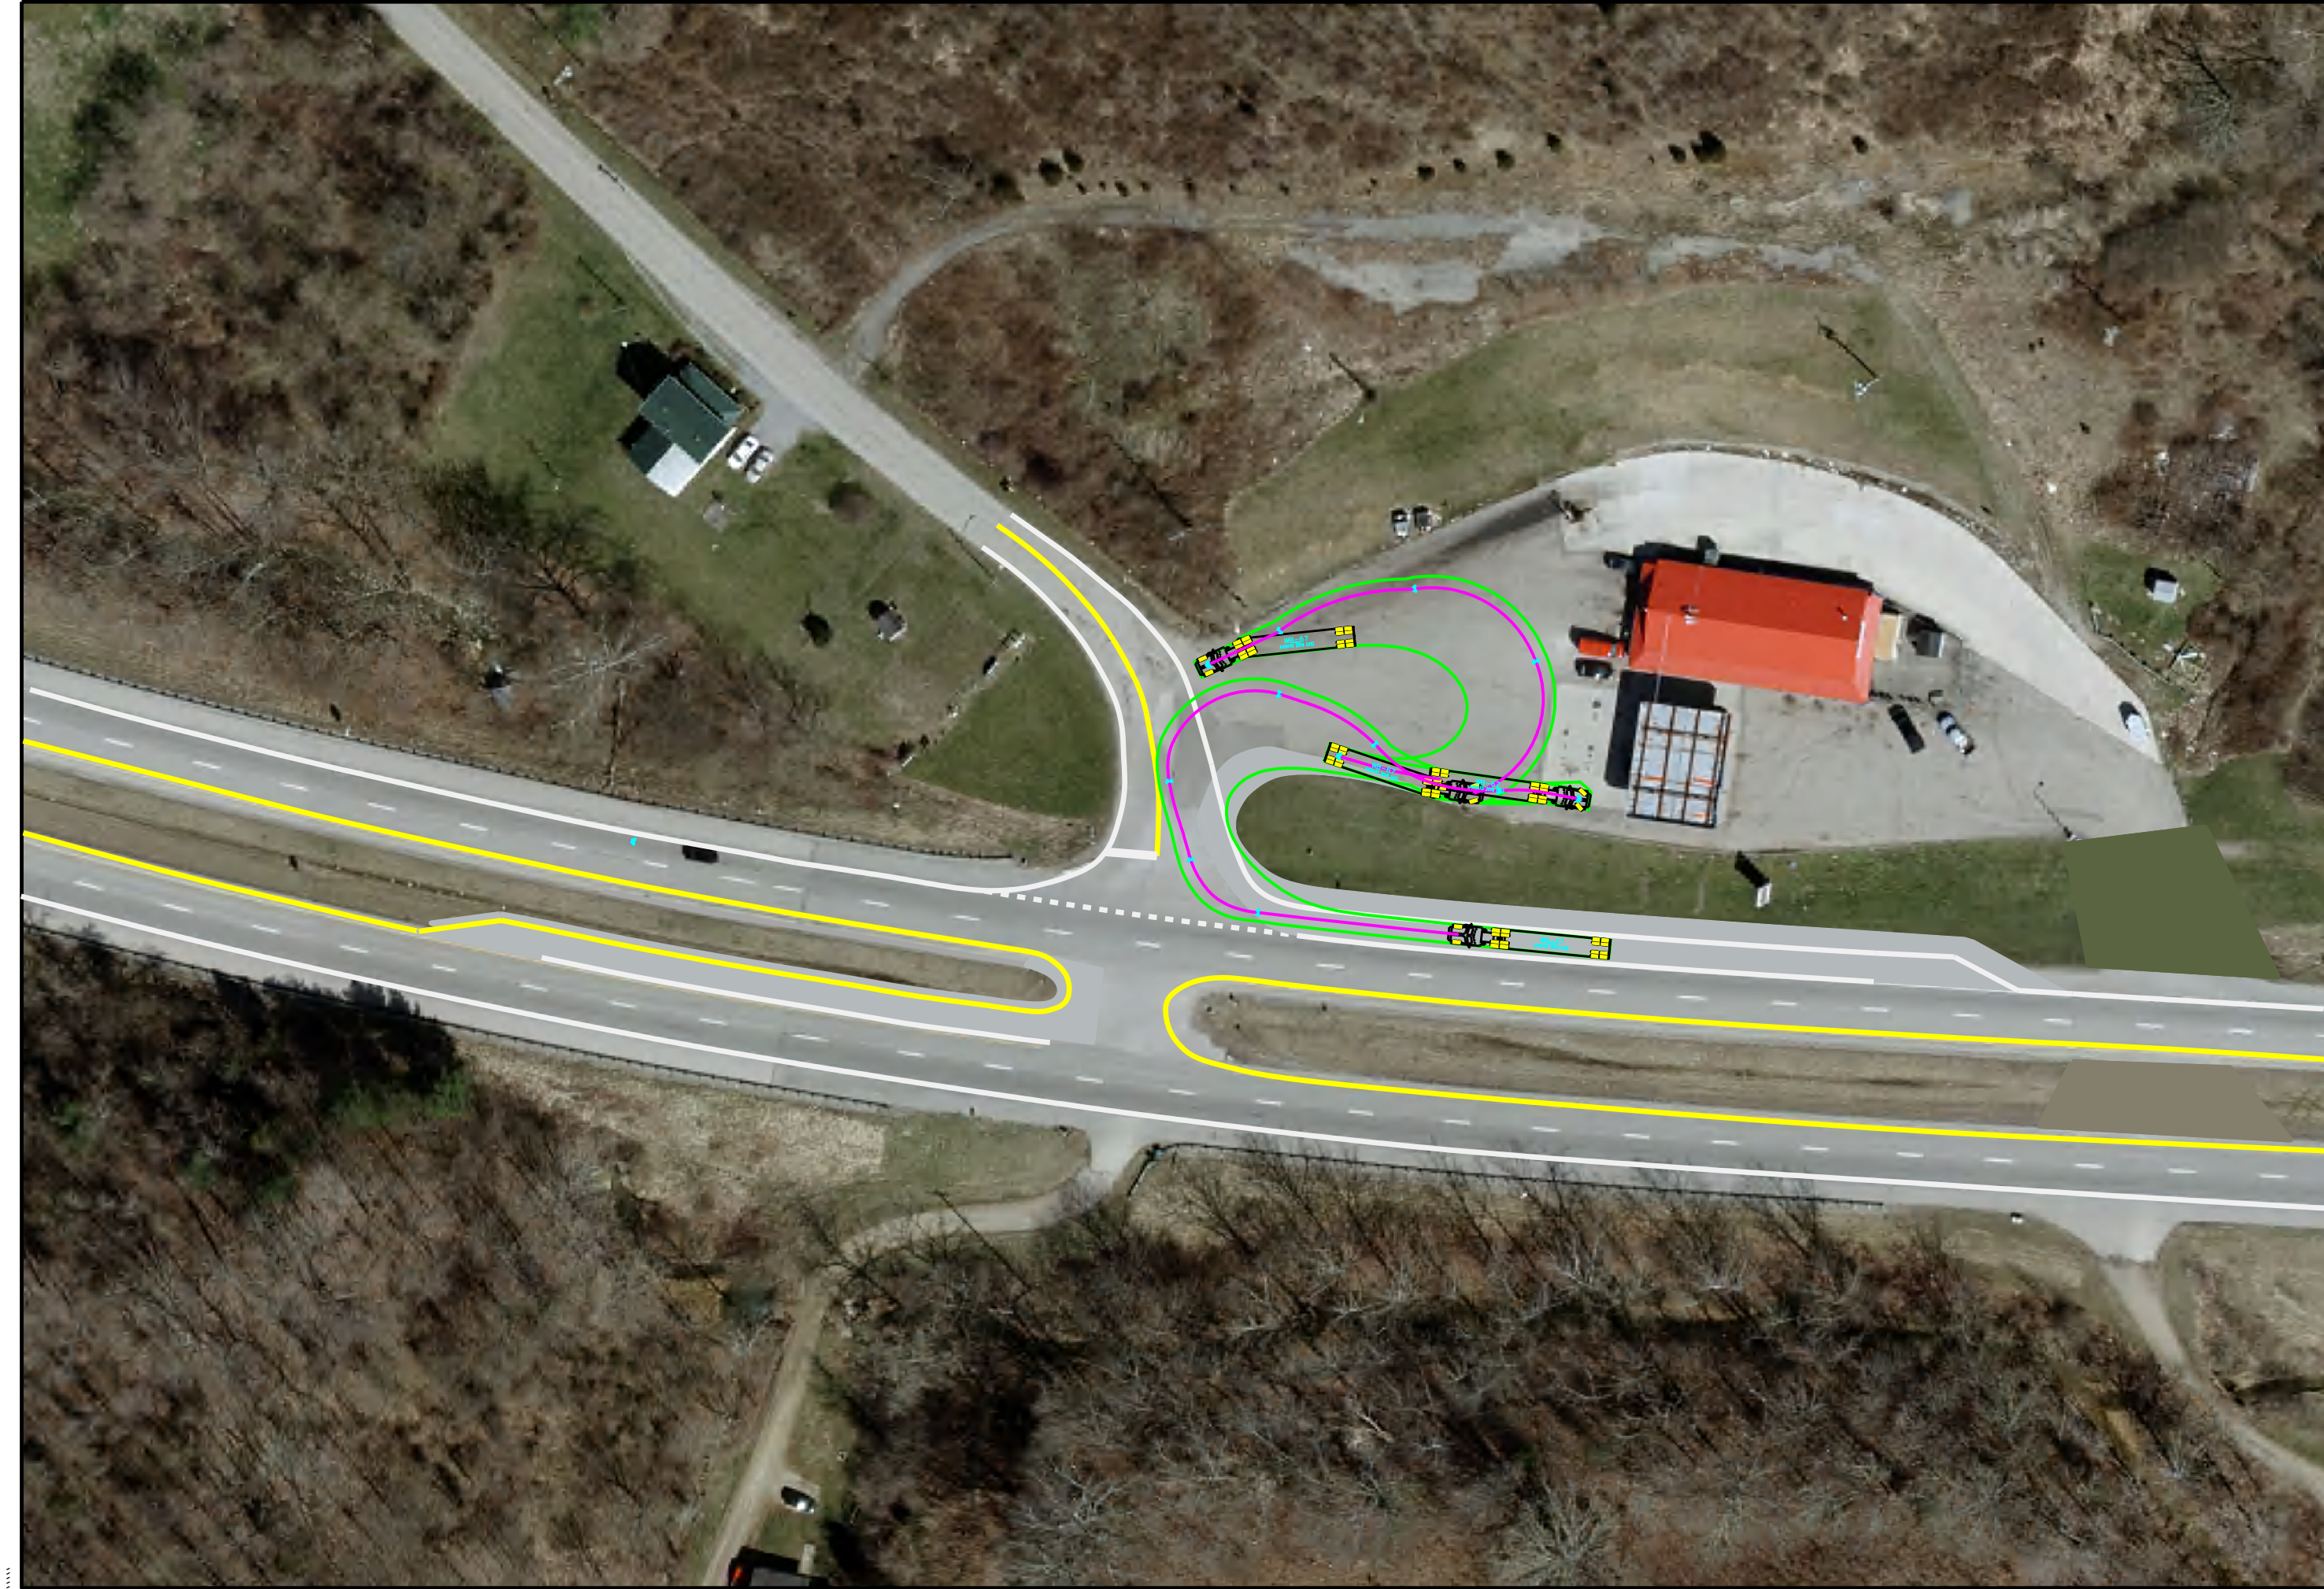

R0S-35-34.56

R0S-35-34.56 (Main St)
Turn Lane Additions

CALCULATED
CHECKED

HORIZONTAL
SCALE 1/4" = 100'