


QUANTITIES CALC. J.H. 8 MAY 1973
 QUANTITIES CK'D. 5-8-73 J.D.


FHWA REGION	STATE	PROJECT
5	OHIO	

446
966


CUY-90-2.80

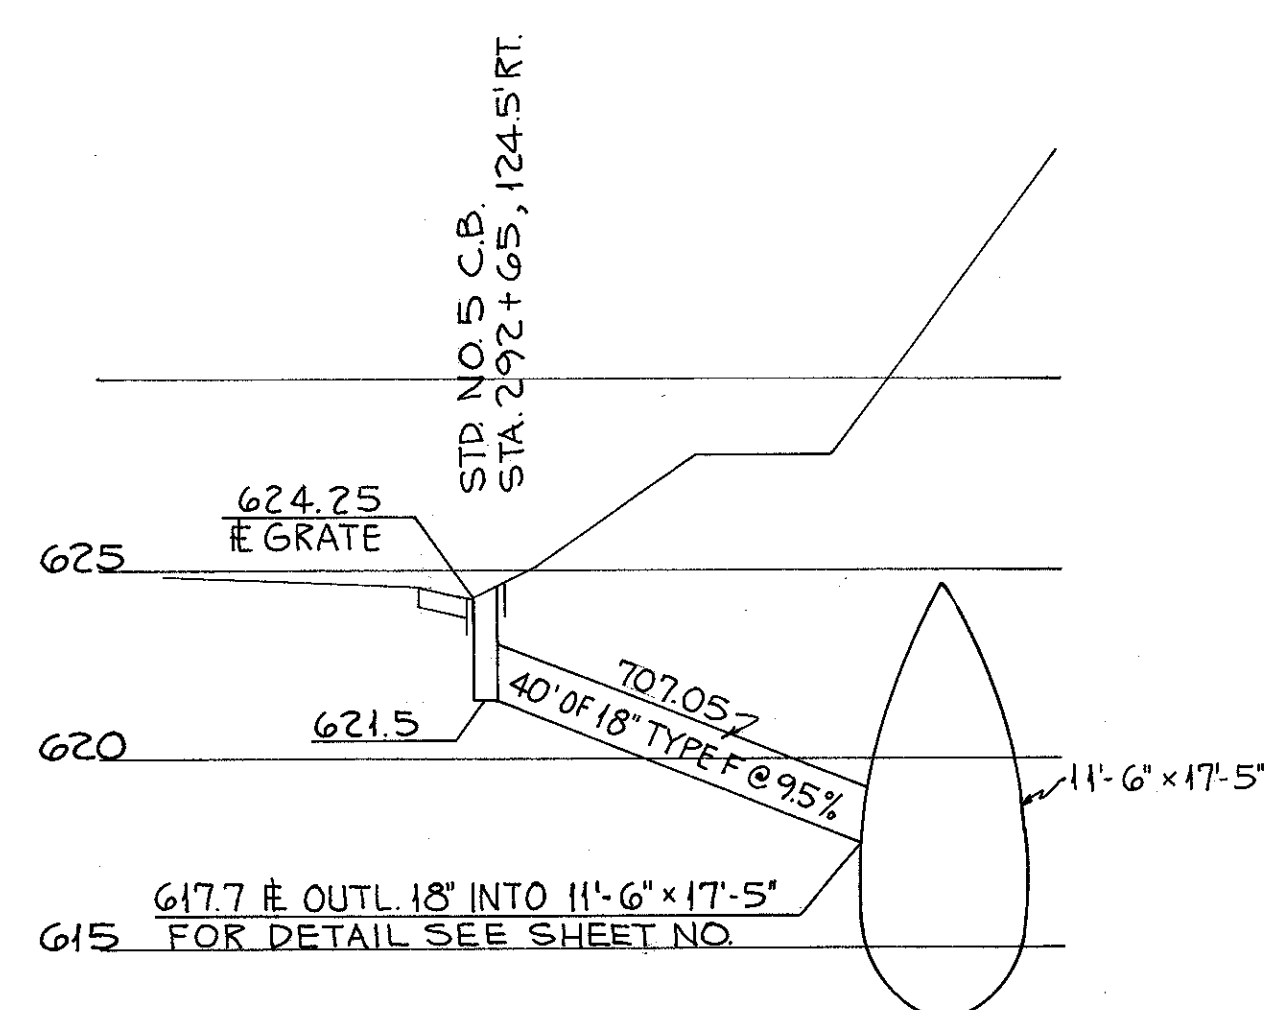


SLM 5.55, 18"
 MM 161.36
 I-D, SHEET NO. 50
 SEE SHEET 50

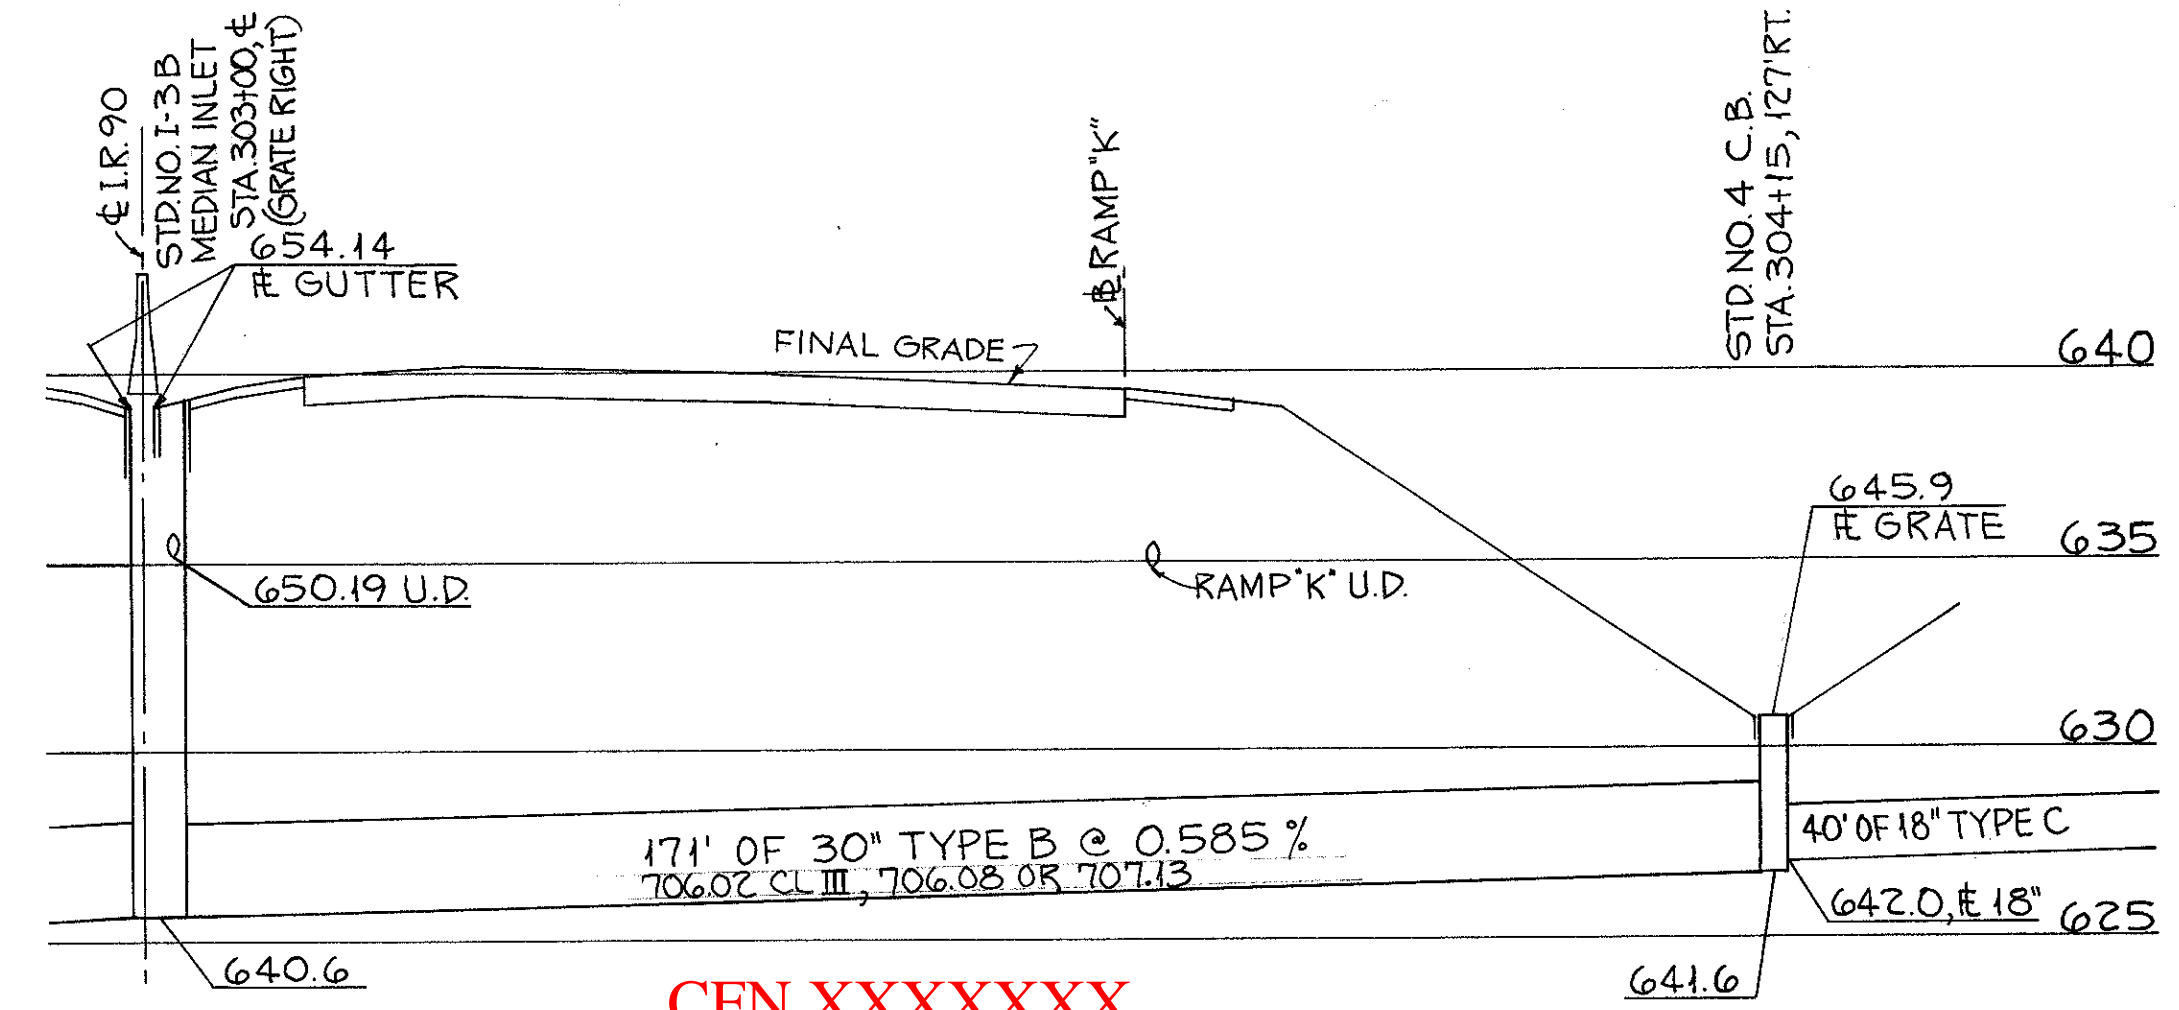


CFN XXXXXXXX
 SLM 5.74, 30"
 MM 161.55
 I-D & 2-D, SHEET NO. 51
 SEE SHEET 51
 INV. 3/10/2017
 NEEDS INS

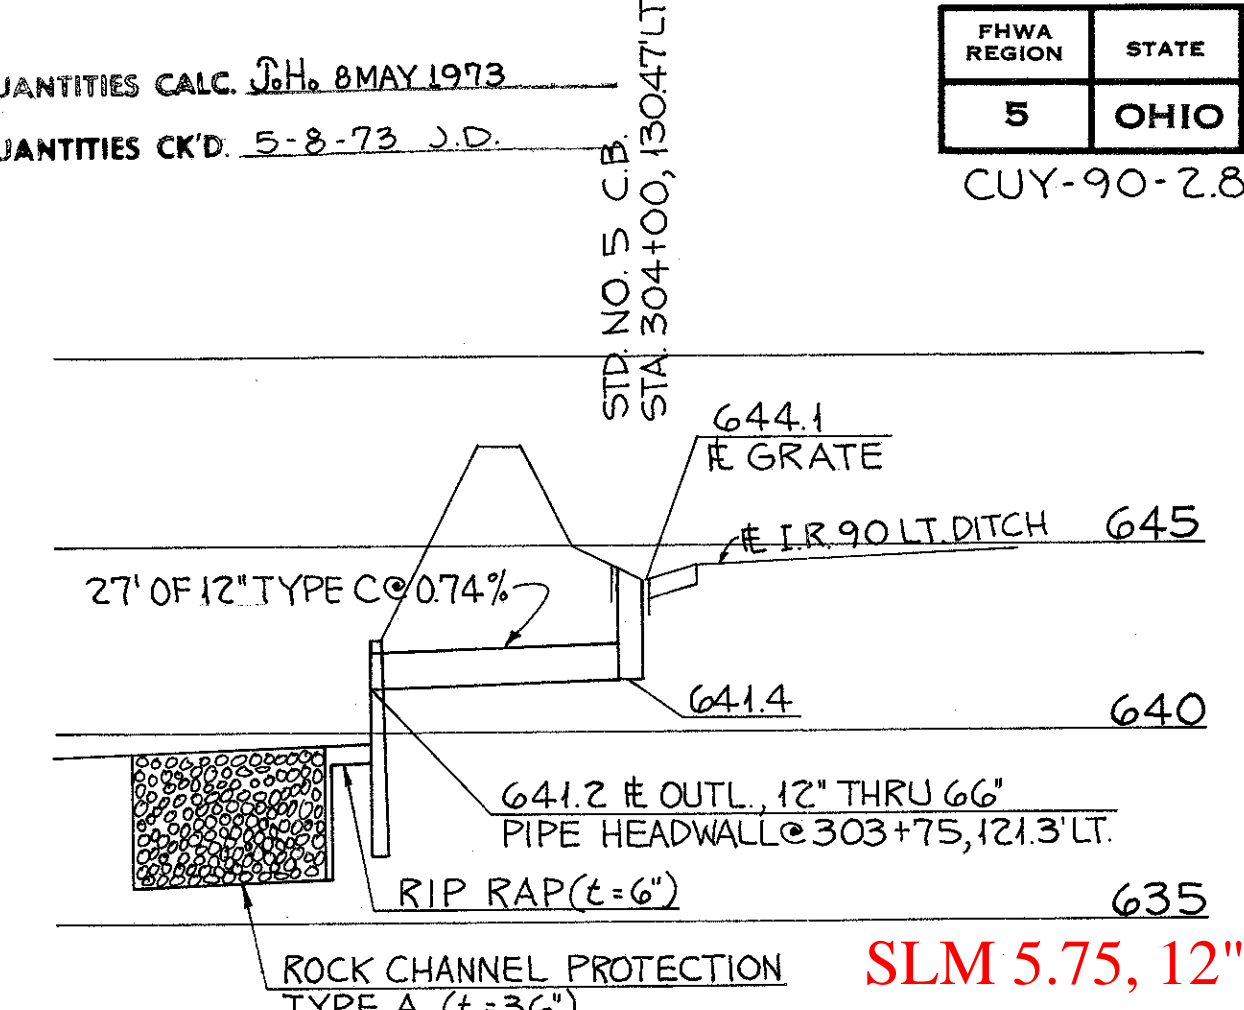

SLM 5.75, 12"
 MM 161.56
 3-D, SHEET NO. 51
 SEE SHEET 51

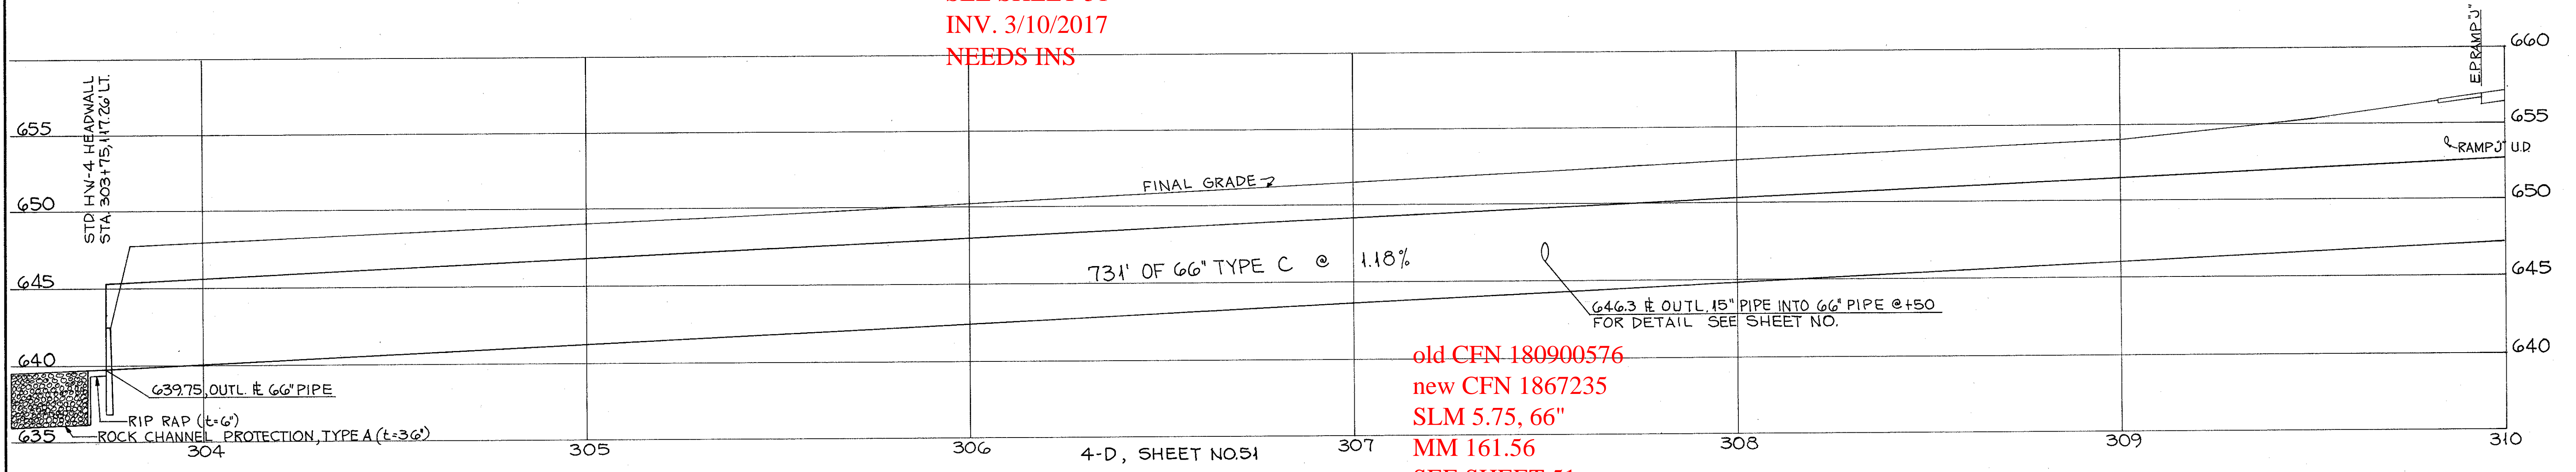

old CFN 180900576
 new CFN 1867235
 SLM 5.75, 66"
 MM 161.56
 SEE SHEET 51

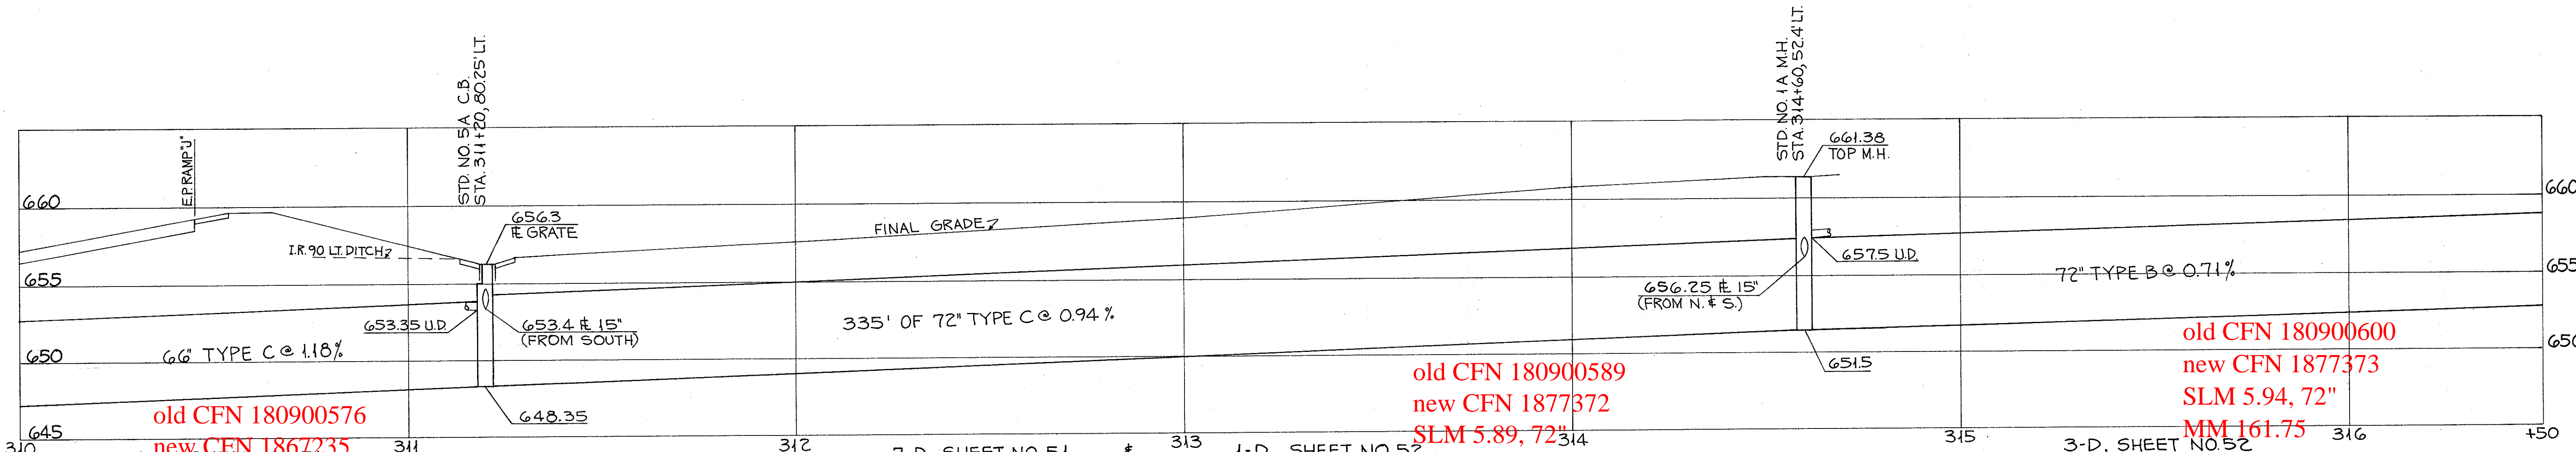

old CFN 180900576
 new CFN 1867235
 SLM 5.75, 66"
 MM 161.56
 SEE SHEET 51

old CFN 180900589
 new CFN 1877372
 SLM 5.89, 72"
 MM 161.70
 SEE SHEET 51
 AND 52

old CFN 180900600
 new CFN 1877373
 SLM 5.94, 72"
 MM 161.75
 SEE SHEET 52