


FED. RD. DIVISION	STATE	PROJECT	
2	OHIO		

FRANKLIN COUNTY
 FRA-270-15.19 S & FRA-270-18.15 S
 (I-270-4(7)ROW & PREL. ENG. ONLY)

E: 270 CURVE DATA
 Δ: 90° 28' 02" LT.
 D: 0° 15' 00"
 R: 12,018.31'
 L: 3186.89'
 T: 1897.76'
 E: 78.44'
 RI STA. 883+28.87

CURVE DATA - WATKINS Q.D.		RELOC. U.S. 33	
CURVE No. 51	CURVE No. 2	C CURVE DATA	
A = 16° 00' RT.	PL STA. 2+4.18.5	A = 35° 35' 15" LT.	
D = 5° 59' 40.11"	A = 80° - 30' 54" RT.	R = 3906.53'	
R = 955.81'	Dec = 8° - 00' - 00"	L = 2426.42'	
L = 266.91'	R = 716.20'	T = 1253.79'	
T = 134.33'	L = 607.65'	E = 196.27'	
E = 94.40'	L = 1001.54'	D = 1° 28' 00"	
P.I. STA = 16+478.47	E = 222.98'	PL STA. 294+01.70	
R.I. STA = 294+53.07		STA. 294.81.86 BK	

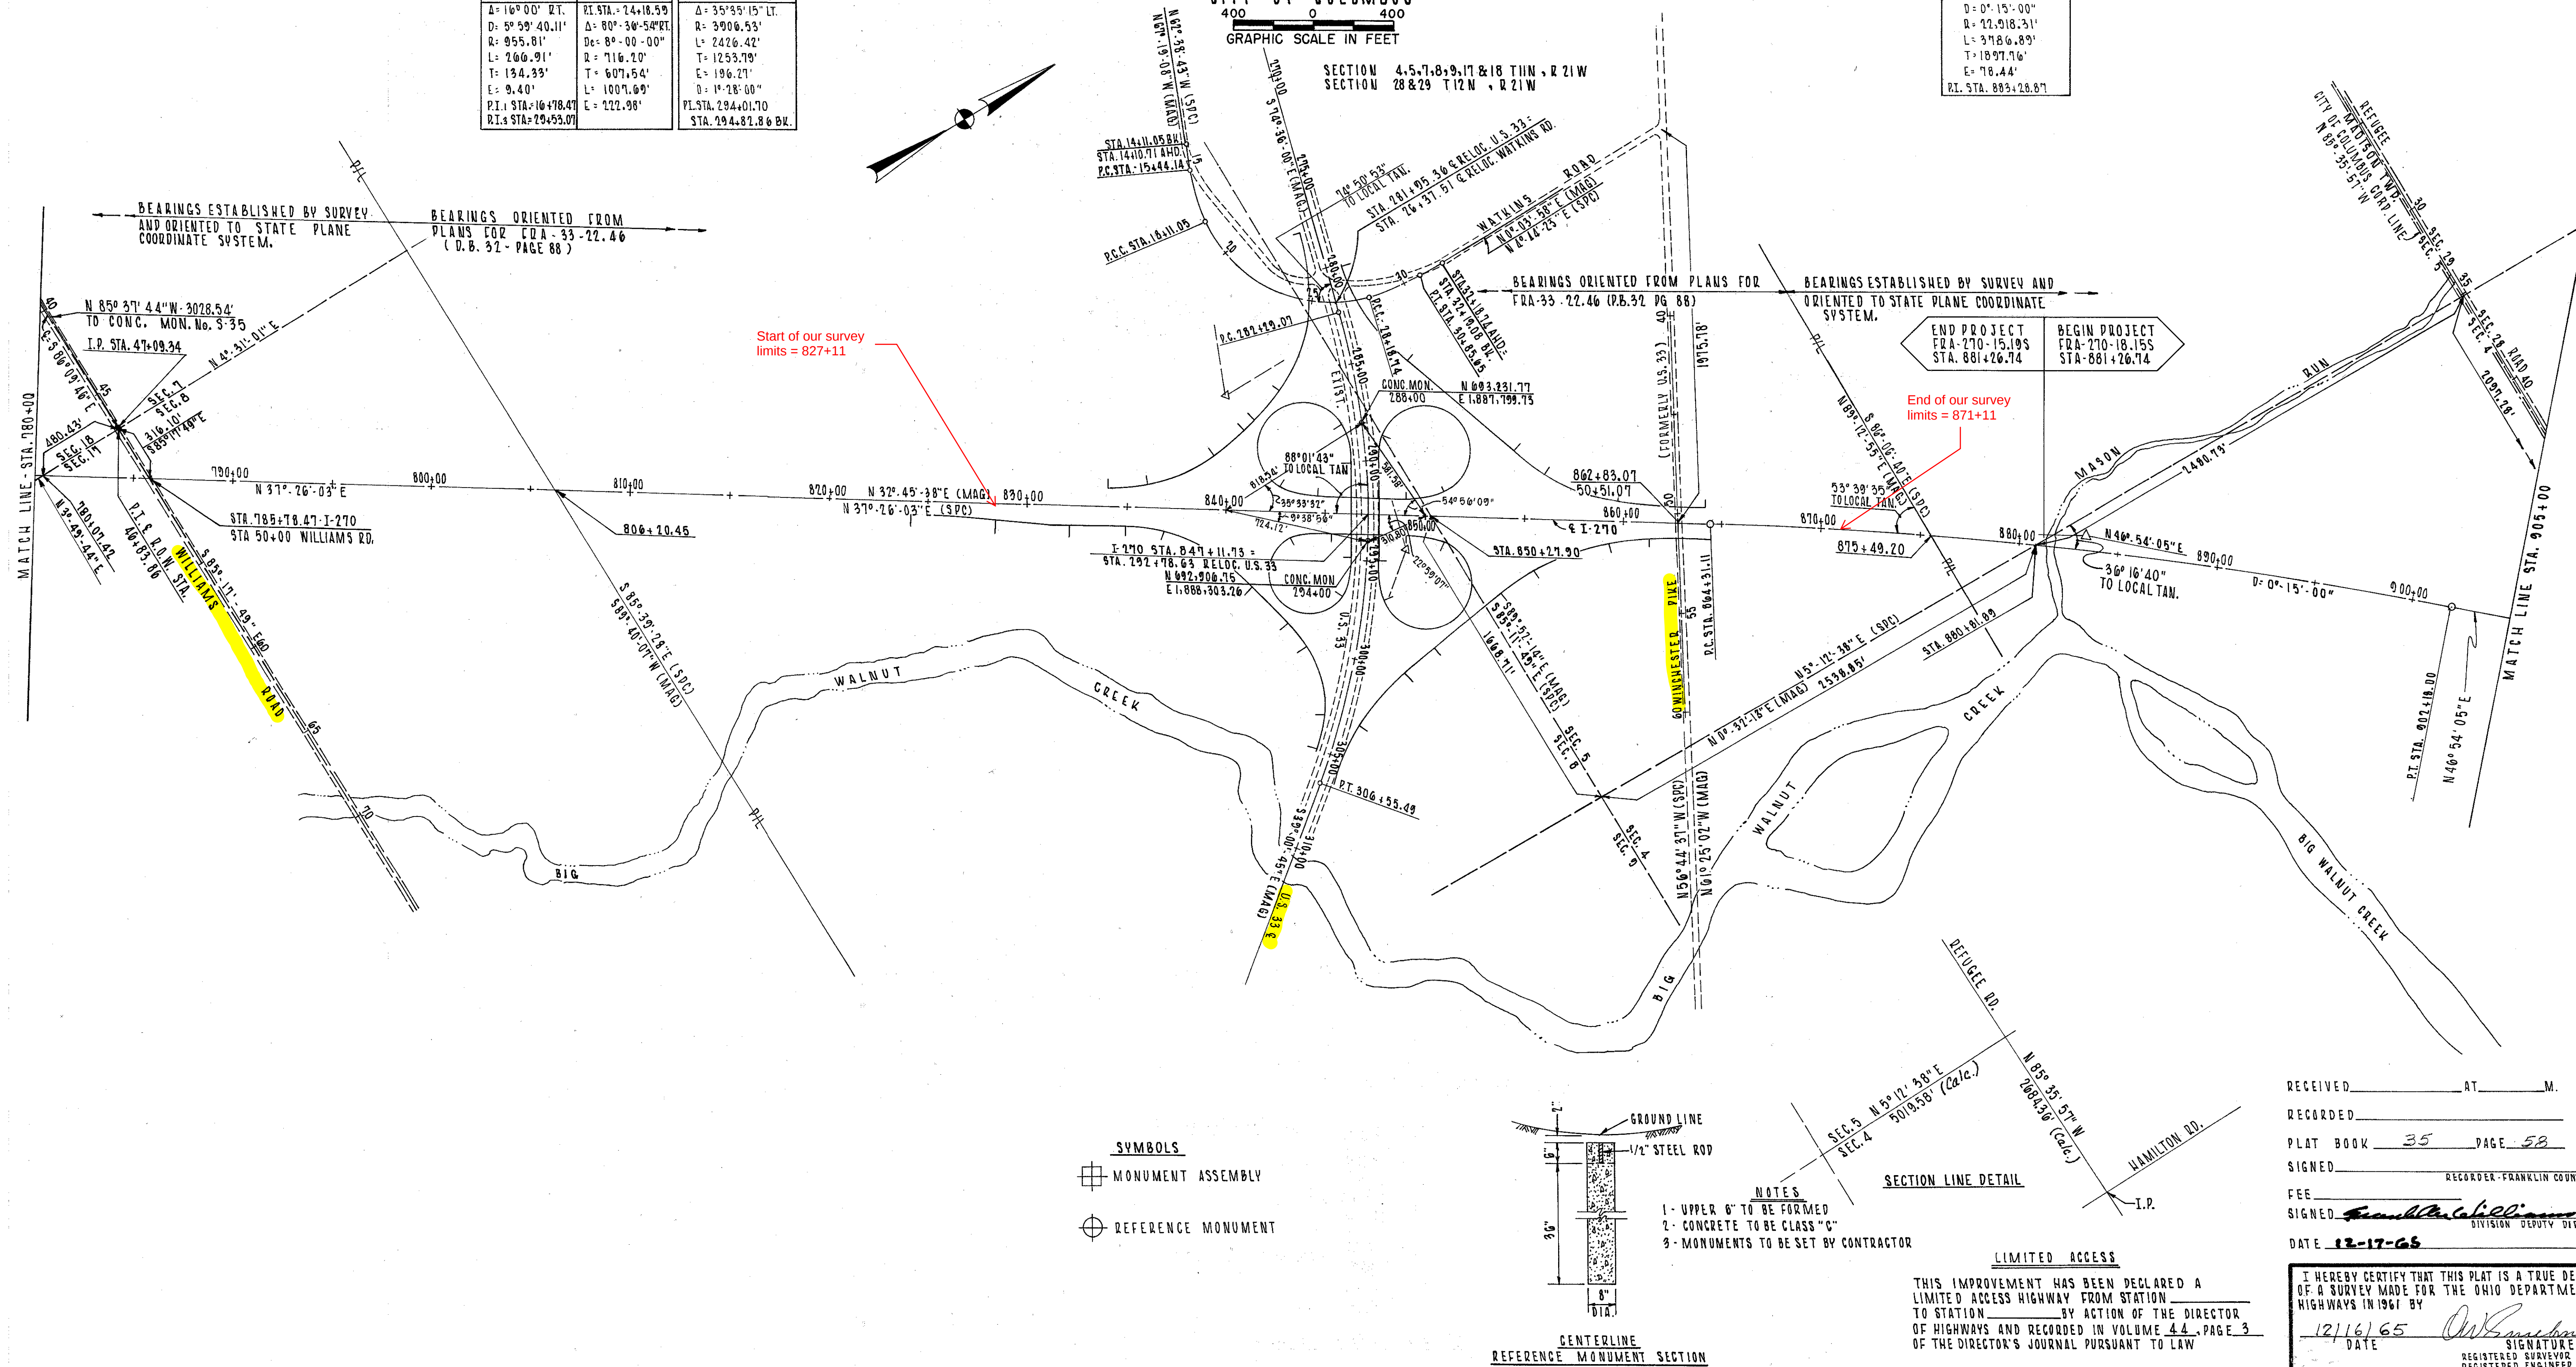

RECEIVED _____ AT _____ M.
RECORDED _____
PLAT BOOK 35 PAGE 58
SIGNED _____
RECORDER - FRANKLIN COUNTY, OHIO
FEE _____
SIGNED Franklin County
DIVISION DEPUTY DIRECTOR
DATE 12-17-68

I HEREBY CERTIFY THAT THIS PLAT IS A TRUE DELINEATION
OF A SURVEY MADE FOR THE OHIO DEPARTMENT OF
HIGHWAYS IN 1961 BY


12/16/65 W. S. Sanderberg
DATE SIGNATURE

REGISTERED SURVEYOR NO. 771
REGISTERED ENGINEER NO. 1336

FED. RD. DIVISION	STATE	PROJECT	
2	OHIO		

FRANKLIN COUNTY
 FRA-270-15.19S & FRA-270-18.15 S
 (I-270-4(7)ROW & PREL.ENG.ONLY)

SECTION 4 T11 N, R21 W
SECTION 28 T12 N, R21 W

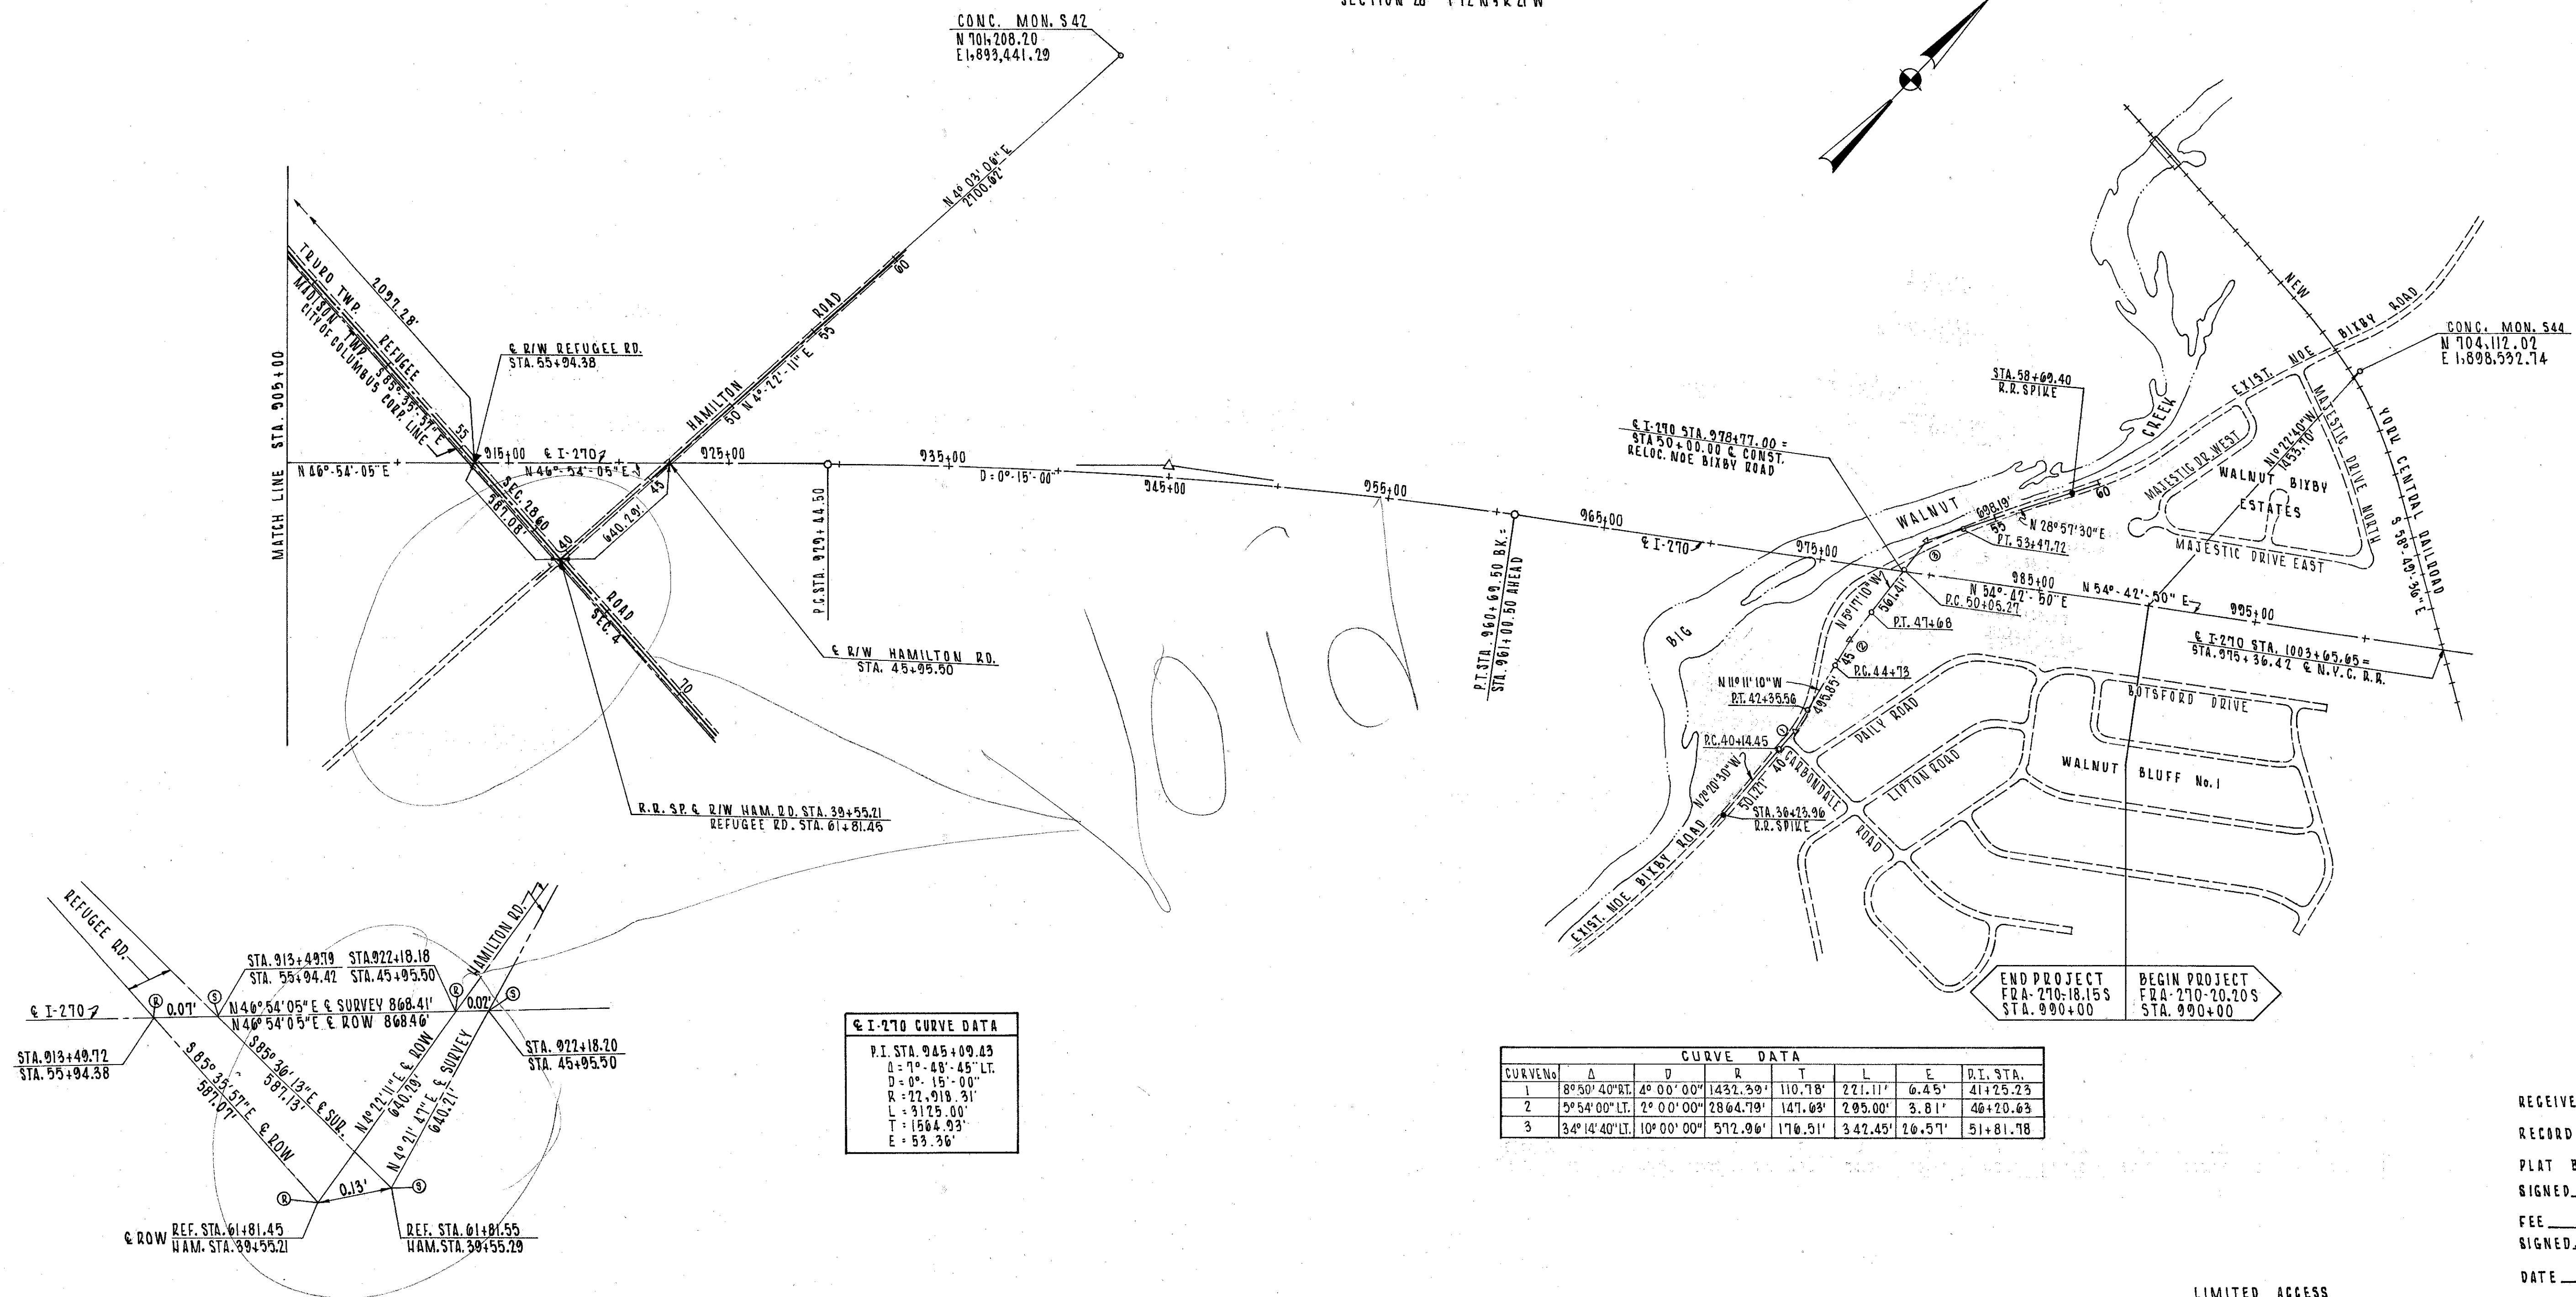

EXAGGERATED DETAIL OF E SURVEY & E RIGHT-OF-WAY
AT HAMILTON ROAD & REFUGEE ROAD

CURVE DATA							
CURVENo	Δ	D	R	T	L	E	D.I. STA.
1	89°50'40"RT.	40°00'00"	1432.39'	110.78'	221.11'	6.45'	41+25.2
2	5°54'00"LT.	2°00'00"	2864.79'	147.03'	295.00'	3.81'	46+20.6
3	34°14'40"LT.	10°00'00"	572.96'	170.51'	342.45'	20.57'	51+81.78

LIMITED ACCESS

THIS IMPROVEMENT HAS BEEN DECLARED A
LIMITED ACCESS HIGHWAY FROM STATION _____
TO STATION _____ BY ACTION OF THE DIRECTOR
OF HIGHWAYS AND RECORDED IN VOLUME 44, PAGE 3
OF THE DIRECTOR'S JOURNAL PURSUANT TO LAW

RECEIVED _____ AT _____ M.
RECORDED _____
PLAT BOOK 35 PAGE 58, 59, 60
SIGNED _____
RECORDER- FRANKLIN COUNTY, OHIO
FEE _____
SIGNED Frank B. L. Seaman
DIVISION DEPUTY DIRECTOR
DATE 12-17-68

I HEREBY CERTIFY THAT THIS PLAT IS A TRUE DELINEATION
OF A SURVEY MADE FOR THE OHIO DEPARTMENT OF
HIGHWAYS IN 1961 BY

12/16/65 DATE *DW Schmeys* SIGNATURE

REGISTERED SURVEYOR NO. 771
REGISTERED ENGINEER NO. 133G

CENTERLINE SURVEY PLAT

OHIO DEPARTMENT OF HIGHWAYS

FRA-270-15.19S & FRA-270-18.15S

FRANKLIN COUNTY OHIO
CORPORATION OF OBETZ & MADISON TOWNSHIP

400 0 400
GRAPHIC SCALE IN FEET


SECTION 17 & 18 T11N, R21W

FED. RD. DIVISION	STATE	PROJECT
2	OHIO	

FRANKLIN COUNTY
FRA-270-15.19S & FRA-270-18.15S
(I-270-4(7) ROW & PREL. ENG. ONLY)



REFERENCE MONUMENTS TO BE PLACED ON CENTERLINE AT THE FOLLOWING LOCATIONS DURING CONSTRUCTION.			
REFERENCE MONUMENTS			
I-270			
P.O.C. STA. 725+00.00	P.O.C. STA. 871+00.00		
730+00.00	876+00.00		
P.T. STA. 735+29.20	885+00.00		
P.O.T. STA. 741+00.00	891+00.00		
746+00.00	899+00.00		
752+00.00	907+00.00		
757+00.00	P.T. STA. 902+18.00		
763+00.00	P.O.T. STA. 907+00.00		
769+00.00	912+00.00		
775+00.00	918+00.00		
781+00.00	924+00.00		
787+00.00	P.C. STA. 929+44.50		
793+00.00	P.O.C. STA. 935+00.00		
799+00.00	940+00.00		
805+00.00	945+00.00		
811+00.00	951+00.00		
817+00.00	956+00.00		
823+00.00	P.T. STA. 960+00.50BK.		
829+00.00	= STA. 961+00.50AND		
834+00.00	P.O.T. STA. 965+00.00		
840+00.00	970+00.00		
845+00.00	974+00.00		
851+00.00	980+00.00		
858+00.00	985+00.00		
P.C. STA. 864+31.11	990+00.00		
TOTAL = 48			
REFERENCE MONUMENT ASSEMBLIES			
WILLIAMS ROAD		REFUGEE ROAD	
P.O.T. STA. 41+00.00	P.O.T. STA. 19+00.00		
P.I. STA. 46+83.86	25+00.00		
	30+00.00		
P.O.T. STA. 53+00.00	34+00.00		
59+00.00	39+00.00		
	P.I. STA. 44+19.53		
WATKINS ROAD			
P.C. STA. 5+44.14	P.O.T. STA. 50+00.00		
P.C.C. STA. 18+11.05	56+00.00		
P.O.C. STA. 23+00.00	01+81.45		
P.C.C. STA. 28+18.74	05+00.00		
P.T. STA. 30+85.65	70+00.00		
COLLEGE AVENUE		NOE-BIXBY ROAD	
P.O.T. STA. 42+00.00	P.C. STA. 40+14.45		
47+00.00	P.T. STA. 42+35.56		
53+00.00	P.C. STA. 44+73.00		
58+00.00	P.T. STA. 47+68.00		
HAMILTON ROAD			
P.O.T. STA. 31+00.00	P.C. STA. 50+05.27		
35+00.00	P.T. STA. 53+47.72		
44+00.00	P.O.T. STA. 58+00.00		
50+00.00			
TOTAL = 35			

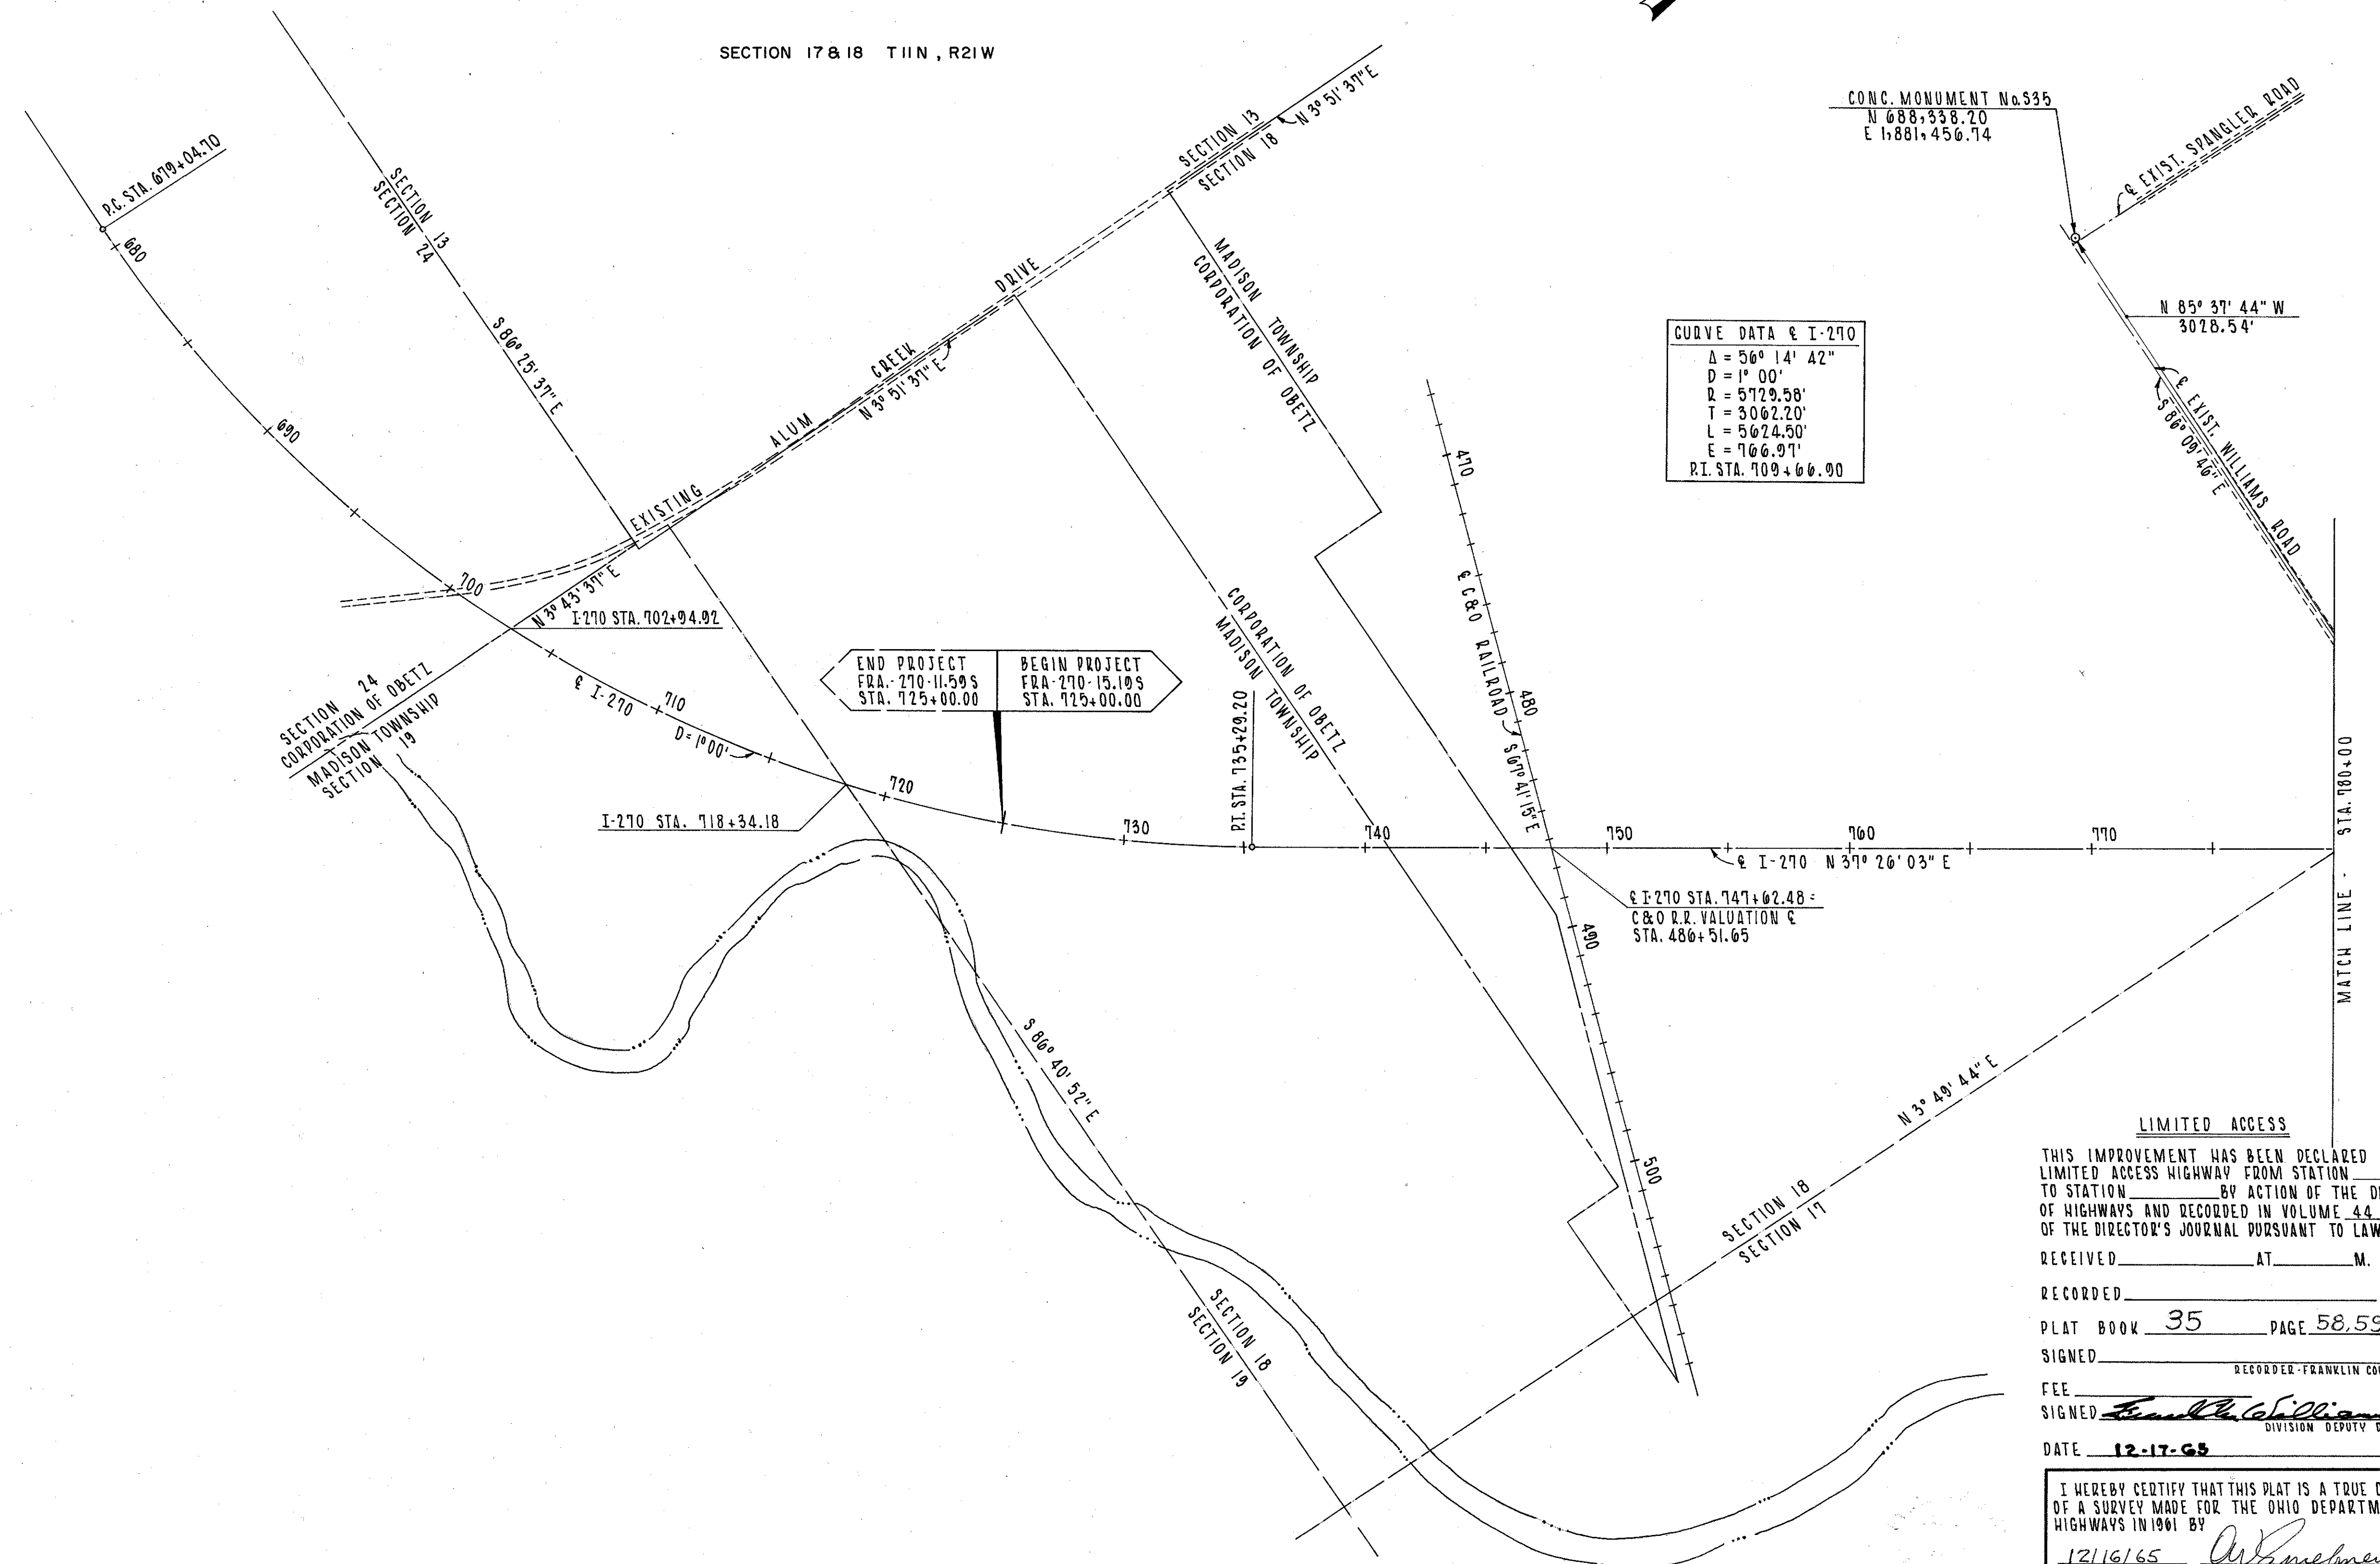

CURVE DATA I-270	
Δ = 56° 14' 42"	
D = 1° 00'	
R = 5729.58'	
T = 3062.20'	
L = 5624.50'	
E = 766.97'	
P.I. STA. 709+66.90	

LIMITED ACCESS
THIS IMPROVEMENT HAS BEEN DECLARED A LIMITED ACCESS HIGHWAY FROM STATION TO STATION BY ACTION OF THE DIRECTOR OF HIGHWAYS AND RECORDED IN VOLUME 44, PAGE 3 OF THE DIRECTOR'S JOURNAL PURSUANT TO LAW.

RECEIVED _____ AT _____ M.
RECORDED _____
PLAT BOOK 35 PAGE 58, 59, 60
SIGNED _____
FEE _____
SIGNED Frank R. G. O'Connell
DIVISION DEPUTY DIRECTOR
DATE 12-17-65

I HEREBY CERTIFY THAT THIS PLAT IS A TRUE DELINEATION OF A SURVEY MADE FOR THE OHIO DEPARTMENT OF HIGHWAYS IN 1961 BY
DATE 12/16/65 SIGNATURE Frank R. G. O'Connell
REGISTERED SURVEYOR NO. 771
REGISTERED ENGINEER NO. 1336

CENTERLINE SURVEY PLAT

CENTERLINE SURVEY PLAT

OHIO DEPARTMENT OF HIGHWAYS

FRA-270-15.19S & FRA-270-18.15S

FRANKLIN COUNTY OHIO
MADISON AND TRURO TOWNSHIPS
CITY OF COLUMBUS

FED. RD. DIVISION	STATE	PROJECT
2	OHIO	


FRANKLIN COUNTY
FRA-270-15.19S & FRA-270-18.15S
(1-270-4(7)ROW & PREL. ENG. ONLY)

WATKINS ROAD & CURVE DATA		RELOC. U.S. 33
SPIRAL DATA		RELOC. DATA
$\Delta = 112^\circ 36' 54''$ RT. X: 396.89'	PI STA. 24+18.59	$\Delta = 35^\circ 55' 15''$ LT.
$\theta_s = 16^\circ 00' 00''$ Y: 37.03'	$\Delta = 80^\circ 30' 54''$ RT.	R: 3900.53'
Ls: 400.00' L.T.: 267.716'	Dc: 80'-00'-00"	L: 2426.42'
P: 9.18' S.T.: 134.33'	R: 716.10'	T: 1253.79'
K: 199.48' L.C.: 398.67'	T: 607.54'	E: 196.27'
Ts: 1287.60' Es: 591.59'	L: 1007.69'	D: 10' 28' 00"
	E: 122.98'	PL STA. 294+01.70
		STA. 294+82.86 BK.


FRA-270 CURVE DATA	
$\Delta = 9^\circ 28' 02''$ LT.	
D: 0' 15' 00"	
R: 22518.31'	
L: 3786.89'	
T: 1897.76'	
E: 78.44'	
PI STA. 863+28.87	

GRAPHIC SCALE IN FEET

SECTION 4, 5, 7, 8, 9, 17 & 18 T11N, R 21W
SECTION 28 & 29 T12N, R 21W

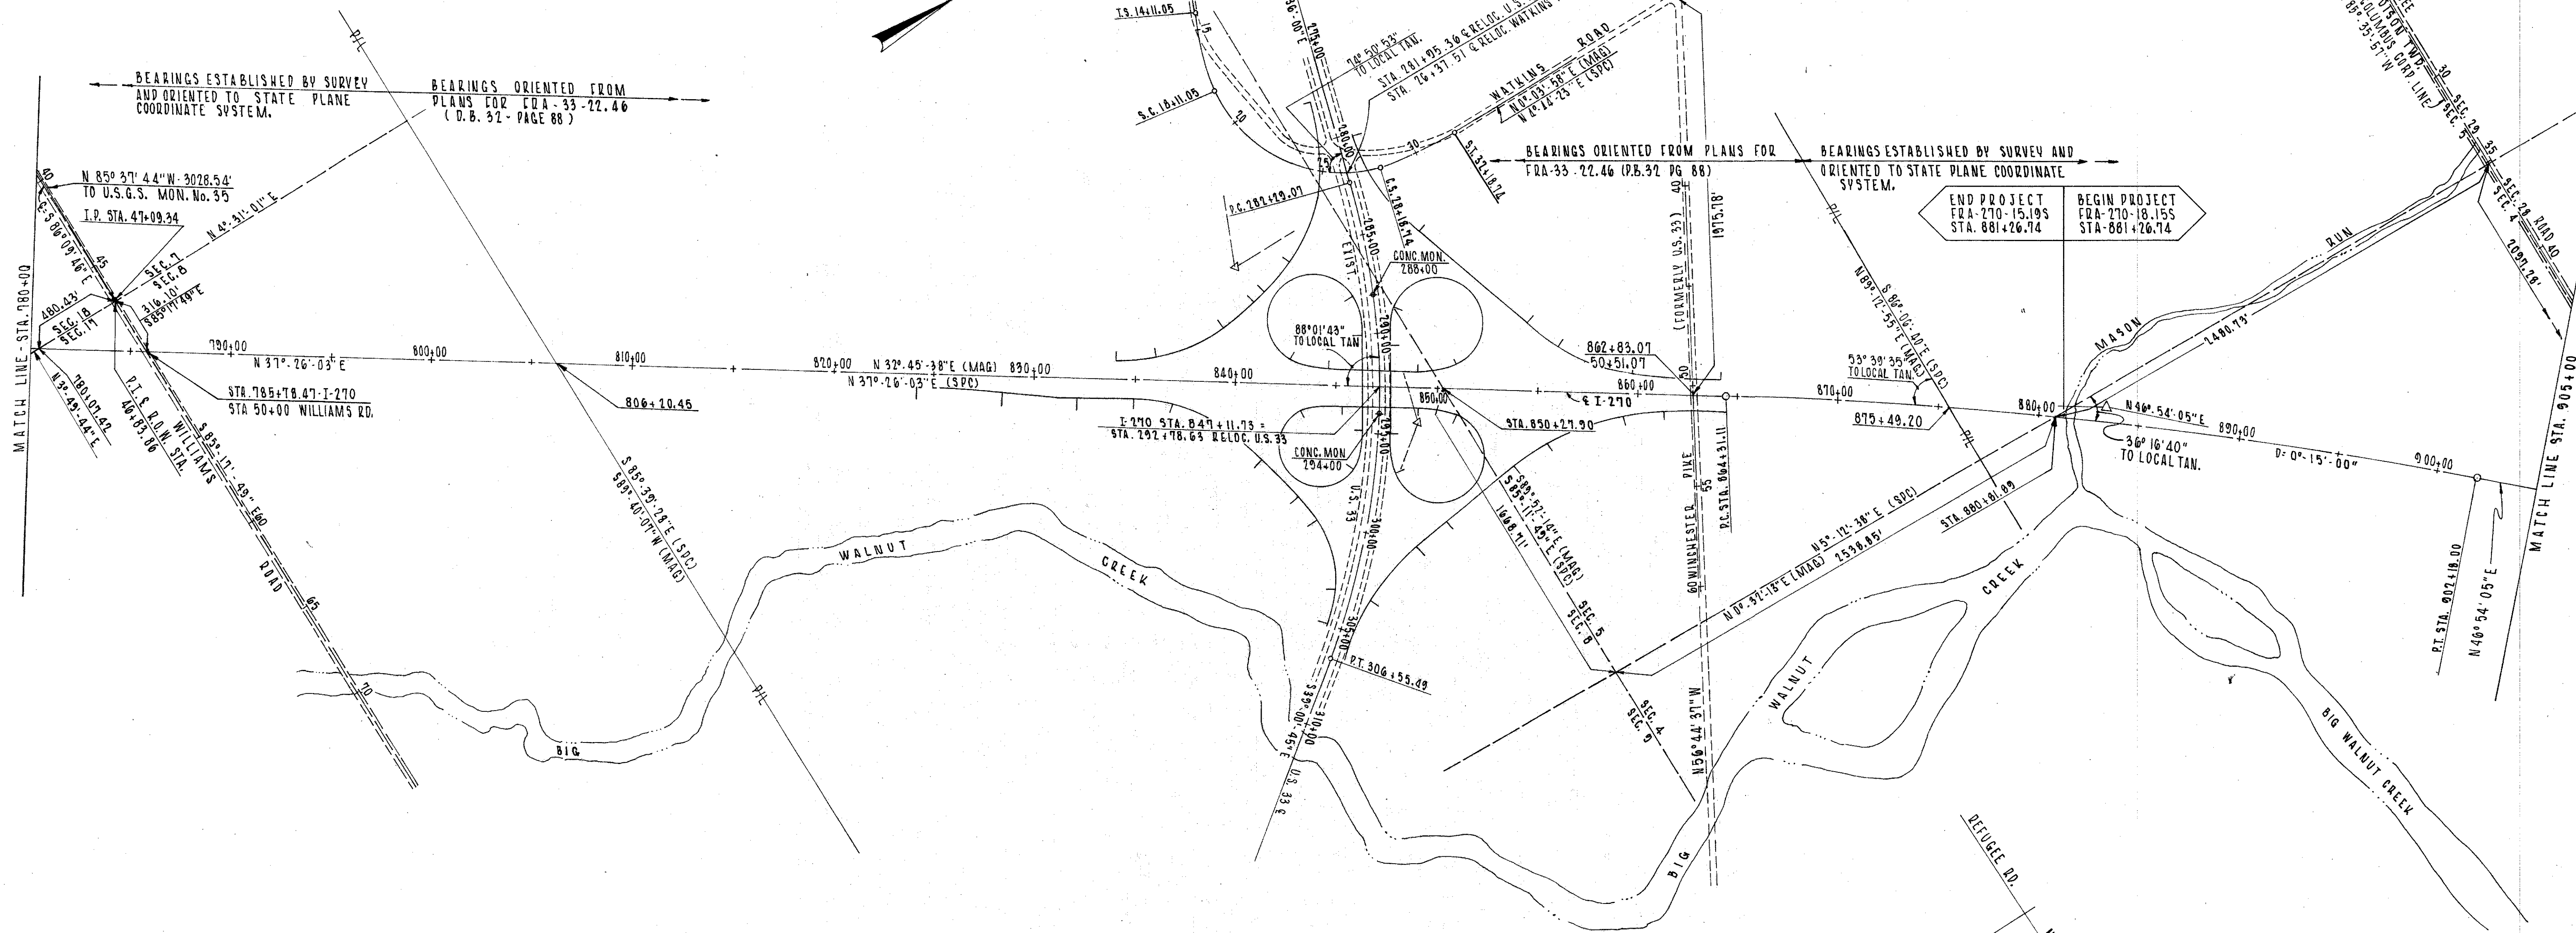

- SYMBOLS**
- MONUMENT ASSEMBLY
 - REFERENCE MONUMENT

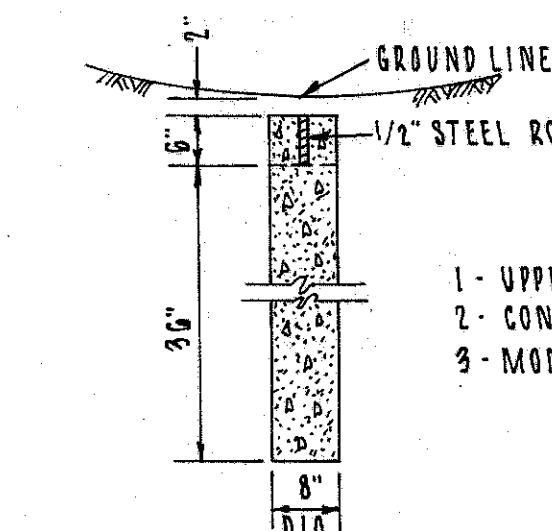

- NOTES**
- UPPER 6" TO BE FORMED
 - CONCRETE TO BE CLASS "C"
 - MONUMENTS TO BE SET BY CONTRACTOR

SECTION LINE DETAIL

LIMITED ACCESS

THIS IMPROVEMENT HAS BEEN DECLARED A LIMITED ACCESS HIGHWAY FROM STATION TO STATION BY ACTION OF THE DIRECTOR OF HIGHWAYS AND RECORDED IN VOLUME 44, PAGE 3 OF THE DIRECTOR'S JOURNAL PURSUANT TO LAW

RECEIVED _____ AT _____ M.
RECORDED _____
PLAT BOOK _____ PAGE _____
SIGNED _____
FEE _____
SIGNED _____
DATE _____

I HEREBY CERTIFY THAT THIS PLAT IS A TRUE DELINEATION OF A SURVEY MADE FOR THE OHIO DEPARTMENT OF HIGHWAYS IN 1961 BY
DATE _____ SIGNATURE _____
REGISTERED SURVEYOR NO. _____
REGISTERED ENGINEER NO. _____

CENTERLINE SURVEY PLAT

CENTERLINE SURVEY PLAT

OHIO DEPARTMENT OF HIGHWAYS

FRA-270-15.19S & FRA-270-18.15S

FRANKLIN COUNTY OHIO
MADISON AND TRURO TOWNSHIPS
CITY OF COLUMBUS


400 0 400
GRAPHIC SCALE IN FEET

SECTION 4 T11N,R21W
SECTION 28 T12N,R21W

FED. RD. DIVISION	STATE	PROJECT
2	OHIO	

FRANKLIN COUNTY
FRA-270-15.19S & FRA-270-18.15S
(I-270-4(7) ROW & PREL. ENG. ONLY)

134
15
2
19

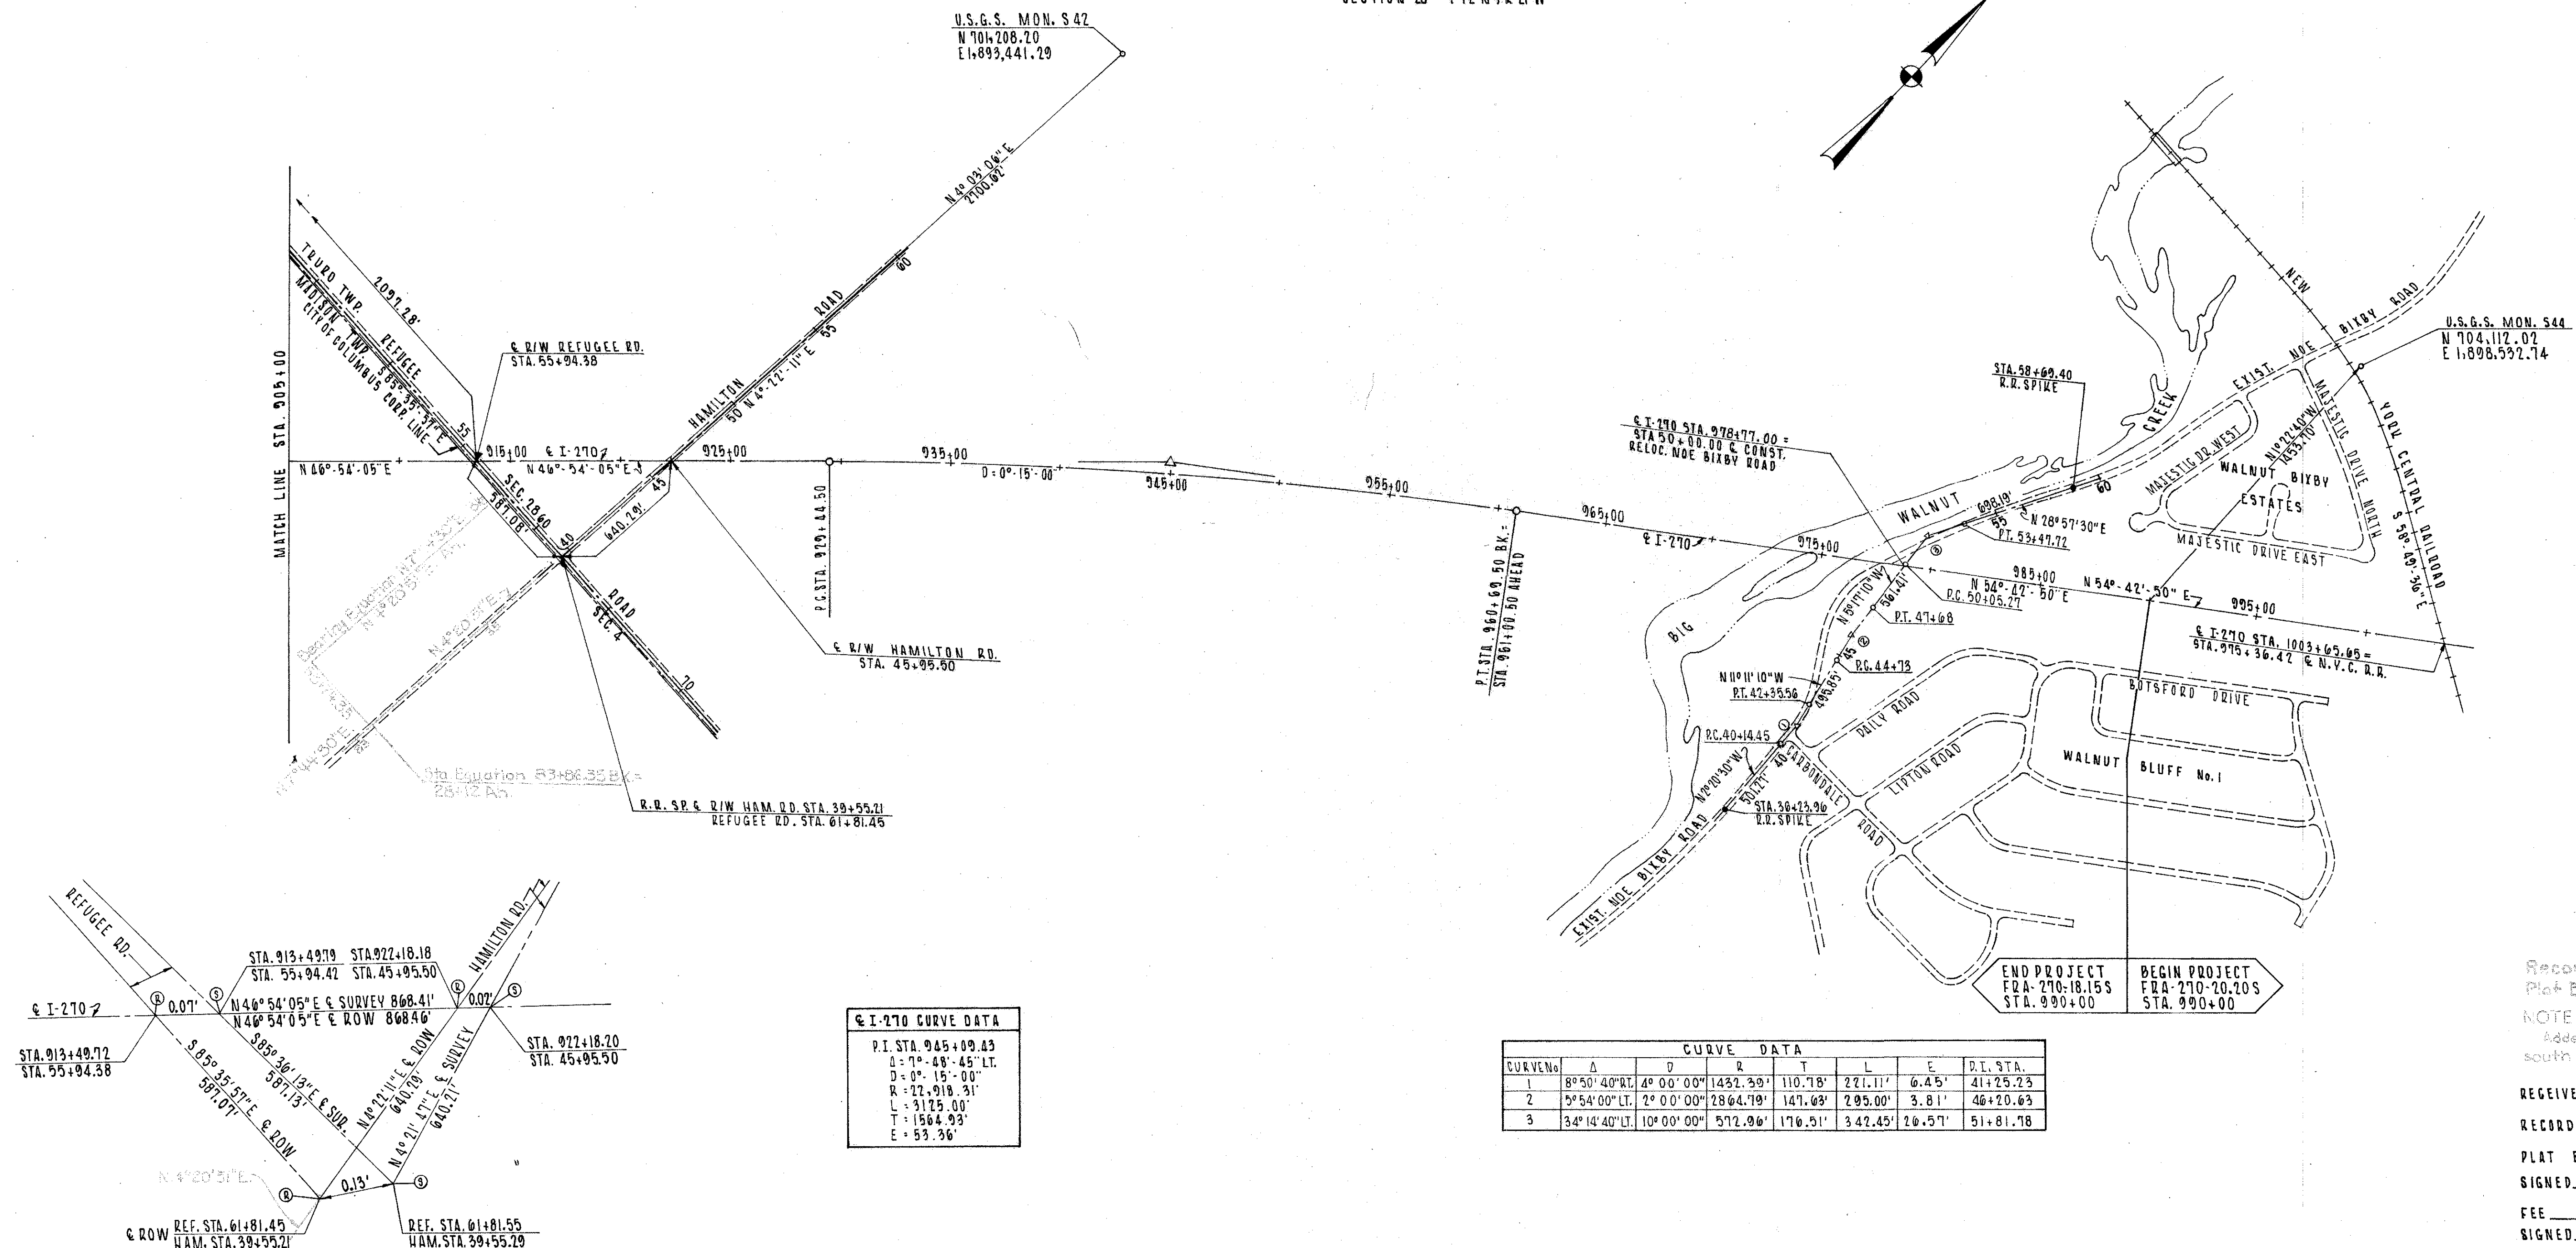

Recorded _____
Plat Book _____ Page _____

NOTE:
Added alignment for Hamilton Road south of Refugee Road 12-8-84

RECEIVED _____ AT _____ M.

RECORDED _____

PLAT BOOK 33 PAGE 59

SIGNED _____

FEE _____

SIGNED _____

DATE _____

LIMITED ACCESS
THIS IMPROVEMENT HAS BEEN DECLARED A LIMITED ACCESS HIGHWAY FROM STATION _____ TO STATION _____ BY ACTION OF THE DIRECTOR OF HIGHWAYS AND RECORDED IN VOLUME 44, PAGE 3 OF THE DIRECTOR'S JOURNAL PURSUANT TO LAW


I HEREBY CERTIFY THAT THIS PLAT IS A TRUE DELINEATION OF A SURVEY MADE FOR THE OHIO DEPARTMENT OF HIGHWAYS IN 1961 BY

DATE

SIGNATURE
REGISTERED SURVEYOR NO.
REGISTERED ENGINEER NO.

CENTERLINE SURVEY PLAT

PROPERTY MAP

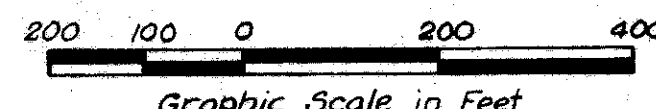

LIMITED ACCESS

FED. RD. DIVISION	STATE	PROJECT
2	OHIO	

FRANKLIN COUNTY
FRA-270-15.195 & 18.15 S
(I-270-4(7) ROW & PREL. ENG. ONLY)

235
251
3
19

UTILITY COMPANIES

COLUMBUS & SOUTHERN OHIO ELECTRIC CO.
215 N. FRONT STREET
COLUMBUS, OHIO

OHIO BELL TELEPHONE CO.
111 N. FOURTH STREET
COLUMBUS, OHIO

COLUMBIA GAS OF OHIO INC.
109 N. FRONT STREET
COLUMBUS, OHIO


CITY OF COLUMBUS, DIVISION OF WATER
90 W. BROAD STREET
COLUMBUS, OHIO

CITY OF COLUMBUS, DIVISION OF SEWERS
90 W. BROAD STREET
COLUMBUS, OHIO

MADISON TOWNSHIP
T11N R21W
SECTION 5

MADISON TOWNSHIP
T11N R21W
SECTION 4

Property Map- Sta. 855+00 to Sta. 913+49.79

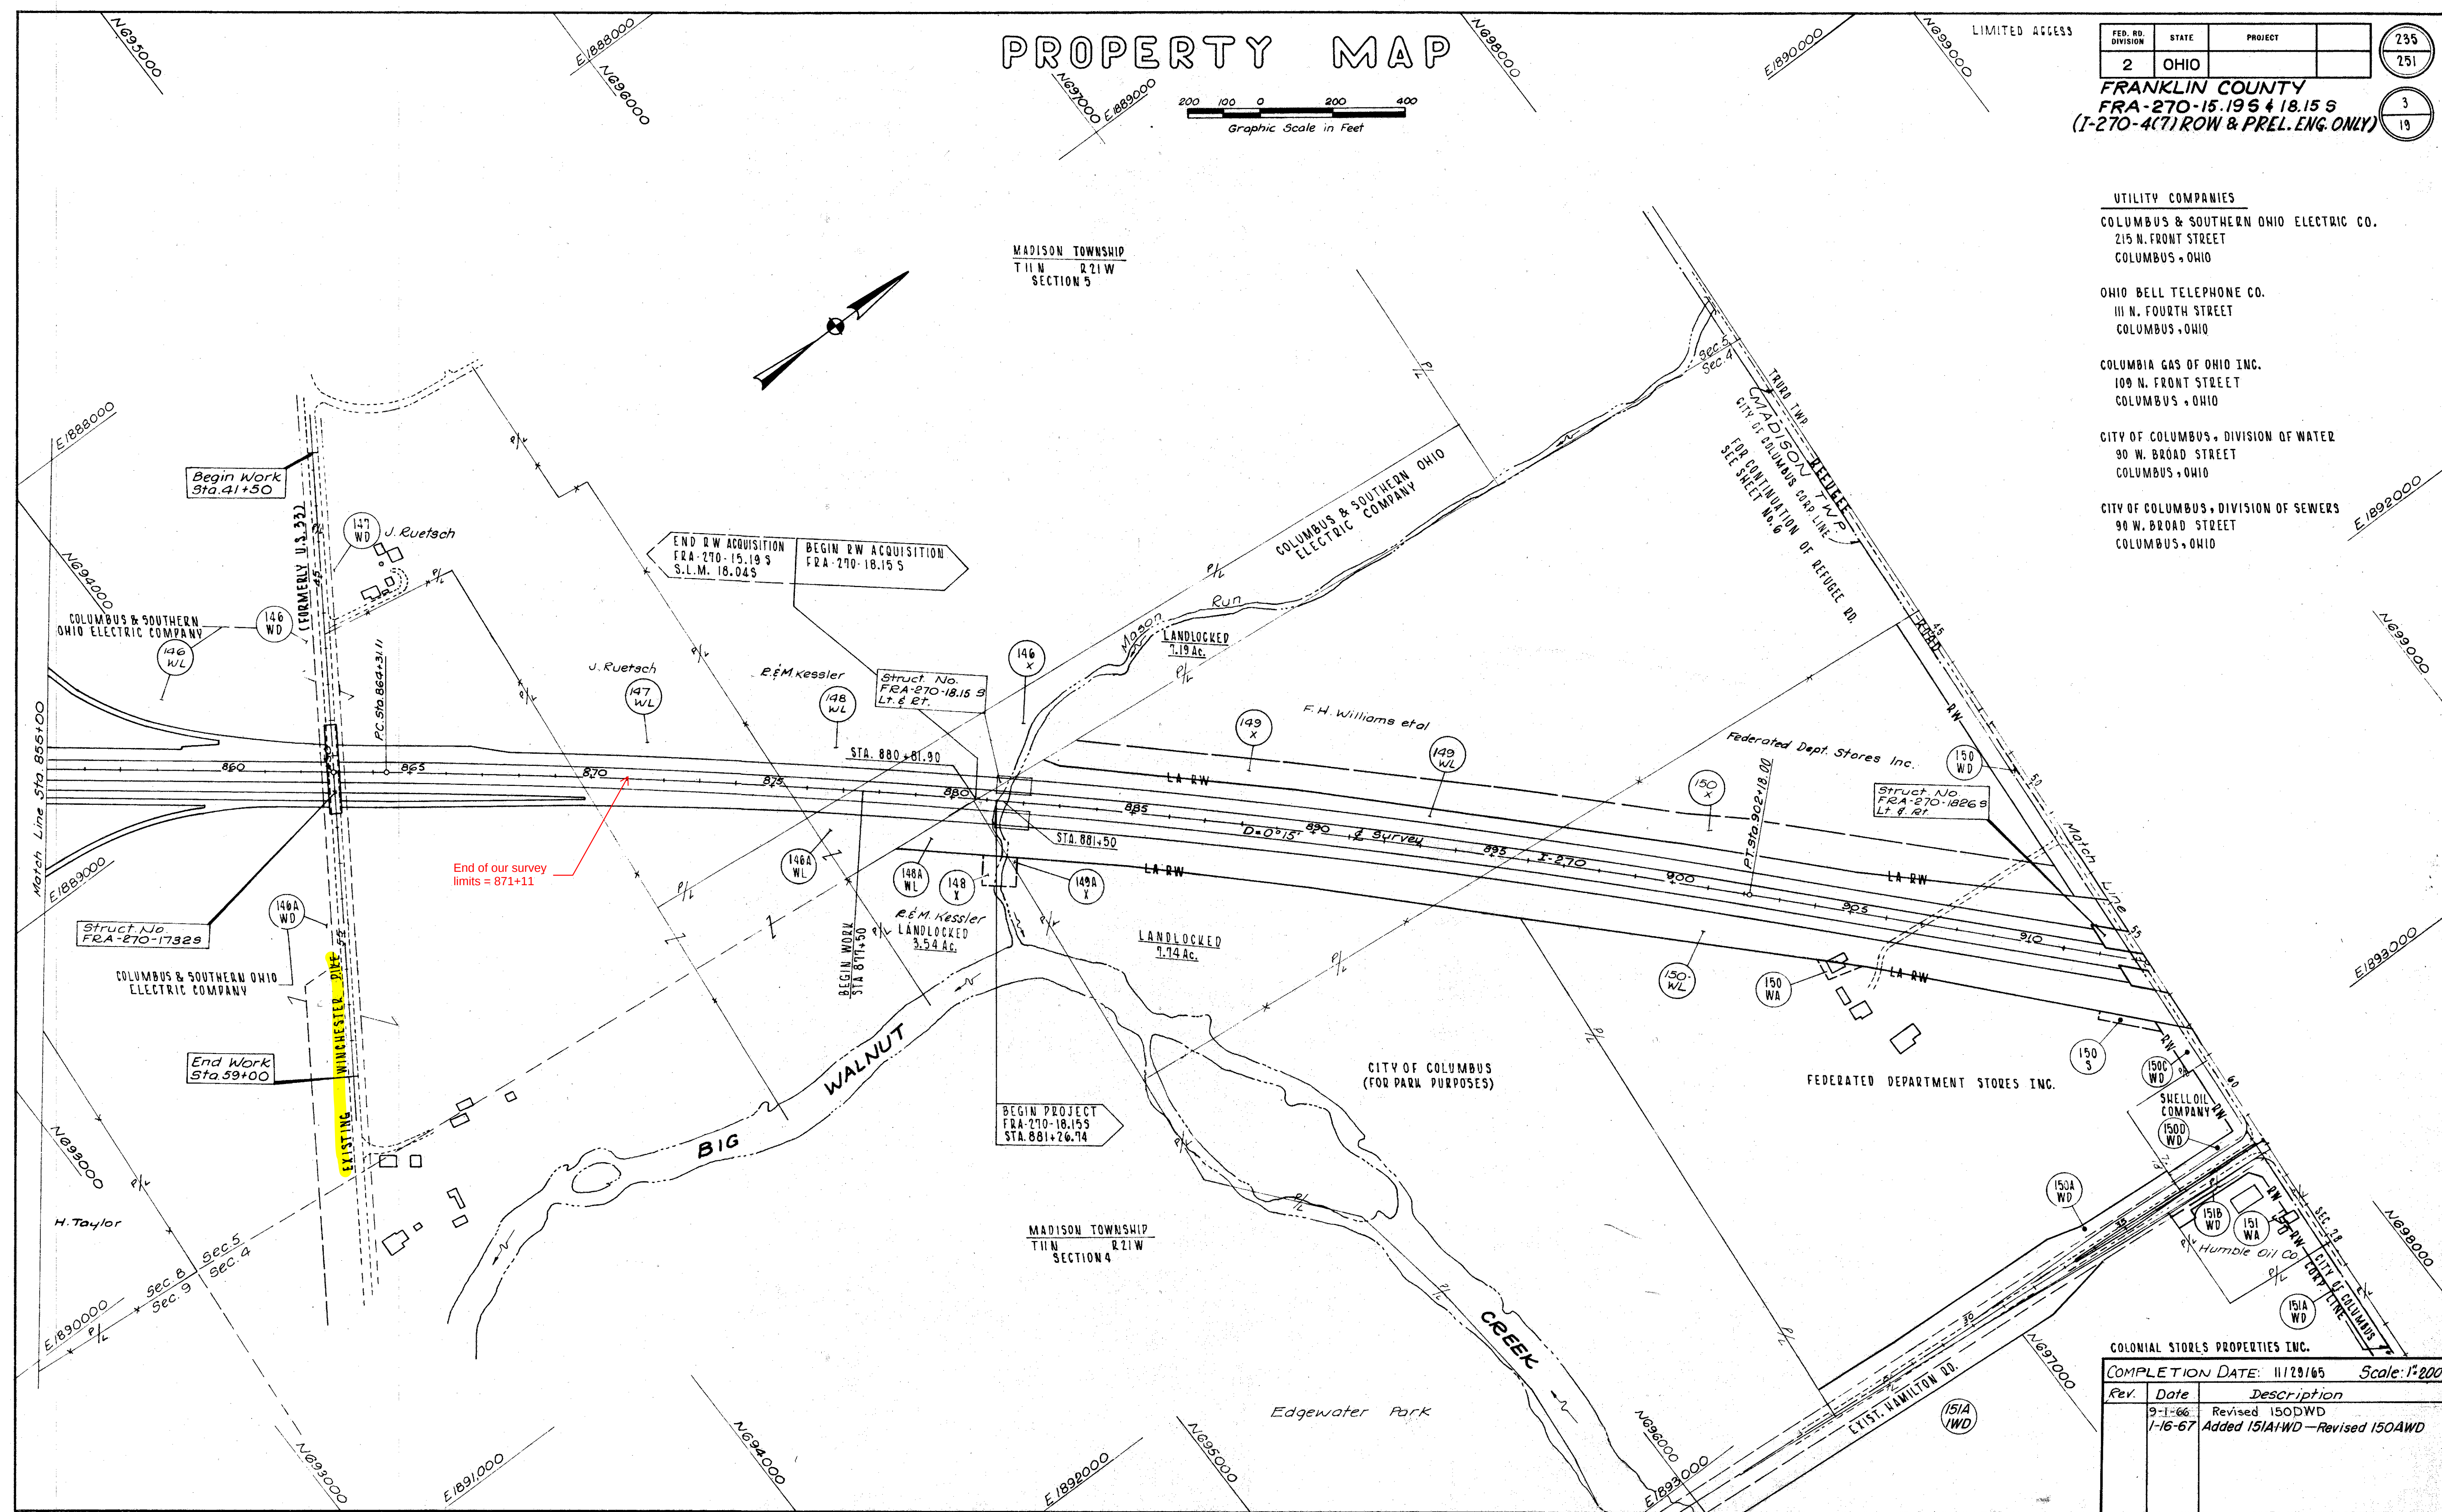

COLONIAL STORES PROPERTIES INC.		
COMPLETION DATE: 11/29/65 Scale: 1"=200'		
Rev.	Date	Description
9-1-66		Revised 150DWD
1-16-67		Added 151A+WD-Revised 150A+WD

PROPERTY MAP

200 100 0 200 400
Graphic Scale in Feet

LIMITED ACCESS

FED. NO. DIVISION	STATE	PROJECT
2	OHIO	

FRANKLIN COUNTY
FRA-270-18.15 S
(1-270-417) ROW & PREL.
ENG. ONLY

236
251

4
19

CITY OF COLUMBUS
TRURO TOWNSHIP
T12N R21W
SECTION 28

Sears - Roebuck Co.

Federated Department
Stores Inc.

Columbus East Joint Venture, a Partnership

Struct. No.
FRA-270-18263
Lt. & Rt.

Struct. No.
FRA-270-18423
Lt. & Rt.

Cape Rainier Development Corp.

LANDLOCKED
5.38 ACRES

Note Berlin
LA-RW

LANDLOCKED
3.90 ACRES

LANDLOCKED
1.58 AC.
H. Gerhart

CATALPA RECREATION PARK INC.

LANDLOCKED
1.12 AC.

M. & L. Wetzel
LANDLOCKED
20.42 AC.

T. Peters et al

NATE BERLIN

Grace Lutheran Evangelical Church

CITY OF COLUMBUS
TRURO TOWNSHIP
T12N R21W
SECTION 28

Rev.	Date	Description
	3-7-68	Wrong & Parcel Change 153A-1WL to 150A-WL
	3-27-68	New Owner 152D-WD, 152D-WD 1

BIG WALNUT CREEK

Property Map - Sta. 913+49.79 to Sta. 970+00

PROPERTY MAP

200 100 0 200 400
Graphic Scale in Feet

FED. RD. DIVISION	STATE	PROJECT
2	OHIO	

FRANKLIN COUNTY
FRA-270-18.153
(I-270-4(1) ROW & PREL.
ENG. ONLY)

231
251

5
19

CITY OF COLUMBUS
TRURO TOWNSHIP
T12 N R21 W
SECTION 28

C. & P. Evans

END R/W ACQUISITION
FRA-270-18.15 S
S.L.M. 20.46 S

BEGIN R/W ACQUISITION
FRA-270-20.20 S
STA. 1003+32.78

END WORK
STA. 991+50

Struct. No.
FRA-270-1946 S
Lt. & Et.

STATE OF OHIO
(Majestic Inc.)

WALNUT BLUFF NO 1
PLAT BOOK 34 PAGE 42 & 43

WALNUT BLUFF NO 2
PLAT BOOK 34 PAGE 42 & 43

CITY OF COLUMBUS
TRURO TOWNSHIP
T12 N R21 W
SECTION 28

COMPLETION DATE 11/29/05 Scale: 1"=200'		
Rev.	Date	Description

Property Map Sta 970+00 to Sta. 1020+00

Graphic scale in Feet

Truro Twp.
T12N R21W
Section 28
City of Columbus

Francis H. Williams
Etc

Ernest G. Fritzsche

SCIT INC

~~Cape Rainier
Development Corp.~~

Sears, Roebuck Company

Begin Work
Sta. 18+90

Frances H. Williams

Truro Twp.

Madison Twp.

J. J. Carberry

Begin R/W Acquisition

Standard
Oil
Company

J. C. Margulis

F. H. Williams Etal.

Madison Twp.
T11N R21W
Section 4 & 5

For Continuation of Project
See Sheet No's 3&4

City of Columbus
Corporation Line

4.

BIG WALNUT CREEK

PROPERTY MAP REFUGEE ROAD

COMPLETION DATE 11/29/65 SCALE: 1"=200'		
Rev.	Date	Description
	1-7-66	Added Parcel 149 E-WD
	3-6-68	New owners & parcels

SUMMARY OF ADDITIONAL RIGHT OF WAY REQUIRED

TOTAL NUMBER OF OWNERS 29

FED. RD. DIVISION	STATE	PROJECT
2	OHIO	

FRANKLIN COUNTY
FRA - 270 - 18.15 S
(1-270- 4(7) ROW & PREL. ENG. ONLY)

239
251
7
18

ENGRS PARCEL NO.	AUDITORS PARCEL NO.	OWNER	DEED RECORD		DEED AREA	TO BE ACQUIRED			NET RESIDUE		SHEET NO.	R. W. FUNDS	REMARKS
			BOOK	PAGE		LAND (NET)	PRESENT ROAD OCCUPIED	BLDGS	LEFT	RIGHT			
149 WL 149 X 149 X-1 149 WD 149B-WD 149 T 149 T-1 149 Y	116 118468	Frances Helsel Williams et al	2498	176	53.08	9.12 2.34 0.02 0.954 0.55 .204 .174 0.229	- - - 0.635 0.41 - -	- - - - - - -	33.67 - - - - - -	7.74 - - - - - -	8,10 8,10 8 9 9 9 9 8	I I I U.S. U.S. U.S. U.S. I	
149C-WD 149C-T	358	Julius C. Margulies	2308	113	17.037	0.888 .238	0.595 -	- -	- -	15.56 -	9 9	U.S. U.S.	
149D-WD	97	J.J. Carberry (Bishop)	2663	534	21.62	0.538	0.43	-	-	20.65	9	U.S.	
149E-WD	54701	Station Development Corp.	2583	208	1.428	0.273	0.197	-	0.958	-	9	U.S.	
150 WL 150 WD 150A-WD 150C-WD 150 X 150 S 150 WA-2 150A-WL	39	Federated Department Stores Inc.	2450	490	92.907	11.49 0.95 0.86 0.15 3.39 0.08 - -	0.14 0.66 2.19 0.07 - - - -	Yes - - - - - - -	11.43 - - - - - - -	62.34 - - - - - - -	10,11 9,10,11 13,14 11 10,11 11 10,11 15	I I & U.S. I I I I I I	1.940 Ac. Conveyed to 150D-WD P.R.O. T.B.A. "I" Funds 0.30Ac. 0.42Ac. "U.S." Funds 0.36Ac. 0.53Ac. "U.S." Funds 1.77Ac. 0.69Ac. "State" Funds 0.42Ac. 0.17Ac.
150D-WD	3551	Shell Oil Co.	2551	244	1.940	0.31	0.41	-	-	1.26	11,13,14	I & U.S.	"I" Funds P.R.O. T.B.A. 0.13Ac. 0.13Ac. "U.S." Funds 0.28Ac. 0.18Ac.
151A-WD 151A-TWD		Colonial Stores Properties Inc.	2549	380	39.566	0.42 1.54	0.37 1.66	- -	- -	35.58 -	13	U.S.	"U.S." Funds P.R.O. T.B.A. 0.72Ac. 0.52Ac. "State" Funds 0.94Ac. 1.02Ac.
151B-WD 151 WA		Humble Oil Co.	2295	626	2.303	0.36 -	0.26 -	Yes -	- -	1.68 -	13,14 13	U.S. U.S.	
152A-WD 152A-TWD	89632 3548	Standard Oil Co.	2262 2554	269 615	0.918 0.963	0.19 0.216	0.26 0.20	- -	0.47 -	- 0.54	11,13,14 9	I & U.S. U.S.	"I" Funds T.B.A. P.R.O. 0.13Ac. 0.17Ac. "U.S." Funds 0.06Ac. 0.09Ac.
152C-WL 152C-TWD 152C-2WD 152C-T	137333 137334 137335	Federated Department Stores Inc. & Sears, Roebuck & Co.	2485	484	47.672	5.45 0.13 0.15 0.68	0.61 0.11 0.13 -	Yes - - -	38.82 - - -	0.33 - - -	11,12 11,14 11,14 11,12	I I I I	Par.137333= 5.981 Ac. Par.137334= 0.422 Ac. Par.137335= 0.502 Ac.
152E-WD	137336	Sears, Roebuck & Co.	2485	481	16.772	0.34	0.27	-	16.16	-	9,10	U.S.	
153 WD	110554	Edith Beglin	APR. BK. 14	172	1.45	0.271	0.324	-	0.855	-	11,13,14	I & U.S.	"I" Funds P.R.O. T.B.A. 0.13Ac. 0.109Ac. "U.S." Funds 0.21Ac. 0.162Ac.
153A-WL 153A-WD 153A-T-WD 153A-2-WD 153B-WD 153C-WD 153A-T-1 153A-T-2 153 WA	110480	Cape Rainier Development Corp. SCIT INC.	2450	107	31.549	6.14 0.27 0.16 0.40 0.704 0.922 0.43 0.05 -	0.32 0.21 0.04 0.26 0.469 0.640 - - -	- - - - Yes - - - -	14.66 - - - - - - - -	9.09 12 12 13 9 9 12 12 9	I I I U.S. U.S. U.S. I I I	Part of residue, parcel 153A WL taken for FRA-317-1.32 * Tract of 14.08 Ac. (calc.) ** Tract of 7.423 Ac. (calc.) Remove Building	
150A-T 150WA-1		Federated Department Stores Inc.				0.02 -	- -	- -	- -	- -	15 9	I	
153E-WD		Col. & Southern Ohio Elect. Co.	2729	553 554	2.839	0.206	0.138	-	2.495	-	9	U.S.	TO INSTALL TRAFFIC LIGHT DETECTOR

ENGRS PARCEL NO.	AUDITORS PARCEL NO.	OWNER	DEED RECORD		DEED AREA	TO BE ACQUIRED			NET RESIDUE		SHEET NO.	R. W. FUNDS	REMARKS
			BOOK	PAGE		LAND (NET)	PRESENT ROAD OCCUPIED	BLDGS	LEFT	RIGHT			
154 WL 154 WD	118555	Nate Berlin	2505	577	33.00	6.32 0.07	- 0.16	- -	5.38 -	21.07 -	12,15 13	I U.S.	
156 WL 156 X 156 T	118520	Thelma Peters et al.	2440	524	127.00	9.77 0.23 0.01	- - -	- - -	3.90 - -	113.33 - -	15 15 15	I I I	
157 WL 157 T 157 AT	118452	Miriam H. Wetzel et al.	2244	620	162.238	7.06 2.72 0.16	- - -	- - -	134.76 - -	20.42 - -	15,16 17 18	I I I	Tract No. 3
158 WL 158 T 158 T-1	100955	Helen M. Gerhart	2549	61	5.255	2.56 0.67 0.02	- - -	- - -	1.58 - -	1.12 - -	15,16 16,17 16	I I I	
159 WL 159 T 159 T-1 159 T-2	118514	Catalpa Recreation Park Inc.	1018 2576	335 481	18.975	5.17 0.21 0.14 0.02	- - - -	- - - -	13.67 - - -	0.14 - - -	16,17,18 16,18 16,17 16	I I I I	
159 A-T	118461	Boyd L. & Mary E. Davis	2237	488		0.36	-	-	-	-	16,18	I	
159 B-T	118668	Ralph B. & Ollie Boyd	2206	282		0.10	-	-	-	-	18	I	Catalpa Park Subd. Lot 1
159 C-T	118672 118673	Elizabeth Seidell (Fee) Henry L. & Eileen C. Roche(LC)	2337	698		0.21	-	-	-	-	18	I	Catalpa Park Subd. Lots 2 & 3
159 D-T	5546 5547	Kenneth J. & Jane S. Merrill	1909	354		0.21	-	-	-	-	18	I	Catalpa Park Subd. Lots 4 & 5
159 E-T	5548	Charles & Anna M. Wehe	1437	32		0.10	-	-	-	-	18	I	Catalpa Park Subd. Lot 6
159 F-T	118677	Carl E. & Constance J. Kerner John J & Enabelle Hilsher	2644	104		0.10	-	-	-	-	18	I	Catalpa Park Subd. Lot 7
159 G-T	118678 118679	J.W. Mercer Realty Co.	2191	304		0.21	-	-	-	-	18	I	Catalpa Park Subd. Lots 8 & 9
159 H-T	118680 118682	Emma Purtree	2451	603		0.39	-	-	-	-	18	I	Catalpa Park Subd. Lots 10, 11 & 12
159 J-T	126	H.L. Mayne	1220	285		0.33	-	-	-	-	18	I	
160 WL 160 WD 160A-WD 160D-WD 160E-WD		State of Ohio (Sinking Fund)	2614 2615 2615 2615 2615	700 16 20 24 26	22.989 3.378 1.310 6.854 2.609	22.236 2.097 0.595 6.212 2.450	0.753 1.281 0.715 0.642 0.159	- - - - -	- - - - -	- - - - -	16,17,18,19 16,17 16,18 16,17 16,18	I I I I I	
160 T 160 T-1 160 WA 160A-WA	129680	Majestic Inc.	2326	3.69	292.31	3.867 0.27 - -	- - - -	- - - -	- - - -	- - - -	16,17 18 16 16	I I I I	All Conveyed except 49.507Ac.
161 WA 152D-WD 152D-WD-1 152D-WD-1 152D-S1	132870 137332 137332	Lewis H. & Mary J. Phillips Columbus East Joint Venture, a Partnership	2515 2715	65 487		- 0.72 0.39 0.02	- 0.54 0.23 -	- - - -	- - - -	- - - -	16 10,11 12 11	I I & U.S. I I	Walnut Bluff Subd. No.1 Lot 15 Par. 137332 = 40.271Ac. I-FUNDS P.R.O. T.B.A. 0.33Ac. 0.52Ac. U.S. FUNDS 0.21Ac. 0.20Ac.

Note L.L. indicates residual lands that are landlocked

9-26-68 REV. AREA 152DWD
3-27-68 New Owner 152D-WD, 152D-WD-1 & 152D-S-1
3-6-68 Revision-New Owners & Parcels.
7-5-67 Revision T.B.A. & P.R.O. For 152A-WD
1-16-67 ADDED 151A-WD - REVISED 150AWD
10-12-66 Split funding on parcels 149WD, 150DWD, 152AWD, 152CWD, 153WD
to show P.R.O. & T.B.A.


COMPLETION DATE 11/29/65	
REVISION	DESCRIPTION
1-31-66	Rev. Parcel 153
1-31-66	Added Parcel 149E-WD
3-27-68	Revised take 151B-WD
4-28-68	Changed Owners Parcel 159F-T
6-19-68	Added Parcels 149T-1, 149Y
9-1-66	Revised 150DWD
10-12-66	Added area 149T, 149T-1, 149CT
3-31-72	Rev. Par. 153 WD

FED. RD. DIVISION	STATE	PROJECT	
2	OHIO		

FRANKLIN COUNTY
FRA 270-15.195
(I-270-4(7) ROW & PREL. ENG. ONLY)


240
251

8
19

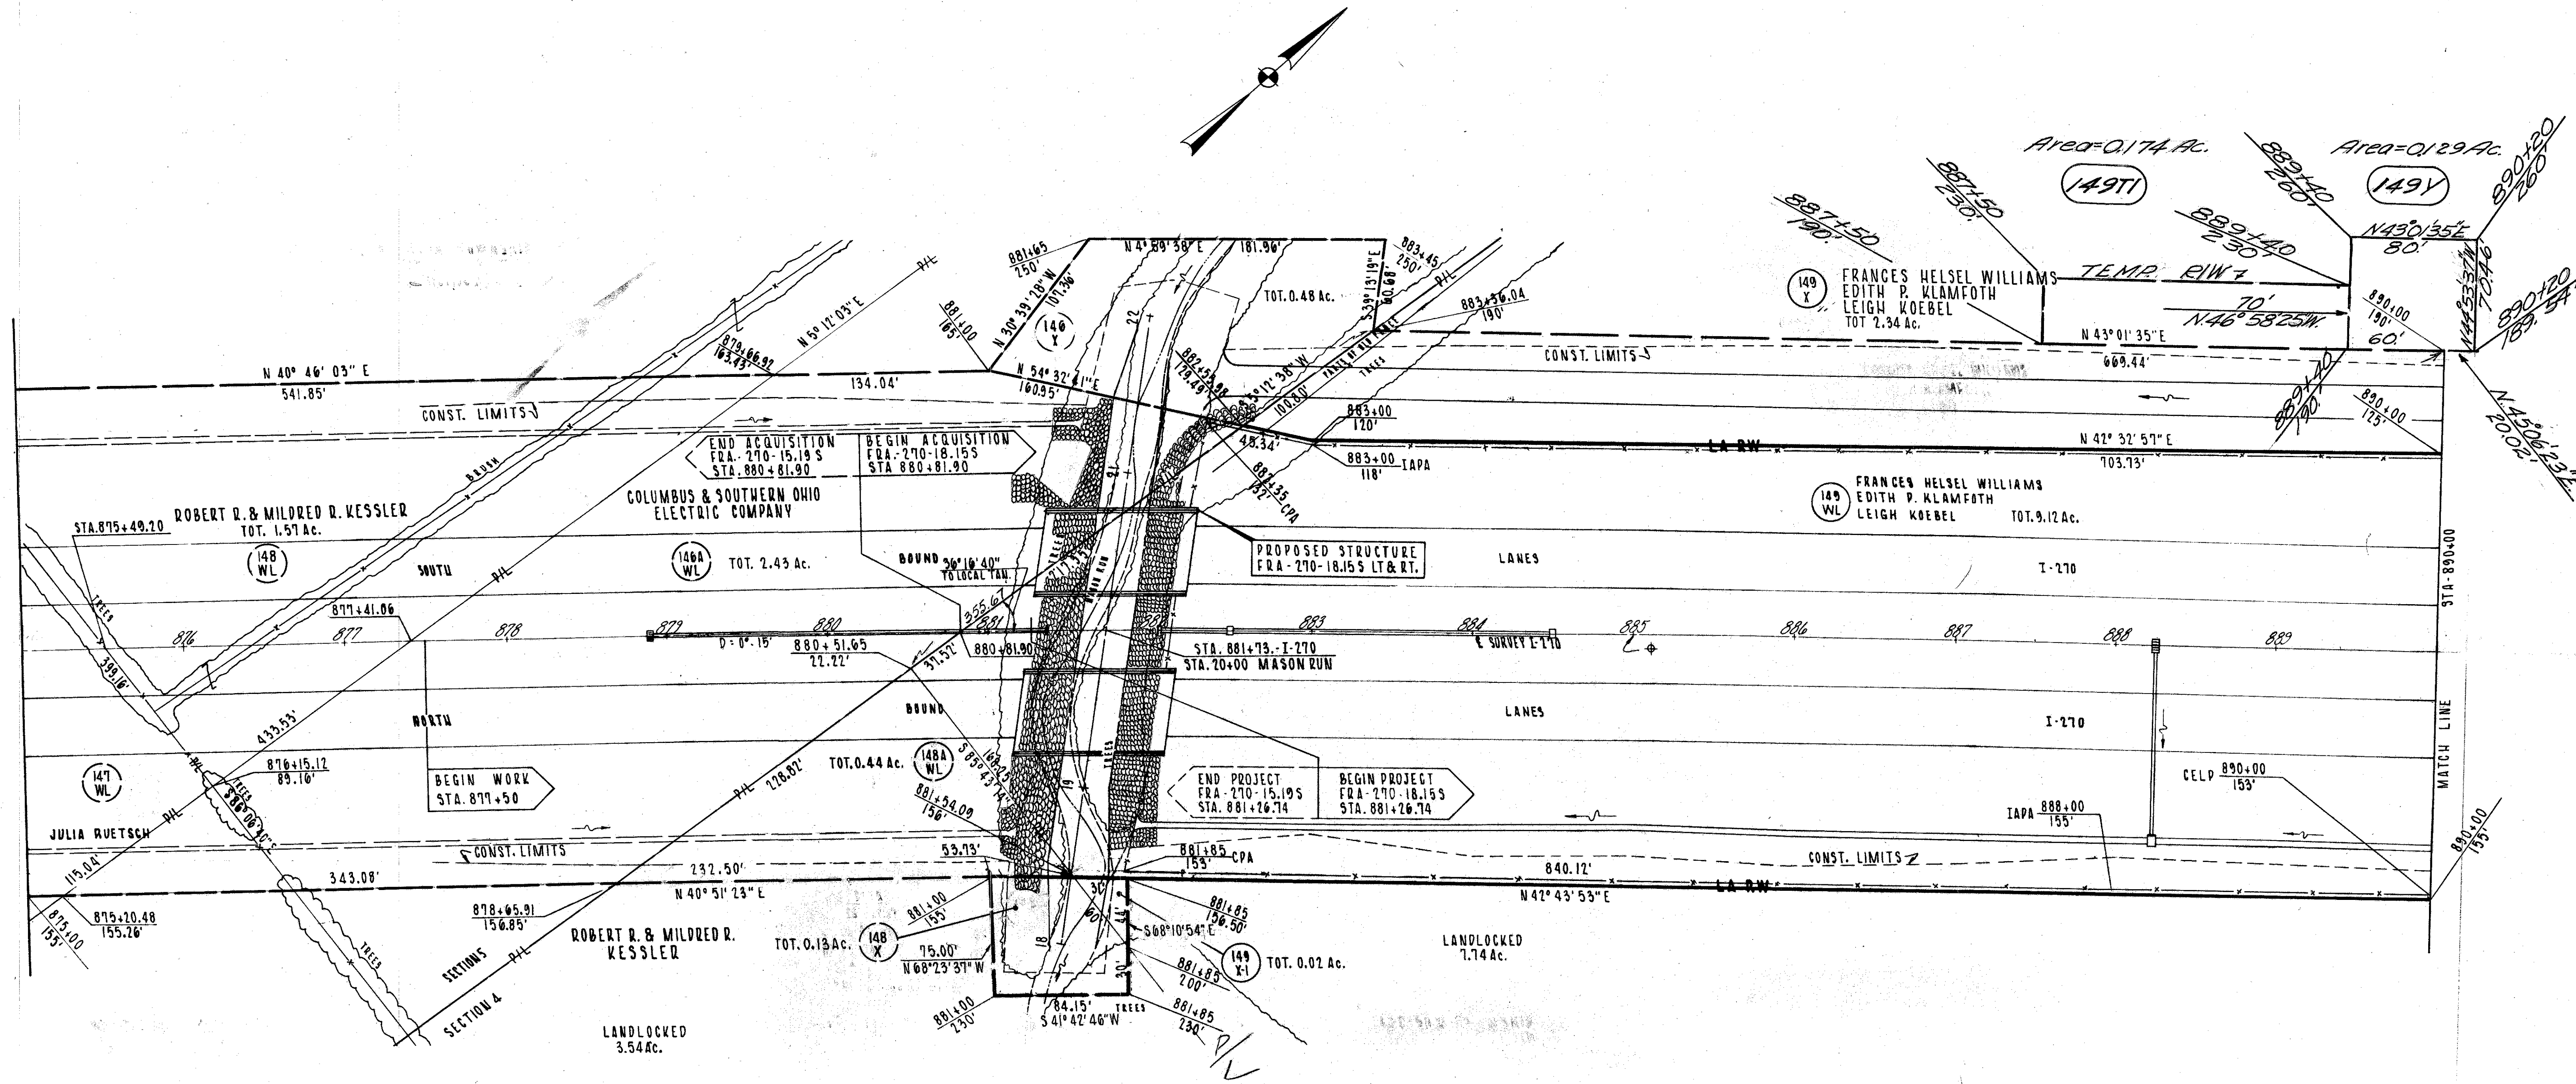

I-270 CURVE DATA
P.I. STA. 883+28.87
Δ = 9° 28' 02" RT.
D = 0° 15' 00"
R = 22,918.31'
L = 3786.89'
T = 1897.16'
E = 78.44'

COMPLETION DATE: 11/29/05		SCALE: 1"=50'
REV.	DATE	DESCRIPTION
1	11/29/05	Added Parcels 149T1 & 149Y

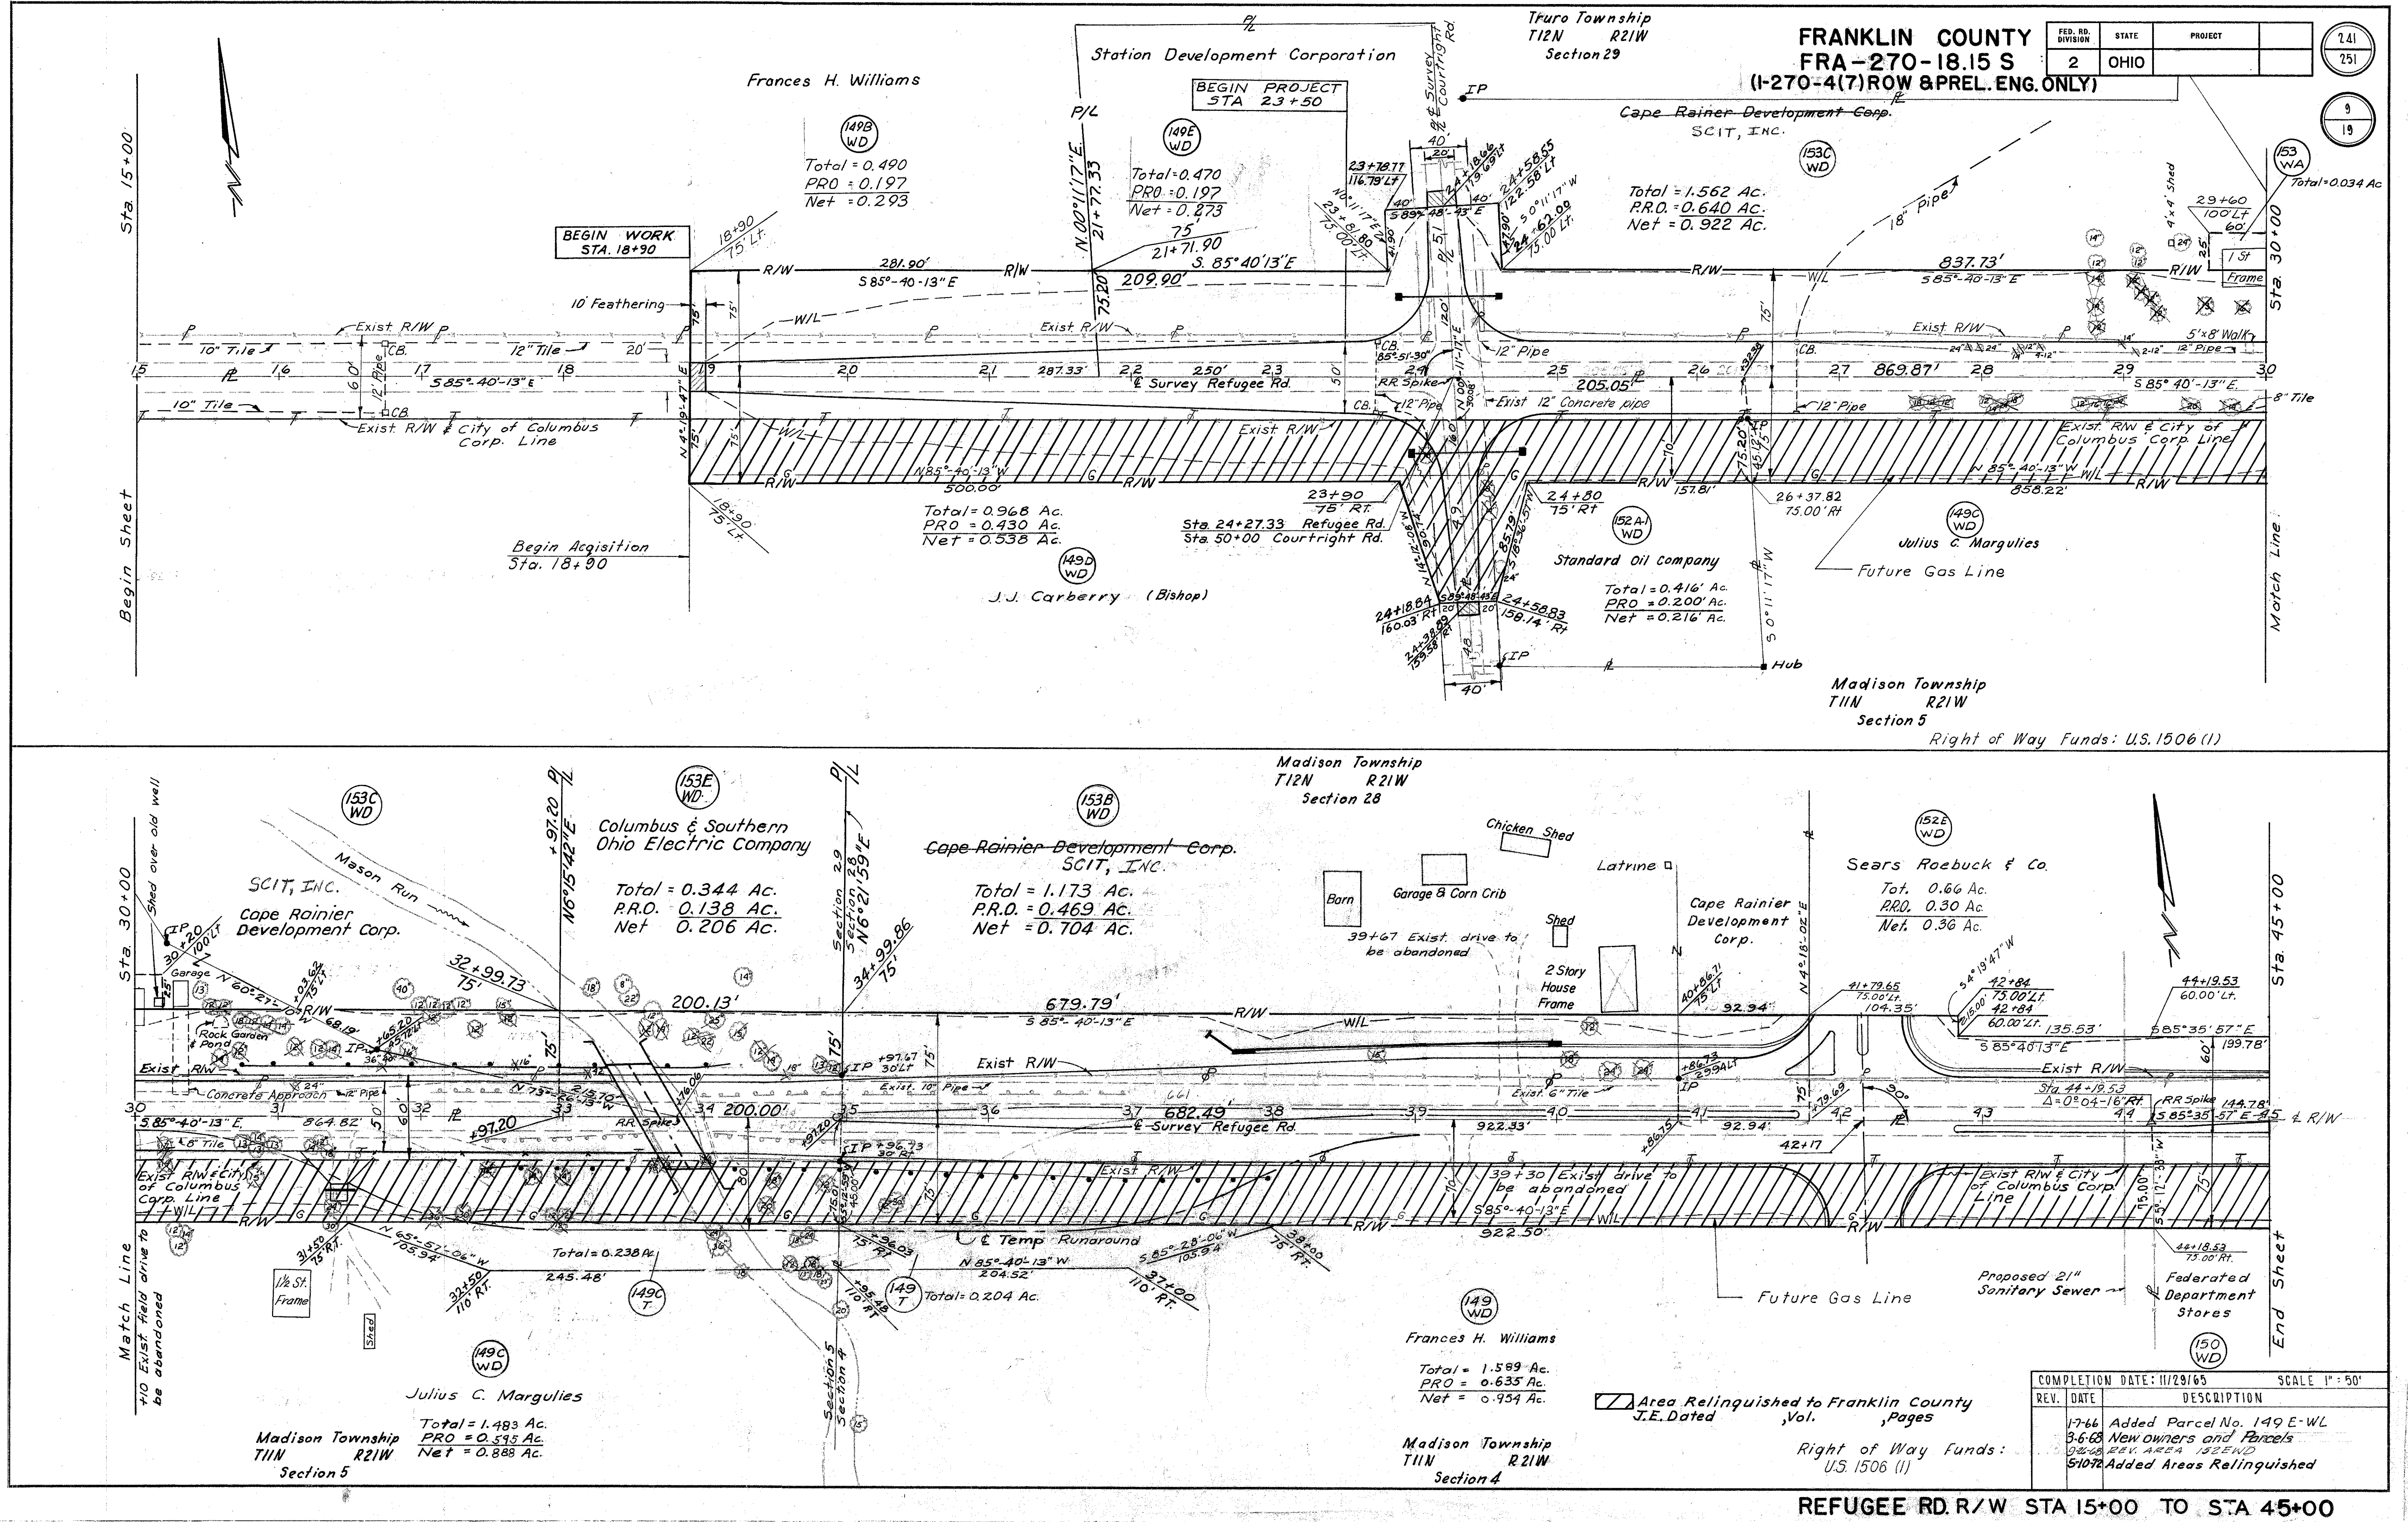




FRANKLIN COUNTY
FRA-270-18.15 S
(I-270-4(7)ROW & PREL. ENG. ONLY)

FED. RD. DIVISION	STATE	PROJECT	241
2	OHIO		251
			9
			19

REV.	DATE	DESCRIPTION
17-66		Added Parcel No. 149E-WL
5-6-68		New Owners and Parcels
12-68		REV. AREA 152E-WL
5-10-72		Added Areas Relinquished

COMPLETION DATE: 11/29/65 SCALE 1" = 50'

REFUGEE RD. R/W STA 15+00 TO STA 45+00

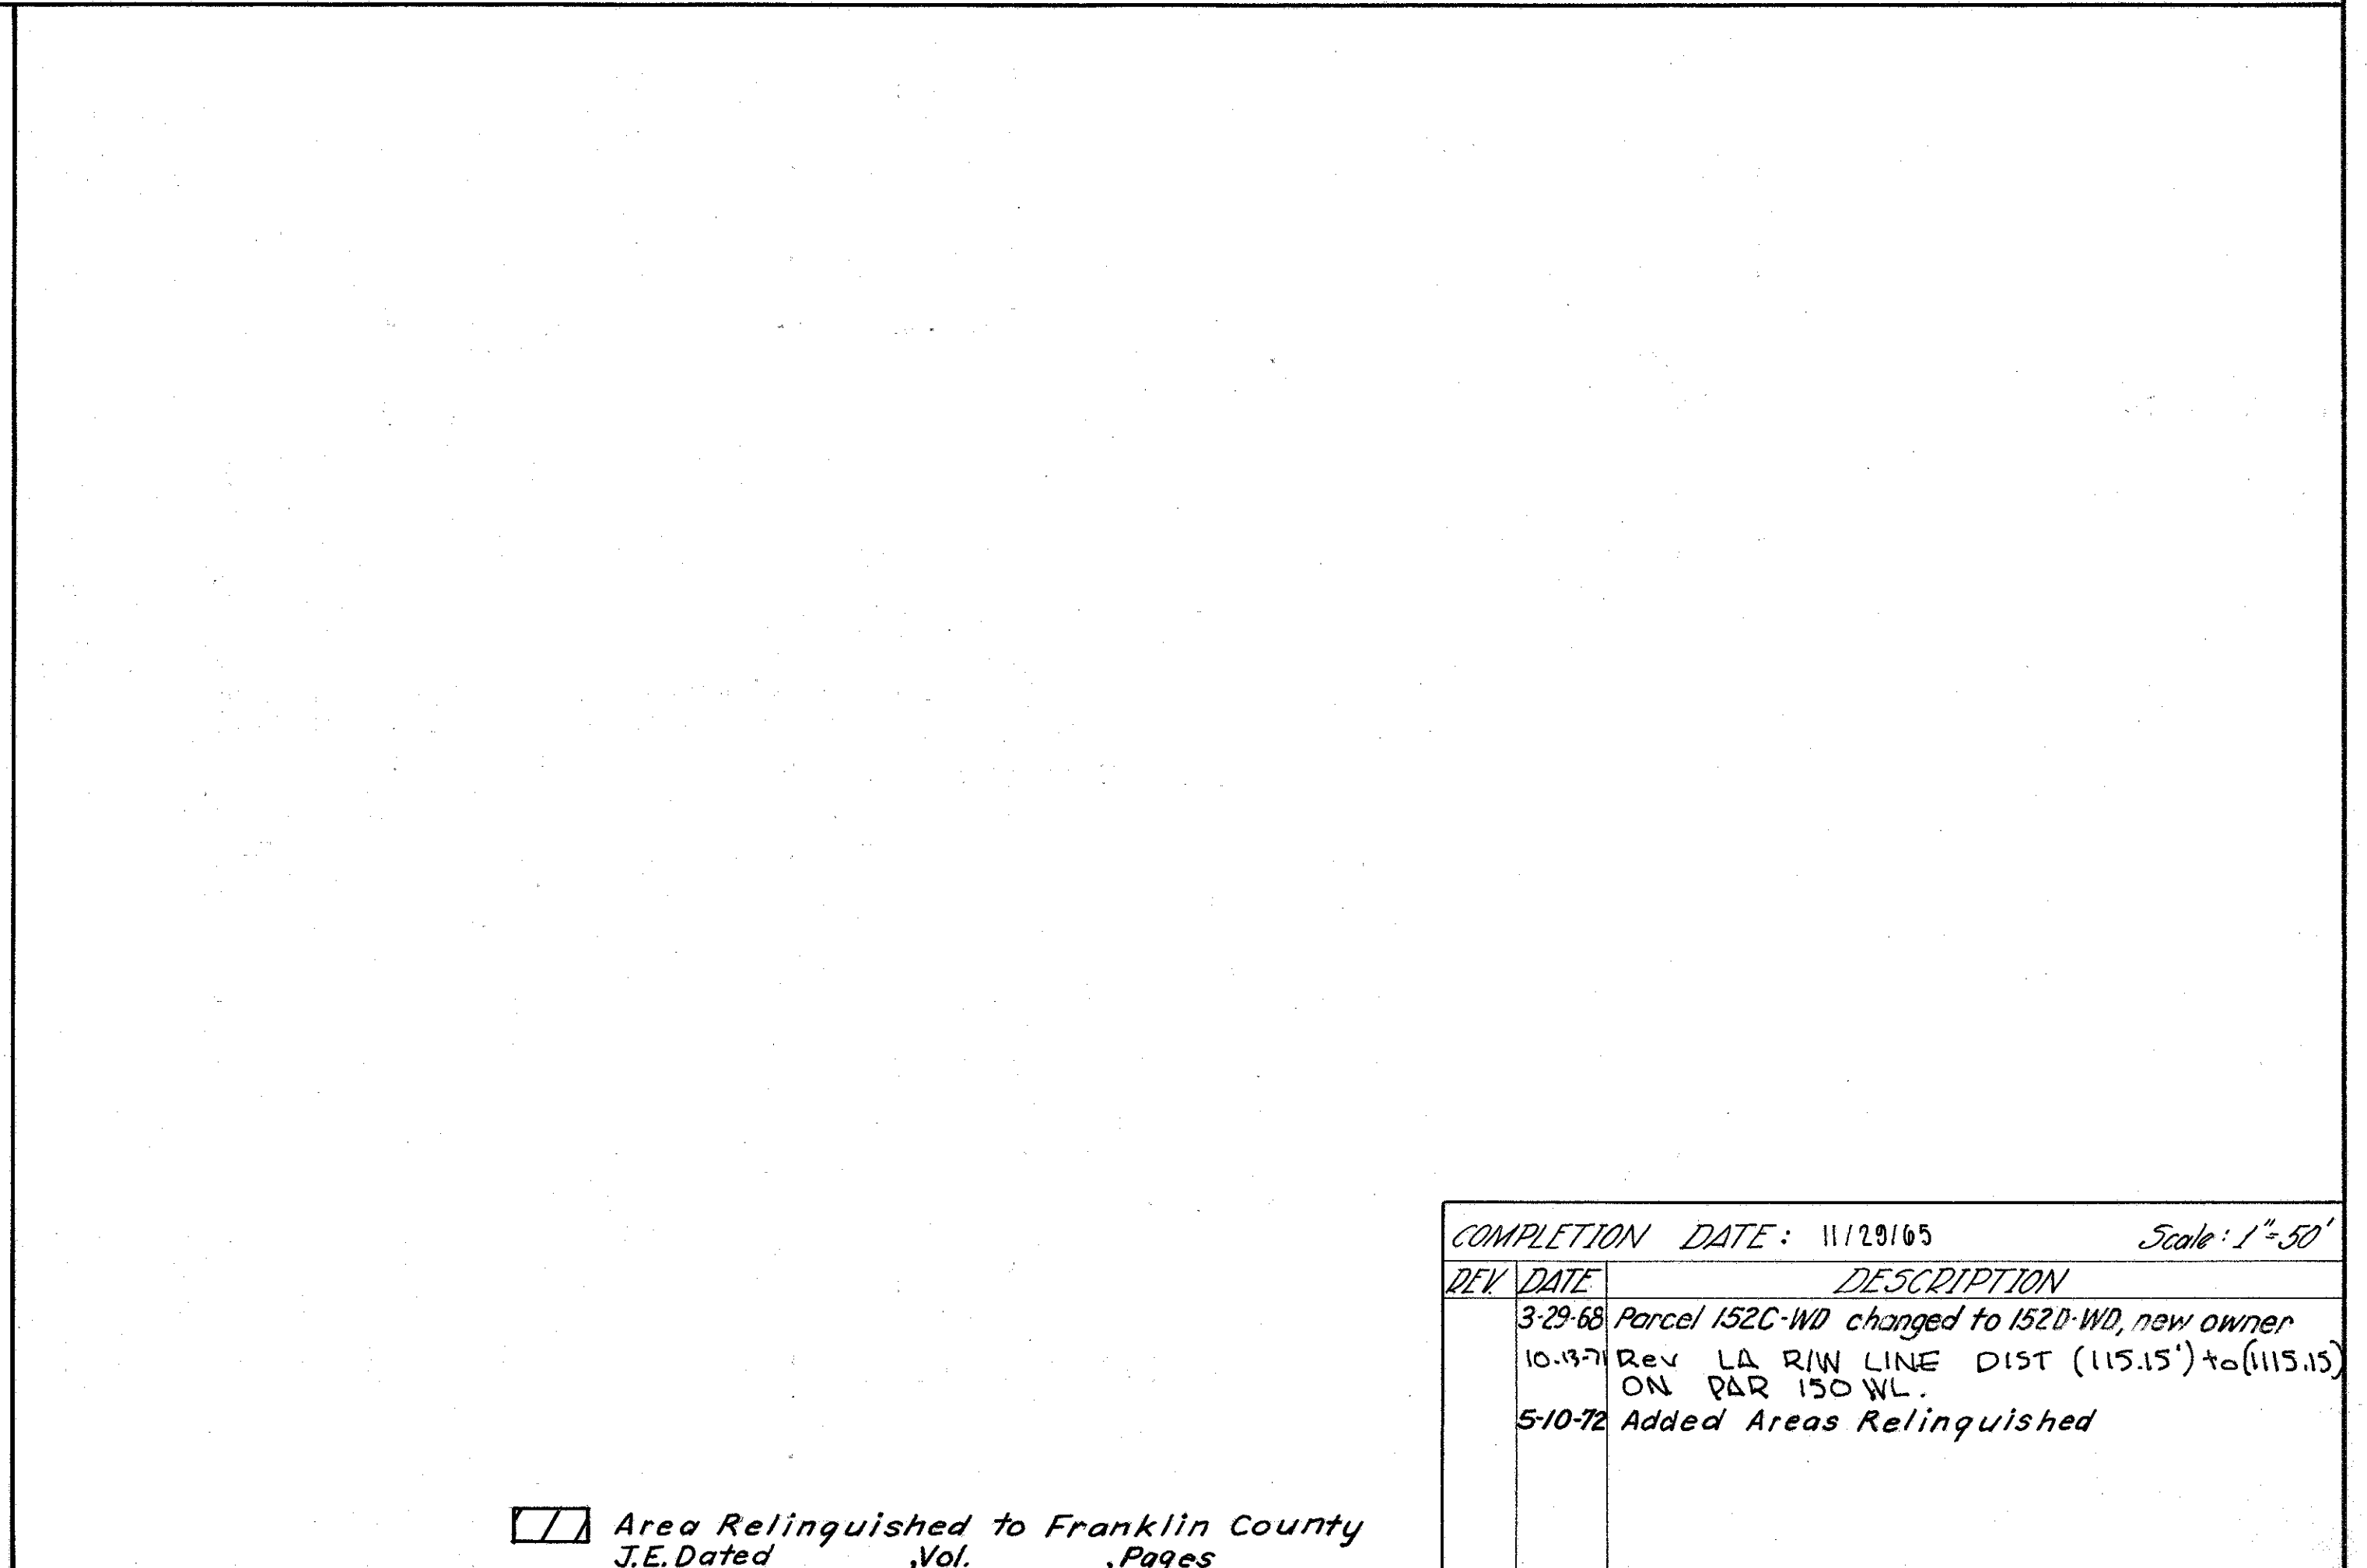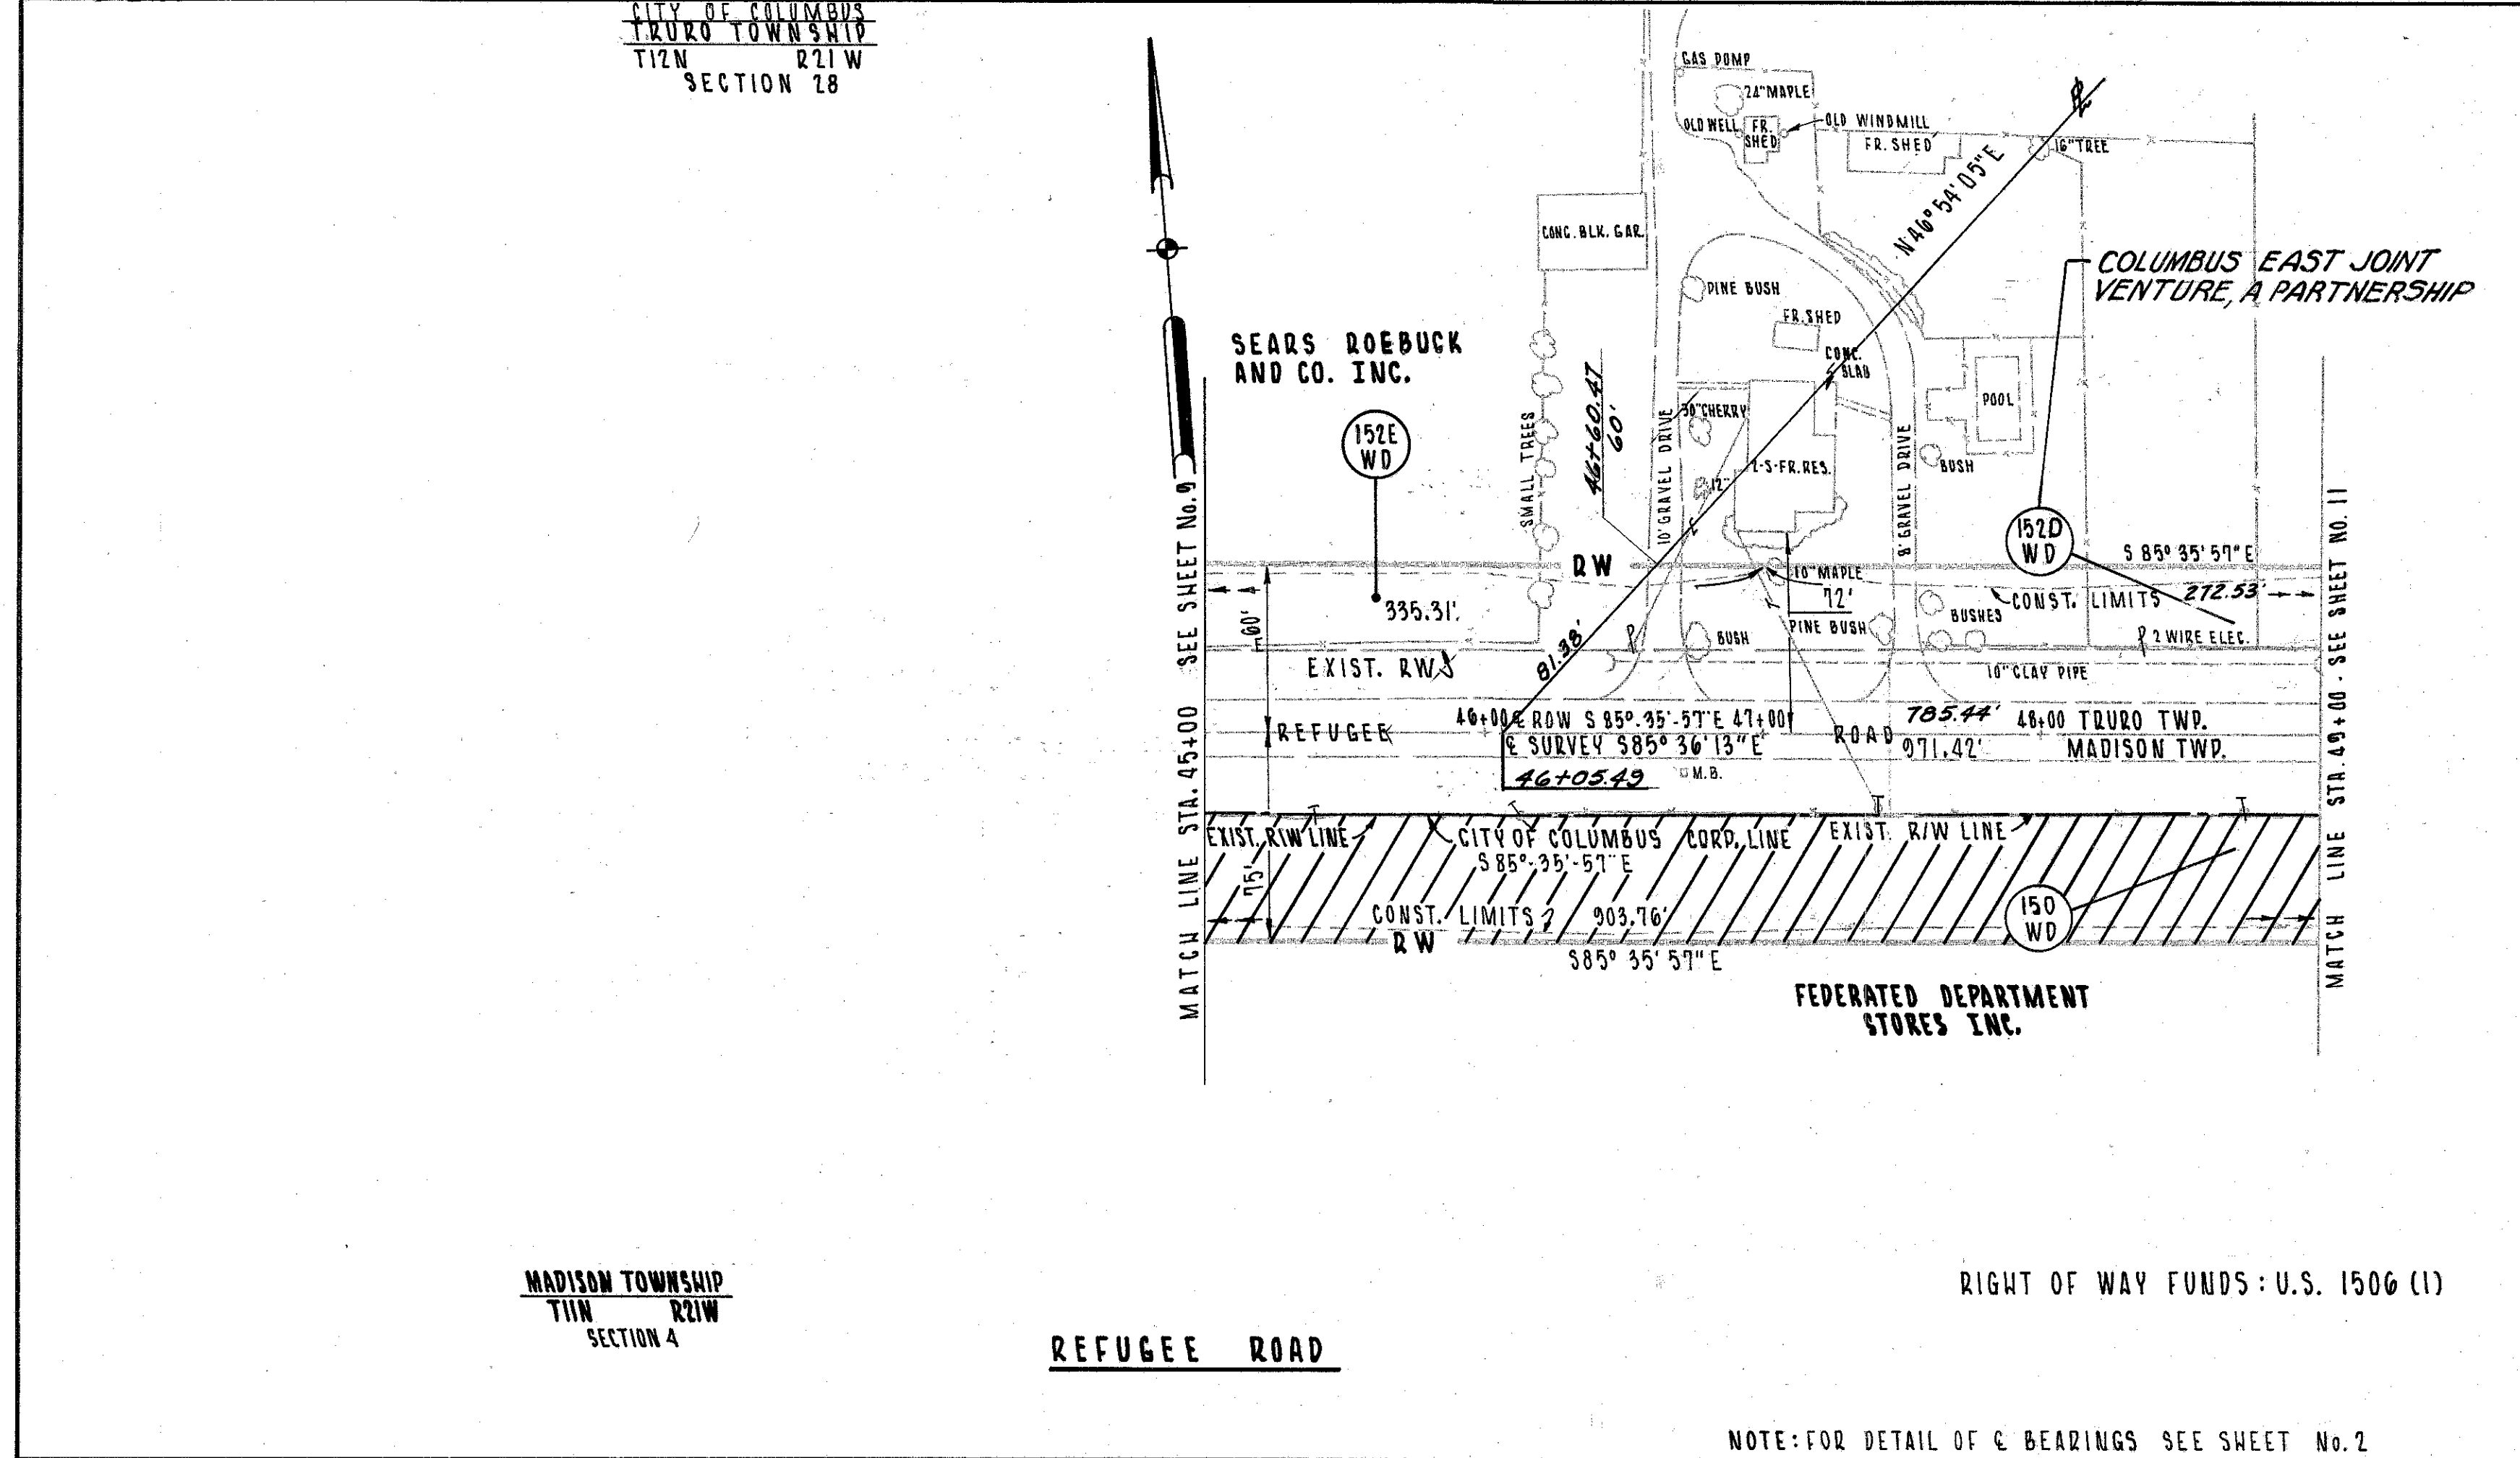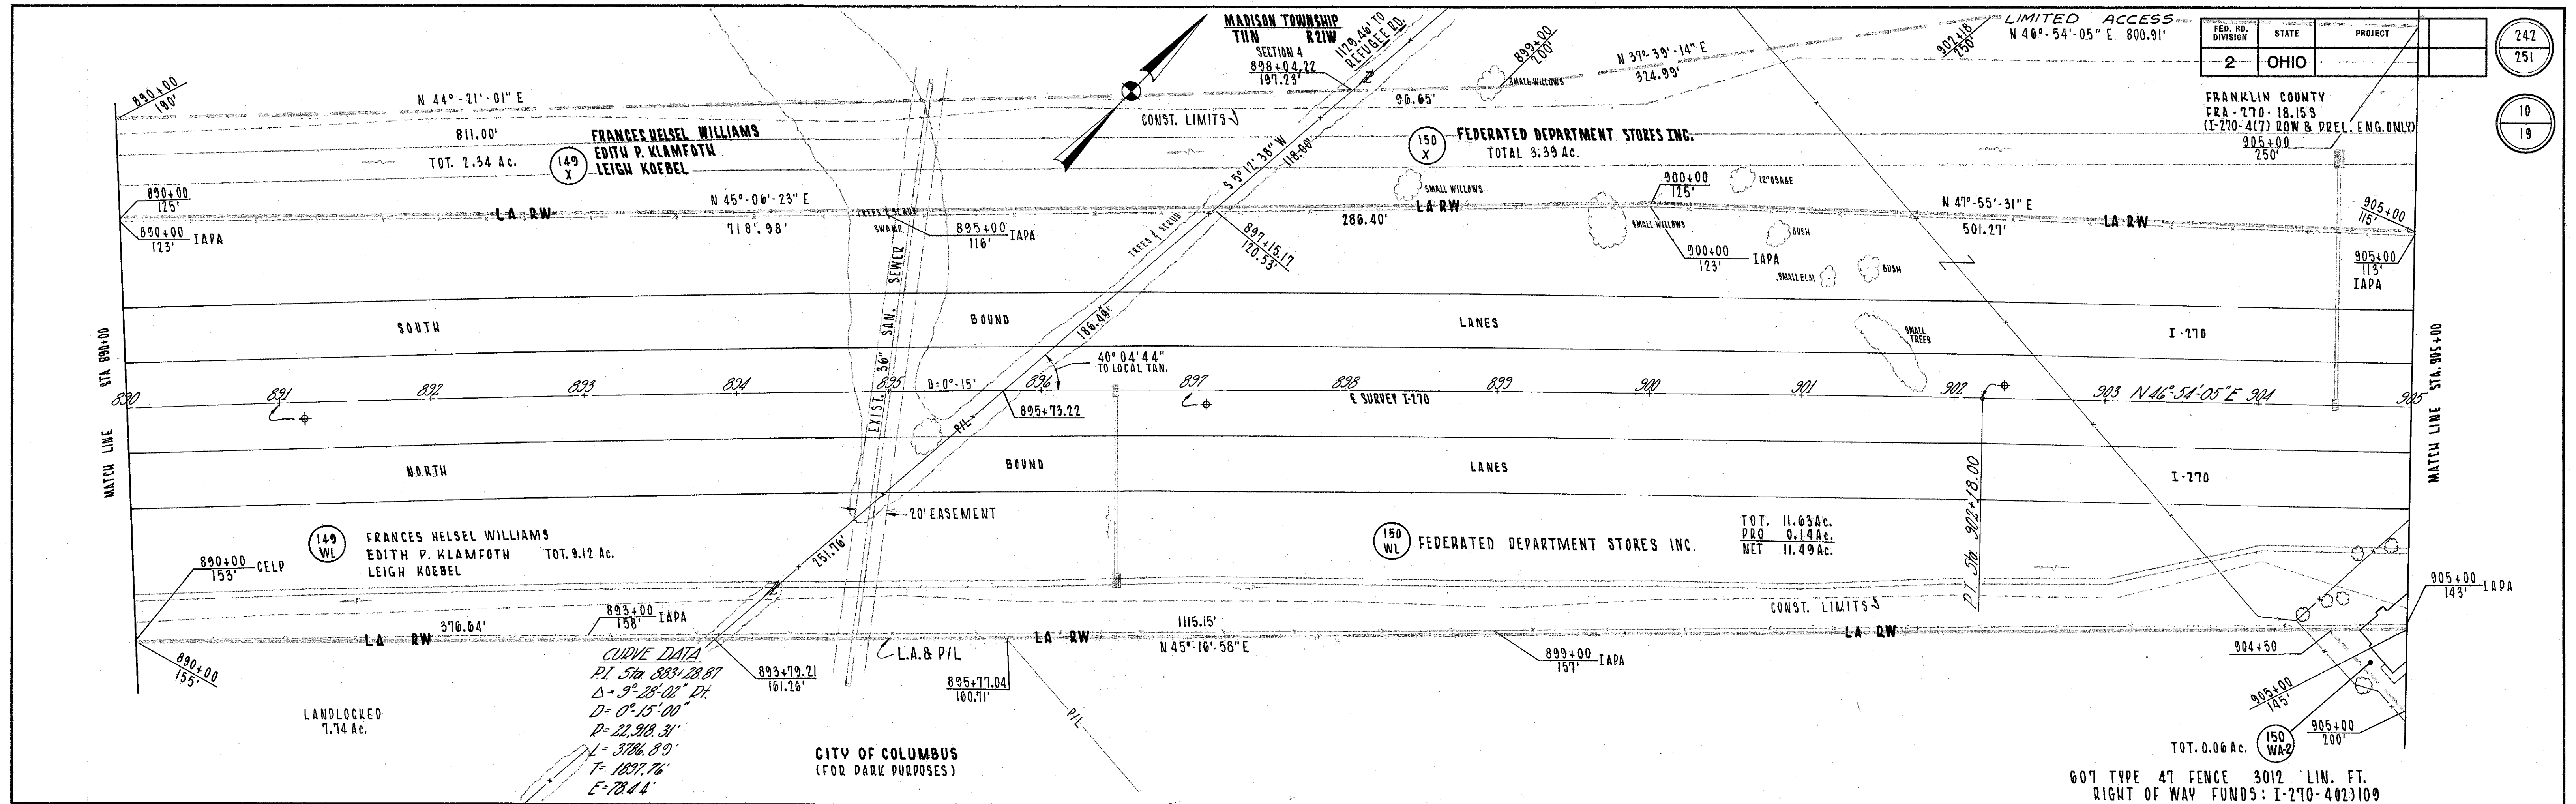

TRURO TOWNSHIP
T11N R21W
SECTION 28
CITY OF COLUMBUS

LIMITED ACCESS

FED. RD. DIVISION	STATE	PROJECT
2	OHIO	

243
251
11
19

FRANKLIN COUNTY
FRA-270-18.15S
(F-270-4(7) ROW & PREL.
ENG. ONLY)

920
50
115
1085

FEDERATED DEPARTMENT STORES INC.

TOT. 1.26 Ac.
PRD. 0.54 Ac.
NET. 0.72 Ac.
COLUMBUS EAST JOINT
VENTURE, A PARTNERSHIP

COLUMBUS EAST JOINT VENTURE, A PARTNERSHIP

FEDERATED DEPARTMENT
STORES INC. & SEARS
ROEBUCK CO.
TOT. 0.68 Ac.

FEDERATED DEPARTMENT STORES INC.
& SEARS ROEBUCK & CO.
TOT. 6.06 Ac.
PRD. 0.61 Ac.
NET. 5.45 Ac.

FEDERATED DEPARTMENT STORES INC.
TOTAL 11.63 Ac.
PRD. 0.14 Ac.
NET 11.49 Ac.

FEDERATED DEPARTMENT STORES INC.
& SEARS ROEBUCK CO.

CAPE RAMIER
DEVELOPMENT CORP.

607 TYPE 47 FENCE 1790 LIN. FT.
607 TYPE CL. FENCE 1377 LIN. FT.

MADISON TOWNSHIP
T11N R21W
SECTION 4

FEDERATED DEPARTMENT
STORES INC.

RIGHT OF WAY FUNDS I-270 4(12)109

U.S. 1506 (1)

PARCEL NUMBERS	PARCEL NUMBERS
150 WL	152C WD
150 Y	152C-1-WD
150 WD	152C-2-WD
150C-WD	150D-WD
150 WA	153A-1-WD
150S	153WD
152C-WL	
152A-WD	
	153 WD
	152D-WD
	150 D-WD
	153 WD
	152 A-WD

NOTE: FOR INTERSECTION DETAILS SEE SHEET No. 14
FOR DETAIL OF BEARINGS SEE SHEET No. 2

SHELL OIL CO.
TOT. 0.72 Ac.
PRD. 0.41 Ac.
NET. 0.31 Ac.

END PORTION 60+99.50
RESUME U.S. PORTION

R/W PLANS STA. 905+00 TO STA. 920+00 & REFUGEE ROAD

REV.	DATE	DESCRIPTION
9-1-66	12-6-66	Revised 150DWD
9-29-68	12-6-68	Hamilton Rd. South Alignment
9-29-68	12-6-68	152C-WD & 152C-S1 changed to 152D-WD & 152D-S1
9-29-68	12-6-68	REV. PAR. 152DWD
9-29-68	12-6-68	REV. PAR. 153WD
5-10-72	5-10-72	Added Areas Relinquished

Area Relinquished to Franklin County
J.E. Dated 3/1/72, Vol. 1, Pages 243, 251


LIMITED ACCESS

FED. RD. DIVISION	STATE	PROJECT
2	OHIO	

244
251

FRANKLIN COUNTY
FRA-270-18.158
(I-270-417) ROW & PREL.
ENG. ONLY

12
19

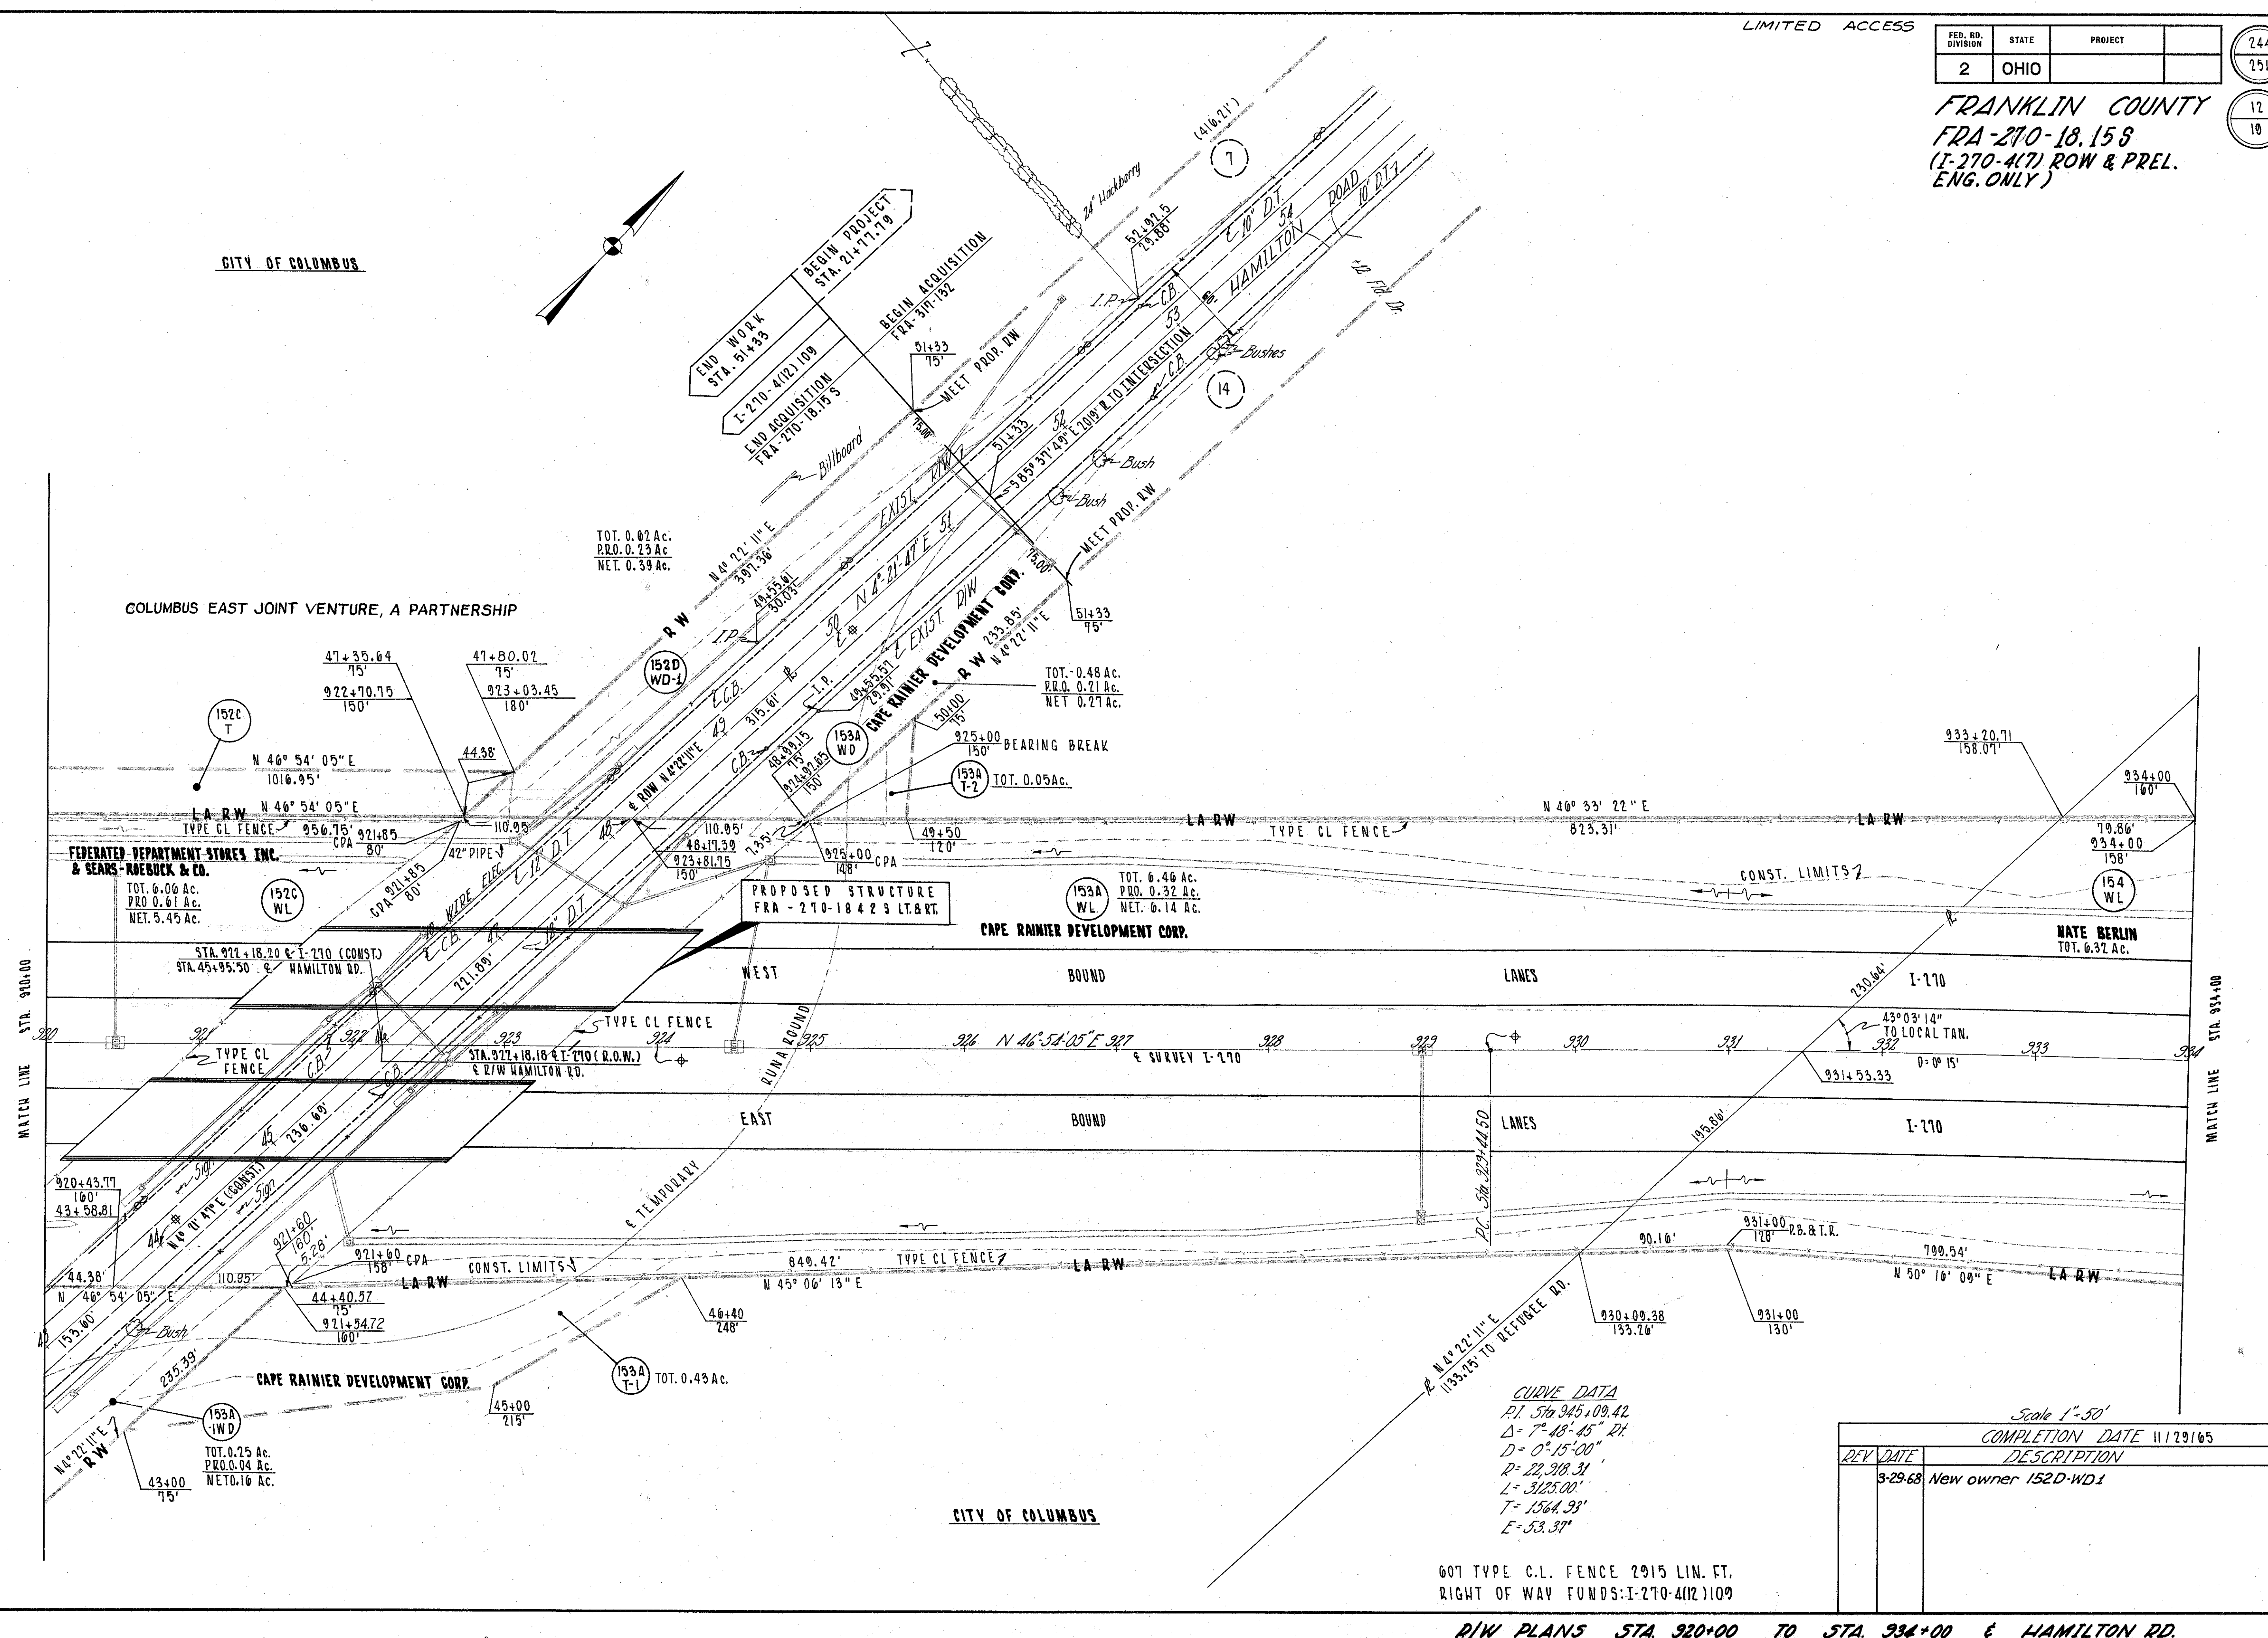

CURVE DATA
P.I. 576.945+09.42
Δ=7°48'45" P.I.
D=0°15'00"
R=22,918.31'
L=3123.00'
T=1564.33'
E=53.37'


607 TYPE C.L. FENCE 2915 LIN. FT.
RIGHT OF WAY FUNDS: I-270-417(1)109


R/W PLANS STA 920+00 TO STA 934+00 & HAMILTON RD.

Scale 1"=50'

COMPLETION DATE 11/29/05

REV	DATE	DESCRIPTION
3-29-68		New owner 152D-WD1

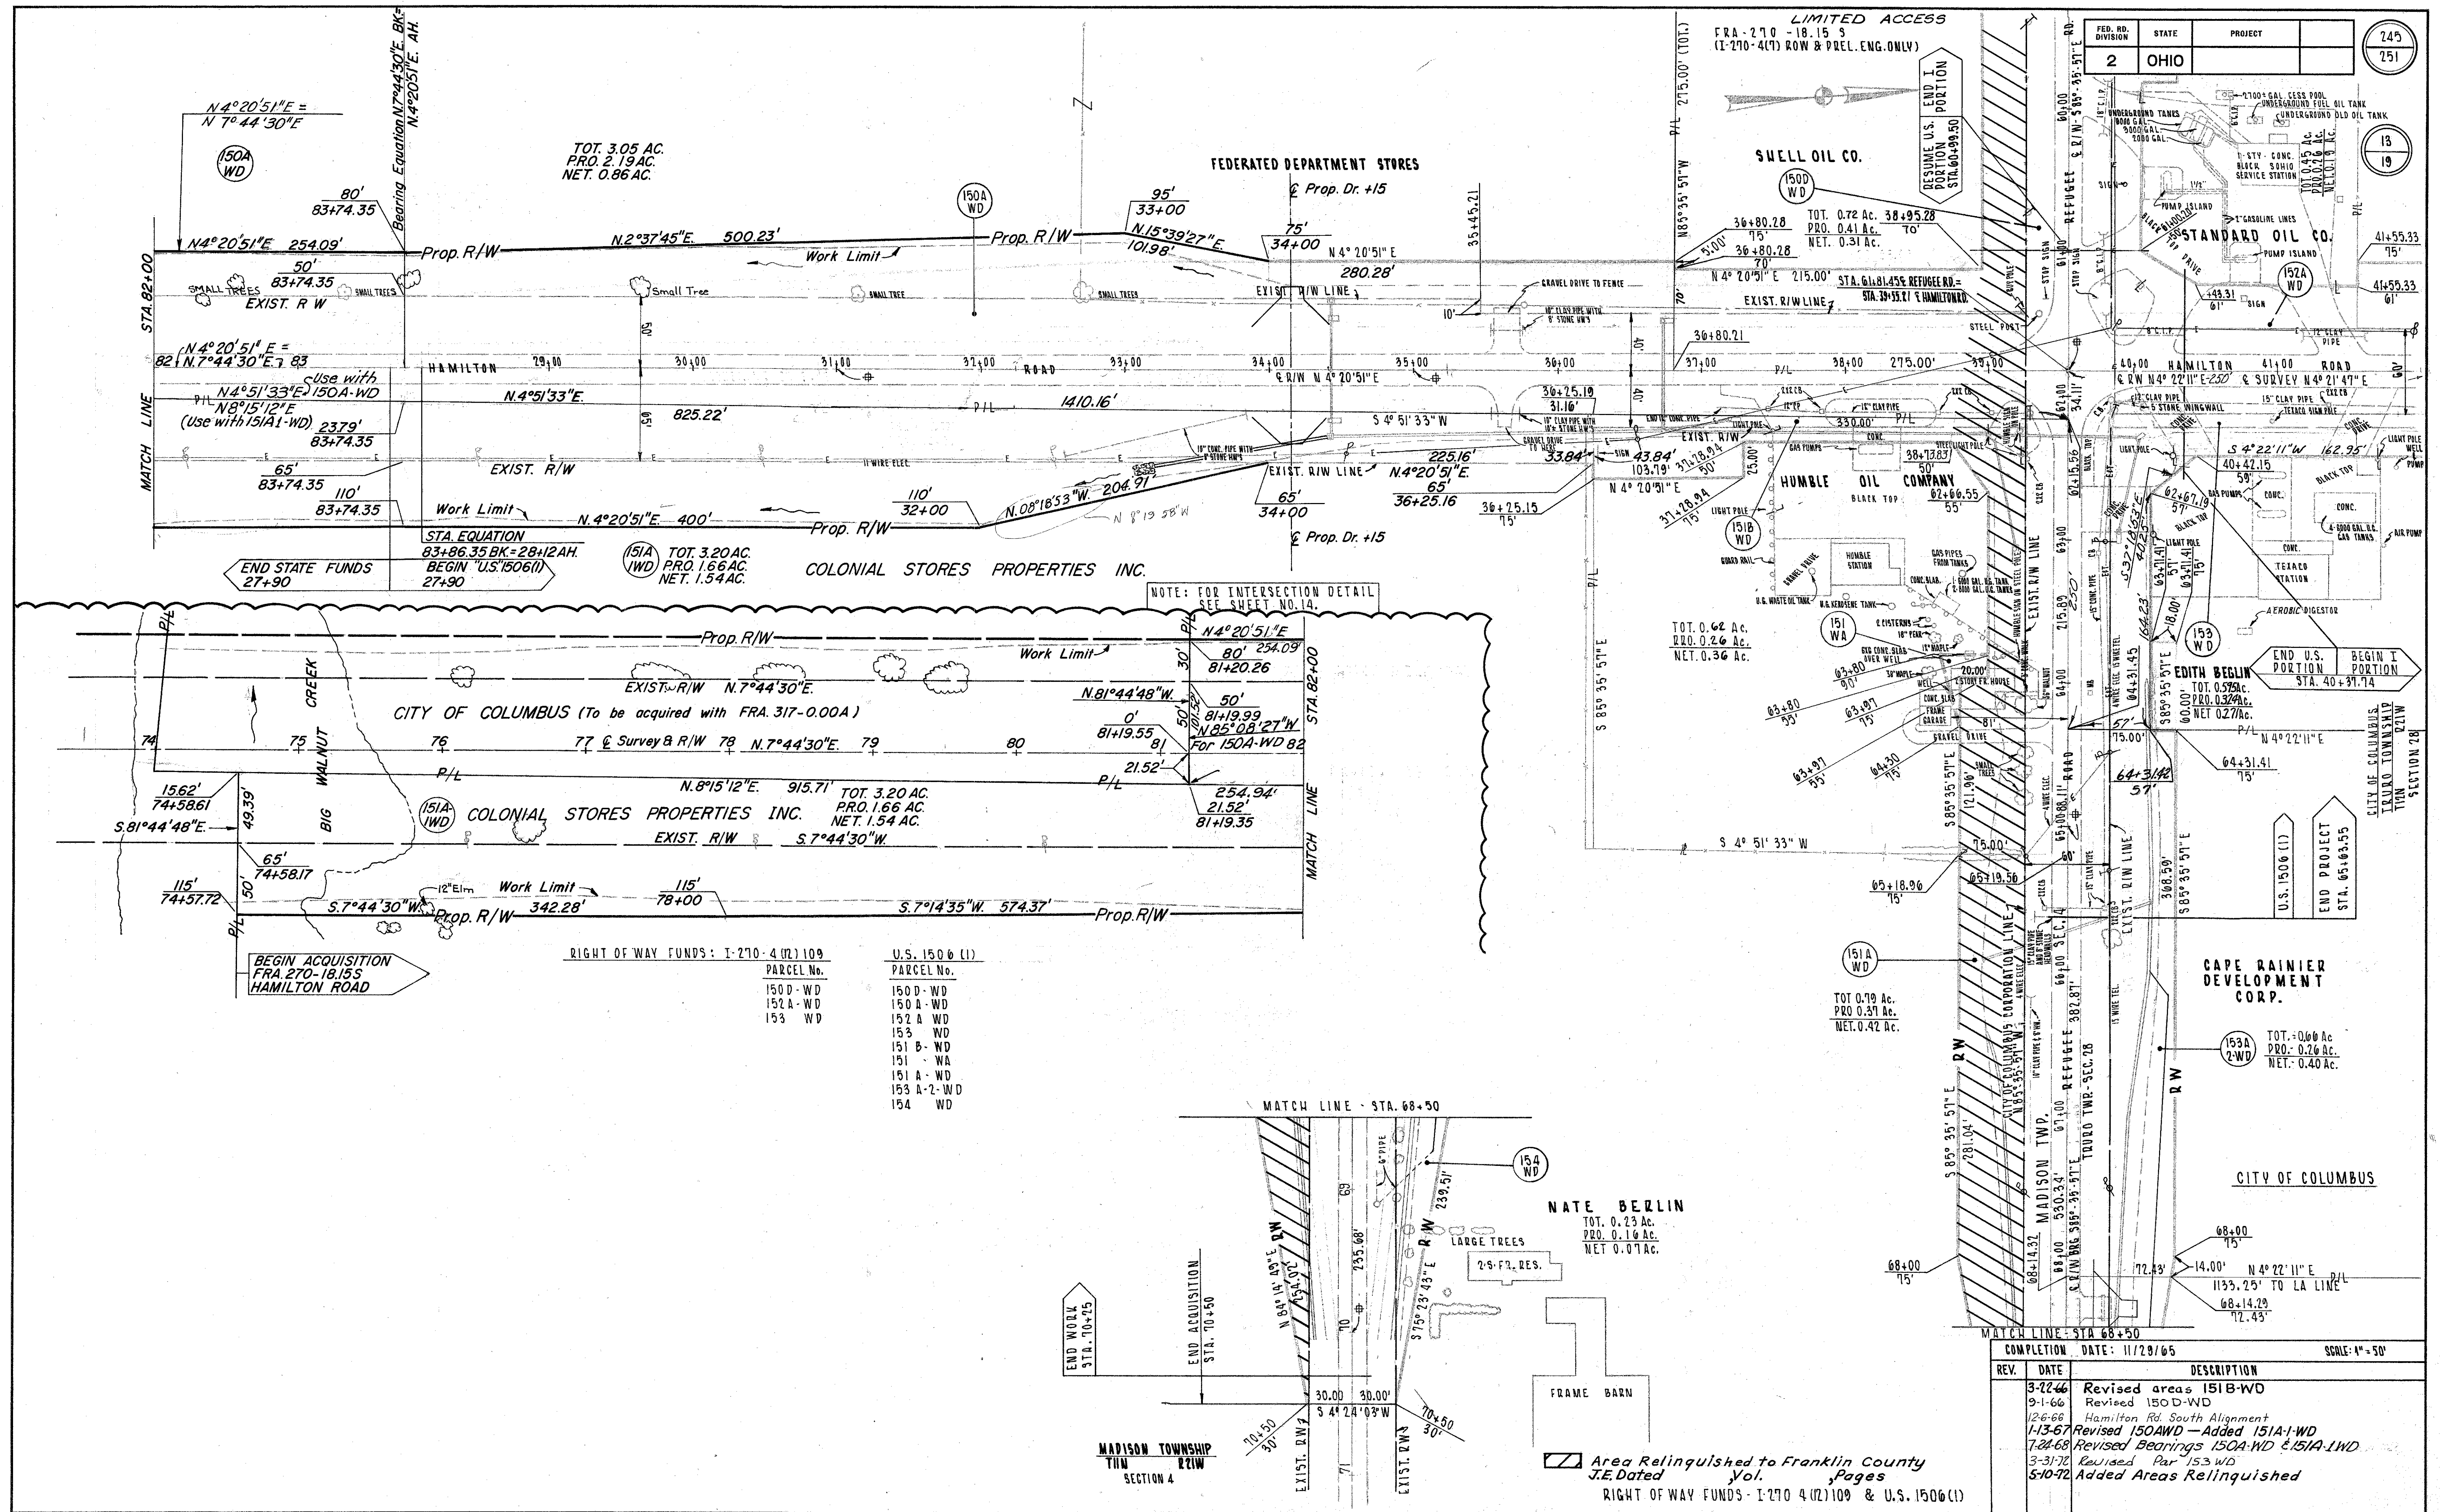

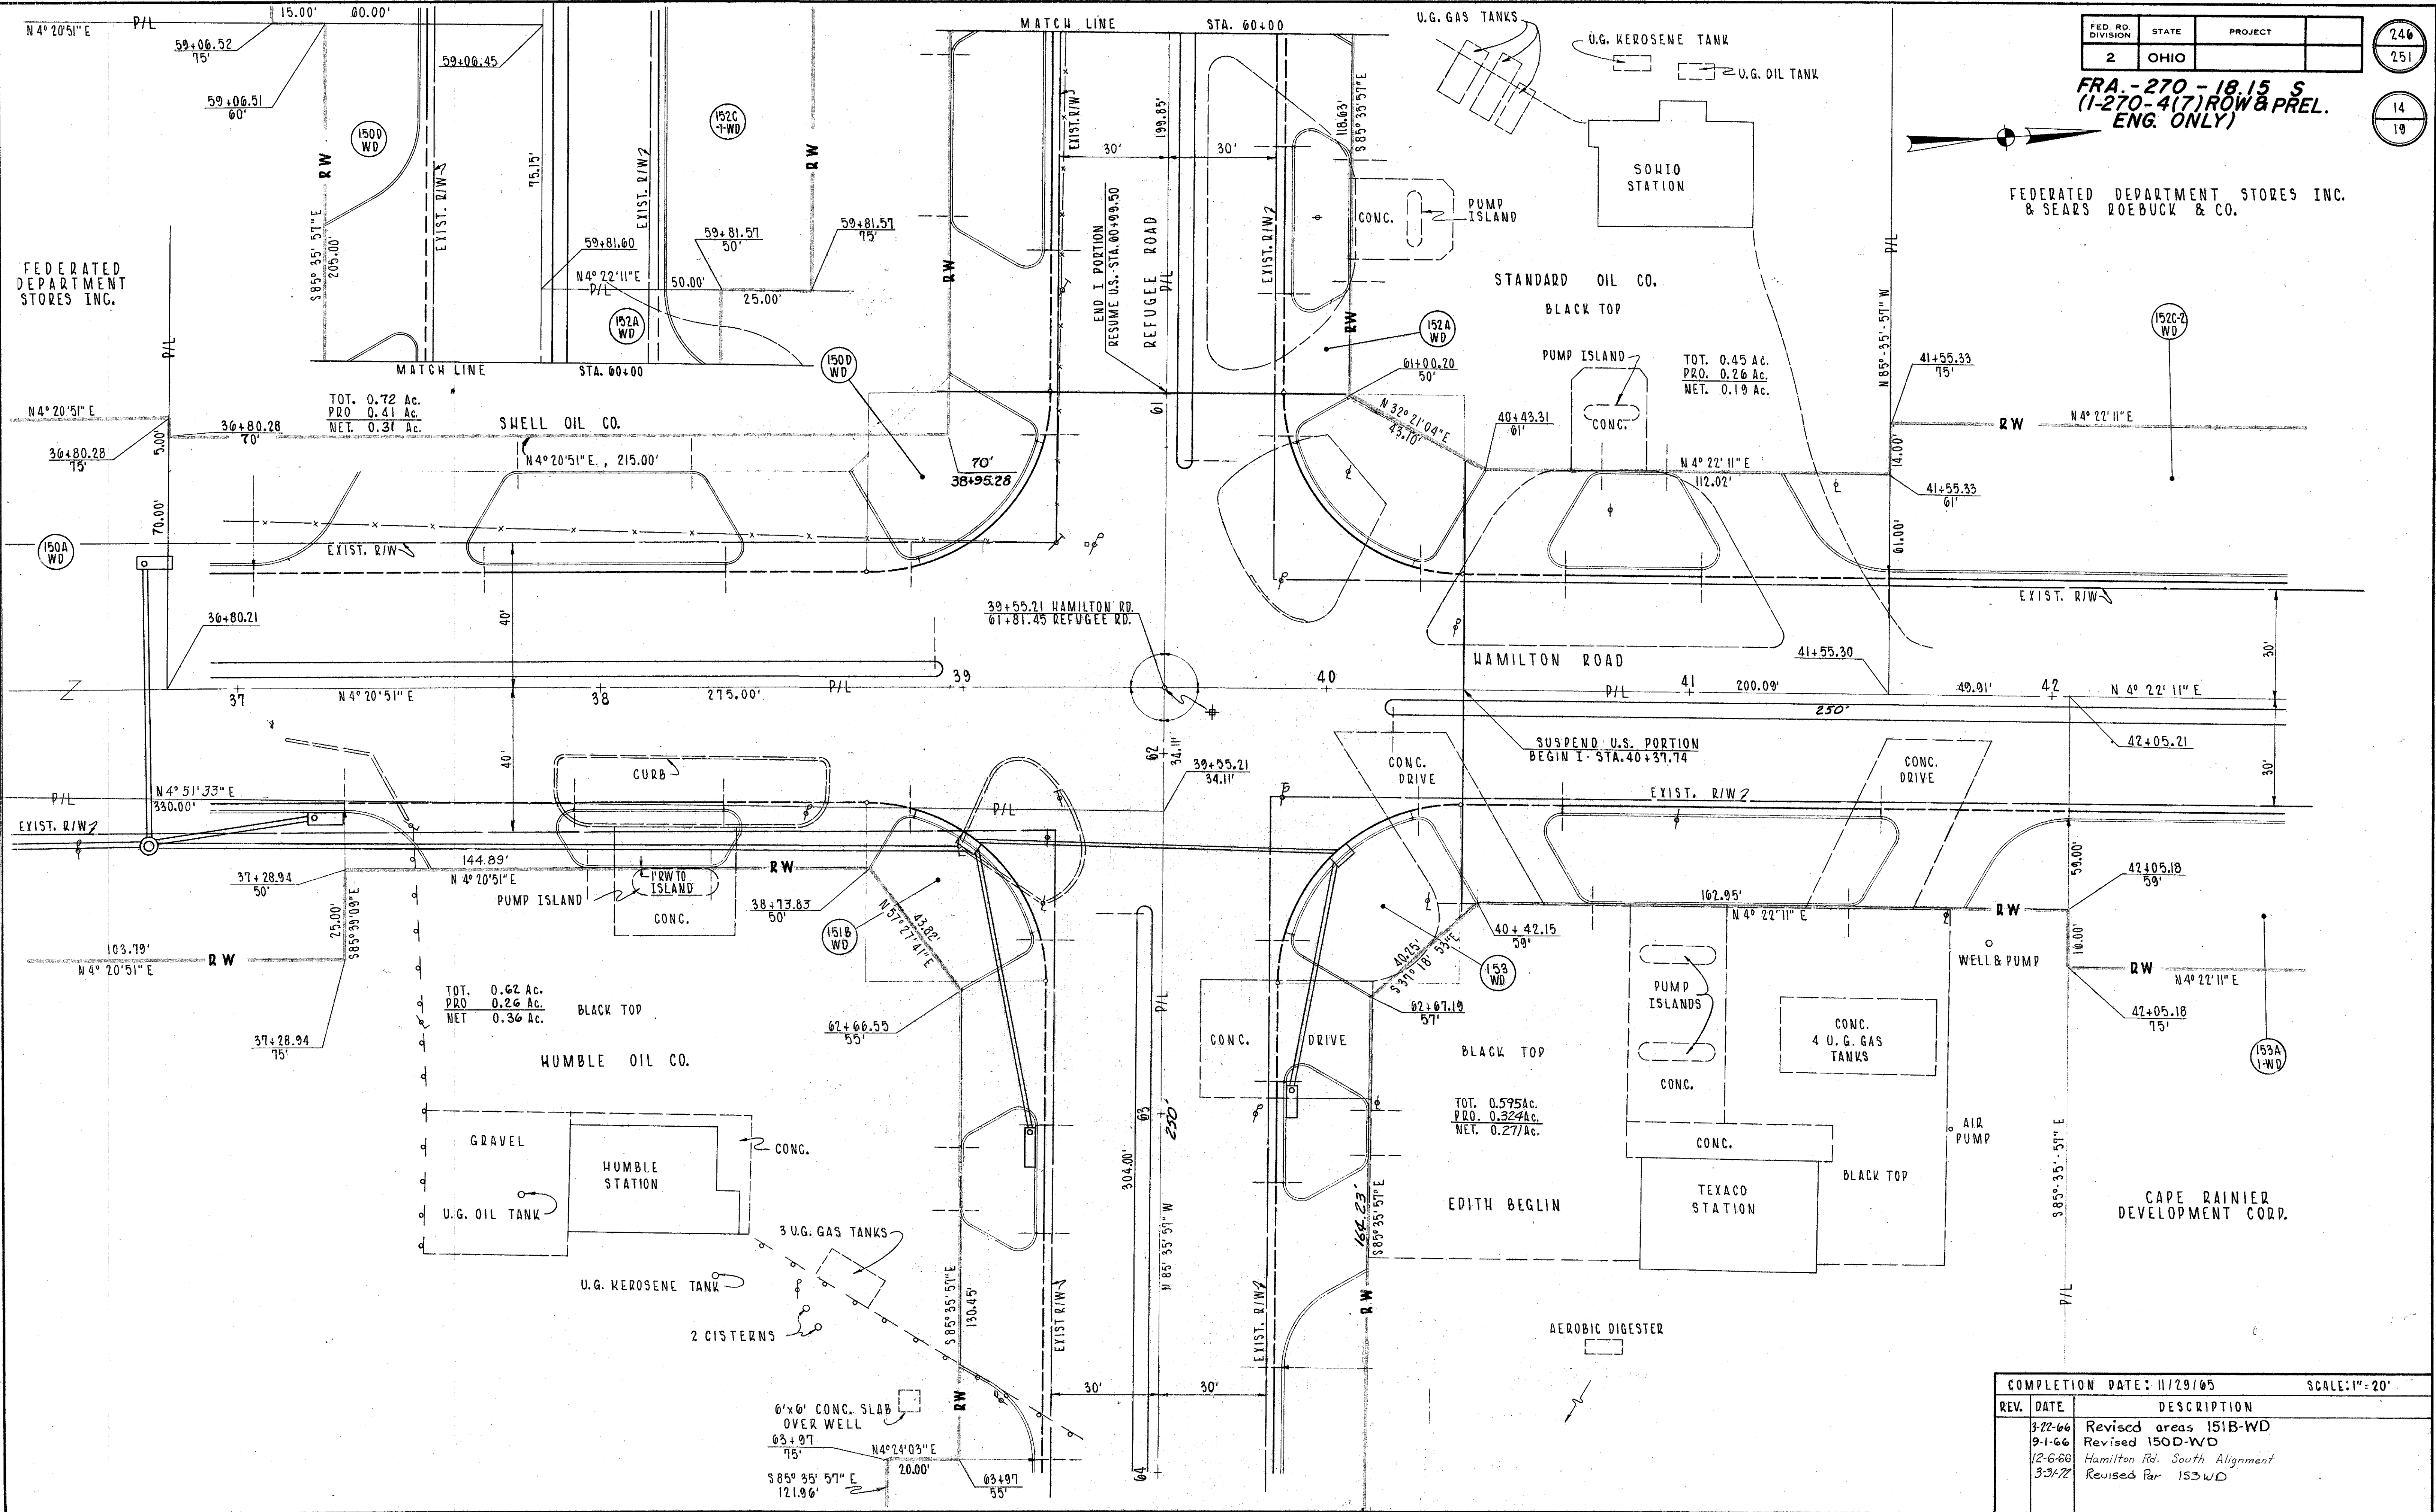



FED. RD. DIVISION	STATE	PROJECT
2	OHIO	


FRA - 270 - 18.15 S
(1-270-4(7) ROW & PREL.
ENG. ONLY)

FEDERATED DEPARTMENT STORES INC.
& SEARS ROEBUCK & CO.

COMPLETION DATE: 11/29/65		SCALE: 1" = 20'
REV.	DATE	DESCRIPTION
	3-22-66	Revised areas 151B-WD
	9-1-66	Revised 150D-WD
	12-6-68	Hamilton Rd. South Alignment
	3-21-72	Revised Par 153-WD

INTERSECTION DETAIL HAMILTON & REFUGEE RDS.

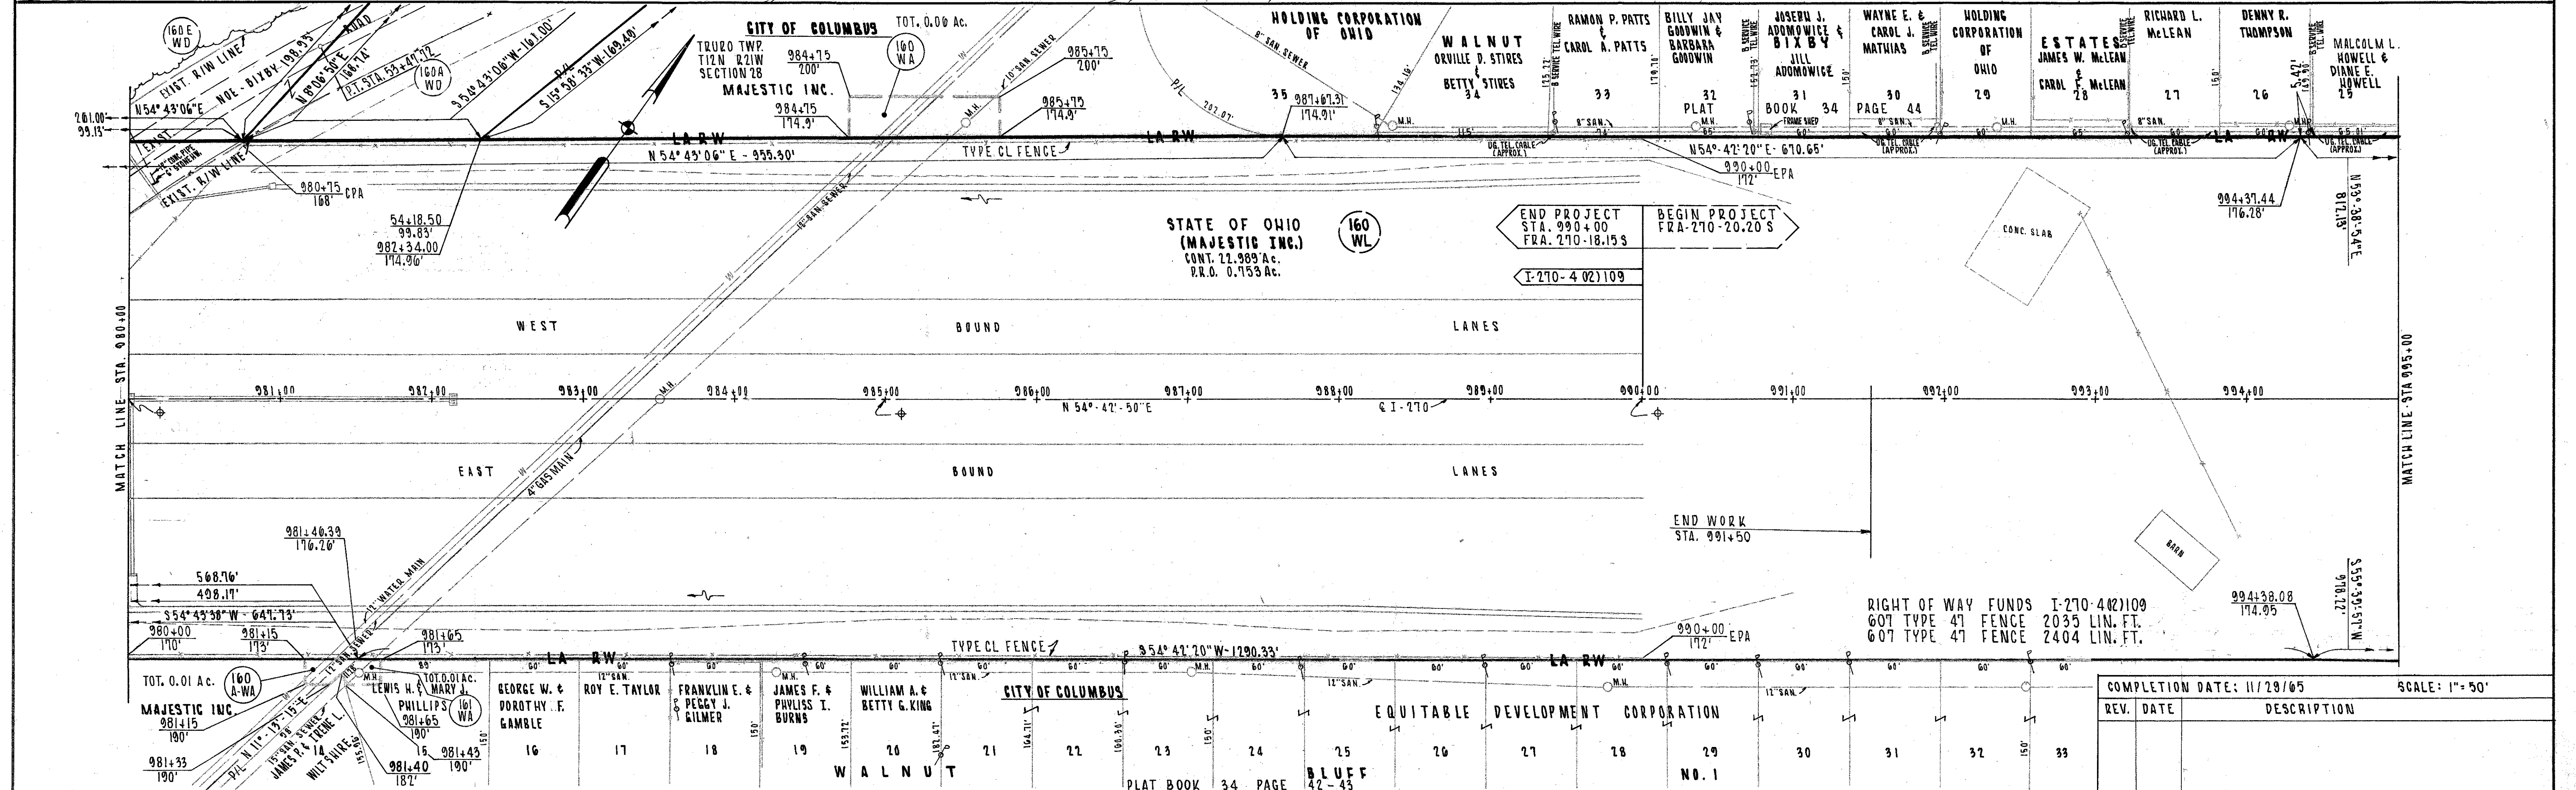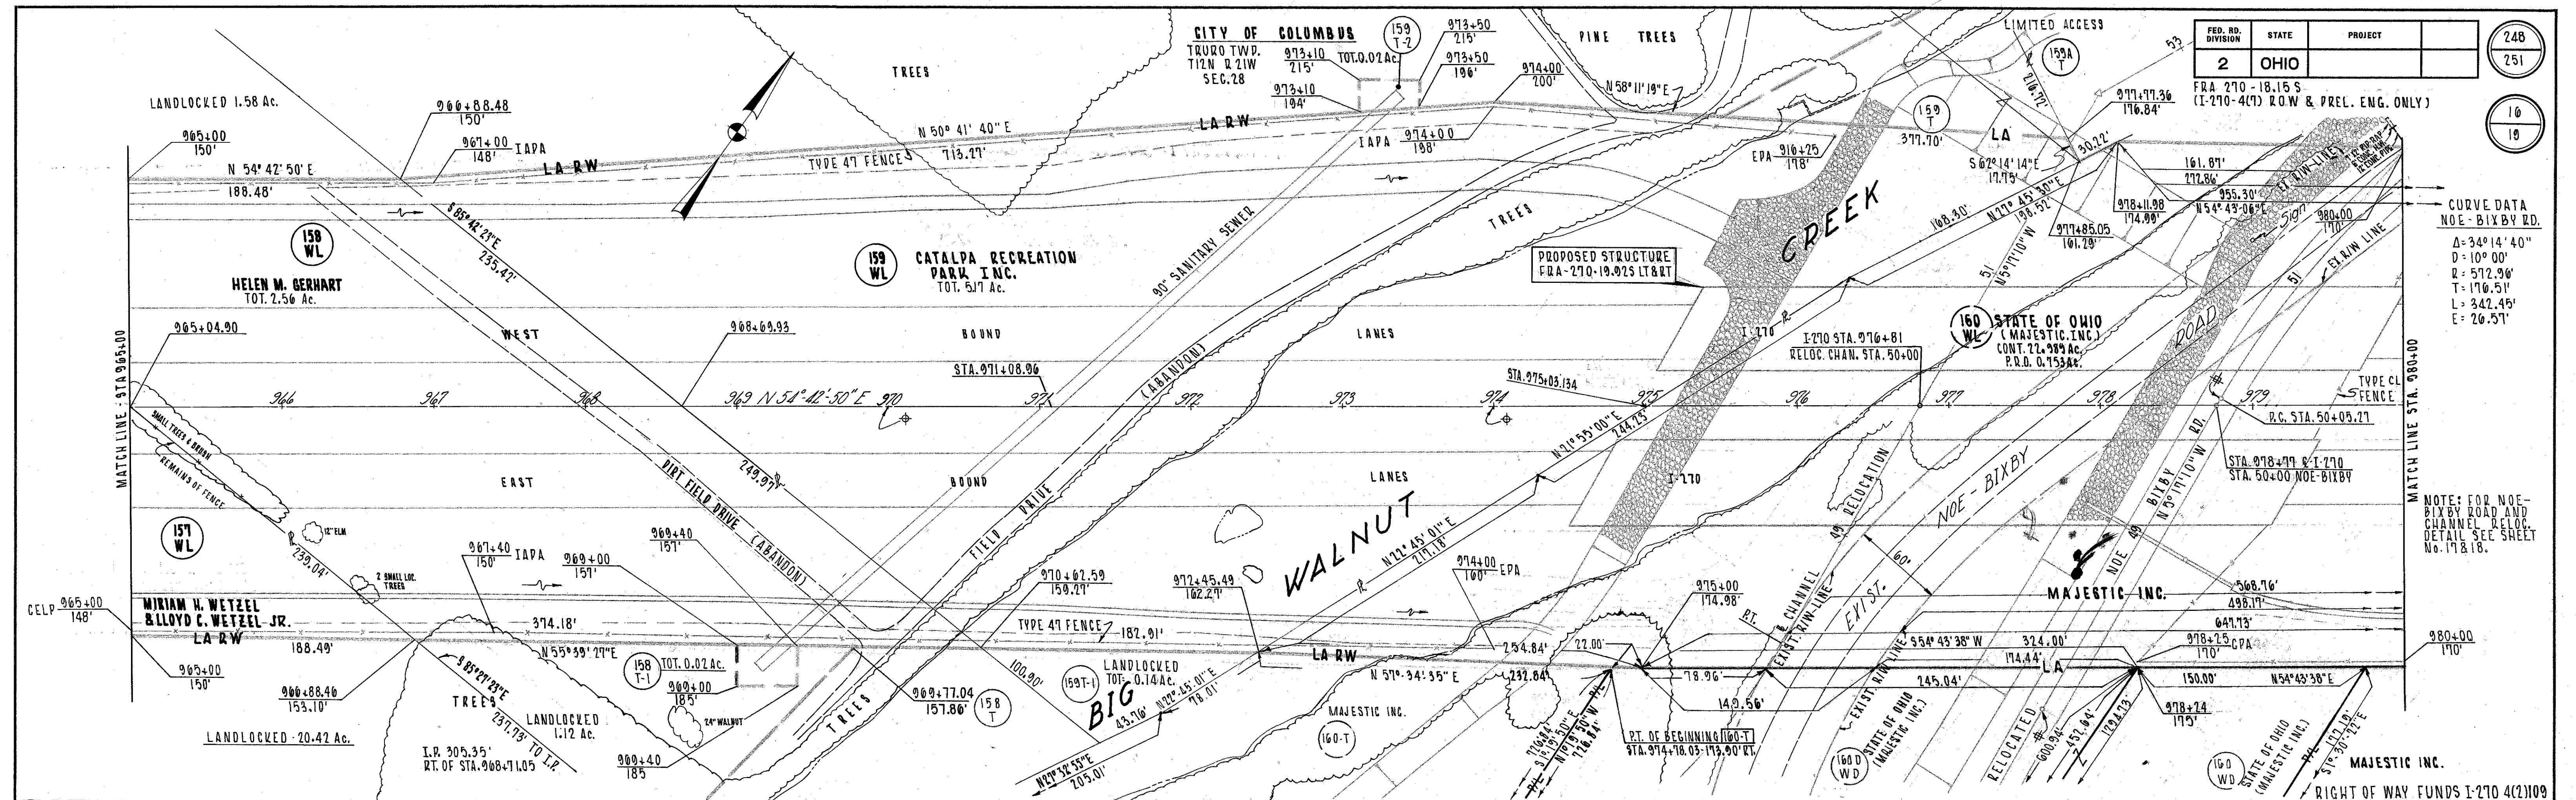

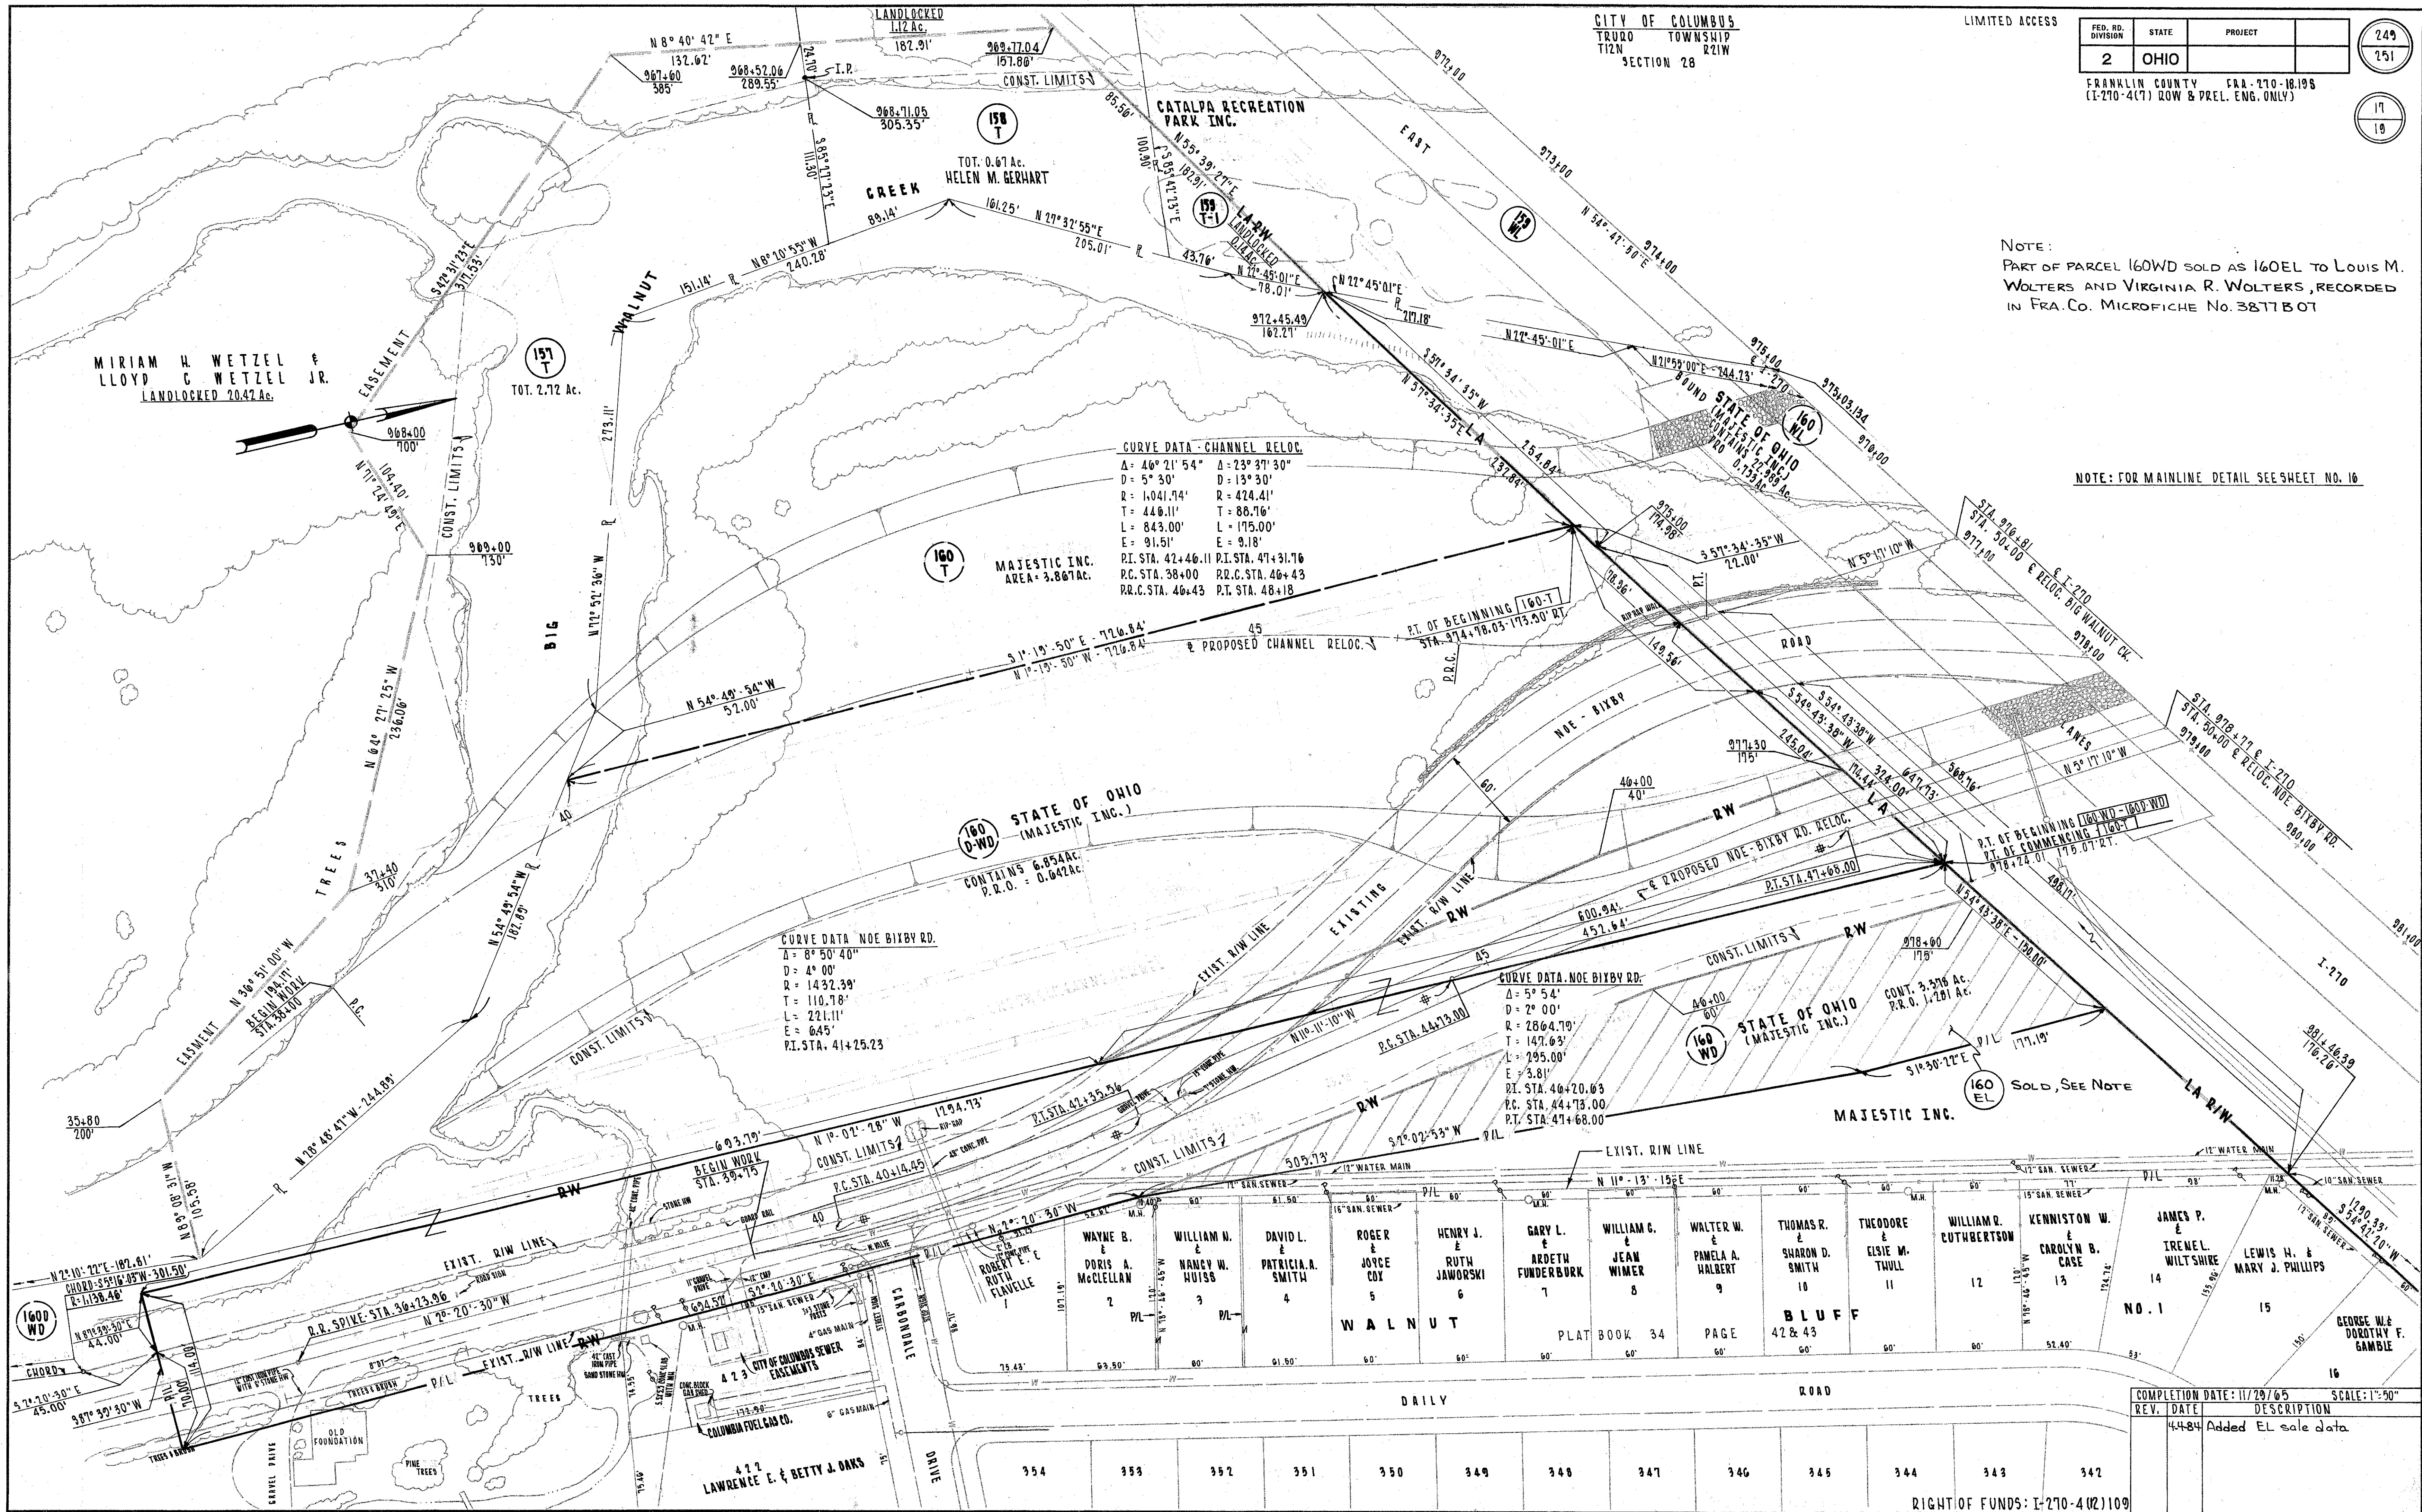

CITY OF COLUMBUS
TRURO T12N
TOWNSHIP R21W
SECTION 28

LIMITED ACCESS

FED. RD. DIVISION	STATE	PROJECT
2	OHIO	

FRANKLIN COUNTY FRA-270-16.195
(1-270-4(7) ROW & PREL. ENG. ONLY)

249
251
17
19

NOTE:
PART OF PARCEL 160WD SOLD AS 160EL TO LOUIS M. WOLTERS AND VIRGINIA R. WOLTERS, RECORDED IN FRA.CO. MICROFICHE NO. 3877B07

NOTE: FOR MAINLINE DETAIL SEE SHEET NO. 16

CURVE DATA - CHANNEL RELOC.
Δ = 46° 21' 54" D = 23° 37' 30"
D = 5° 30' R = 13° 30'
R = 1,041.74' T = 424.41'
T = 446.11' L = 88.76'
L = 843.00' E = 91.51'
P.I. STA. 42+46.11 P.T. STA. 47+31.76
P.C. STA. 38+00 R.C. STA. 46+43
P.R.C. STA. 46+43 P.T. STA. 48+18

STATE OF OHIO
(MAJESTIC INC.)
CONTAINS 6.854AC.
P.R.O. = 0.042AC.

CURVE DATA NOE BIXBY RD.
Δ = 8° 50' 40" D = 4° 00'
D = 4° 00' R = 1432.39'
T = 110.78' L = 221.11'
E = 645'
P.I. STA. 41+25.23

CURVE DATA NOE BIXBY RD.
Δ = 5° 54' D = 2° 00'
D = 2° 00' R = 2864.79'
T = 147.63' L = 295.00'
E = 3.81'
P.I. STA. 46+20.63
P.C. STA. 44+13.00
P.T. STA. 47+68.00

STATE OF OHIO
(MAJESTIC INC.)
CONT. 3.376 AC.
P.R.O. 1.201 AC.

SOLD, SEE NOTE

WAYNE B. & DORIS A. McCLELLAN	DAVID L. & PATRICIA A. SMITH	ROGER & JOYCE COX	HENRY J. & RUTH JAWORSKI	GARY L. & ARDETH FUNDERBARK	WILLIAM C. & JEAN WIMER	WALTER W. & PAMELA A. HALBERT	THOMAS R. & SHARON D. SMITH	THEODORE & ELSIE M. TULL	WILLIAM R. CUTHBERTSON	KENNISTON W. & CAROLYN B. CASE	JAMES P. & TRENEL WILTSHIRE	LEWIS H. & MARY J. PHILLIPS	GEORGE W. & DOROTHY F. GAMBLE
1	4	5	6	7	8	9	10	11	12	13	14	15	16

COMPLETION DATE: 11/29/65		SCALE: 1"=50'
REV.	DATE	DESCRIPTION
	4484	Added EL sale data


RIGHT OF FUNDS: I-270-4(02)109
R/W PLANS - RELOCATED NOE-BIXBY RD. STA. 95+50 TO STA. 50+00

FED. RD. DIVISION	STATE	PROJECT
2	OHIO	

FRANKLIN COUNTY FRA-270-18,155
(I-270-4(2) ROW & PREL. ENG. ONLY)

250
251
18
19

CURVE DATA
NOE-BIXBY RD. RELOC.
Δ = 34°14'40"
D = 10°00'
R = 572.96'
T = 176.51'
L = 342.45'
E = 26.57'
P.I. STA. 51+81.78

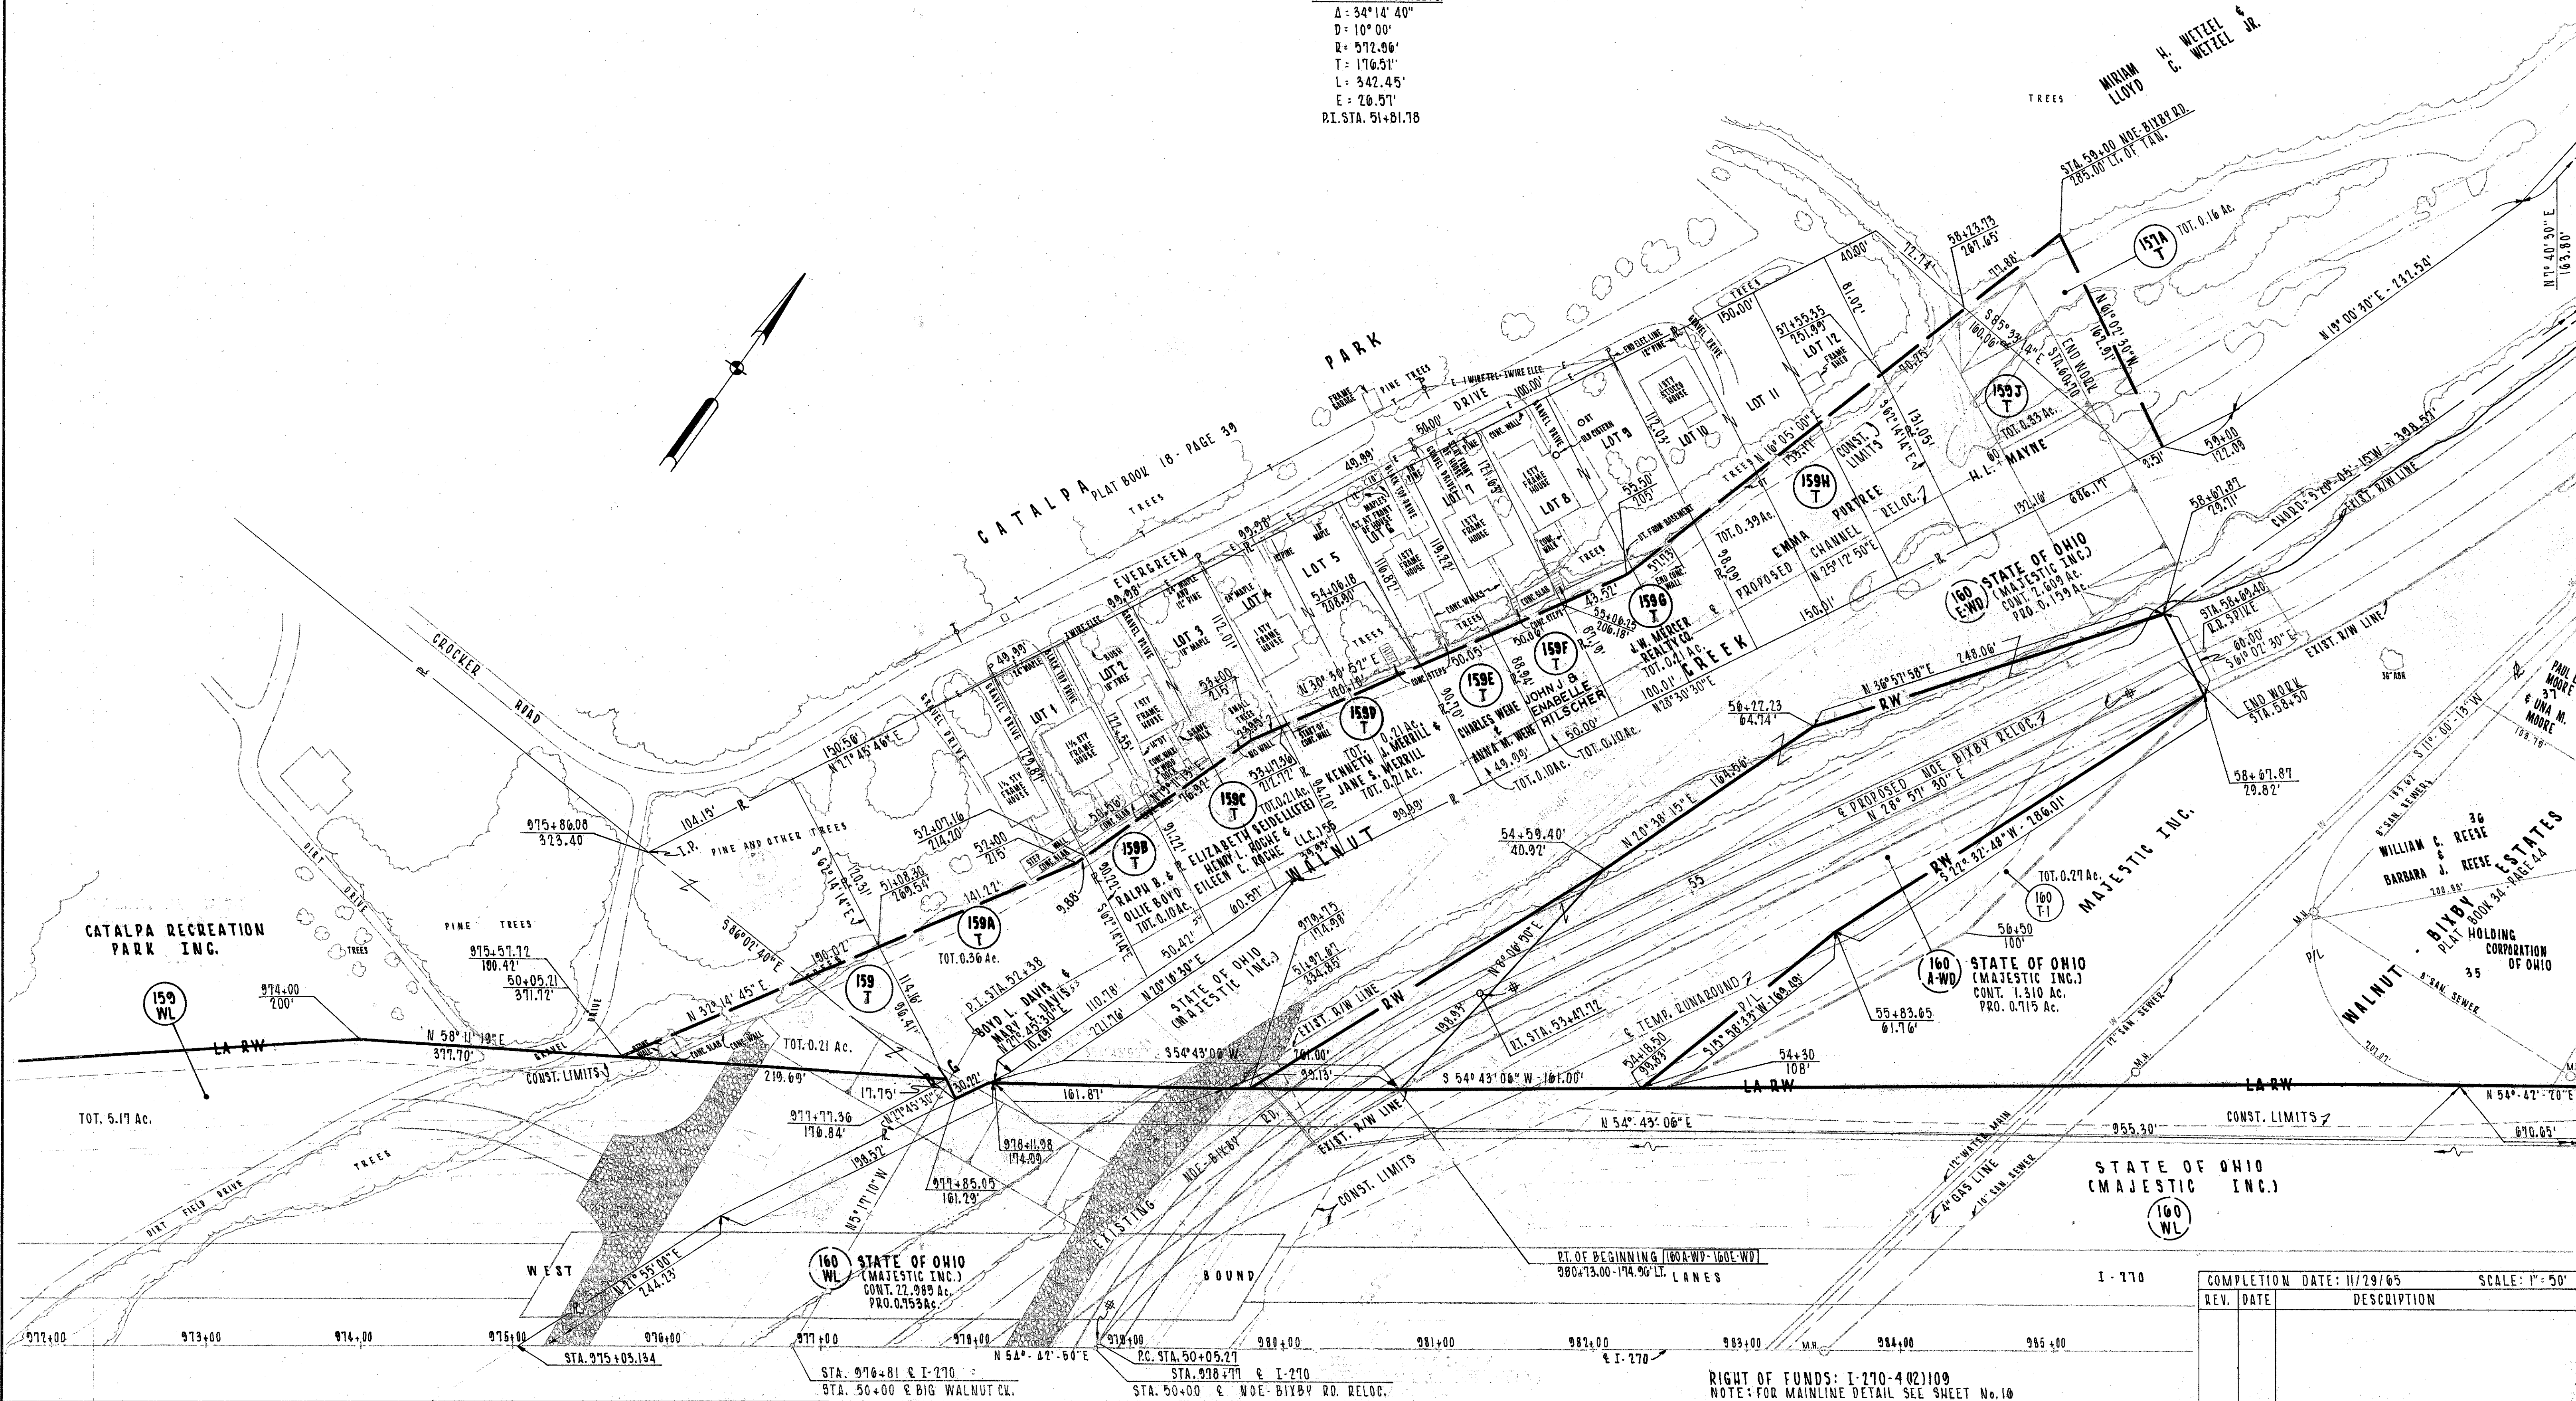

REV.	DATE	DESCRIPTION

COMPLETION DATE: 11/29/65
SCALE: 1" = 50'


RIGHT OF FUNDS: I-270-4(2)109
NOTE: FOR MAINLINE DETAIL SEE SHEET No. 18

FED. RD. DIVISION	STATE	PROJECT
2	OHIO	

FRANKLIN COUNTY - FRA-270-18.15 S
(I-270-4(7) ROW & PREL. ENG. ONLY)

251
251

19
19

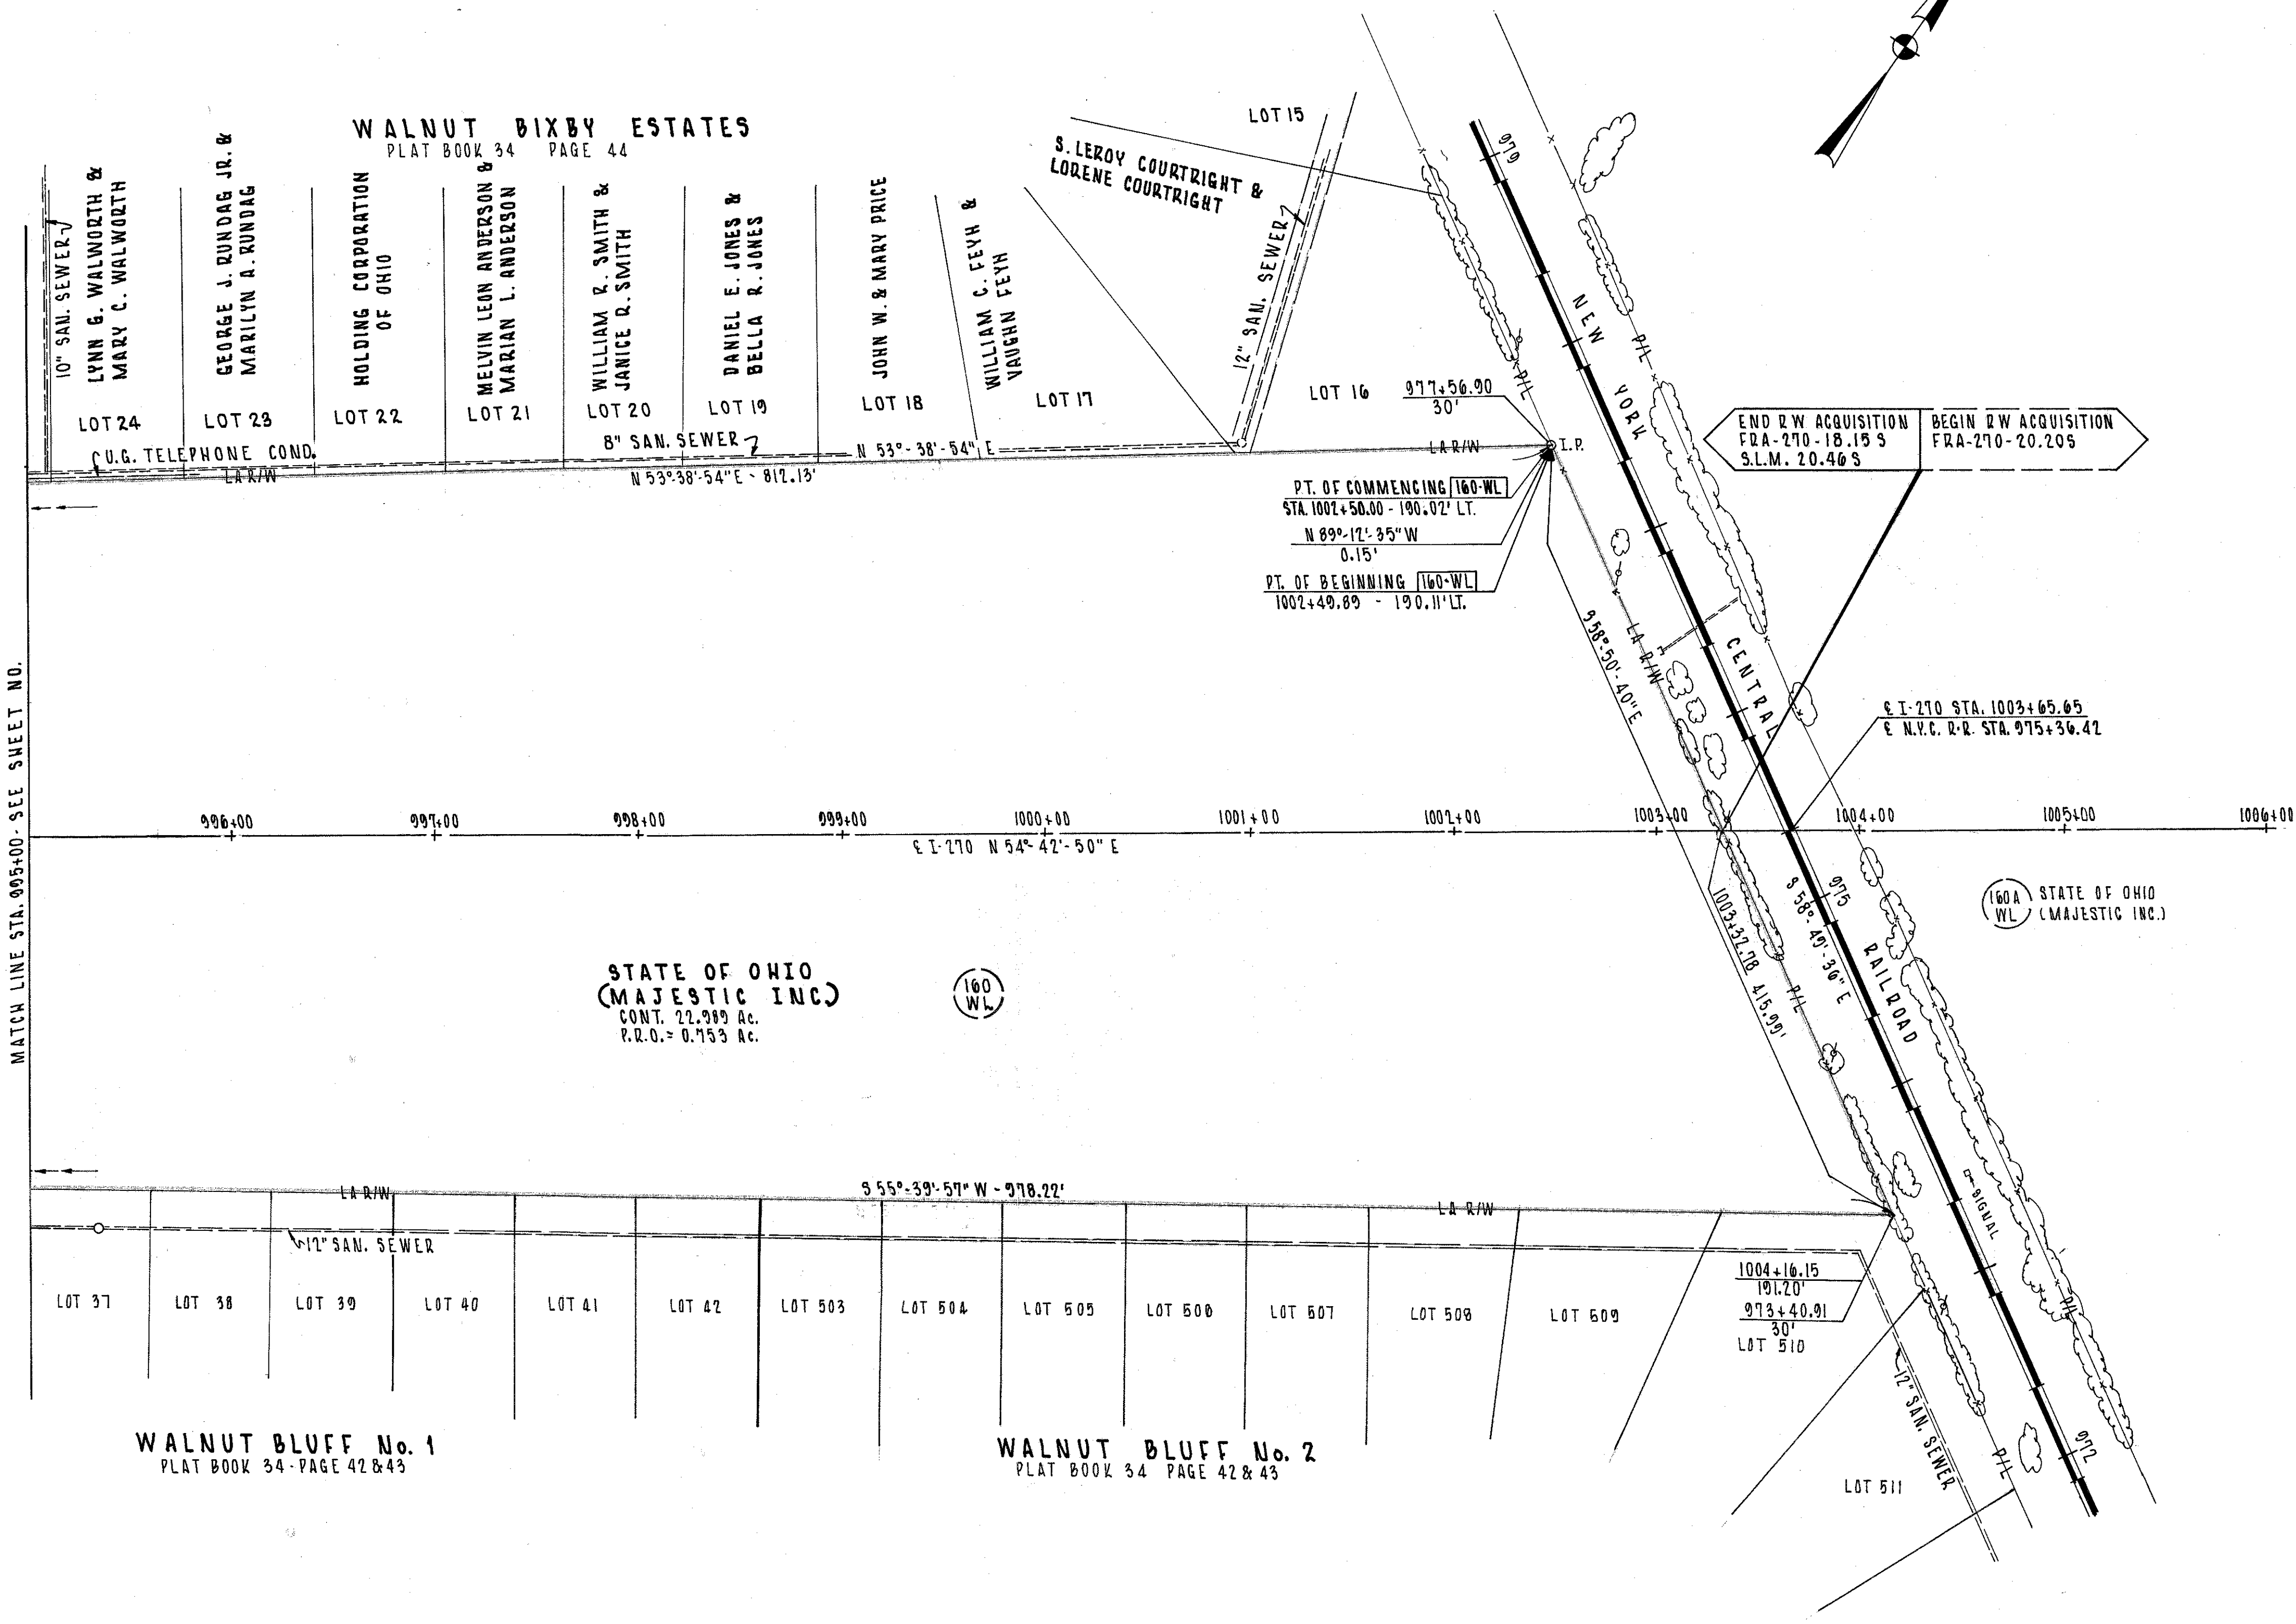

MATCH LINE STA. 995+00. SEE SHEET NO.

WALNUT BLUFF No. 1
PLAT BOOK 34 - PAGE 42 & 43

WALNUT BLUFF No. 2
PLAT BOOK 34 - PAGE 42 & 43

COMPLETION DATE: 11/29/05		SCALE: 1"=50'
REV.	DATE	DESCRIPTION